

APPENDIX A
AS-BUILT LOTB SHEETS

Rochester Overhead

DIST.	COUNTY	ROUTE	POST MILES—TOTAL PROJECT	SHEET NO.	TOTAL SHEETS
08	SBC	31	3.4 / 5.5	10A	156

DESIGN SECTION SUPERVISOR: [Signature]
 REGISTERED CIVIL ENGINEER NO. 1461
 DATE APPROVED: January 14, 1974

LEGEND OF BORING OPERATIONS

- PENETRATOR
- 2 1/2" CONE PENETRATOR
- ROTARY BORING (JET)
- LAGER BORING (JET)
- 1" SOIL TUBE
- TEST PIT

LEGEND OF BORING OPERATIONS (continued)

- Top Hole El.
- Top of Sample (ft)
- Bottom of Sample (ft)
- Bottom of Borehole (ft)
- Bottom of Jet (ft)
- Bottom of Lag (ft)
- Bottom of Soil Tube (ft)
- Bottom of Test Pit (ft)


LEGEND OF EARTH MATERIALS

- SILTY CLAY or CLAYEY SILT
- PEAT AND/OR ORGANIC MATTER
- FILL MATERIAL
- IGNEOUS ROCK
- SEDIMENTARY ROCK
- METAMORPHIC ROCK
- GRAVEL
- SAND
- SILT
- CLAY
- STANDY CLAY or CLAYEY SAND
- SANDY SILT or SILTY SAND

CLASSIFICATION OF MATERIAL BASED ON STANDARD GRADE SIZE LIMITS



DIAGRAM SHOWING THE BASIS FOR ESTIMATES OF GRADE SIZE DISTRIBUTION USED IN DETERMINATION OF CLASS NAMES. UNDESIRABLE AMOUNTS OF THE TERM "GRAVELLY" MAY BE ADDED TO THE CLASS NAME, VIZ. "GRAVELLY SAND". THE TERMS "GRAVELLY CLAY", "GRAVELLY SILT", AND "GRAVELLY SAND" ARE USED TO DESCRIBE SAND, SILT AND GRAVEL REFER TO STANDARD GRADE SIZE LIMITS.

NOTE: Classification of earth material as shown on this sheet is based upon field inspection and is not to be construed to imply mechanical analysis.

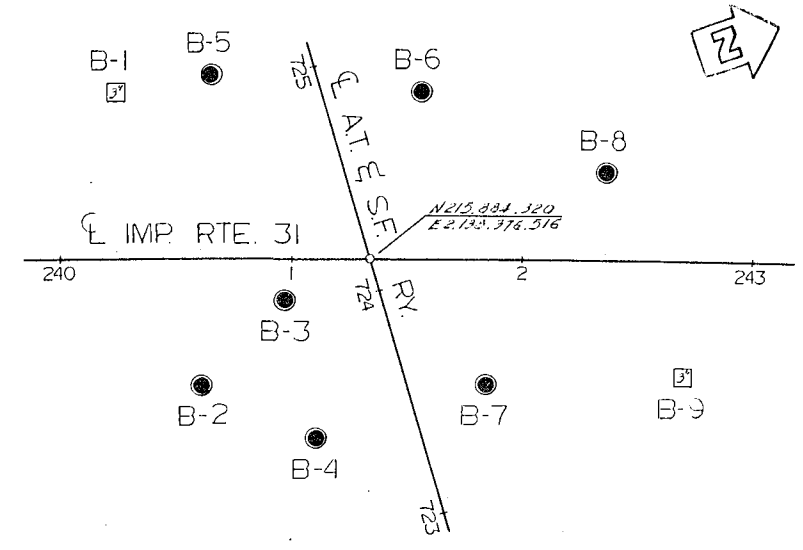

PROFILE

Scale: 1" = 10' (Vertical), 1" = 20' (Horizontal)

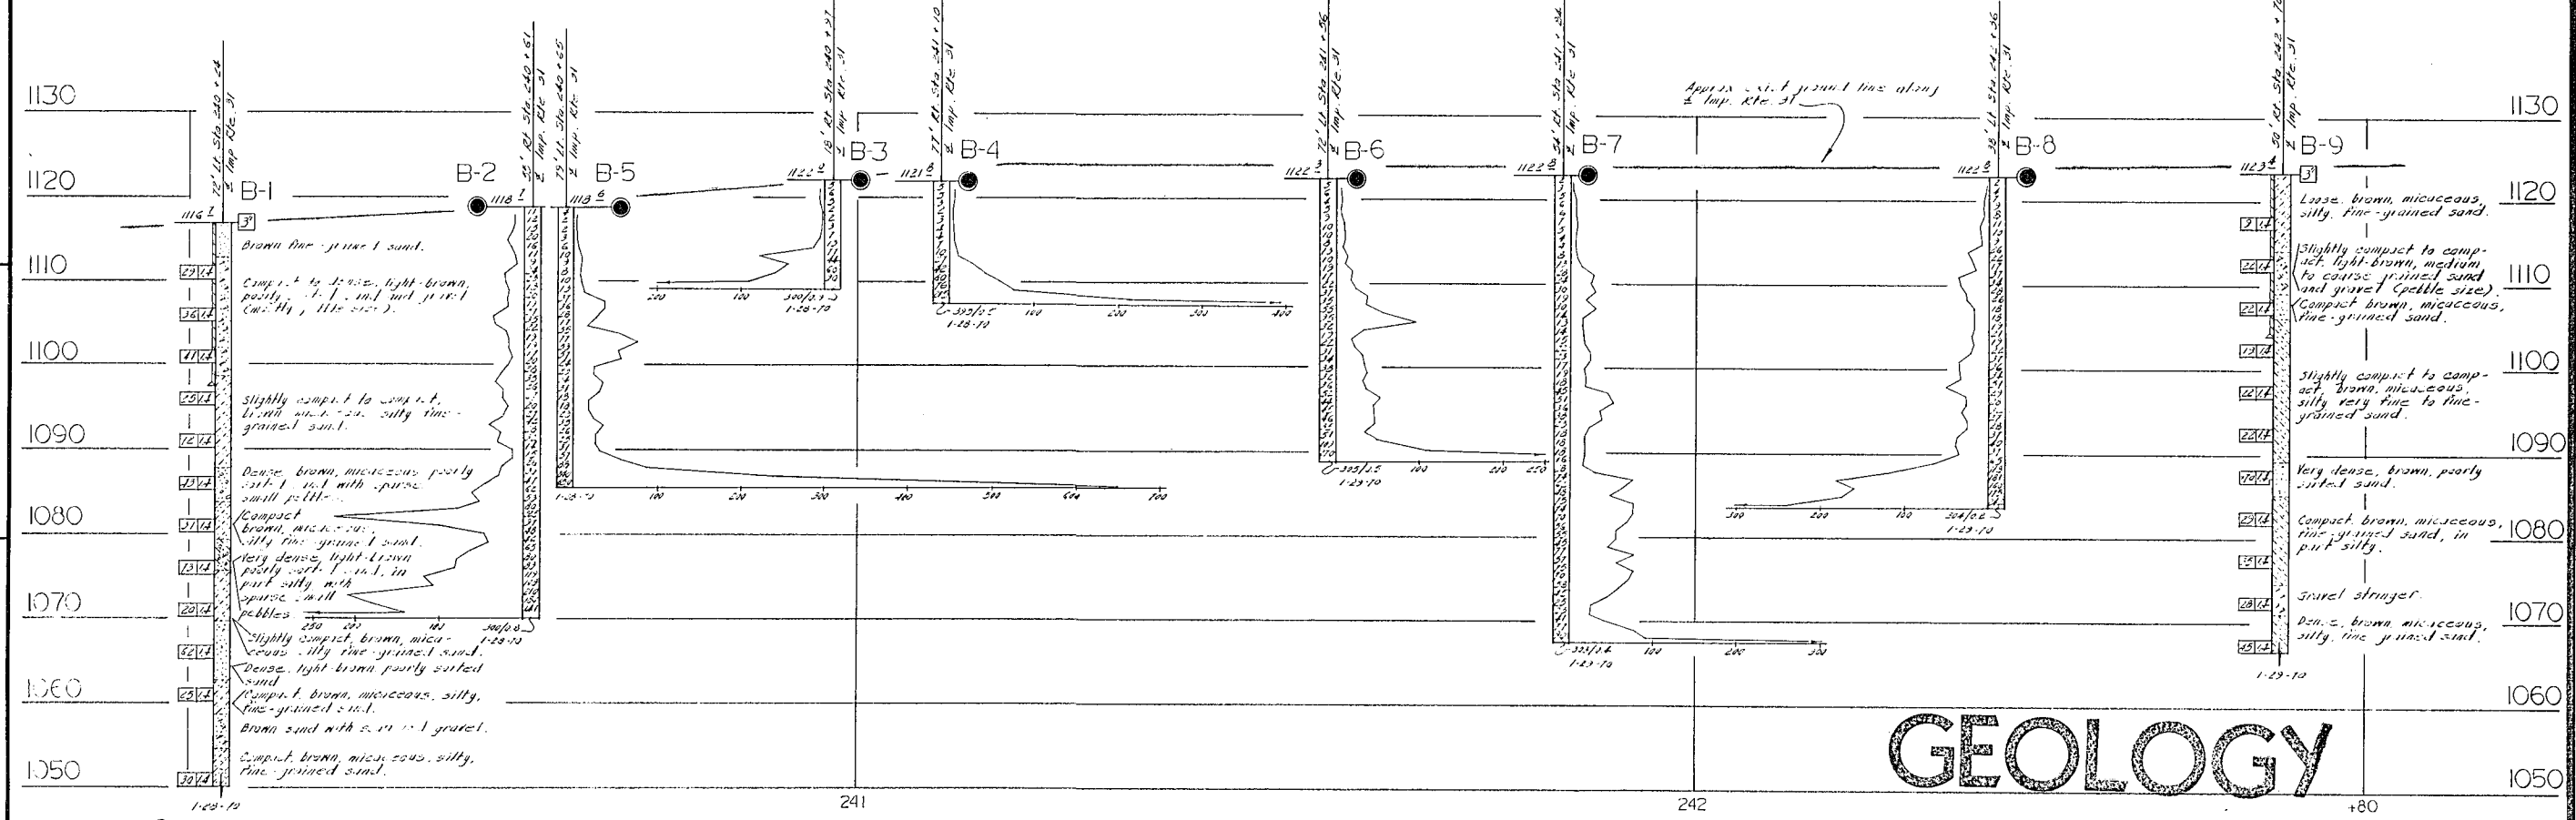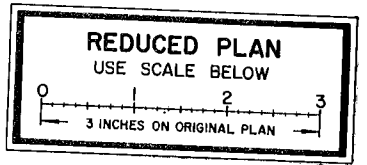

GEOLOGY

STATE OF CALIFORNIA DEPARTMENT OF TRANSPORTATION				
ROCHESTER OVERHEAD				
LOG OF TEST BORINGS				
BRIDGE NO. 54-919R/L	POST MILE 4.1	DRAWING NO.	SHEET 10	OF 10
REVISION DATES		(PRELIMINARY STAGE ONLY)		

WO 171801
 CU 08201



BRIDGE DEPARTMENT
 ENGINEERING GEOLOGY SECTION

10A

Arrow Route UC /Day Canyon Channel

DIST.	COUNTY	ROUTE	POST MILES—TOTAL PROJECT	SHEET NO.	TOTAL SHEETS
08	SEd.	31	3.4/5.5	115	136

DESIGN SECTION SUPERVISOR REGISTERED CIVIL ENGINEER NO. 14816
 DATE APPROVED: January 14, 1974

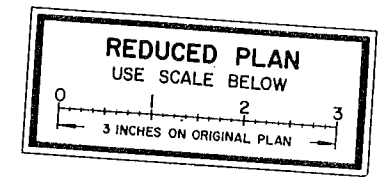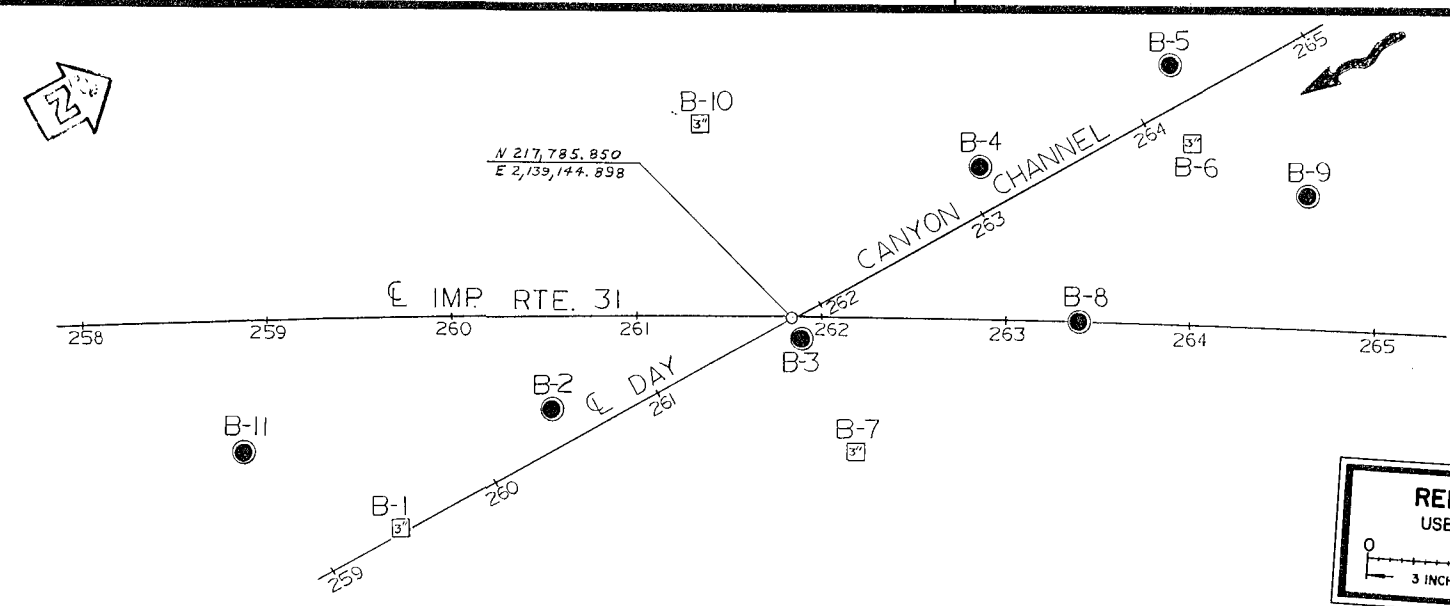

PLAN
Scale: 1"=50'

PROFILE
Scale: Vert. 1"=10'
Horiz. 1"=20'

NO RECORDS WERE ENCOUNTERED
 IN THE INVESTIGATION BY
 DATE: MAY, 1970

LEGEND

PHENOMETER
 2 1/2" CONE PENETROMETER
 SAMPLER BORING (SB)
 ROTARY BORING (RB)
 AUGER BORING (AB)
 JET BORING
 CORE BORING
 TEST PIT

1" SOIL TUBE

ROTARY BORING

PENETRATION BORING

Top Hole El.
 Bottom Hole El.
 Location
 Description of material
 Size of sample (inches)
 (Using a 1/2" diameter)
 Unconfined compressive strength
 (psi)
 Shear strength (psi)
 Estimated material change
 (psi)
 Unconfined material change
 (psi)


LEGEND OF EARTH MATERIALS

GRAVEL
 SAND
 SILT
 CLAY
 SANDY CLAY OR CLAYEY SAND
 SILT OR SILTY SAND
 CLAYEY SILT OR SILTY CLAY
 ORGANIC MATTER
 FILL MATERIAL
 INGENUOUS ROCK
 SEDIMENTARY ROCK
 METAMORPHIC ROCK

CLASSIFICATION OF MATERIAL BASED ON STANDARD GRAVEL SIZE LIMITS

DIAGRAM SHOWING THE BASIS FOR ESTIMATES OF GRAVEL SIZE DISTRIBUTION USE IN DETERMINING GRAVEL PERCENTAGE. IF GRAVEL IS PRESENT IN APPRECIABLE AMOUNTS THE TERM "GRAVELLY" MAY BE ADDED TO THE CLAY NAME, I.E., "CLAYEY SILTY SAND", "SANDY SILTY CLAY", "SANDY SILTY CLAYEY SILT", "SANDY SILTY CLAYEY SILT WITH GRAVEL", "SANDY SILTY CLAYEY SILT WITH GRAVEL AND SILT", "SANDY SILTY CLAYEY SILT WITH GRAVEL AND SILT AND CLAY".

NOTE: Classification of earth material as shown on this sheet is based upon field inspection and is not to be construed to imply mechanical analysis.

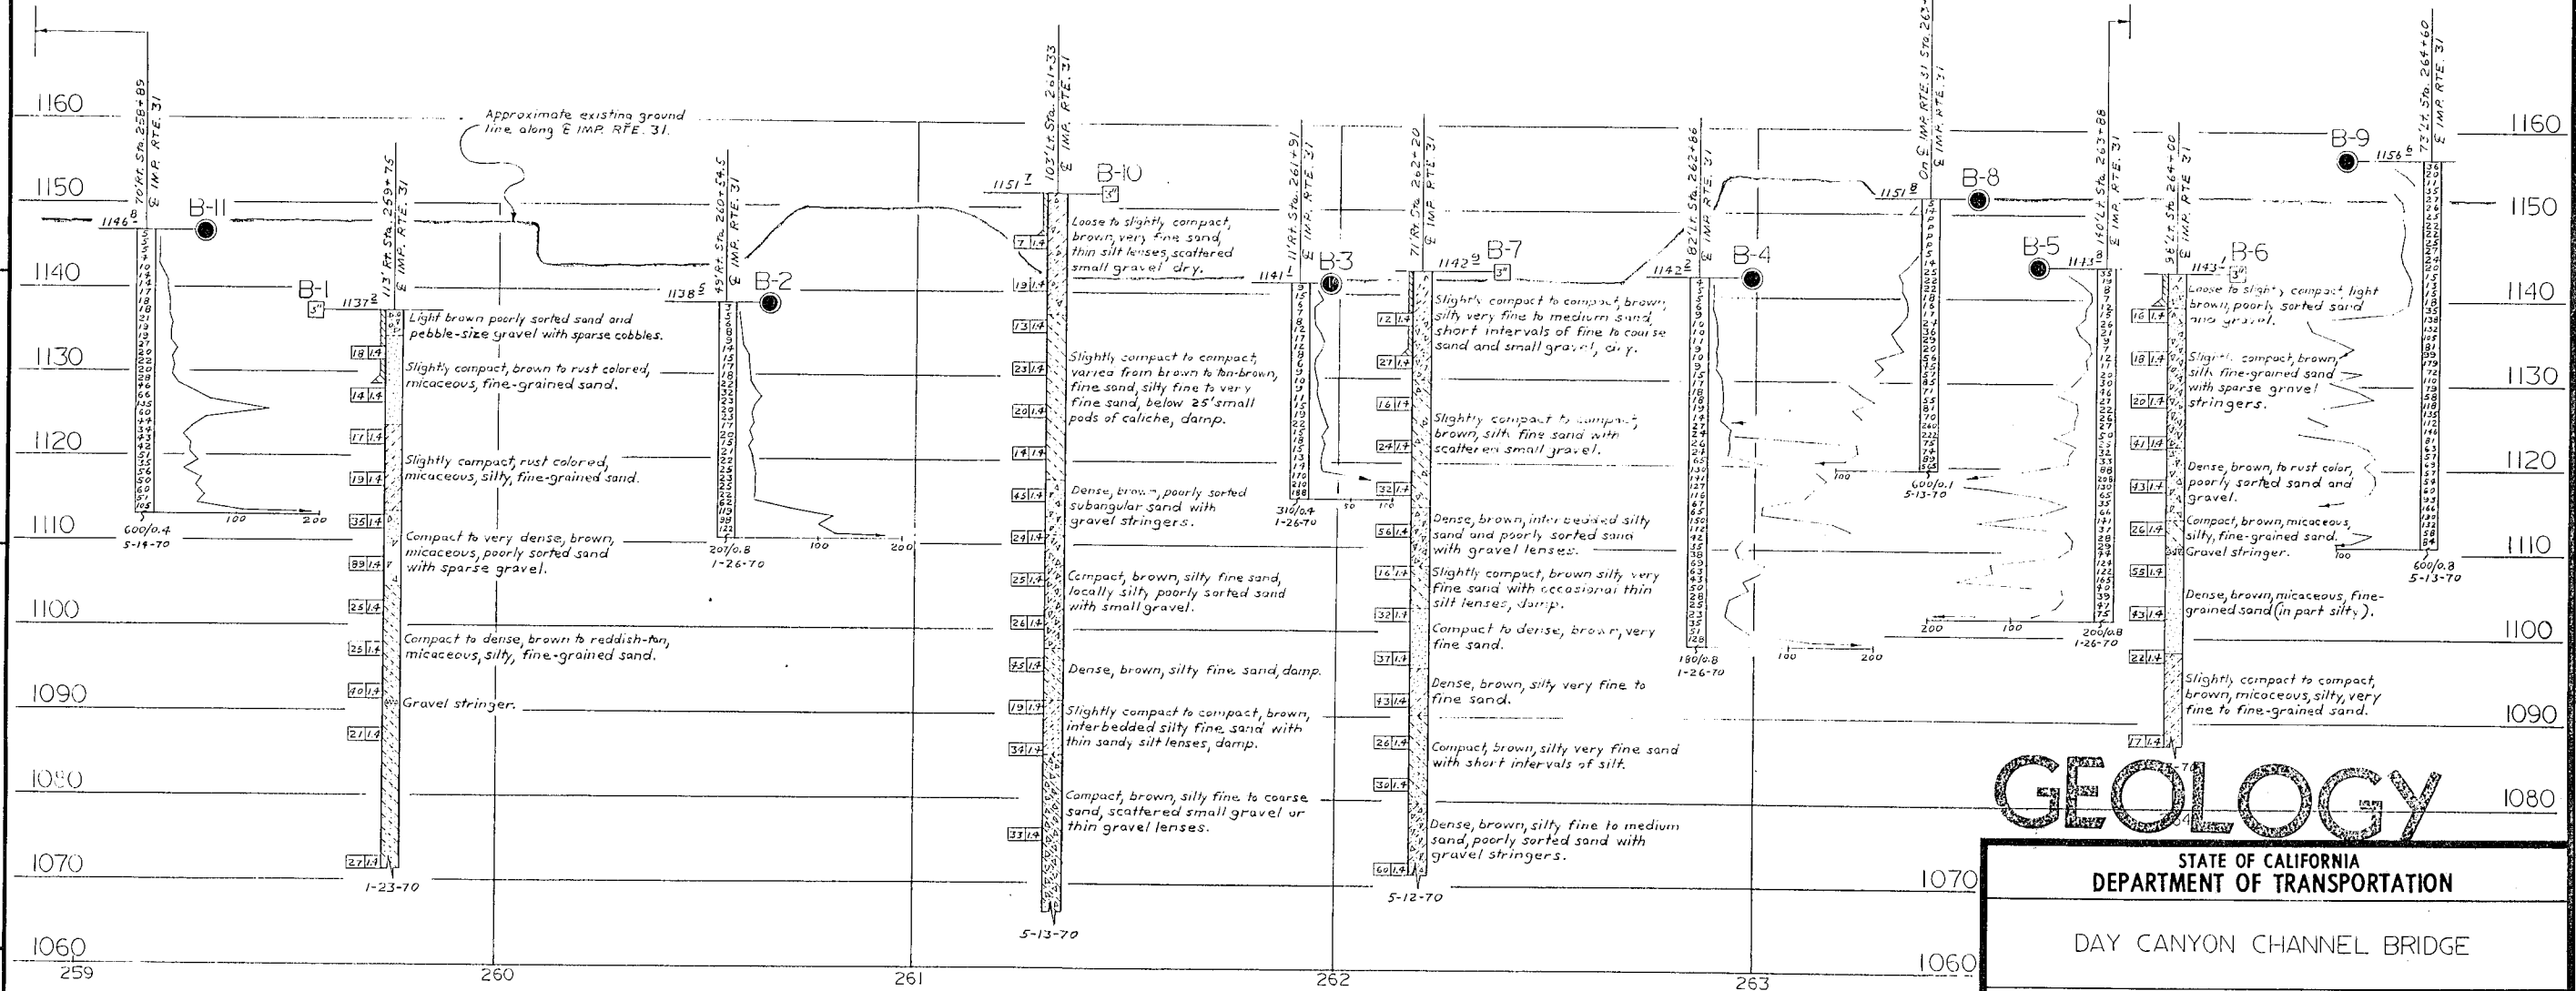

GEOLOGY

STATE OF CALIFORNIA
 DEPARTMENT OF TRANSPORTATION

DAY CANYON CHANNEL BRIDGE

LOG OF TEST BORINGS

BRIDGE NO. 54-920 R/L	POST MILE 4.5	DRAWING NO.	SHEET 11	OF 11
-----------------------	---------------	-------------	----------	-------

FIELD STUDY BY: E. SANDERS 5-13-70
 DRAWN BY: S. WENZEL 5-20-70
 CHECKED BY: D. E. CALVERT 5-23-70
 Approved: [Signature]

BRIDGE DEPARTMENT
 ENGINEERING GEOLOGY SECTION

WO 171802
 CU 08201

Disregard prints bearing earlier revision dates

REVISION DATES	(PRELIMINARY STAGE ONLY)
18/2/70	10/20

115


Rte 66 / I-15 Separation

The State of California or its officers or agents shall not be responsible for the accuracy or completeness of electronic copies of this plan sheet.


DIST	COUNTY	ROUTE	POST MILES TOTAL PROJECT	SHEET NO.	TOTAL SHEETS
08	SBd	15,66	5.0/5.5, 9.6/10.0	92	92

James Weaver
 GEOTECHNICAL PROFESSIONAL
 8-26-96
 PLANS APPROVAL DATE

Schaefter Dixon Associates, Inc.
 22 Mauchly
 Irvine, California 92718

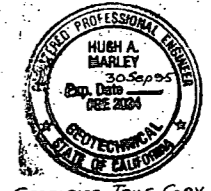


CERTIFIED TRUE COPY
 Hugh A. Marley
 Ph. D., C.E., G.E.
 Geotechnical Professional
 G.E. 2034
 Vice President - Ergs
 Schaefter Dixon Assoc., Inc.
 14 March 1995

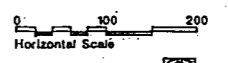

-Plan-

REFERENCE:
 Station Numbers are Based on CALTRANS Geometric Approval Drawing.
 BENCHMARK:
 One-inch Round Head Bolt in Curb, on Foothill Blvd. Under Fry, I-15 Overpass on Northernly Curb of Center Divider, North of Westerly Most Bridge Support
 ELEVATION: 1203.774
 No Groundwater Encountered.

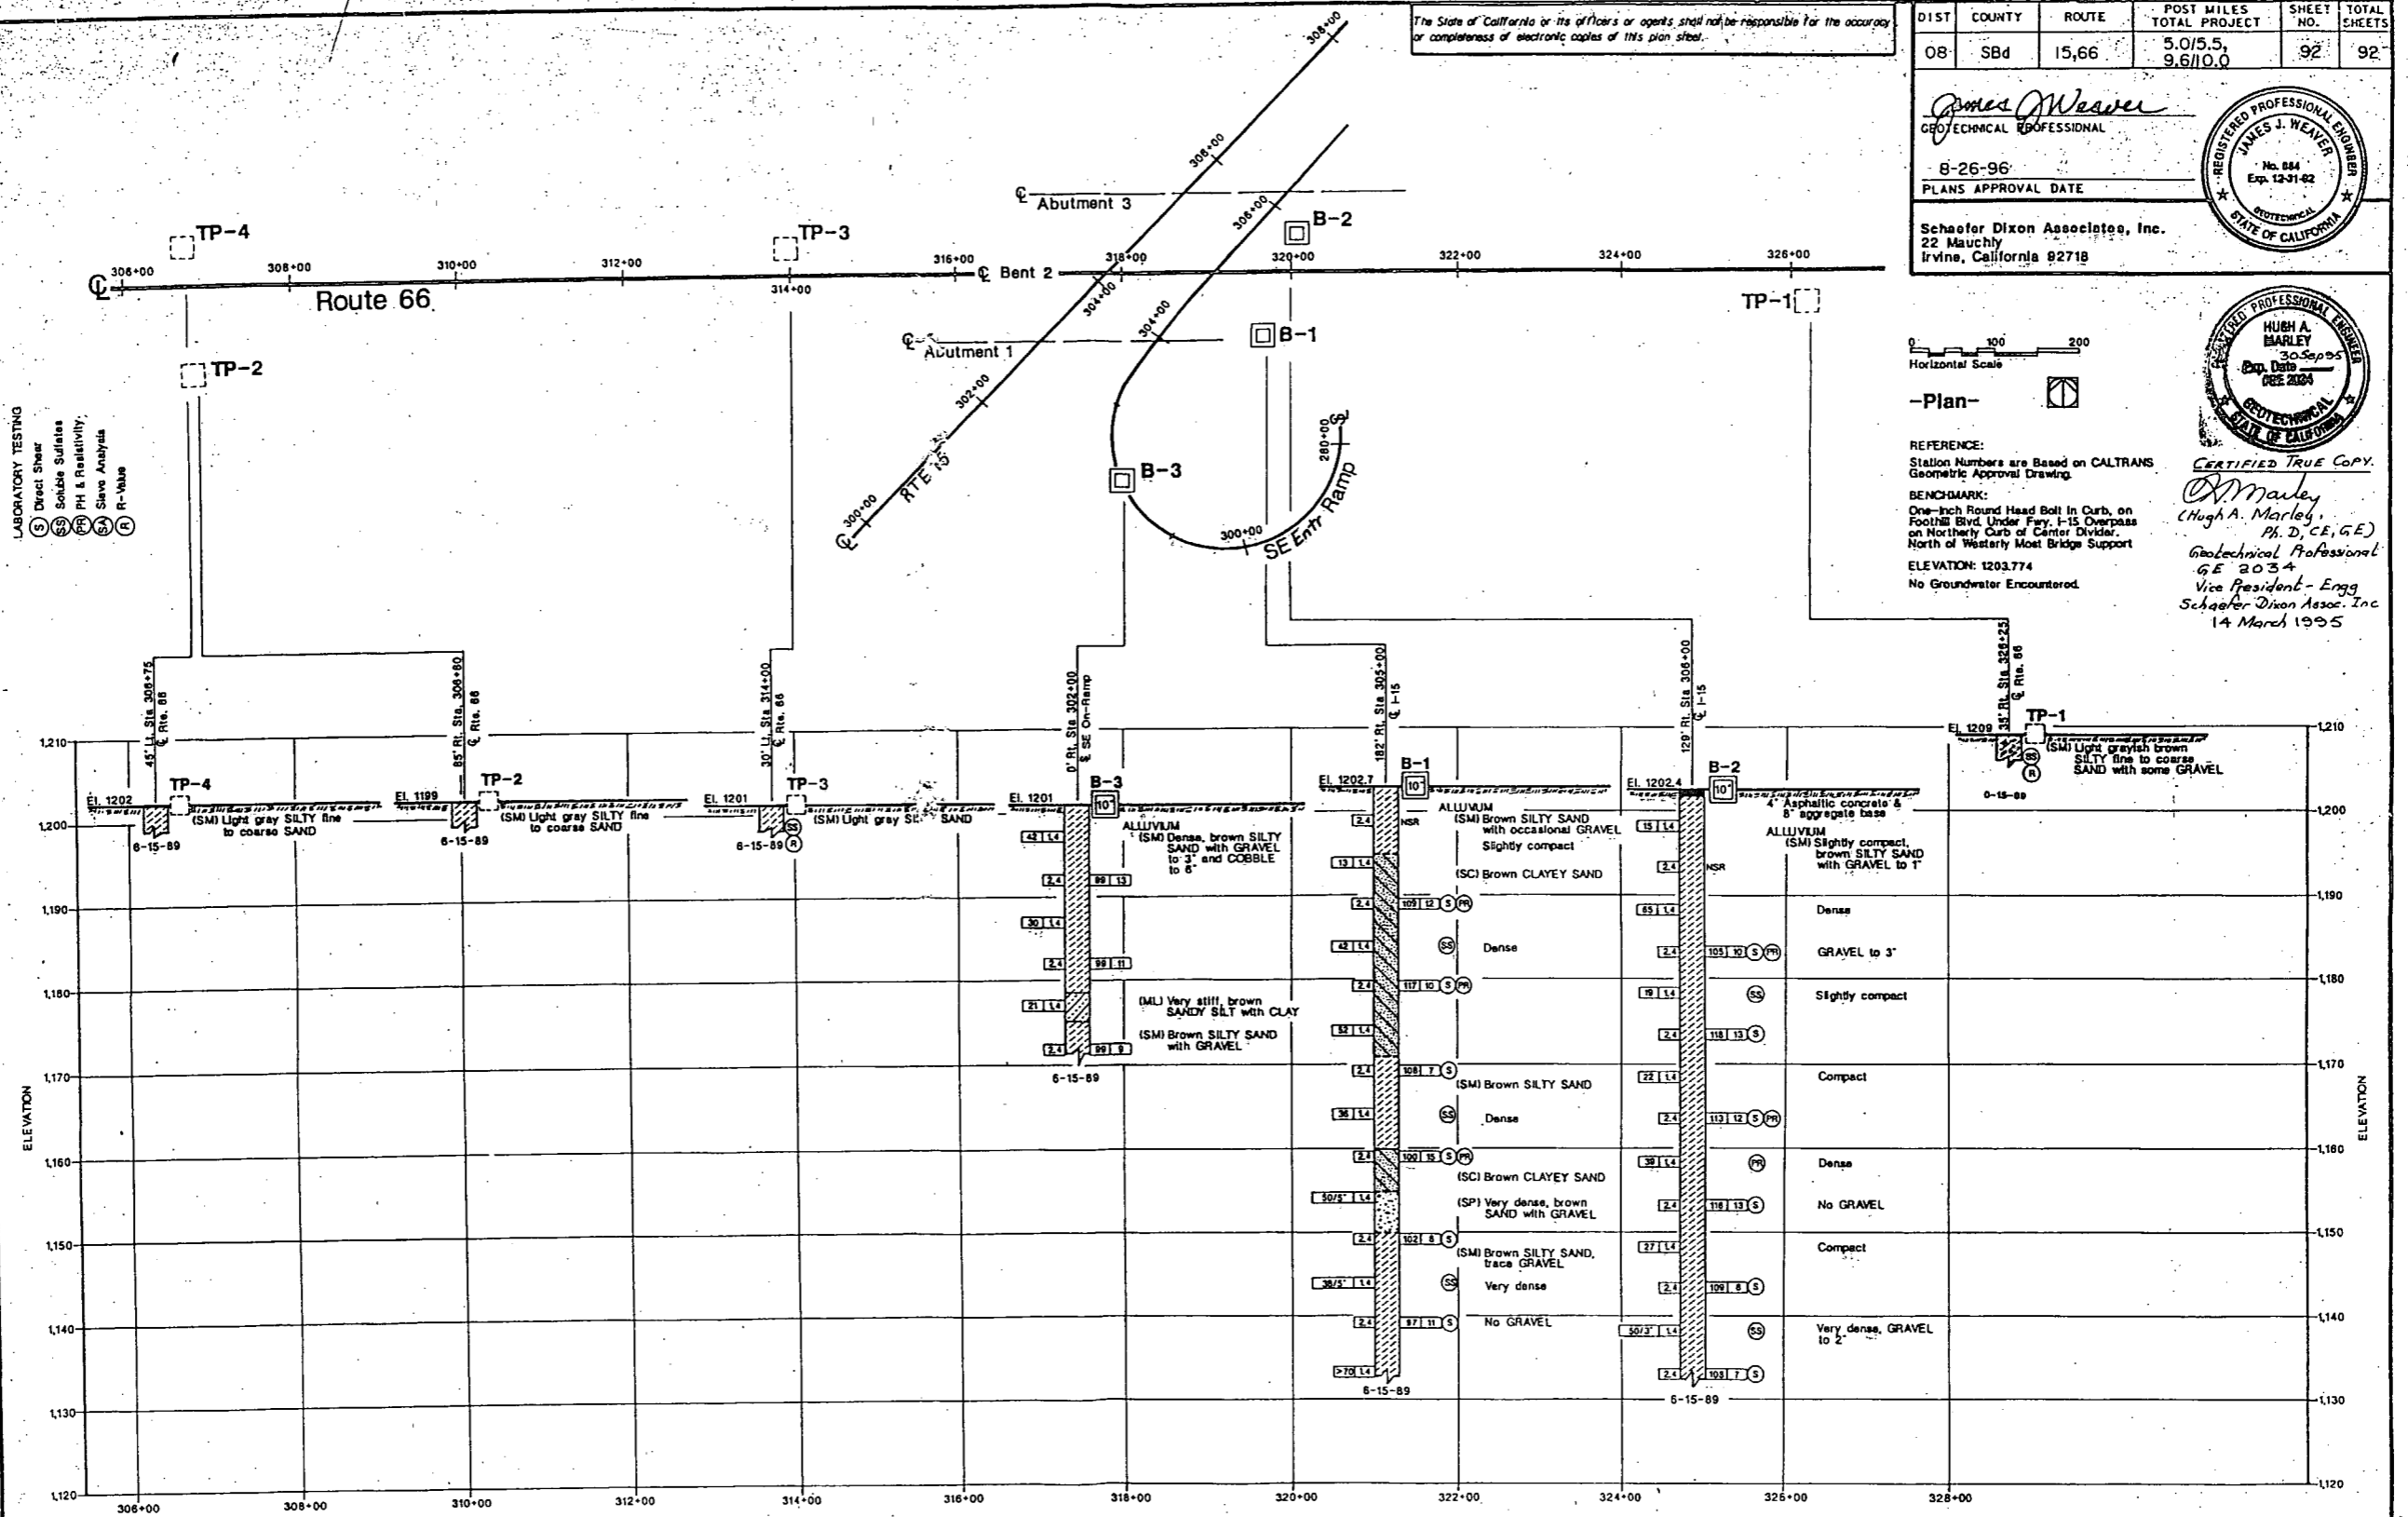

LEGEND OF BORING OPERATIONS

3 1/2" CORE PENETROMETER
 (S) Direct Shear
 (SS) Soils Sulfides
 (SR) PH & Resistivity
 (SA) Shear Analysis
 (R) R-Value

ROTARY SAMPLE BORING (WET)
 (S) Direct Shear
 (SS) Soils Sulfides
 (SR) PH & Resistivity
 (SA) Shear Analysis
 (R) R-Value

3 1/2" CORE PENETROMETER
 (S) Direct Shear
 (SS) Soils Sulfides
 (SR) PH & Resistivity
 (SA) Shear Analysis
 (R) R-Value

LEGEND OF EARTH MATERIALS

GRAVEL
 SAND
 SILT
 CLAY
 CLAYEY SILT
 CLAYEY SAND
 SANDY SILT
 SANDY SAND
 SILTY SAND
 SILTY CLAY

CLAYEY SILT
 SILT
 SAND
 CLAY
 CLAYEY SILT
 CLAYEY SAND
 SANDY SILT
 SANDY SAND
 SILTY SAND
 SILTY CLAY

CONSISTENCY CLASSIFICATION FOR SOILS

Penetration (lb/in ²)	Consistency
0-4	Very soft
5-9	Soft
10-20	Medium
25-35	Stiff
40-60	Very stiff
70-90	Hard
>100	Very hard

NOTE: Classification of earth material as shown on this sheet is based upon field inspection and it will be construed to imply mechanical analysis.

DRIVEN BY: WS
 CHECKED BY: PL
 DATE: 2-1991

PREPARED FOR THE
STATE OF CALIFORNIA
 DEPARTMENT OF TRANSPORTATION

Wei Te Koo
 PROJECT ENGINEER

BRIDGE NO. 54-922 R/L
 POST MILE 5.3
ROUTE 15/66 SEPARATION (RETAINING WALLS)
LOG OF TEST BORINGS

CU 08206
 EA 281800

REVISION DATES (PRELIMINARY STAGE ONLY)

1	2	3	4	5	6	7	8	9	10
---	---	---	---	---	---	---	---	---	----

SHEET 9 OF 9

Project No.: 90-014


ORIGINAL SCALE IN INCHES FOR REDUCED PLANS: 0, 1, 2, 3

DIST.	COUNTY	ROUTE	POST MILES-TOTAL PROJECT	SHEET NO.	TOTAL SHEETS
08	SBD.	31			

BRIDGE ENGINEER _____ REGISTERED CIVIL ENGINEER NO. _____
 DATE APPROVED _____

BENCH MARKS

B.M. # 31-A-69 Elev. 1198.89'
 Std. disk in conc. stamped "B.M. 31-A-69"
 75' Rt. 315+00 E Foothill 1.0' deep.

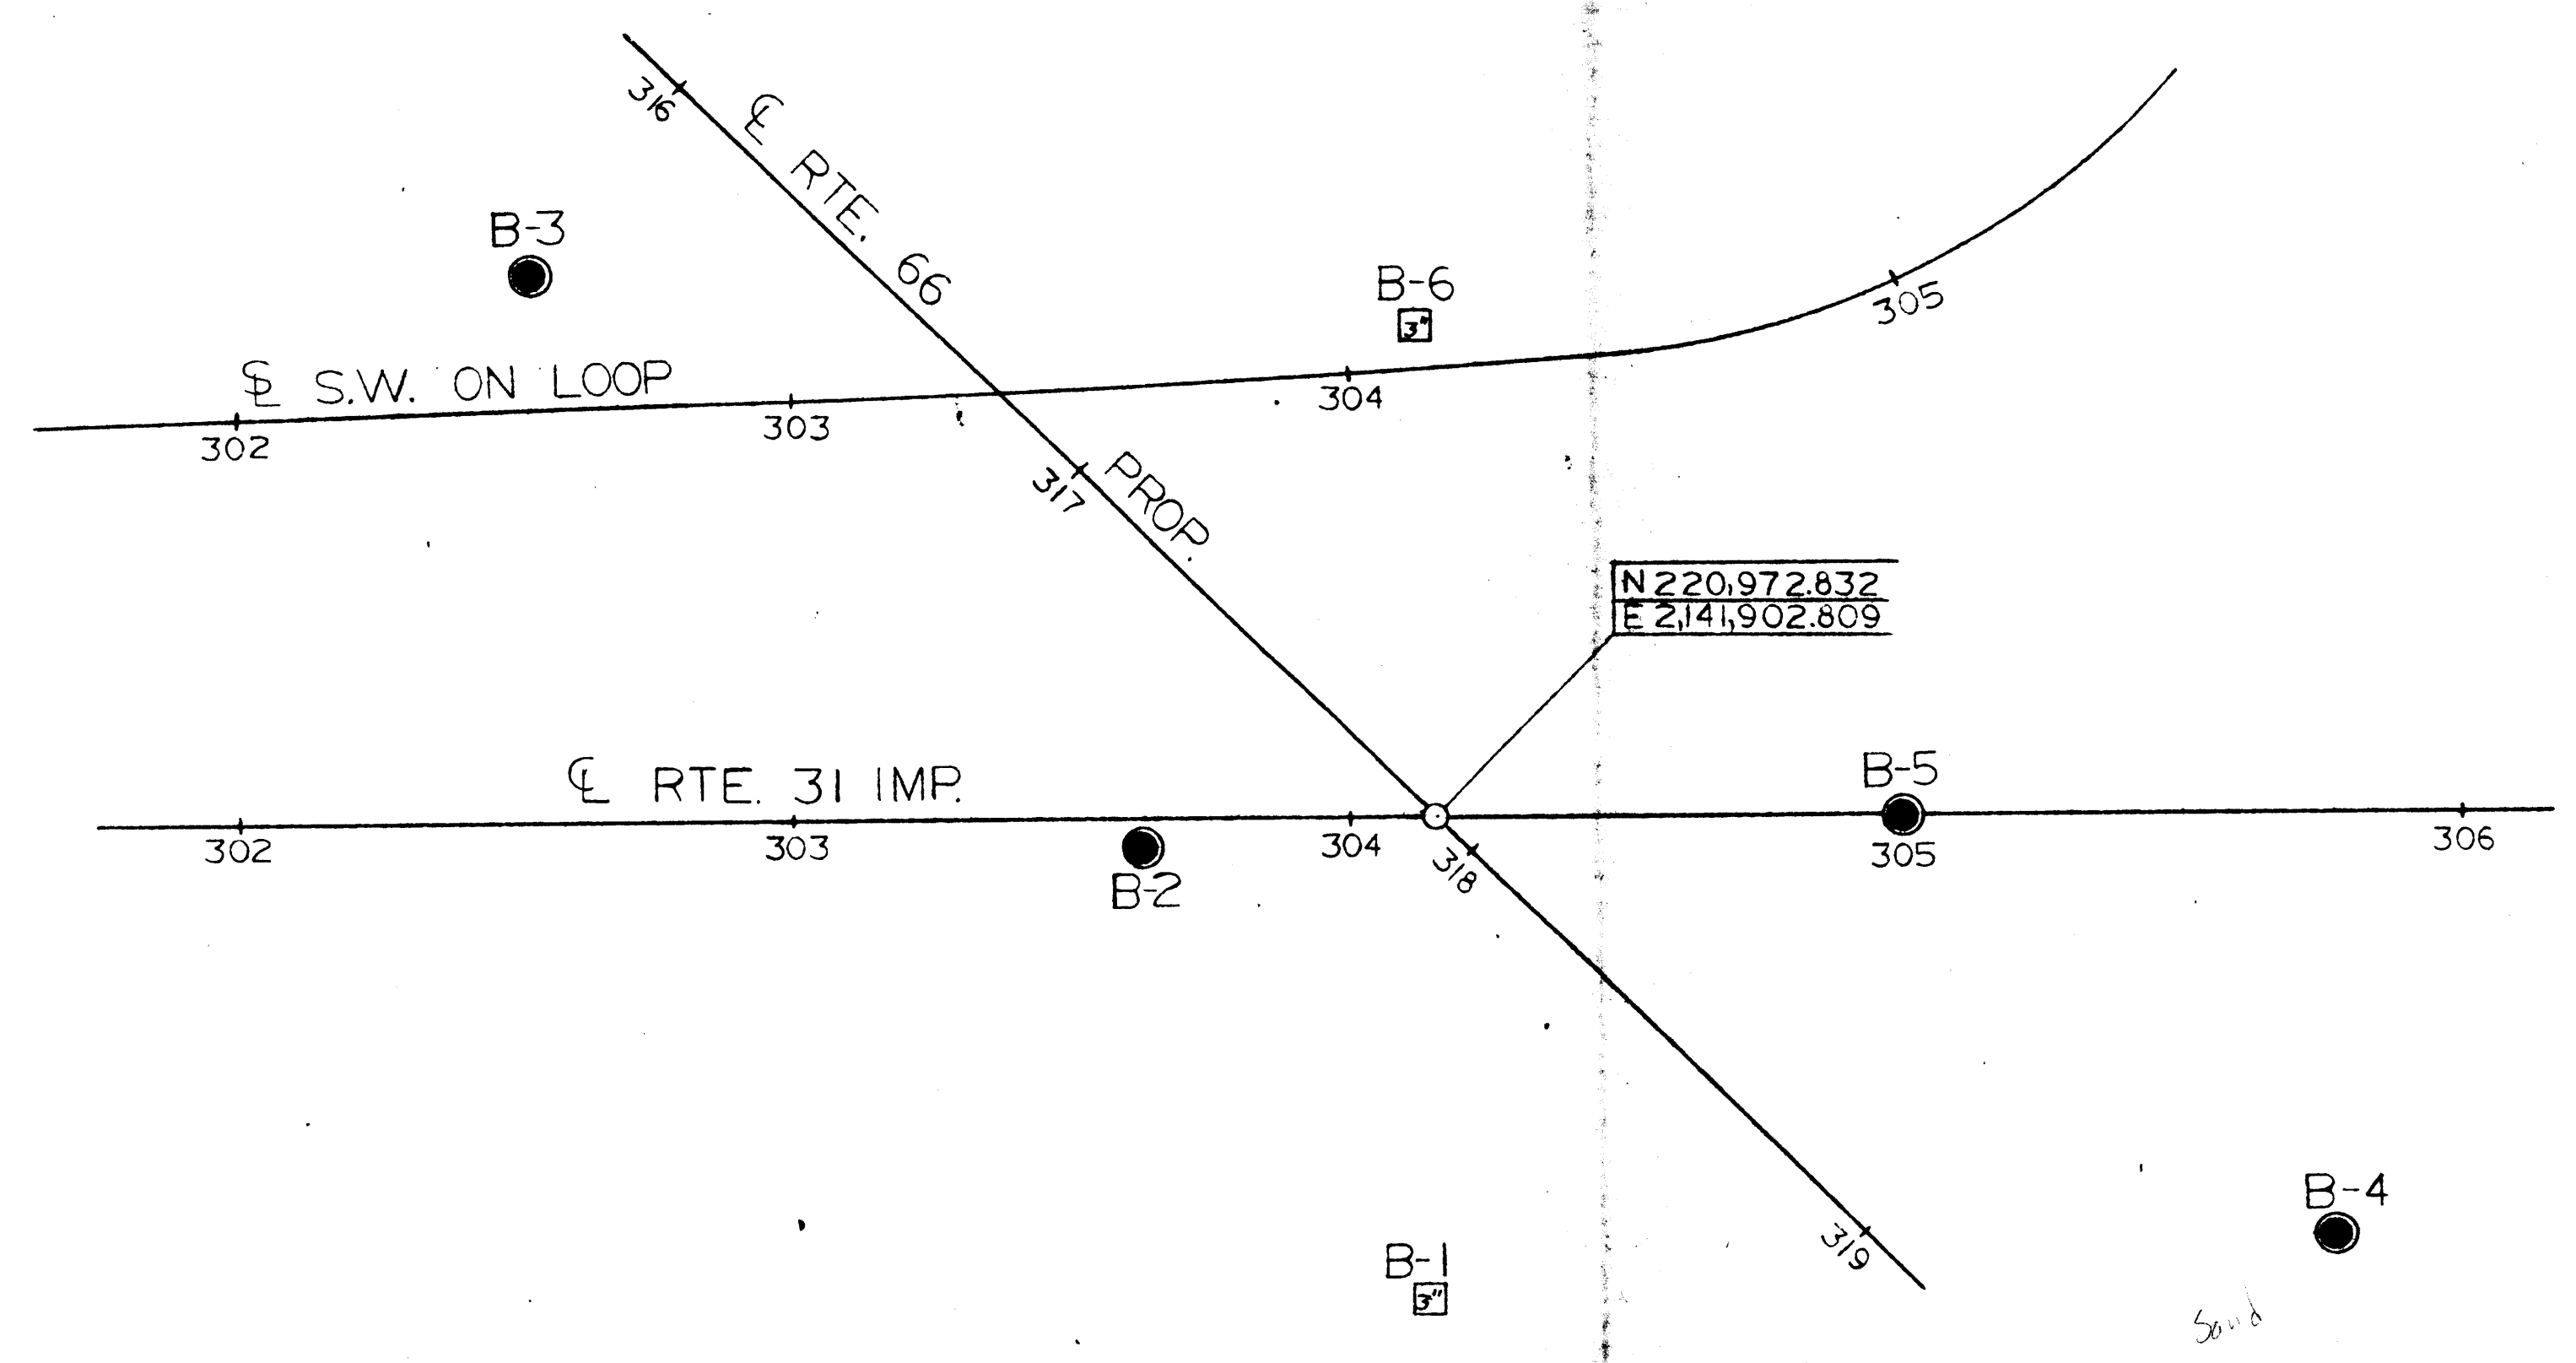


PLAN
 Scale: 1" = 30'

PROFILE
 Scale: Vert. 1" = 10'
 Horiz. 1" = 20'

Handwritten notes:
 6.50
 4.77
 1.73

NO GROUND WATER ENCOUNTERED
 DURING THIS INVESTIGATION BY
 BRIDGE DEPT. GEOLOGY SECTION
 DATE SEP, 1969

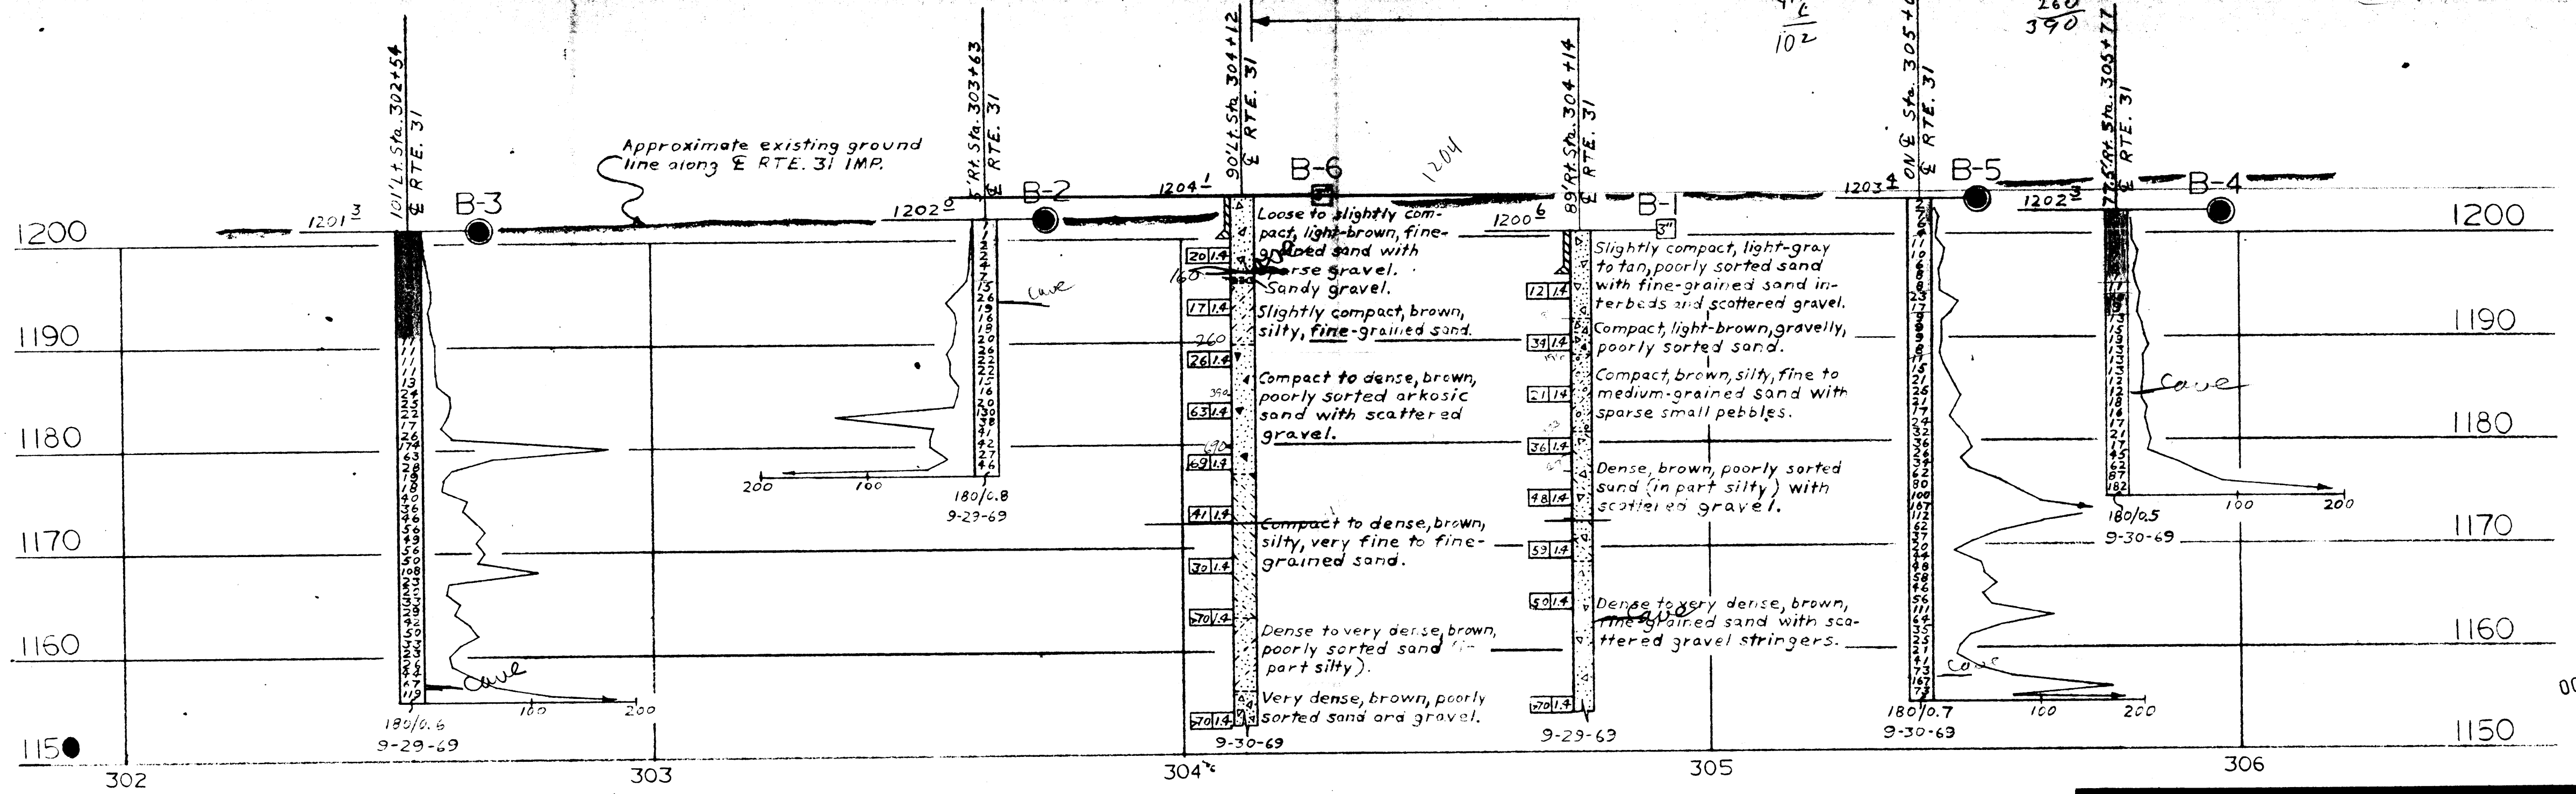

OCT 16 1969

STATE OF CALIFORNIA TRANSPORTATION AGENCY DEPARTMENT OF PUBLIC WORKS DIVISION OF HIGHWAYS			
ROUTE. 31/66 SEPARATION			
LOG OF TEST BORINGS			
BRIDGE NO. 54-922 RL	POST MILE 5.3	DRAWING NO.	SHEET OF
REVISION DATES		(PRELIMINARY SHEETS ONLY)	

WO 059031
 CU 08201

Disregard prints bearing earlier revision dates

LEGEND OF BORING OPERATIONS

- PHENOMETER
- 2 1/2" CONE PENETROMETER
- SWIMMER BORING (REV)
- ROTARY BORING (REV)
- AUGER BORING (REV)
- JET BORING
- CORE BORING
- TEST PIT

LEGEND OF EARTH MATERIALS

- SILTY CLAY OR CLAYEY SILT
- PEAT
- ORGANIC MATTER
- FILL MATERIAL
- IGNEOUS ROCK
- SEDIMENTARY ROCK
- METAMORPHIC ROCK
- GRAVEL
- SAND
- SILT
- CLAY
- SANDY CLAY OR CLAYEY SAND
- SANDY SILT OR SILTY SAND

CLASSIFICATION OF MATERIAL BASED ON STANDARD GRADE SIZE LIMITS

Diagram showing the basis for size estimates and the location of class marks. The diagram is a ternary plot for sand, silt, and clay percentages.

LEGEND OF EARTH MATERIALS

- SILTY CLAY OR CLAYEY SILT
- PEAT
- ORGANIC MATTER
- FILL MATERIAL
- IGNEOUS ROCK
- SEDIMENTARY ROCK
- METAMORPHIC ROCK
- GRAVEL
- SAND
- SILT
- CLAY
- SANDY CLAY OR CLAYEY SAND
- SANDY SILT OR SILTY SAND

CLASSIFICATION OF MATERIAL BASED ON STANDARD GRADE SIZE LIMITS

Diagram showing the basis for size estimates and the location of class marks. The diagram is a ternary plot for sand, silt, and clay percentages.

NOTE: Classification of earth material as shown on this sheet is based upon field inspection and is not to be construed to imply mechanical analysis.

FIELD STUDY	By D.B. CRANFORD 9-30-69
DRAWN	By E. JIMENEZ 10-8-69
CHECKED	By R. COVATTA 10-20-69
Approval Recommended by	<i>[Signature]</i>

BRIDGE DEPARTMENT
 ENGINEERING GEOLOGY SECTION

Etiwanda Avenue

LEGEND OF BORING OPERATIONS

- PENETRATION BORING: No. count recorded, Date and time of operation, Pushed into soil at second, per foot (Using a No. 2 hand hammer or hammer of similar weight 15 lbs. or as noted), Bore hole diameter.
- ROTARY BORING: Boring date, Boring site, Name of bore, View shown.
- SAMPLER BORING (DRY): 3/4" CORE PENETROMETER, Top hole elevation, Depth from ground surface, Date, Time, Name of operator, Date of operation, Description of material, Soil weight (lbs), Moisture, % moisture, Size of sample (in), Unconfined compression test (psi) or as noted, C.S.G. & C.B.T., Unconfined compressive strength (T/F) or as noted, Unconfined shear strength (T/F) or as noted, Unconfined moment of change.
- JET BORING: Same as sampler boring.
- TEST PIT: Retain, Boring date, Name of bore.

LEGEND OF EARTH MATERIALS


- SILTY CLAY or CLAYEY SILT
- CLAY
- SANDY SILT
- SILT
- SANDY SAND
- SAND
- GRAVEL
- ORGANIC MATTER
- FILL MATERIAL
- IGNEOUS ROCK
- SEDIMENTARY ROCK
- METAMORPHIC ROCK

CONSISTENCY CLASSIFICATION FOR SOILS

According to the Standard Penetration Test Cohesive

No. of blows	Consistency
0-5	Very loose
5-10	Loose
10-20	Shlightly compact
20-35	Compact
35-70	Dense
>70	Very dense

NOTE: Classification of earth material as shown on this sheet is based upon field inspection and is not to be construed to imply mechanical analysis.

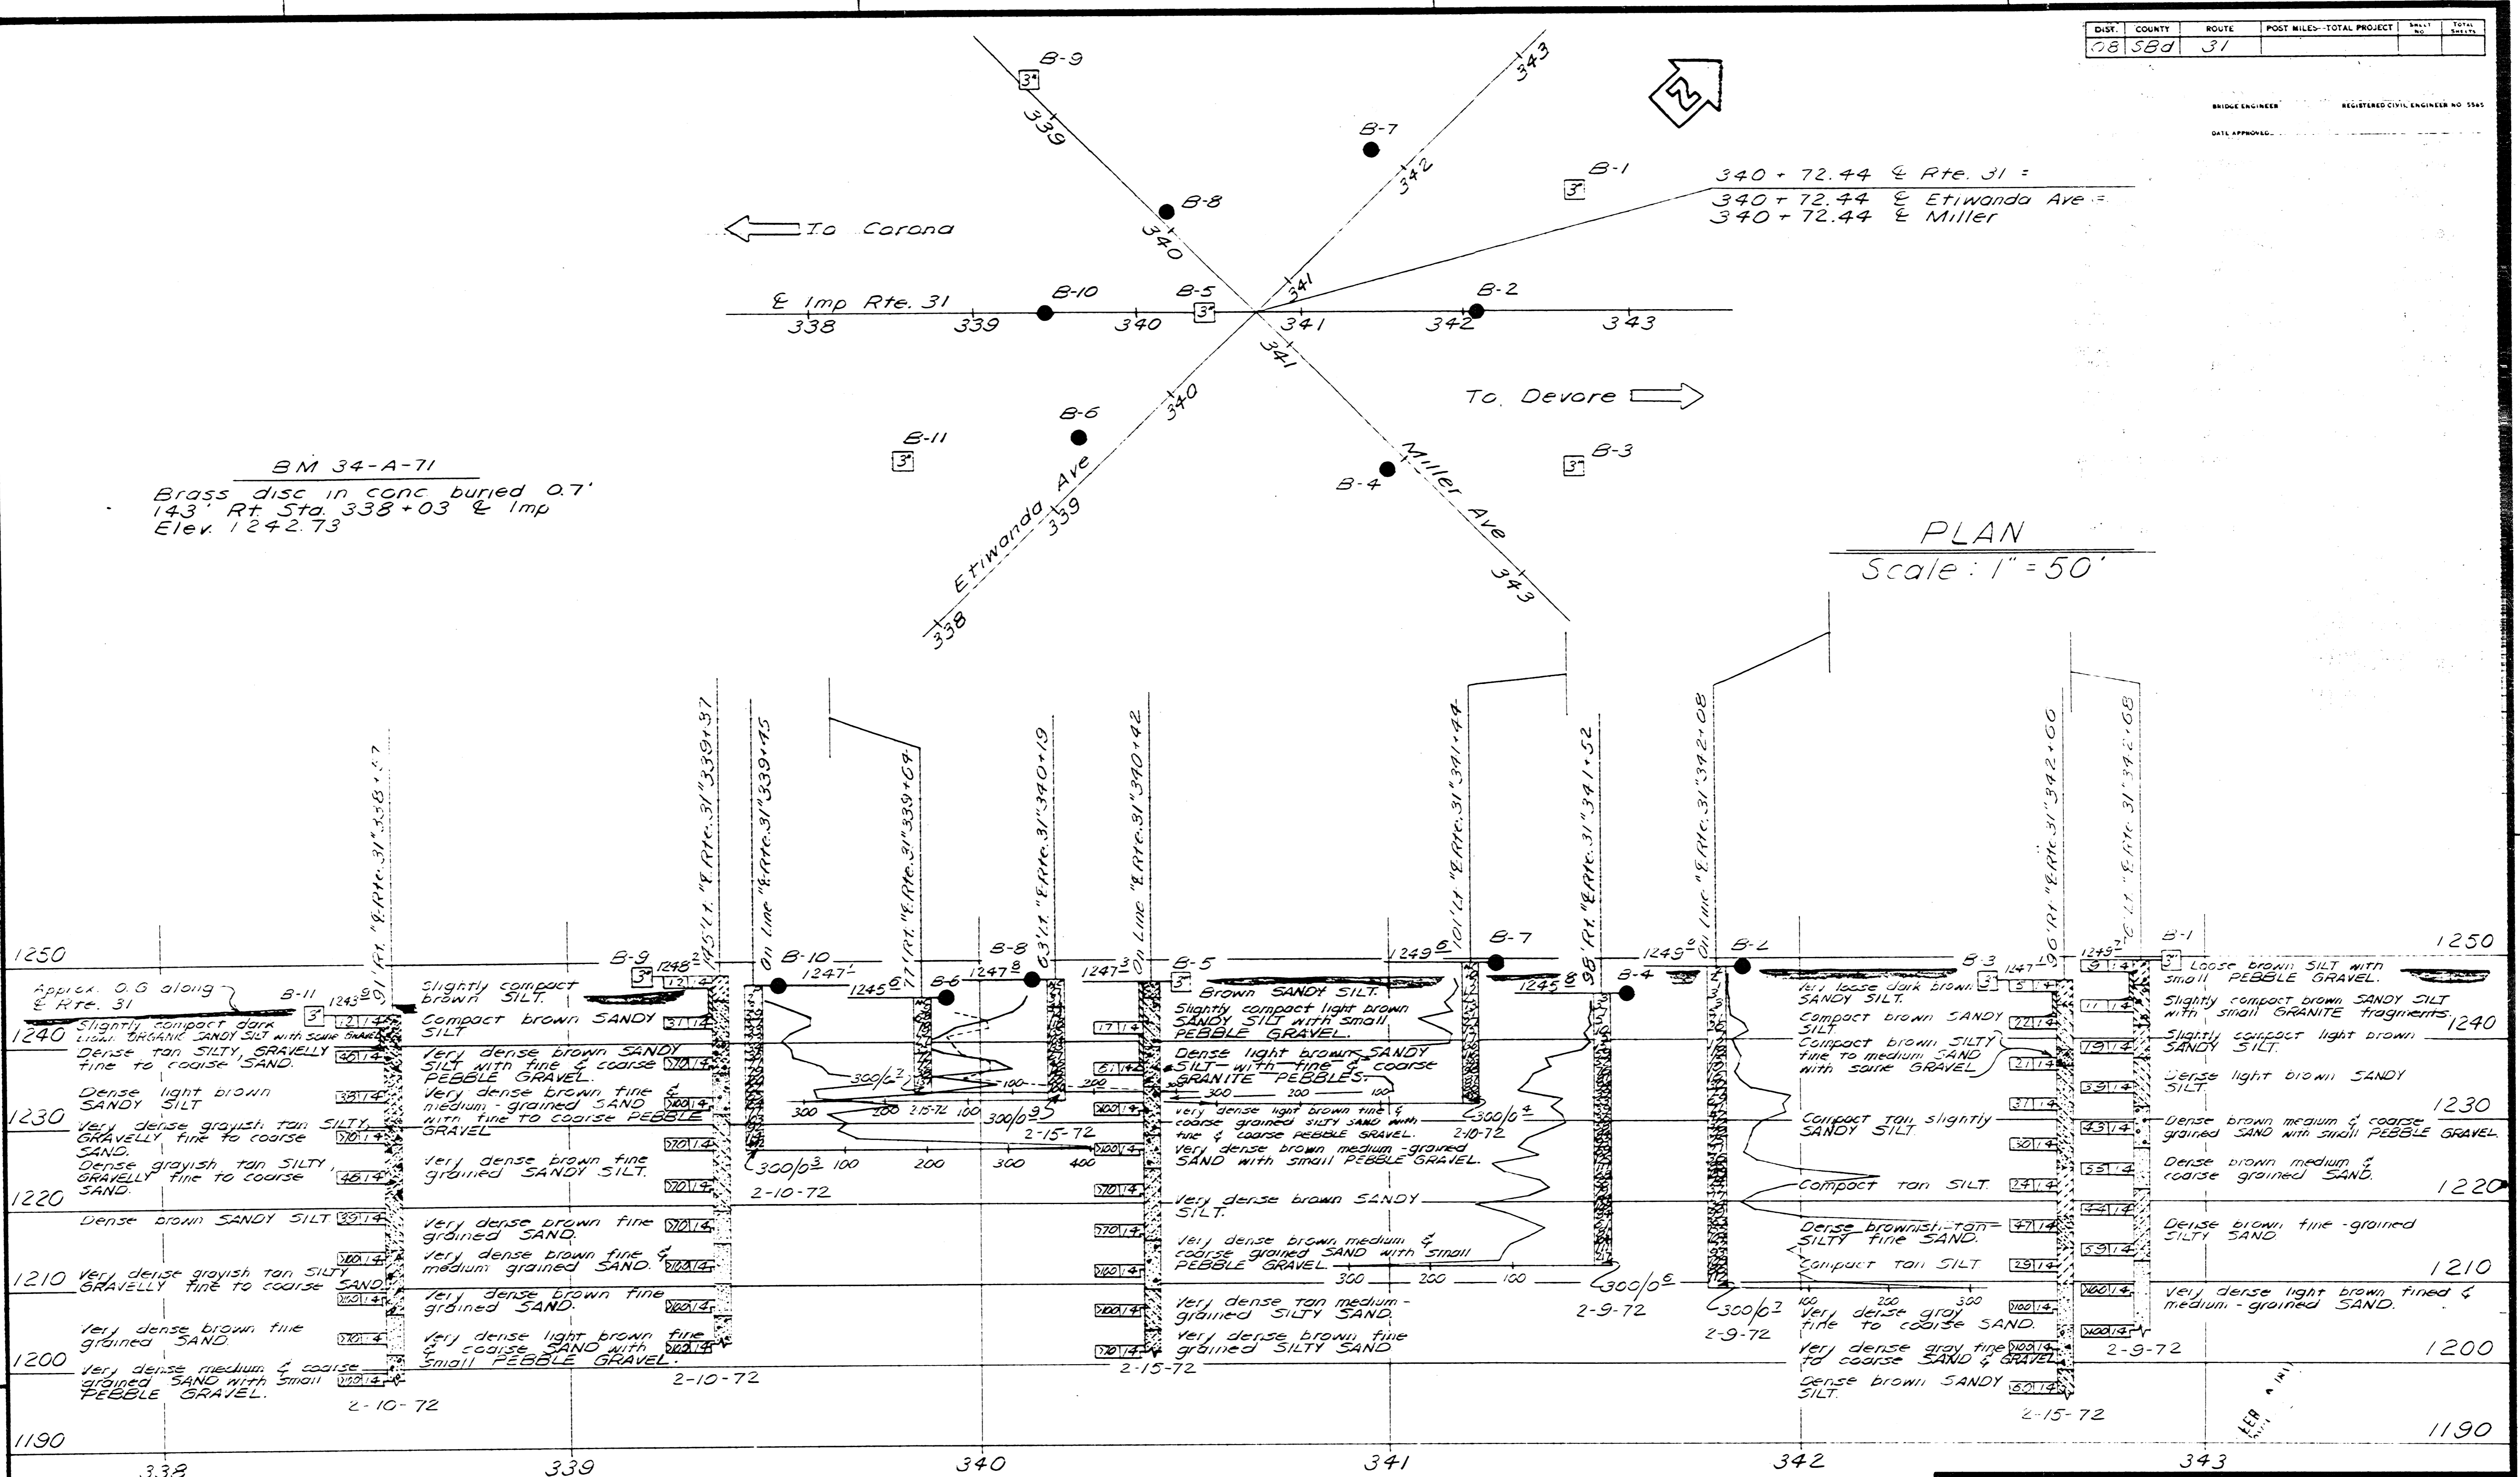

PROFILE
Scale: Horz. 1" = 20'
Vert. 1" = 10'

NO GROUND WATER ENCOUNTERED DURING THIS INVESTIGATION BY BRIDGE DEPT. GEOLOGY SECTION DATE 2-7-72

Station	Boring	Soil Description	Notes
1190	B-11	Very dense grayish tan silty gravelly fine to coarse sand	
1200	B-11	Very dense brown fine grained sand	
1210	B-11	Very dense brown fine grained sand	
1220	B-11	Dense brown sandy silt	
1230	B-11	Very dense grayish tan silty gravelly fine to coarse sand	
1240	B-11	Slightly compact dark light brown sandy silt with some small pebble gravel	
1250	B-11	Slightly compact brown silty	
1190	B-10	Very dense brown fine grained sand	
1200	B-10	Very dense brown fine grained sand	
1210	B-10	Very dense brown fine grained sand	
1220	B-10	Very dense brown fine grained sand	
1230	B-10	Very dense brown fine grained sand	
1240	B-10	Very dense brown fine grained sand	
1250	B-10	Very dense brown fine grained sand	
1190	B-9	Very dense brown fine grained sand	
1200	B-9	Very dense brown fine grained sand	
1210	B-9	Very dense brown fine grained sand	
1220	B-9	Very dense brown fine grained sand	
1230	B-9	Very dense brown fine grained sand	
1240	B-9	Very dense brown fine grained sand	
1250	B-9	Very dense brown fine grained sand	
1190	B-8	Very dense brown fine grained sand	
1200	B-8	Very dense brown fine grained sand	
1210	B-8	Very dense brown fine grained sand	
1220	B-8	Very dense brown fine grained sand	
1230	B-8	Very dense brown fine grained sand	
1240	B-8	Very dense brown fine grained sand	
1190	B-2	Very dense brown fine grained sand	
1200	B-2	Very dense brown fine grained sand	
1210	B-2	Very dense brown fine grained sand	
1220	B-2	Very dense brown fine grained sand	
1230	B-2	Very dense brown fine grained sand	
1240	B-2	Very dense brown fine grained sand	
1250	B-2	Very dense brown fine grained sand	
1190	B-1	Very dense brown fine grained sand	
1200	B-1	Very dense brown fine grained sand	
1210	B-1	Very dense brown fine grained sand	
1220	B-1	Very dense brown fine grained sand	
1230	B-1	Very dense brown fine grained sand	
1240	B-1	Very dense brown fine grained sand	
1250	B-1	Very dense brown fine grained sand	

STATE OF CALIFORNIA
TRANSPORTATION AGENCY
DEPARTMENT OF PUBLIC WORKS
DIVISION OF HIGHWAYS
MAY 25 1972

ETIWANDA AVENUE UNDERCROSSING

LOG OF TEST BORINGS

BRIDGE NO. 54-3732	POST MILE 5.0	DRAWING NO.	SHEET
REVISION DATES		(PRELIMINARY STAGE ONLY)	

Baseline Rd

DIST.	COUNTY	ROUTE	POST MILES--TOTAL PROJECT	SHEET NO.	TOTAL SHEETS
08	580	31			

BRIDGE ENGINEER _____ REGISTERED CIVIL ENGINEER NO. 15-45
 DATE APPROVED _____

FOR PLAN SEE SHEET NO. 1 OF 2

LEGEND OF BORING OPERATIONS

B-70 - Core Penetration
 B-71 - Sampler Boring (Dry)
 B-72 - Rotary Boring (Wet)
 B-73 - Auger Boring (Dry)
 B-74 - Jet Boring
 B-75 - Core Boring
 B-76 - Test Pit

LEGEND OF BORING OPERATIONS

B-77 - Soil Tube
 B-78 - Penetration Boring
 B-79 - Rotary Boring


LEGEND OF EARTH MATERIALS

SILTY CLAY or CLAYEY SILT
 ORGANIC MATTER
 FILL MATERIAL
 IGNEOUS ROCK
 SEDIMENTARY ROCK
 METAMORPHIC ROCK

CONSISTENCY CLASSIFICATION FOR SOILS

According to the Standard Penetration Test

No. of blows	Consistency
0-5	Very soft
5-10	Soft
10-20	Stiff
20-35	Very stiff
35-70	Hard
>70	Very hard

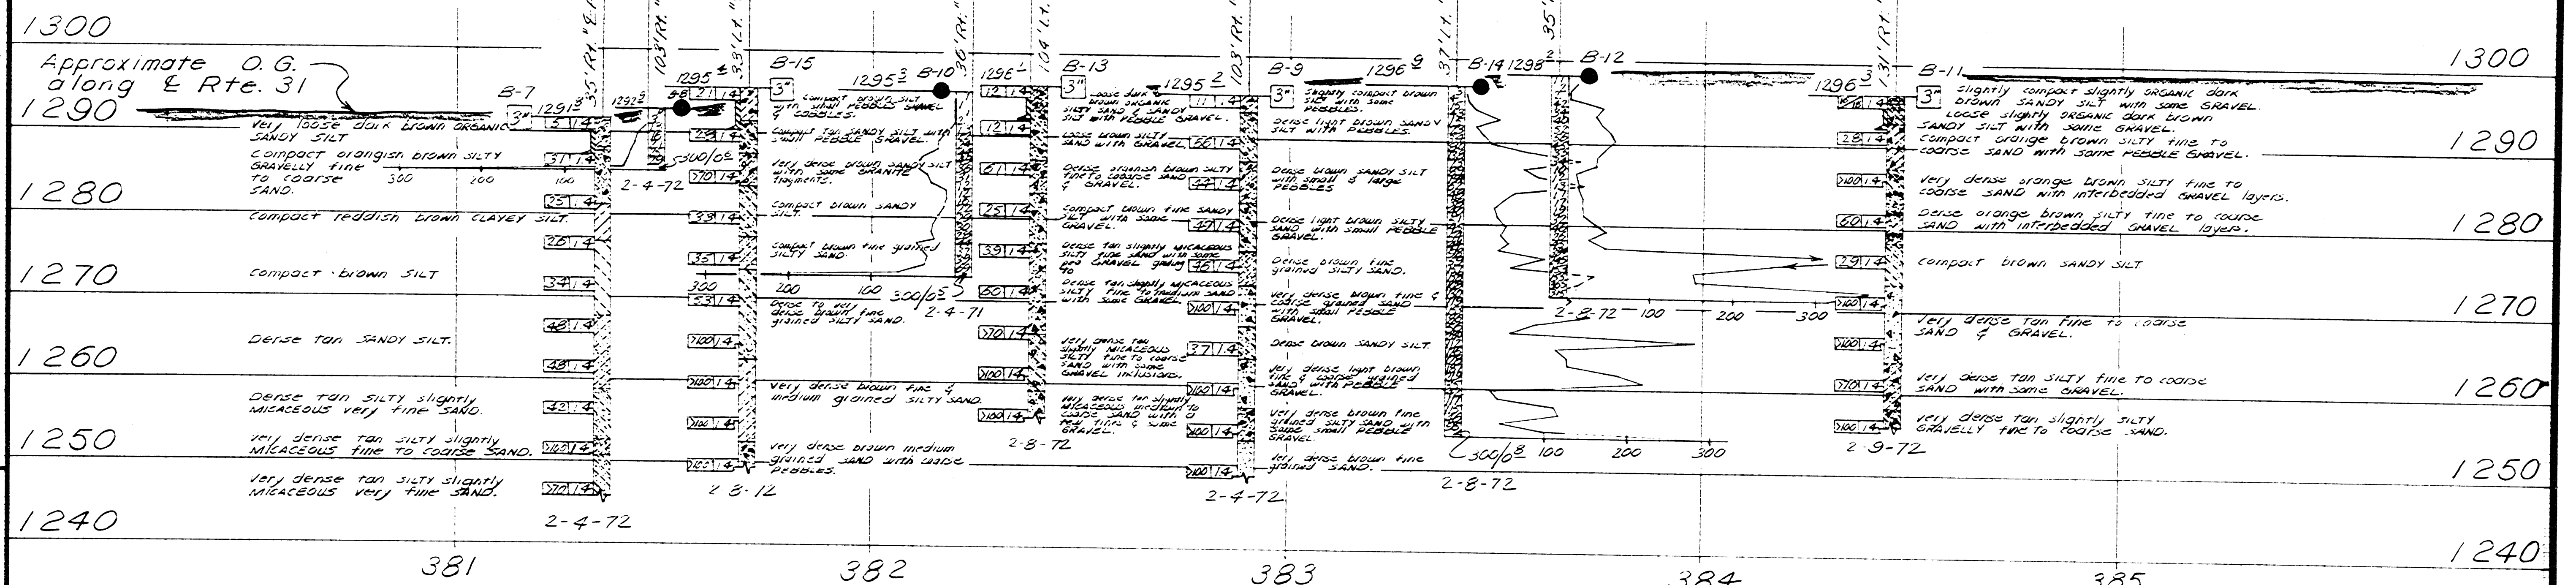

PROFILE
 Scale: Horz. 1" = 20'
 Vert. 1" = 10'

BRIDGE DEPARTMENT
 ENGINEERING GEOLOGY SECTION

FIELD STUDY by R. FOX 2-72
 DRAWN by S. Kawamura 3-17-72
 CHECKED by R. FOX 4-3-72

Approval Recommended by _____
 Certified Engineering Geologist No. _____

STATE OF CALIFORNIA
 TRANSPORTATION AGENCY
 DEPARTMENT OF PUBLIC WORKS
 DIVISION OF HIGHWAYS

BASELINE ROAD UNDERCROSSING

LOG OF TEST BORINGS (2 of 2)

BRIDGE NO. 54-974 R/L	POST MILE 6.8	DRAWING NO.	SHEET OF
REVISION DATES (PRELIMINARY STAGE ONLY)			


WO 059081
 CU 08101

Discard prints bearing earlier revision dates

DIST.	COUNTY	ROUTE	POST MILES-TOTAL PROJECT	SHEET NO.	TOTAL SHEETS
08	58d	31			


BRIDGE ENGINEER: _____ REGISTERED CIVIL ENGINEER NO. 1565
 DATE APPROVED: _____

LEGEND OF BORING OPERATIONS

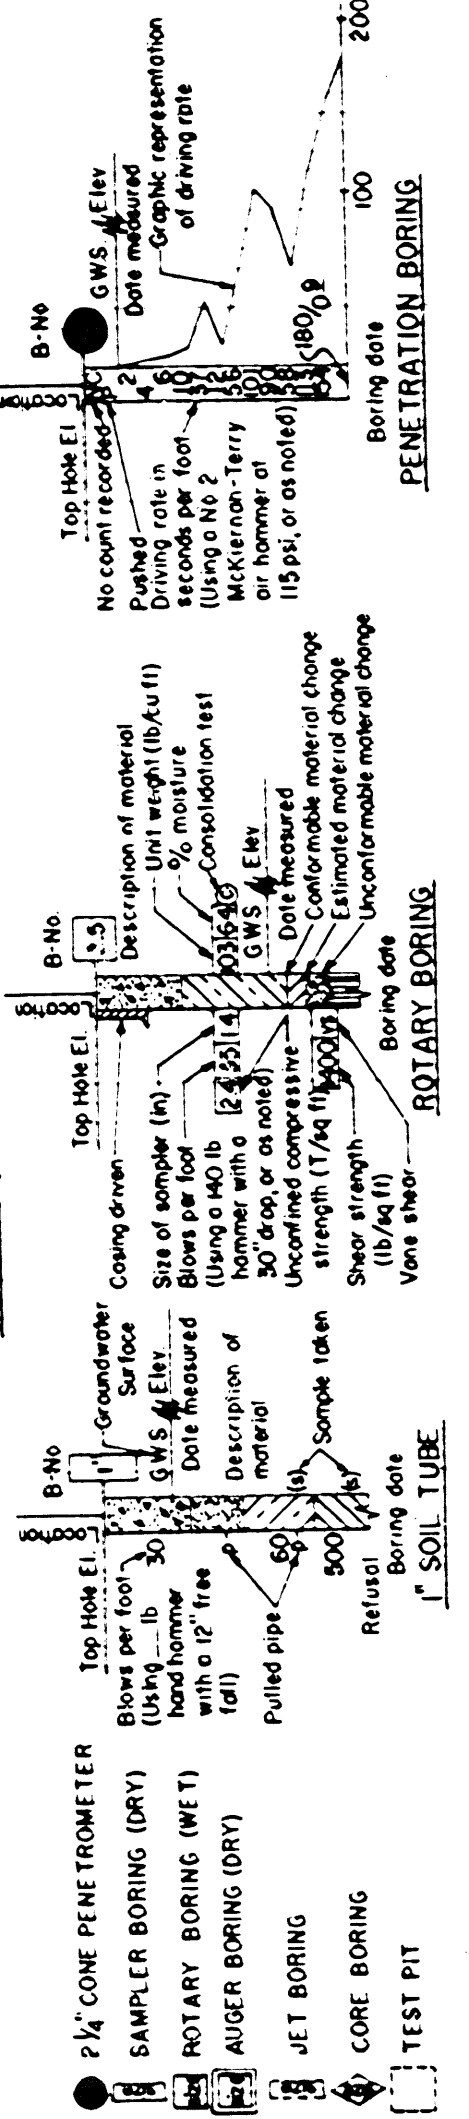


LEGEND OF EARTH MATERIALS

	SILTY CLAY or CLAYEY SILT
	ORGANIC MATTER
	FILL MATERIAL
	IGNEOUS ROCK
	SEDIMENTARY ROCK
	METAMORPHIC ROCK
	SILTY SAND
	SANDY SILT
	SILTY CLAY
	CLAYEY SILT
	SILTY SAND WITH SMALL GRANITE FRAGMENTS

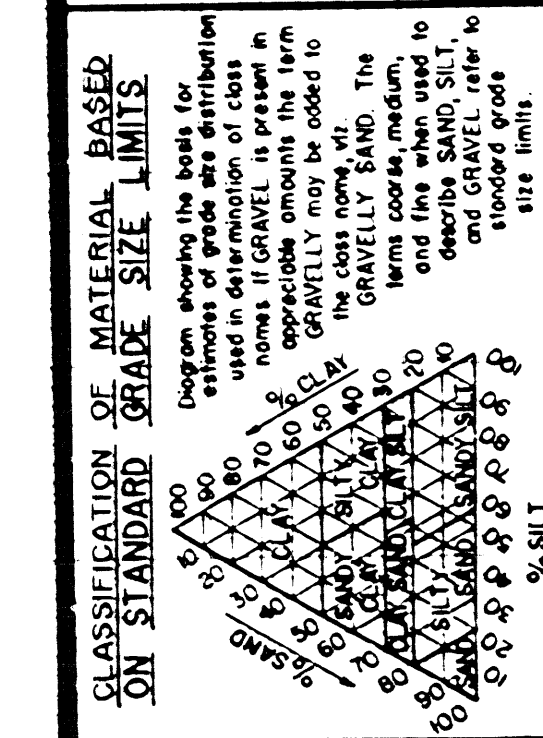

NOTE: Classification of earth material as shown on this sheet is based upon field inspection and is not to be construed to imply mechanical analysis.

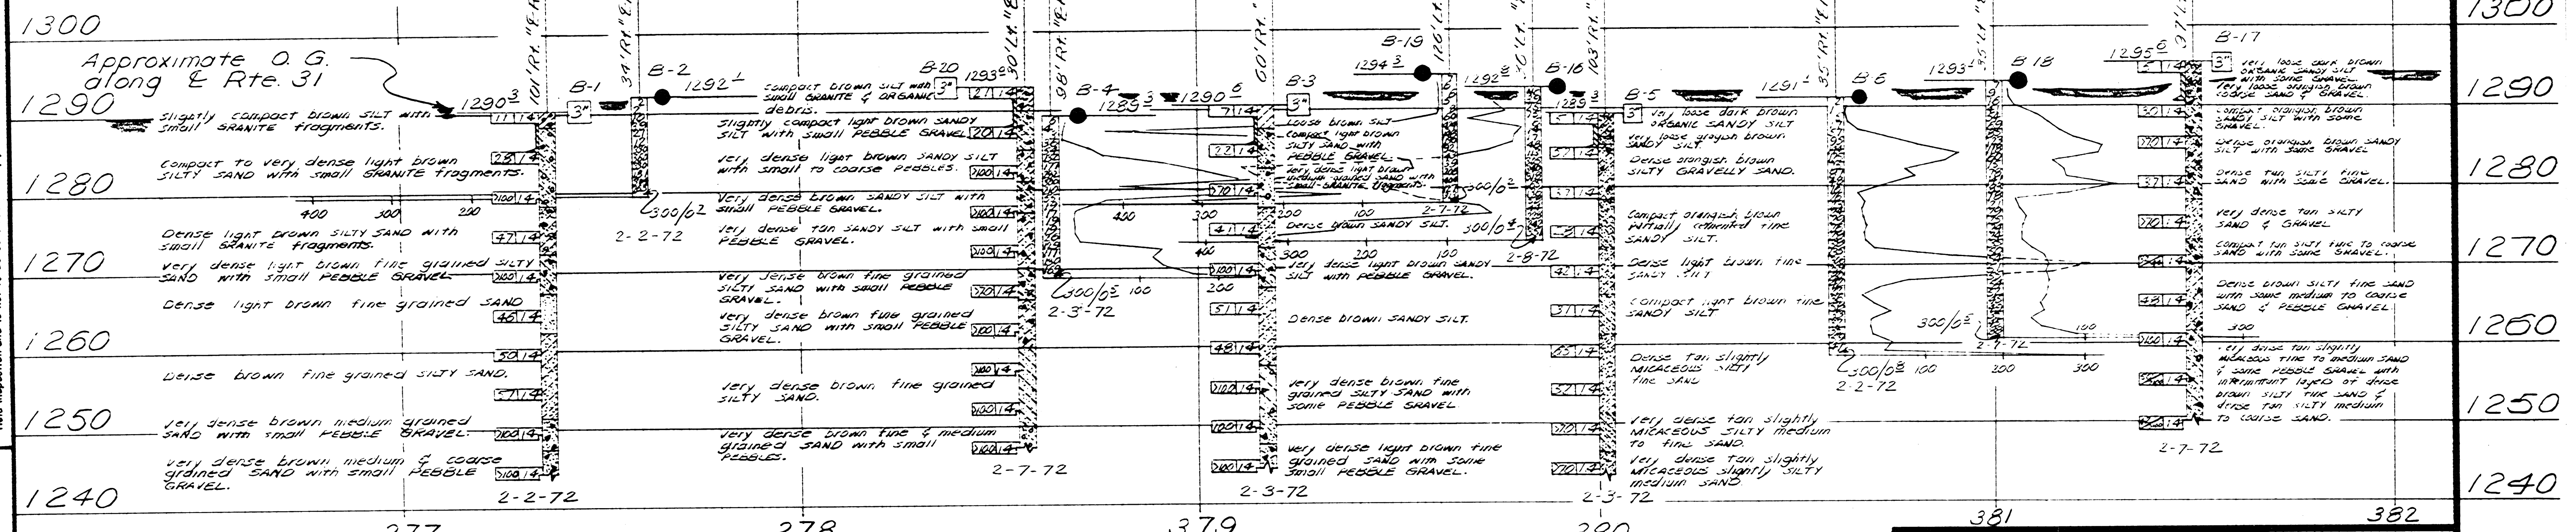

PROFILE
 Scale: Horiz. 1" = 20'
 Vert. 1" = 10'

BRIDGE DEPARTMENT
 ENGINEERING GEOLOGY SECTION

FIELD STUDY	by R. FOX	2-7-72
DRAWN	by S. KAWAMURA	3-17-72
CHECKED	by R. FOX	4-3-72

Approval Recommended by _____
 Certified Engineering Geologist No. _____

STATE OF CALIFORNIA
 TRANSPORTATION AGENCY
 DEPARTMENT OF PUBLIC WORKS
 DIVISION OF HIGHWAYS

BASELINE ROAD UNDERCROSSING

LOG OF TEST BORINGS (1 of 2)

BRIDGE NO.	54-974 R/L	POST MILE	6.8	DRAWING NO.		SHEET	1 of 2
REVISION DATES				(PRELIMINARY STAGE ONLY)			

WO 059081
 CU 08101

Discard prints bearing earlier revision dates

Etiwanda Overhead

DIST.	COUNTY	ROUTE	POST MILES—TOTAL PROJECT	SHEET NO.	TOTAL SHEETS
08	S.Bd	15	5.517.2	140	140

S. J. Jones
 DESIGN SECTION SUPERVISOR REGISTERED CIVIL ENGINEER NO. 72810
 DATE APPROVED: November 18, 1974

LEGEND OF BORING OPERATIONS

2 1/2" CONE PENETROMETER
 Top Hole El.
 No. count record
 Driving rate in blow count
 (Using a 140 lb. hammer or hammer of 112 lb. or as noted)

SAMPLER BORING (DRY)
 Description of material
 Size of sampler (in.)
 Sample depth (ft.)
 (Using a 140 lb. hammer or hammer of 112 lb. or as noted)


ROTARY BORING
 Description of material
 Size of sampler (in.)
 Sample depth (ft.)
 (Using a 140 lb. hammer or hammer of 112 lb. or as noted)

ALGER BORING (DRY)
 Description of material
 Size of sampler (in.)
 Sample depth (ft.)
 (Using a 140 lb. hammer or hammer of 112 lb. or as noted)

JET BORING
 Description of material
 Size of sampler (in.)
 Sample depth (ft.)
 (Using a 140 lb. hammer or hammer of 112 lb. or as noted)

CORE BORING
 Description of material
 Size of sampler (in.)
 Sample depth (ft.)
 (Using a 140 lb. hammer or hammer of 112 lb. or as noted)

TEST PIT

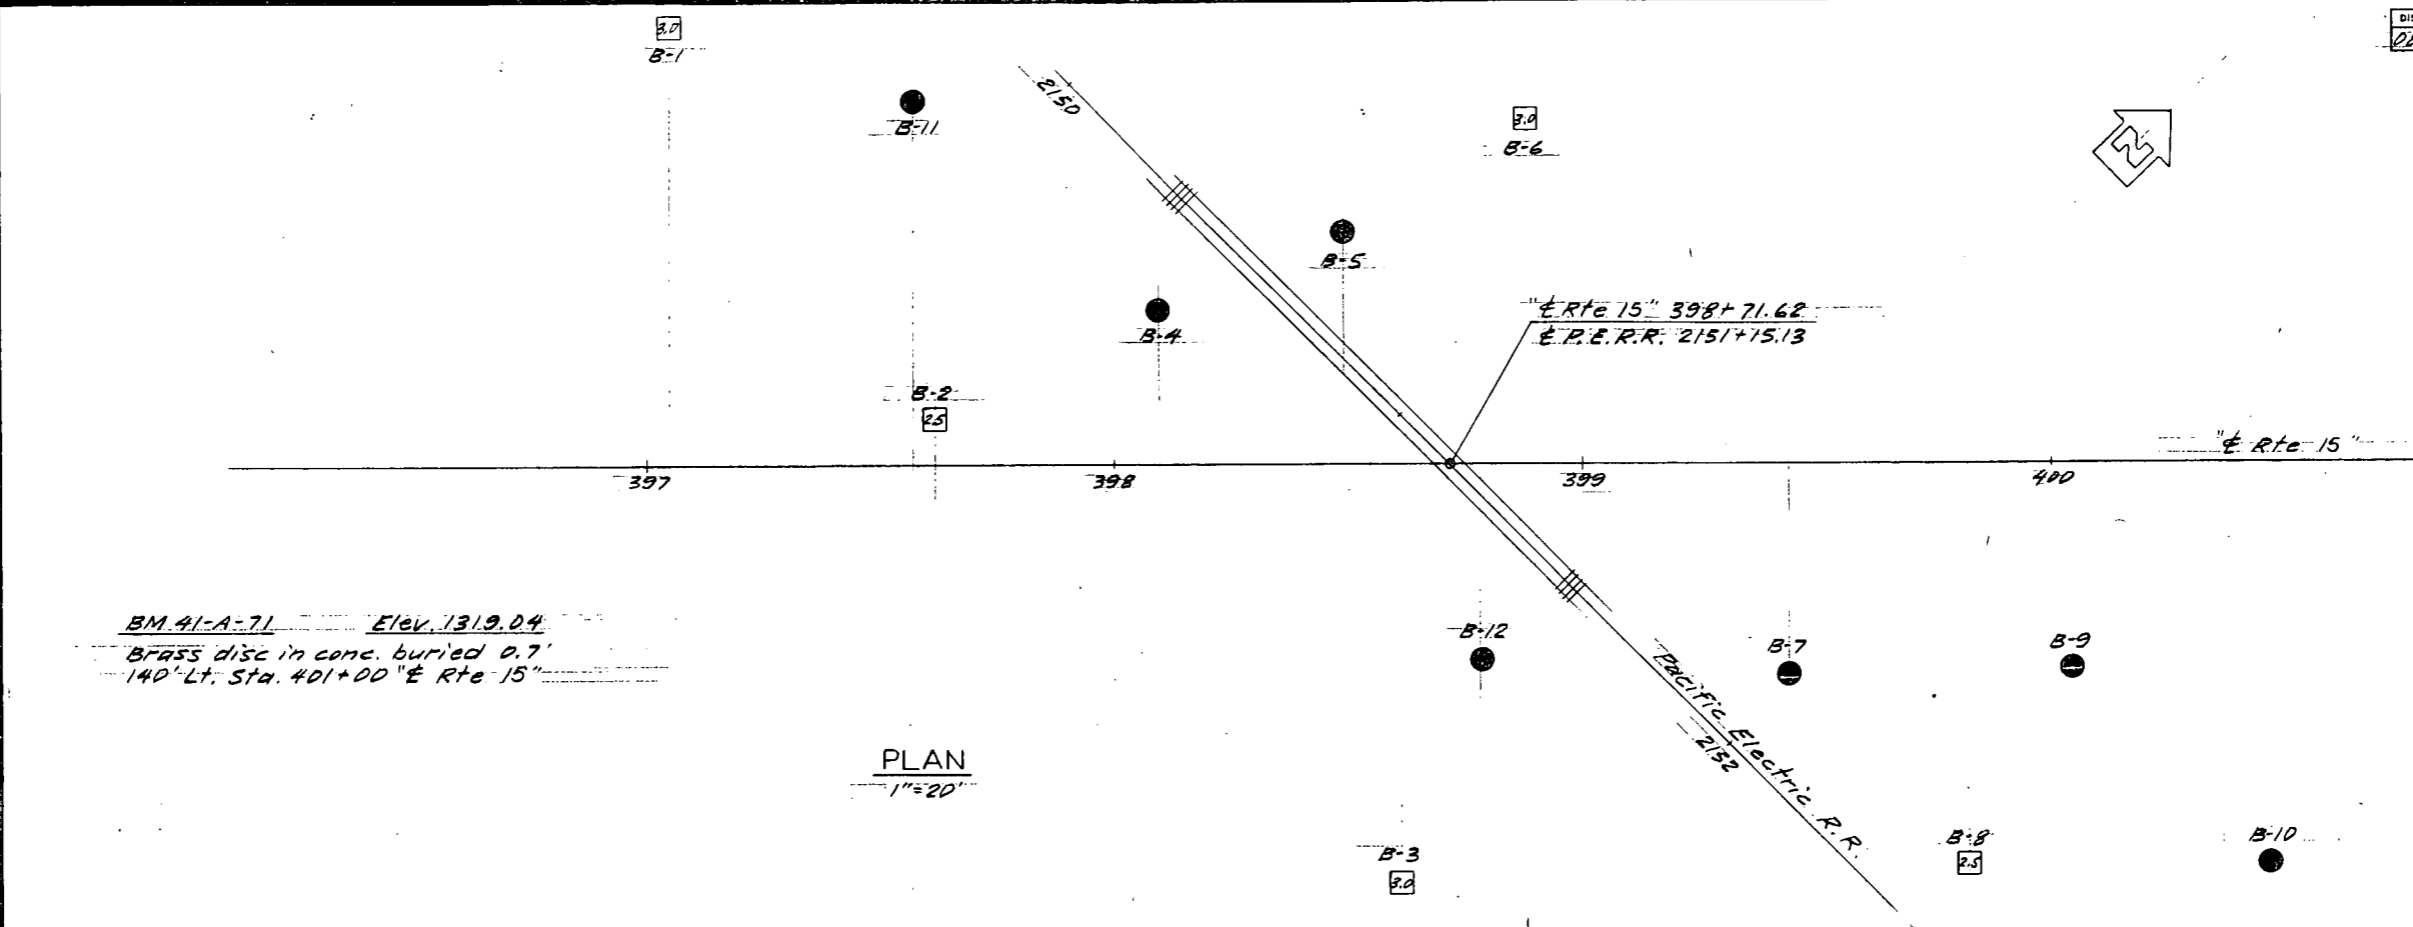

REDUCED PLAN
 USE SCALE BELOW

3 INCHES ON ORIGINAL PLAN


LEGEND OF EARTH MATERIALS

LEGEND OF SOILS

CONSISTENCY CLASSIFICATION

CLASSIFICATION OF MATERIAL BASED ON STANDARD GRADE SIZE LIMITS

Diagram showing the limits for classification of soils based on standard grade size limits. The diagram plots percentage of sand, silt, and clay against soil classification categories.

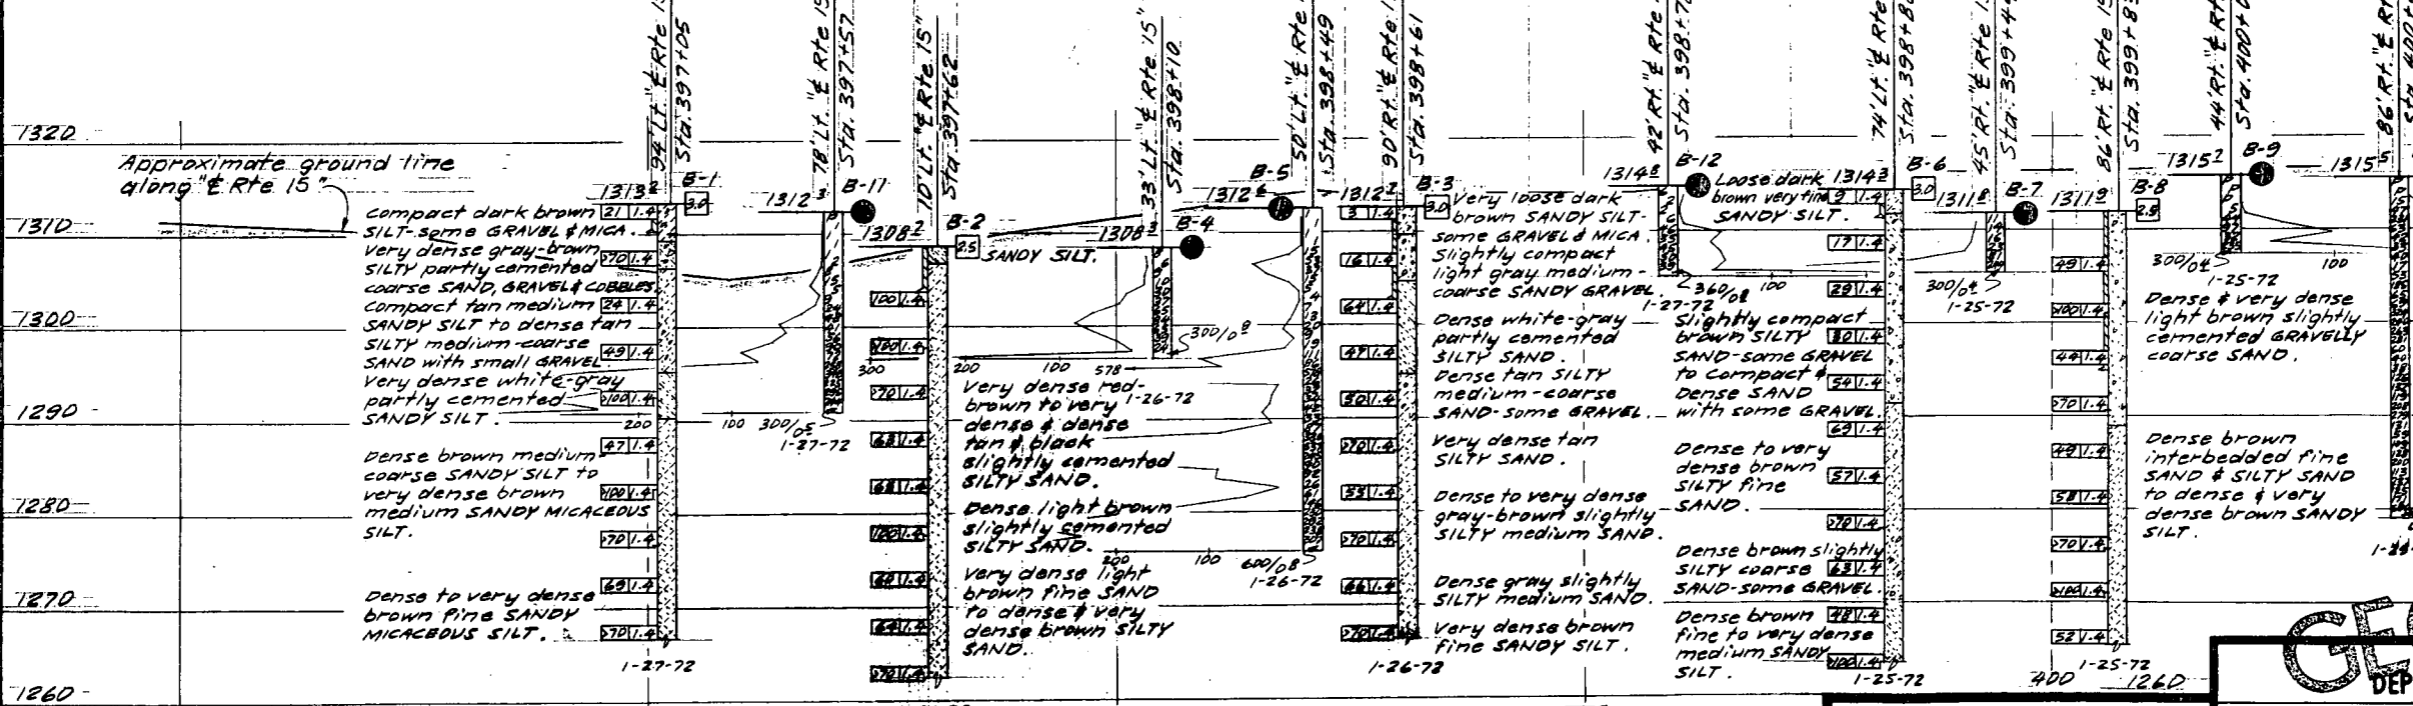

PROFILE
 Vert. 1"=10'
 Horiz. 1"=20'

NO GROUND WATER ENCOUNTERED DURING THIS INVESTIGATION BY BRIDGE DEPT. GEOLOGY SECTION DATE 1/17/72

BRIDGE DEPARTMENT
 ENGINEERING GEOLOGY SECTION
 FIELD STUDY by R. Fox 1/72
 DRAWN by K. Erdow 2/14/72
 CHECKED by D. G. Schmitt 2-72
 Approval Recommended by *[Signature]*
 Certified Engineering Geologist No. 260

GEOLOGY
 STATE OF CALIFORNIA
 DEPARTMENT OF TRANSPORTATION

ETIWANDA OVERHEAD

LOG OF TEST BORINGS

BRIDGE NO. 5A-923 R/L	POST MILE 7.1	DRAWING NO.	SHEET 14	OF 14
-----------------------	---------------	-------------	----------	-------

WO 771901
 CU - 88201

Disregard prints bearing earlier revision dates




REVISION DATES	(PRELIMINARY STAGE ONLY)

Victoria Street Undercrossing

DIST.	COUNTY	ROUTE	POST MILES-TOTAL PROJECT	SHEET NO.	TOTAL SHEETS
08	SBD	31			

BRIDGE ENGINEER: _____ REGISTERED CIVIL ENGINEER NO. 5554
 DATE APPROVED: _____

LEGEND OF BORING OPERATIONS

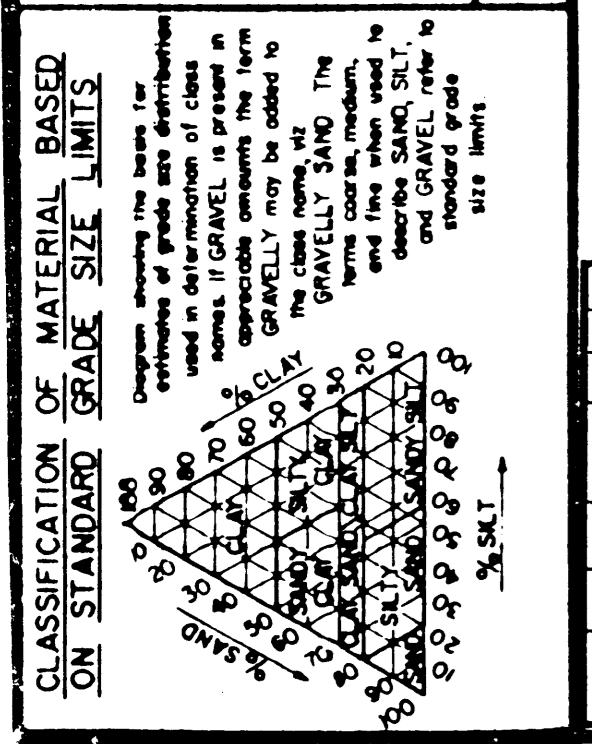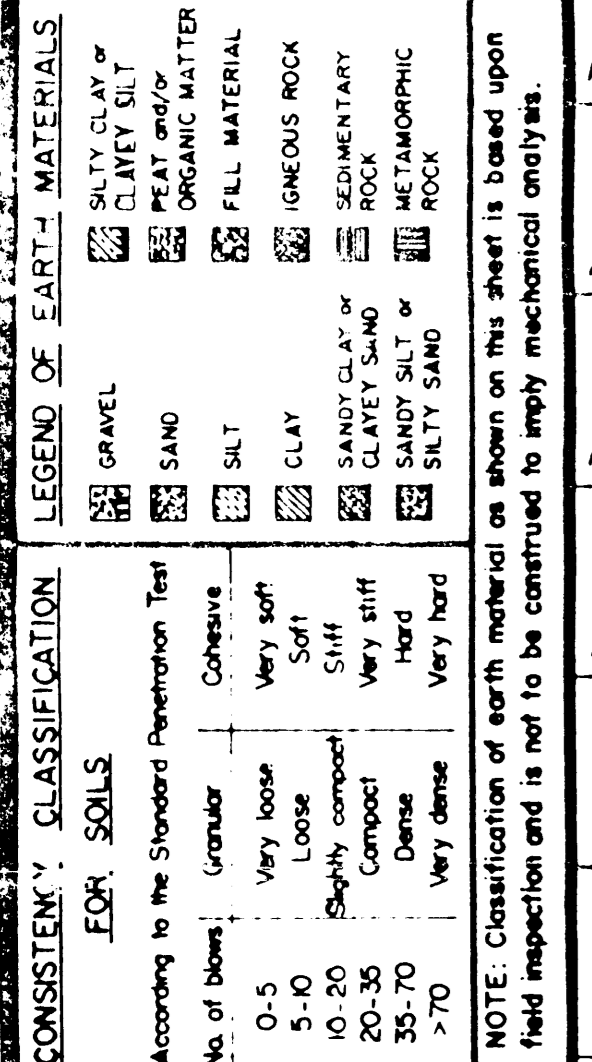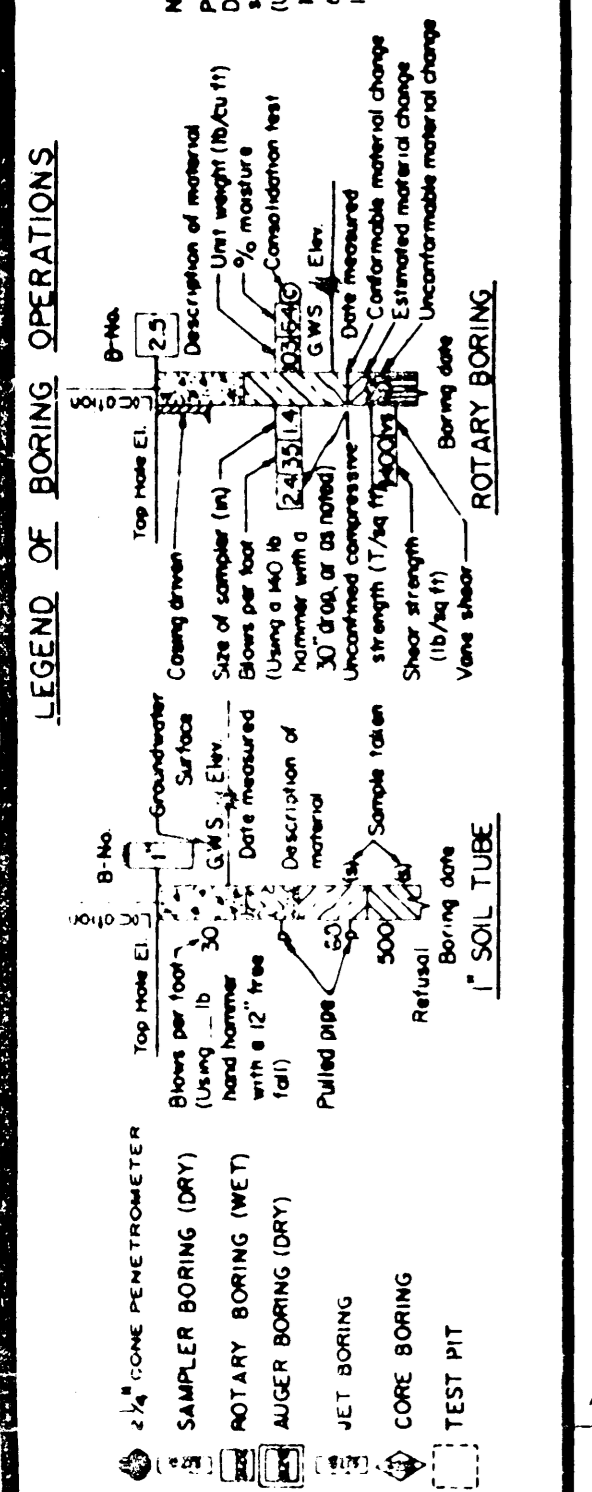


CONSISTENCY CLASSIFICATION FOR SOILS


According to the Standard Penetration Test

No. of blows	Consistency
0-5	Very loose
5-10	Loose
10-20	Slightly compact
20-30	Compact
30-70	Dense
>70	Very dense

BENCH MARK
 BM 42-A-71 Brass disc in concrete buried 0.6' 197' Lt & Imp Rte 31 Sta 416+15 Elev=1327.70

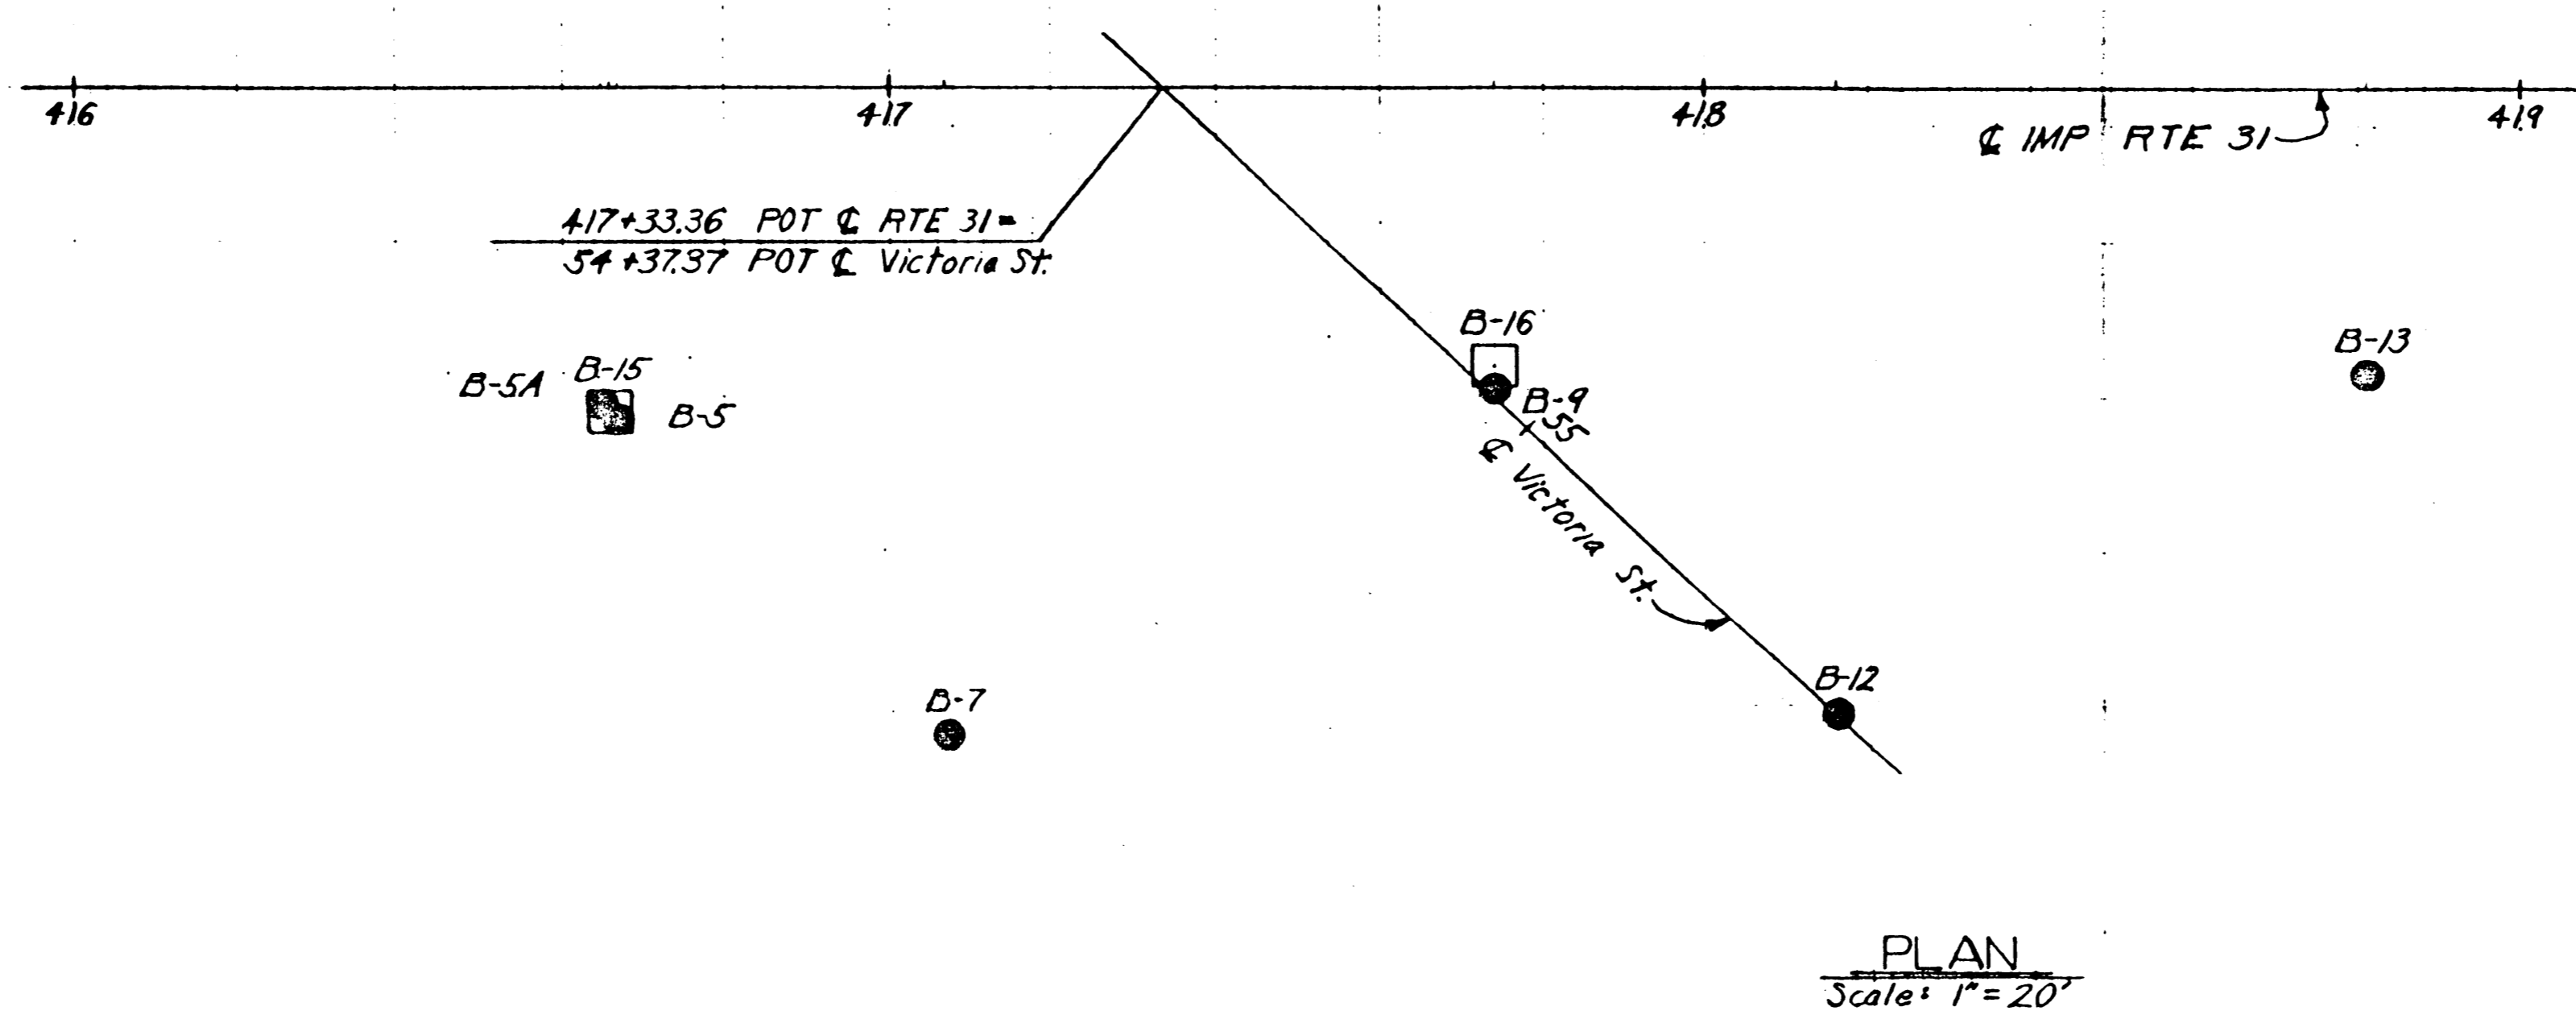


PLAN
 Scale: 1"=20'

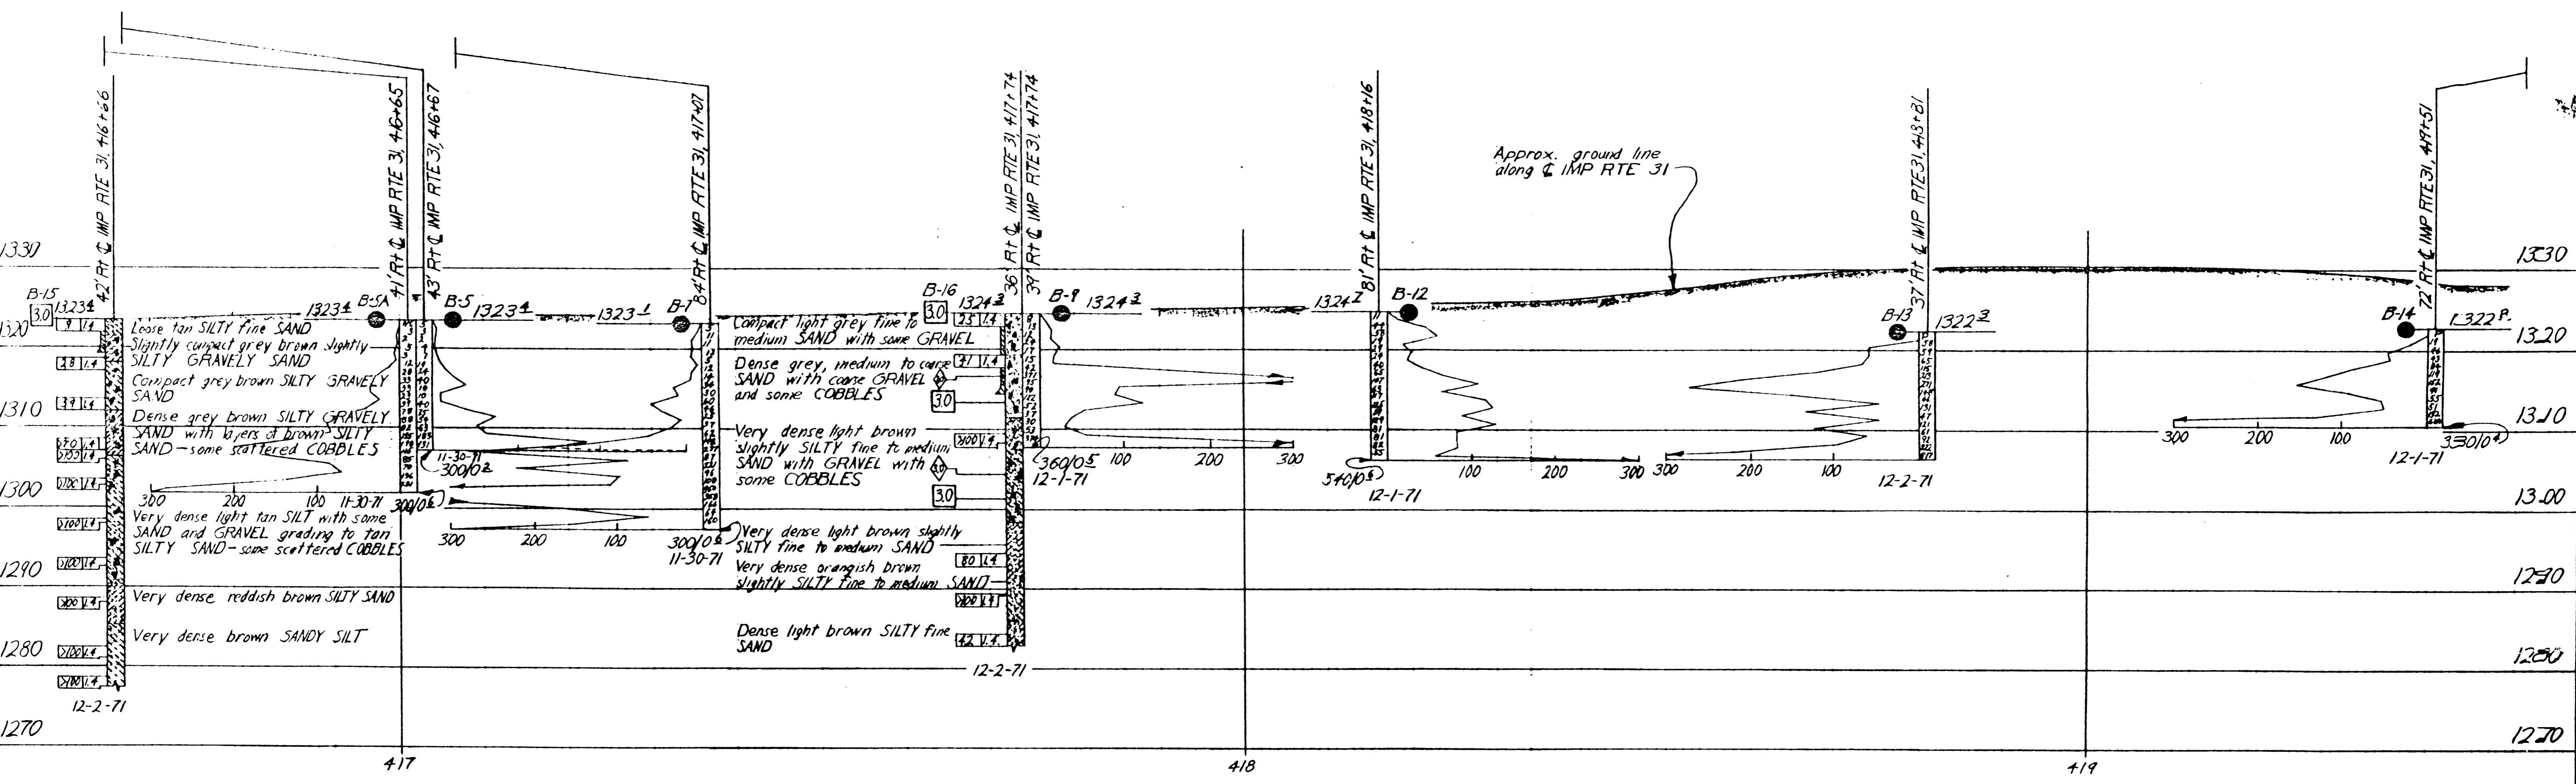

PROFILE
 Scale: 1"=10'

NO GROUND WATER ENCOUNTERED DURING THIS INVESTIGATION BY PROFILE AND GEOLOGY SECTION DATE 12-6-71

DIST.	COUNTY	ROUTE	POST MILES - TOTAL PROJECT	Sheet No.	Total Sheets
08	SBD	015			
ENGINEERING GEOLOGY BRANCH - TRANSPORTATION MATERIALS & RESEARCH					
W. C. Cain					
CERTIFIED ENGINEERING GEOLOGIST - PROJECT GEOLOGIST					
VICTORIA STREET UNDERCROSSING					
LOG OF TEST BORINGS 1 OF 2					
NOTE: THIS LOG OF TEST BORINGS IS AVAILABLE ON MICROFILM AT OFFICE OF STRUCTURES DESIGN SACRAMENTO CALIFORNIA.					
CU: 08E03	BRIDGE No.				
EA: 204301	54-0965R				

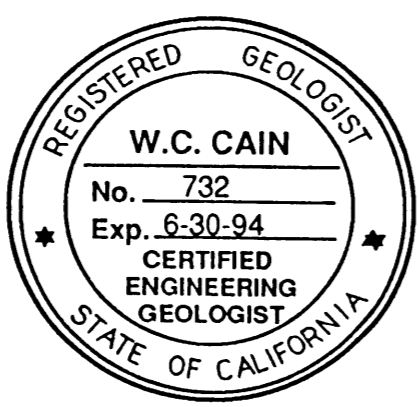

BRIDGE DEPARTMENT	
ENGINEERING GEOLOGY SECTION	
FIELD STUDY	by W. T. NELSON 12-71
DRAWN	by D. G. SCHOTT 12-30-71
CHECKED	by W. T. NELSON 1-71
Approval Recommended by _____ Engineering Geologist	
Certified Engineering Geologist No. _____	

STATE OF CALIFORNIA TRANSPORTATION AGENCY DEPARTMENT OF PUBLIC WORKS DIVISION OF HIGHWAYS			
VICTORIA STREET UNDERCROSSING			
LOG OF TEST BORINGS			
BRIDGE NO.	POST MILE	DRAWING NO.	SHEET
54-965 R/L	7.5		12
REVISION DATES (PRELIMINARY STAGE ONLY)			

WO 139200 132900
 CU 08201

Discard prints bearing earlier revision dates

East Etiwanda Creek

DIST.	COUNTY	ROUTE	POST MILES - TOTAL PROJECT	SHEET	NO.
08	SBD	015		2	2

LEGEND OF BORING OPERATIONS

2 1/2" CONE PENETROMETER
 No. 501
 Blows per foot
 (Using a No. 2
 30' cone, or as noted)
 115 psi. or as noted

SAMPLER BORING (DRY)
 No. 502
 Description of material
 Unit weight (lb/cu ft)
 % moisture
 Consolidation test
 Etc.

ROTARY BORING
 No. 503
 Description of material
 Unit weight (lb/cu ft)
 % moisture
 Consolidation test
 Etc.

JET BORING
 No. 504
 Description of material
 Unit weight (lb/cu ft)
 % moisture
 Consolidation test
 Etc.

TEST PIT
 No. 505
 Description of material
 Unit weight (lb/cu ft)
 % moisture
 Consolidation test
 Etc.



SOIL TUBE
 No. 506
 Description of material
 Unit weight (lb/cu ft)
 % moisture
 Consolidation test
 Etc.

LEGEND OF EARTH MATERIALS
 SILTY CLAY or CLAYEY SILT
 PEAT and/or ORGANIC MATTER
 FILL MATERIAL
 IGNEOUS ROCK
 SEDIMENTARY ROCK
 CLAYEY SAND or SILTY SAND
 SAND
 SILT
 CLAY
 SANDY CLAY or CLAYEY SAND
 SILTY SAND
 GRAVEL
 COBBLES

CONSISTENCY CLASSIFICATION FOR SOILS
 According to the Standard Penetration Test
 No. of blows
 0-5
 5-10
 10-20
 20-35
 35-70
 >70

CLASSIFICATION OF MATERIAL BASED ON STANDARD GRADE SIZE LIMITS
 Dashed showing the limits for determining of class in gravelly materials. The term GRAVELLY may be added to terms coarse, medium, and fine when used to describe materials which do not meet the standard grade size limits.


BENCH MARK
 B.M. 42-A-71. Brass disc in concrete buried 06' 197' Lt. of Imp. Rte. 31
 Sta 416 +15 Elev. = 1327.70

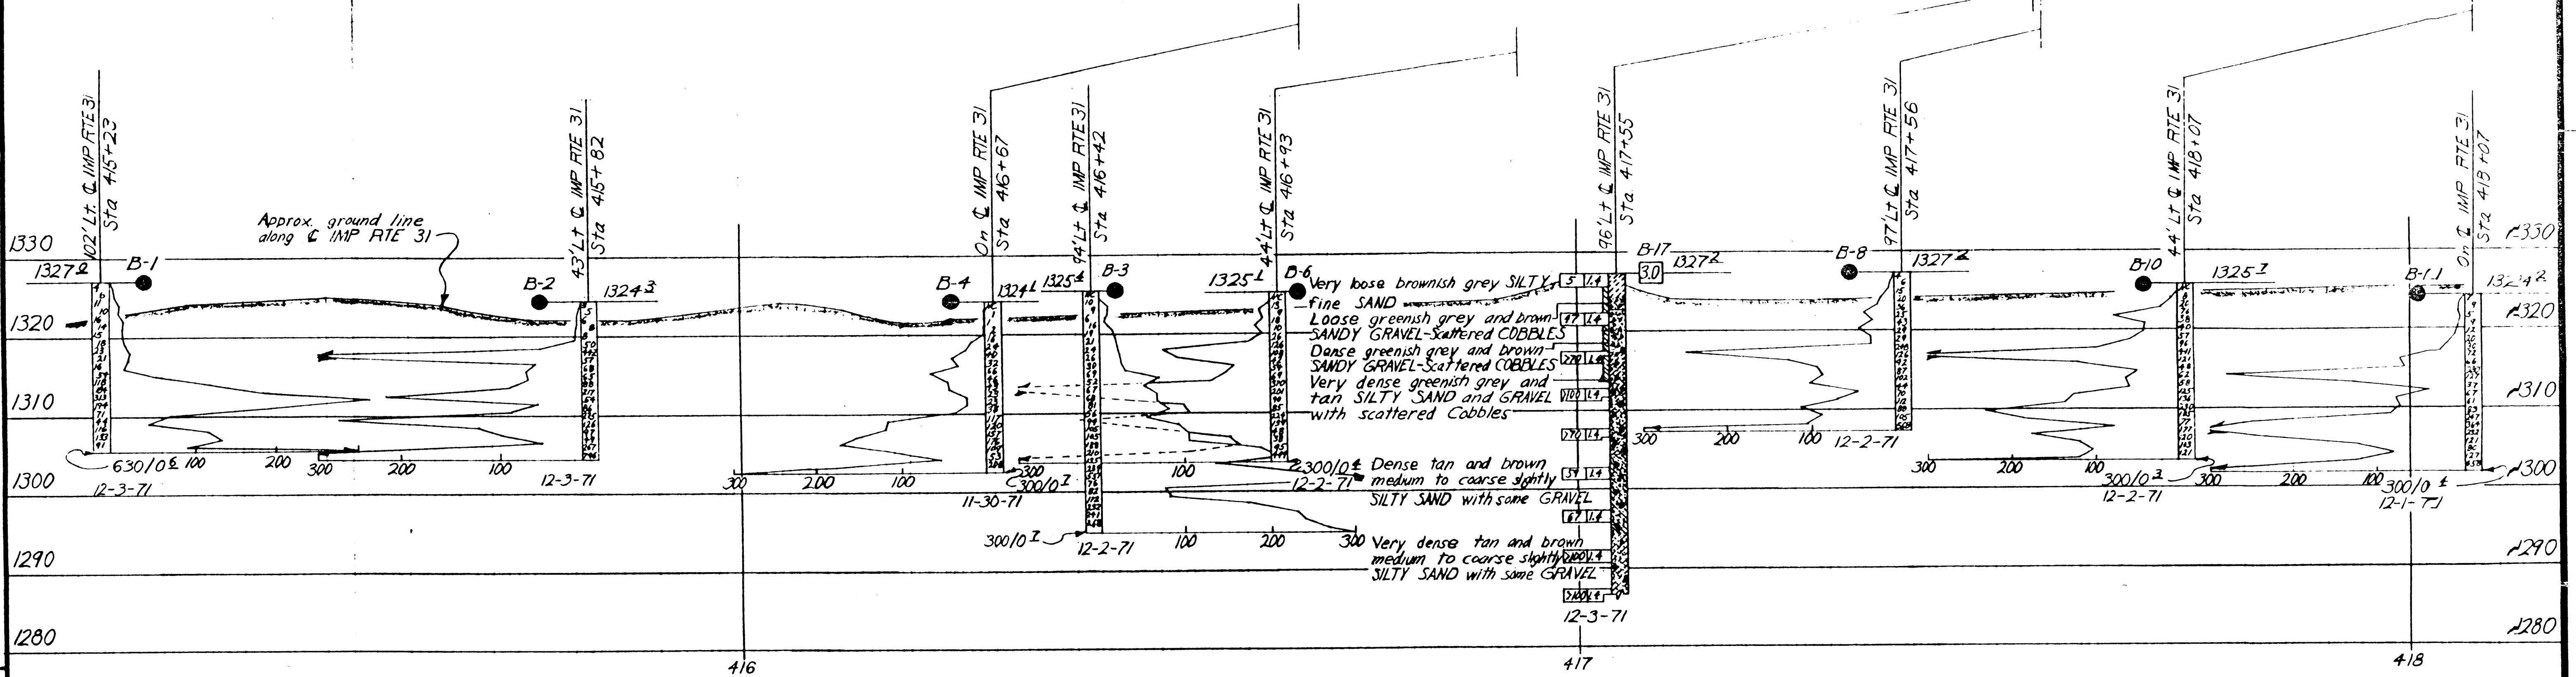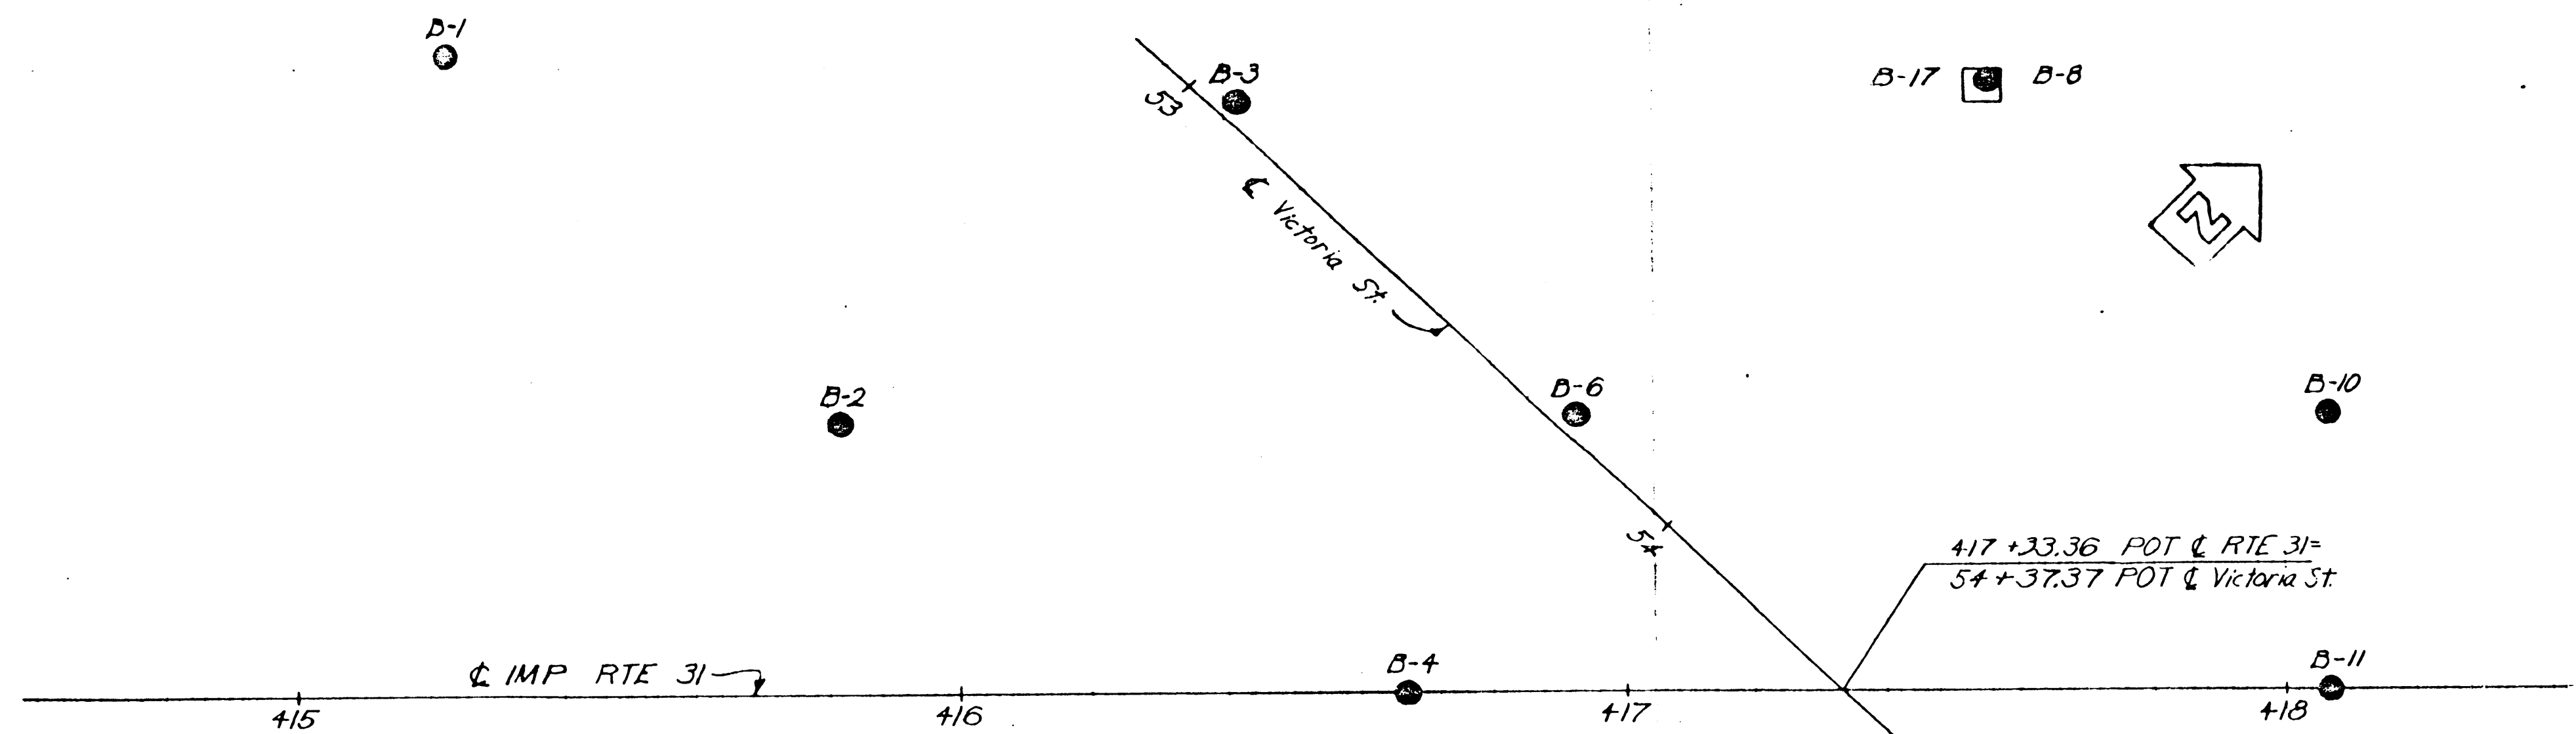

CLASSIFICATION OF MATERIAL BASED ON STANDARD GRADE SIZE LIMITS

Dashed showing the limits for determining of class in gravelly materials. The term GRAVELLY may be added to terms coarse, medium, and fine when used to describe materials which do not meet the standard grade size limits.

DIST.	COUNTY	ROUTE	POST MILES - TOTAL PROJECT	Sheet No.	Total Sheets
08	SBD	015			
ENGINEERING GEOLOGY BRANCH - TRANSPORTATION MATERIALS & RESEARCH					
VICTORIA STREET UNDERCROSSING					
LOG OF TEST BORINGS 2 OF 2					
NOTE: THIS LOG OF TEST BORINGS IS AVAILABLE ON MICROFILM AT OFFICE OF STRUCTURES DESIGN SACRAMENTO CALIFORNIA.				CU: 08203 EA: 204301	BRIDGE No. 54-0965R

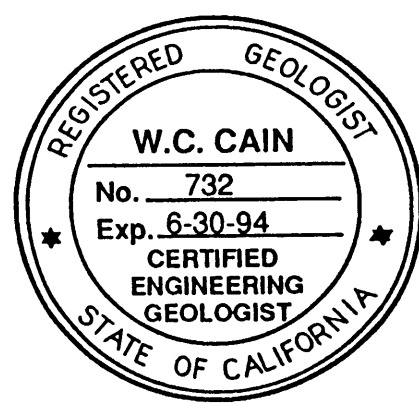

NO GRADING MATERIALS PERMITTED
 FOR THIS PROJECT EXCEPT BY
 ENGINEERING GEOLOGY SECTION
 DATE 12-6-71

BRIDGE DEPARTMENT
 ENGINEERING GEOLOGY SECTION

FIELD STUDY by W. T. NELSON 12-71
 DRAWN by D. G. SCHOTT 12-28-71
 CHECKED by W. T. NELSON 1-72

Approval Recommended by _____
 Engineering Geologist
 Certified Engineering Geologist No. _____

STATE OF CALIFORNIA
 TRANSPORTATION AGENCY
 DEPARTMENT OF PUBLIC WORKS
 DIVISION OF HIGHWAYS

VICTORIA STREET UNDERCROSSING

LOG OF TEST BORINGS

BRIDGE NO. 54-965 R/L POST MILE 7.5 DRAWING NO. 2 SHEET 2

REVISION DATES (PRELIMINARY STAGE ONLY)

DIST.	COUNTY	ROUTE	POST MILES-TOTAL PROJECT	SHEET NO.	TOTAL SHEETS
OR	Sbd	31			

BRIDGE ENGINEER _____ REGISTERED CIVIL ENGINEER NO. 5545
 DATE APPROVED _____

LEGEND OF BORING OPERATIONS

SOIL TUBE
 B No. _____
 Top Hole El. _____
 Blot per foot _____
 in 12' dia _____
 Refusal _____
 Boring date _____

ROTARY BORING
 B No. _____
 Top Hole El. _____
 Casing diameter _____
 Description of material _____
 Blow per foot _____
 Blow per 10 ft _____
 Date finished _____
 G.W. El. _____
 Date finished _____
 Confined compressive strength _____
 Unconfined compressive strength _____
 Vane shear strength _____
 Vane shear _____

CONE PENETROMETER
 B No. _____
 Top Hole El. _____
 Blot per foot _____
 in 12' dia _____
 Refusal _____
 Boring date _____

2 1/2" CONE PENETROMETER
 B No. _____
 Top Hole El. _____
 Blot per foot _____
 in 12' dia _____
 Refusal _____
 Boring date _____

SAAMPLER BORING (DRY)
 B No. _____
 Top Hole El. _____
 Blot per foot _____
 in 12' dia _____
 Refusal _____
 Boring date _____

ROTARY BORING (WET)
 B No. _____
 Top Hole El. _____
 Blot per foot _____
 in 12' dia _____
 Refusal _____
 Boring date _____

AUGER BORING (DRY)
 B No. _____
 Top Hole El. _____
 Blot per foot _____
 in 12' dia _____
 Refusal _____
 Boring date _____

JET BORING
 B No. _____
 Top Hole El. _____
 Blot per foot _____
 in 12' dia _____
 Refusal _____
 Boring date _____

CORE BORING
 B No. _____
 Top Hole El. _____
 Blot per foot _____
 in 12' dia _____
 Refusal _____
 Boring date _____

TEST PIT
 B No. _____
 Top Hole El. _____
 Blot per foot _____
 in 12' dia _____
 Refusal _____
 Boring date _____

LEGEND OF EARTH MATERIALS

GRAVEL
 SAND
 SILT
 CLAY
 SILTY CLAY or CLAYEY SILT
 PEAT and/or ORGANIC MATTER
 FILL MATERIAL
 IGNEOUS ROCK
 SEDIMENTARY ROCK
 METAMORPHIC ROCK




CONSISTENCY CLASSIFICATION FOR SOILS

No. of blows	Consistency
0-5	Very soft
5-10	Soft
10-20	Stiff
20-35	Very stiff
35-70	Hard
>70	Very hard

NOTE: Classification of earth material as shown on this sheet is based upon field inspection and is not to be construed to imply mechanical analysis.

CLASSIFICATION OF MATERIAL BASED ON STANDARD GRADE SIZE LIMITS

Diagram showing the basis for classification of soil materials based on the percentage of material passing through standard sieve sizes.

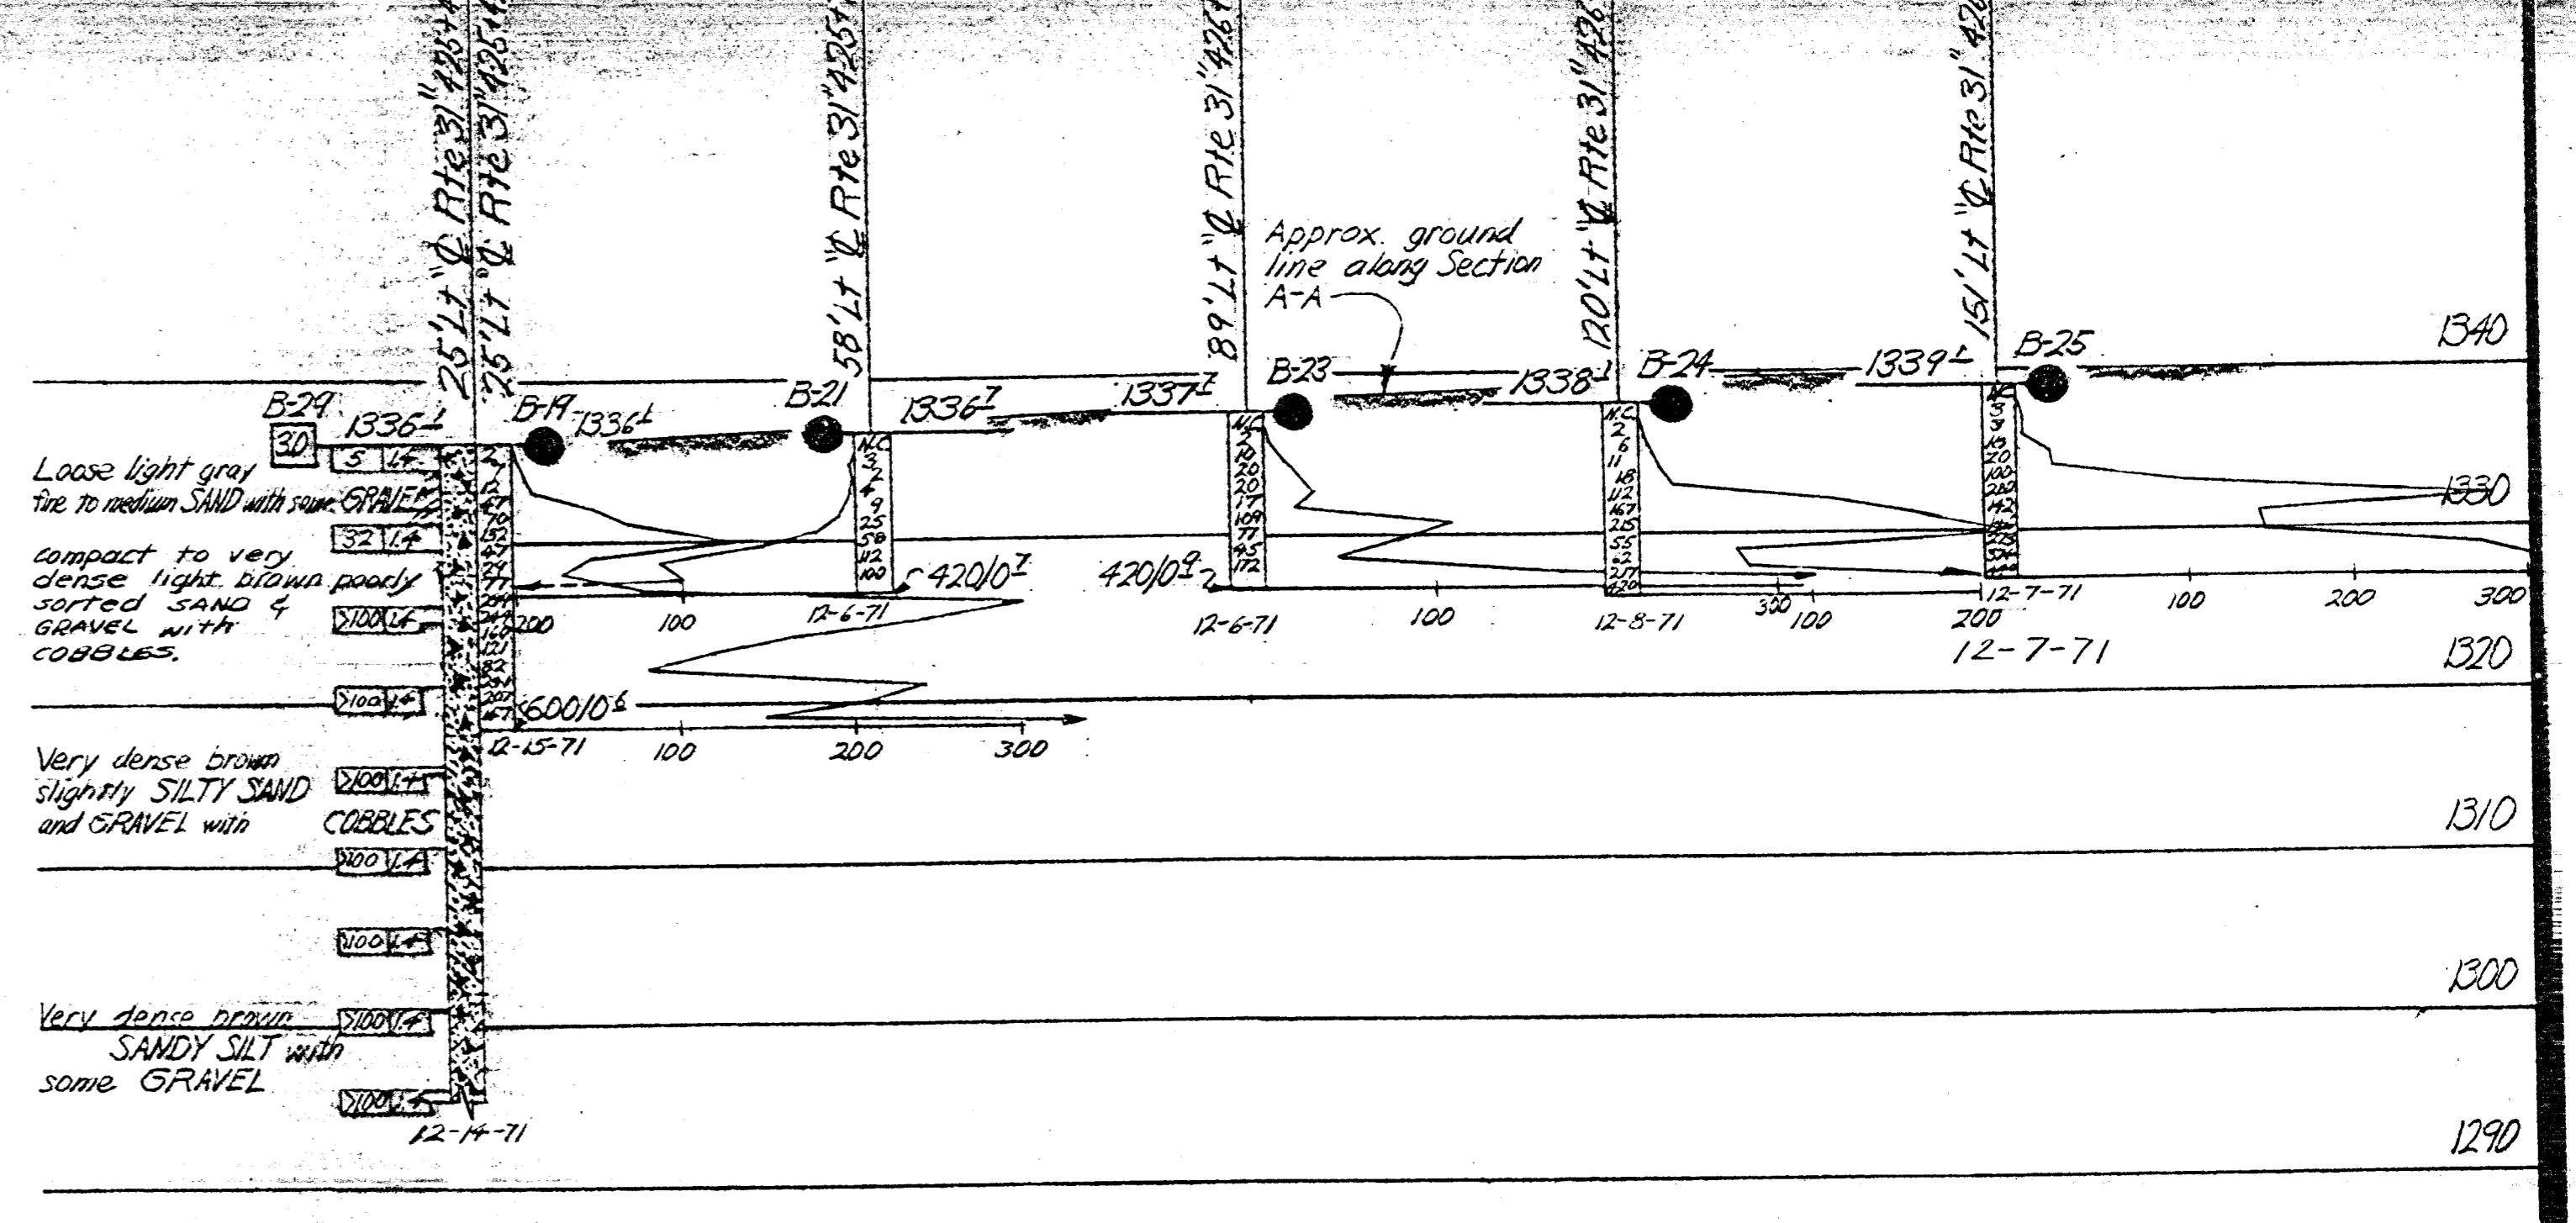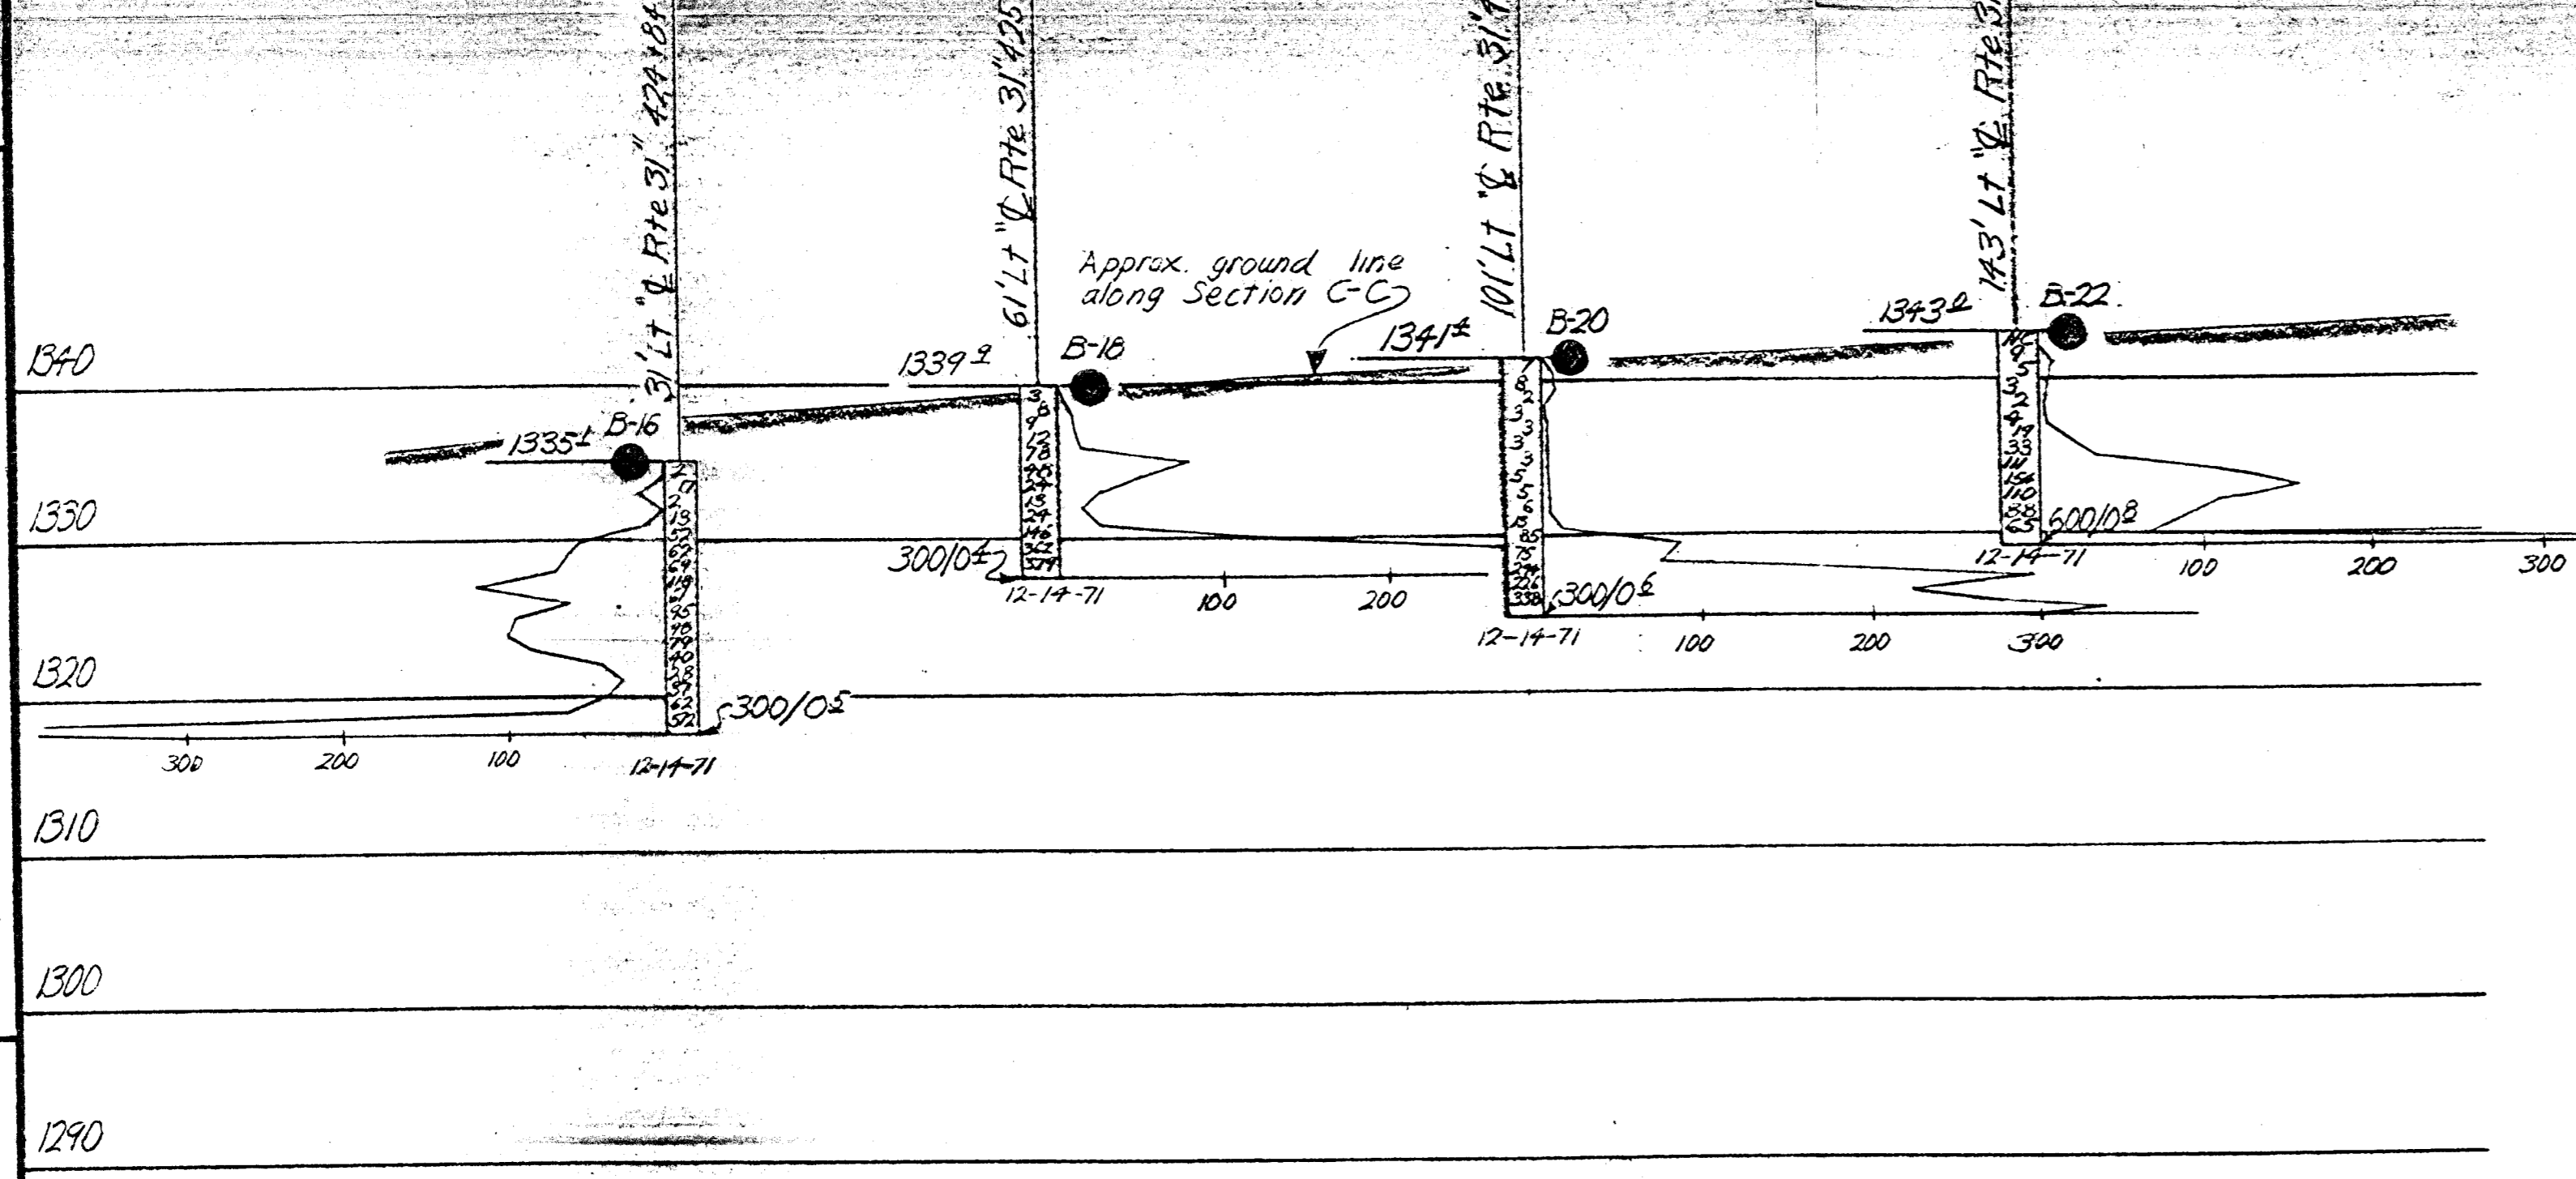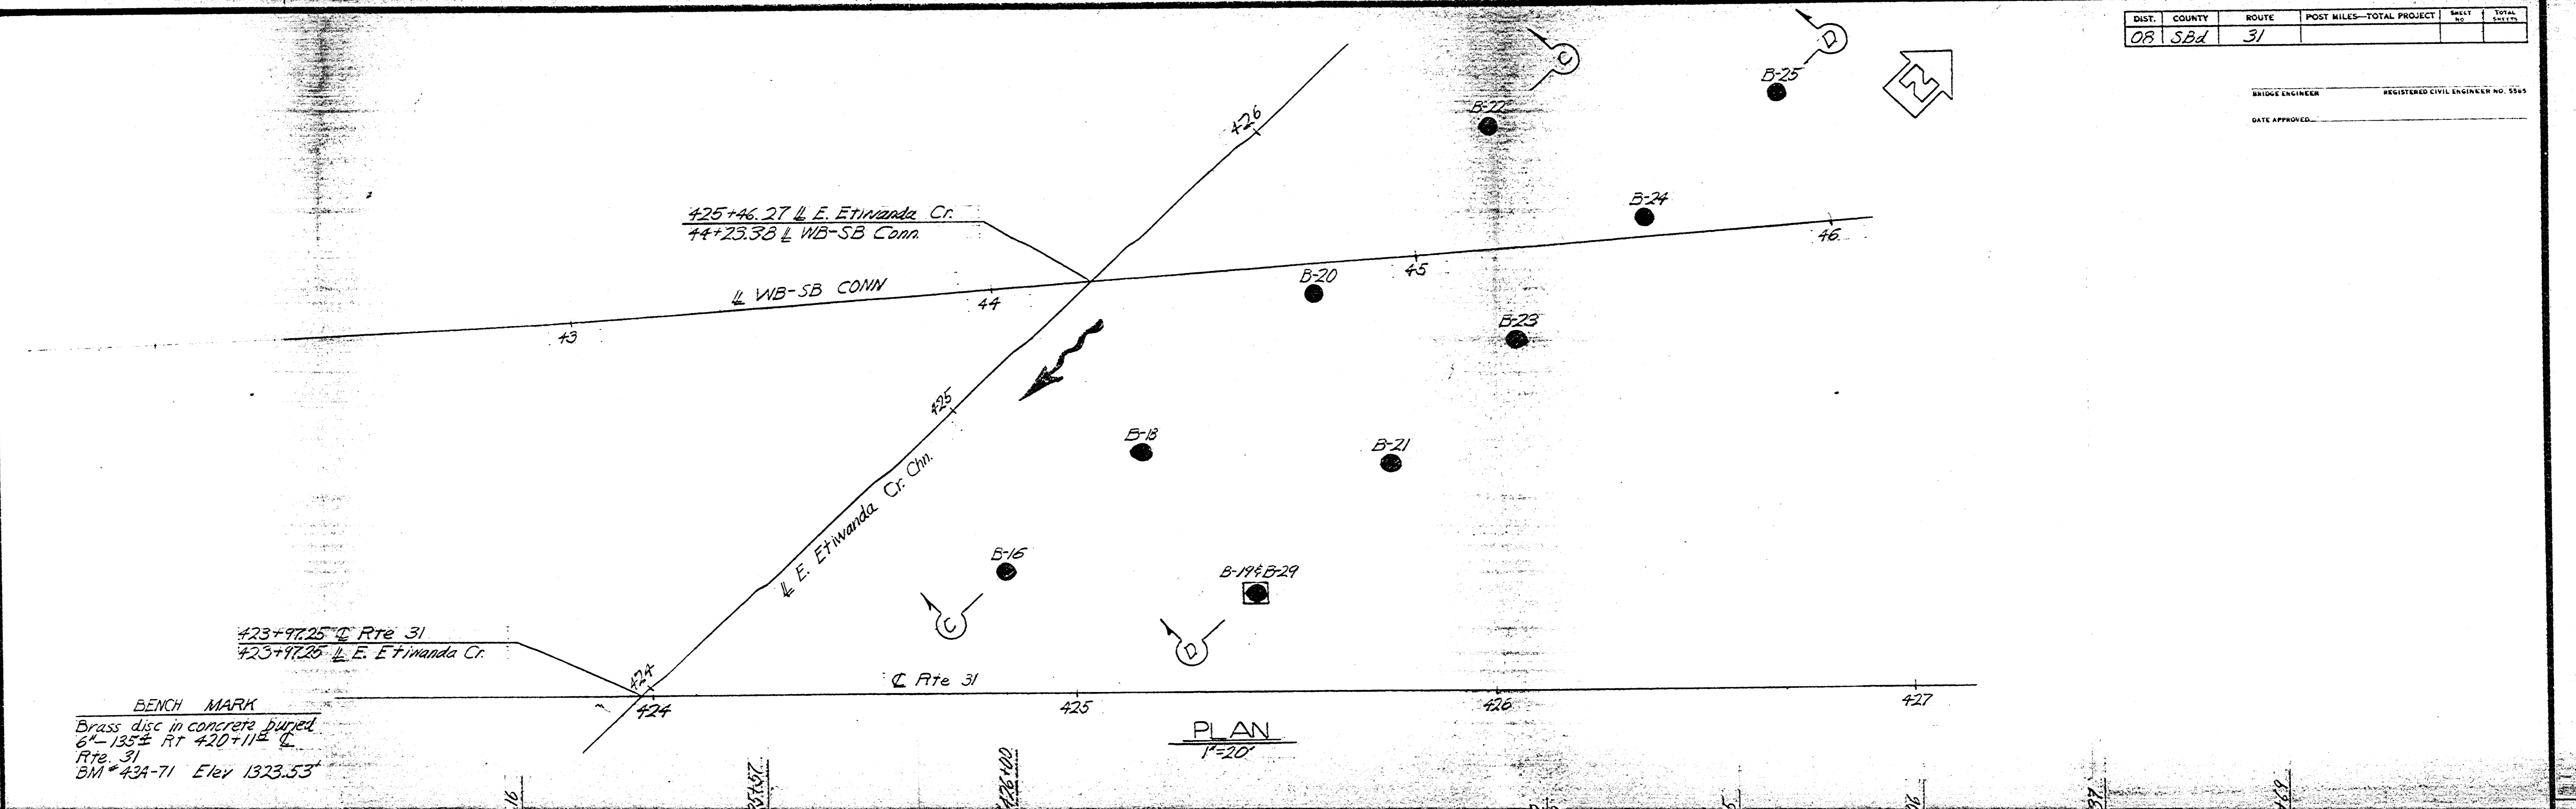

NO GROUND WATER ENCOUNTERED DURING THIS INVESTIGATION BY BRIDGE DEPT. GEOLOGY SECTION DATE 12-71

BRIDGE DEPARTMENT
ENGINEERING GEOLOGY SECTION

FIELD STUDY by W.T. NELSON 12/71
 DRAWN by D.G. SCHOTT 4-28-72
 CHECKED by W.T. NELSON 7-72

Approval Recommended by _____
 Certified Engineering Geologist No. _____

STATE OF CALIFORNIA
 TRANSPORTATION AGENCY
 DEPARTMENT OF PUBLIC WORKS
 DIVISION OF HIGHWAYS

EAST ETIWANDA CREEK BRIDGE

LOG OF TEST BORINGS 3 of 3

BRIDGE NO. 54-464 RLL POST MILE 7.6 DRAWING NO. _____ SHEET _____ OF _____

REVISION DATES _____ (PRELIMINARY STAGE ONLY)

WO 172001
 CU 08201

Diagnose prints bearing earlier revision dates

DIST.	COUNTY	ROUTE	POST MILES—TOTAL PROJECT	BRIDGE NO.	TOTAL SHEETS
08	S.Bd	31			

BRIDGE ENGINEER _____ REGISTERED CIVIL ENGINEER NO. 5565
 DATE APPROVED _____


LEGEND OF BORING OPERATIONS

SOIL TUBE
 B-No. Top hole E.I. Casing driven. Size of sampler (in). Blows per foot (with a 14" free fall). Poured pipe. Retained soil. 1" SOIL TUBE.

ROTARY BORING
 B-No. Top hole E.I. Description of material. Unit weight (lb/cu ft). % moisture. Casing diameter. Size of sampler. Description of material. Estimated material change. 10/16 (ft). Rotary boring.

PENETRATION BORING
 B-No. Top hole E.I. No. count recorder. Driving rate in seconds per foot. 15 psi, or as noted. 115 psi, or as noted. Penetration boring.

BENCH MARK
 Brass disc in concrete buried
 6" - 135 ± Rt 420 + 11 ±
 Rte 31
 BM # 43A-71 Elev. 1323.53'

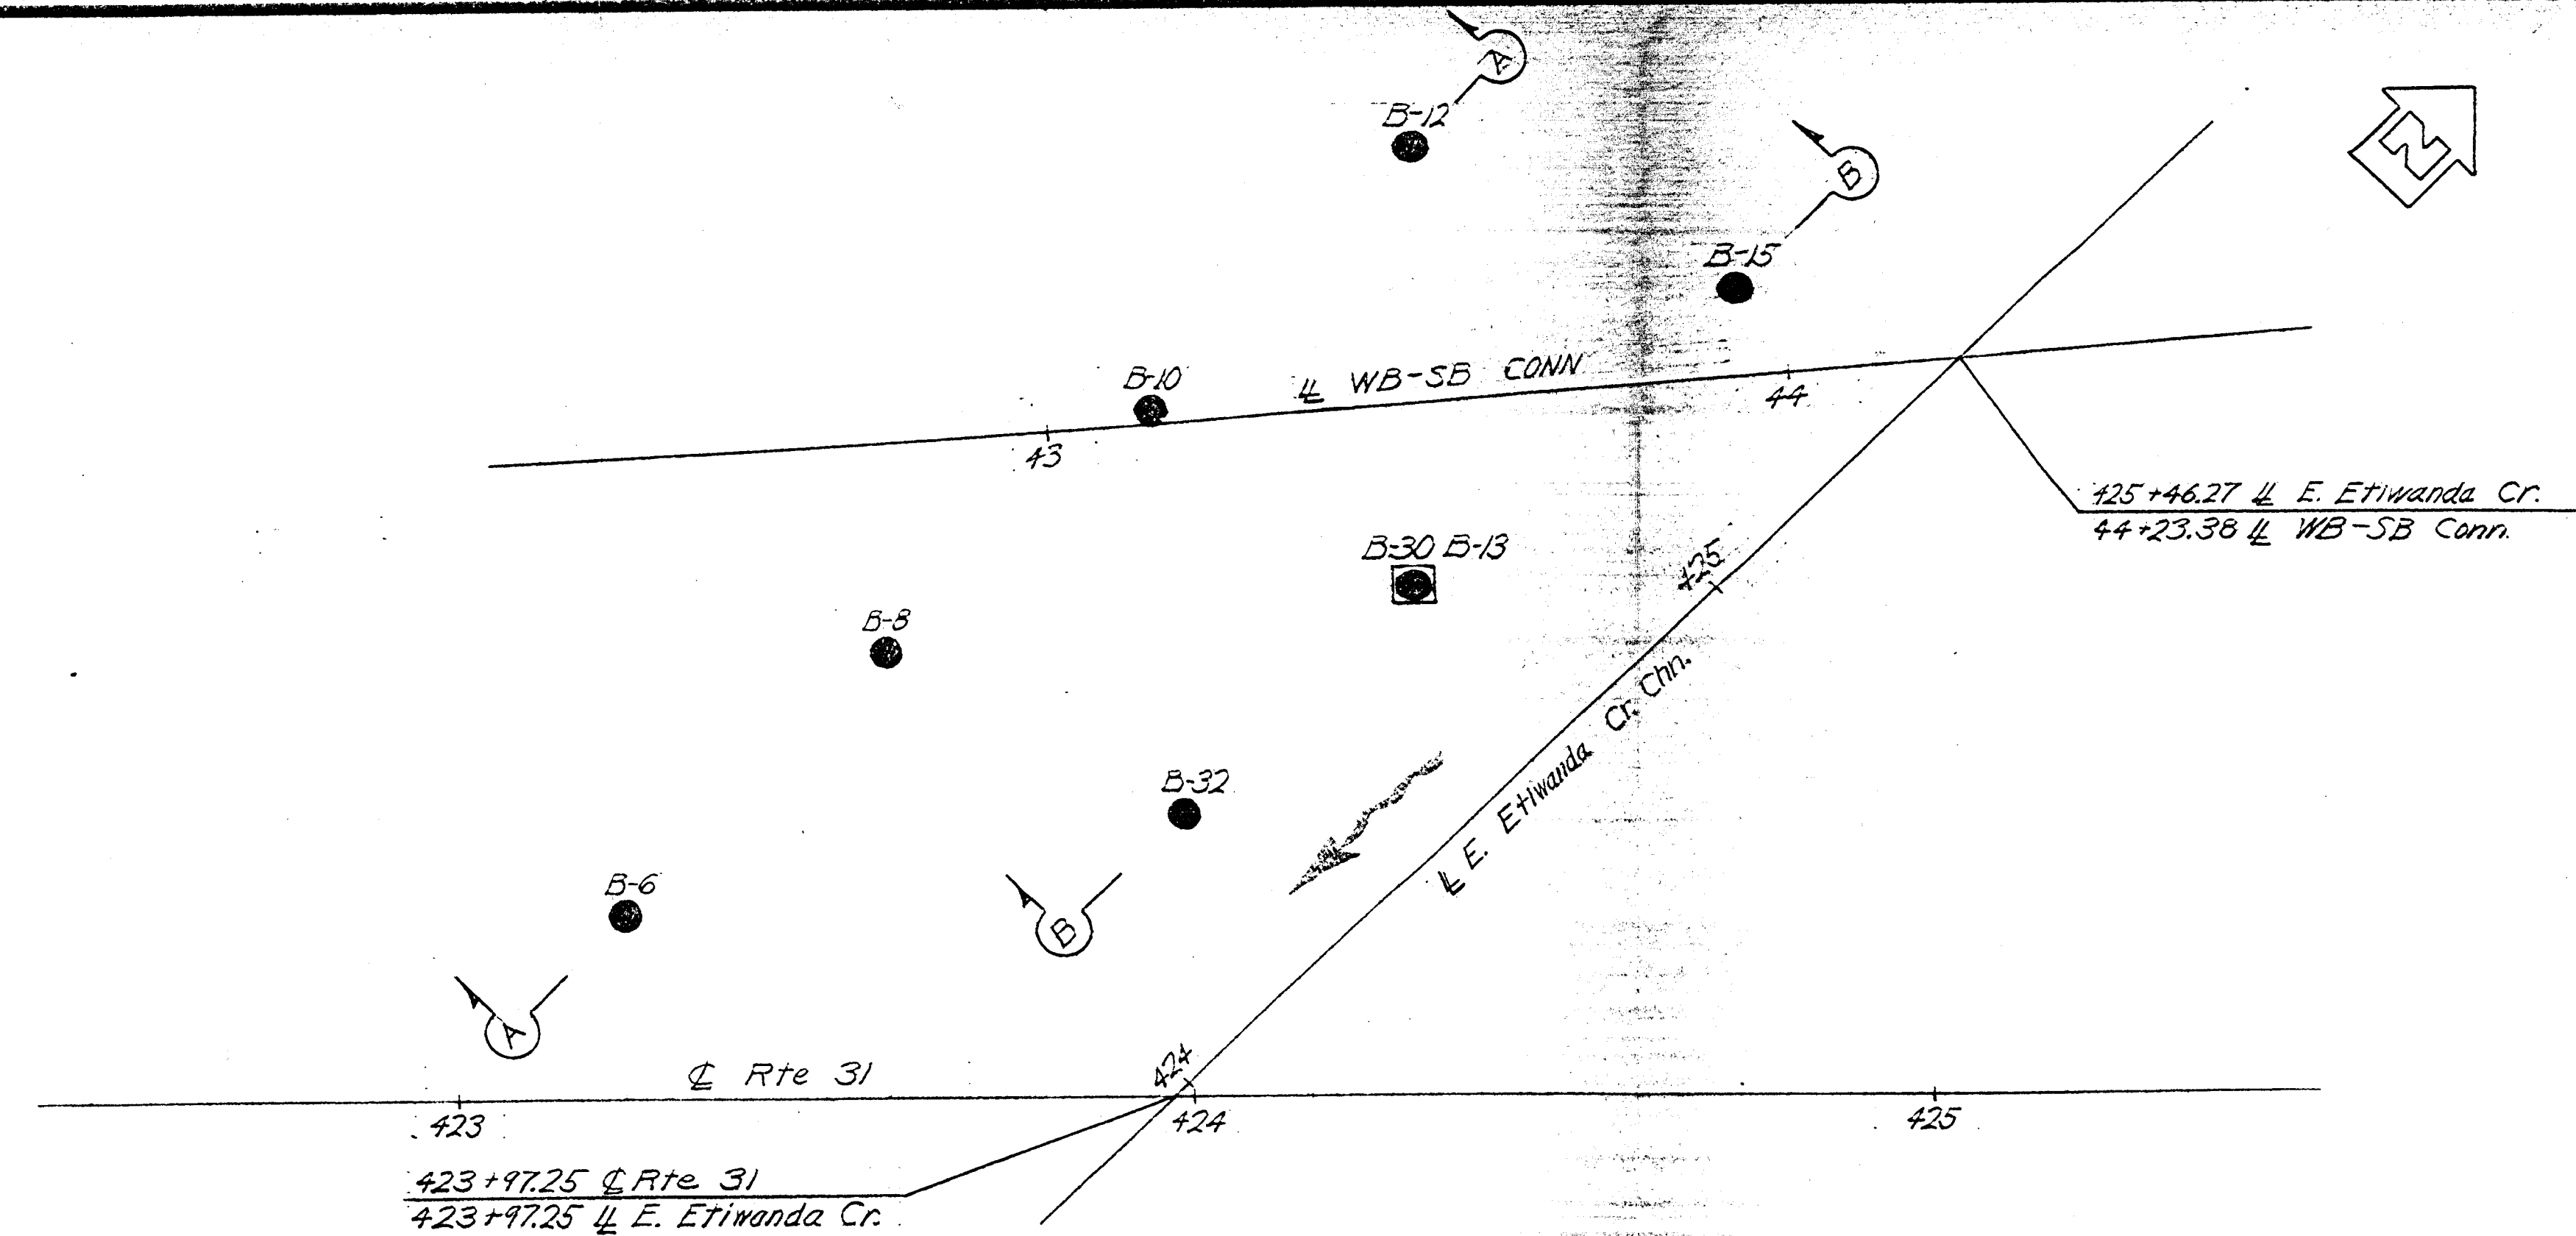

PLAN
1"=20'

LEGEND OF EARTH MATERIALS


GRAVEL
 SAND
 SILT
 CLAY
 SANDY CLAY
 CLAYEY SAND
 SILTY SAND
 SILTY CLAY
 CLAYEY SILT
 ORGANIC MATTER
 FILL MATERIAL
 GROUNDWATER
 SEDIMENTARY ROCK
 METAMORPHIC ROCK

CONSISTENCY CLASSIFICATION FOR SOILS

According to the Standard Penetration Test

No. of blows	Consistency
0-5	Very loose
5-10	Loose
10-20	Slightly compact
20-35	Compact
35-70	Dense
>70	Very dense

NOTE: Classification of earth material as shown on this sheet is based upon field inspection and is not to be construed to imply mechanical analysis.

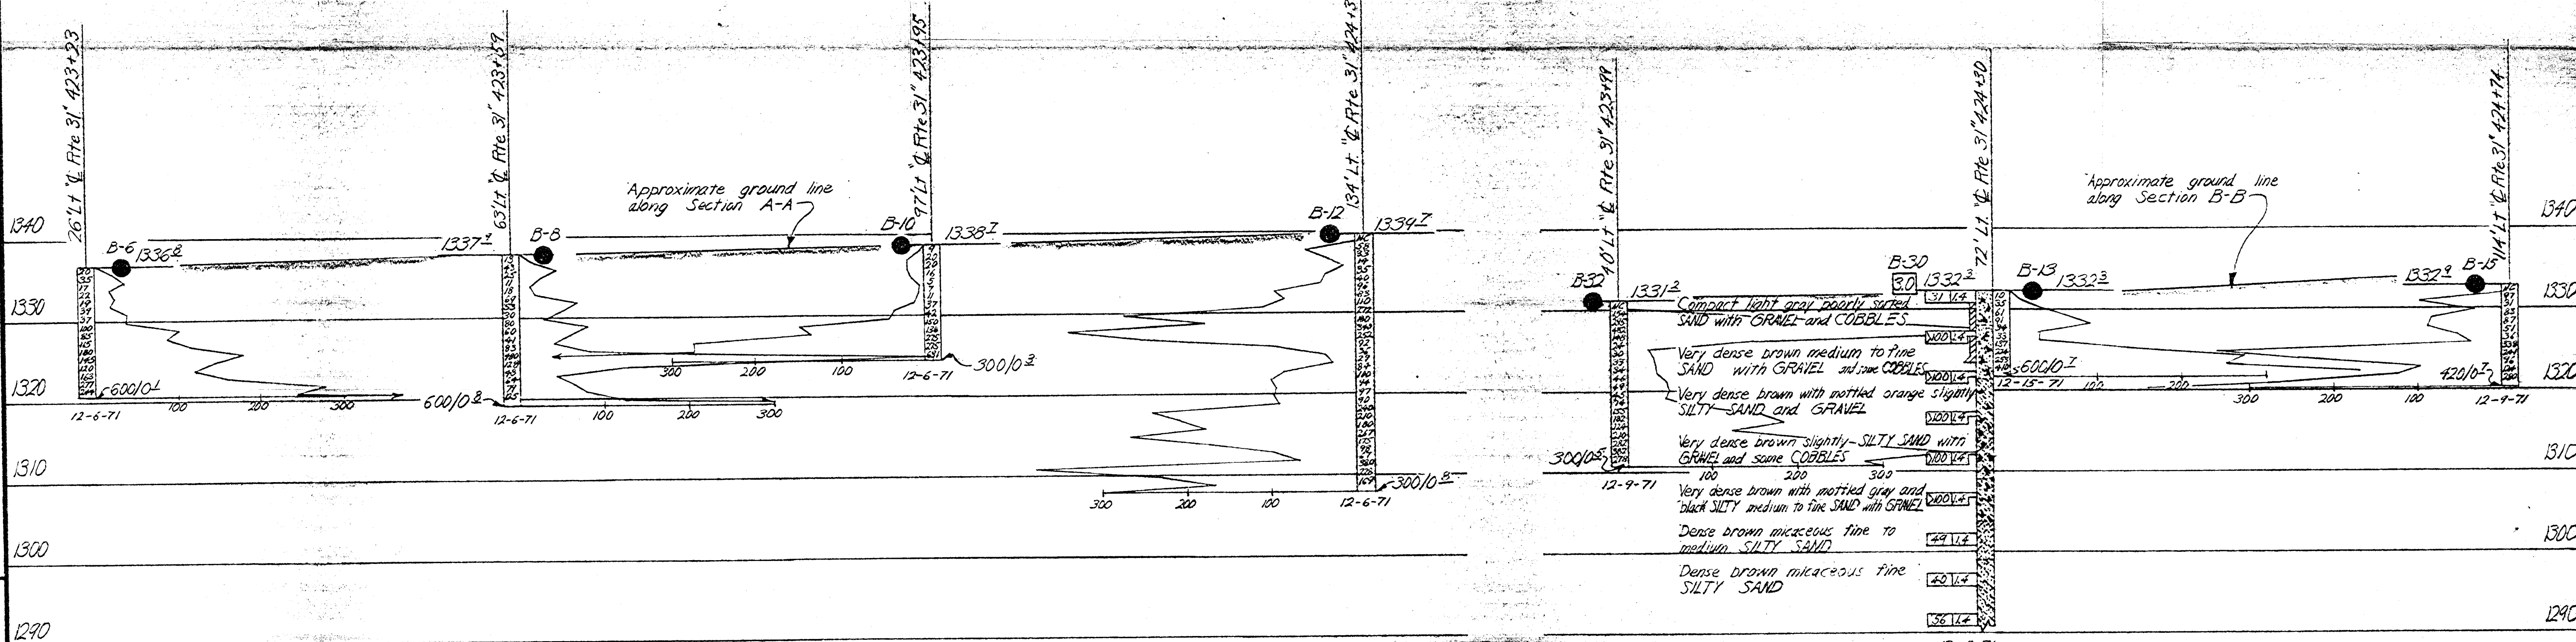

SECTION A-A
1"=20'

SECTION B-B
1"=10'

NO GROUND WATER ENCOUNTERED DURING THIS INVESTIGATION BY BRIDGE DEPT. GEOLOGY SECTION DATE 12-71

BRIDGE DEPARTMENT
ENGINEERING GEOLOGY SECTION

FIELD STUDY by W. T. NELSON 12/71
 DRAWN by D. S. SCHOTT 4/72
 CHECKED by W. T. NELSON 7-72

Approval Recommended by _____ Engineering Geologist
 Certified Engineering Geologist No. _____


STATE OF CALIFORNIA
 TRANSPORTATION AGENCY
 DEPARTMENT OF PUBLIC WORKS
 DIVISION OF HIGHWAYS

EAST ETIWANDA CREEK BRIDGE

LOG OF TEST BORINGS 2 of 3

BRIDGE NO. 54-964 R/L POST MILE 7.6 DRAWING NO. SHEET OF

REVISION DATES (PRELIMINARY STAGE ONLY)

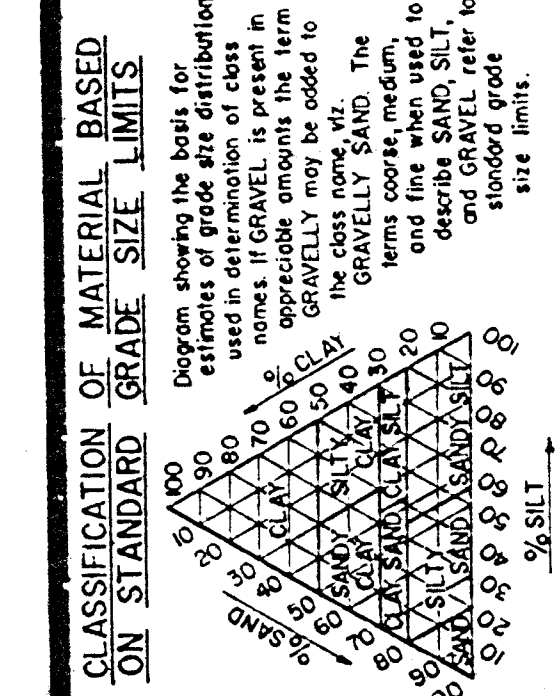


WO: 172001
 CH: 12361




Disregard prints bearing earlier revision dates.

DIST.	COUNTY	ROUTE	POST MILES—TOTAL PROJECT	SHEET NO.	TOTAL SHEETS
08	S.Bd	31			

BRIDGE ENGINEER _____ REGISTERED CIVIL ENGINEER NO. 5845
 DATE APPROVED _____

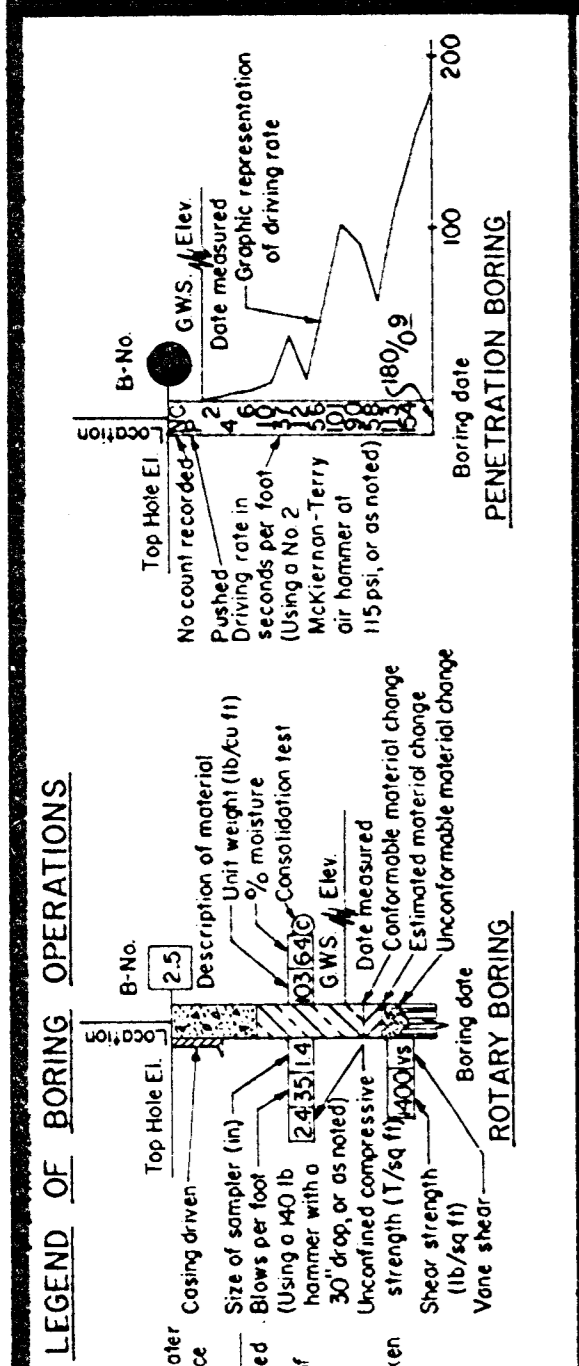


BENCH MARK
 Brass disc in concrete buried
 6" x 135±" Rt. 420+11.2 ±
 Rte 31
 B.M. #43A-71 Elev. 1323.53'

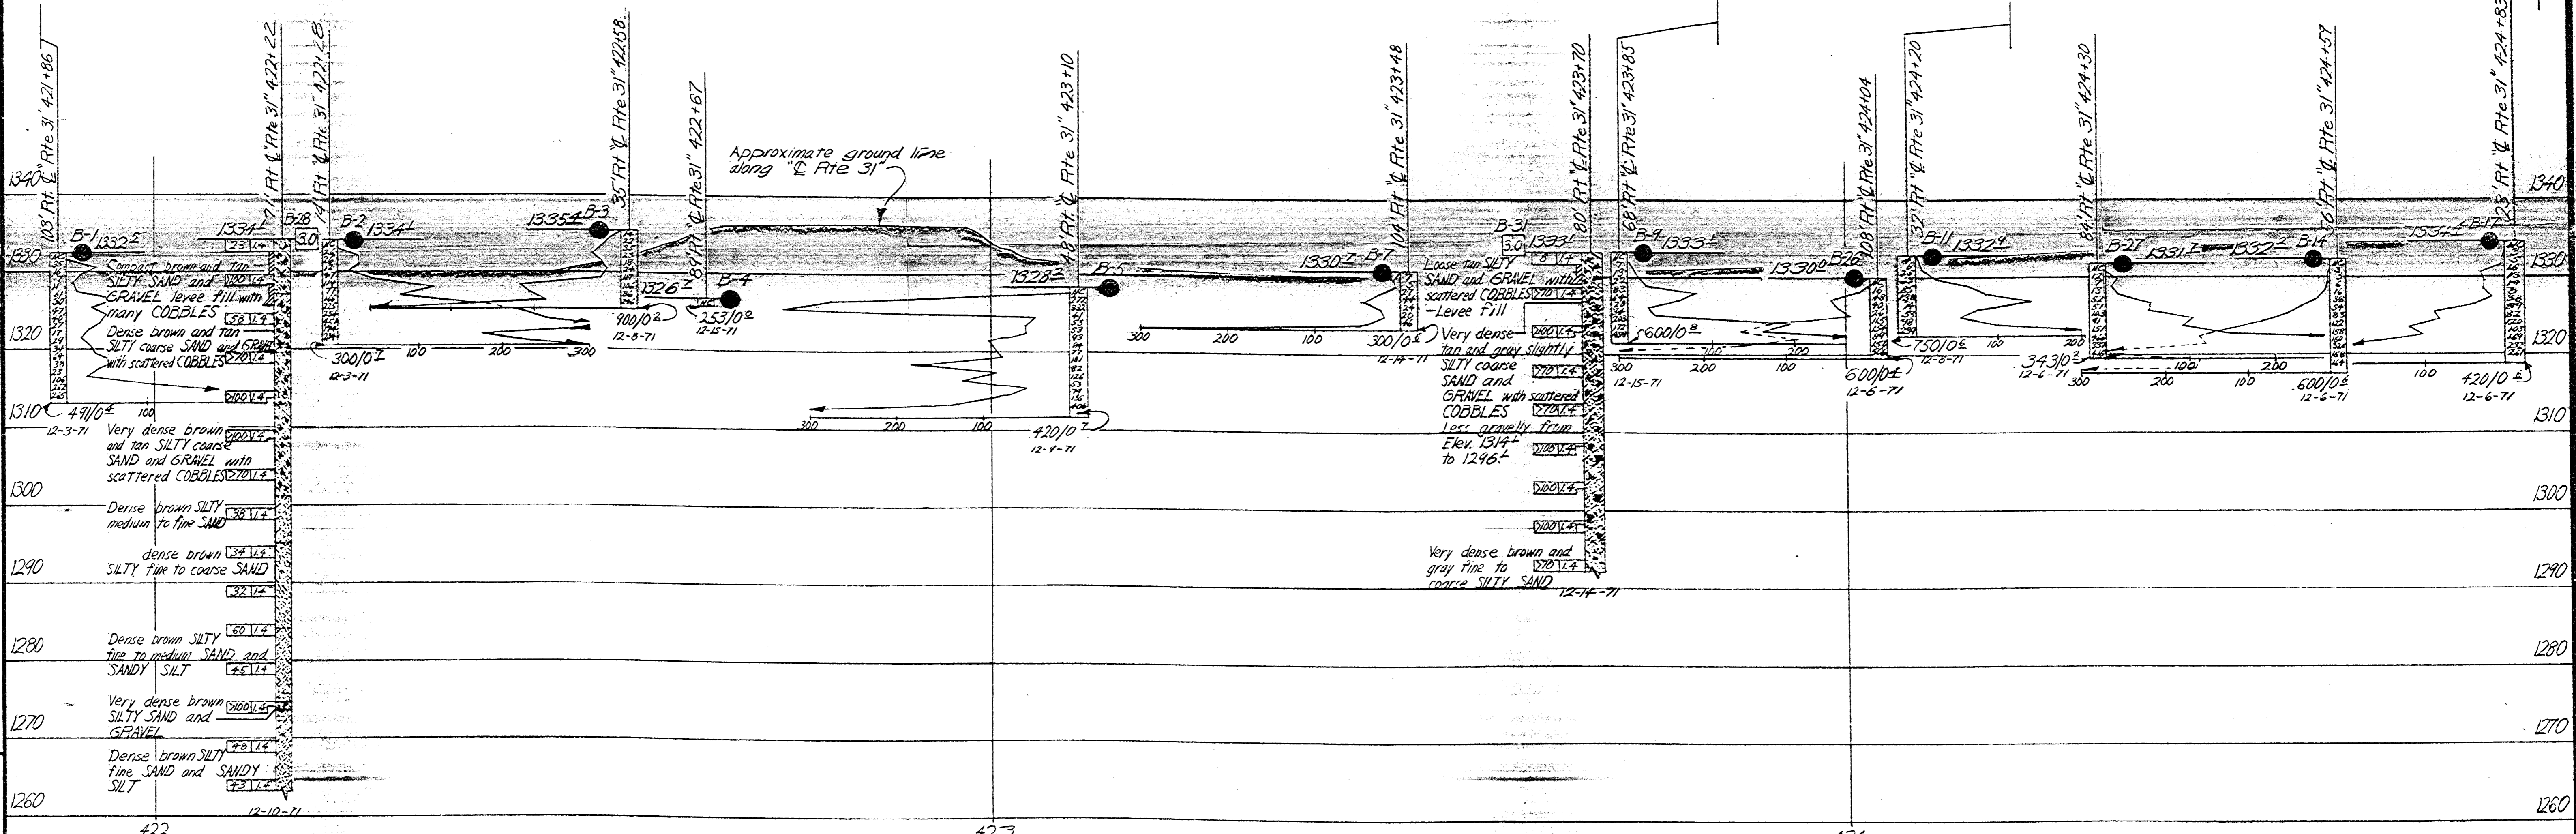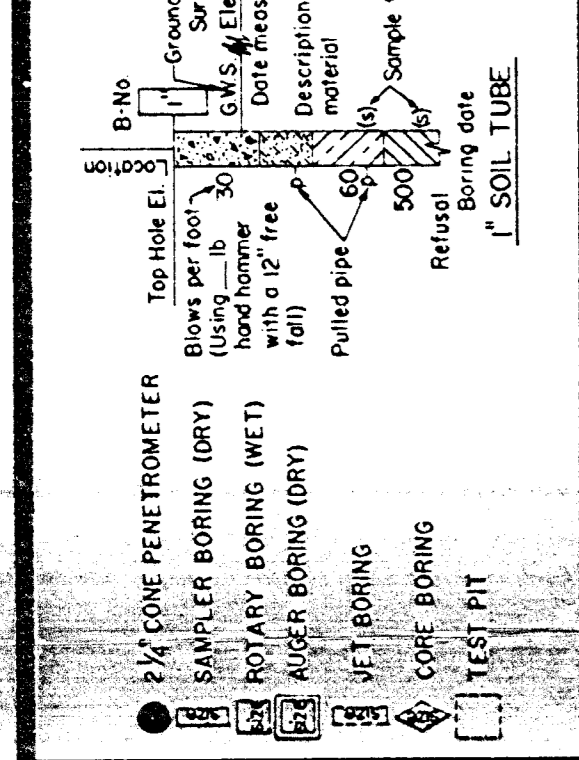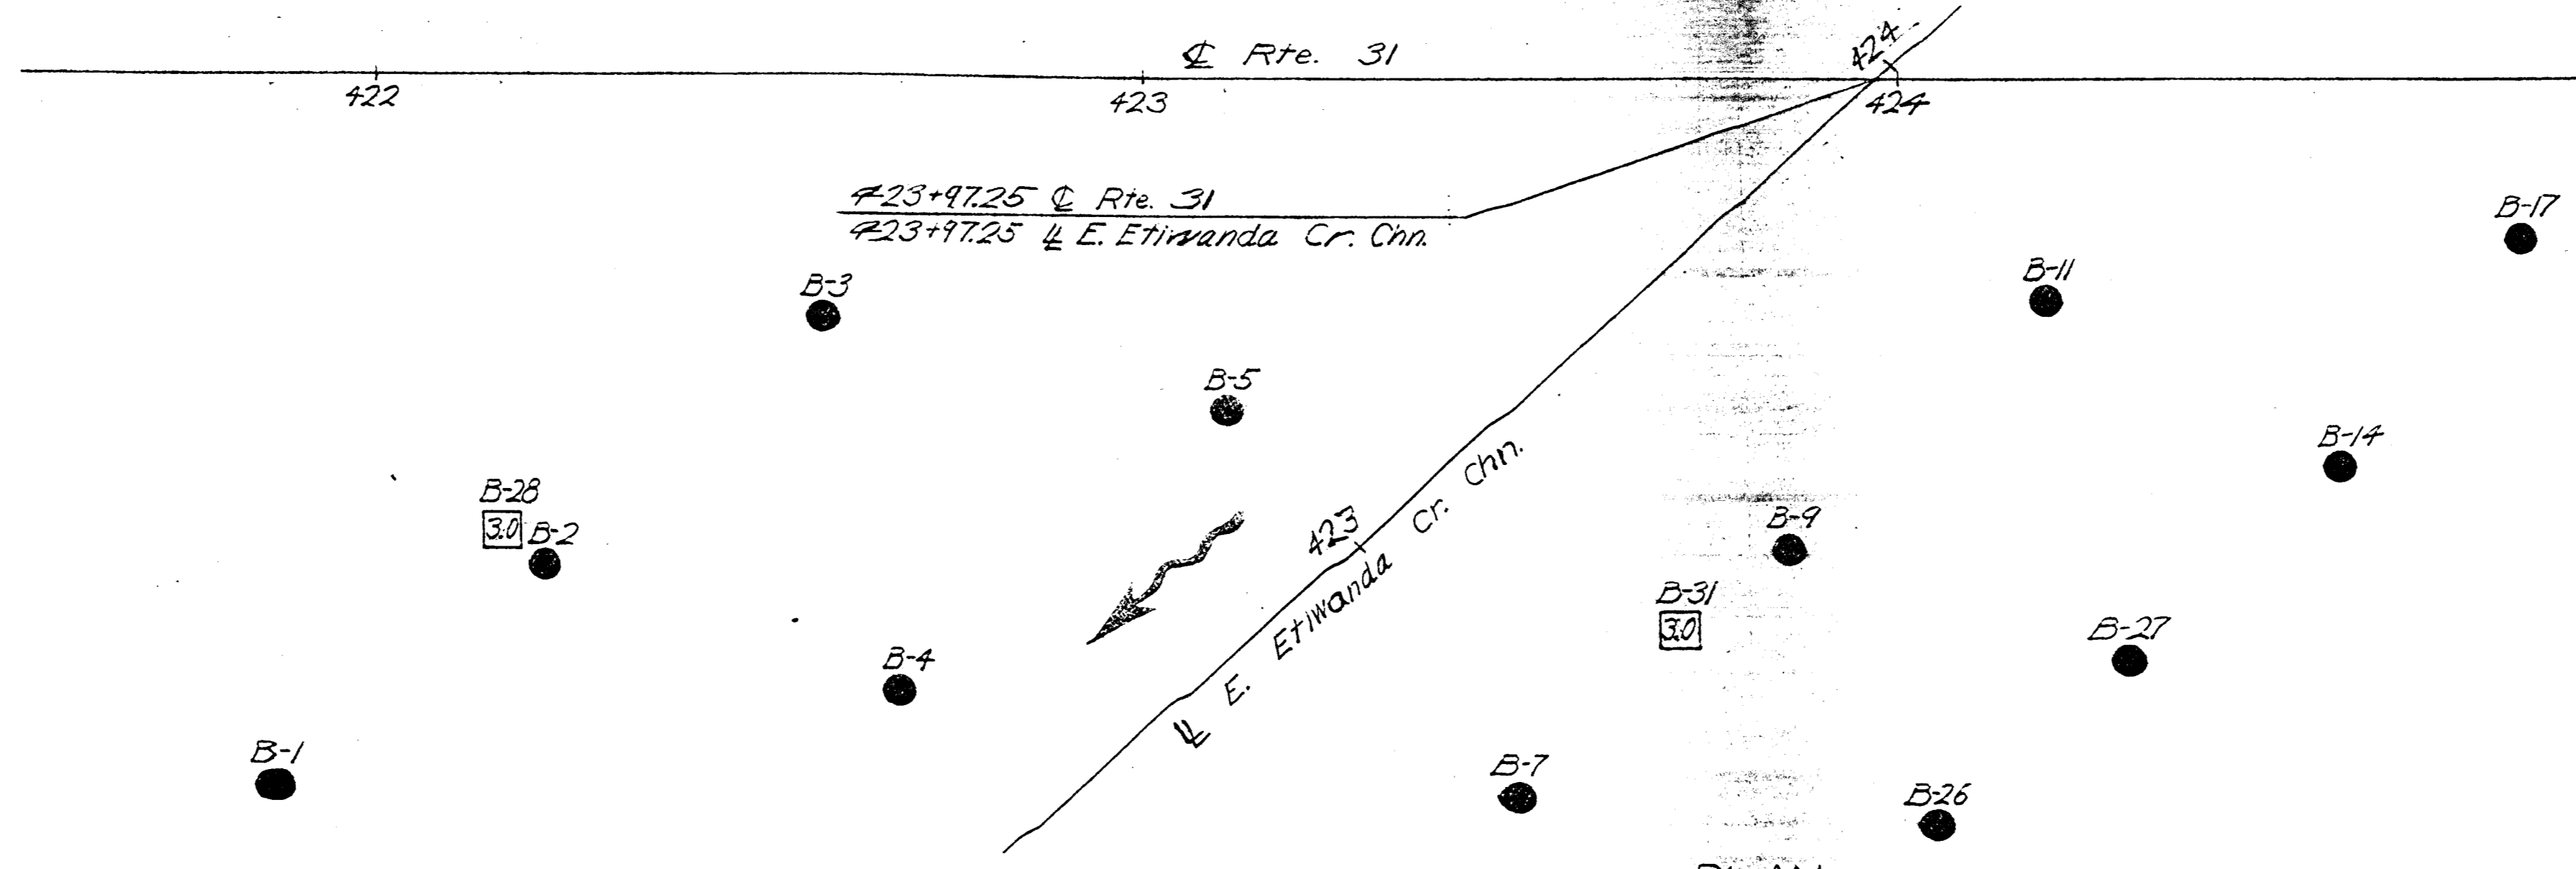

CONSISTENCY CLASSIFICATION FOR SOILS

According to the Standard Penetration Test

No. of blows	Consistency
0-5	Very loose
5-10	Loose
10-20	Slightly compact
20-35	Dense
35-70	Very dense
>70	Very hard

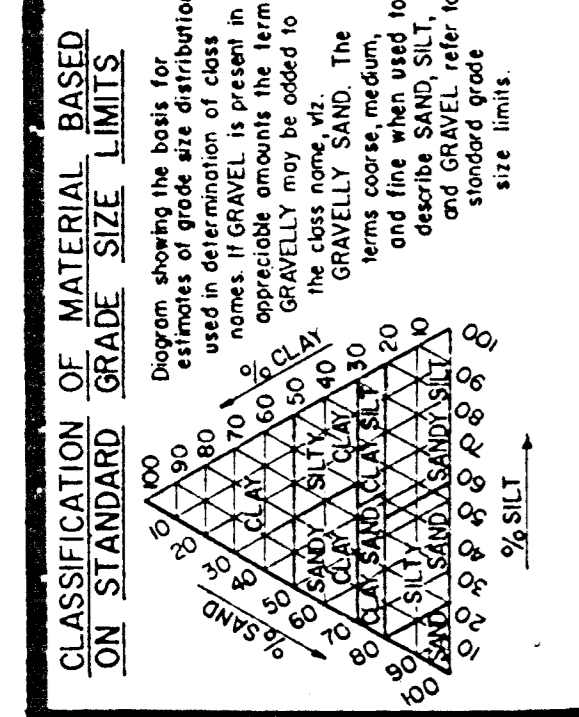

NOTE: Classification of earth material as shown on this sheet is based upon field inspection and is not to be construed to imply mechanical analysis.

NO GROUND WATER ENCOUNTERED
 DATE 12-71

PROFILE
 1"=10'

BRIDGE DEPARTMENT
ENGINEERING GEOLOGY SECTION
 FIELD STUDY by W.T. NELSON 12/71
 DRAWN by O.G. SCHOTT 3/72
 CHECKED by W.T. NELSON 7-72
 Approval Recommended by _____ Engineering Geologist
 Certified Engineering Geologist No. _____

STATE OF CALIFORNIA
 TRANSPORTATION AGENCY
 DEPARTMENT OF PUBLIC WORKS
 DIVISION OF HIGHWAYS

EAST ETIWANDA CREEK BRIDGE

LOG OF TEST BORINGS 1 of 3

BRIDGE NO. 54-964 R/L POST MILE 7.6 DRAWING NO. _____ SHEET _____ OF _____

REVISION DATES _____ (PRELIMINARY STAGE ONLY)

WO 172001
 CU 08201

Discard prints bearing earlier revision dates

E210-N15 Connector / I-15 Separation

DIST	COUNTY	ROUTE	POST MILES	TOTAL PROJECT	SHEET NO.	TOTAL SHEETS
08	SBD	30				

BRIDGE ENGINEER: REGISTERED PROFESSIONAL ENGINEER NO. 5547
 DATE APPROVED:

LEGEND OF BORING OPERATIONS

SOIL TUBE
 Top hole (EI)
 Bore hole
 Boring date
 1" SOIL TUBE

ROTARY BORING
 Top hole (EI)
 Bore hole
 Boring date
 ROTARY BORING

1/4" CORE PENETROMETER
 Bore hole
 Boring date
 1/4" CORE PENETROMETER

SAMPLER BORING (DRY)
 Bore hole
 Boring date
 SAMPLER BORING (DRY)

AUGER BORING (DRY)
 Bore hole
 Boring date
 AUGER BORING (DRY)

JET BORING
 Bore hole
 Boring date
 JET BORING

CORE BORING
 Bore hole
 Boring date
 CORE BORING

TEST PIT
 Bore hole
 Boring date
 TEST PIT

LEGEND OF EARTH MATERIALS

GRAVEL
 SAND
 SILT
 CLAY
 SANDY CLAY or CLAYEY SAND
 SILTY SAND

PEAT AND/OR ORGANIC MATERIAL
 FILL MATERIAL
 IGNEOUS ROCK
 SEDIMENTARY ROCK
 METAMORPHIC ROCK

CONSISTENCY CLASSIFICATION FOR SOILS

According to the Standard Penetration Test

Very soft
 Soft
 Stiff
 Very stiff
 Hard
 Very hard


Very loose
 Loose
 Slightly compact
 Compact
 Very dense

No. of blows
 0-5
 5-10
 10-20
 20-30
 30-50
 > 50

CLASSIFICATION OF MATERIAL BASED ON STANDARD GRADE SIZE LIMITS


Diagram showing the basis for determination of gradation of aggregate or soil in accordance with the appropriate specification. The term GRAVELLY SAND may be used to describe a mixture of sand and gravel when the sand portion is more than 75% sand and the gravel portion is less than 25% gravel.

B.M. 8A-71
 Brass Disk in Conc. Bur. 6"
 465' Rt. 74+14.5 & Imp. Rte. 30
 Elev. 1371.97

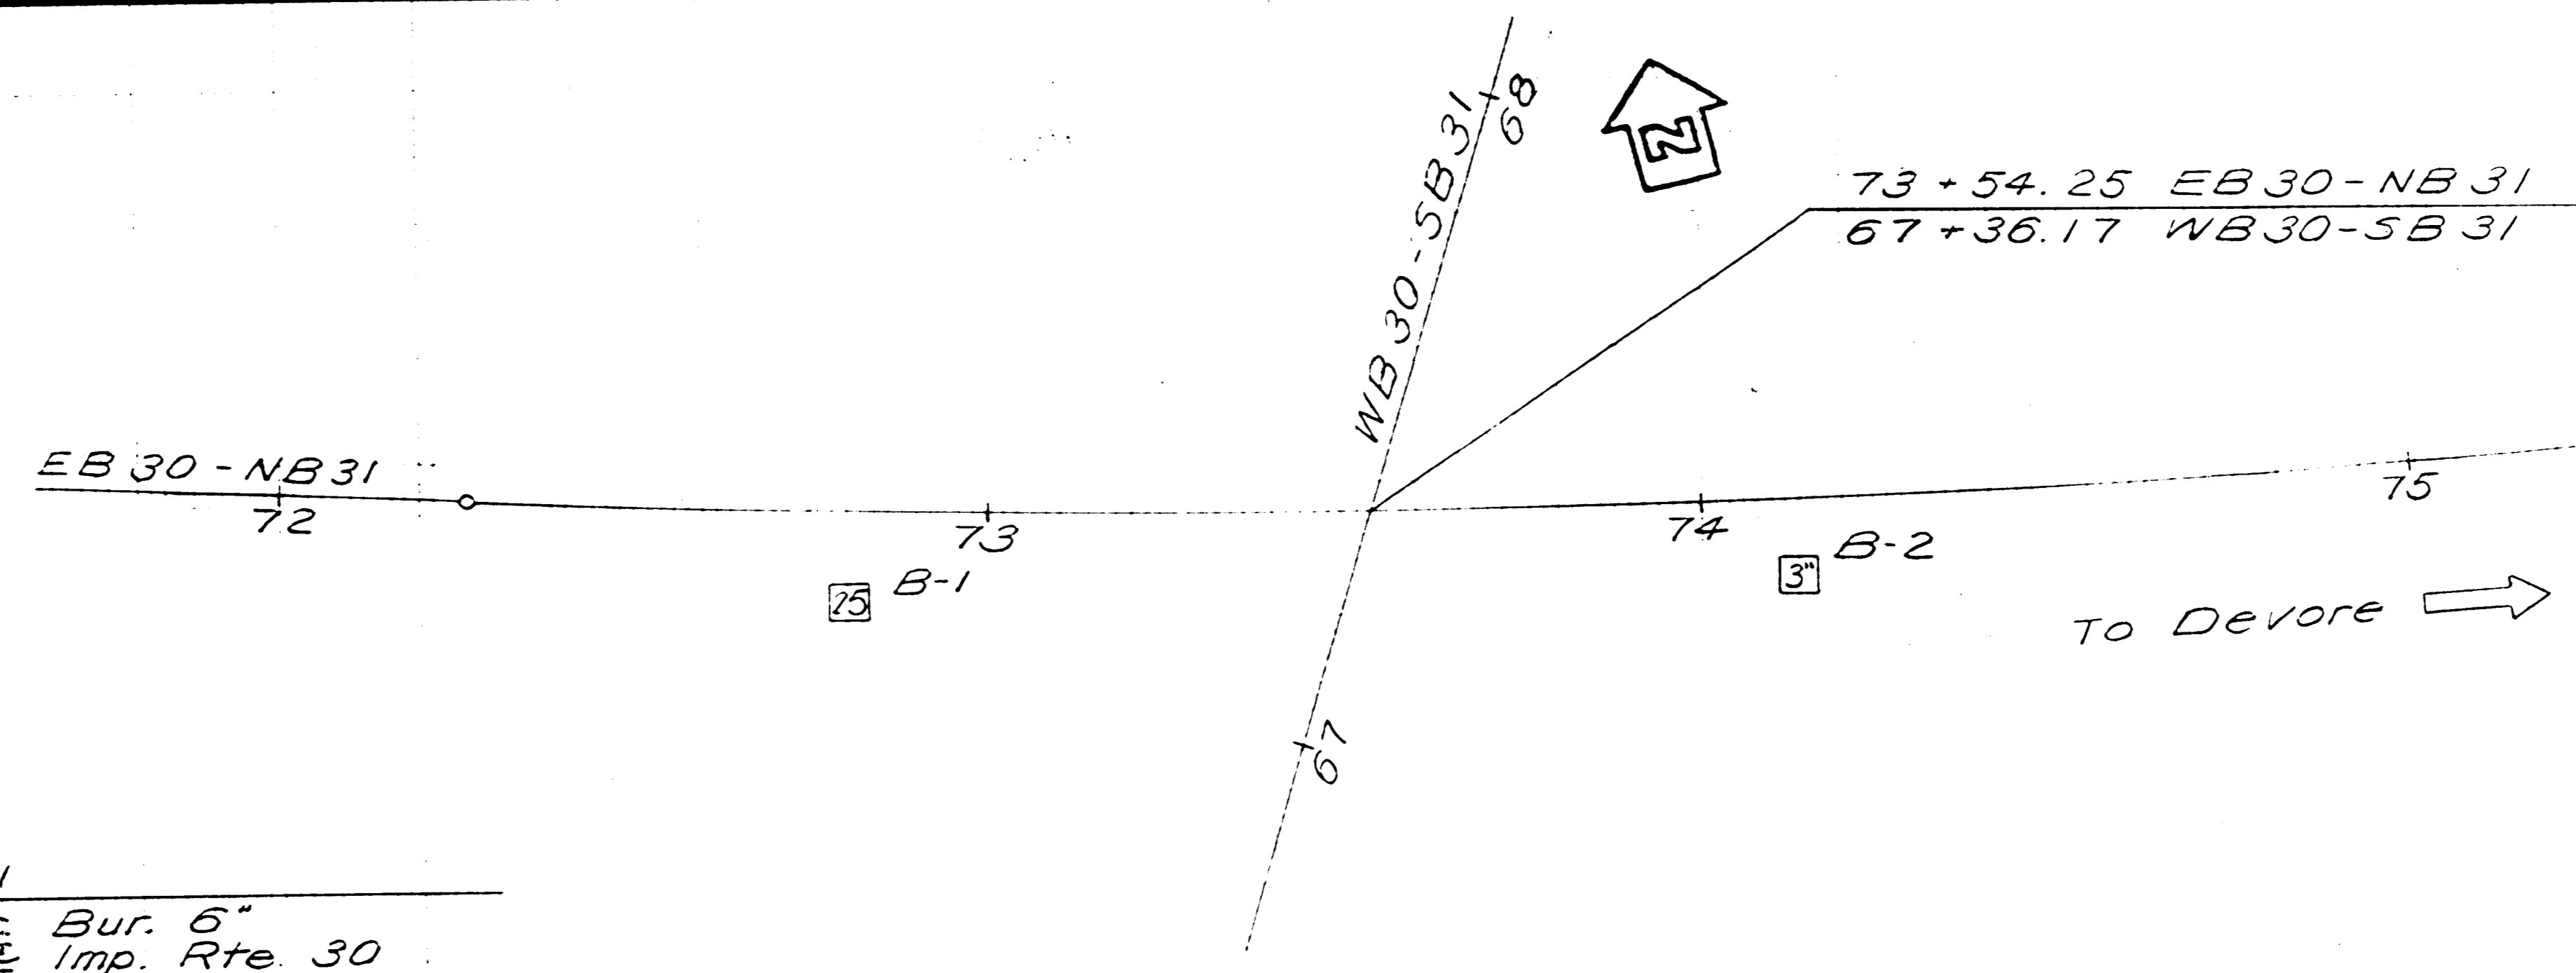

PLAN
 Scale: 1" = 20'

Approximate ground line along EB 30-NB 31

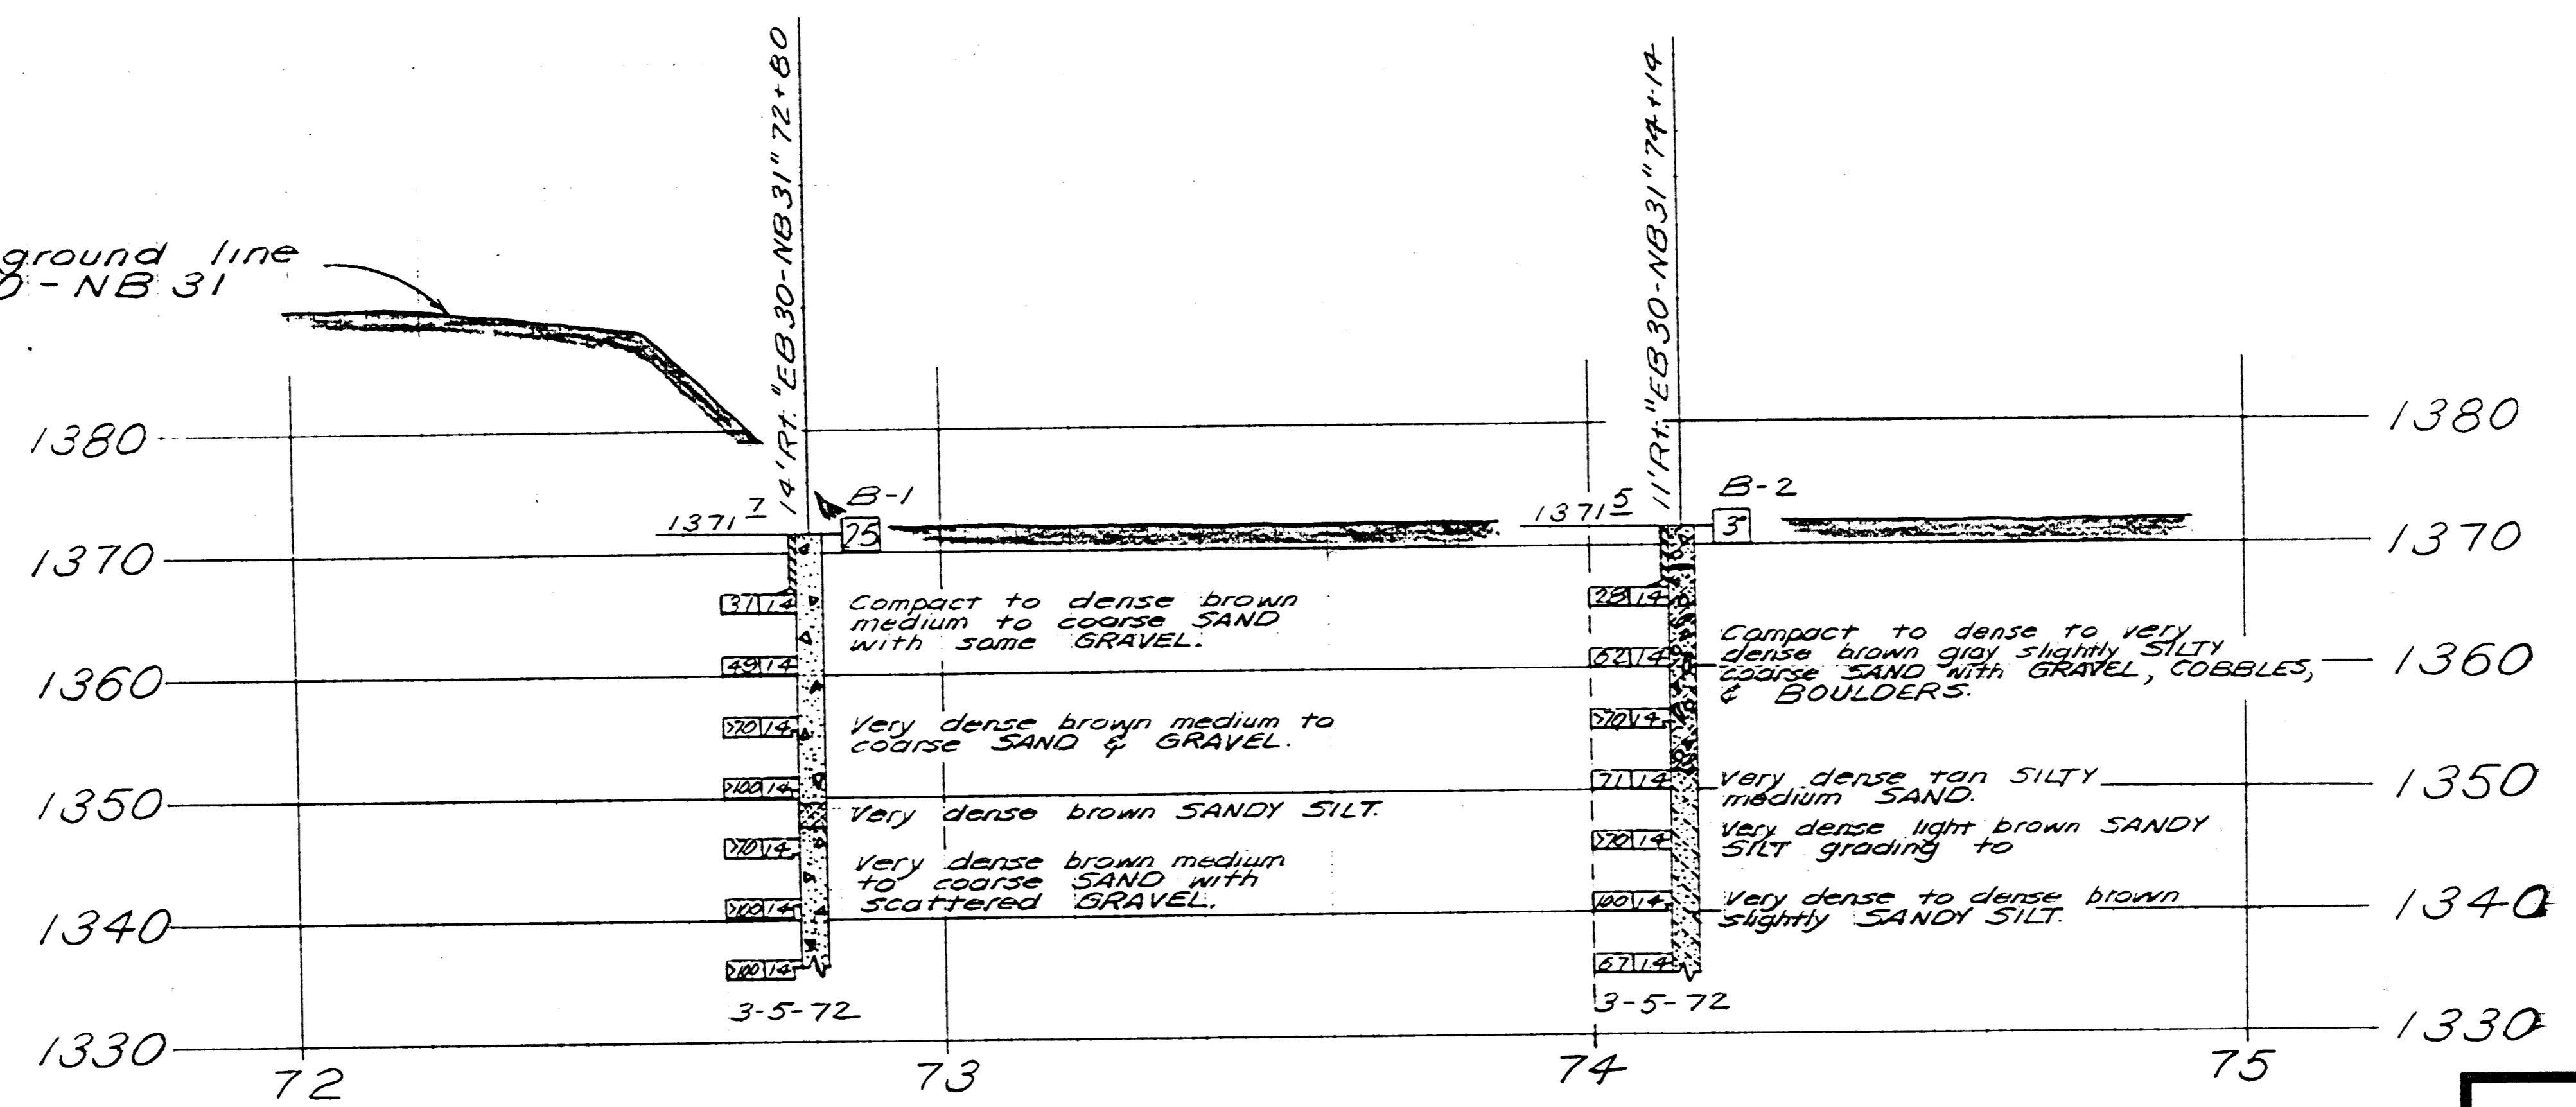

NO GROUND WATER ENCOUNTERED DURING THIS INVESTIGATION BY BRIDGE DEPT. GEOLOGY SECTION
 DATE 3-72

PROFILE
 Scale: Horz. 1" = 20'
 Vert. 1" = 10'

BRIDGE DEPARTMENT
 ENGINEERING GEOLOGY SECTION

FIELD STUDY by R. FOX 3-72
 DRAWN by S. KAMMURA 3-23-72
 CHECKED by R. FOX 4-7-72

Approval Recommended by _____
 Engineering Geologist
 Certified Engineering Geologist No. _____

STATE OF CALIFORNIA
 TRANSPORTATION AGENCY
 DEPARTMENT OF PUBLIC WORKS
 DIVISION OF HIGHWAYS

SOUTHWEST CONNECTOR SEPARATION

LOG OF TEST BORINGS

BRIDGE NO. 54-958 POST MILE 11.6 DRAWING NO. SHEET OF

REVISION DATES (PRELIMINARY STAGE ONLY)

WO 132900
 CU 08201

Discard prints bearing earlier revision dates

LEGEND OF BORING OPERATIONS

LEGEND OF EARTH MATERIALS

CONSISTENCY CLASSIFICATION FOR SOILS

CLASSIFICATION OF MATERIAL BASED ON STANDARD GRADE SIZE LIMITS

LEGEND OF BORING OPERATIONS

2 1/2" CONE PENETROMETER
 SAMPLER BORING (WET)
 AUGER BORING (WET)
 AUGER BORING (DRY)
 JET BORING
 CORE BORING
 TEST PIT

LEGEND OF EARTH MATERIALS

GRAVEL
 SAND
 SILT
 CLAY
 SANDY CLAY or CLAYEY SAND
 SILTY SAND or SILTY CLAY
 SILTY CLAY or CLAYEY SILT
 FEAT and/or ORGANIC MATTER
 ALL MATERIAL
 GASEOUS ROCK
 SEDIMENTARY ROCK
 METAMORPHIC ROCK


CONSISTENCY CLASSIFICATION FOR SOILS

According to the Standard Penetration Test No. of blows

0-5 Granular
 5-10 Very loose
 10-20 Loose
 20-35 Slightly compact
 35-70 Compact
 >70 Dense
 Very dense

CLASSIFICATION OF MATERIAL BASED ON STANDARD GRADE SIZE LIMITS

Diagram showing the limits for various soil types based on percentages of sand, silt, and clay. Includes symbols for gravel, sand, silt, and clay.

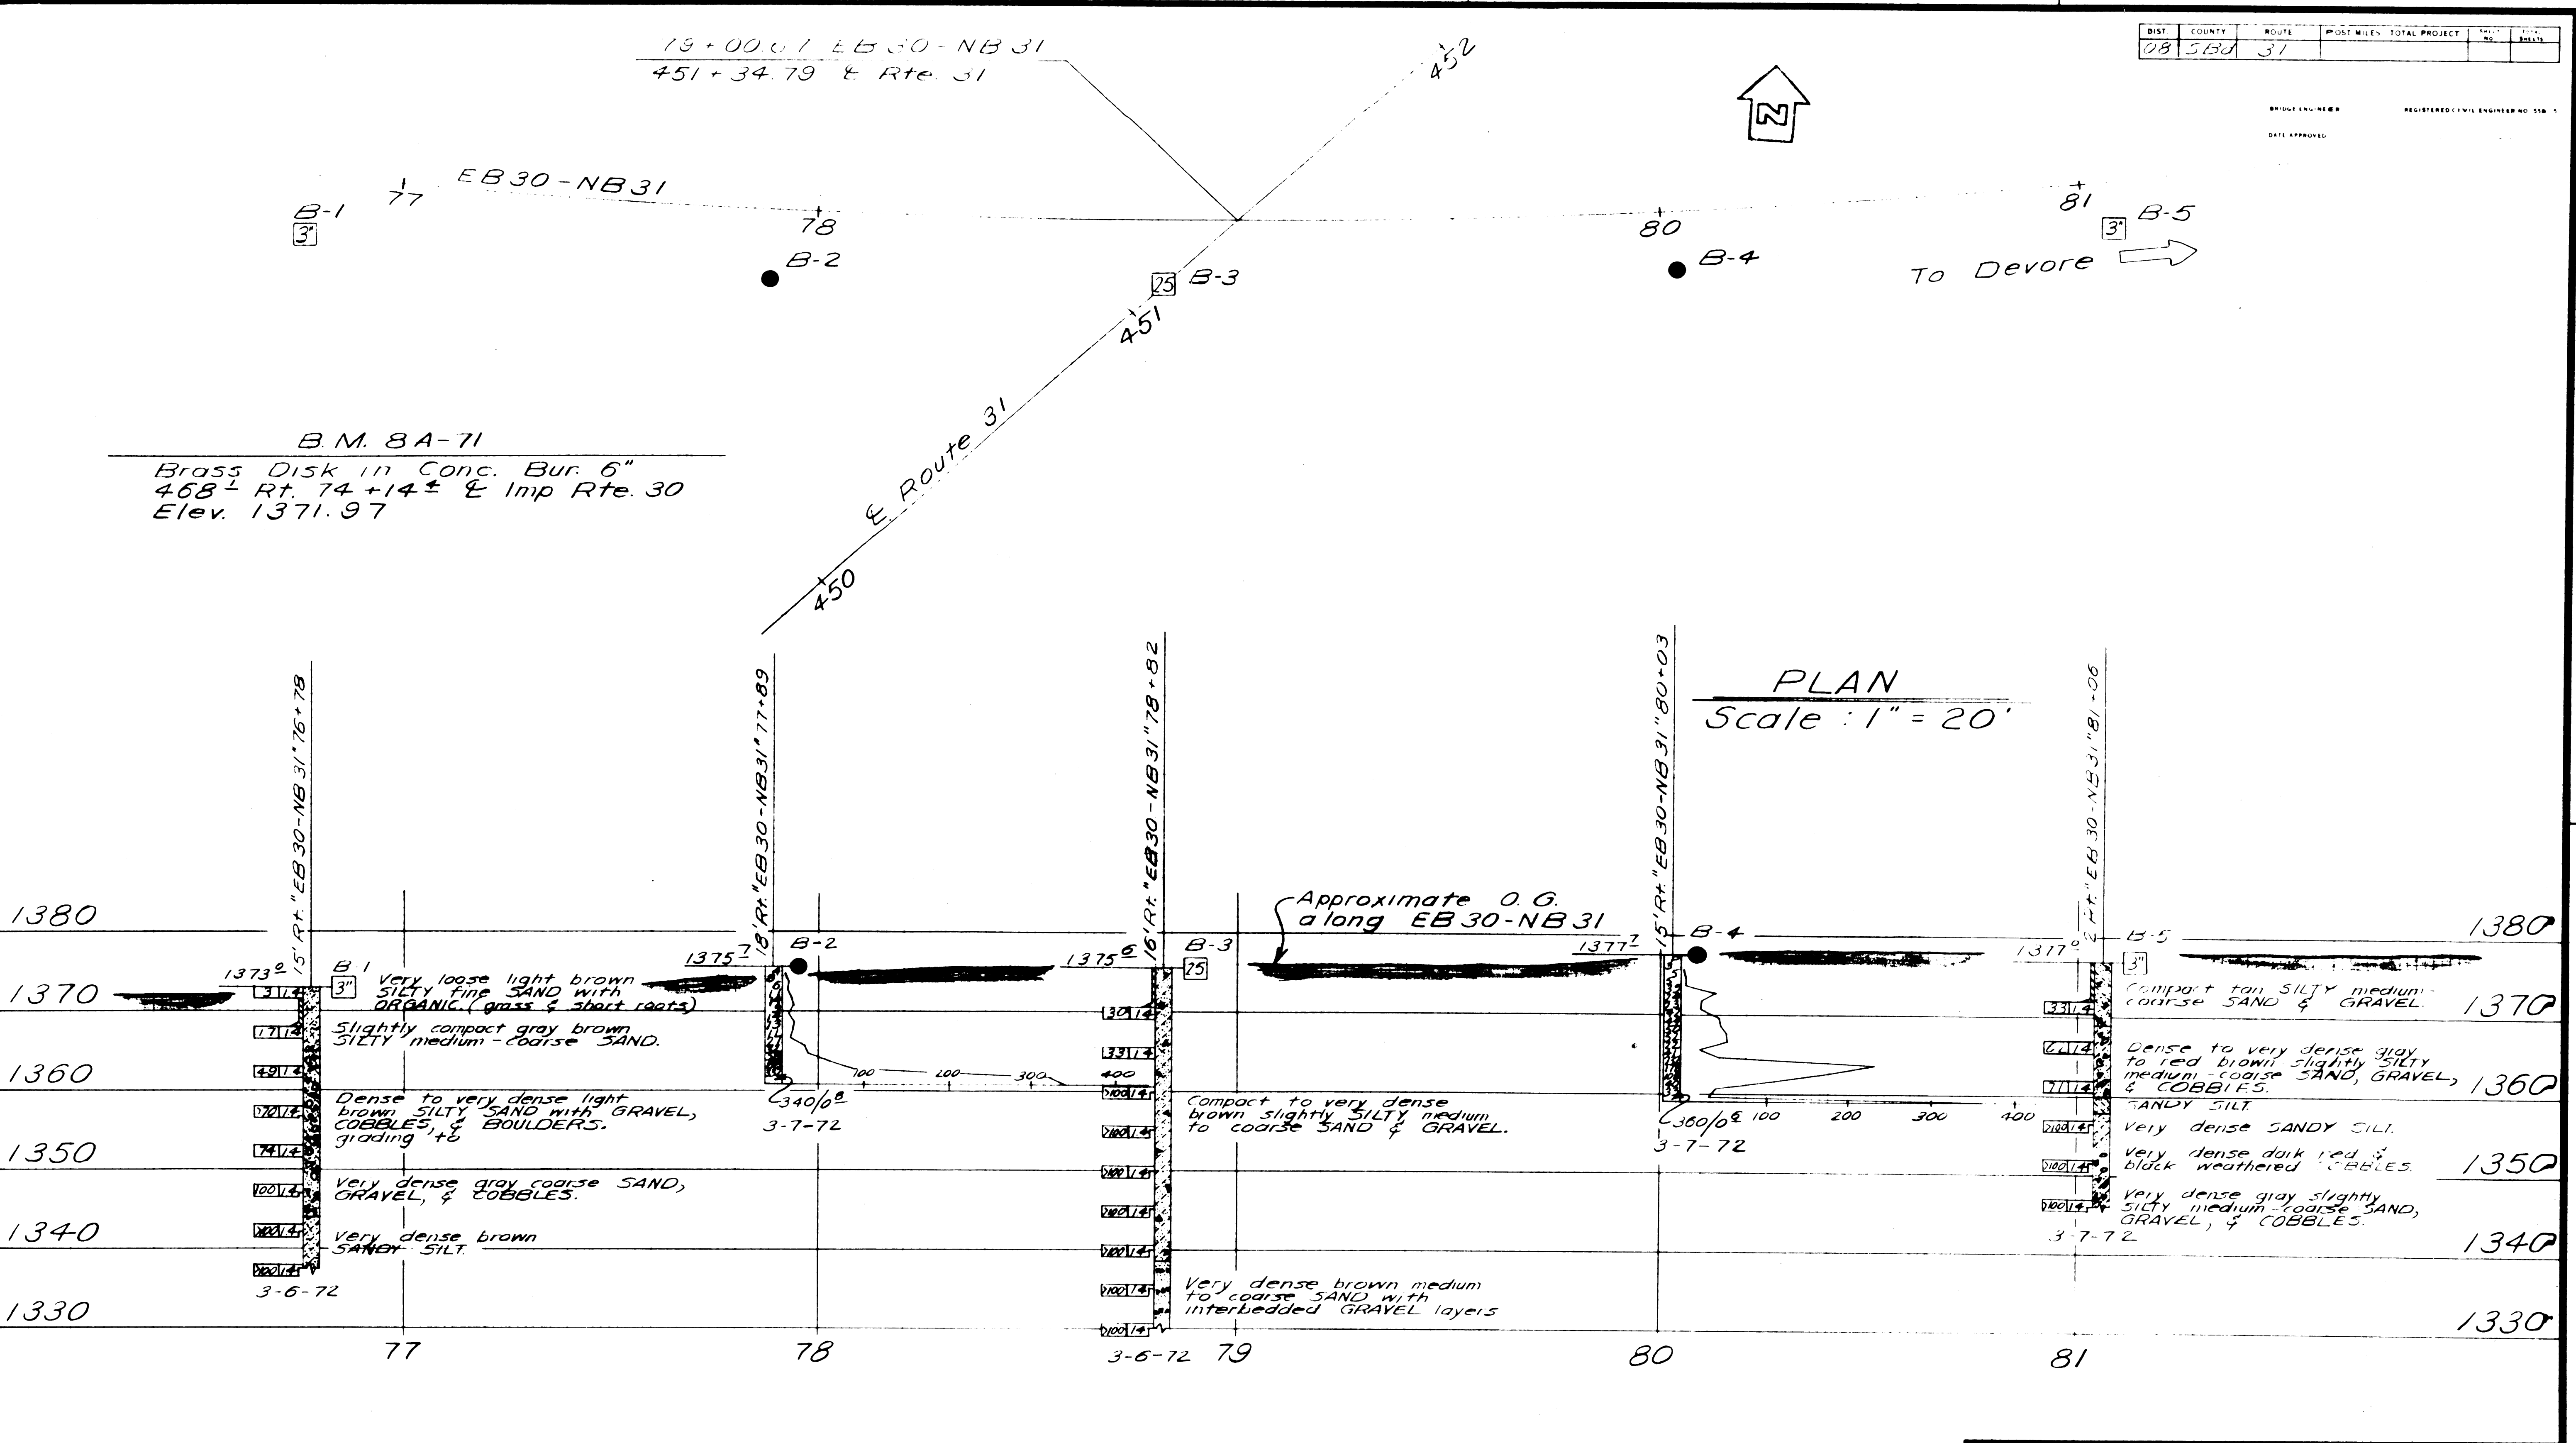

DIST	COUNTY	ROUTE	POST MILES	TOTAL PROJECT	SHEET NO.	TOTAL SHEETS
08	SBD	31				

BRIDGE ENGR. NO. _____ REGISTERED CIVIL ENGINEER NO. 516
 DATE APPROVED _____

BRIDGE DEPARTMENT
ENGINEERING GEOLOGY SECTION

FIELD STUDY by R. FOX 3-72
 DRAWN by S. KALININ 3-22-72
 CHECKED by R. FOX 3-72

Approval Recommended by _____ Engineering Geologist
 Certified Engineering Geologist No. _____

STATE OF CALIFORNIA
 TRANSPORTATION AGENCY
 DEPARTMENT OF PUBLIC WORKS
 DIVISION OF HIGHWAYS

SOUTHWEST CONNECTOR OVERCROSSING






LOG OF TEST BORINGS

BRIDGE NO. 54-966	POST MILE B.1	DRAWING NO.	SHEET OF
REVISION DATES (PRELIMINARY STAGE ONLY)			

WO 132900
 CU 08201

Discard prints bearing earlier revision dates

SR 210 / I-15 Separation

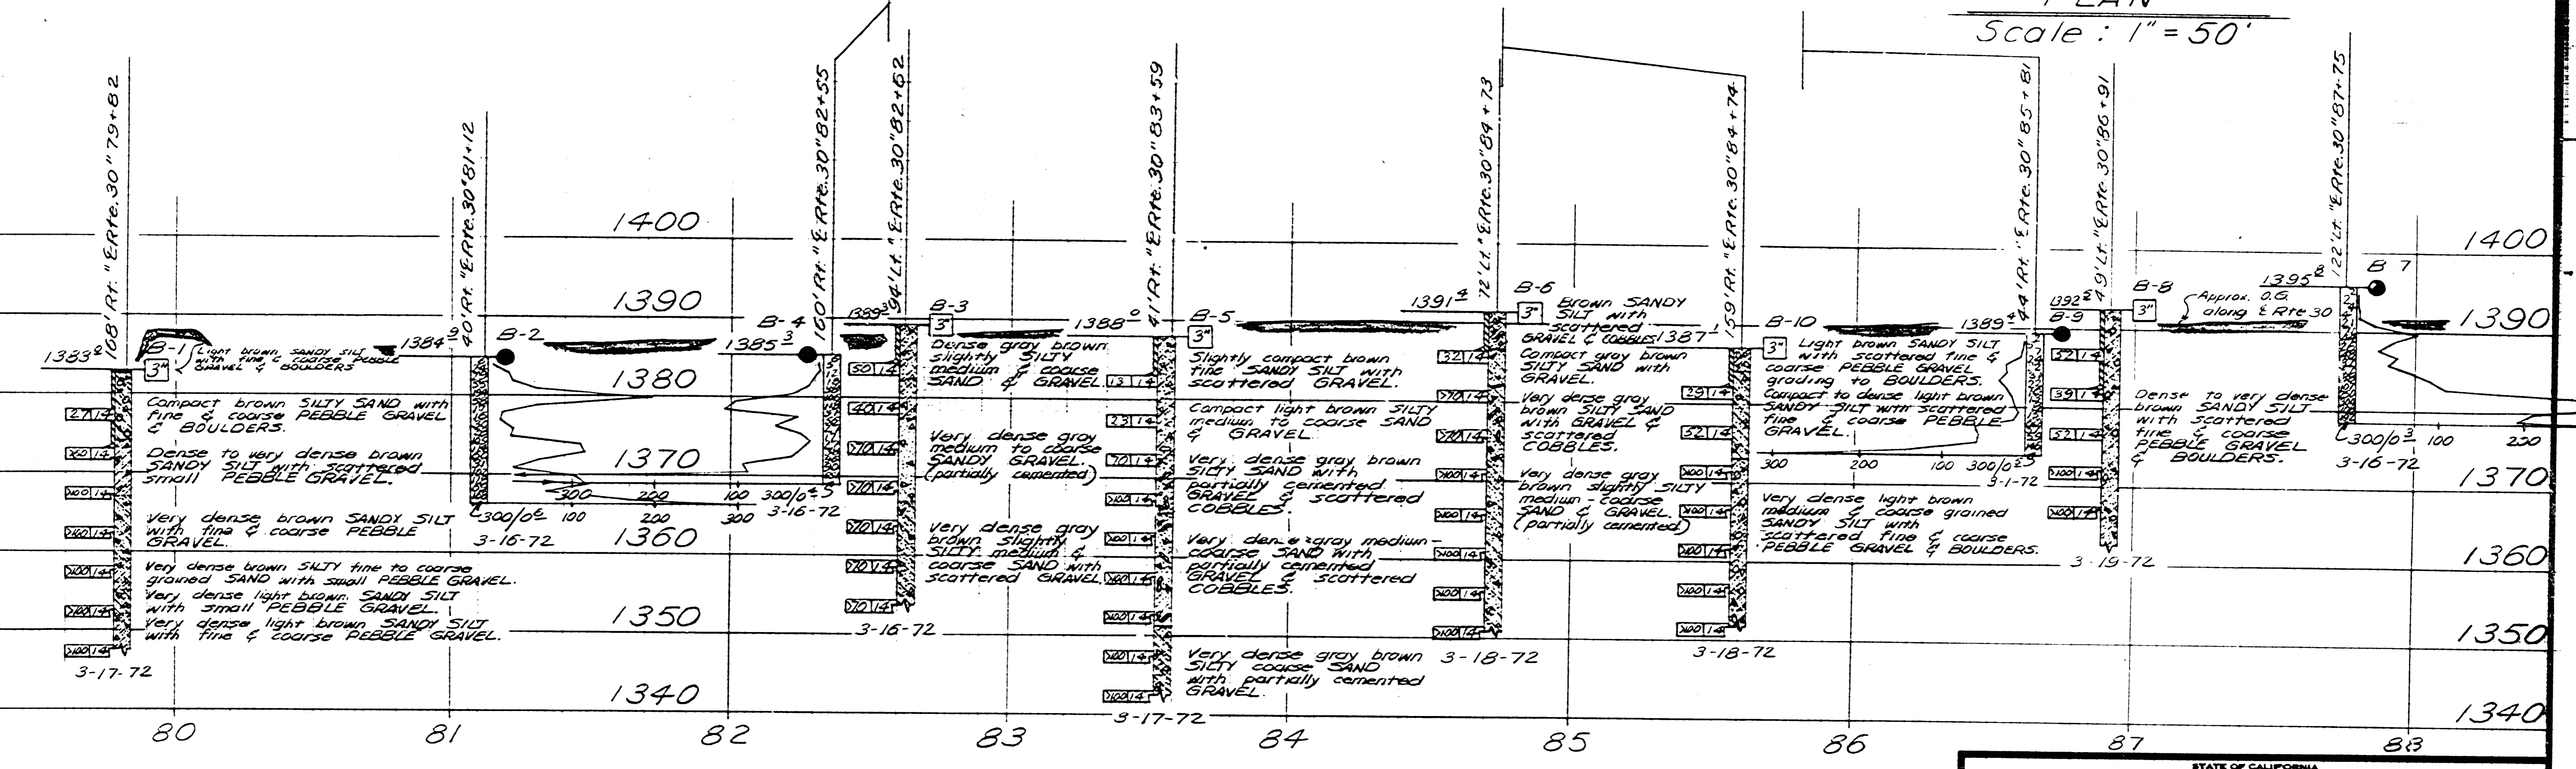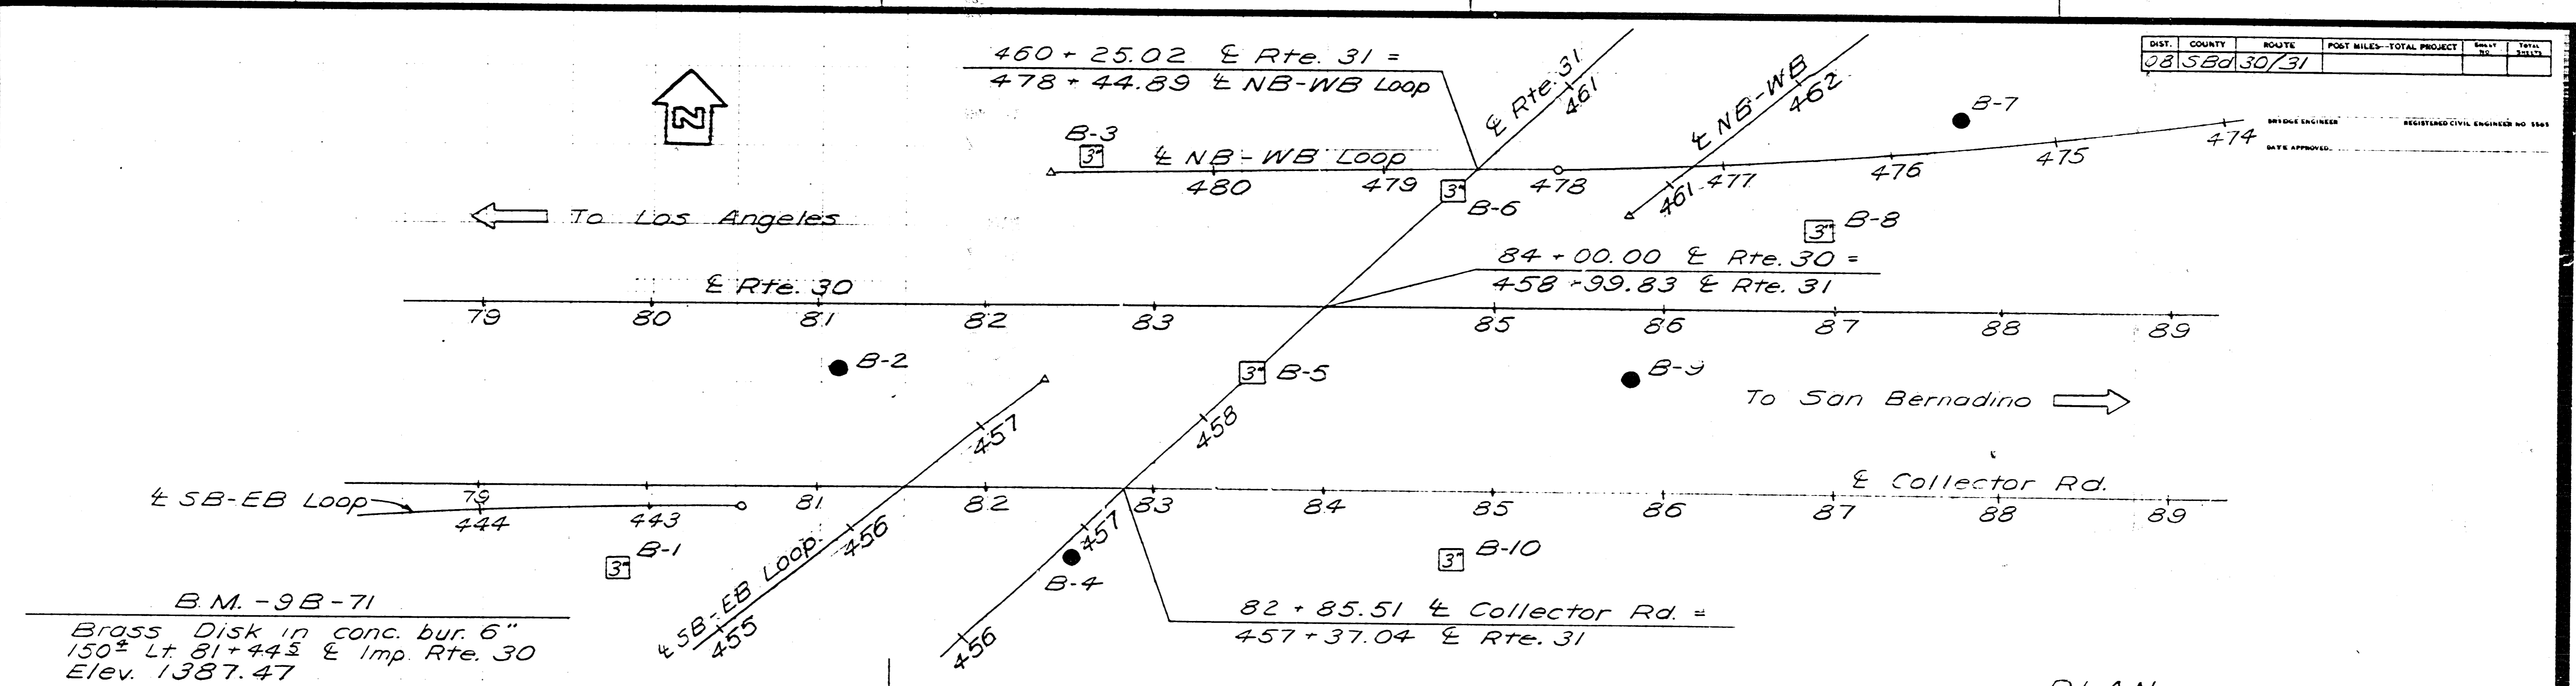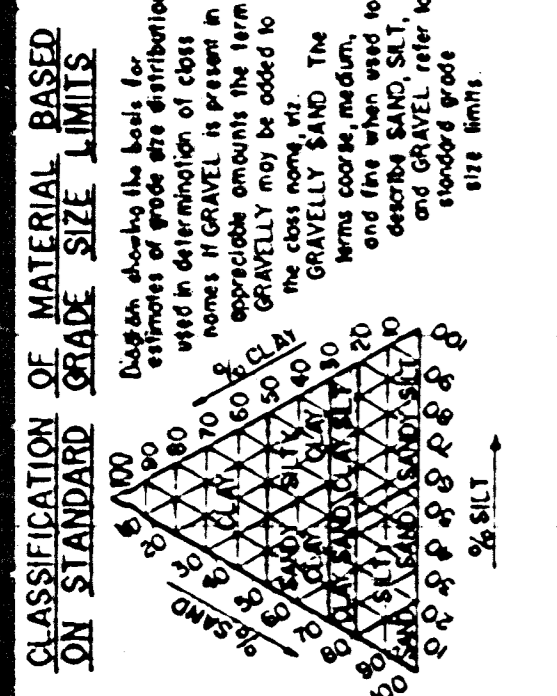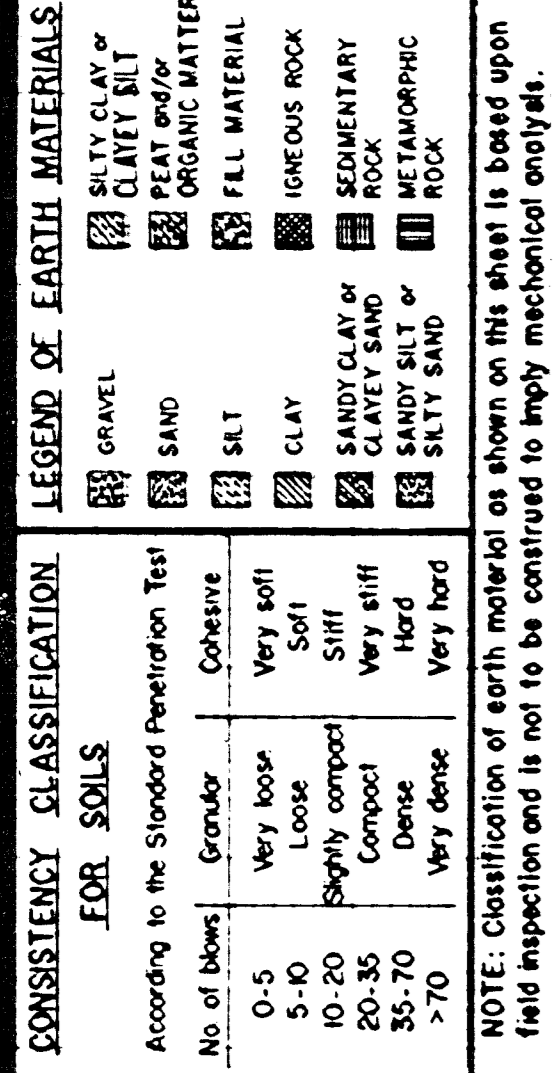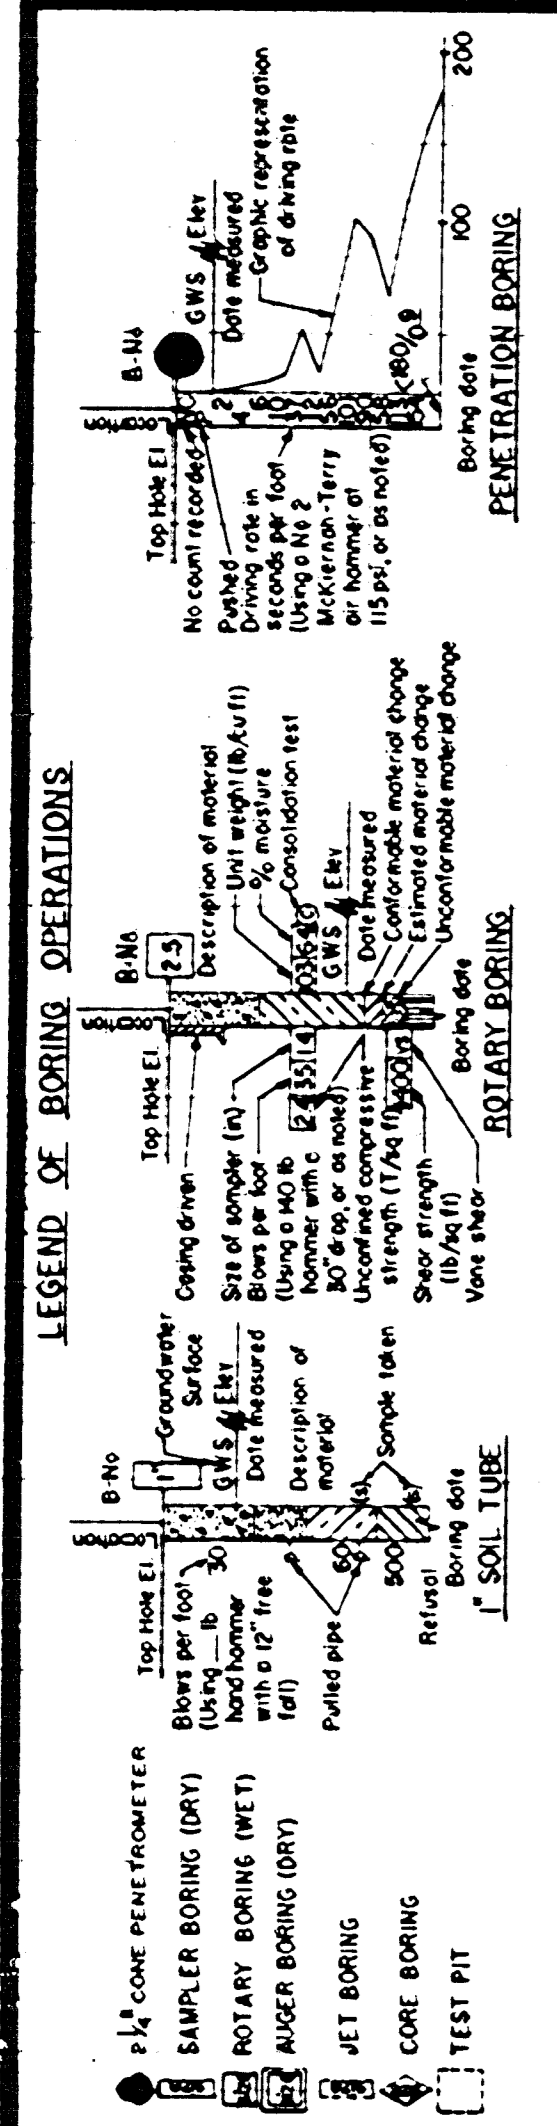

NO GROUND WATER ENCOUNTERED DURING THIS INVESTIGATION BY BRIDGE DEPT. GEOLOGY SECTION DATE 3-72

PROFILE
Scale: Horiz. 1" = 30'
Vert. 1" = 10'

BRIDGE DEPARTMENT
ENGINEERING GEOLOGY SECTION
FIELD STUDY by R. FOX 3-72
DRAWN by S. KAWAMURA 4-24-72
CHECKED by R. FOX 5-30-72

STATE OF CALIFORNIA
TRANSPORTATION AGENCY
DEPARTMENT OF PUBLIC WORKS
DIVISION OF HIGHWAYS

ROUTE 30/31 SEPARATION

LOG OF TEST BORINGS

BRIDGE NO. 54-961 R/L	POST MILE 11.8	DRAWING NO.	SHEET	OF
REVISION DATES (PRELIMINARY STAGE ONLY)				

WO 17200/
CU 08201






Discard print bearing earlier revision dates

PRINTED ON 12.5 PAPER CLOTH

DIST	COUNTY	ROUTE	POST MILES TOTAL PROJECT	SHEET NO.	TOTAL SHEETS
08	Sbd	30			


PLANS APPROVAL DATE _____

THE STATE OF CALIFORNIA OR ITS OFFICERS OR AGENTS SHALL NOT BE RESPONSIBLE FOR THE ACCURACY OR COMPLETENESS OF ELECTRONIC COPIES OF THIS PLAN SHEET.

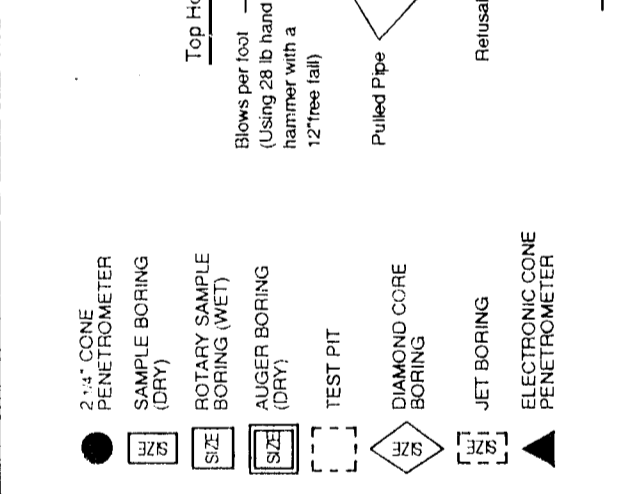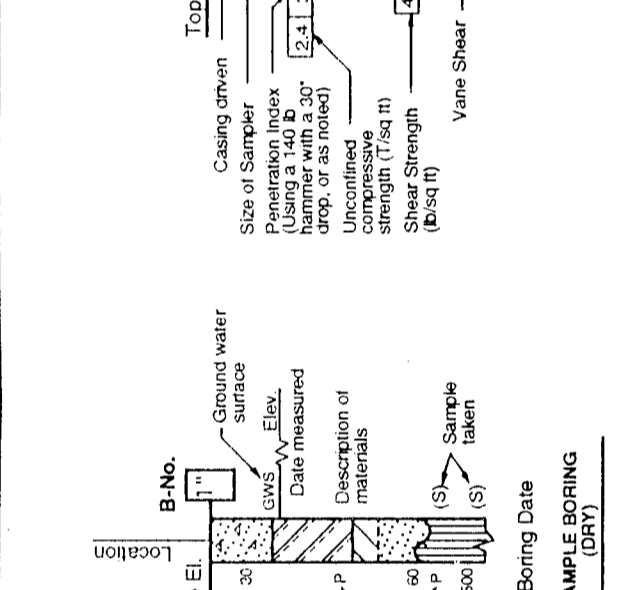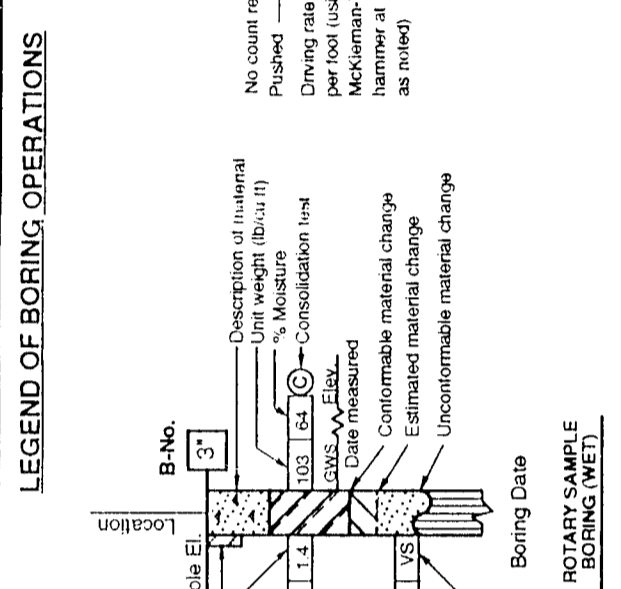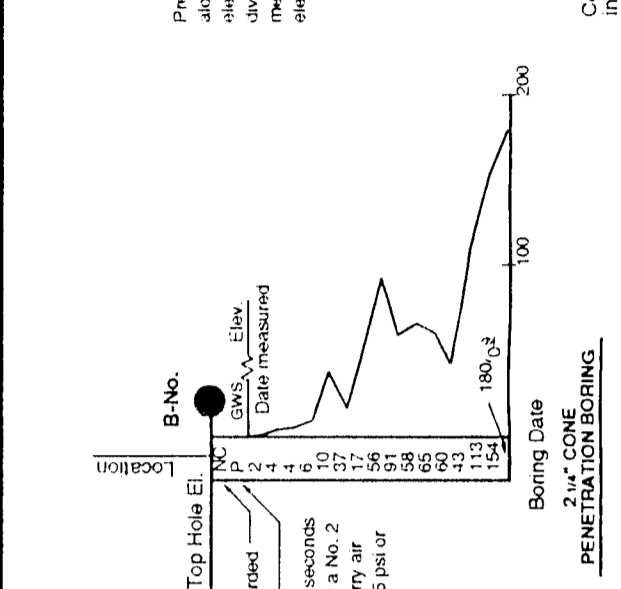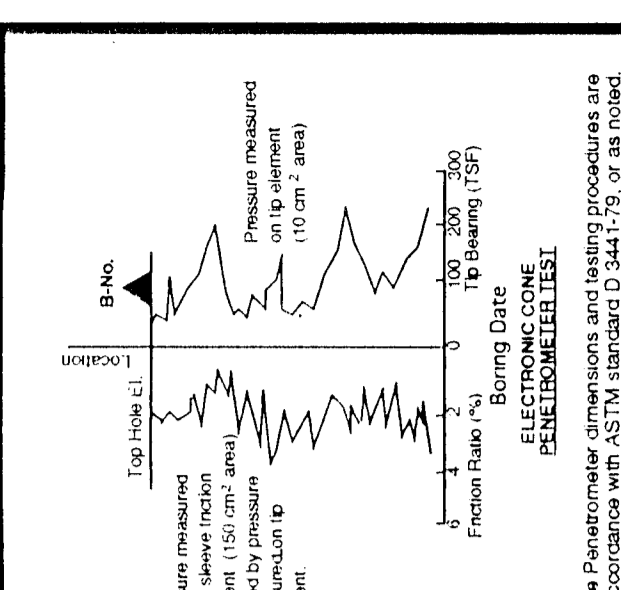


CONSISTENCY CLASSIFICATION FOR SOILS	
Penetration (Blows/Ft)	Consistency
0-4	Very Loose
5-9	Loose
10-19	Slightly compact
20-29	Compact
30-59	Dense
>70	Very Dense

NOTE: Classification of earth material as shown on this sheet is based upon field inspection and is not to be construed to imply mechanical analysis.

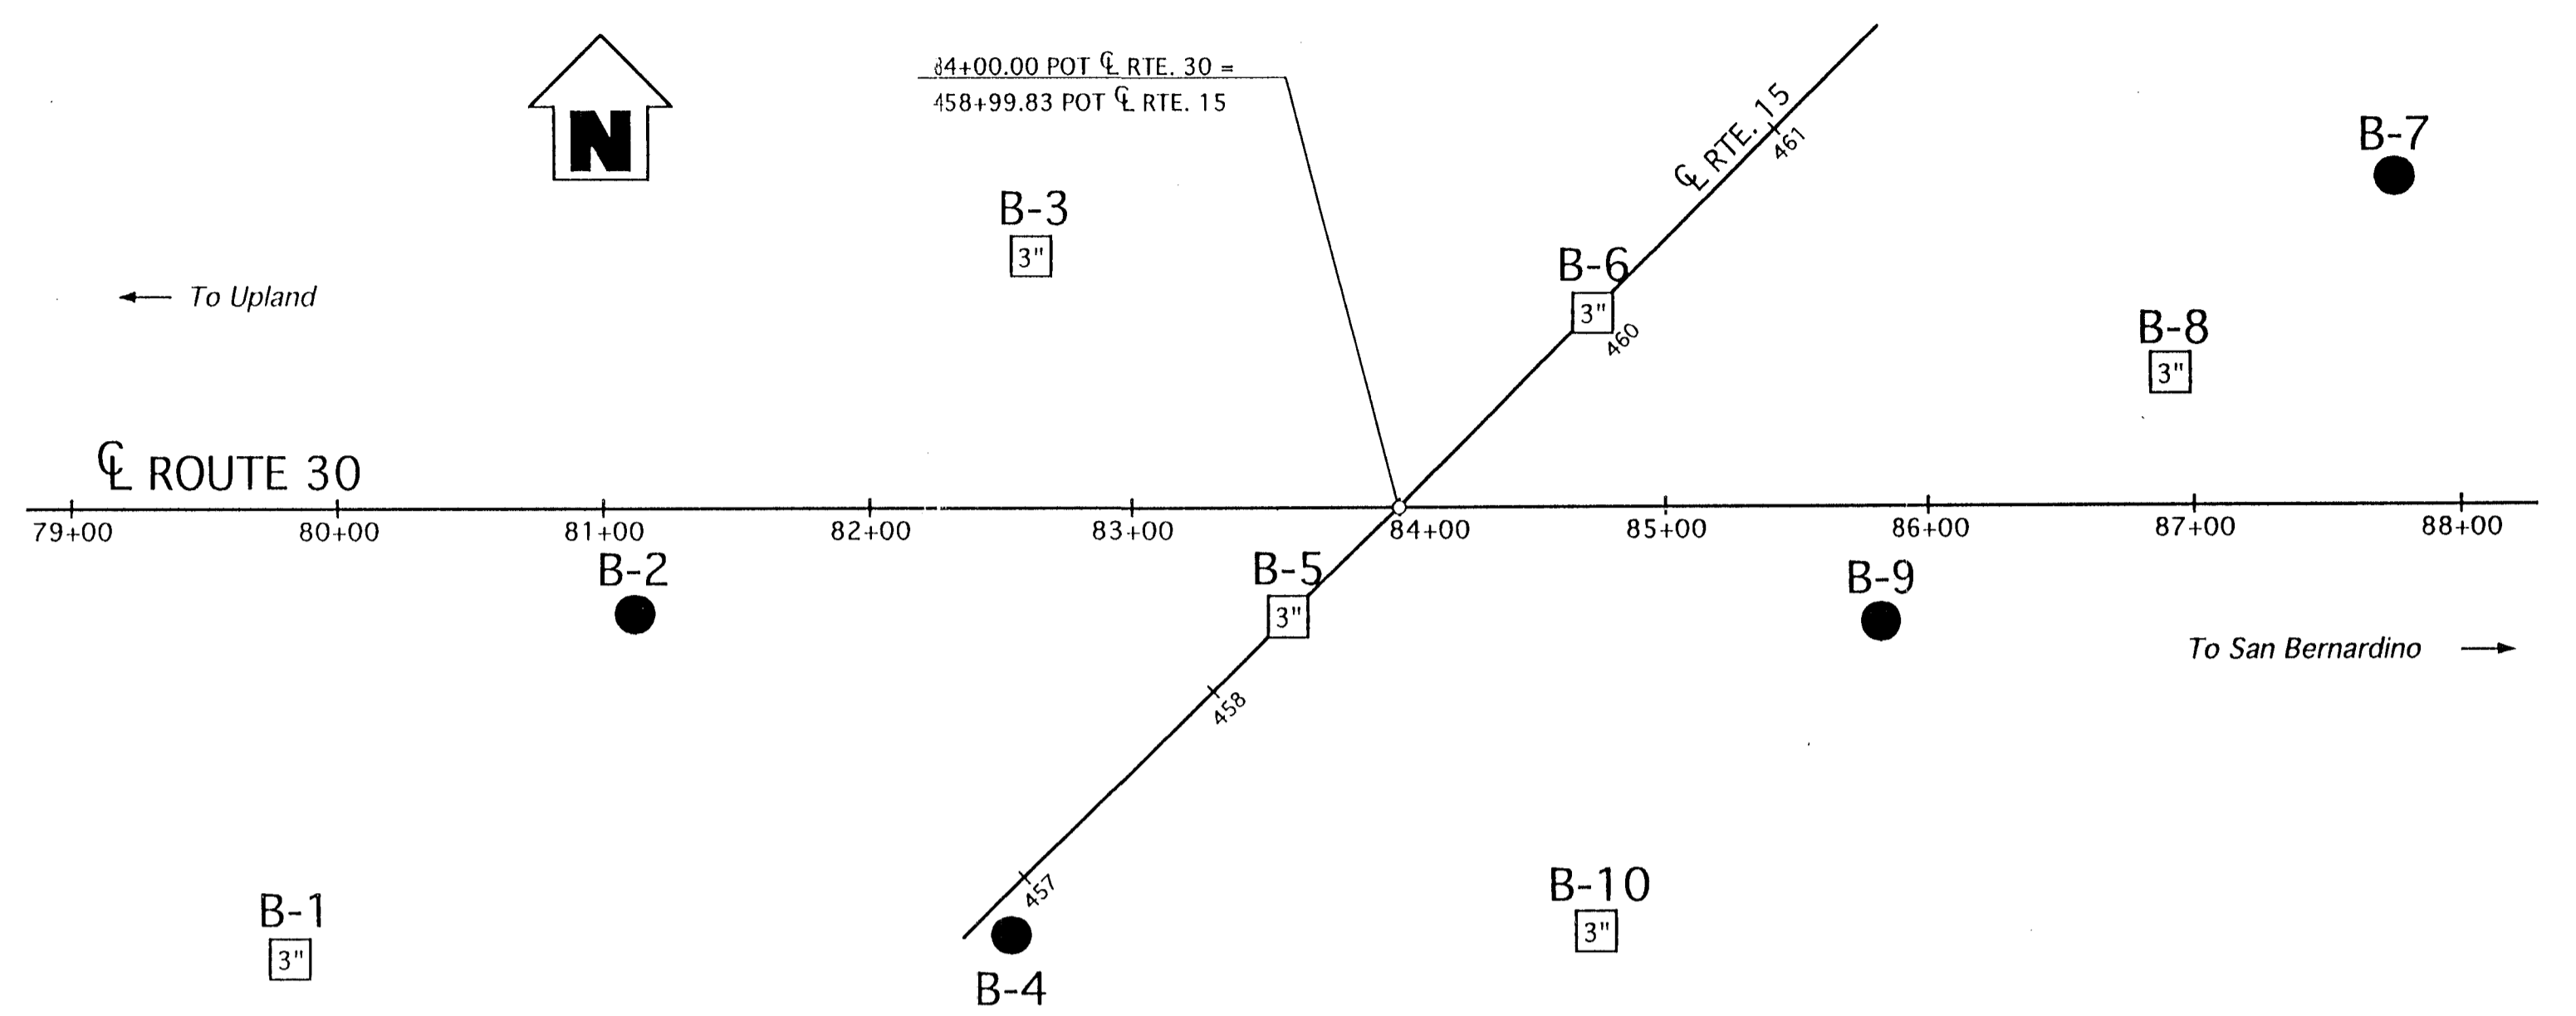

BENCH MARK
BRASS DISK IN CONC. BUR. 6" 150± LT.
81+44.5 C/L IMP. RTE. 30.
ELEV. 1387.47

NOTE: NO GROUND WATER ENCOUNTERED DURING FIELD INVESTIGATION.

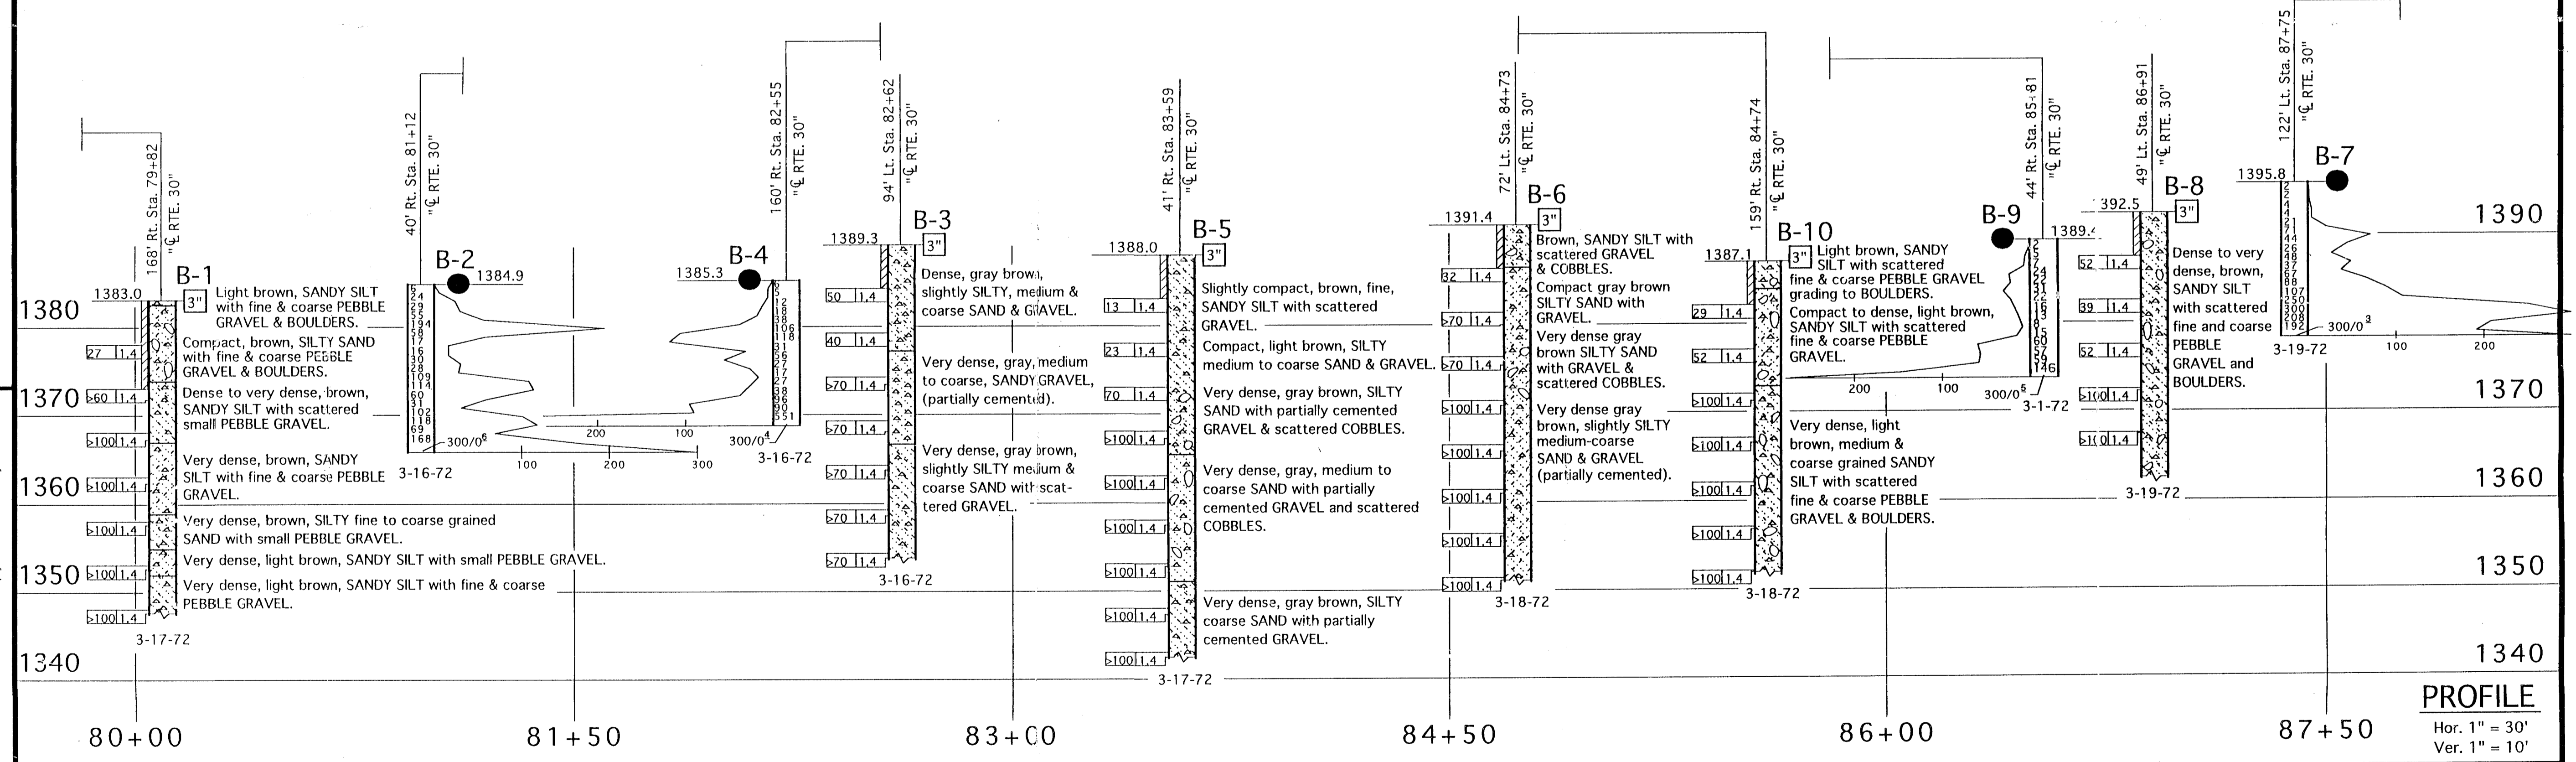

ENGINEERING SERVICE CENTER	STRUCTURE FOUNDATIONS	FIELD INVESTIGATION BY: R.W. FOX	State of CALIFORNIA DEPARTMENT OF TRANSPORTATION	DIVISION OF STRUCTURES STRUCTURE DESIGN	BRIDGE NO. 54-0961 POST MILE R11.6	ROUTE 15/30 SEPARATION LOG OF TEST BORINGS
DRAWN BY Sara Valencia	5/96					
CHECKED BY						



S15-E210 Connector Separation

DIST	COUNTY	ROUTE	POST MILES TOTAL PROJECT	SHEET NO.	TOTAL SHEETS
08	Sbd	30/31			



REGISTERED ENGINEERING GEOLOGIST

PLANS APPROVAL DATE

THE STATE OF CALIFORNIA OR ITS OFFICERS OR AGENTS SHALL NOT BE RESPONSIBLE FOR THE ACCURACY OR COMPLETENESS OF ELECTRONIC COPIES OF THIS PLAN SHEET.

LEGEND OF BORING OPERATIONS

2 1/4" CONE PETER
 SAMPLER BORING (DRY)
 ROTARY SAMPLER BORING (WET)
 AUGER BORING (DRY)
 TEST PIT
 JET BORING
 ELECTRONIC CONE PENETROMETER

LEGEND OF EARTH MATERIALS

GRAVEL
 SAND
 SILT
 CLAY
 SANDY CLAY or CLAYEY SAND
 SILTY SAND
 SILTY CLAY

CLAYEY SILT
 PEAT and/or ORGANIC MATTER
 FILL MATERIAL
 IGNEOUS ROCK
 SEDIMENTARY ROCK
 CLAYEY SAND
 SILTY SAND
 SILTY CLAY

CONSISTENCY CLASSIFICATION FOR SOILS
 According to the Standard Penetration Test

Penetration Index (Blows/Ft)	Consistency
0-4	Very Soft
5-9	Soft
10-19	Slightly compact
20-34	Compact
35-59	Dense
>70	Very Dense

LEGEND OF BORING OPERATIONS (continued)

2 1/4" CONE PETER
 SAMPLER BORING (DRY)
 ROTARY SAMPLER BORING (WET)
 AUGER BORING (DRY)
 TEST PIT
 JET BORING
 ELECTRONIC CONE PENETROMETER


LEGEND OF BORING OPERATIONS (continued)

2 1/4" CONE PETER
 SAMPLER BORING (DRY)
 ROTARY SAMPLER BORING (WET)
 AUGER BORING (DRY)
 TEST PIT
 JET BORING
 ELECTRONIC CONE PENETROMETER

BENCH MARK


BM #1-11-86 Elev. 1410.54'
 AERIAL TARGET LOCATED ON RIGHT SHOULDER APPROX. 90± RIGHT OF STATION 469+30± C/L ROUTE 15.

BM #1-12-86 Elev. 1421.12
 AERIAL TARGET LOCATED ON RIGHT SHOULDER APPROX. 95± RIGHT OF STATION 474+15± C/L ROUTE 15.

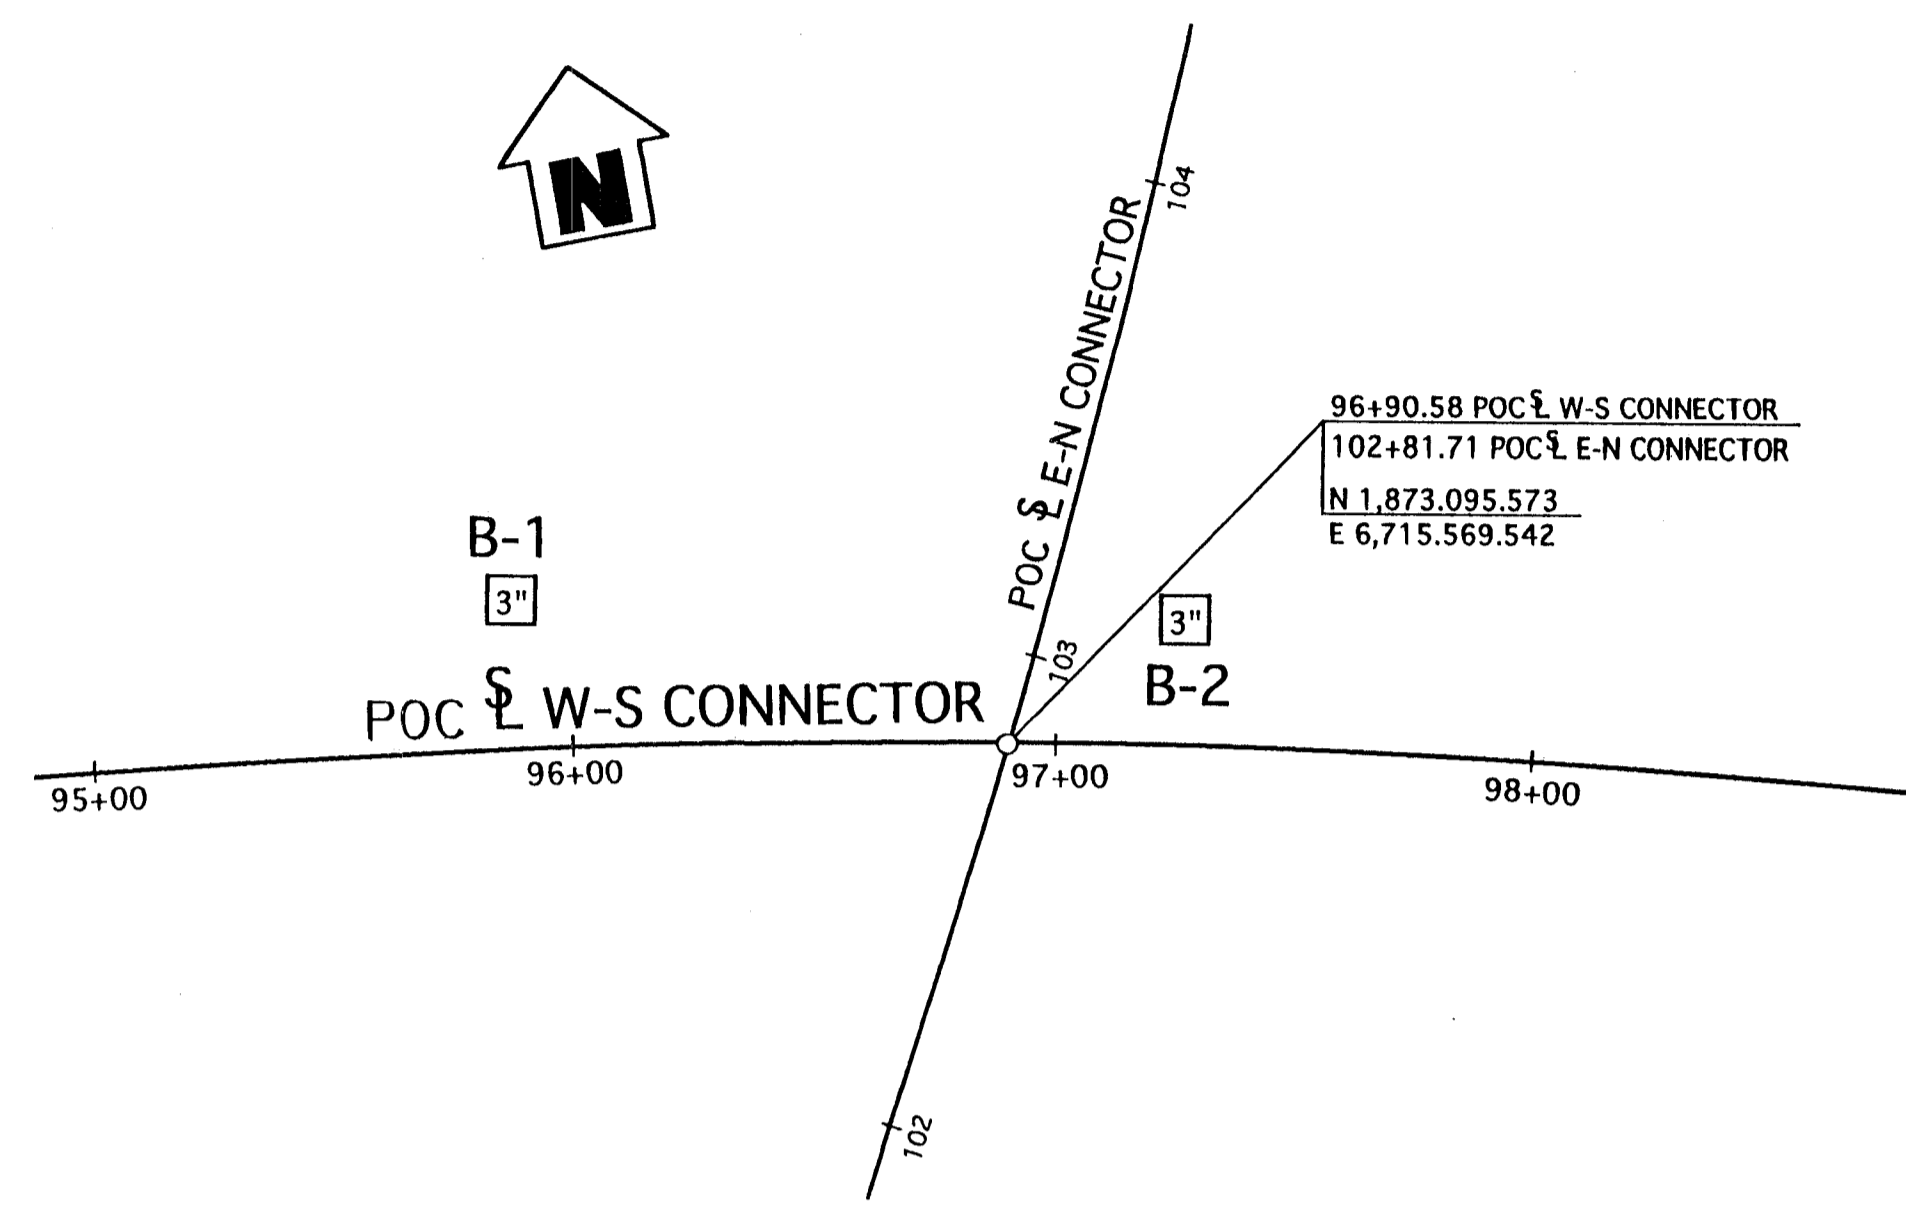

PLAN
 1" = 40'

NOTE: NO GROUND WATER ENCOUNTERED DURING FIELD INVESTIGATION.

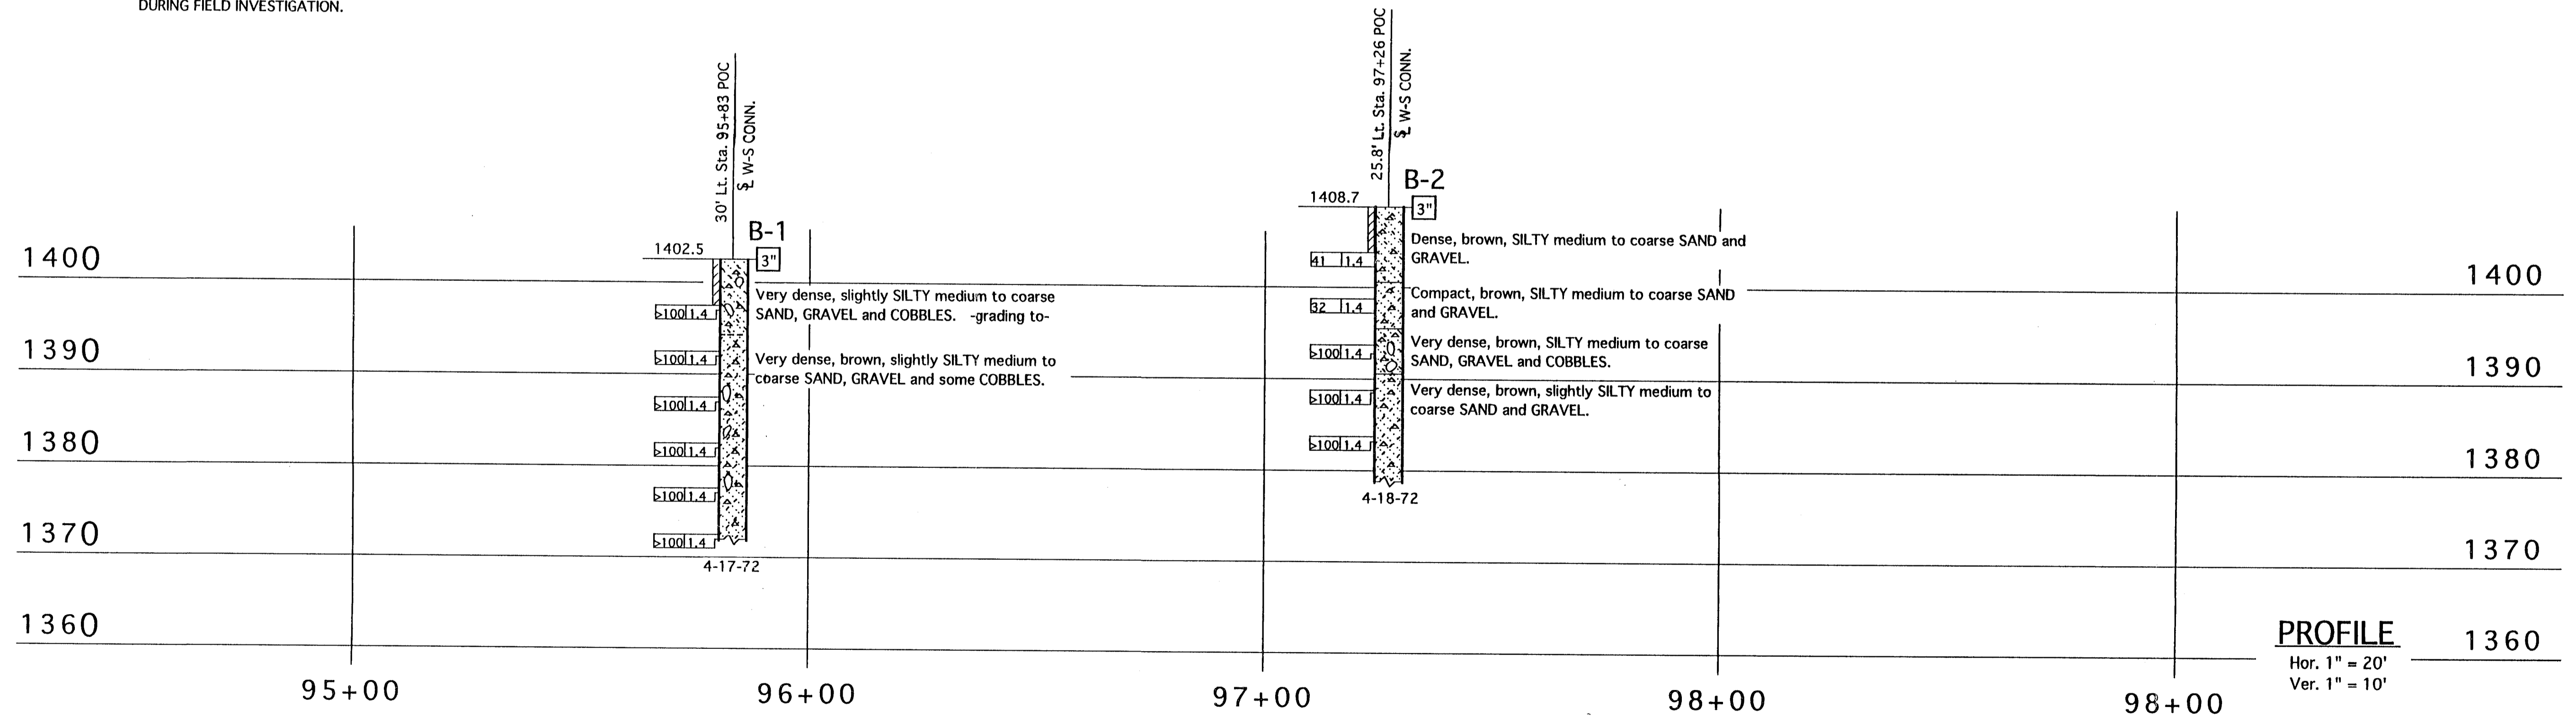



PROFILE
 Hor. 1" = 20'
 Ver. 1" = 10'

ENGINEERING SERVICE CENTER	STRUCTURE FOUNDATIONS	FIELD INVESTIGATION BY: R.W. FOX 4/72	State of CALIFORNIA DEPARTMENT OF TRANSPORTATION	DIVISION OF STRUCTURES STRUCTURE DESIGN	BRIDGE NO. 54-0959F POST MILE R11.9-Fna	WESTSOUTH CONNECTOR SEPARATION LOG OF TEST BORINGS
DRAWN BY Sana Senerca 3/96	CHECKED BY					
ORIGINAL SCALE IN INCHES FOR REDUCED PLANS → 0 1 2 3			CU: 08236 EA: 204301	DISREGARD PRINTS BEARING EARLIER REVISION DATES →		REVISION DATES (PRELIMINARY STAGE ONLY)
						SHEET OF

DIST	COUNTY	ROUTE	POST MILES TOTAL PROJECT	SHEET NO.	TOTAL SHEETS
08	Sbd	15,30	7.1/10.1 R10.0/R13.1	987	1184

REGISTERED PROFESSIONAL ENGINEER M. DESALVATORE No. 39499 Exp. 12-31-97 CIVIL STATE OF CALIFORNIA	
8-4-97	
PLANS APPROVAL DATE	

THE STATE OF CALIFORNIA OR ITS OFFICERS OR AGENTS SHALL NOT BE RESPONSIBLE FOR THE ACCURACY OR COMPLETENESS OF ELECTRONIC COPIES OF THIS PLAN SHEET.

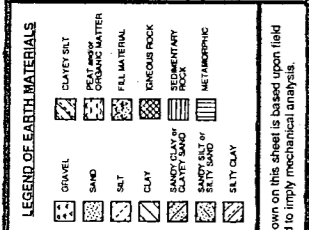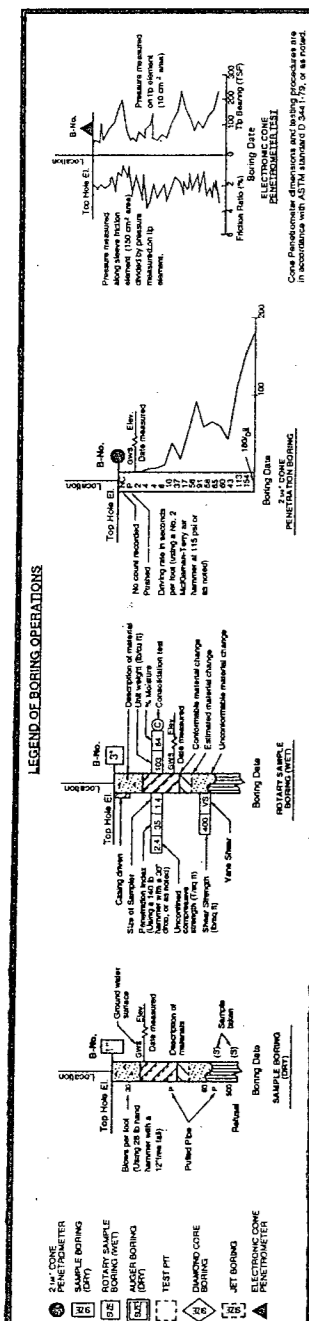


CONSISTENCY CLASSIFICATION FOR SOILS

According to the Standard Penetration Test


Penetration Index (Blows / Ft)	Cohesive	Non-Cohesive
0-4	Very Soft	Very Loose
5-9	Soft	Loose
10-19	Slightly compact	Medium
20-34	Compact	Dense
35-69	Very Hard	Very Dense
>70	Very Hard	Very Dense

NOTE: Classification of earth material as shown on this sheet is based upon field inspection and is not to be construed to imply mechanical analysis.

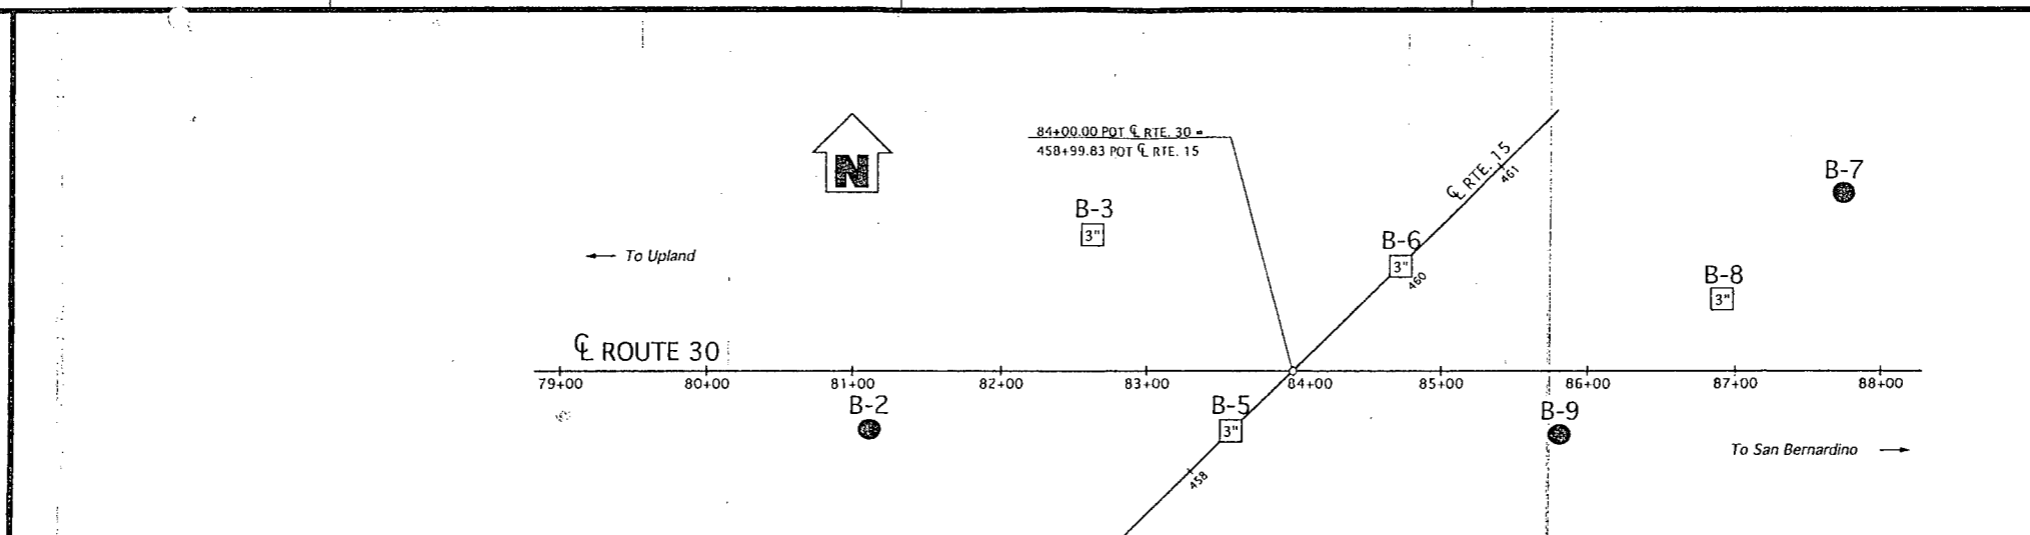


BENCH MARK
BRASS DISK IN CONC. BUR. 6" 150± LT.
81+44.5 C/L IMP. RTE. 30.
ELEV. 1387.47

NOTE: NO GROUND WATER ENCOUNTERED DURING FIELD INVESTIGATION.

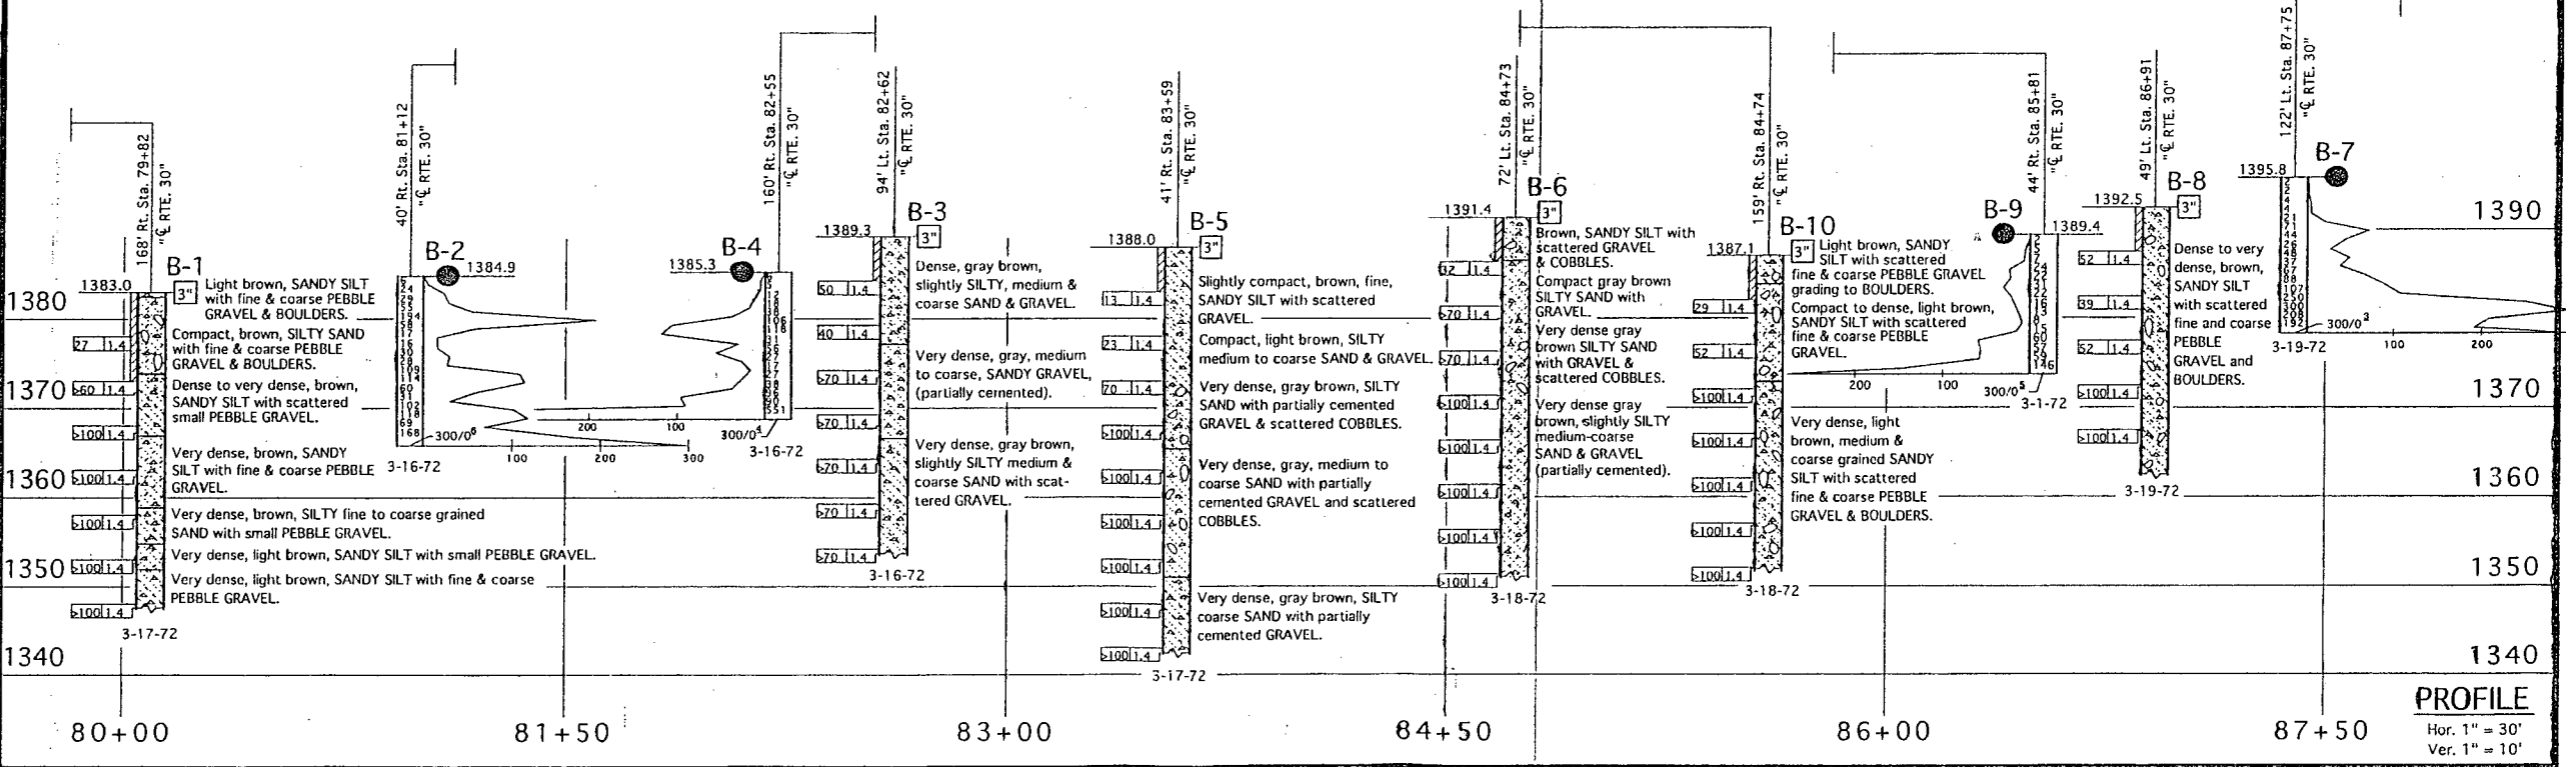

ENGINEERING SERVICE CENTER	STRUCTURE FOUNDATIONS	FIELD INVESTIGATION BY: R.W. FOX	State of CALIFORNIA DEPARTMENT OF TRANSPORTATION	DIVISION OF STRUCTURES STRUCTURE DESIGN	BRIDGE NO. 54-0961 POST MILE R11.6	ROUTE 15/30 SEPARATION LOG OF TEST BORINGS
DRAWN BY Sara Guerrero	5/96					
CHECKED BY						

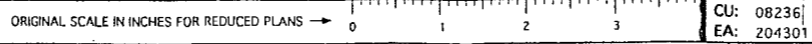

CU: 08236	DISREGARD PRINTS BEARING EARLIER REVISION DATES	REVISION DATES (PRELIMINARY STAGE ONLY)	SHEET 33 OF 33
-----------	---	---	----------------

DIST.	COUNTY	ROUTE	POST MILES—TOTAL PROJECT	SHEET NO.	TOTAL SHEETS
08	S.Bd	30/31 I.C.			

BRIDGE ENGINEER: REGISTERED CIVIL ENGINEER NO. 8645
 DATE APPROVED: _____

LEGEND OF BORING OPERATIONS

SOIL TUBE
 B No. _____
 Top Hole El. _____
 Blows per foot (with 14" T-bar) _____
 Refused _____
 1" SOIL TUBE

ROTARY BORING
 B No. _____
 Top Hole El. _____
 Description of material _____
 Unit weight (lb/cu ft) _____
 Moisture content (%) _____
 Consolidation test _____
 C.S.E. El. _____
 Ditch required _____
 Unconfined compressive strength (lb/sq. in.) _____
 Shear strength _____
 Vane shear _____
 Vane test _____
 Rotary boring _____
 Unconfined compressive strength (lb/sq. in.) _____
 Shear strength _____
 Vane shear _____
 Vane test _____

3/4" CONE PENETROMETER
 B No. _____
 Top Hole El. _____
 Blows per foot (with 14" T-bar) _____
 Refused _____
 3/4" CONE PENETROMETER

SAMPLER BORING (DRY)
 B No. _____
 Top Hole El. _____
 Blows per foot (with 14" T-bar) _____
 Refused _____
 SAMPLER BORING (DRY)

ROTARY BORING (WET)
 B No. _____
 Top Hole El. _____
 Blows per foot (with 14" T-bar) _____
 Refused _____
 ROTARY BORING (WET)

AUGER BORING (DRY)
 B No. _____
 Top Hole El. _____
 Blows per foot (with 14" T-bar) _____
 Refused _____
 AUGER BORING (DRY)

JET BORING
 B No. _____
 Top Hole El. _____
 Blows per foot (with 14" T-bar) _____
 Refused _____
 JET BORING

CORE BORING
 B No. _____
 Top Hole El. _____
 Blows per foot (with 14" T-bar) _____
 Refused _____
 CORE BORING

TEST PIT
 B No. _____
 Top Hole El. _____
 Blows per foot (with 14" T-bar) _____
 Refused _____
 TEST PIT

LEGEND OF EARTH MATERIALS

GRAVEL
 SILTY CLAY or CLAYEY SILT
 PEAT and/or ORGANIC MATTER
 FILL MATERIAL
 IGNEOUS ROCK
 SEDIMENTARY ROCK
 METAMORPHIC ROCK


CONSISTENCY CLASSIFICATION FOR SOILS
 According to the Standard Penetration Test
 No. of blows
 0-5 Very loose
 5-10 Loose
 10-20 Slightly compact
 20-35 Compact
 35-70 Dense
 >70 Very dense

COHESIVE
 Very soft
 Soft
 Stiff
 Very stiff
 Hard
 Very hard

NOTE: Classification of earth material as shown on this sheet is based upon field inspection and is not to be construed to imply mechanical analysis.


CLASSIFICATION OF MATERIAL BASED ON STANDARD GRADE SIZE LIMITS

Diagram showing the basis for classification of soil in terms of percentage of coarse and fine material. The coarse fraction is defined as material passing the No. 4 sieve and retained on the No. 20 sieve. The fine fraction is defined as material passing the No. 20 sieve. The limits for classification are shown in the diagram.

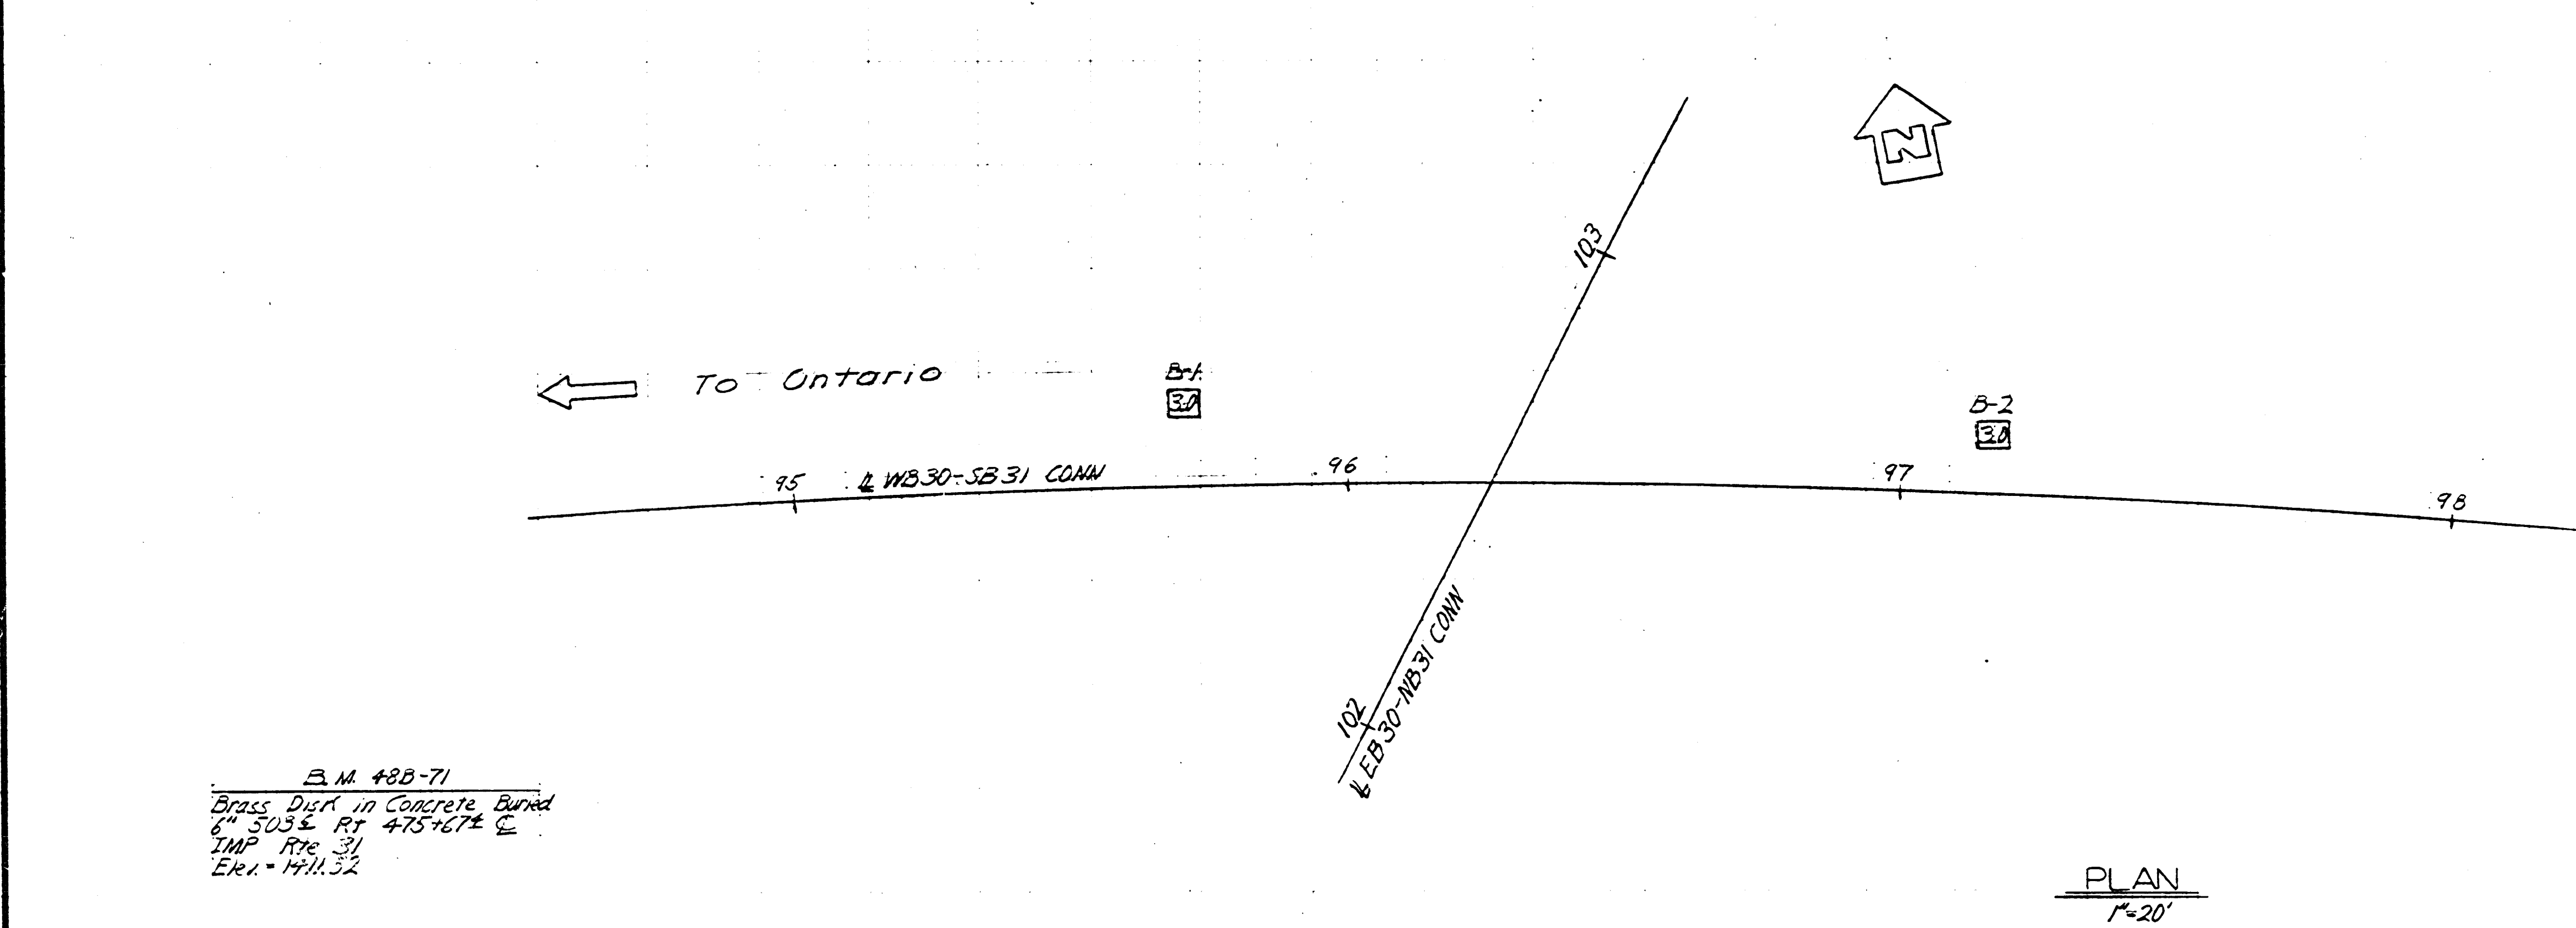

B.M. #88-71
 Brass Disk in Concrete Buried
 6" SDB & RT 475+67.4
 IMP. Rte. 31
 Elev. = 1411.52

PLAN
 1"=20'

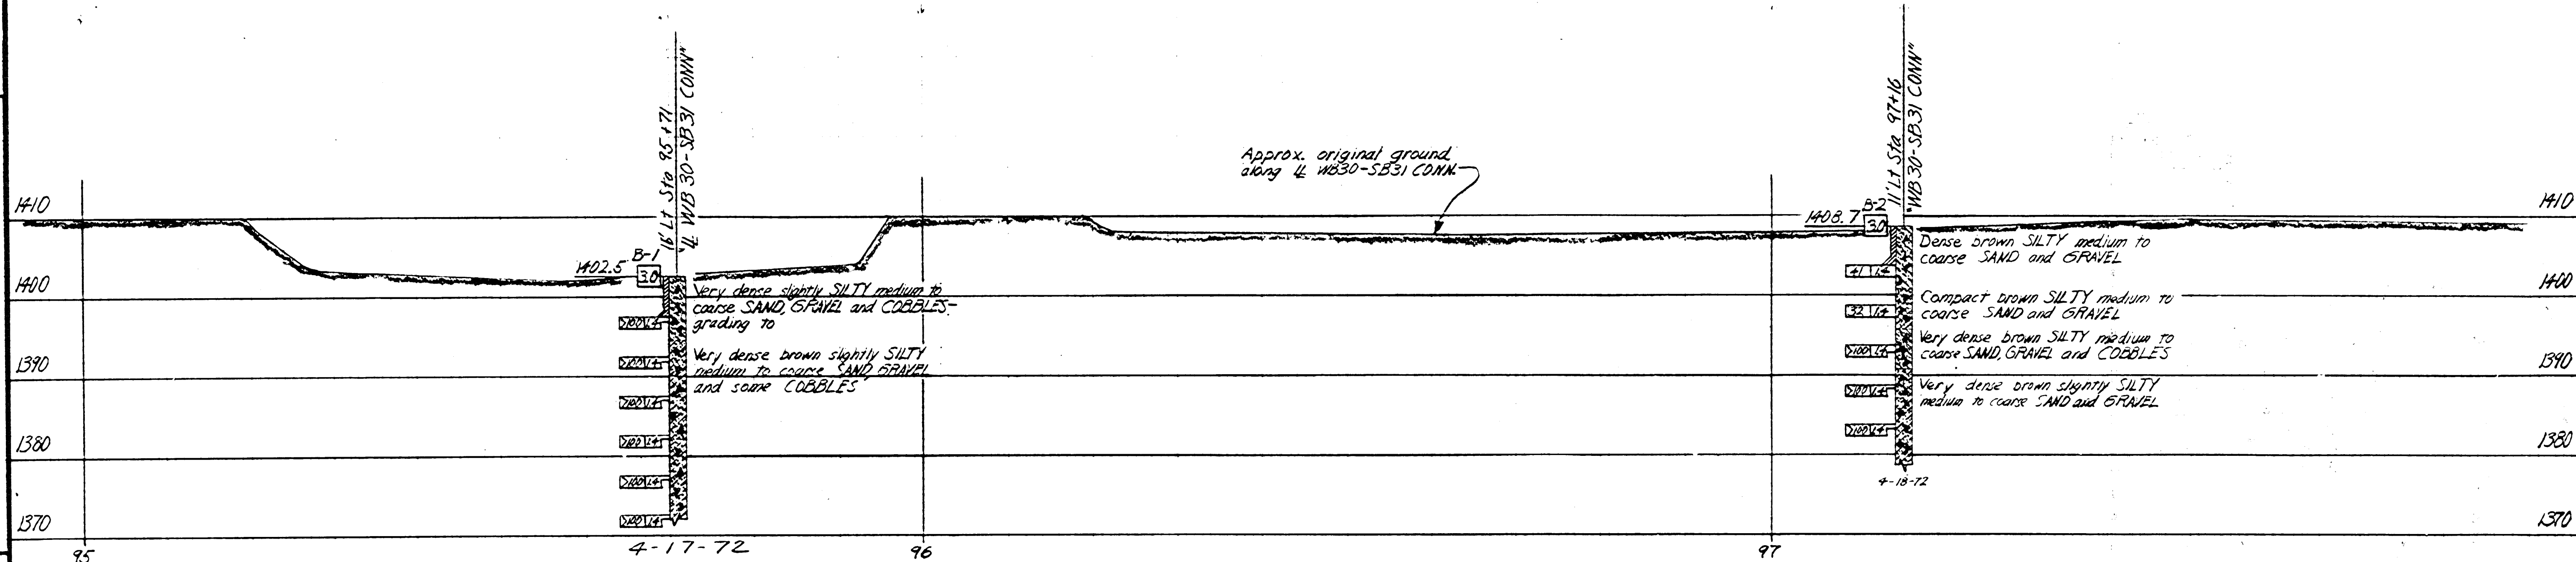

PROFILE
 1"=10'

NO GROUND WATER ENCOUNTERED DURING THIS INVESTIGATION BY BRIDGE DEPT. GEOLOGY SECTION DATE 4-18-72

BRIDGE DEPARTMENT
ENGINEERING GEOLOGY SECTION

FIELD STUDY by R. FOX 4-72
 DRAWN by D.G. SCHOTT 5-72
 CHECKED by R. FOX 5-30-72

Approval Recommended by _____
 Engineering Geologist
 Certified Engineering Geologist No. _____

STATE OF CALIFORNIA
 TRANSPORTATION AGENCY
 DEPARTMENT OF PUBLIC WORKS
 DIVISION OF HIGHWAYS

NORTHEAST CONNECTOR SEPARATION

LOG OF TEST BORINGS

BRIDGE NO. 54-959
 POST MILE R 12.0
 DRAWING NO. _____
 SHEET _____ OF _____

REVISION DATES (PRELIMINARY STAGE ONLY)

WO 173001
 CU 08201

Discard prints bearing earlier revision dates

W210-S15 Connector / I-15 Separation

DIST	COUNTY	ROUTE	POST MILES TOTAL PROJECT	SHEET NO.	TOTAL SHEETS
08	Sbd	30/31			

REGISTERED ENGINEERING GEOLOGIST	
PLANS APPROVAL DATE _____	

THE STATE OF CALIFORNIA OR ITS OFFICERS OR AGENTS SHALL NOT BE RESPONSIBLE FOR THE ACCURACY OR COMPLETENESS OF ELECTRONIC COPIES OF THIS PLAN SHEET.

LEGEND OF BORING OPERATIONS

2 1/4" CONE TESTER SAMPLE BORING (DRY)

ROTARY SAMPLE BORING (WET)

3" CONE TESTER SAMPLE BORING (DRY)

3" CONE TESTER SAMPLE BORING (WET)

3" CONE TESTER SAMPLE BORING (WET) WITH SAMPLING

3" CONE TESTER SAMPLE BORING (WET) WITH SAMPLING AND PENETROMETER

LEGEND OF EARTH MATERIALS

GRAVEL	CLAYEY SILT
SAND	PEAT AND/OR ORGANIC MATTER
SILT	FILL MATERIAL
CLAY	IGNEOUS ROCK
SANDY CLAY or CLAYEY SAND	SEDIMENTARY ROCK
SANDY SILT or SILTY SAND	METAMORPHIC
SILTY CLAY	

CONSISTENCY CLASSIFICATION FOR SOILS

According to the Standard Penetration Test


Penetration Index (Blows/Ft)	Consistency
0-4	Very Soft
5-9	Soft
10-19	Slightly compact
20-34	Compact
35-59	Dense
>70	Very Dense

NOTE: Classification of earth material as shown on this sheet is based upon field inspection and is not to be construed to imply mechanical analysis.

BENCH MARK


BM #1-11-86 Elev. 1410.54'
AERIAL TARGET LOCATED ON RIGHT SHOULDER APPROX. 90± RIGHT OF STATION 469+30± C/L ROUTE 15.

BM #1-12-86 Elev. 1421.12
AERIAL TARGET LOCATED ON RIGHT SHOULDER APPROX. 95± RIGHT OF STATION 474+15± C/L ROUTE 15.

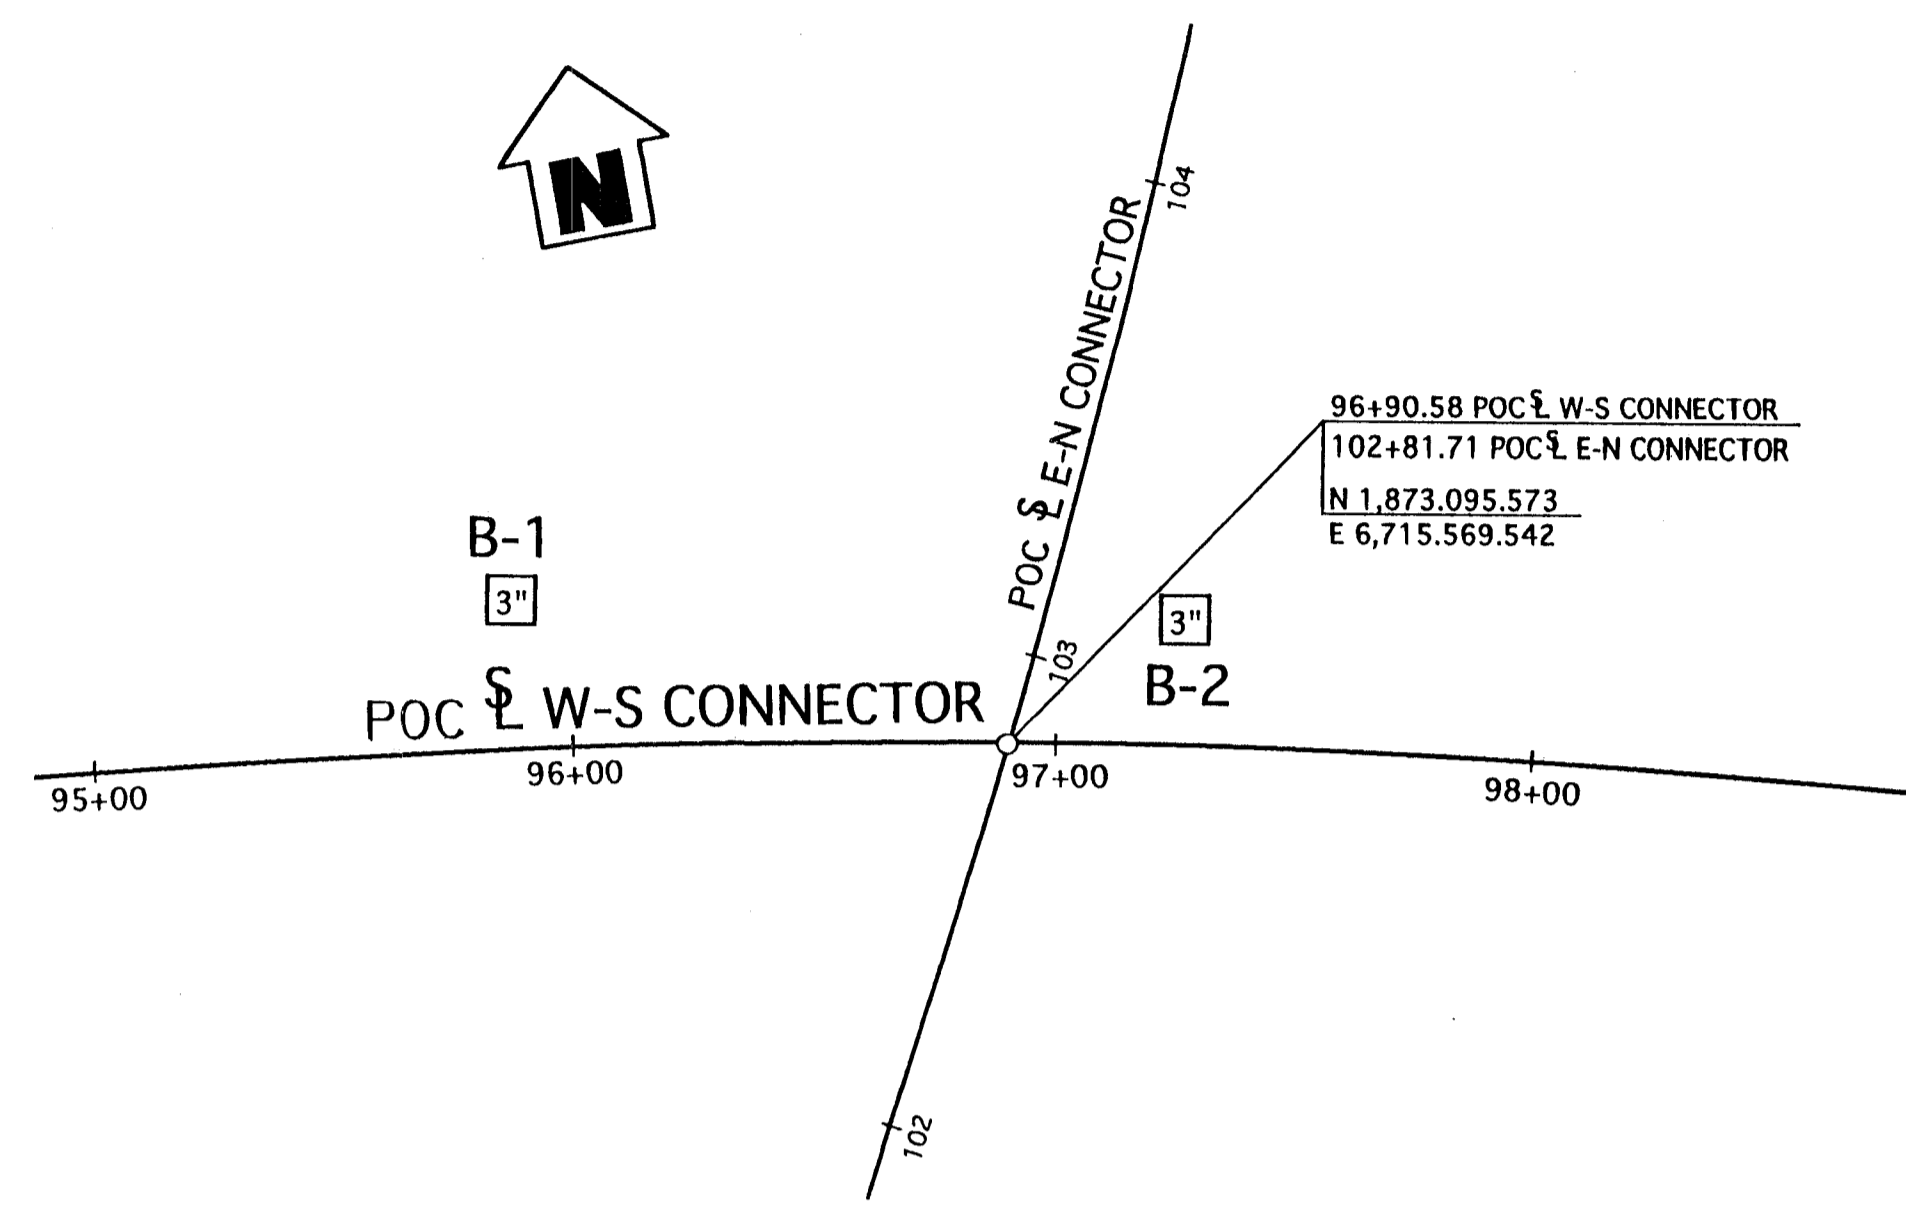

PLAN
1" = 40'

NOTE: NO GROUND WATER ENCOUNTERED DURING FIELD INVESTIGATION.

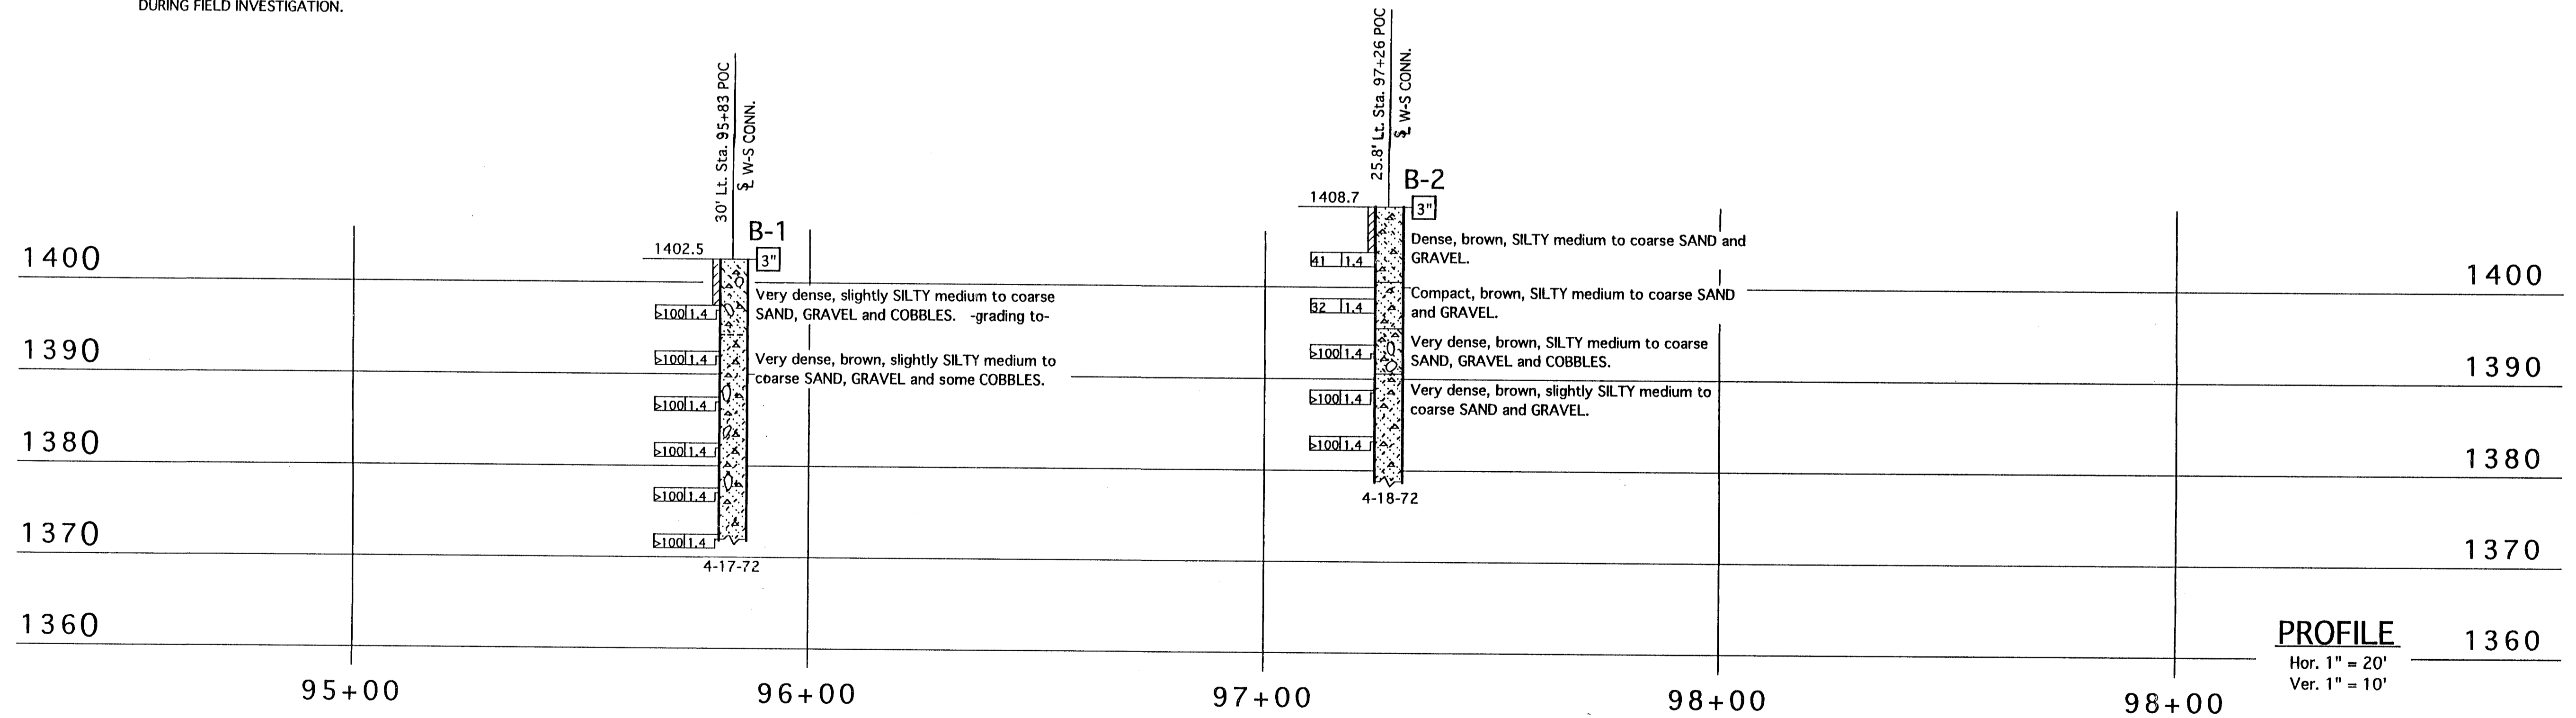


PROFILE
Hor. 1" = 20'
Ver. 1" = 10'

ENGINEERING SERVICE CENTER	STRUCTURE FOUNDATIONS	FIELD INVESTIGATION BY: R.W. FOX 4/72	State of CALIFORNIA DEPARTMENT OF TRANSPORTATION	DIVISION OF STRUCTURES STRUCTURE DESIGN	BRIDGE NO. 54-0959F POST MILE R11.9-Fna	WESTSOUTH CONNECTOR SEPARATION LOG OF TEST BORINGS
DRAWN BY Sana Senerca 3/96	CHECKED BY	CU: 08236 EA: 204301	DISREGARD PRINTS BEARING EARLIER REVISION DATES		REVISION DATES (PRELIMINARY STAGE ONLY)	SHEET OF

ORIGINAL SCALE IN INCHES FOR REDUCED PLANS → 0 1 2 3

Cherry Avenue UC

DIST	COUNTY	ROUTE	POST MILES TOTAL PROJECT	SHEET NO.	TOTAL SHEETS
08	SBd	15			

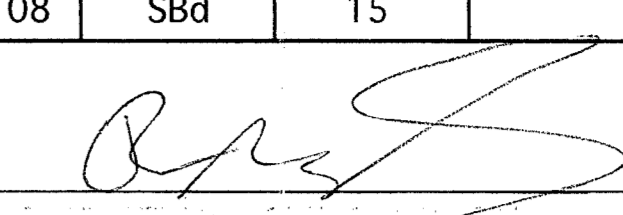
 REGISTERED PROFESSIONAL ENGINEER
 R. MAHALLATI
 No. 49374
 Exp. 9-30-96
 CIVIL
 STATE OF CALIFORNIA

PLANS APPROVAL DATE _____

THE STATE OF CALIFORNIA OR ITS OFFICERS OR AGENTS SHALL NOT BE RESPONSIBLE FOR THE ACCURACY OR COMPLETENESS OF ELECTRONIC COPIES OF THIS PLAN SHEET.

LEGEND OF BORING OPERATIONS

2 1/4" CONE PENETROMETER
 B.No. _____
 Location _____
 Boring Date _____
 Description of material (per ft)
 % Moisture
 Consolidation test
 Unconfined Compressive strength (1/2 in. dia.)
 Estimated material change
 Unconfined material change

ROTARY SAMPLE BORING (WET)
 B.No. _____
 Location _____
 Boring Date _____
 Casing driven
 Size of Sampler (Using standard or special)
 Blow count (per ft)
 Unconfined Compressive strength (1/2 in. dia.)
 Vane Shear

2 1/4" CONE PENETROMETER (DRY)
 B.No. _____
 Location _____
 Boring Date _____
 Blows per foot (Using standard or special)
 Pulled Pipe
 Reveal

LEGEND OF EARTH MATERIALS


GRAVEL
 SAND
 SILT
 CLAY
 SANDY CLAY or CLAYEY SAND
 SILTY SAND or SANDY SILT
 SILTY CLAY

CLAYEY SILT
 SILTY CLAY
 FILL MATERIAL
 ORGANIC MATERIAL
 GENEALOUS ROCK
 SEDIMENTARY ROCK
 METAMORPHIC

CONSISTENCY CLASSIFICATION FOR SOILS
 According to the Standard Penetration Test

Penetration Index (Blows / Ft)	Granular	Cohesive
0-4	Very Loose	Very Soft
5-9	Loose	Soft
10-19	Slightly compact	Stiff
20-34	Compact	Very Stiff
35-69	Dense	Hard
>70	Very Dense	Very Hard

NOTE: Classification of earth material as shown on this sheet is based upon field inspection and is not to be construed to imply mechanical analysis.

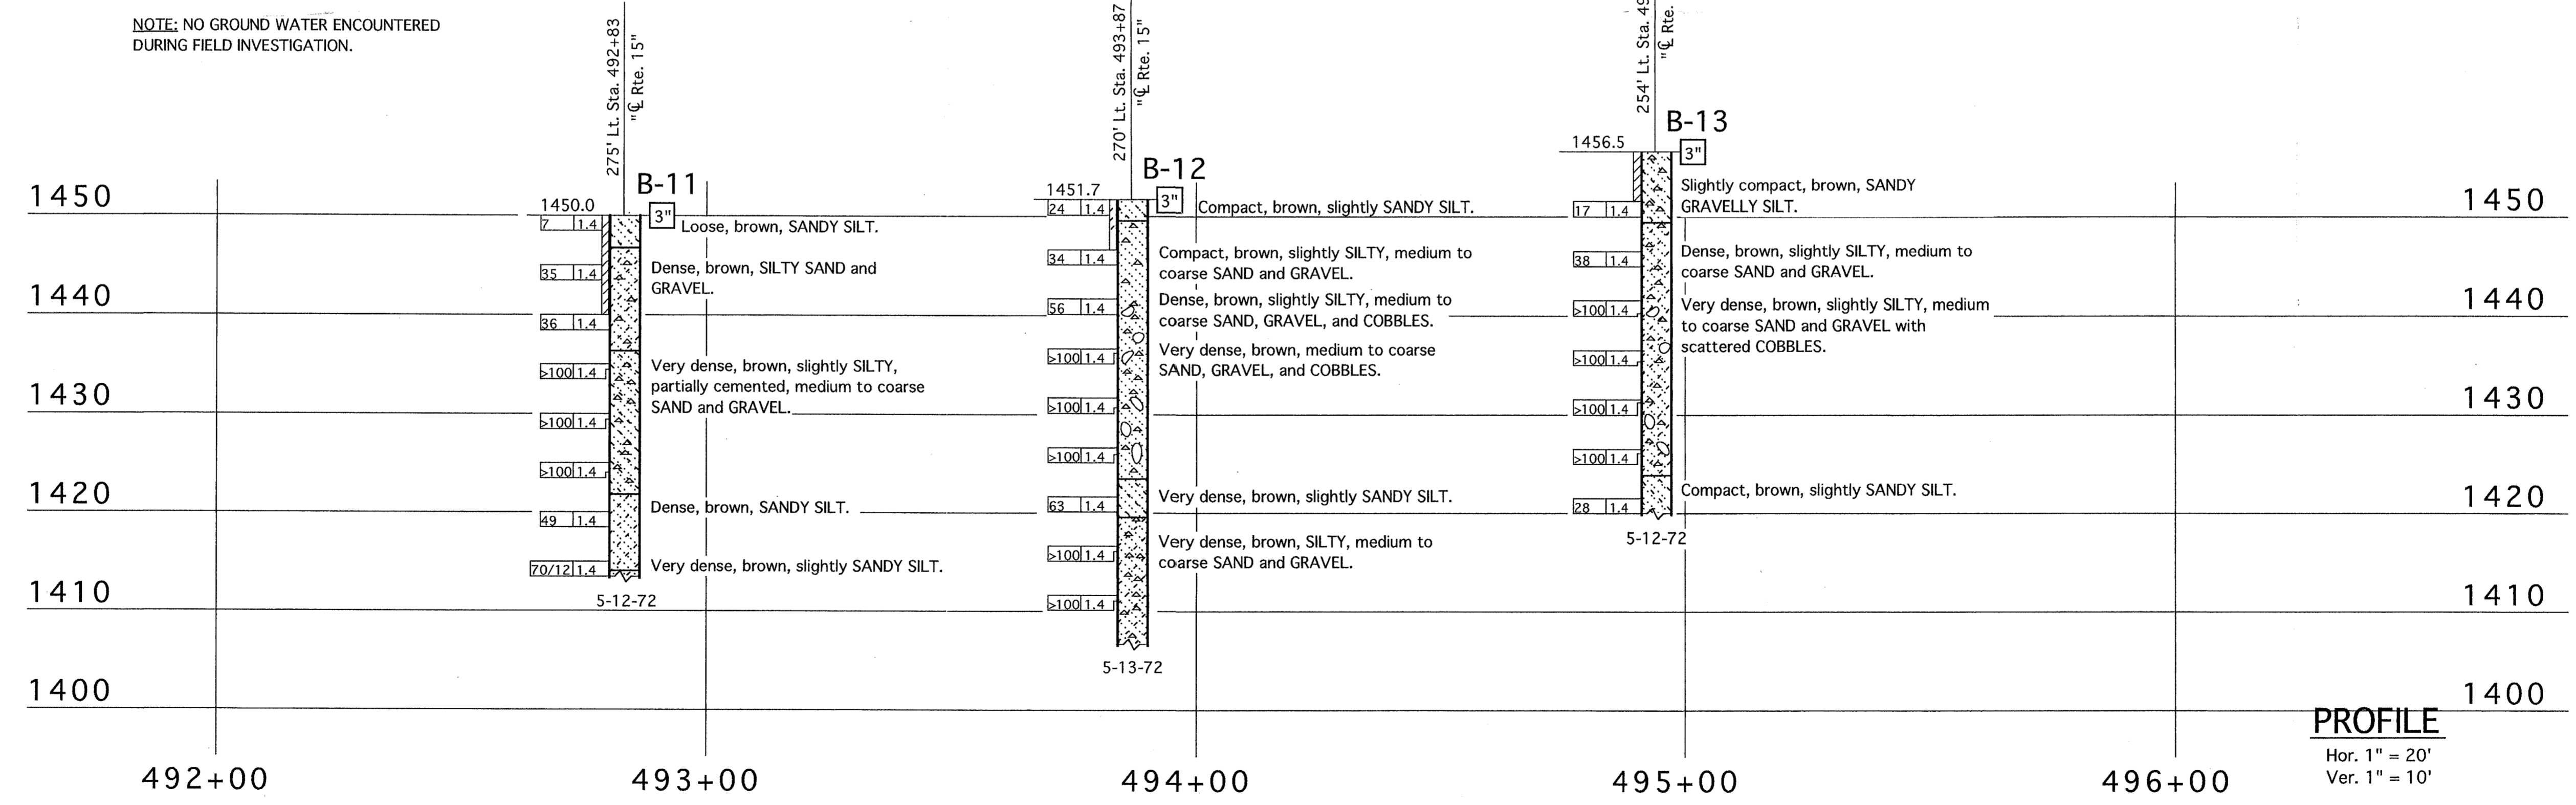

FOR PLAN VIEW, SEE "LOG OF TEST BORINGS 1 OF 3"

ENGINEERING SERVICE CENTER	STRUCTURE FOUNDATIONS	FIELD INVESTIGATION BY: R. W. FOX	State of CALIFORNIA DEPARTMENT OF TRANSPORTATION	DIVISION OF STRUCTURES STRUCTURE DESIGN	BRIDGE NO. 54-0970 L/R POST MILE 8.83RCUc	CHERRY AVE. UNDERCROSSING (WIDEN) LOG OF TEST BORINGS 2 OF 3
DRAWN BY Sona Soman 5/96	CHECKED BY					

ORIGINAL SCALE IN INCHES FOR REDUCED PLANS → 0 1 2 3

CU: 08236
EA: 204301

DISREGARD PRINTS BEARING EARLIER REVISION DATES →

REVISION DATES (PRELIMINARY STAGE ONLY)				SHEET	OF
				18	19

DIST.	COUNTY	ROUTE	POST MILES-TOTAL PROJECT	SHEET NO.	TOTAL SHEETS
08	58	31			

BRIDGE ENGINEER
REGISTERED CIVIL ENGINEER NO. 5245
DATE APPROVED: _____

LEGEND OF BORING OPERATIONS

SOIL TUBE
Top Hole El., Bore hole, Blows per foot, Penetration, etc.

ROTARY BORING
Top Hole El., Bore hole, Blows per foot, Penetration, etc.

CONE PENETROMETER
Blows per foot, Penetration, etc.

SAMPLER BORING (DRY)
Blows per foot, Penetration, etc.

ROTARY BORING (WET)
Blows per foot, Penetration, etc.

AUGER BORING (DRY)
Blows per foot, Penetration, etc.

JET BORING
Blows per foot, Penetration, etc.

CORE BORING
Blows per foot, Penetration, etc.


TEST PIT
Blows per foot, Penetration, etc.

LEGEND OF EARTH MATERIALS

CONSISTENCY CLASSIFICATION FOR SOILS

CLASSIFICATION OF MATERIAL BASED ON STANDARD GRADE SIZE LIMITS

NOTE: Classification of earth material as shown on this sheet is based upon field inspection and is not to be construed to imply mechanical analysis.

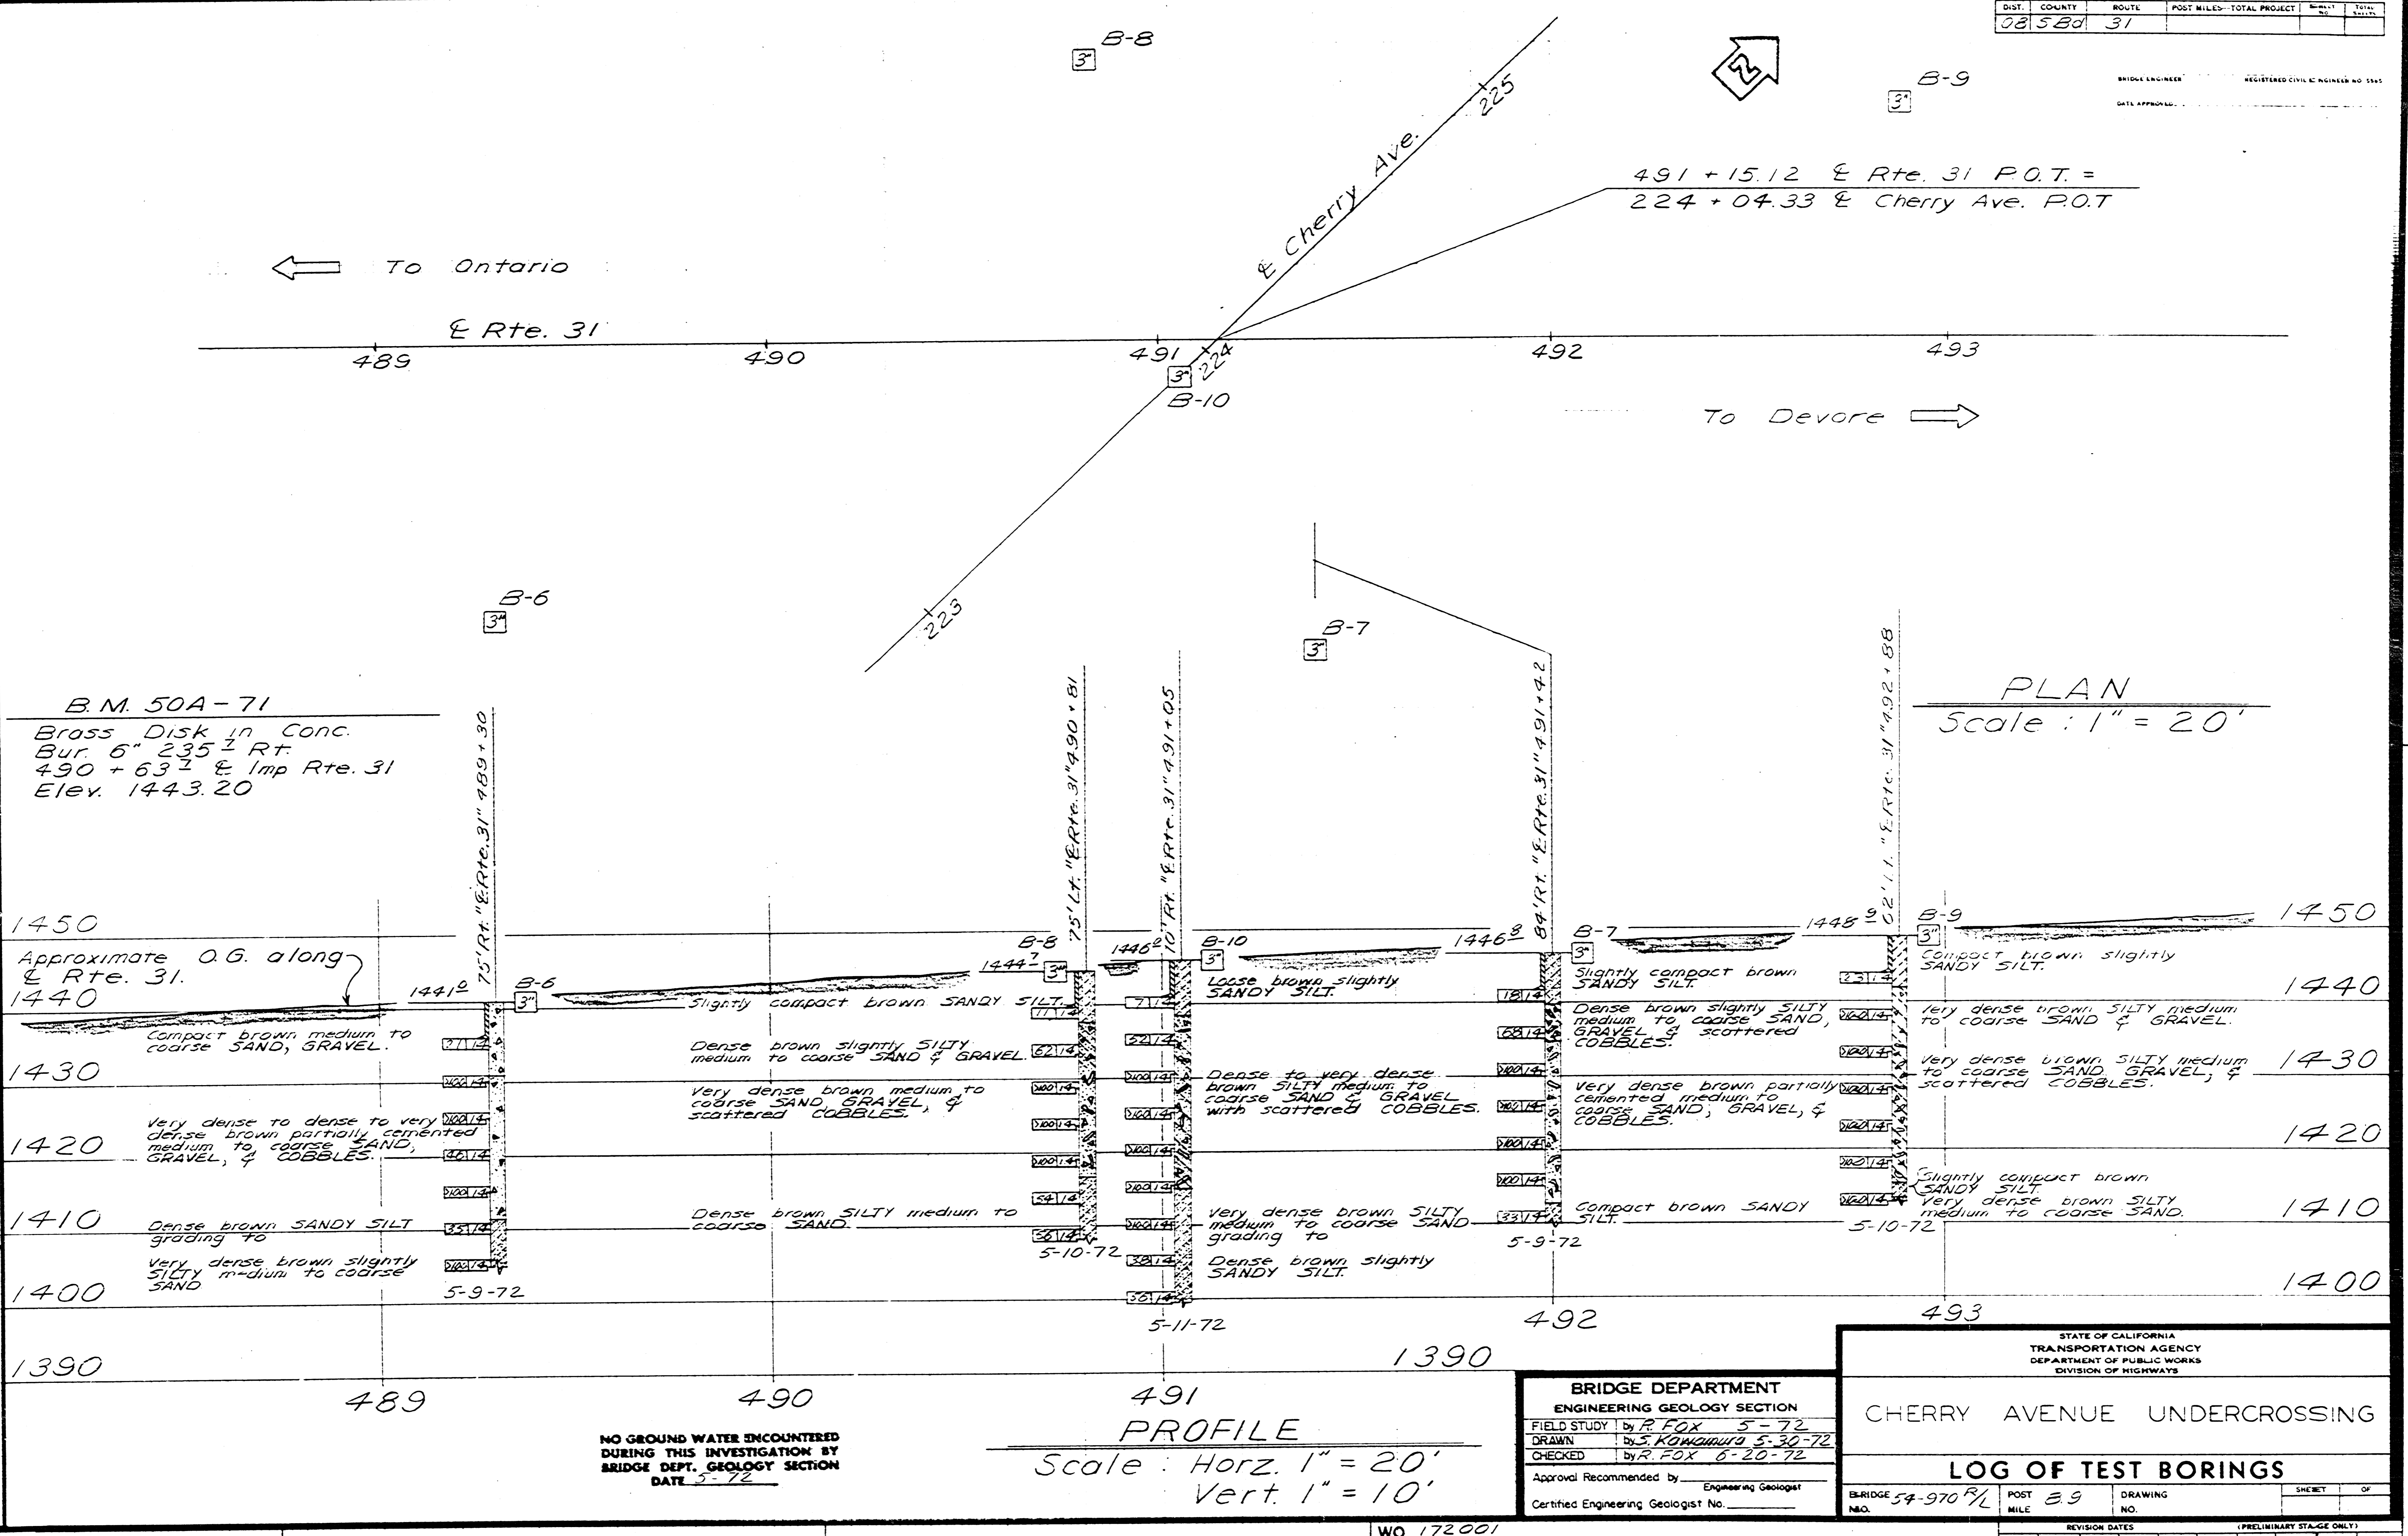

NO GROUND WATER ENCOUNTERED
DURING THIS INVESTIGATION BY
BRIDGE DEPT. GEOLOGY SECTION
DATE 5-72


WO 172001
CU 08201

Discard prints bearing earlier revision dates

DIST.	COUNTY	ROUTE	POST MILES - TOTAL PROJECT	SHEET NO.	TOTAL SHEETS
08	SBD	31			

BRIDGE ENGINEER _____ REGISTERED CIVIL ENGINEER NO. 5945
 DATE APPROVED _____

- LEGEND OF BORING OPERATIONS**
- SOIL TUBE**: Shows depth of soil tube, depth of cone penetration test, and depth of blow count test.
 - TEST PIT**: Shows location and depth of test pit.
 - CONE PENETROMETER**: Shows depth and blow count test results.
 - SAAMPLER BORING (DRY)**: Shows depth and blow count test results.
 - ROTARY BORING (DRY)**: Shows depth and blow count test results.
 - JET BORING**: Shows depth and blow count test results.
 - CORE BORING**: Shows depth and blow count test results.
 - TEST PIT**: Shows location and depth of test pit.

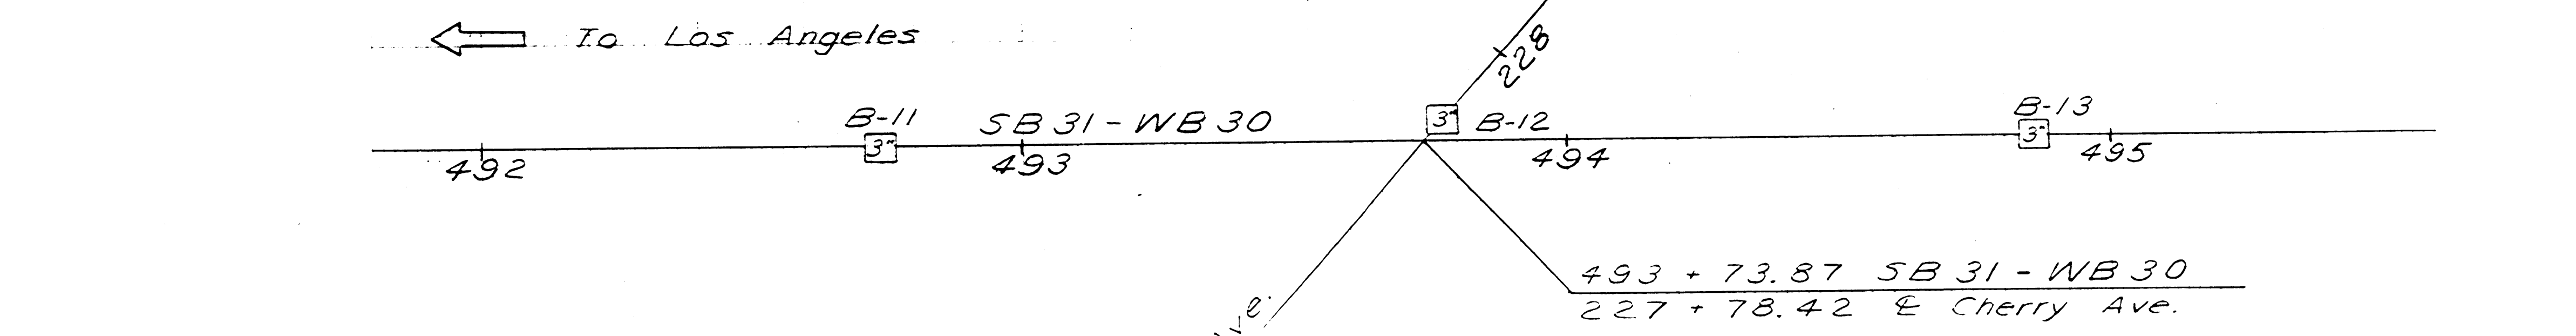


B.M. 50A-71
 Brass Disk in Conc
 Bur. 6" 2352 Rt.
 490 + 63' & Imp Rte. 31
 Elev. 1443.20

PLAN
 Scale: 1" = 20'

LEGEND OF EARTH MATERIALS

GRAVEL	SANDY SILT	CLAYEY SILT	CLAYEY SAND
SAND	CLAY	ORGANIC SILT	ORGANIC SAND
SILT	CLAYEY SAND	CLAYEY SILT	CLAY
CLAY	SANDY SILT	CLAYEY SAND	CLAYEY SILT
SANDY SILT	CLAYEY SAND	CLAYEY SILT	CLAY
CLAYEY SAND	CLAYEY SILT	CLAYEY SAND	CLAYEY SILT
CLAYEY SILT	CLAYEY SAND	CLAYEY SILT	CLAYEY SAND
CLAYEY SAND	CLAYEY SILT	CLAYEY SAND	CLAYEY SILT
CLAYEY SILT	CLAYEY SAND	CLAYEY SILT	CLAYEY SAND
CLAYEY SAND	CLAYEY SILT	CLAYEY SAND	CLAYEY SILT

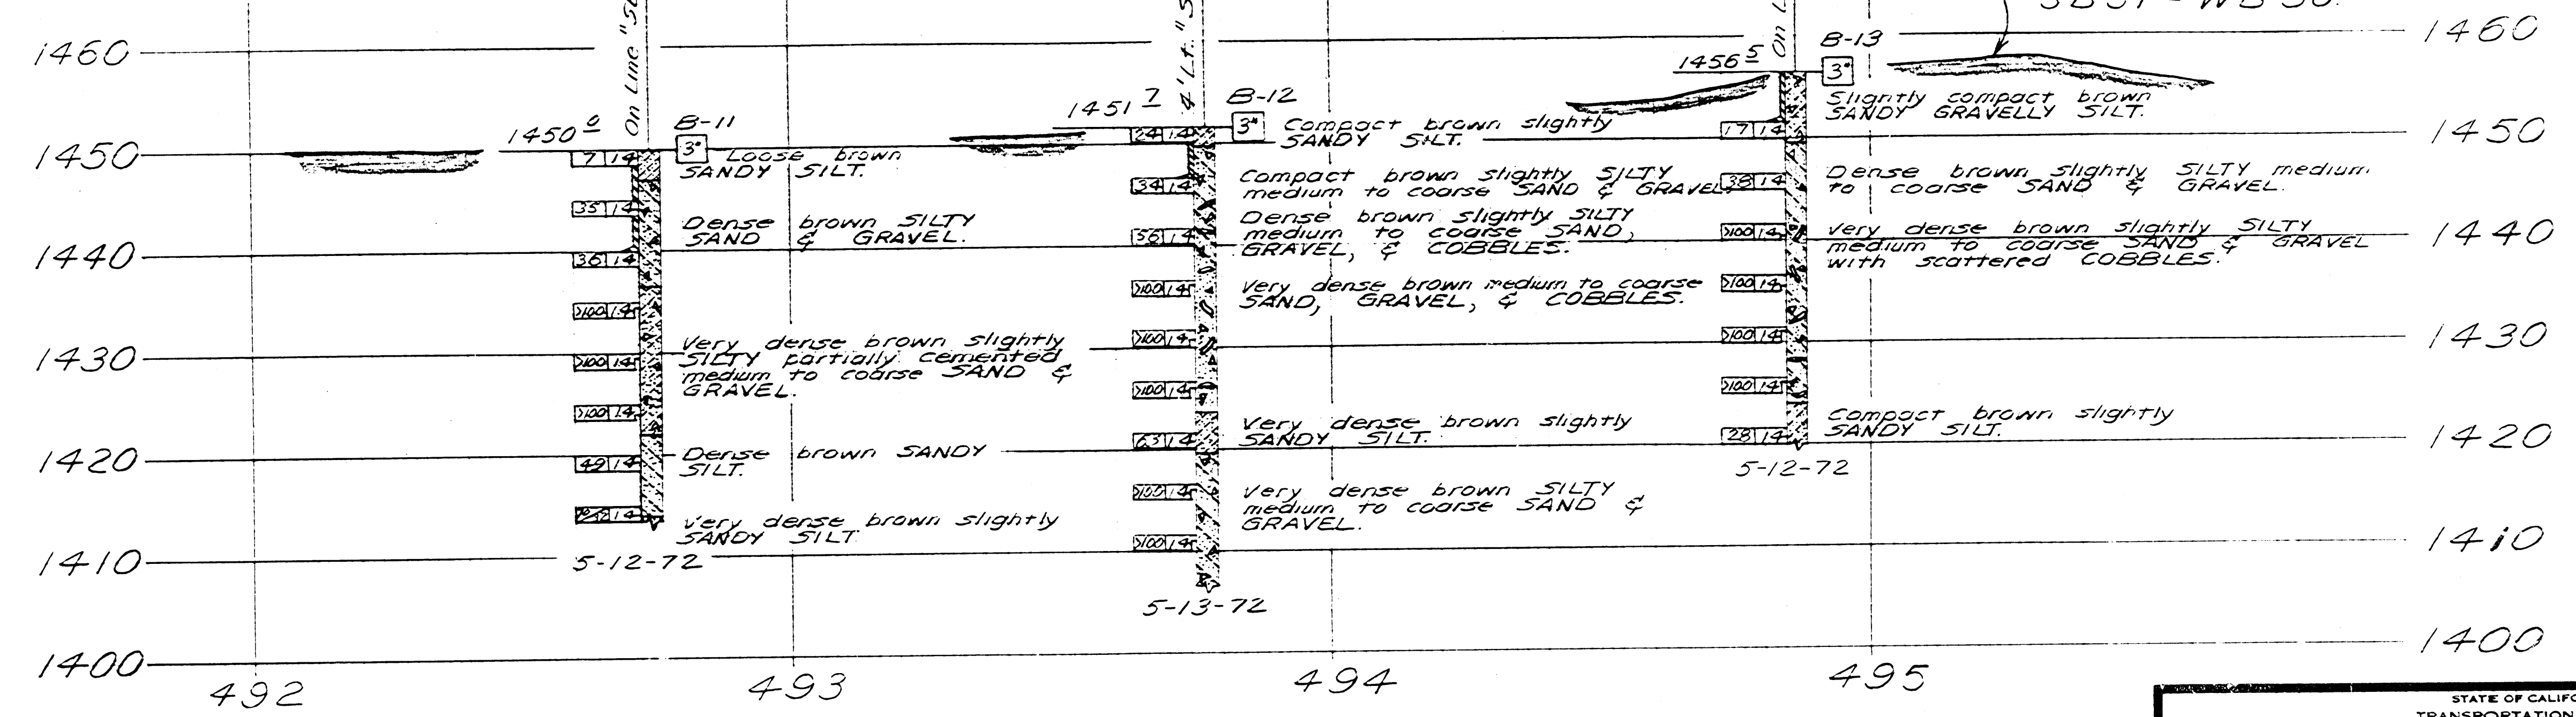

CLASSIFICATION OF MATERIAL BASED ON STANDARD GRADE SIZE LIMITS

Diagram showing the relationship between soil types and their standard grade size limits. Includes terms like CLAY, SILT, SAND, GRAVEL, COBBLES, and their respective percentages.

NOTE: Classification of earth material as shown on this sheet is based upon field inspection and is not to be construed to imply mechanical analysis.

STATE OF CALIFORNIA
 TRANSPORTATION AGENCY
 DEPARTMENT OF PUBLIC WORKS
 DIVISION OF HIGHWAYS

BRIDGE DEPARTMENT
 ENGINEERING GEOLOGY SECTION

CHERRY AVENUE UNDERCROSSING

LOG OF TEST BORINGS

BRIDGE NO. 54 910QL POST MILE 2.9 DRAWING NO. SHEET 1 OF 1

Approval Recommended by _____
 Certified Engineering Geologist No. _____

WO 172001
 CU 08201

Disregard print bearing earlier revision dates

LEGEND OF BORING OPERATIONS

SOIL TUBE

Top Hook EI
Bore hole
Retinal
Boring core
View shear

ROTARY BORING

Top Hook EI
Bore hole
Retinal
Boring core
View shear

CONE PENETROMETER

Top Hook EI
Bore hole
Retinal
Boring core
View shear

SAMPLER BORING (DRY)

Top Hook EI
Bore hole
Retinal
Boring core
View shear

NOTARY BORING (WET)

Top Hook EI
Bore hole
Retinal
Boring core
View shear

AUGER BORING (DRY)

Top Hook EI
Bore hole
Retinal
Boring core
View shear

JET BORING

Top Hook EI
Bore hole
Retinal
Boring core
View shear

CORE BORING

Top Hook EI
Bore hole
Retinal
Boring core
View shear

TEST PIT

Top Hook EI
Bore hole
Retinal
Boring core
View shear

LEGEND OF EARTH MATERIALS

SILTY CLAY or CLAYEY SILT
CLAYEY SILT
ORGANIC MATERIAL
FILL MATERIAL
UNSATURATED SAND
SATURATED SAND
SANDY SILT
CLAY
SANDY CLAY
CLAYEY SAND
SANDY SAND
GRAVEL
SAND
SILT
CLAY
SANDY CLAY
CLAYEY SAND
SANDY SAND
GRAVEL
SAND
SILT
CLAY
SANDY CLAY
CLAYEY SAND
SANDY SAND



CONSISTENCY CLASSIFICATION FOR SOILS

According to the Standard Penetration Test

No. of Blows	Consistency
0-5	Very soft
5-10	Soft
10-20	Stiff
20-35	Very stiff
35-70	Hard
>70	Very hard

CLASSIFICATION OF MATERIAL BASED ON STANDARD GRADE SIZE LIMITS

Diagram showing the basis for determination of class in terms of percentages of material passing through various sieve sizes. The diagram is a semi-logarithmic plot of sieve size (mm) versus percentage passing.

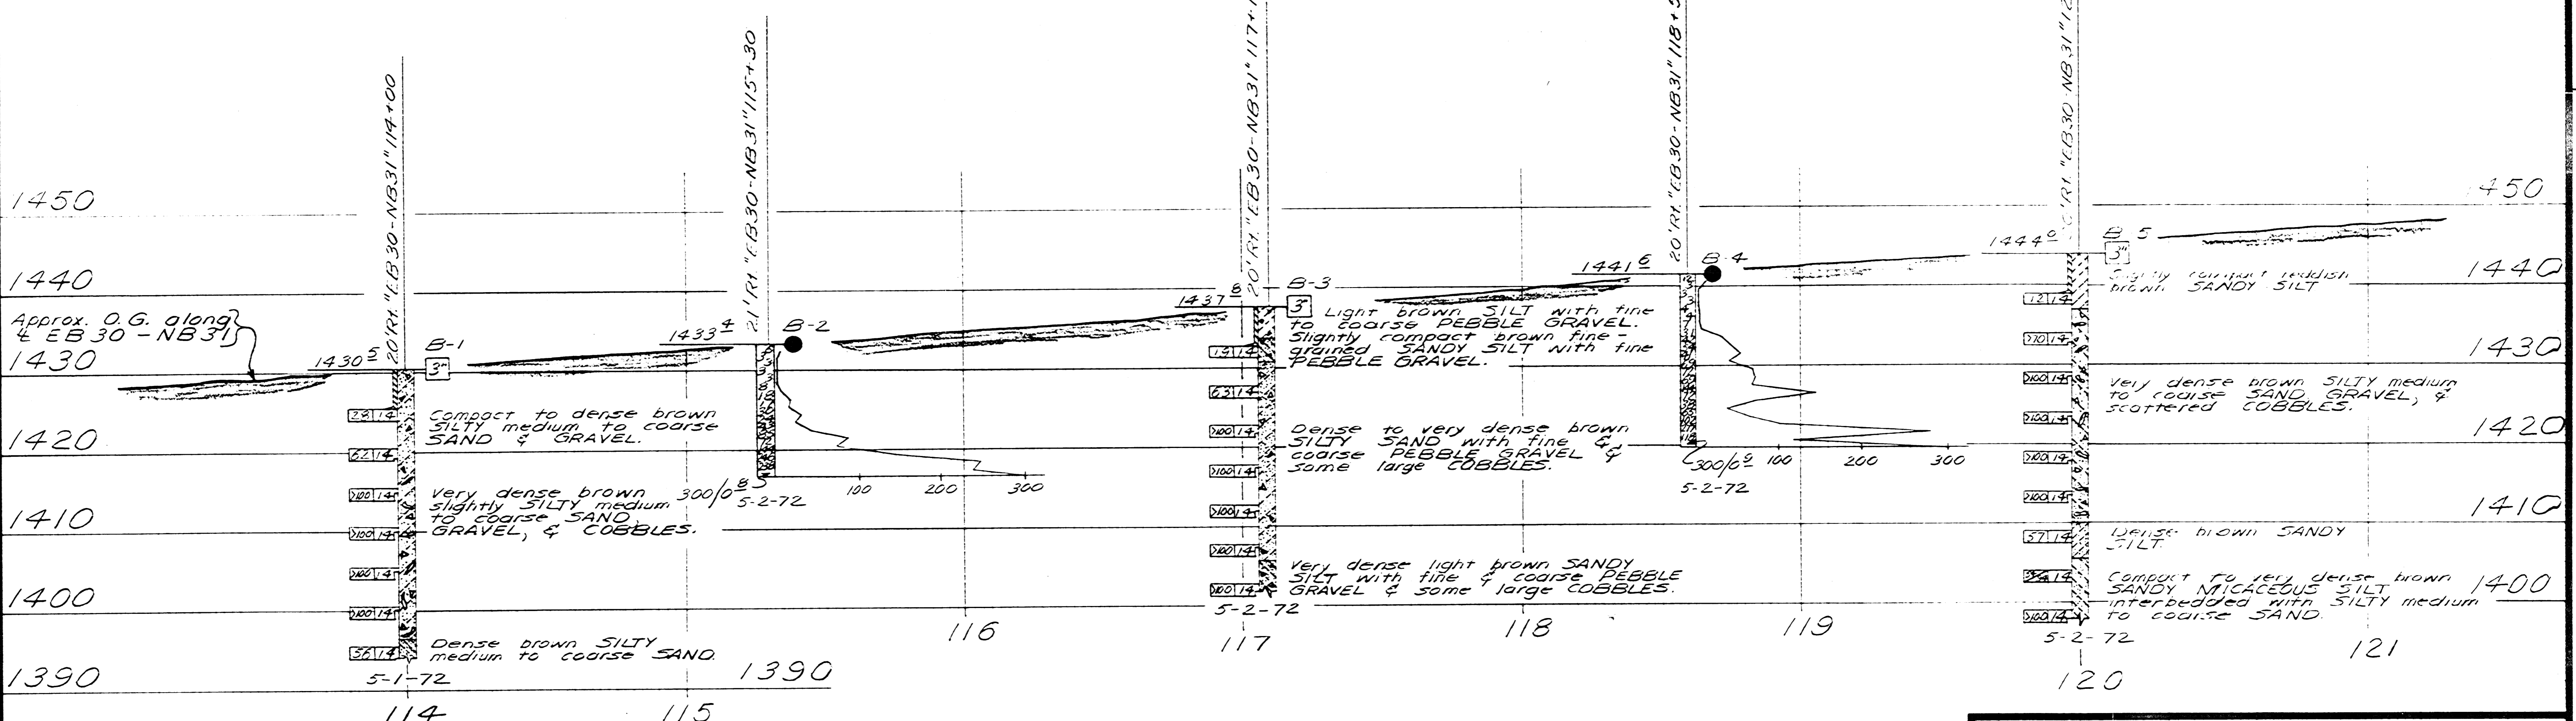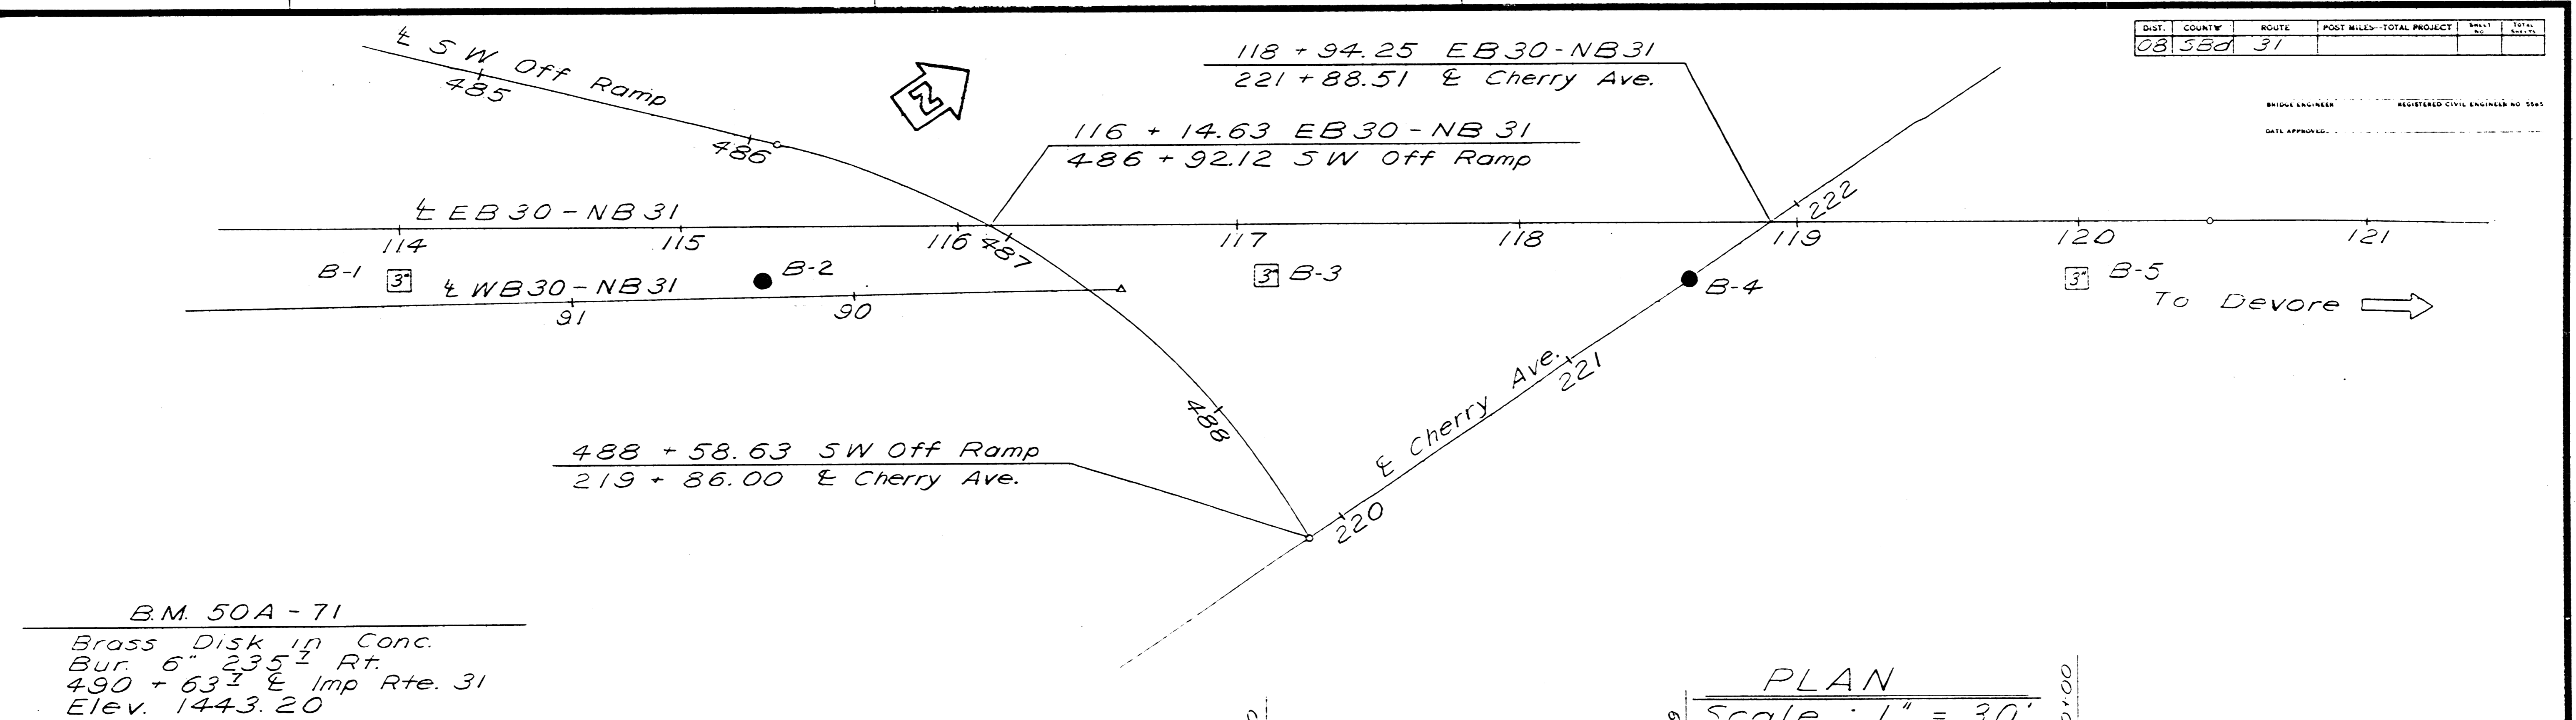

B.M. 50A-71
Brass Disk in Conc.
Bur. 6" 235' Rt.
490 + 63' E Imp Rte. 31
Elev. 1443.20

NO GROUND WATER ENCOUNTERED DURING THIS INVESTIGATION BY BRIDGE DEPT. GEOLOGY SECTION DATE 5-72

PROFILE
Scale: Horz. 1" = 30'
Vert. 1" = 10'

BRIDGE DEPARTMENT
ENGINEERING GEOLOGY SECTION

FIELD STUDY by R. FOX 5-72
DRAWN by S. KAWAMURA 5-31-72
CHECKED by R. FOX 6-20-72

Approval Recommended by _____
Certified Engineering Geologist No. _____

STATE OF CALIFORNIA
TRANSPORTATION AGENCY
DEPARTMENT OF PUBLIC WORKS
DIVISION OF HIGHWAYS

CHERRY AVENUE UNDERCROSSING

LOG OF TEST BORINGS

BRIDGE 54 570RR POST MILE 8.9 DRAWING NO. _____ SHEET _____ OF _____

REVISION DATES (PRELIMINARY STAGE ONLY)

DIST.	COUNTY	ROUTE	POST MILES-TOTAL PROJECT	SHEET NO.	TOTAL SHEETS
03	38	31			

BRIDGE ENGINEER: _____
DATE APPROVED: _____

WO 172001
CU 08201

Discard prints bearing earlier revision dates

T/RW_Summit Ave OC (Beech Ave)

DIST	COUNTY	ROUTE	POST MILES TOTAL PROJECT	SHEET NO.	TOTAL SHEETS
08	SBd	30			

PLANS APPROVAL DATE _____	

THE STATE OF CALIFORNIA OR ITS OFFICERS OR AGENTS SHALL NOT BE RESPONSIBLE FOR THE ACCURACY OR COMPLETENESS OF ELECTRONIC COPIES OF THIS PLAN SHEET.

LEGEND OF BORING OPERATIONS


LEGEND OF EARTH MATERIALS

GRAVEL	CLAYEY SILT
SAND	PEAT AND/OR ORGANIC MATTER
SILT	FILL MATERIAL
CLAY	IGNEOUS ROCK
SANDY CLAY	SEDIMENTARY ROCK
CLAYEY SAND	METAMORPHIC
CLAYEY SILT	
SILT	
CLAY	
SANDY CLAY	
CLAYEY SAND	
CLAYEY SILT	
SILT	
CLAY	

CONSISTENCY CLASSIFICATION FOR SOILS

Penetration Index (Blows/Ft)	Cohesive	
	Granular	Very Soft to Very Hard
0-4	Very Loose	Very Soft
5-9	Loose	Soft
10-19	Slightly compact	Stiff
20-34	Compact	Very Stiff
35-69	Dense	Hard
>70	Very Dense	Very Hard

NOTE: Classification of earth material as shown on this sheet is based upon field inspection and is not to be construed to imply mechanical analysis.

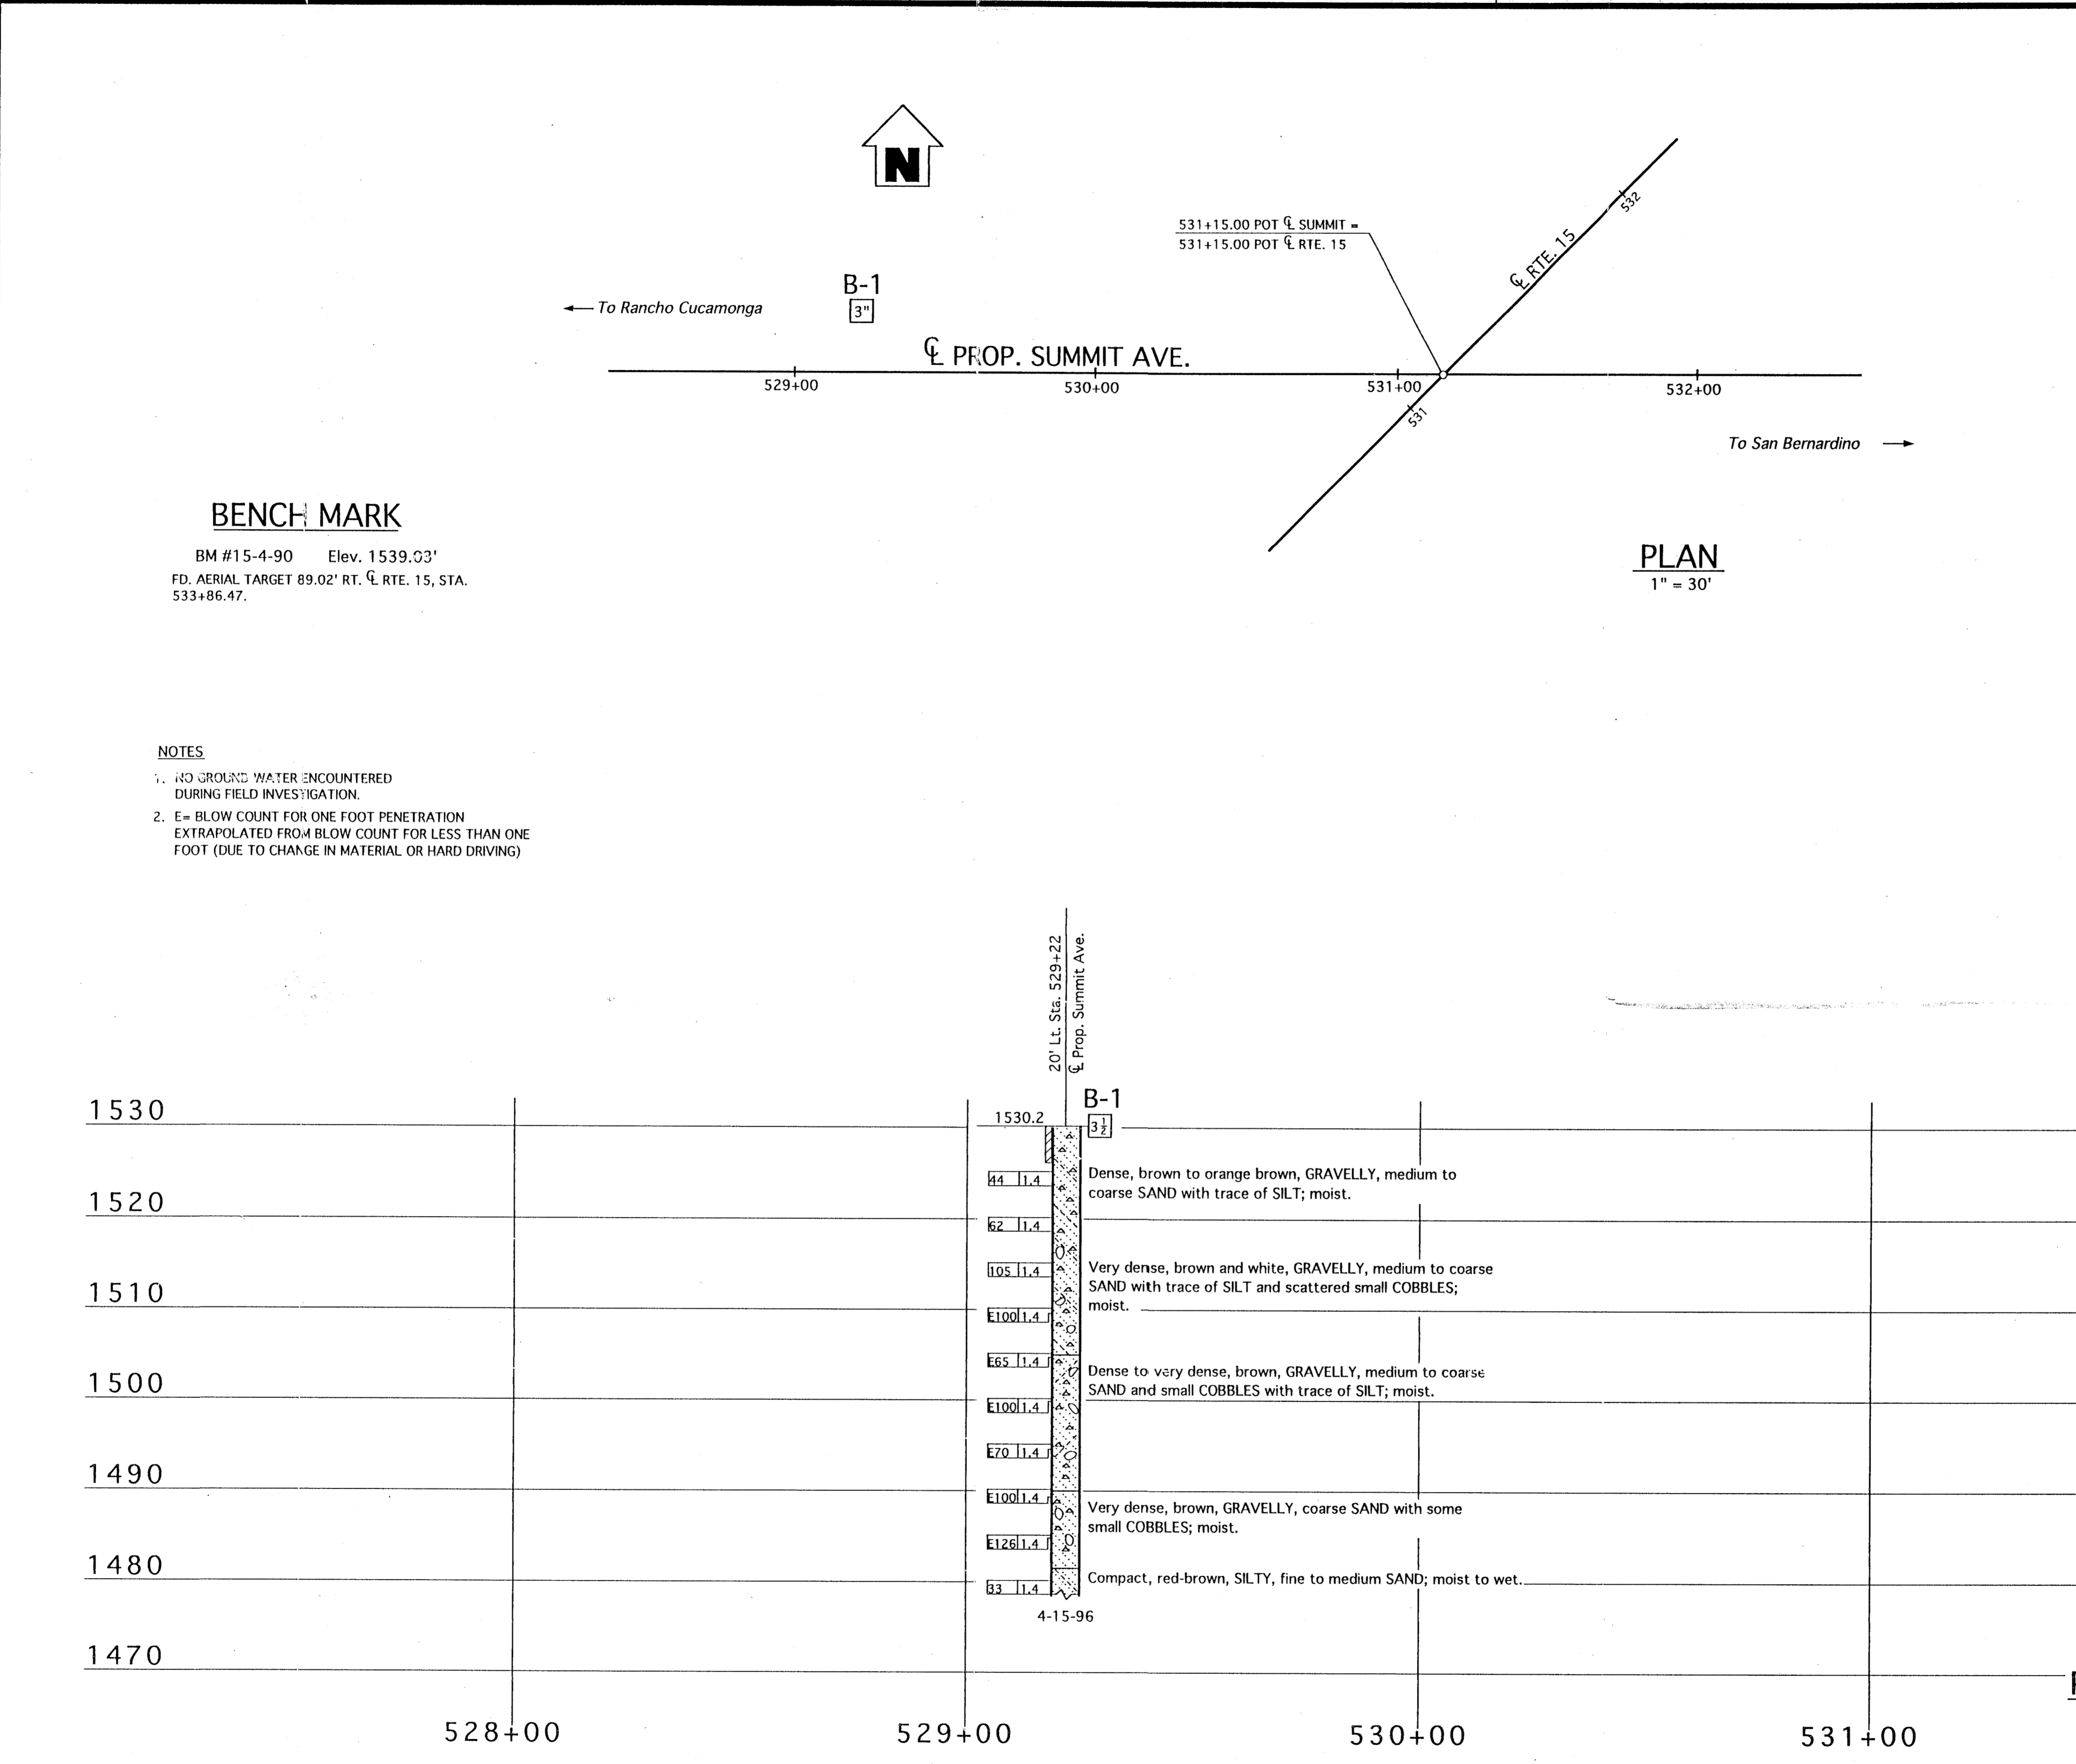

BENCH MARK
 BM #15-4-90 Elev. 1539.03'
 FD. AERIAL TARGET 89.02' RT. C.R.TE. 15, STA. 533+86.47.

NOTES

- NO GROUND WATER ENCOUNTERED DURING FIELD INVESTIGATION.
- E = BLOW COUNT FOR ONE FOOT PENETRATION EXTRAPOLATED FROM BLOW COUNT FOR LESS THAN ONE FOOT (DUE TO CHANGE IN MATERIAL OR HARD DRIVING)

ENGINEERING SERVICE CENTER		STRUCTURE FOUNDATIONS		FIELD INVESTIGATION BY:	State of CALIFORNIA	DIVISION OF STRUCTURES	BRIDGE NO. 54-0978	SUMMIT AVENUE OVERCROSSING	
DRAWN BY: <i>Anna Yermolaeva</i>	5/96			T. ALDERMAN	DEPARTMENT OF TRANSPORTATION	STRUCTURE DESIGN	POST MILE 9.6	LOG OF TEST BORINGS	
CHECKED BY: _____								DISREGARD PRINTS BEARING EARLIER REVISION DATES	



Duncan Canyon Road OC

DIST.	COUNTY	ROUTE	POST MILES-TOTAL PROJECT	SHEET NO.	TOTAL SHEETS
08	SBD	31			

BRIDGE ENGINEER: _____ REGISTERED CIVIL ENGINEER NO. 5545
 DATE APPROVED: _____

LEGEND OF BORING OPERATIONS

2 1/2" CORE PENETROMETER
 SAMPLER BORING (DRY)
 ROTARY BORING (WET)
 AUGER BORING (DRY)
 JET BORING
 CORE BORING
 TEST PIT

SOIL TUBE
 Top hole EI
 Blows per foot
 Blow hammer
 Pulling pipe
 Retained soil

ROTARY BORING
 Top hole EI
 Casing driven
 Size of sample (in)
 Using a split barrel sampler
 30' size or as noted
 Unclassified compressive strength 174 (lb/in²)
 Shear strength
 Vane shear

PENETRATION BORING
 Top hole EI
 No count recorded
 Pushed into soil
 (Using No. 2 or No. 3)
 Measurement of penetration
 in terms of
 100 PSI or greater

LEGEND OF EARTH MATERIALS



GRAVEL
 SAND
 SILT
 CLAY
 SANDY CLAY
 SANDY SILT
 SILTY SAND
 SILTY CLAY
 PEAT
 ORGANIC MATTER
 FILL MATERIAL
 GENEOUS ROCK
 SEDIMENTARY
 METAMORPHIC
 ROCK

CONSISTENCY CLASSIFICATION FOR SOILS
 According to the Standard Penetration Test
 No. of Blows
 0-5
 5-10
 10-20
 20-35
 35-70
 >70

Consistency
 Very soft
 Soft
 Silty
 Very stiff
 Hard
 Very hard

CLASSIFICATION OF MATERIAL BASED ON STANDARD GRADE SIZE LIMITS

Diagram showing the basis for classification of soil materials. If GRAVEL is present in appreciable amounts the term GRAVELLY SAND or GRAVELLY SILT may be added to the terms coarse, medium, or fine SAND, SILT, or CLAY. If SILT or CLAY is present in appreciable amounts the term SILTY SAND or SILTY SILT may be added to the terms coarse, medium, or fine SAND, SILT, or CLAY.

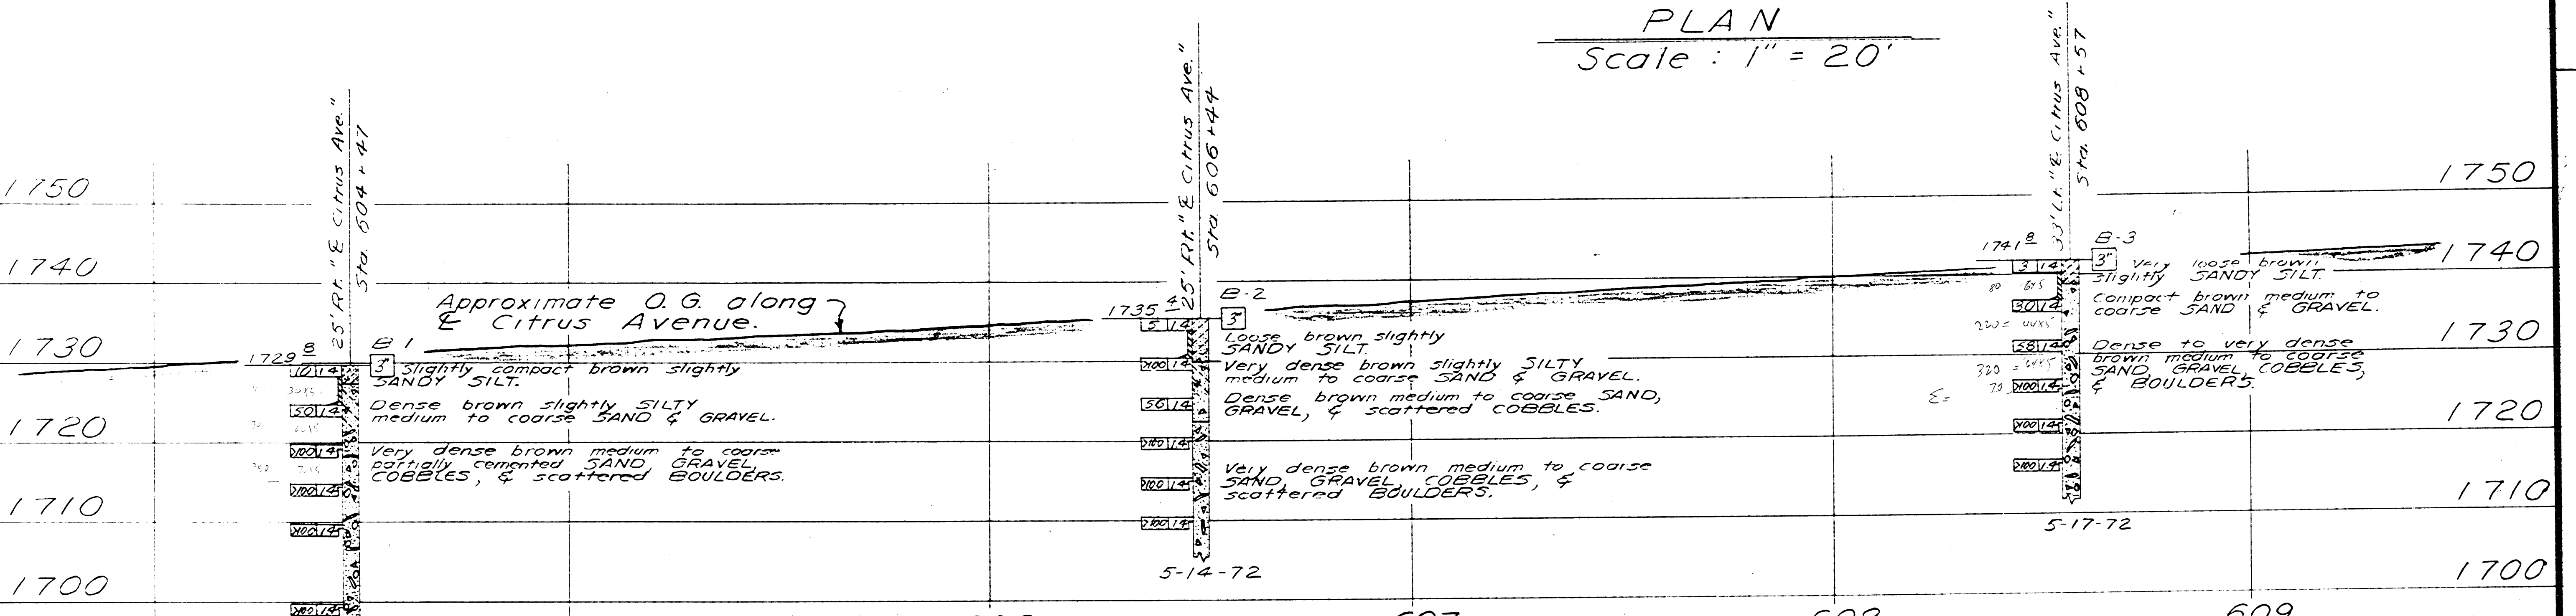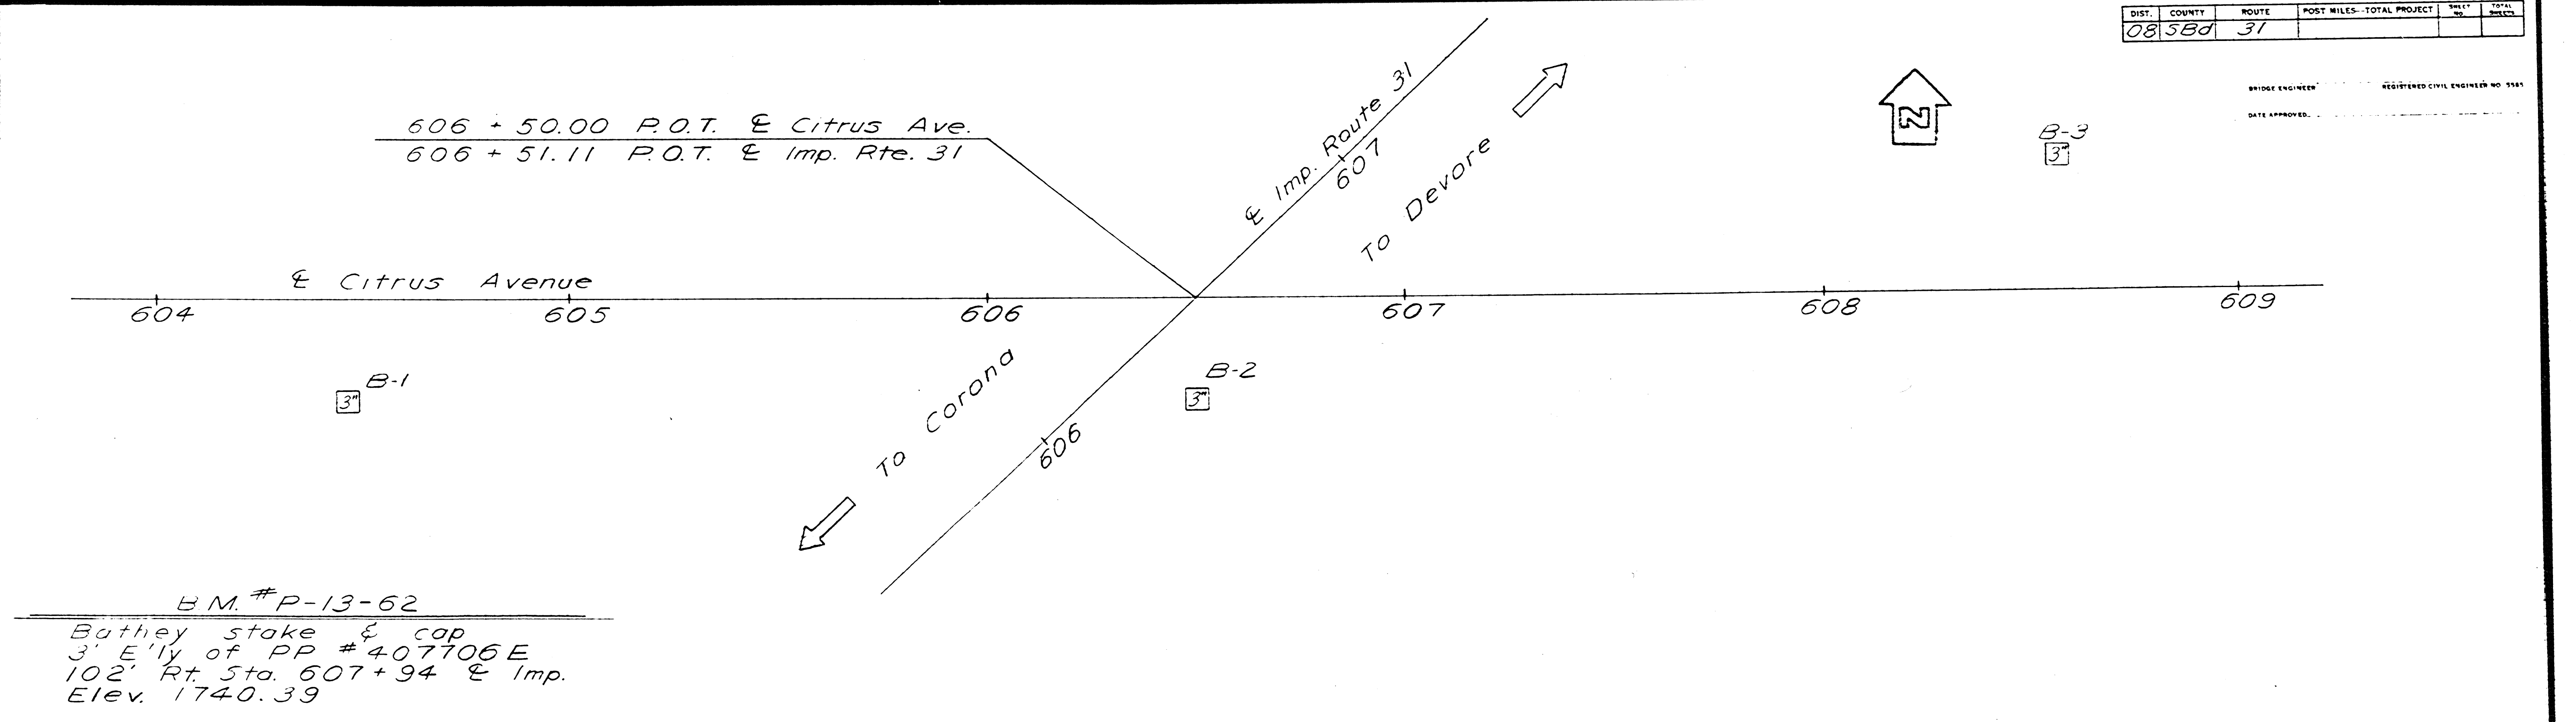

PLAN
 Scale: 1" = 20'

PROFILE
 Scale: Horiz. 1" = 20'
 Vert. 1" = 10'

NO GROUND WATER ENCOUNTERED DURING THIS INVESTIGATION BY BRIDGE DEPT. GEOLOGY SECTION DATE 5-72

BRIDGE DEPARTMENT
 ENGINEERING GEOLOGY SECTION
 FIELD STUDY by R. Fox 5-72
 DRAWN by S. Kawamura 6-2-72
 CHECKED by R. Fox 6-19-72

Approval Recommended by _____
 Engineering Geologist
 Certified Engineering Geologist No. _____

STATE OF CALIFORNIA
 TRANSPORTATION AGENCY
 DEPARTMENT OF PUBLIC WORKS
 DIVISION OF HIGHWAYS

CITRUS AVENUE OVERCROSSING


LOG OF TEST BORINGS


BRIDGE NO. 54-980 POST MILE 11.0 DRAWING NO. _____ SHEET _____ OF _____

REVISION DATES (PRELIMINARY STAGE ONLY)


WO 172101
 CU 08203

Discard prints bearing earlier revision dates

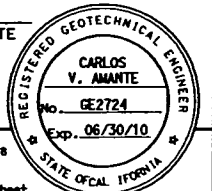DIST	COUNTY	ROUTE	POST MILES TOTAL PROJECT	SHEET No	TOTAL SHEETS
08	SBd	15	10.32/11.44		3
REGISTERED CIVIL ENGINEER DATE					
					
PLANS APPROVAL DATE					
The State of California or its officers or agents shall not be responsible for the accuracy or completeness of electronic copies of this plan sheet.					
CITY OF FONTANA 1170 WEST 3RD STREET SAN BERNARDINO, CA 92410					
LIM & NASCIMENTO ENGINEERING 1887 BUSINESS CENTER DRIVE, SUITE 6 SAN BERNARDINO, CALIFORNIA 92408					
KLEINFELDER WEST INC. 1220 RESEARCH DRIVE, SUITE B REDLANDS, CALIFORNIA 92374					

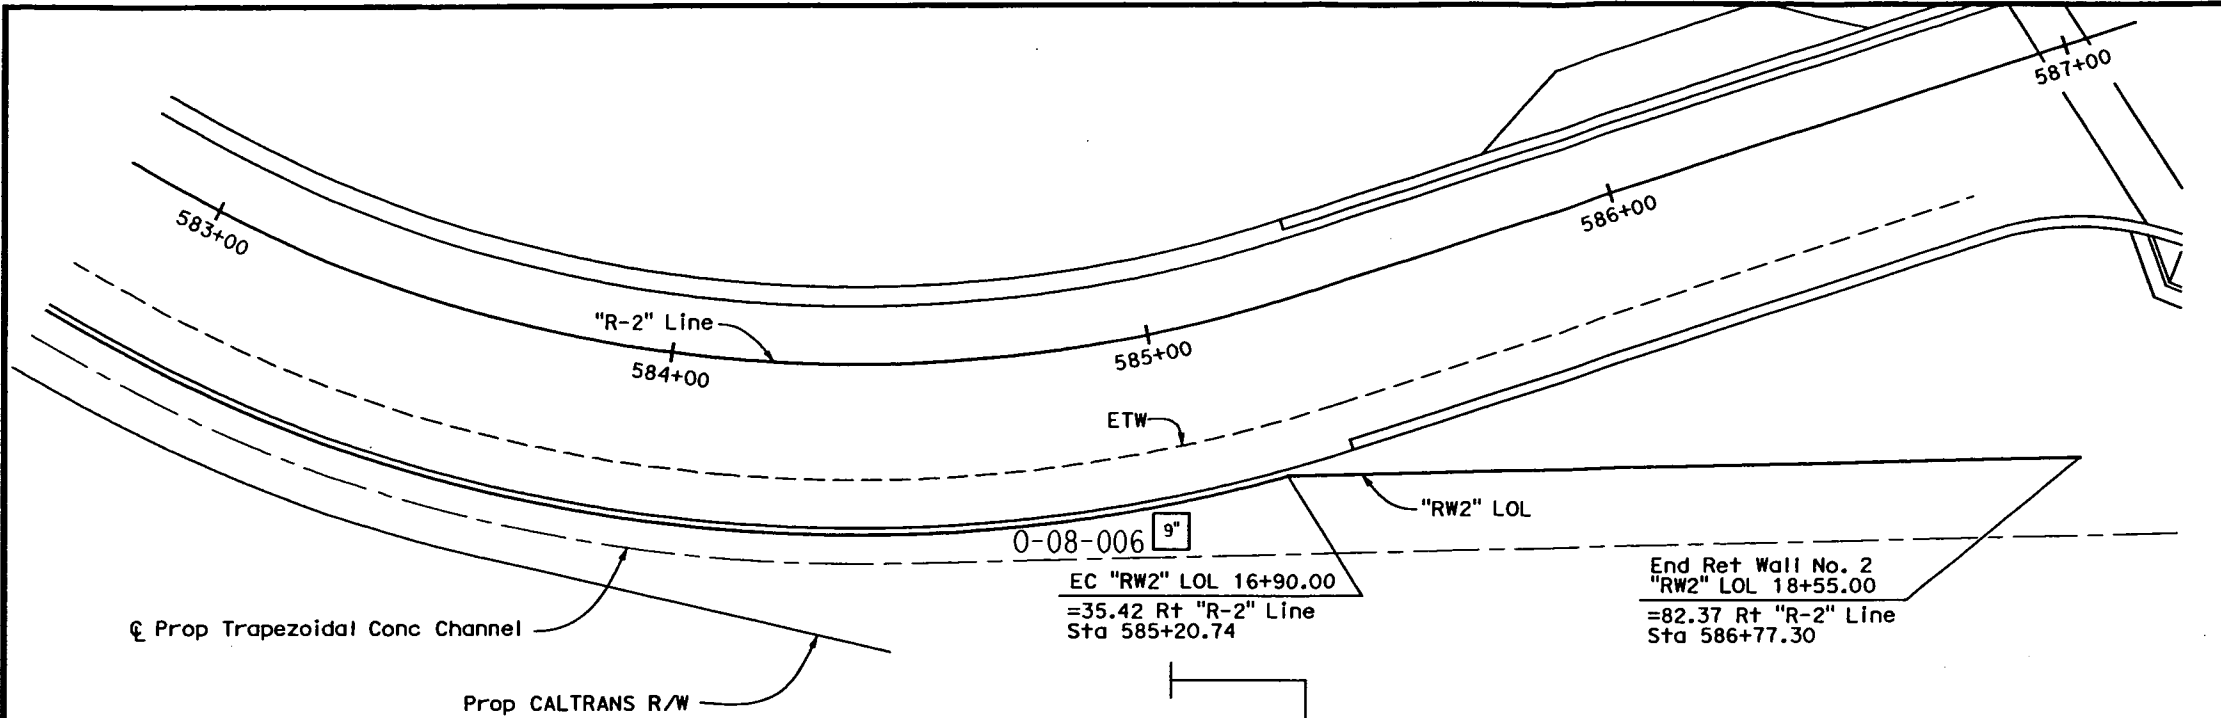

PLAN
1" = 20'

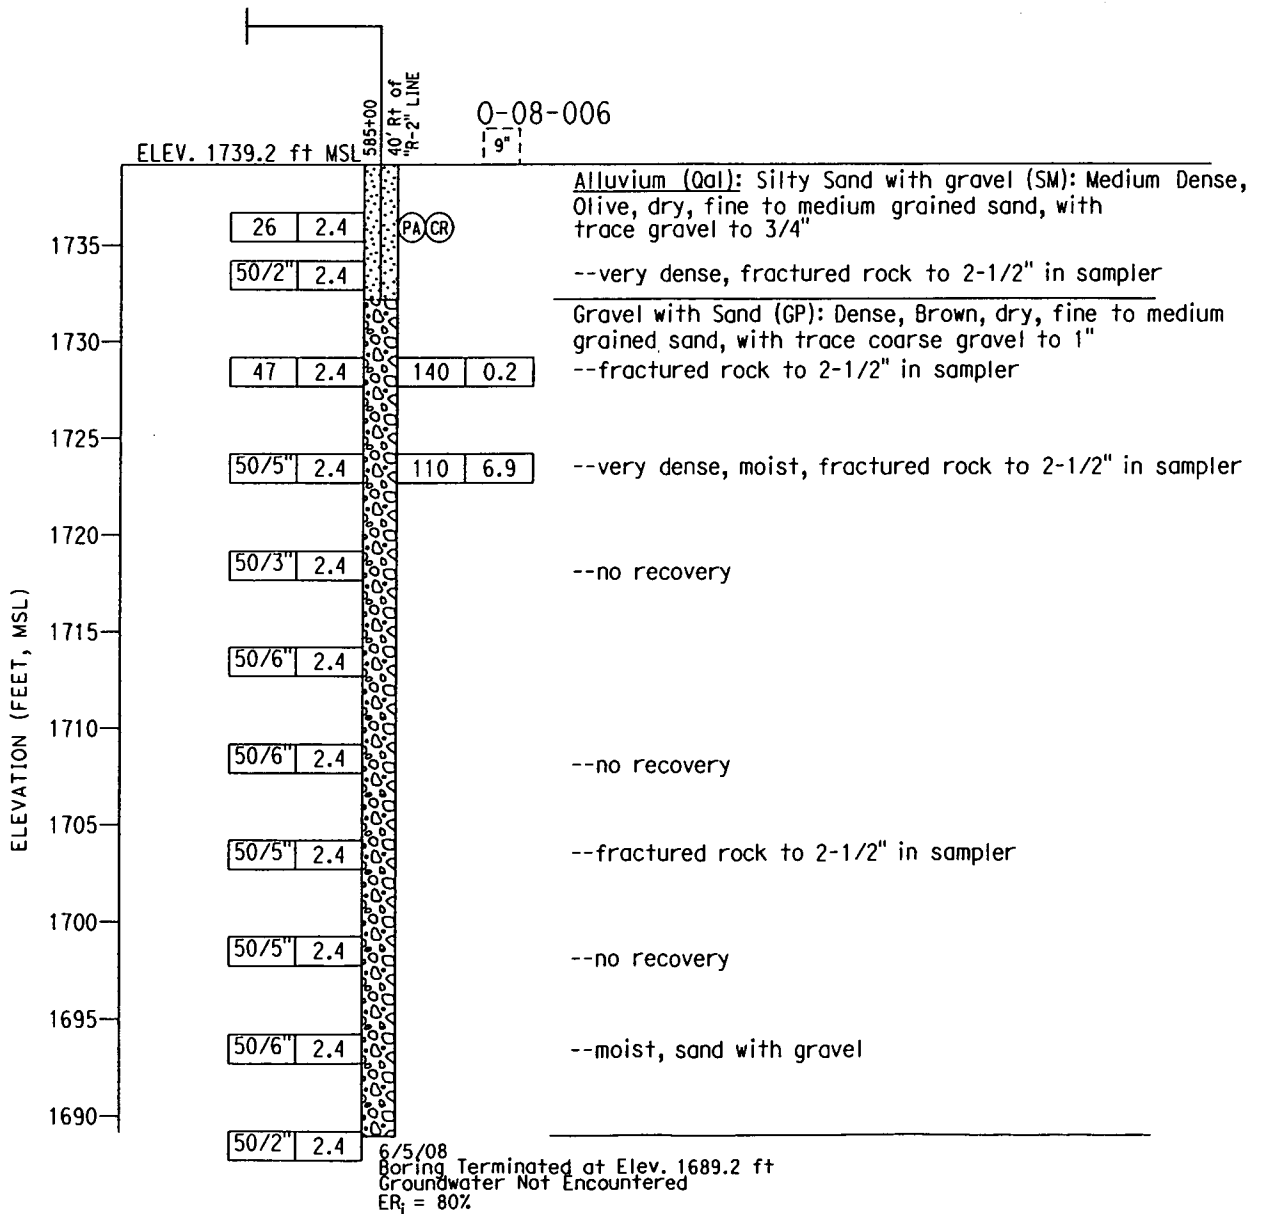

NOTES:

- BORING DRILLED USING AP 1000 PERCUSSION HAMMER (BECKER HAMMER).
- 1.4-INCH DIAMETER SAMPLES WERE TAKEN USING A STANDARD PENETRATION TEST (SPT) SPLIT BARREL SAMPLER WITH AN INSIDE DIAMETER (ID) OF 1.4 INCHES AND AN OUTSIDE DIAMETER (OD) OF 2.0 INCHES.
- 2.4-INCH DIAMETER RING SAMPLES WERE TAKEN USING A CALIFORNIA SPLIT BARREL SAMPLER WITH AN ID OF 2.4 INCHES AND AN OD OF 3.3 INCHES.
- ALL SAMPLES WERE DRIVEN WITH 140 LB HAMMER WITH A FALLING HEIGHT OF 30 INCHES.
- THIS LOTB SHEET WAS PREPARED IN ACCORDANCE WITH THE CALTRANS SOIL AND ROCK LOGGING, CLASSIFICATION, AND PRESENTATION MANUAL (JUNE 2007).


BENCHMARK:
STATE PLANE ZONE: 5
HORIZONTAL DATUM: NAD 83, EPOCH 1992.88
VERTICAL DATUM: NGVD 29
GLOBAL ORIGIN: 6616251.6352, 1757251.6352, -214748.364

C. AMANTE DESIGN OVERSIGHT	DRAWN BY D. FAHRNEY	J. SIPE (STAFF ENGINEER) FIELD INVESTIGATION BY:	PREPARED FOR THE STATE OF CALIFORNIA DEPARTMENT OF TRANSPORTATION		C. AMANTE PROJECT ENGINEER	BRIDGE NO. TBD	RETAINING WALL NO. 2	
SIGN OFF DATE	CHECKED BY M. CHIRUMALLA	DATE: 06/05/08	CU 08224 EA 0H1301		POST MILES	LOG OF TEST BORINGS NO. 2		
GS LOTB ROCK LEGEND	ORIGINAL SCALE IN INCHES FOR REDUCED PLANS		0 1 2 3		DISREGARD PRINTS BEARING EARLIER REVISION DATES	REVISION DATES	SHEET 17 OF 17	

FILE => mse2-2-1tb04.dgn

TIME PLOTTED => 4/29/2009 12:19:53 PM USERNAME => LAN Eng Inboard\eng\lotted =>


DIST	COUNTY	ROUTE	POST MILES TOTAL PROJECT	SHEET No	TOTAL SHEETS
08	Sbd	15	10.32/11.44		44
REGISTERED CIVIL ENGINEER DATE					
PLANS APPROVAL DATE					
The State of California or its officers or agents shall not be responsible for the accuracy or completeness of electronic copies of this plan sheet.					
CITY OF FONTANA 1170 WEST 3RD STREET SAN BERNARDINO, CA 92410					
LIM & NASCIMENTO ENGINEERING 1887 BUSINESS CENTER DRIVE, SUITE 6 SAN BERNARDINO, CALIFORNIA 92408					
KLEINFELDER WEST INC. 1220 RESEARCH DRIVE, SUITE B REDLANDS, CALIFORNIA 92374					

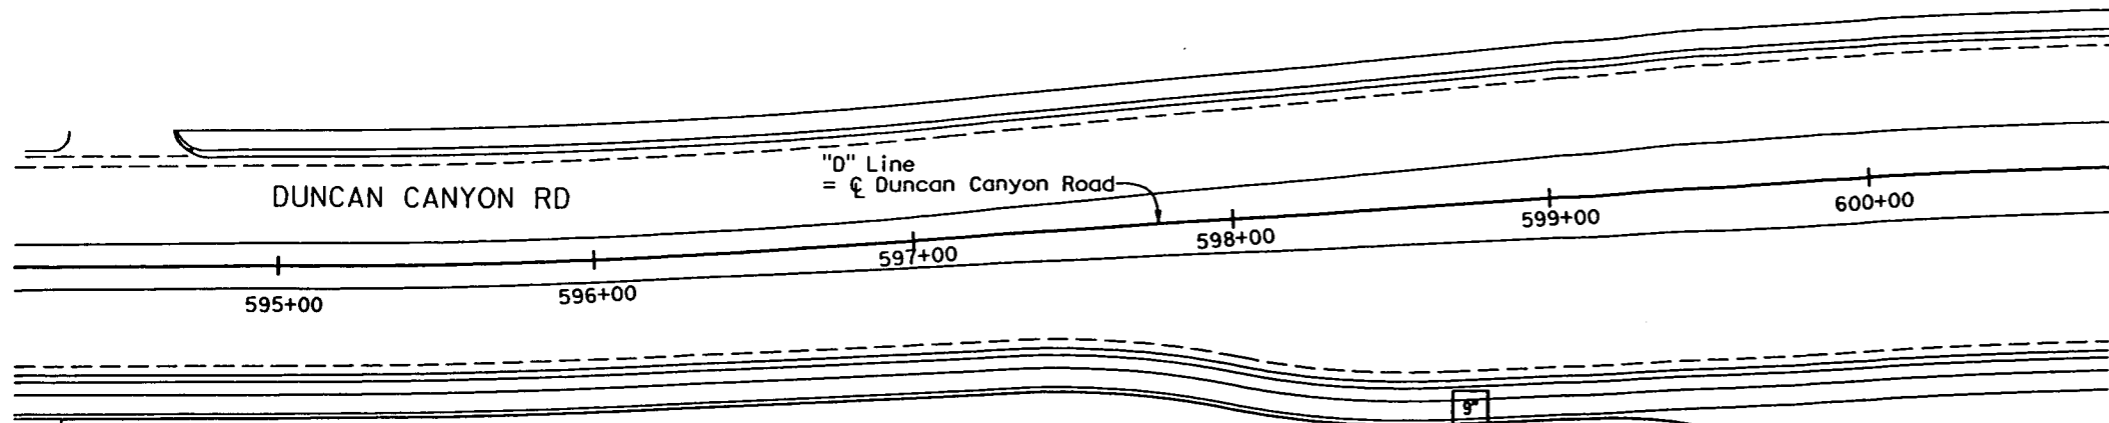

PLAN
1" = 30'

Begin Ret Wall No. 1
"RW1" LOL 10+00.00
=47.43 Rt "D" Line
Sta 594+32.17

End Ret Wall No. 1
"RW1" LOL 16+55.00
=162.56 Rt "D" Line
Sta 600+47.59

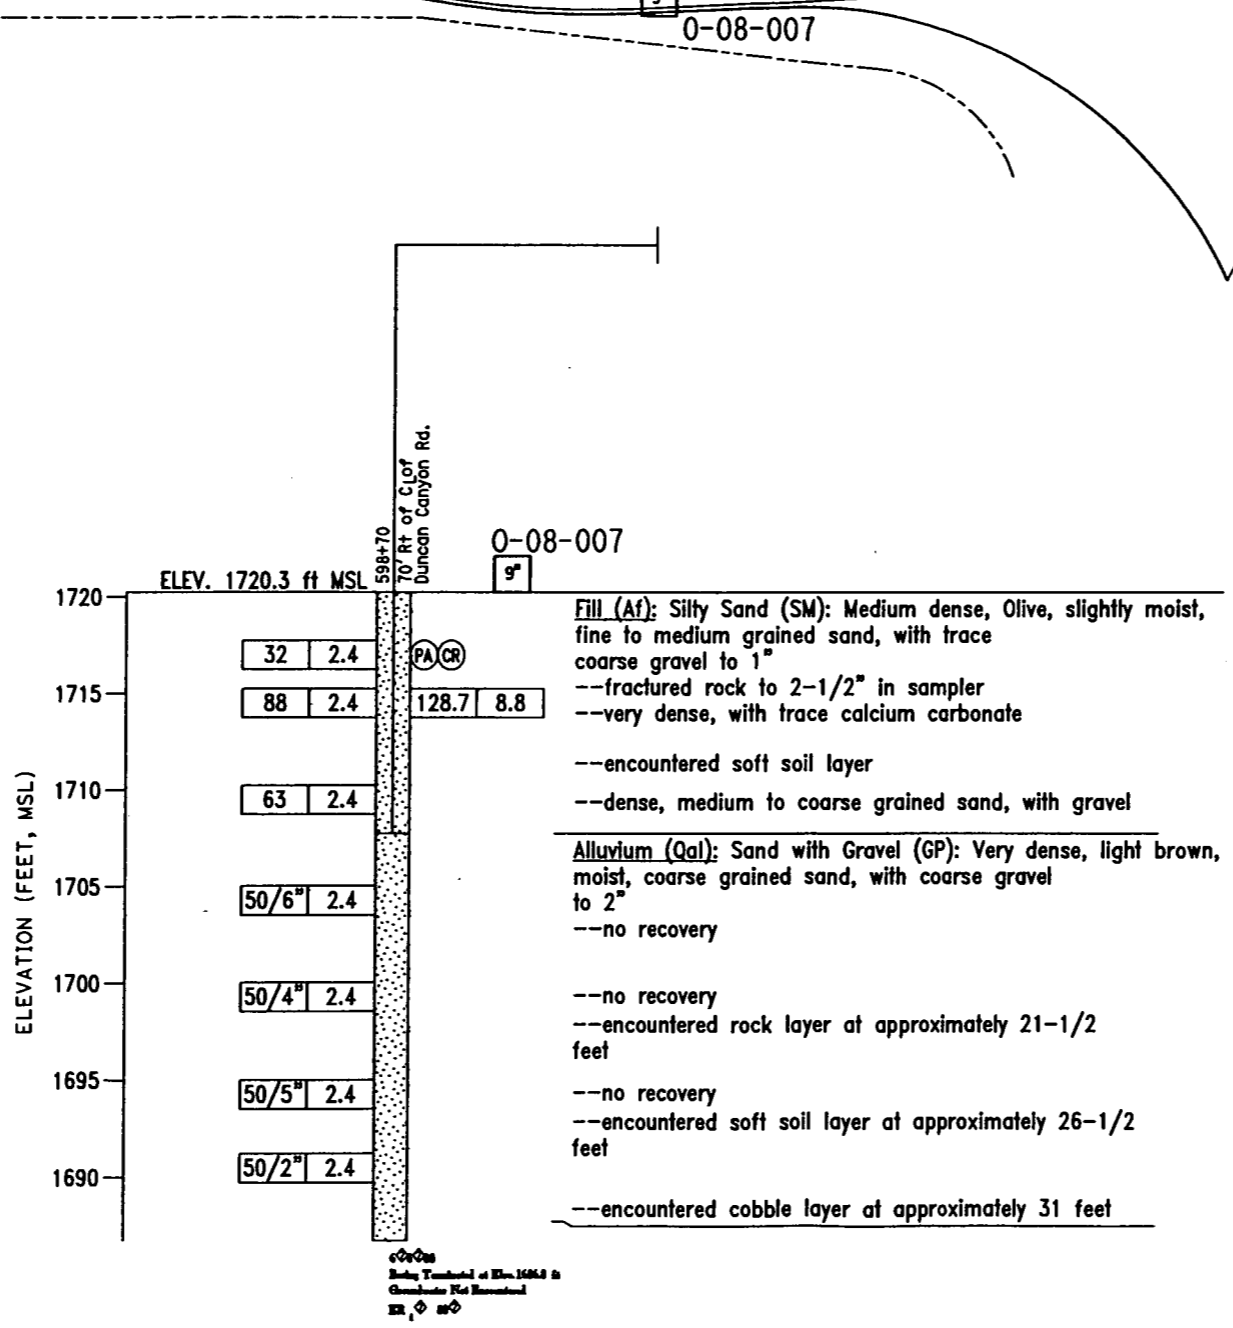

NOTES:

- BORING DRILLED USING AP 1000 PERCUSSION HAMMER (BECKER HAMMER).
- 1.4-INCH DIAMETER SAMPLES WERE TAKEN USING A STANDARD PENETRATION TEST (SPT) SPLIT BARREL SAMPLER WITH AN INSIDE DIAMETER (ID) OF 1.4 INCHES AND AN OUTSIDE DIAMETER (OD) OF 2.0 INCHES.
- 2.4-INCH DIAMETER RING SAMPLES WERE TAKEN USING A CALIFORNIA SPLIT BARREL SAMPLER WITH AN ID OF 2.4 INCHES AND AN OD OF 3.3 INCHES.
- ALL SAMPLES WERE DRIVEN WITH 140 LB HAMMER WITH A FALLING HEIGHT OF 30 INCHES.
- THIS LOG SHEET WAS PREPARED IN ACCORDANCE WITH THE CALTRANS SOIL AND ROCK LOGGING, CLASSIFICATION, AND PRESENTATION MANUAL (JUNE 2007).

BENCHMARK:

STATE PLANE ZONE: 5
 HORIZONTAL DATUM: NAD 83, EPOCH 1992.88
 VERTICAL DATUM: NGVD 29
 GLOBAL ORIGIN: 6616251.6352, 1757251.6352, -214748.364

PROFILE
VERTICAL 1" = 5'


C. AMANTE DESIGN OVERSIGHT	DRAWN BY D. FAHRNEY	J. SIPE (STAFF ENGINEER) FIELD INVESTIGATION BY:	PREPARED FOR THE STATE OF CALIFORNIA DEPARTMENT OF TRANSPORTATION	C. AMANTE PROJECT ENGINEER	BRIDGE NO. TBD	RETAINING WALL NO. 1	
SIGN OFF DATE	CHECKED BY M. CHIRUMALLA	DATE: 06/05/08			POST MILES	LOG OF TEST BORINGS NO. 1	
GS LOTB ROCK LEGEND		ORIGINAL SCALE IN INCHES FOR REDUCED PLANS	0 1 2 3	CU 08224 EA 0H1301	DISREGARD PRINTS BEARING EARLIER REVISION DATES	REVISION DATES	SHEET 15 OF 15

USERNAME => LAN_Eng (number) PLOTTED => 4/29/2009 12:07:11 PM

Sierra Avenue UC

DIST.	COUNTY	ROUTE	POST MILES - TOTAL PROJECT	SHEET NO.	TOTAL SHEETS
08	SBD	15			

BRIDGE ENGINEER _____ REGISTERED CIVIL ENGINEER NO. 55005
 DATE APPROVED _____

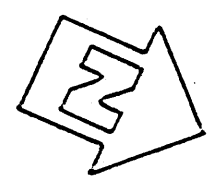

LEGEND OF BORING OPERATIONS

CONCRETE PENETROMETER
 1/2" CONCRETE PENETROMETER
 SAMPLER BORING (DRY)
 ROTARY BORING (DRY)
 WALKER BORING (DRY)
 WALKER BORING (WET)
 CORE BORING
 TEST PIT

SOIL TUBE
 1" SOIL TUBE

ROTARY BORING
 Description of material
 No. of blows (N)
 Size of sampler (in)
 Sampler with
 Undisturbed compressive strength (T_{cu})
 Shear strength (lb/sq ft)
 Vane shear

PENETRATION BORING
 Top Hole Elevation
 No. of blows
 Pushed into
 Driving rate
 McKernon-Terry
 (Type, or omitted)

LEGEND OF EARTH MATERIALS

CLAY, SILT, CLAYEY SILT, CLAYEY SAND, ORGANIC MATTER, FILL MATERIAL, IGNEOUS ROCK, SEDIMENTARY ROCK, METAMORPHIC ROCK, GRAVEL, SAND, SILT, CLAY, SANDY CLAY, CLAYEY SAND, SILTY SAND, SANDY SILT, SILTY CLAY

CONSISTENCY CLASSIFICATION FOR SOILS

According to the Standard Penetration Test

Cohesive: Very soft, Soft, Stiff, Very stiff, Hard, Very hard

Non-cohesive: Very loose, Loose, Slightly compact, Compact, Dense, Very dense



No. of blows: 0-5, 5-10, 10-20, 20-35, 35-70, >70

CLASSIFICATION OF MATERIAL BASED ON STANDARD GRADE SIZE LIMITS

Diagram showing the base for classification of soils. If GRAVEL is present in the determination of class, the class name, with GRAVELLY, SAND, SILTY, CLAYEY, etc., and fine when used to describe SAND, SILT, CLAY, and fine when used to describe SILT, SAND, SILTY, CLAYEY, etc. size limits.

BM # P162 P12 Elev. 2013.90
 Bathey Stake & cap top dike
 332' Rt. Sta 712 + 45 & Imp.

702+79.63 POT Sierra Ave.
 702+79.63 POT Rt. 15

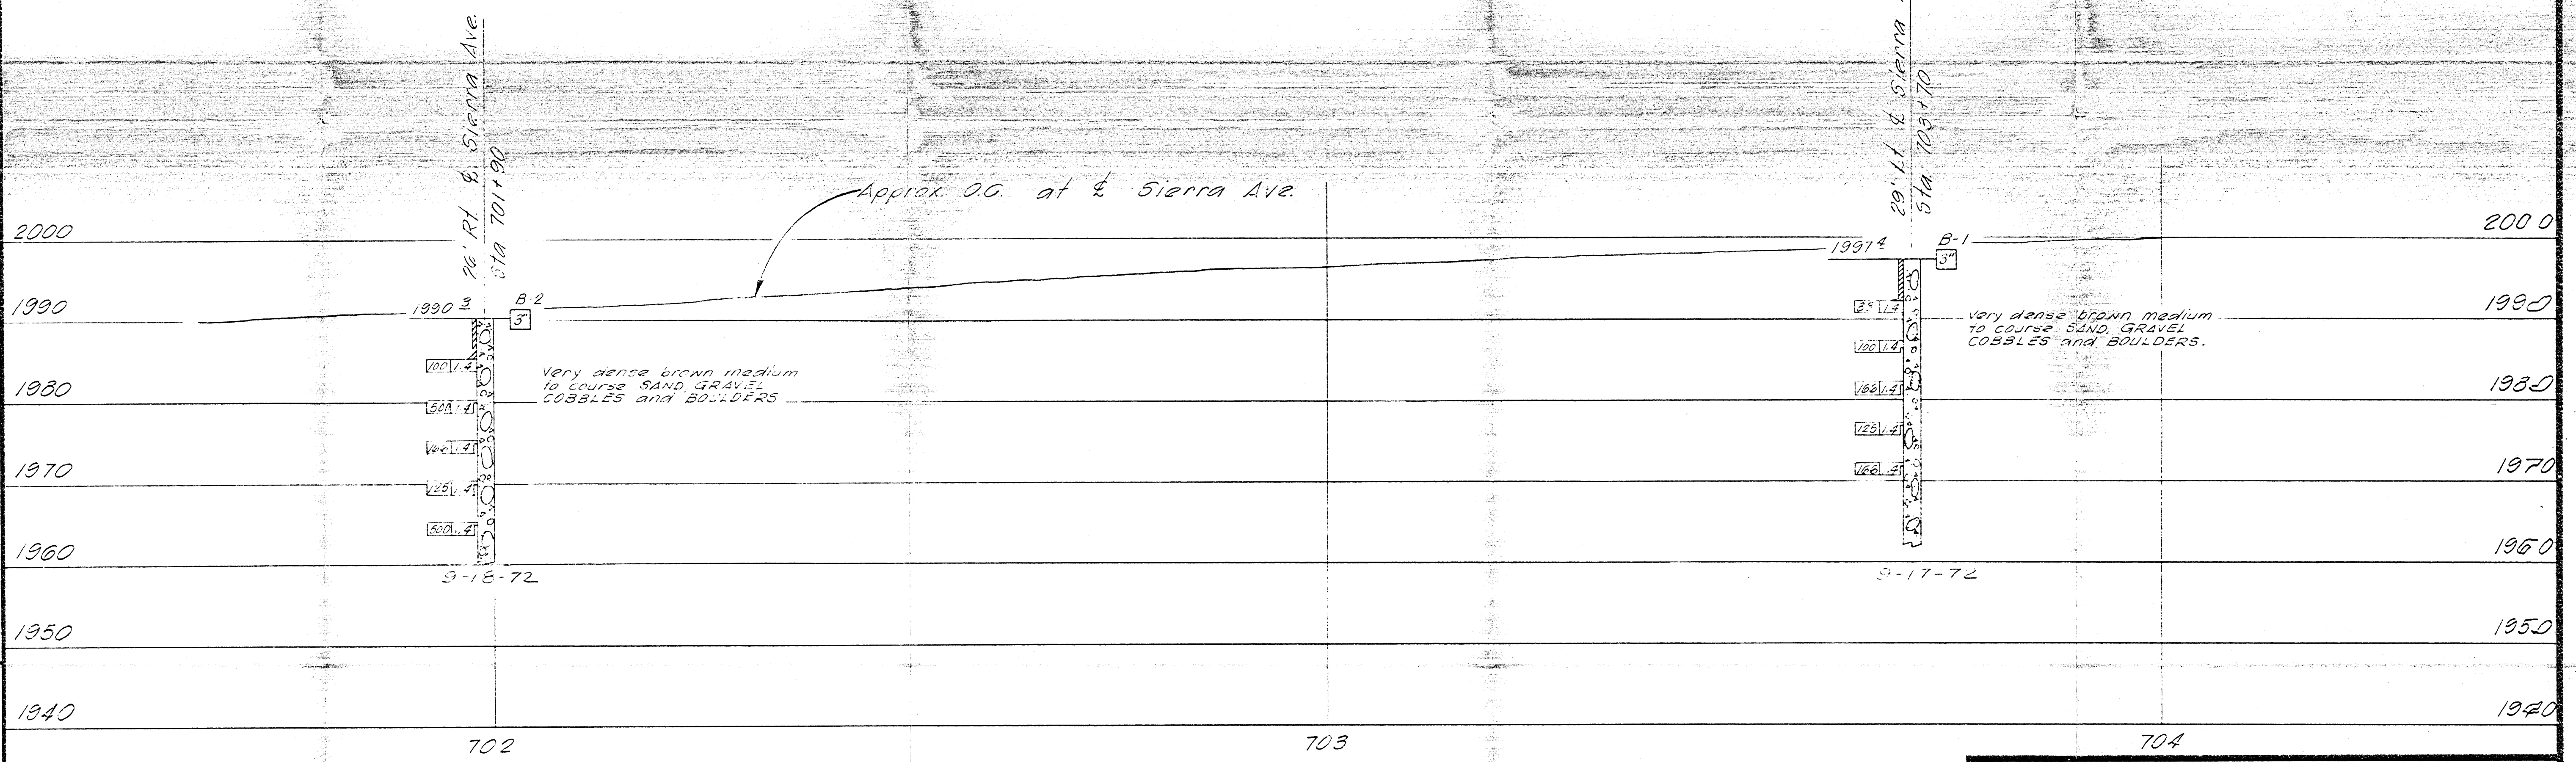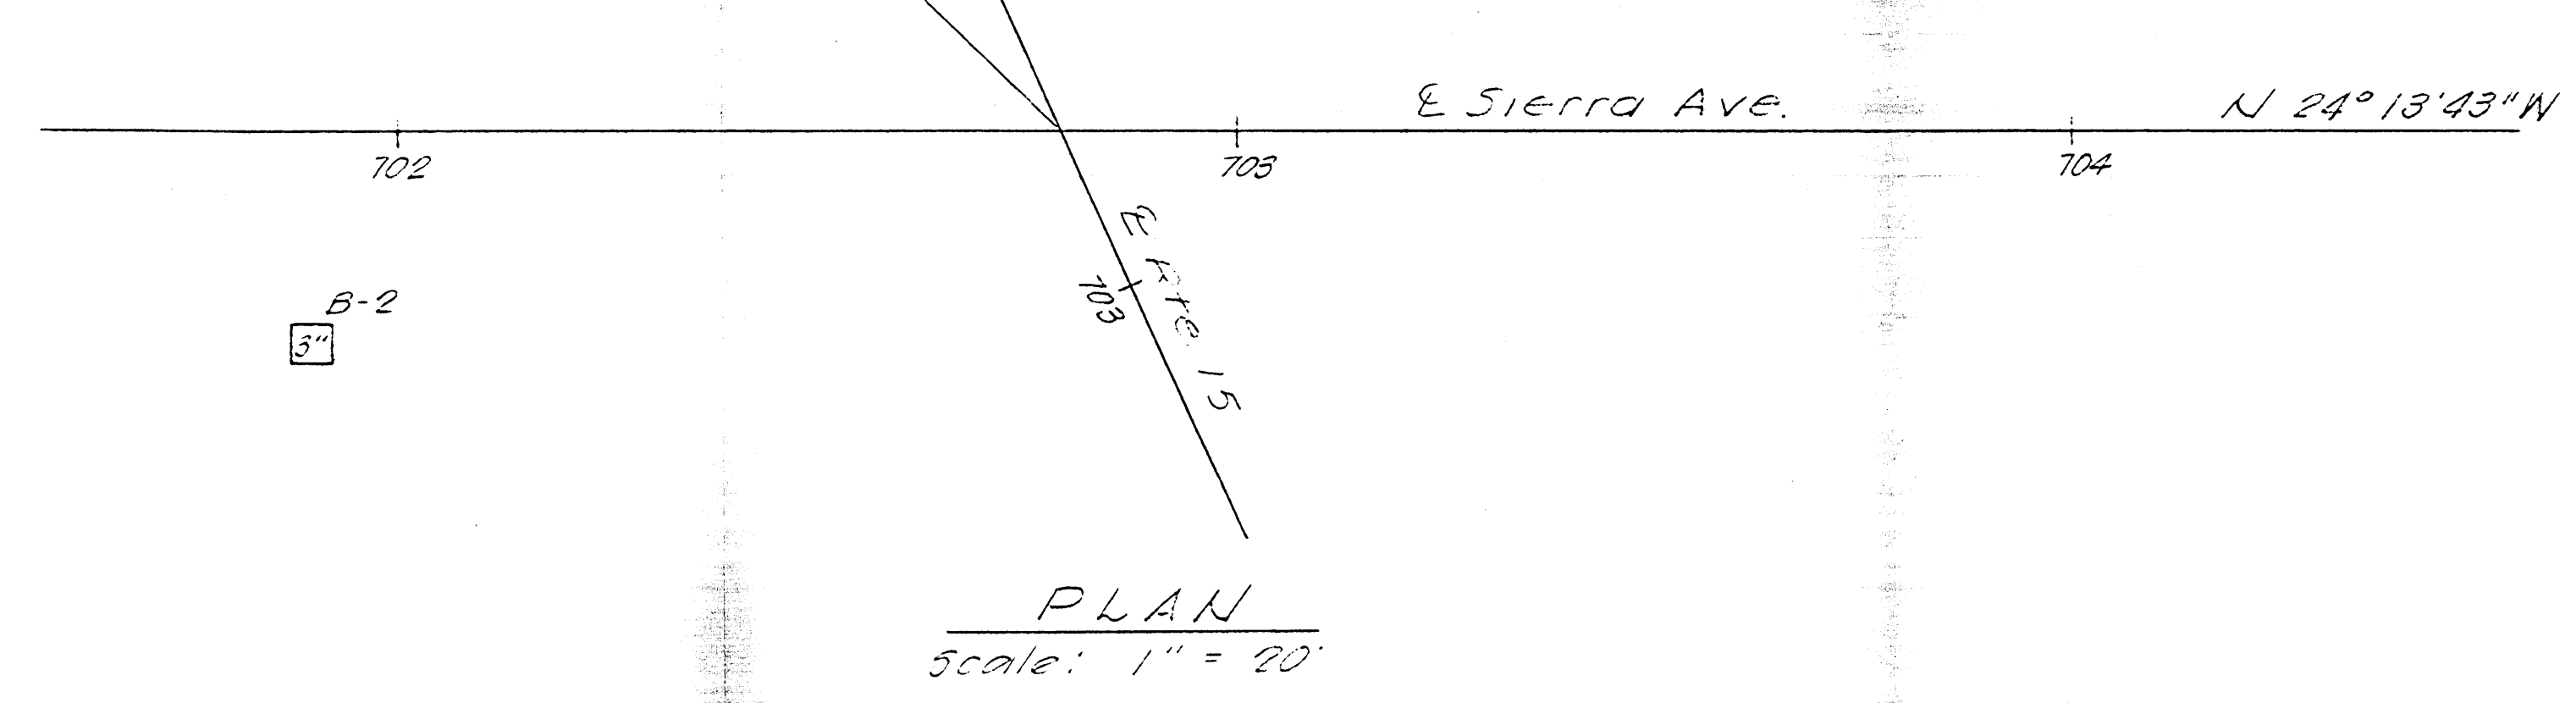

PROFILE
 Scale: Horiz 1" = 10'
 Vert. 1" = 10'

BRIDGE DEPARTMENT
 ENGINEERING GEOLOGY SECTION

FIELD STUDY by R. FOX 9-72
 DRAWN by OKABAYASHI 12/17/72
 CHECKED by R. FOX 10-18-72

Approval Recommended by _____ Engineering Geologist
 Certified Engineering Geologist No. _____

STATE OF CALIFORNIA
 TRANSPORTATION AGENCY
 DEPARTMENT OF PUBLIC WORKS
 DIVISION OF HIGHWAYS

SIERRA AVENUE UNDERCROSSING

LOG OF TEST BORINGS

BRIDGE NO. 54-981 R/L POST MILE 12.9 DRAWING NO. _____ SHEET _____ OF _____

REVISION DATES (PRELIMINARY STAGE ONLY)

Lytle Creek Bridge

DIST.	COUNTY	ROUTE	POST MILES - TOTAL PROJECT	SHEET NO.	TOTAL SHEETS
08	SBD	31			

LEGEND OF BORING OPERATIONS

2 1/4" CONE PENETROMETER
Blow per foot - (US) - lb
Blow per foot - (MET) - kg

SAMPLER BORING (DRY)
Rotary Boring (WET)

AUGER BORING (DRY)

JET BORING

CORE BORING



TEST PIT

LEGEND OF EARTH MATERIALS
SILTY CLAY or CLAYEY SILT
PEAT and/or ORGANIC MATERIAL
FILL MATERIAL
IGNEOUS ROCK
SEDIMENTARY ROCK
METAMORPHIC ROCK

LEGEND OF SOILS
Very soft
Soft
Stiff
Very stiff
Hard
Very hard

CLASSIFICATION OF MATERIAL BASED ON STANDARD GRADE SIZE LIMITS

Diagram showing the basis for estimates of grade size distribution... GRAVEL... SAND... SILT... CLAY...

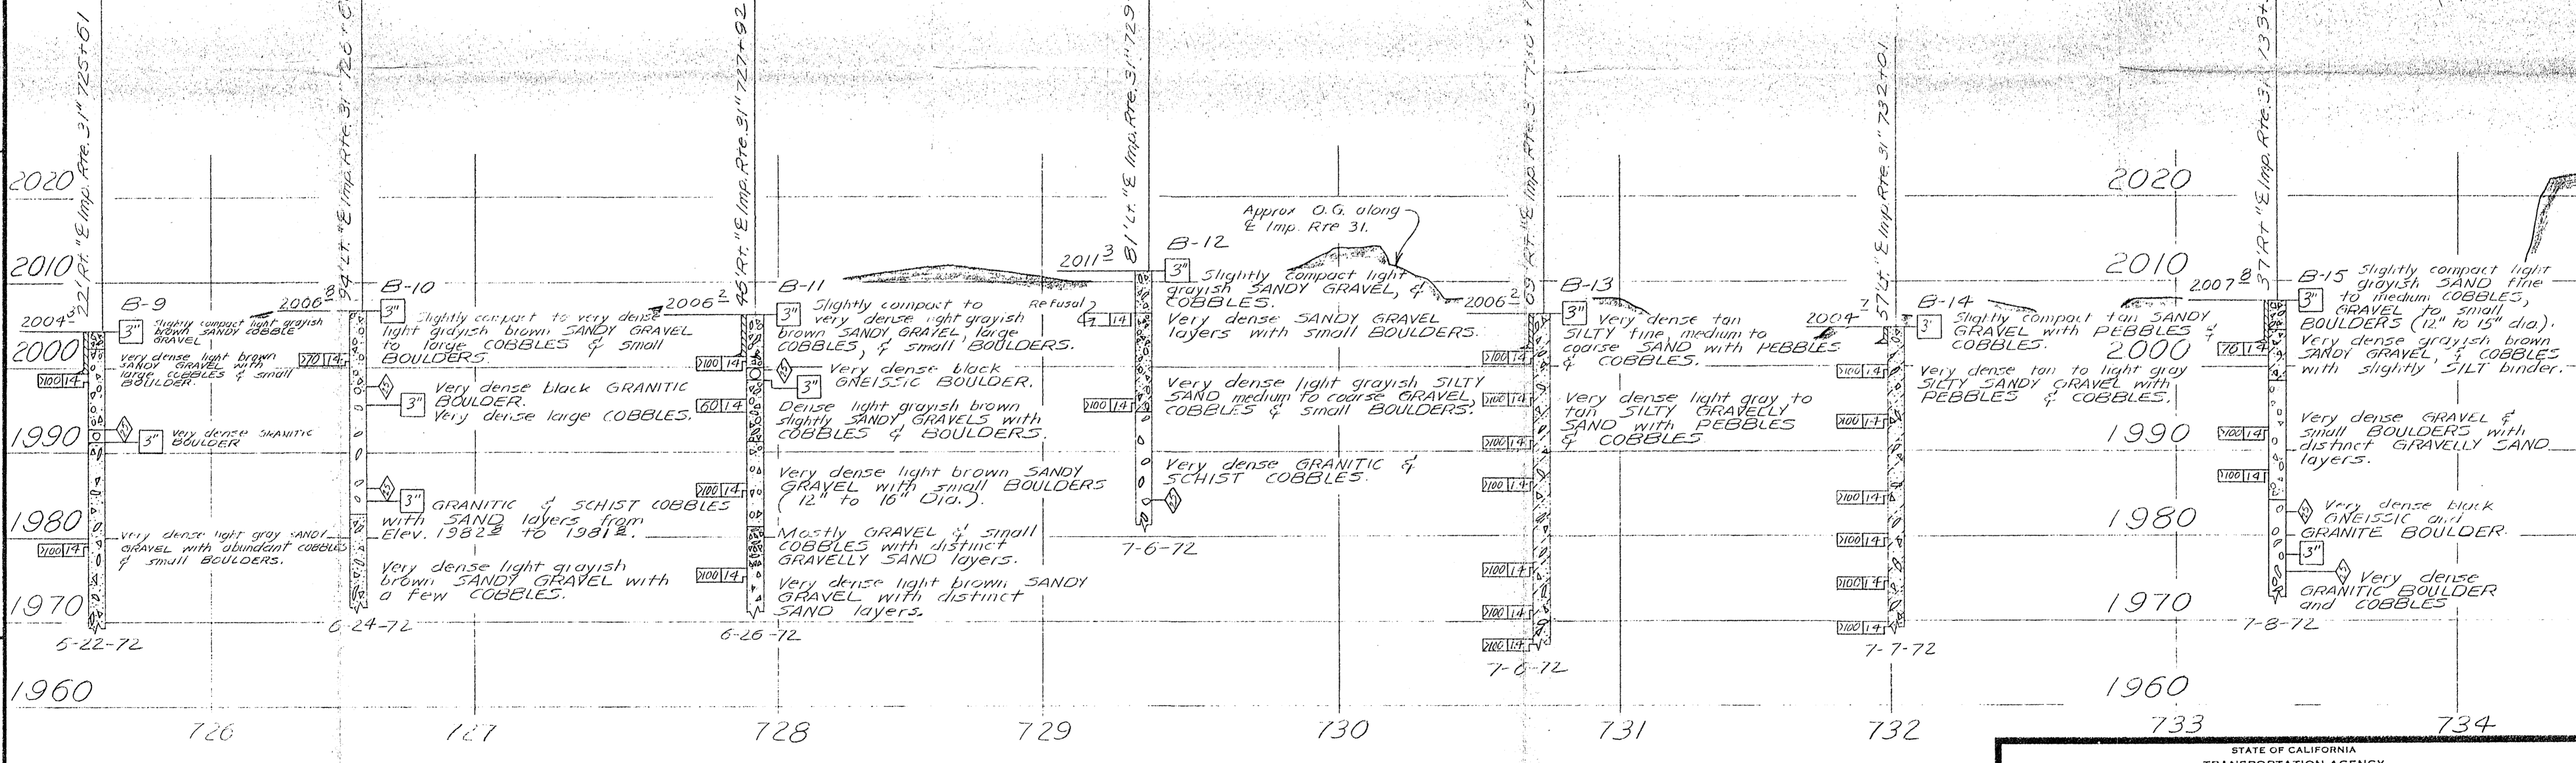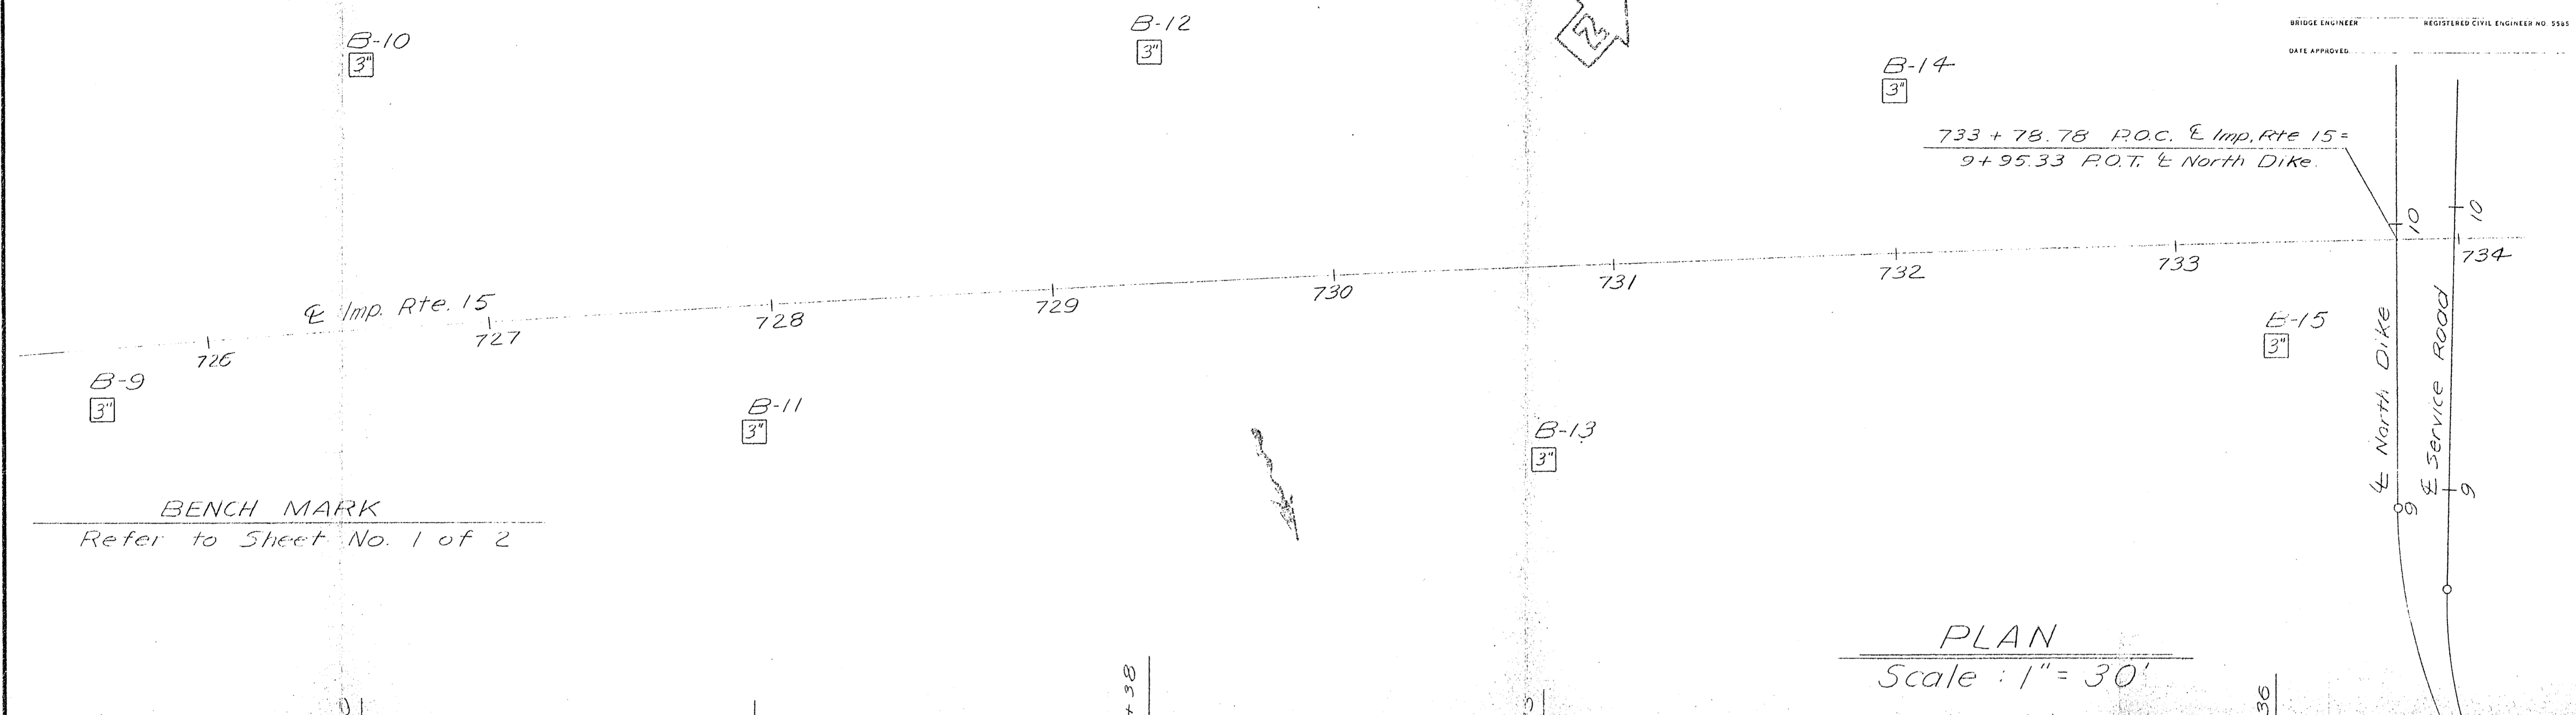

PROFILE
Scale: Horiz. 1" = 30'
Vert. 1" = 10'

BRIDGE DEPARTMENT
ENGINEERING GEOLOGY SECTION

FIELD STUDY by R. Fox 7-72
DRAWN by S.T. Kawamura 8-23-72
CHECKED by R. Fox 9-6-72

Approval Recommended by: [Signature]
Certified Engineering Geologist No. [Number]

STATE OF CALIFORNIA
TRANSPORTATION AGENCY
DEPARTMENT OF PUBLIC WORKS
DIVISION OF HIGHWAYS

LYTLE CREEK BRIDGE

LOG OF TEST BORINGS (2 of 2)

BRIDGE NO. 54-982 R/L	POST MILE R136	DRAWING NO.	SHEET OF
		REVISION DATES (PRELIMINARY STAGE ONLY)	

Revised: Moved E Imp. Rte. 15
1-9-73 S. KAWAMURA

WO 172201
CU 08203

DIST.	COUNTY	ROUTE	POST MILES-TOTAL PROJECT	SHEET NO.	TOTAL SHEETS
08	580	31			

B-8
3"
BRIDGE ENGINEER
REGISTERED CIVIL ENGINEER NO. 52615
DATE APPROVED: _____

LEGEND OF BORING OPERATIONS

SOIL TUBE
Top hole E.I.
Blows per foot
Blows per foot with 1/2" free fall
Description of material
Date measured
GWS Elevation
Penetration test
30' log, or as noted
Unclassified material
Shear strength (lb/ft²)
Sieve analysis (lb/ft²)
Vane shear
Unrecoverable material change

ROTARY BORING
Top hole E.I.
Blows per foot
Blows per foot with 1/2" free fall
Description of material
Date measured
GWS Elevation
Penetration test
30' log, or as noted
Unclassified material
Shear strength (lb/ft²)
Sieve analysis (lb/ft²)
Vane shear
Unrecoverable material change


2 1/2" CONE PENETROMETER
Top hole E.I.
Blows per foot
Blows per foot with 1/2" free fall
Description of material
Date measured
GWS Elevation
Penetration test
30' log, or as noted
Unclassified material
Shear strength (lb/ft²)
Sieve analysis (lb/ft²)
Vane shear
Unrecoverable material change

LEGEND OF EARTH MATERIALS

CLASSIFICATION OF MATERIAL BASED ON STANDARD GRADE SIZE LIMITS

CONSISTENCY CLASSIFICATION FOR SOILS

NOTE: Classification of earth material as shown on this sheet is based upon field inspection and is not to be construed to imply mechanical analysis.

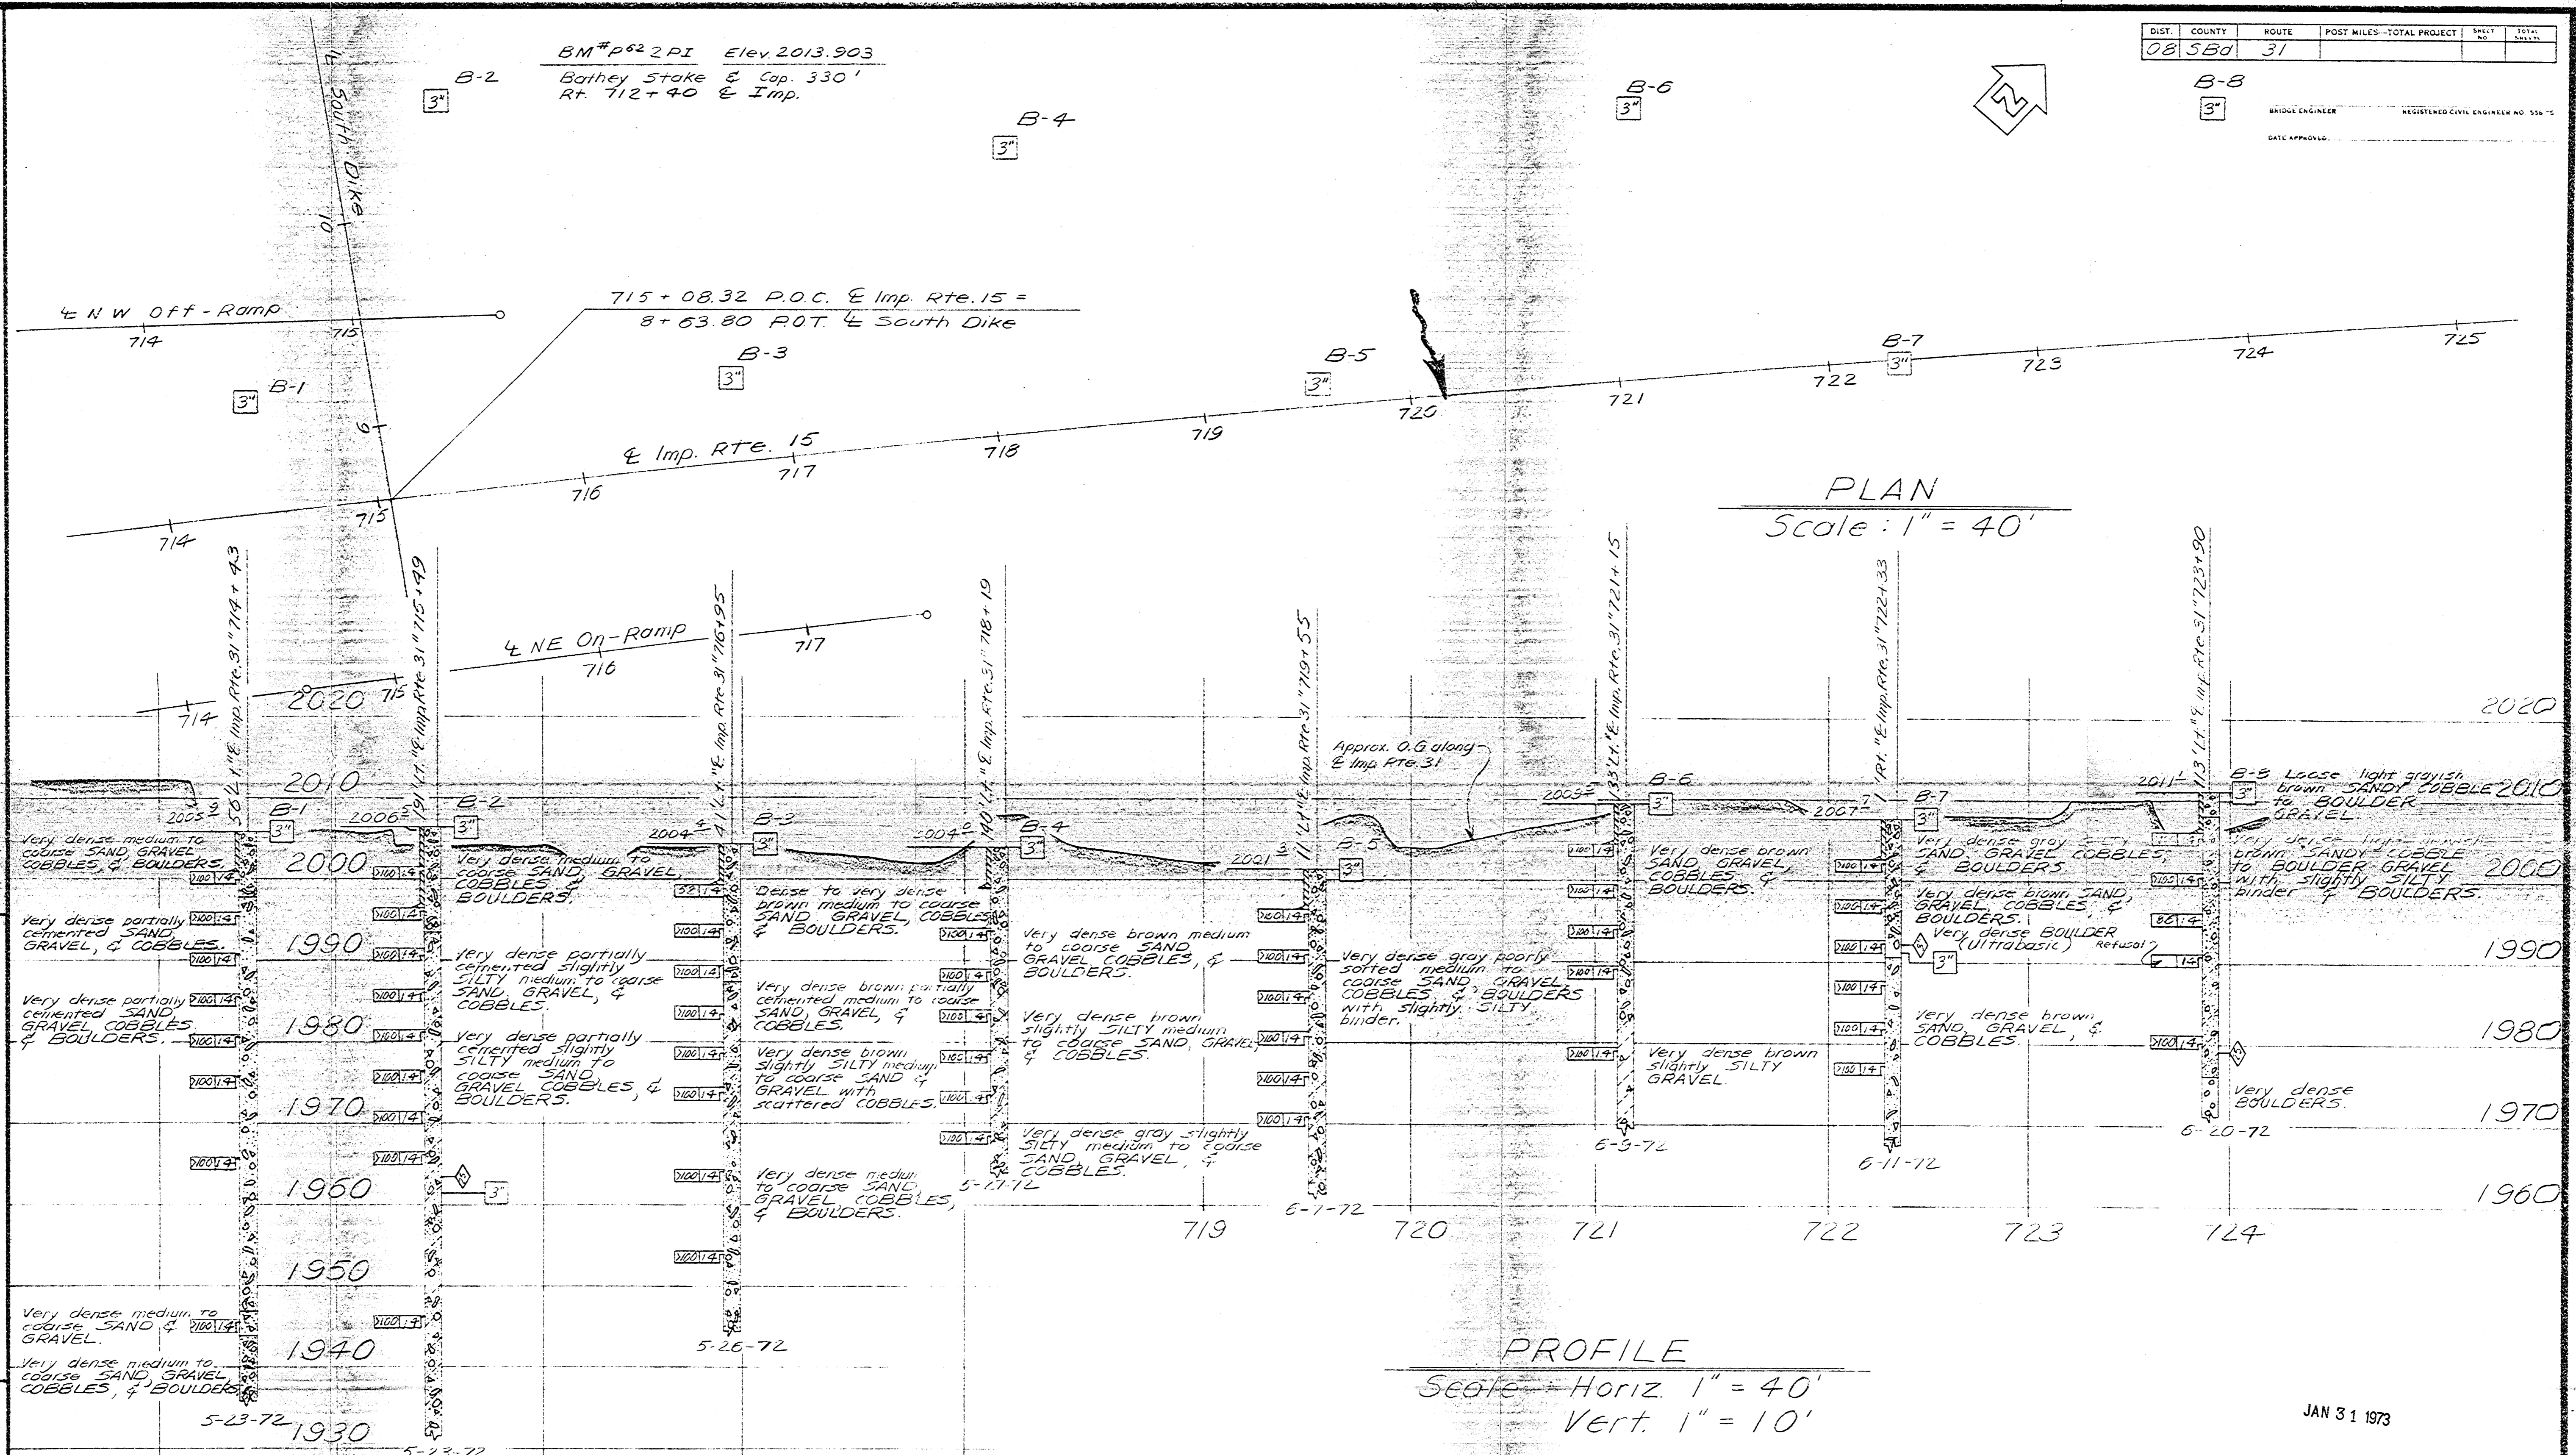

PLAN
Scale: 1" = 40'

PROFILE
Scale - Horiz. 1" = 40'
Vert. 1" = 10'

NO GROUND WATER ENCOUNTERED DURING THIS INVESTIGATION BY BRIDGE DEPT. GEOLOGY SECTION DATE 7-72

Revised: Moved & Imp. Rte. 15
1-9-73 S. KAWAMURA

BRIDGE DEPARTMENT
ENGINEERING GEOLOGY SECTION
FIELD STUDY by R. FOX 7-72
DRAWN by S. T. KAWAMURA 8-22-72
CHECKED by R. FOX 9-6-72
Approval Recommended by _____
Certified Engineering Geologist No. _____

STATE OF CALIFORNIA
TRANSPORTATION AGENCY
DEPARTMENT OF PUBLIC WORKS
DIVISION OF HIGHWAYS

LYTLE CREEK BRIDGE

LOG OF TEST BORINGS (1 of 2)

BRIDGE NO. 54-982 R/L	POST MILE R13.6	DRAWING NO.	SHEET OF

REVISION DATES (PRELIMINARY STAGE ONLY)

1/91	
------	--

JAN 31 1973

WO 172201
CU 08203

Disregard prints bearing earlier revision dates


Glen Helen Parkway UC

DIST	COUNTY	ROUTE	POST MILES TOTAL PROJECT	SHEET NO	TOTAL SHEETS
08	Sbd	15			


BENCH MARK

PNO 173 2120.910
 FD STD Brass disk in concrete stamped
 "SBD-215-173 1988" 40' Ely of EOD Devore
 Rd Bridge at Nly end bridge; 70' Nly of EP
 NB SBD 215 at PM 17.3 at top of slope.

PNO 2010 2179.090
 FD STD Brass disk in concrete stamped
 "D8 SCN SBD-15 PM 16.3 08.04.08" At top
 of slope SOUTH of Connector Bridge
 from NB SBD 15 to NB SBD 215.

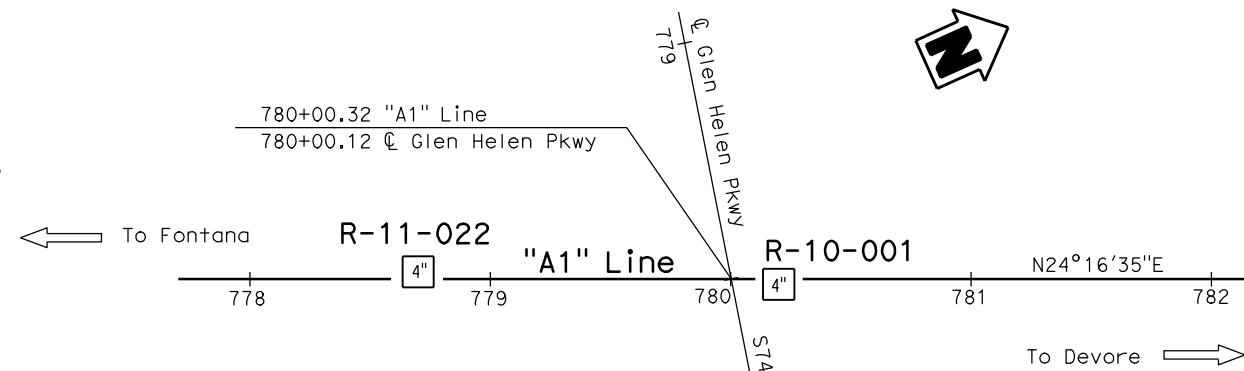


PLAN
1" = 40'

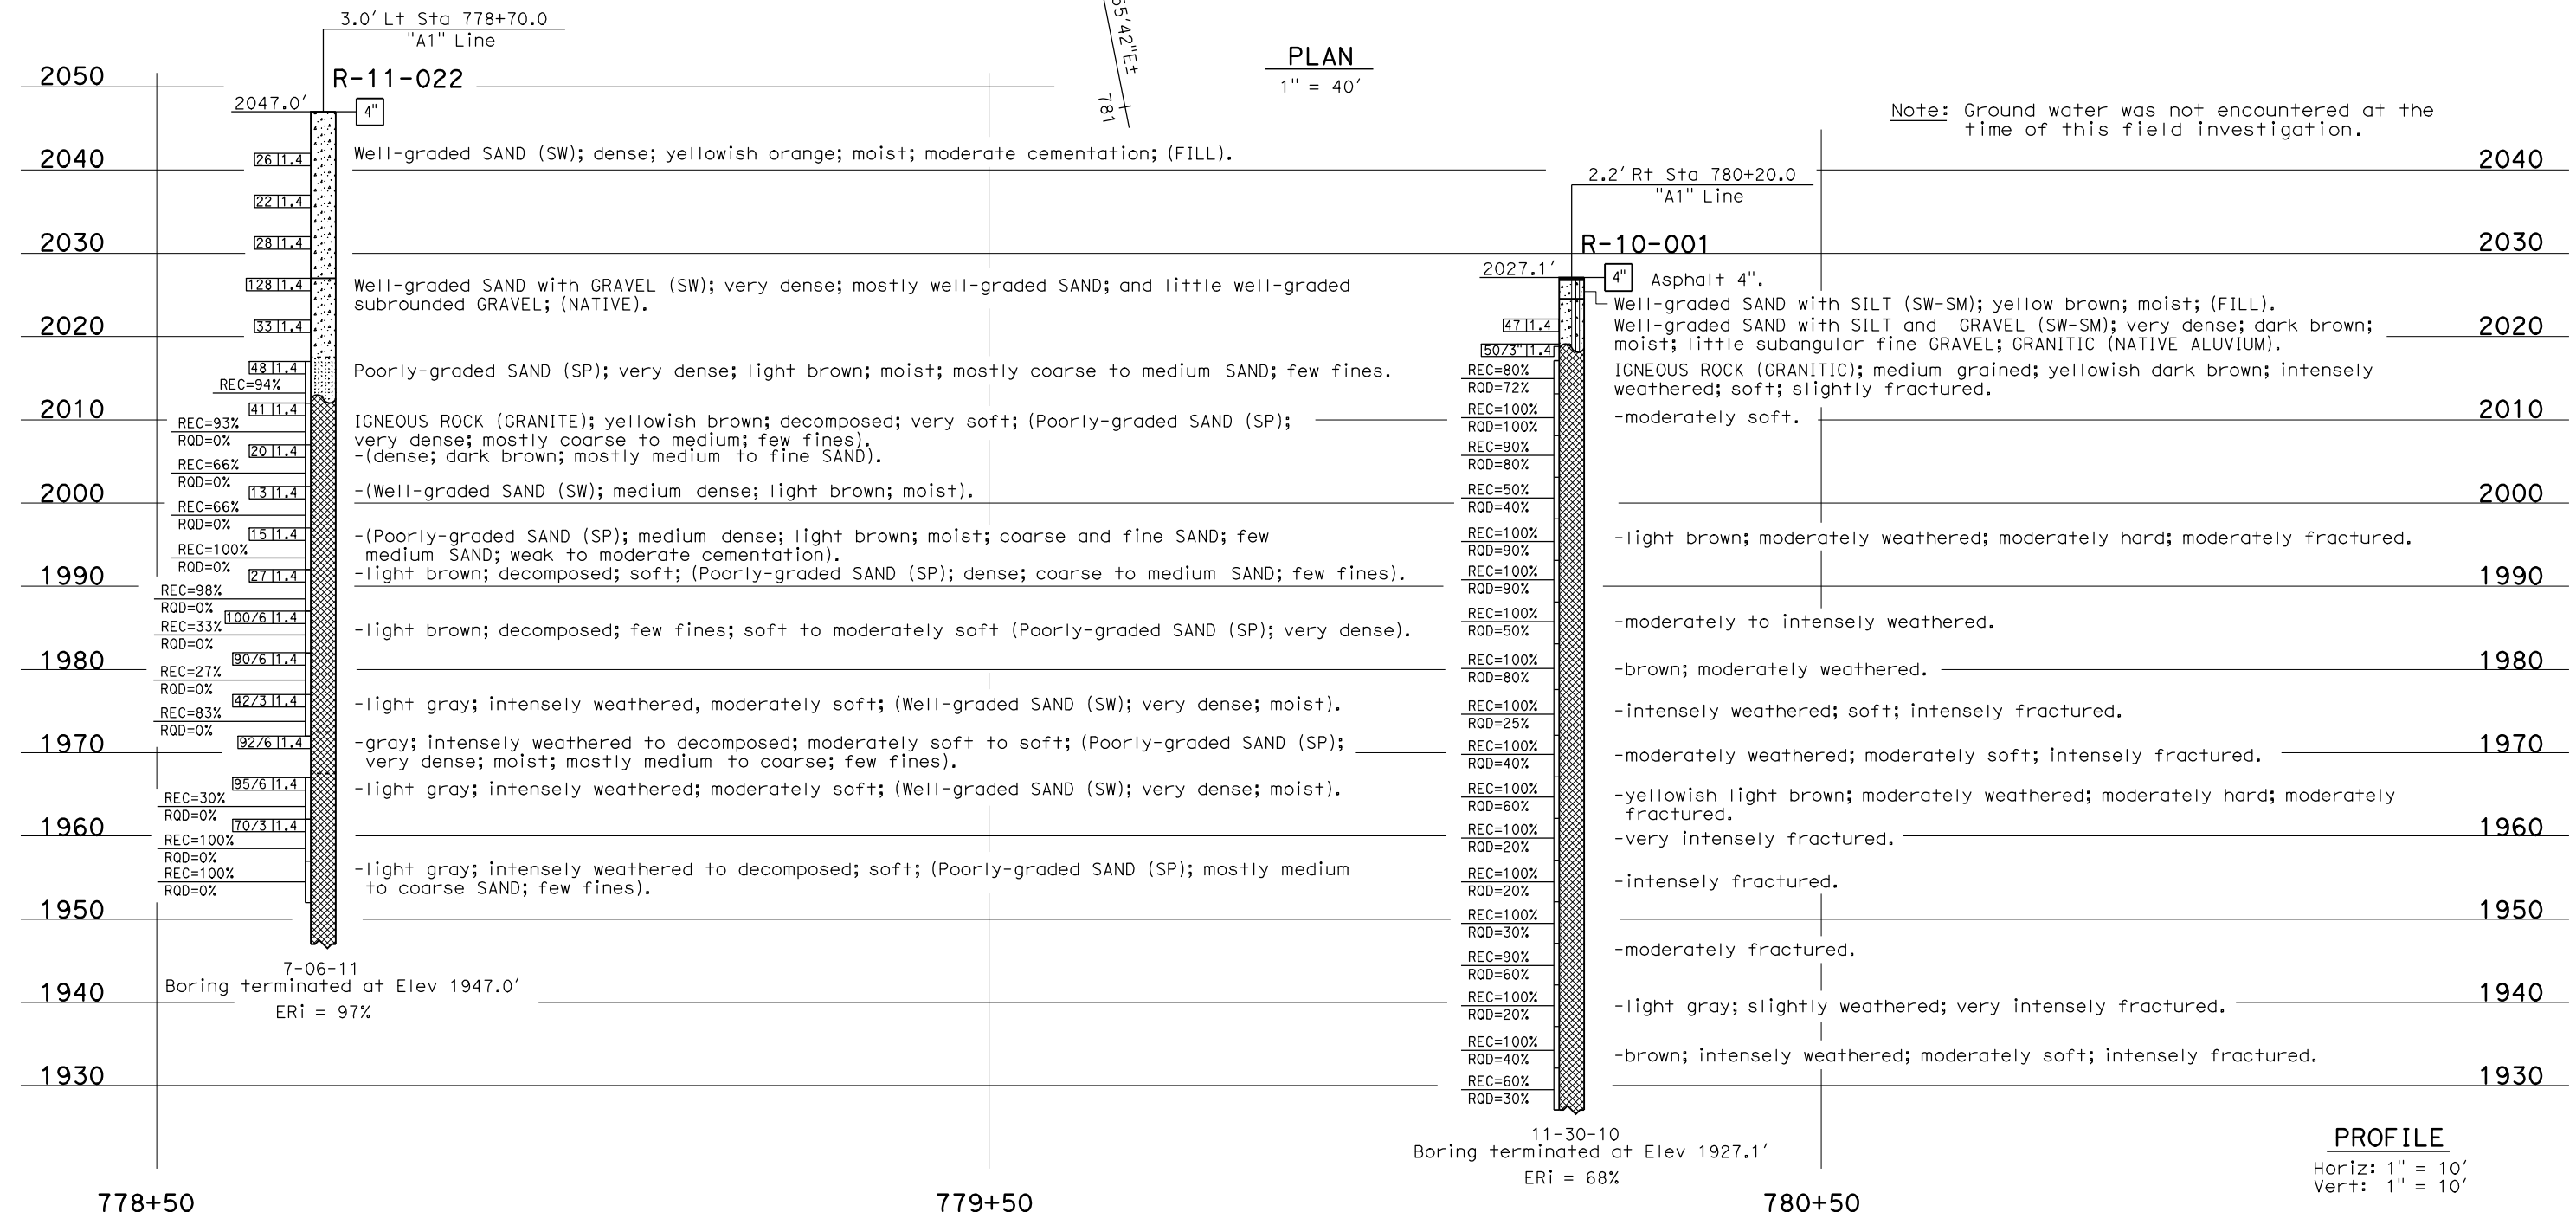

Note: Ground water was not encountered at the time of this field investigation.

PROFILE
 Horiz: 1" = 10'
 Vert: 1" = 10'

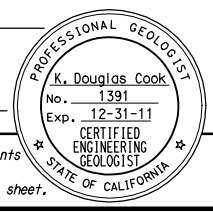

CERTIFIED ENGINEERING GEOLOGIST
 PLANS APPROVAL DATE
 The State of California or its officers or agents shall not be responsible for the accuracy or completeness of electronic copies of this plan sheet.

This LOTB sheet was prepared in accordance with the Caltrans Soil & Rock Logging, Classification, & Presentation Manual (2010 Edition).

ENGINEERING SERVICES		MATERIALS AND GEOTECHNICAL SERVICES		STATE OF CALIFORNIA DEPARTMENT OF TRANSPORTATION		DIVISION OF ENGINEERING SERVICES STRUCTURE DESIGN DESIGN BRANCH X		BRIDGE NO. 54-0779L/R POST MILE 14.77		GLEN HELEN PARKWAY UC (WIDEN)	
FUNCTIONAL SUPERVISOR NAME: A. Perez-Cobo		DRAWN BY: F. Nguyen 5/11 CHECKED BY: B. Levine/S. Logeswaran		FIELD INVESTIGATION BY: A. Wardak, D. Cook		UNIT: 3643 PROJECT NUMBER & PHASE: 08000003660		CONTRACT NO.: 08-0K7100		DISREGARD PRINTS BEARING EARLIER REVISION DATES	
OGS CIVIL LOG OF TEST BORINGS SHEET										REVISION DATES	
										10-30-11	10-24-11
										X	X

DATE PLOTTED => 25-OCT-2011 USERNAME => s128198

SHEET NO.	7
TOTAL SHEETS	8

DATE	NO.	BY	REVISION
08	584	51	11/26/67 258 584

[Handwritten Signature]
 HAWKINS



SEAL OF ENGINEERING SERVICES - MATERIALS AND GEOTECHNICAL
 This log of test borings sheet is considered an integral document of the...
 As such, the State of California requires that this document be filed with...
 and not be altered, changed, or otherwise modified. This document is a true and...
 accurate copy of the original document. It does not represent the liability of...
 the State of California, but is the property of the State of California. This document...
 is to be used and preserved only for the completion of this project, and is not to...
 be used for any other purpose.

CITY & COUNTY	ROUTE	POST MILE TOTAL	PROJECT	SHEET	DATE
San Diego	163	17.7	163	5	11-3-67

ENGINEERING DESIGNS
GLEN HELEN PARKWAY UC (WIDEN)
LOG OF TEST BORINGS 5 OF 5
 UNIT# 3643 CONTRACT NO. BRIDGE NO.
 PROJECT NUMBER & PHASE# 24000003650 CB-041100 54-0779-29

THIS LOG OF TEST BORINGS IS AVAILABLE AT OFFICE OF
 PUBLIC MAINTENANCE AND INVESTIGATION, SACRAMENTO, CALIFORNIA

LEGEND OF MATERIALS

- GRAVEL
- CLAY
- SAND
- SILT
- CLAY
- SAND
- SILT
- SAND
- SILT
- SAND
- SILT

LEGEND OF TEST BORING METHODS

- PROBE
- WATER
- PIVOT POINT
- WATER
- PIVOT POINT
- WATER
- PIVOT POINT

CLASSIFICATION OF MATERIALS


NOTE: Classification of earth material as shown on this sheet is based upon field inspection and is not to be construed to imply mechanical analysis.

ENGINEERING GEOLOGY SECTION

BENCH MARK
 P= PI'S Elev. 1593.33
 Bathy Stake & Cap in conc. Bur. 13
 250' R. Sta. 785+60.4 & Imp. Rte. 31

AS BUILT PLANS
 Contract No. 01-049114
 Date Completed 11-10-67
 Document No. 80000217

Note: All P Soil Tube Borings (SOBT) were driven with closed tip. Blows per ft. using 20 lb drop hammer with 12" free fall

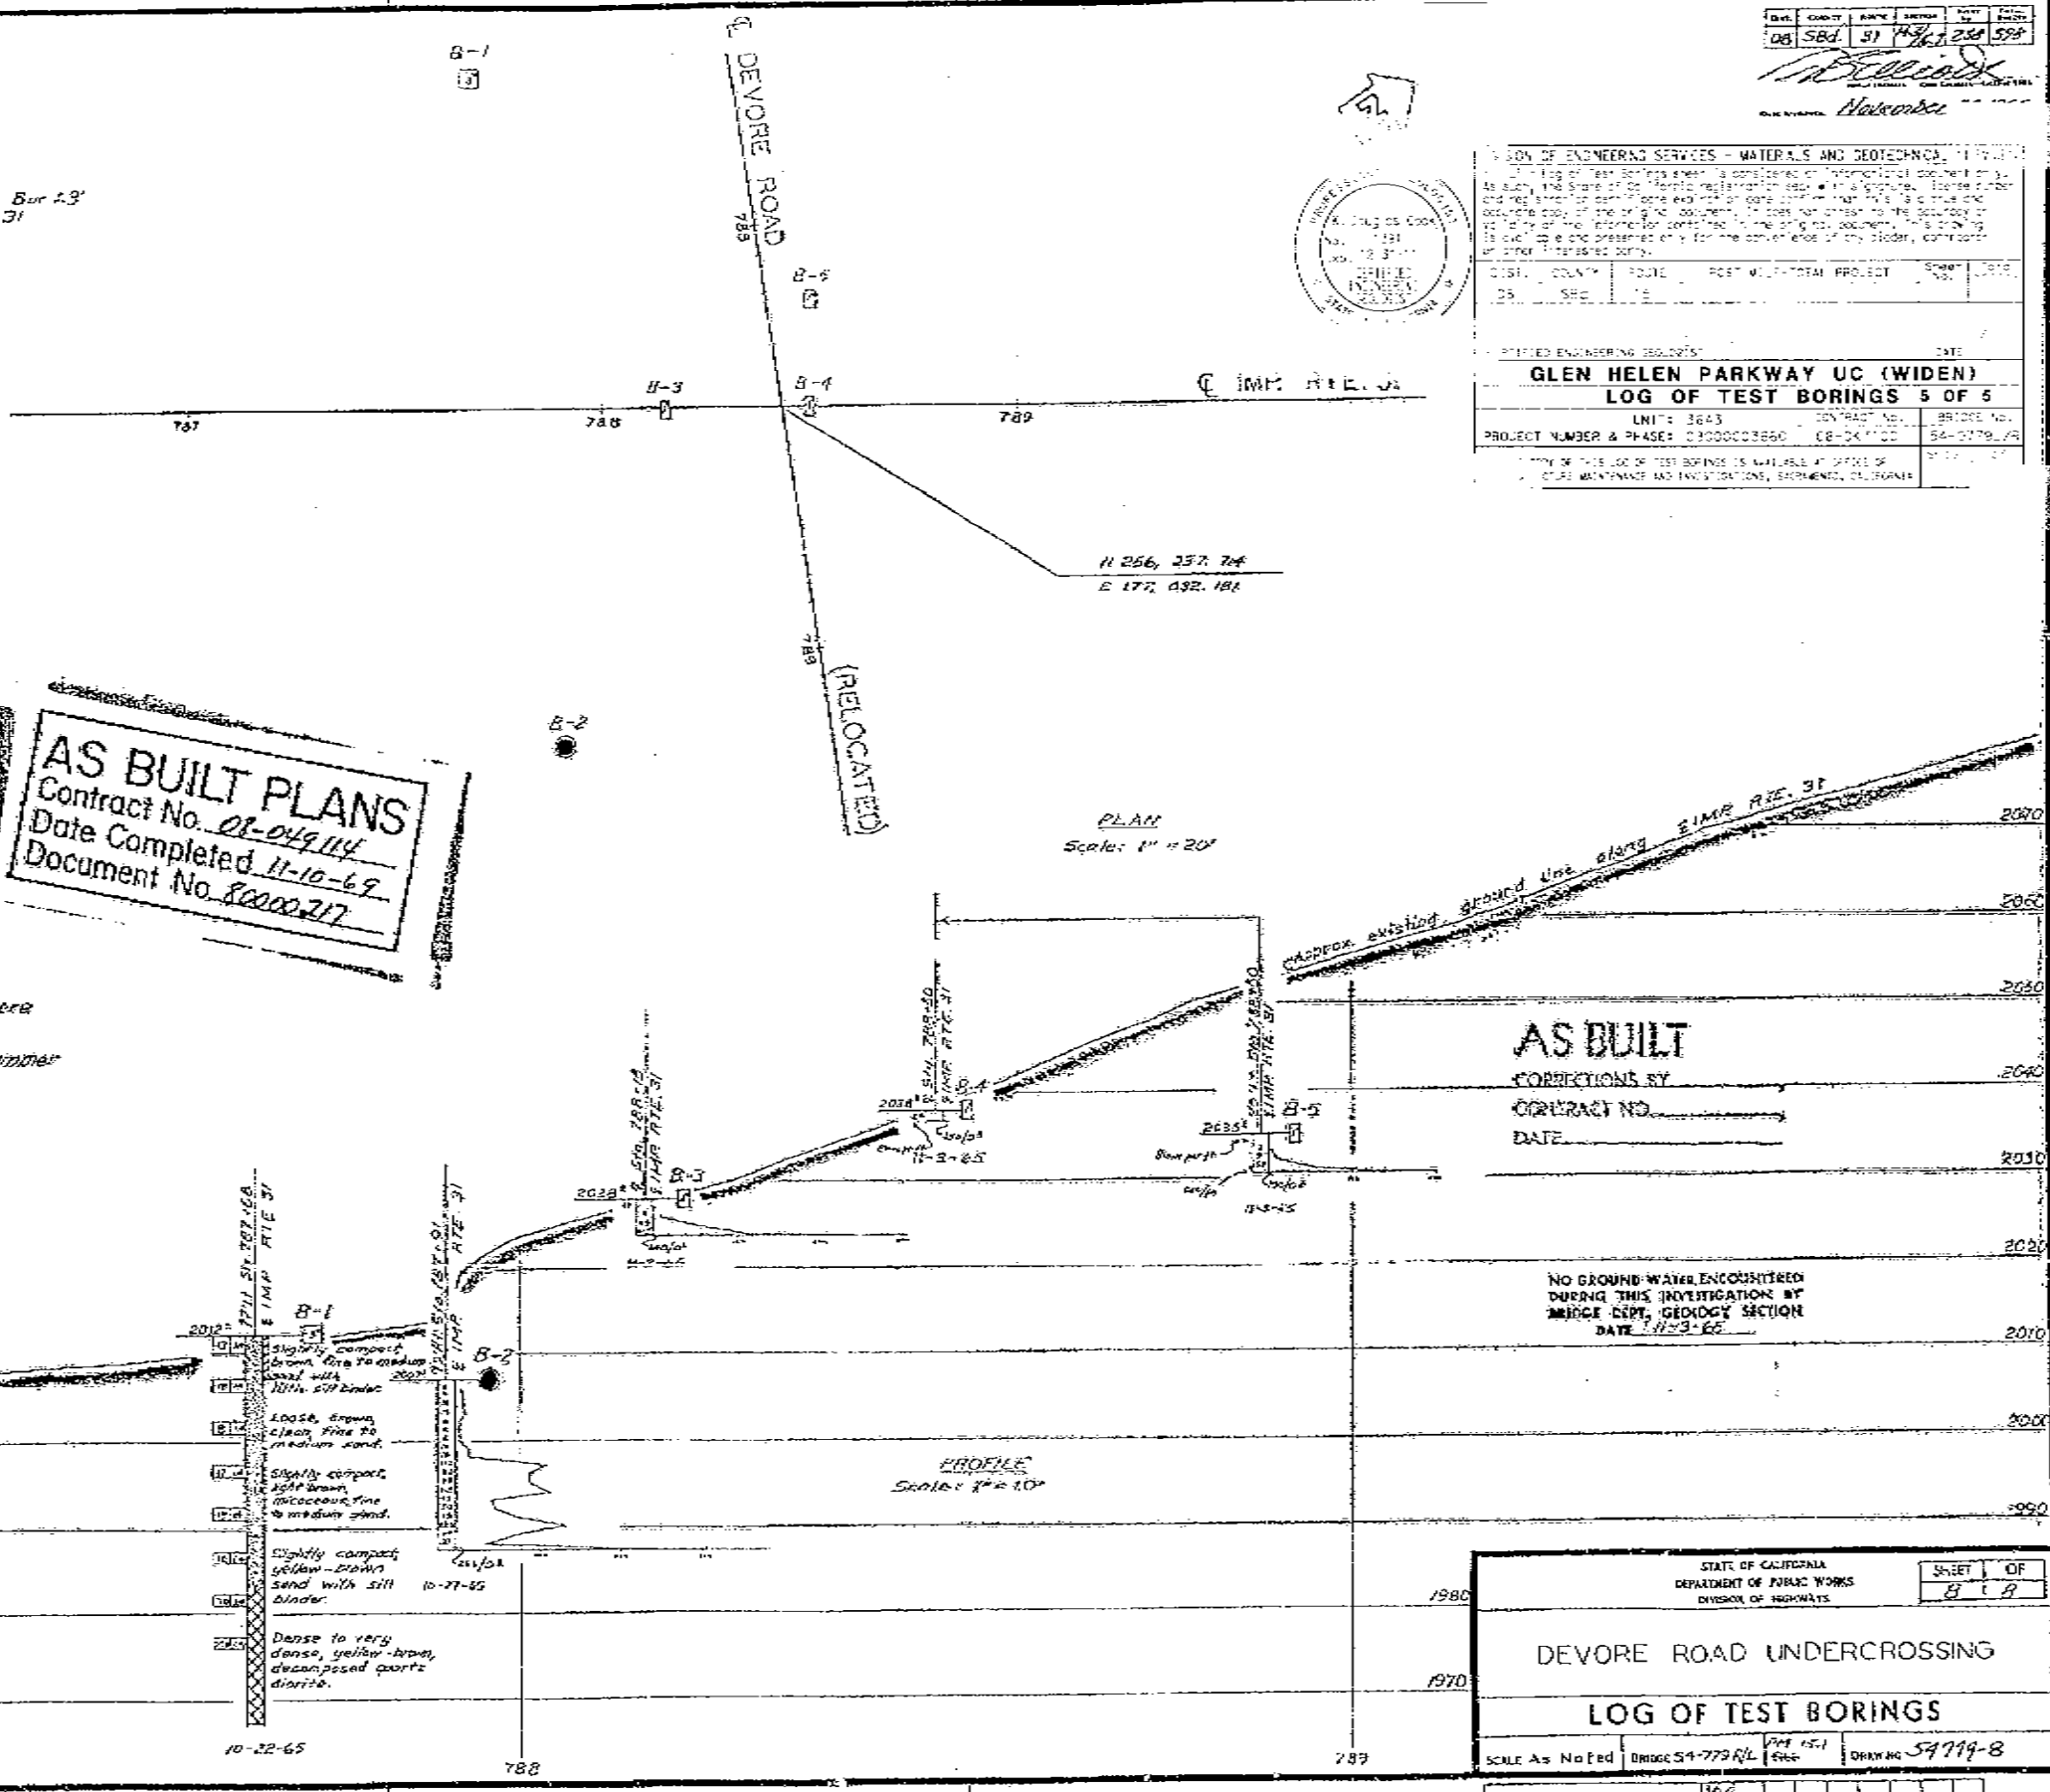

AS BUILT
 CORRECTIONS BY _____
 CONTRACT NO. _____
 DATE: _____

NO GROUND-WATER ENCOUNTERED DURING THIS INVESTIGATION BY BRIDGE DEPT. GEOLOGY SECTION
 DATE: 11-3-67



STATE OF CALIFORNIA DEPARTMENT OF PUBLIC WORKS DIVISION OF HIGHWAYS	SHEET 7 OF 8 B I B
DEVORE ROAD UNDERCROSSING	
LOG OF TEST BORINGS	
SCALE As Noted	BRIDGE 54-779 RL
DATE 11-15-67	DRAWING 54779-B

Charge: 08203

PREL. DRAWING NO. 828



BRIDGE ENGINEER _____ REGISTERED CIVIL ENGINEER NO. 3483
 DATE APPROVED _____

LEGEND OF BORING OPERATIONS

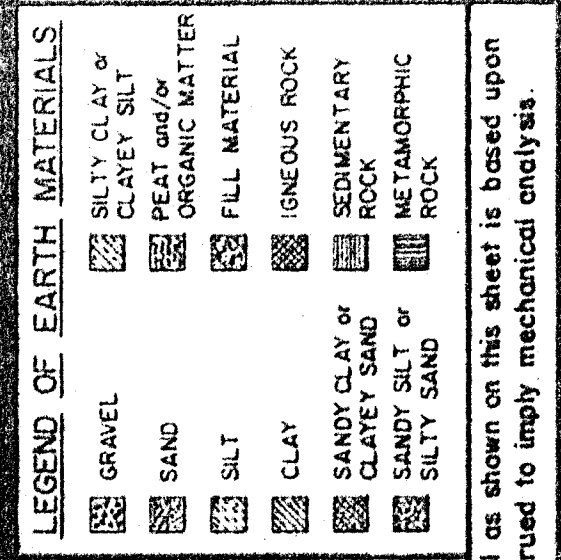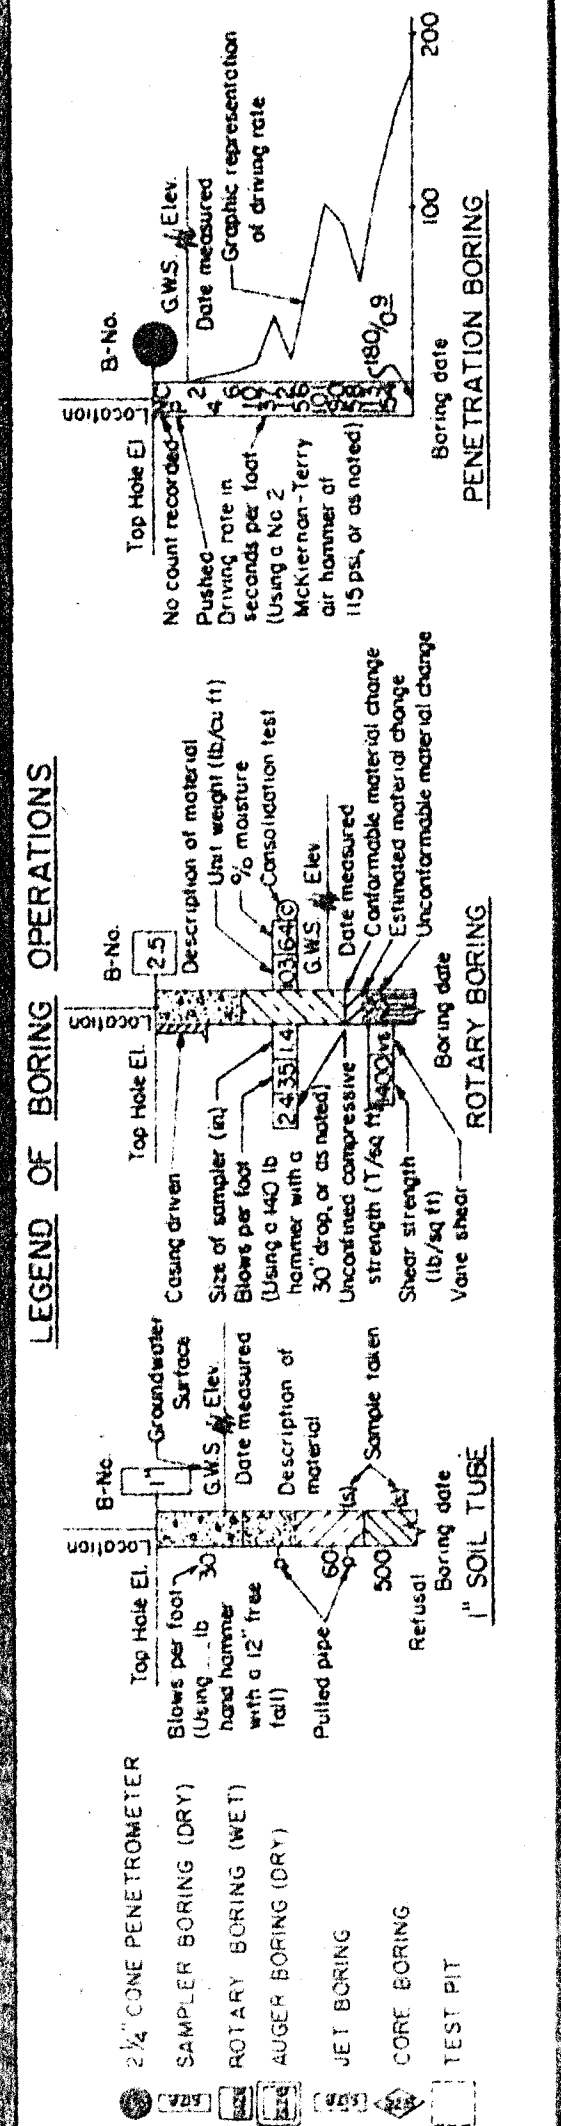

CONSISTENCY CLASSIFICATION FOR SOILS

No. of blows	Granular	Non-granular
0-5	Very loose	Very soft
5-10	Loose	Soft
10-20	Slightly compact	Stiff
20-35	Compact	Very stiff
35-70	Dense	Hard
>70	Very dense	Very hard

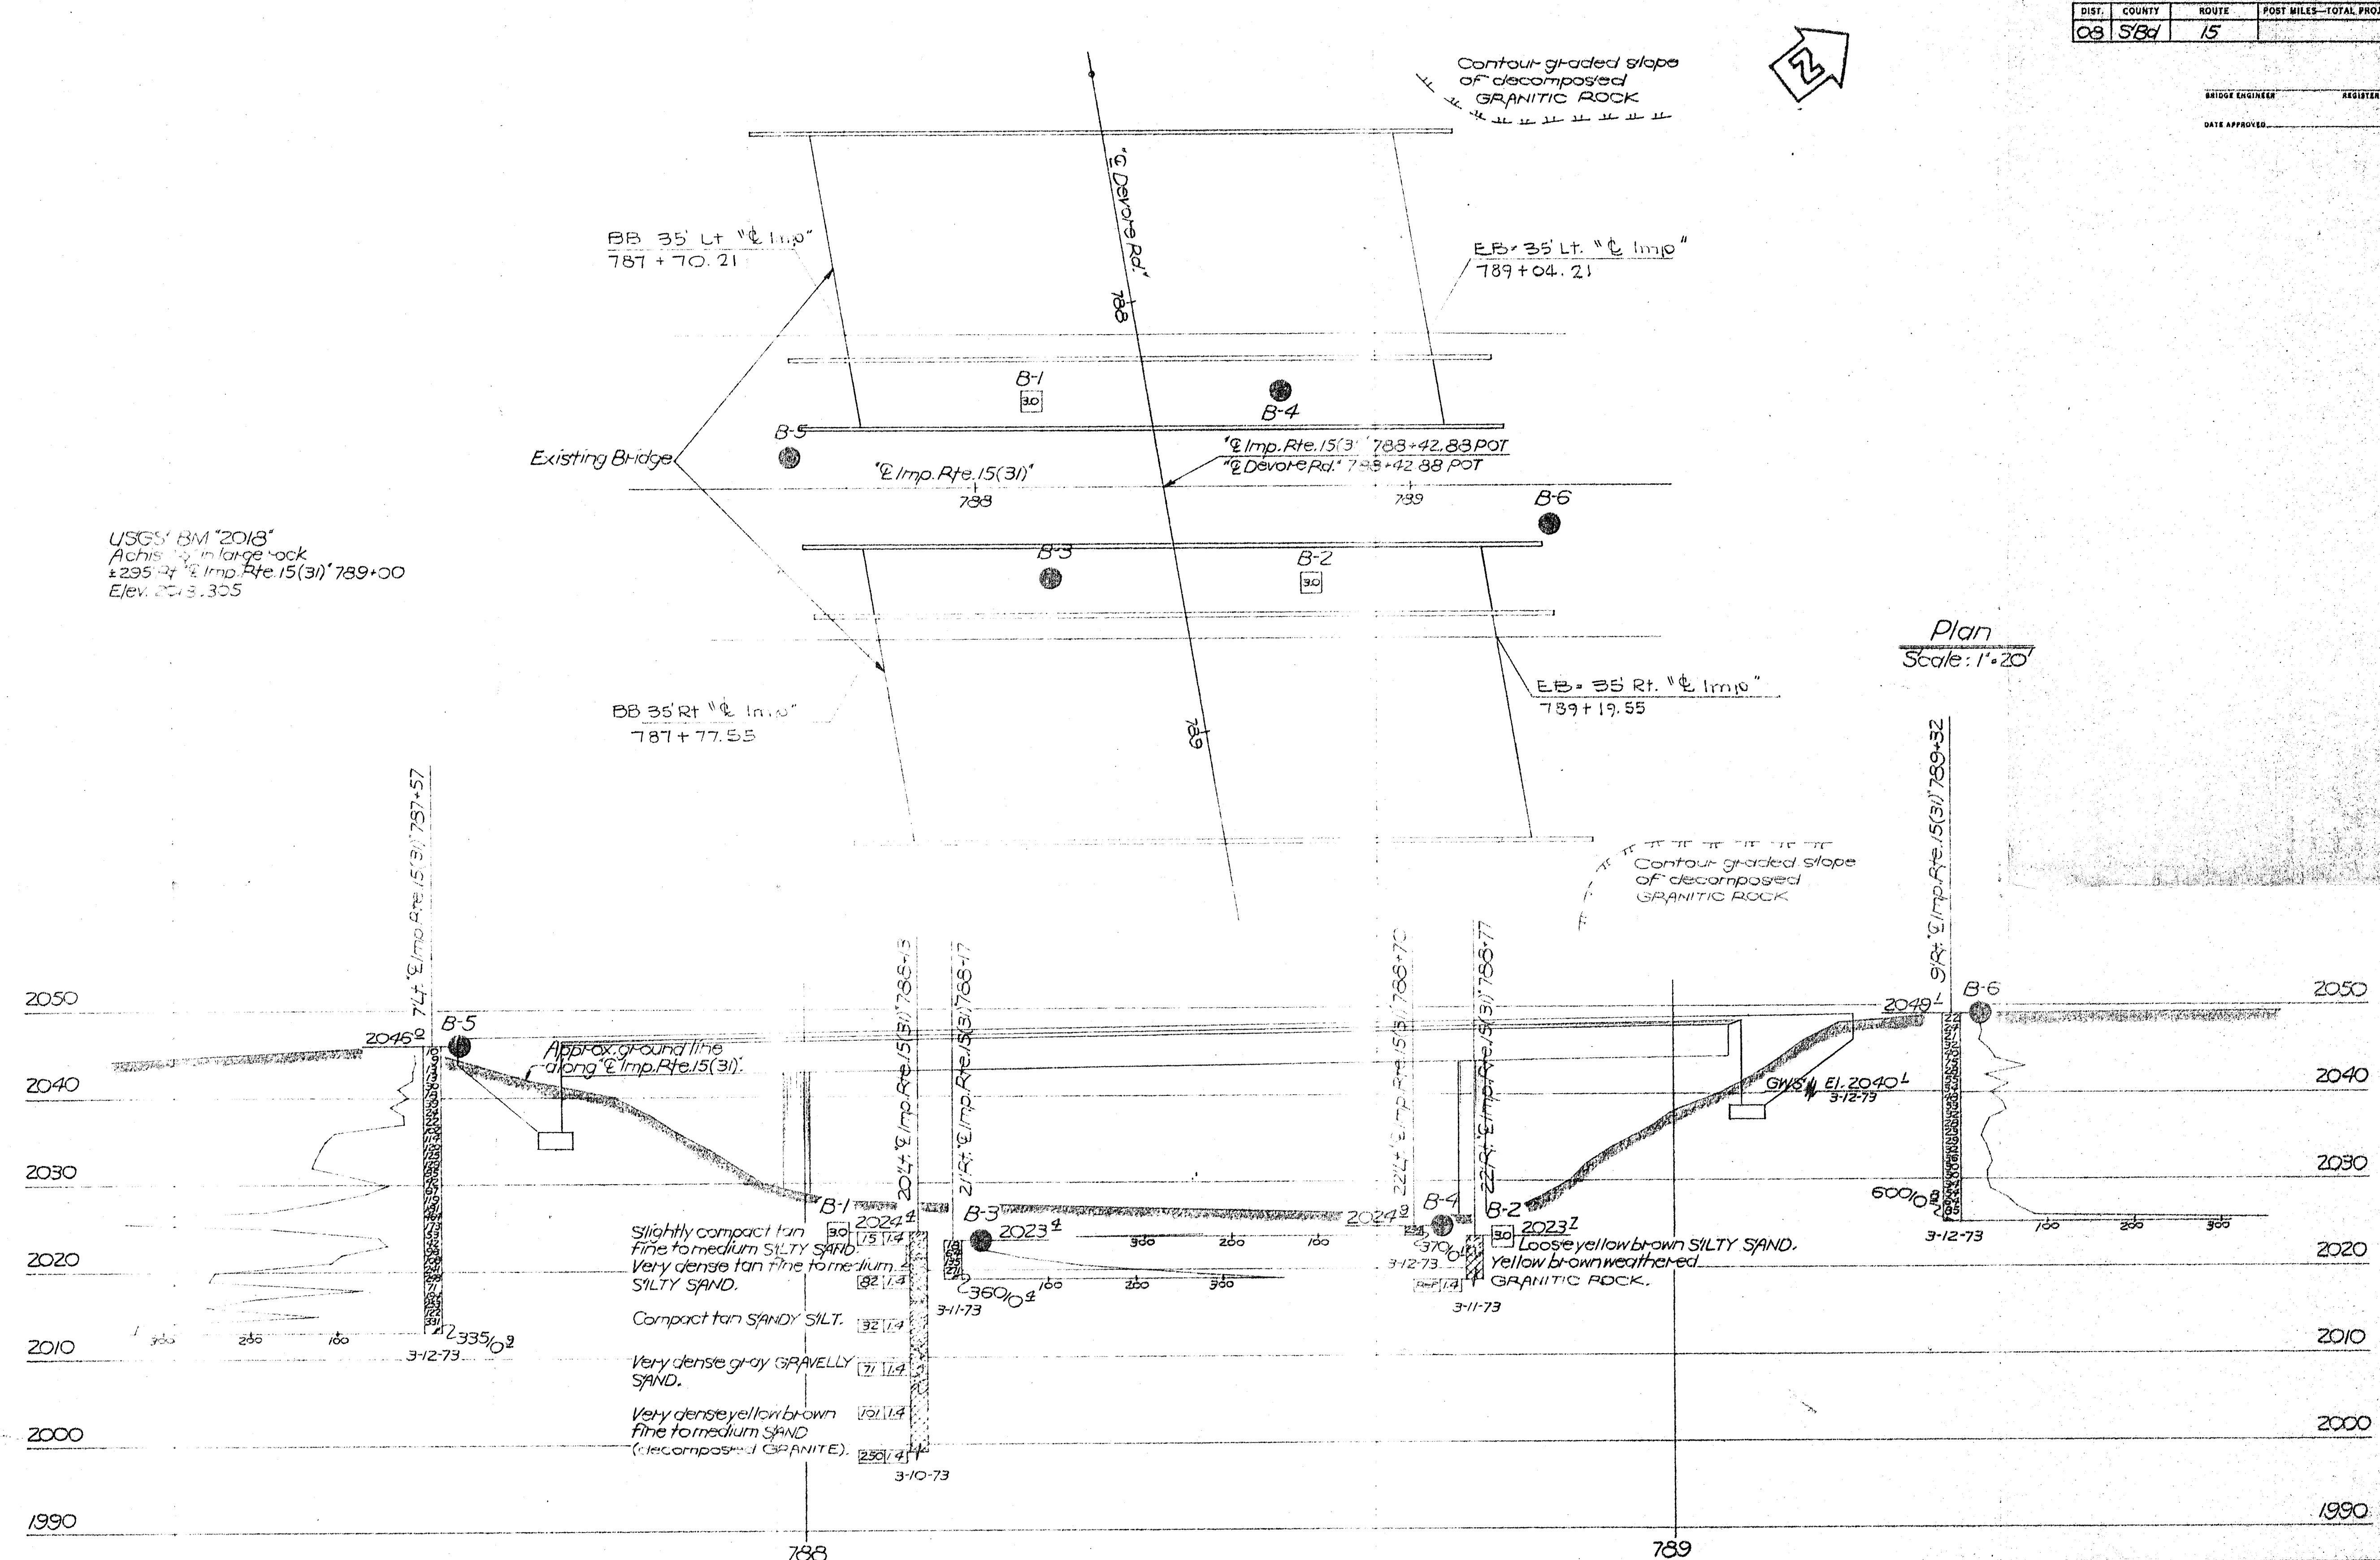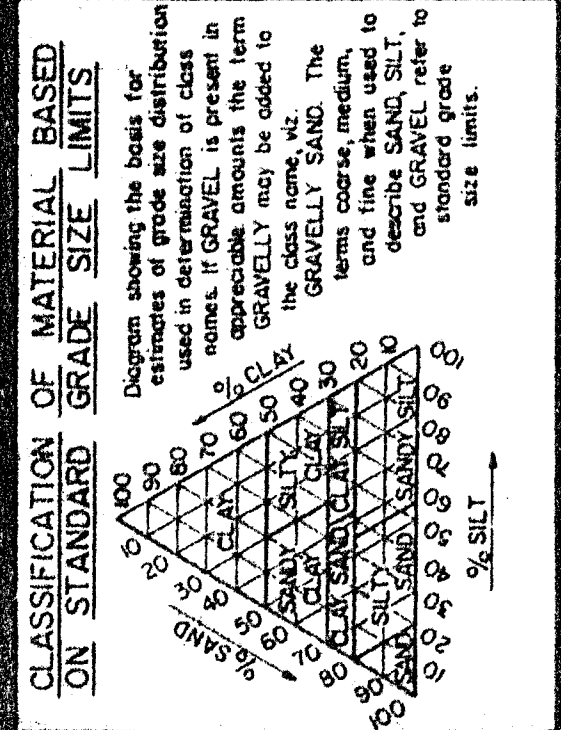

Note - Structure information obtain from General Plan, dated 6-13-73

BRIDGE DEPARTMENT
 ENGINEERING GEOLOGY SECTION

FIELD STUDY	by R. Brand	3-73
DRAWN	by R. Brand	3-30-73
CHECKED	by R. Brand	4-11-73

Approval Recommended by Robert J. Brand
 Engineering Geologist
 Certified Engineering Geologist No. 443

STATE OF CALIFORNIA
 TRANSPORTATION AGENCY
 DEPARTMENT OF PUBLIC WORKS
 DIVISION OF HIGHWAYS

DEVORE ROAD UNDERCROSSING (WIDEN)

LOG OF TEST BORINGS

BRIDGE NO.	54-779 P/L	POST MILE	15.4	DRAWING NO.	
REVISION DATES (PRELIMINARY STAGE ONLY)					

WO 172301
 CU 08201

Discard prints bearing earlier revision dates

PRINTED ON 1025 PAPER/CLOTH

FED. ROAD DIST. NO.	STATE	P. A. PROJECT NO.	SHEET NO.	TOTAL SHEETS
7	CALIF.			

DIST.	COUNTY	ROUTE	SECTION	SHEET NO.	TOTAL SHEETS
08	Sbd.	91	437	230	398

DATE APPROVED: November 28, 1966

BENCH MARK
 P¹² PI 9 Elev. 1993.33
 Battery Stake & Cap in conc. Bur 1.3'
 250' Rt. Sta. 785+60.4 & Imp. Rte. 31

LOCATION: R/L Bent # 2 only
 PILE TYPE: C.I.D.H.
 DIAMETER: 16 inch
 TOTAL NO. PILES: 32
 LINEAL FT. PILES, PLANS: 1028
 LINEAL FT. PILES, "AS BUILT": 1030

REMARKS:
 All footings constructed to plan elev.

LEGEND OF BORING OPERATIONS

2 1/2" CORE PENETROMETER
 SOILER BORING (SOB)
 ROTARY BORING (WET)
 AUGER BORING (DRY)
 CORE BORING
 TEST PIT

LEGEND OF BORING OPERATIONS

2 1/2" CORE PENETROMETER
 SOILER BORING (SOB)
 ROTARY BORING (WET)
 AUGER BORING (DRY)
 CORE BORING
 TEST PIT

LEGEND OF EARTH MATERIALS

CLAY, SILT, OR SILTY SAND
 ORGANIC MATERIAL
 FILL MATERIAL
 IGNEOUS ROCK
 SEDIMENTARY ROCK
 METAMORPHIC ROCK



CLASSIFICATION OF MATERIAL BASED ON STANDARD GRADE SIZE LIMITS

NOTE: Classification of earth material as shown on this sheet is based upon field inspection and is not to be construed to imply mechanical analysis.

FIELD STUDY	BY O. MILES	11-3-65
DRAWN	BY G. BOJIS	11-22-65
CHECKED	BY O. MILES	11-23-65

BRIDGE DEPARTMENT
 ENGINEERING GEOLOGY SECTION

Note: All 1" Soil Tube Borings (COBRA) were driven with closed tip. Blows per ft. - using 28 lb drop hammer with 12" free fall.

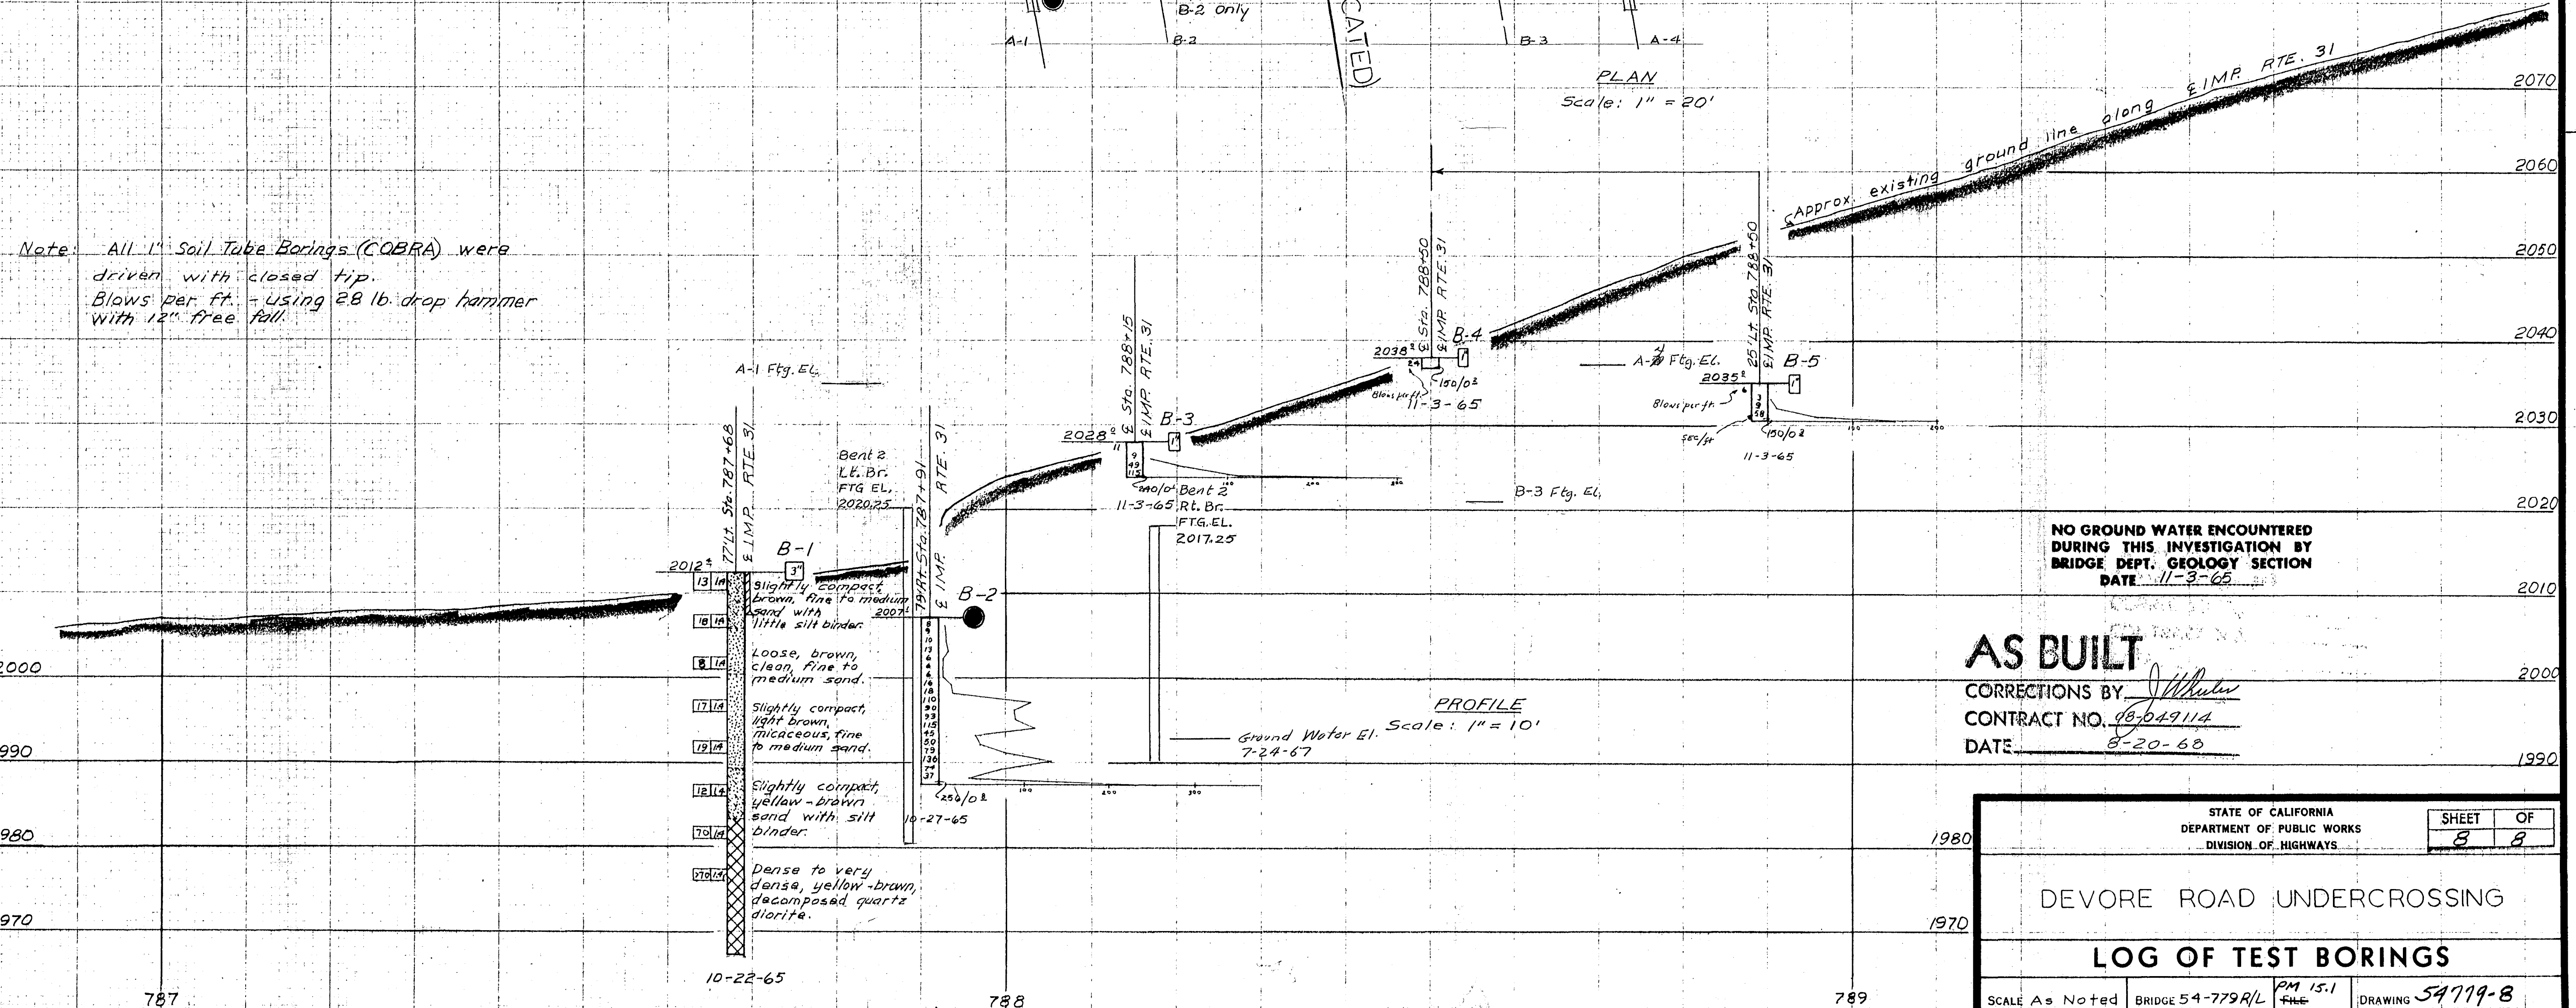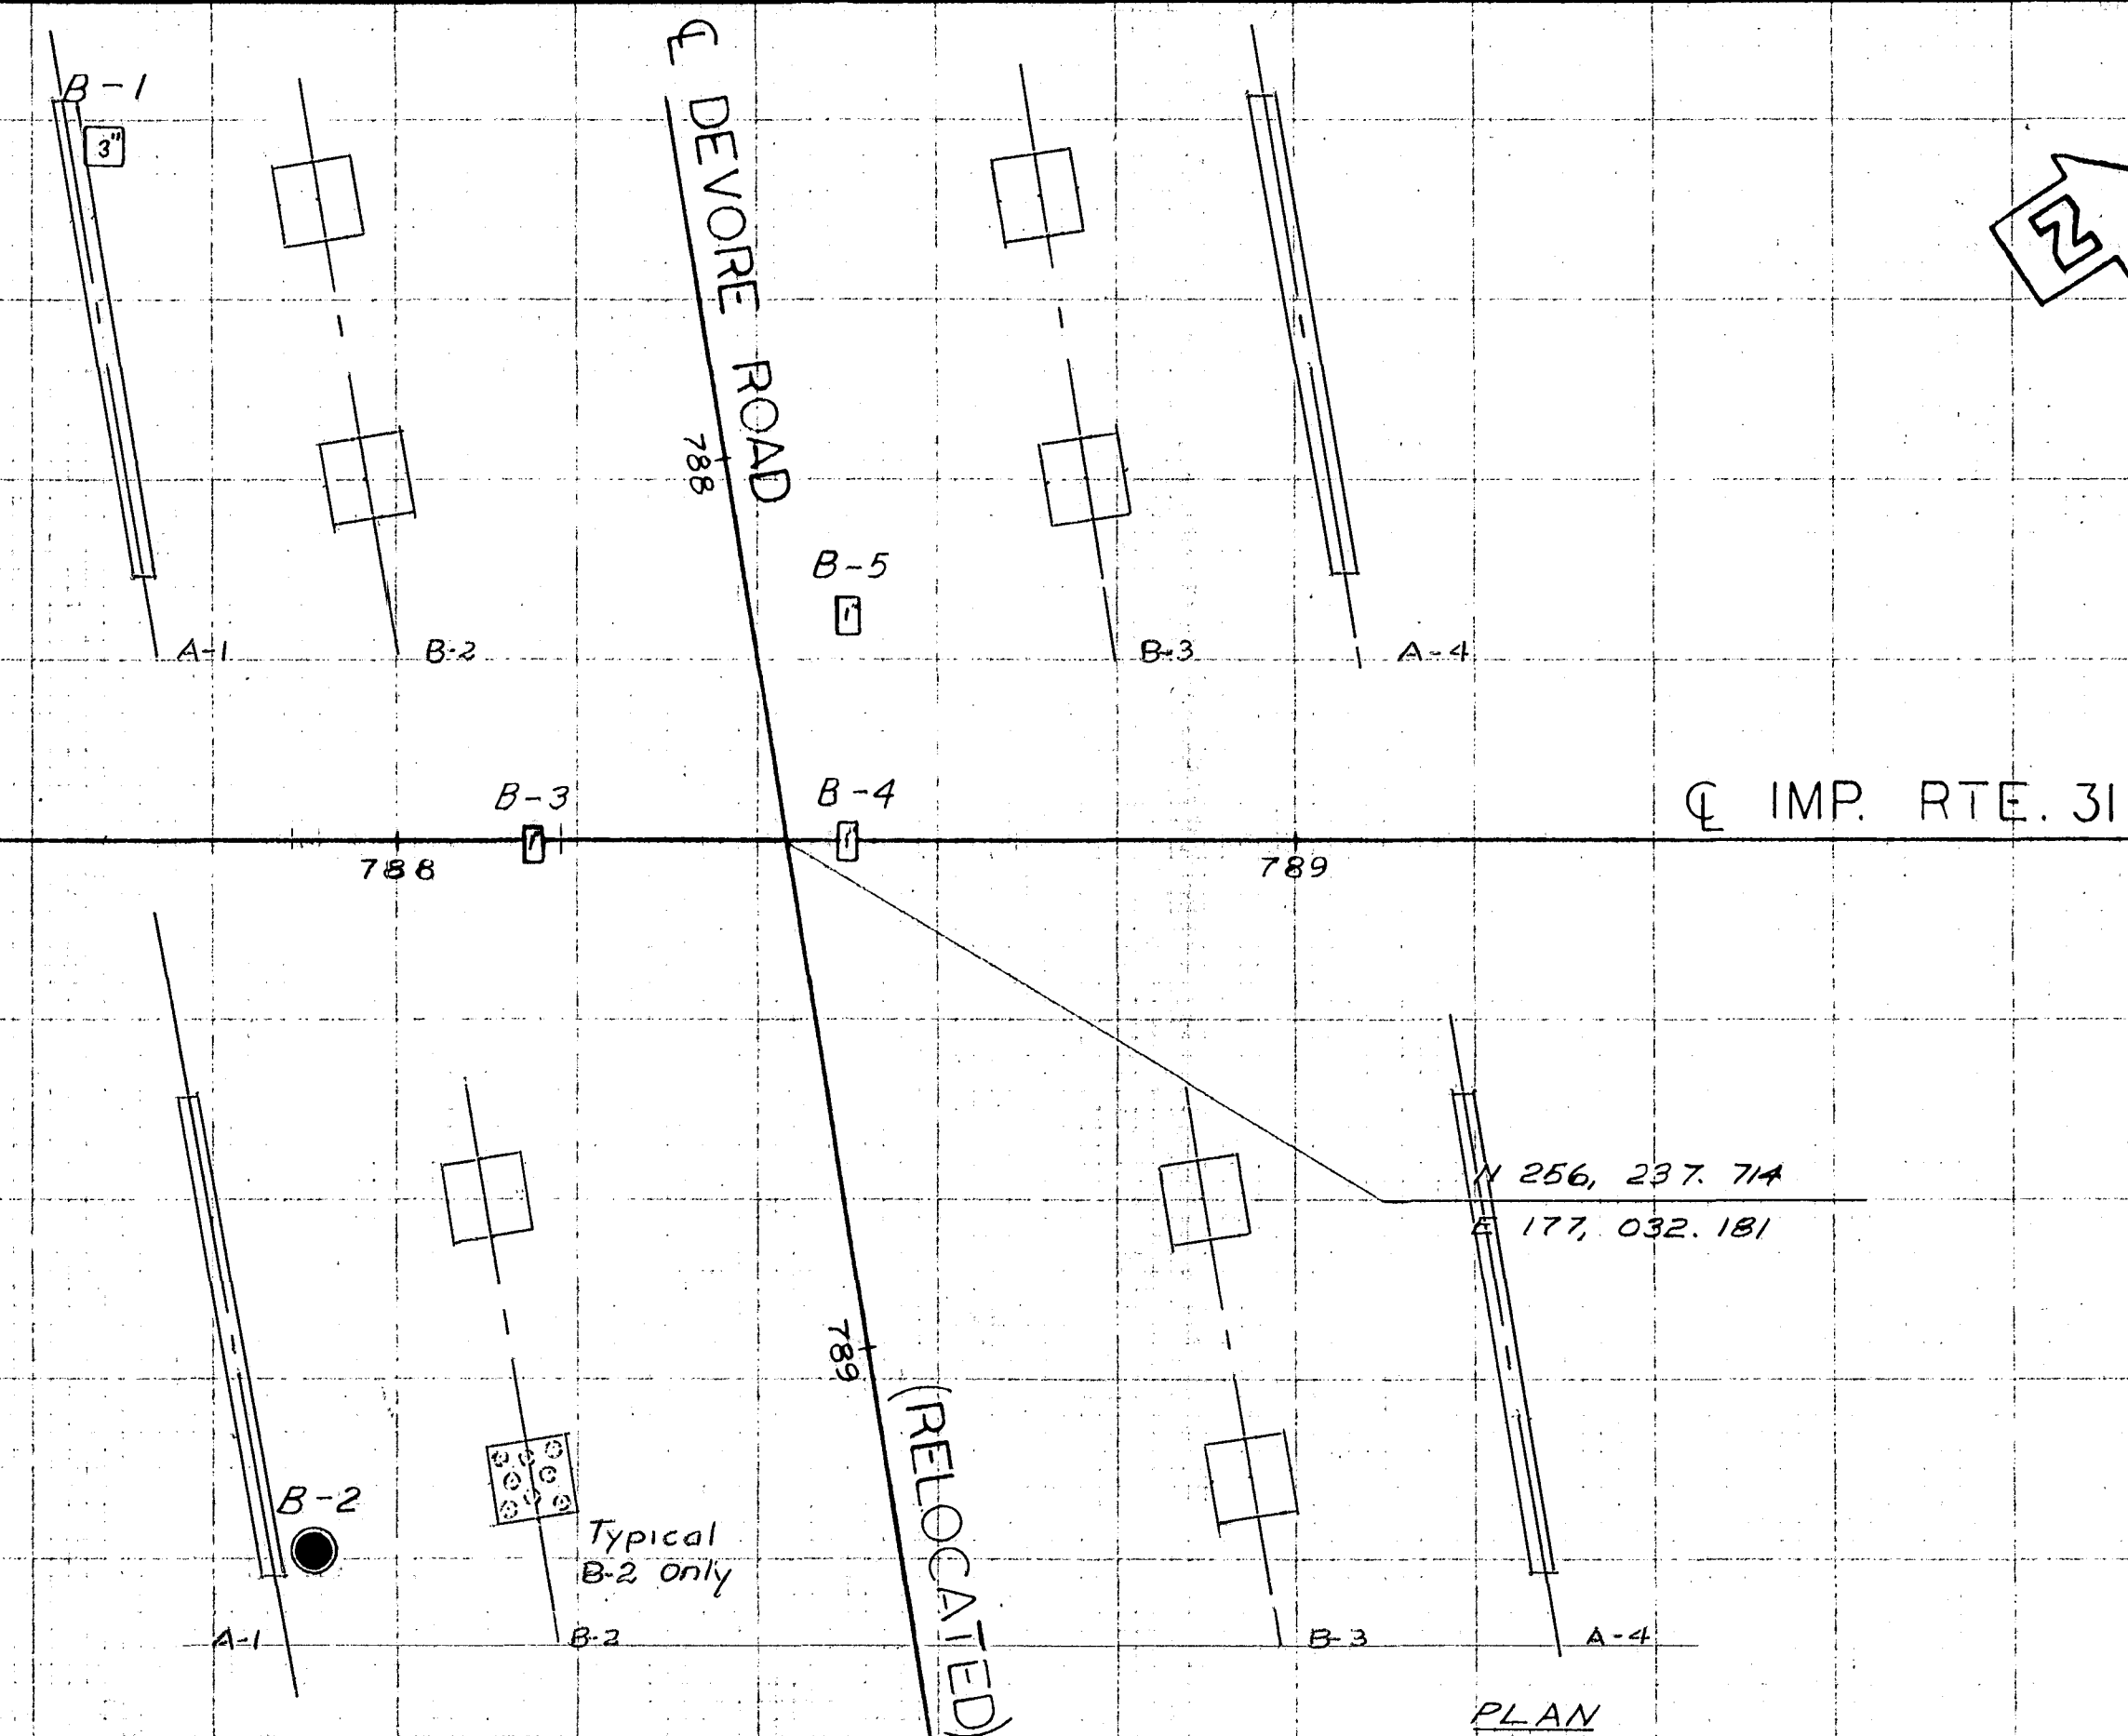

NO GROUND WATER ENCOUNTERED DURING THIS INVESTIGATION BY BRIDGE DEPT. GEOLOGY SECTION DATE 11-3-65

AS BUILT
 CORRECTIONS BY: [Signature]
 CONTRACT NO. 98-049114
 DATE 8-20-68

STATE OF CALIFORNIA
 DEPARTMENT OF PUBLIC WORKS
 DIVISION OF HIGHWAYS

SHEET 8 OF 8

DEVORE ROAD UNDERCROSSING

LOG OF TEST BORINGS

SCALE As Noted BRIDGE 54-779A/L PM 15.1 DRAWING 54719-B

Charge: 08203

Disregard prints bearing earlier numbers

PREL. DRAWING NO. PR-

Glen Helen Road UC

DIST	COUNTY	ROUTE	POST MILES TOTAL PROJECT	SHEET No	TOTAL SHEETS
08	SBd	15			

10-12-11
 CERTIFIED ENGINEERING GEOLOGIST
 K. Douglas Cook
 No. 1391
 Exp. 12-31-11
 CERTIFIED ENGINEERING GEOLOGIST
 STATE OF CALIFORNIA


PLANS APPROVAL DATE

The State of California or its officers or agents shall not be responsible for the accuracy or completeness of electronic copies of this plan sheet.


BENCH MARK

PNO 173 2120.910
 FD STD Brass disk in concrete stamped "SBD-215-173 1988" 40' Ely of EOD Devore Rd Bridge at Nly end bridge; 70' Nly of EP NB SBD 215 at PM 17.3 at top of slope.

PNO 2010 2179.090
 FD STD Brass disk in concrete stamped "D8 SCN SBD-15 PM 16.3 08.04.08" At top of slope SOUTH of Connector Bridge from NB SBD 15 to NB SBD 215.

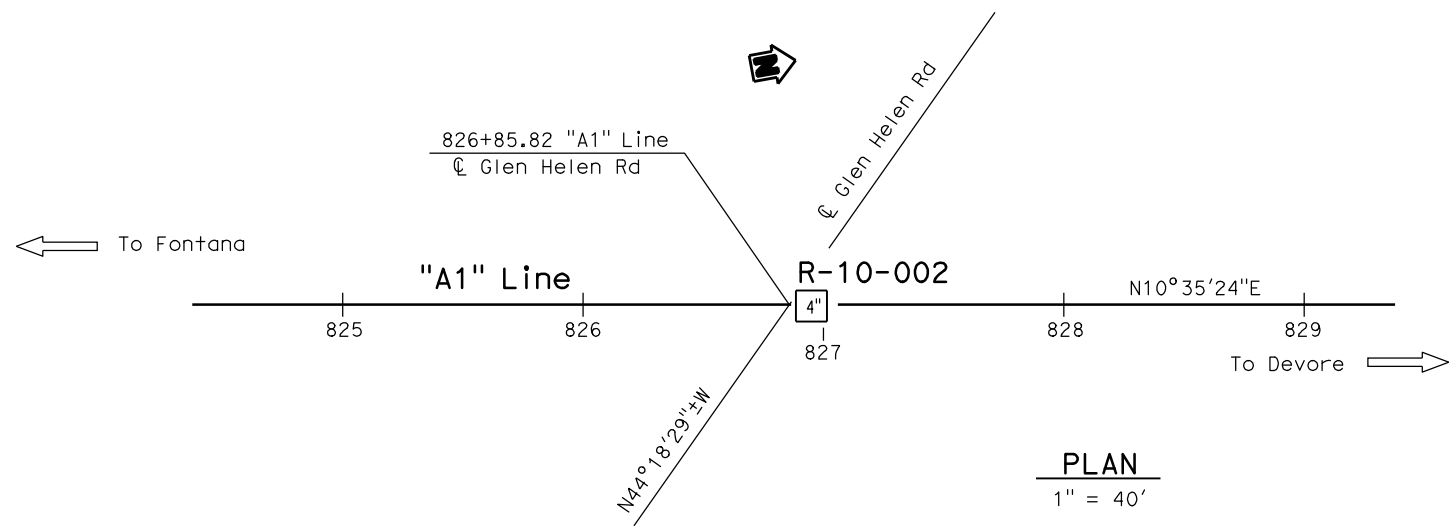


Station	Depth (ft)	Description	Station
2060			2060
2050	2411.4	Well-graded SAND with GRAVEL (SW); medium dense; light gray; moist; little well-graded, subangular GRAVEL.	2050
2040	4211.4	Well-graded SAND (SW); dense; grayish light brown; moist; few subangular well-graded GRAVEL.	2040
2030	7711.4	Well-graded SAND with GRAVEL (SW); very dense; grayish light brown; moist; little fine, subangular GRAVEL; trace fines.	2030
2020			2020
2010	5075"11.4	Well-graded SAND with GRAVEL; COBBLES and BOULDERS (SW); very dense; dark gray; moist; little well-graded GRAVEL; subangular; 10% COBBLES from 3 to 12"; hard; subrounded GRANITIC; 5% BOULDER 12"-18"; subrounded, hard GRANITIC and METAMORPHICS.	2010
2000	5073"11.4	Well-graded SAND with GRAVEL and COBBLES (SW); dark gray; moist; little well-graded subangular GRAVEL; 10% subrounded COBBLES of hard GRANITICS and METAMORPHICS.	2000
1990	5074"11.4	Well-graded GRAVEL with SAND and COBBLES (GW); dark gray; moist; well-graded subangular GRAVEL; 10% COBBLES 3"-6"; hard subrounded; GRANITICS.	1990
1980		Well-graded SAND with GRAVEL (SW); dark gray; moist.	1980
1970		-well-graded subangular little GRAVEL; 10% COBBLES; 3"-6", hard; subrounded; GRANITIC and METAMORPHICS.	1970
1960			1960

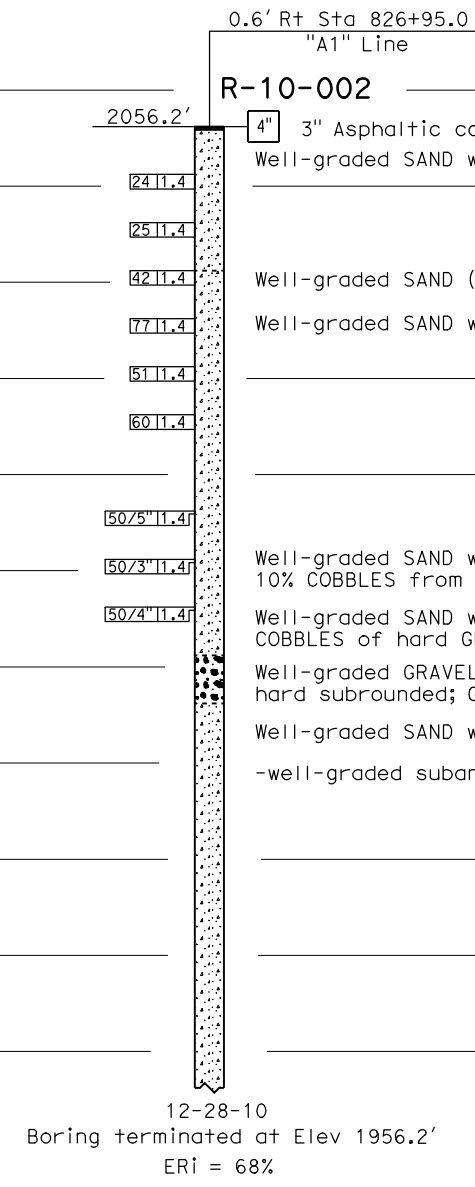

ENGINEERING SERVICES		MATERIALS AND GEOTECHNICAL SERVICES		STATE OF CALIFORNIA		DIVISION OF ENGINEERING SERVICES		BRIDGE NO.		GLEN HELEN RD UC (WIDEN)	
FUNCTIONAL SUPERVISOR		DRAWN BY: F. Nguyen 5/11		DEPARTMENT OF TRANSPORTATION		STRUCTURE DESIGN		54-0780L/R		LOG OF TEST BORINGS 1 OF 4	
NAME: A. Perez-Cobo		CHECKED BY: B. Levine/S. Logeswaran		FIELD INVESTIGATION BY:		DESIGN BRANCH X		POST MILE			
				C. Hoadley, F. Qmehr				15.66			
OGS CIVIL LOG OF TEST BORINGS SHEET		ORIGINAL SCALE IN INCHES FOR REDUCED PLANS		UNIT: 3643		PROJECT NUMBER & PHASE: 08000003660		CONTRACT NO.: 08-0K7100		DISREGARD PRINTS BEARING EARLIER REVISION DATES	
				0 1 2 3		FILE => glenhelen-rd1of4.dgn		REVISION DATES		SHEET OF	
								08-28-11 10-03-11		X X	

DATE PLOTTED => 21-OCT-2011 USERNAME => s128198 TIME PLOTTED => 12:28

BENCH MARK
 B M P²² PI-14 Elev. 2059.09
 Bathey Stake & Cap Bur 1.0' 269.0' Lt.
 Sta. 636+73.2 E Imp. Ate. 31

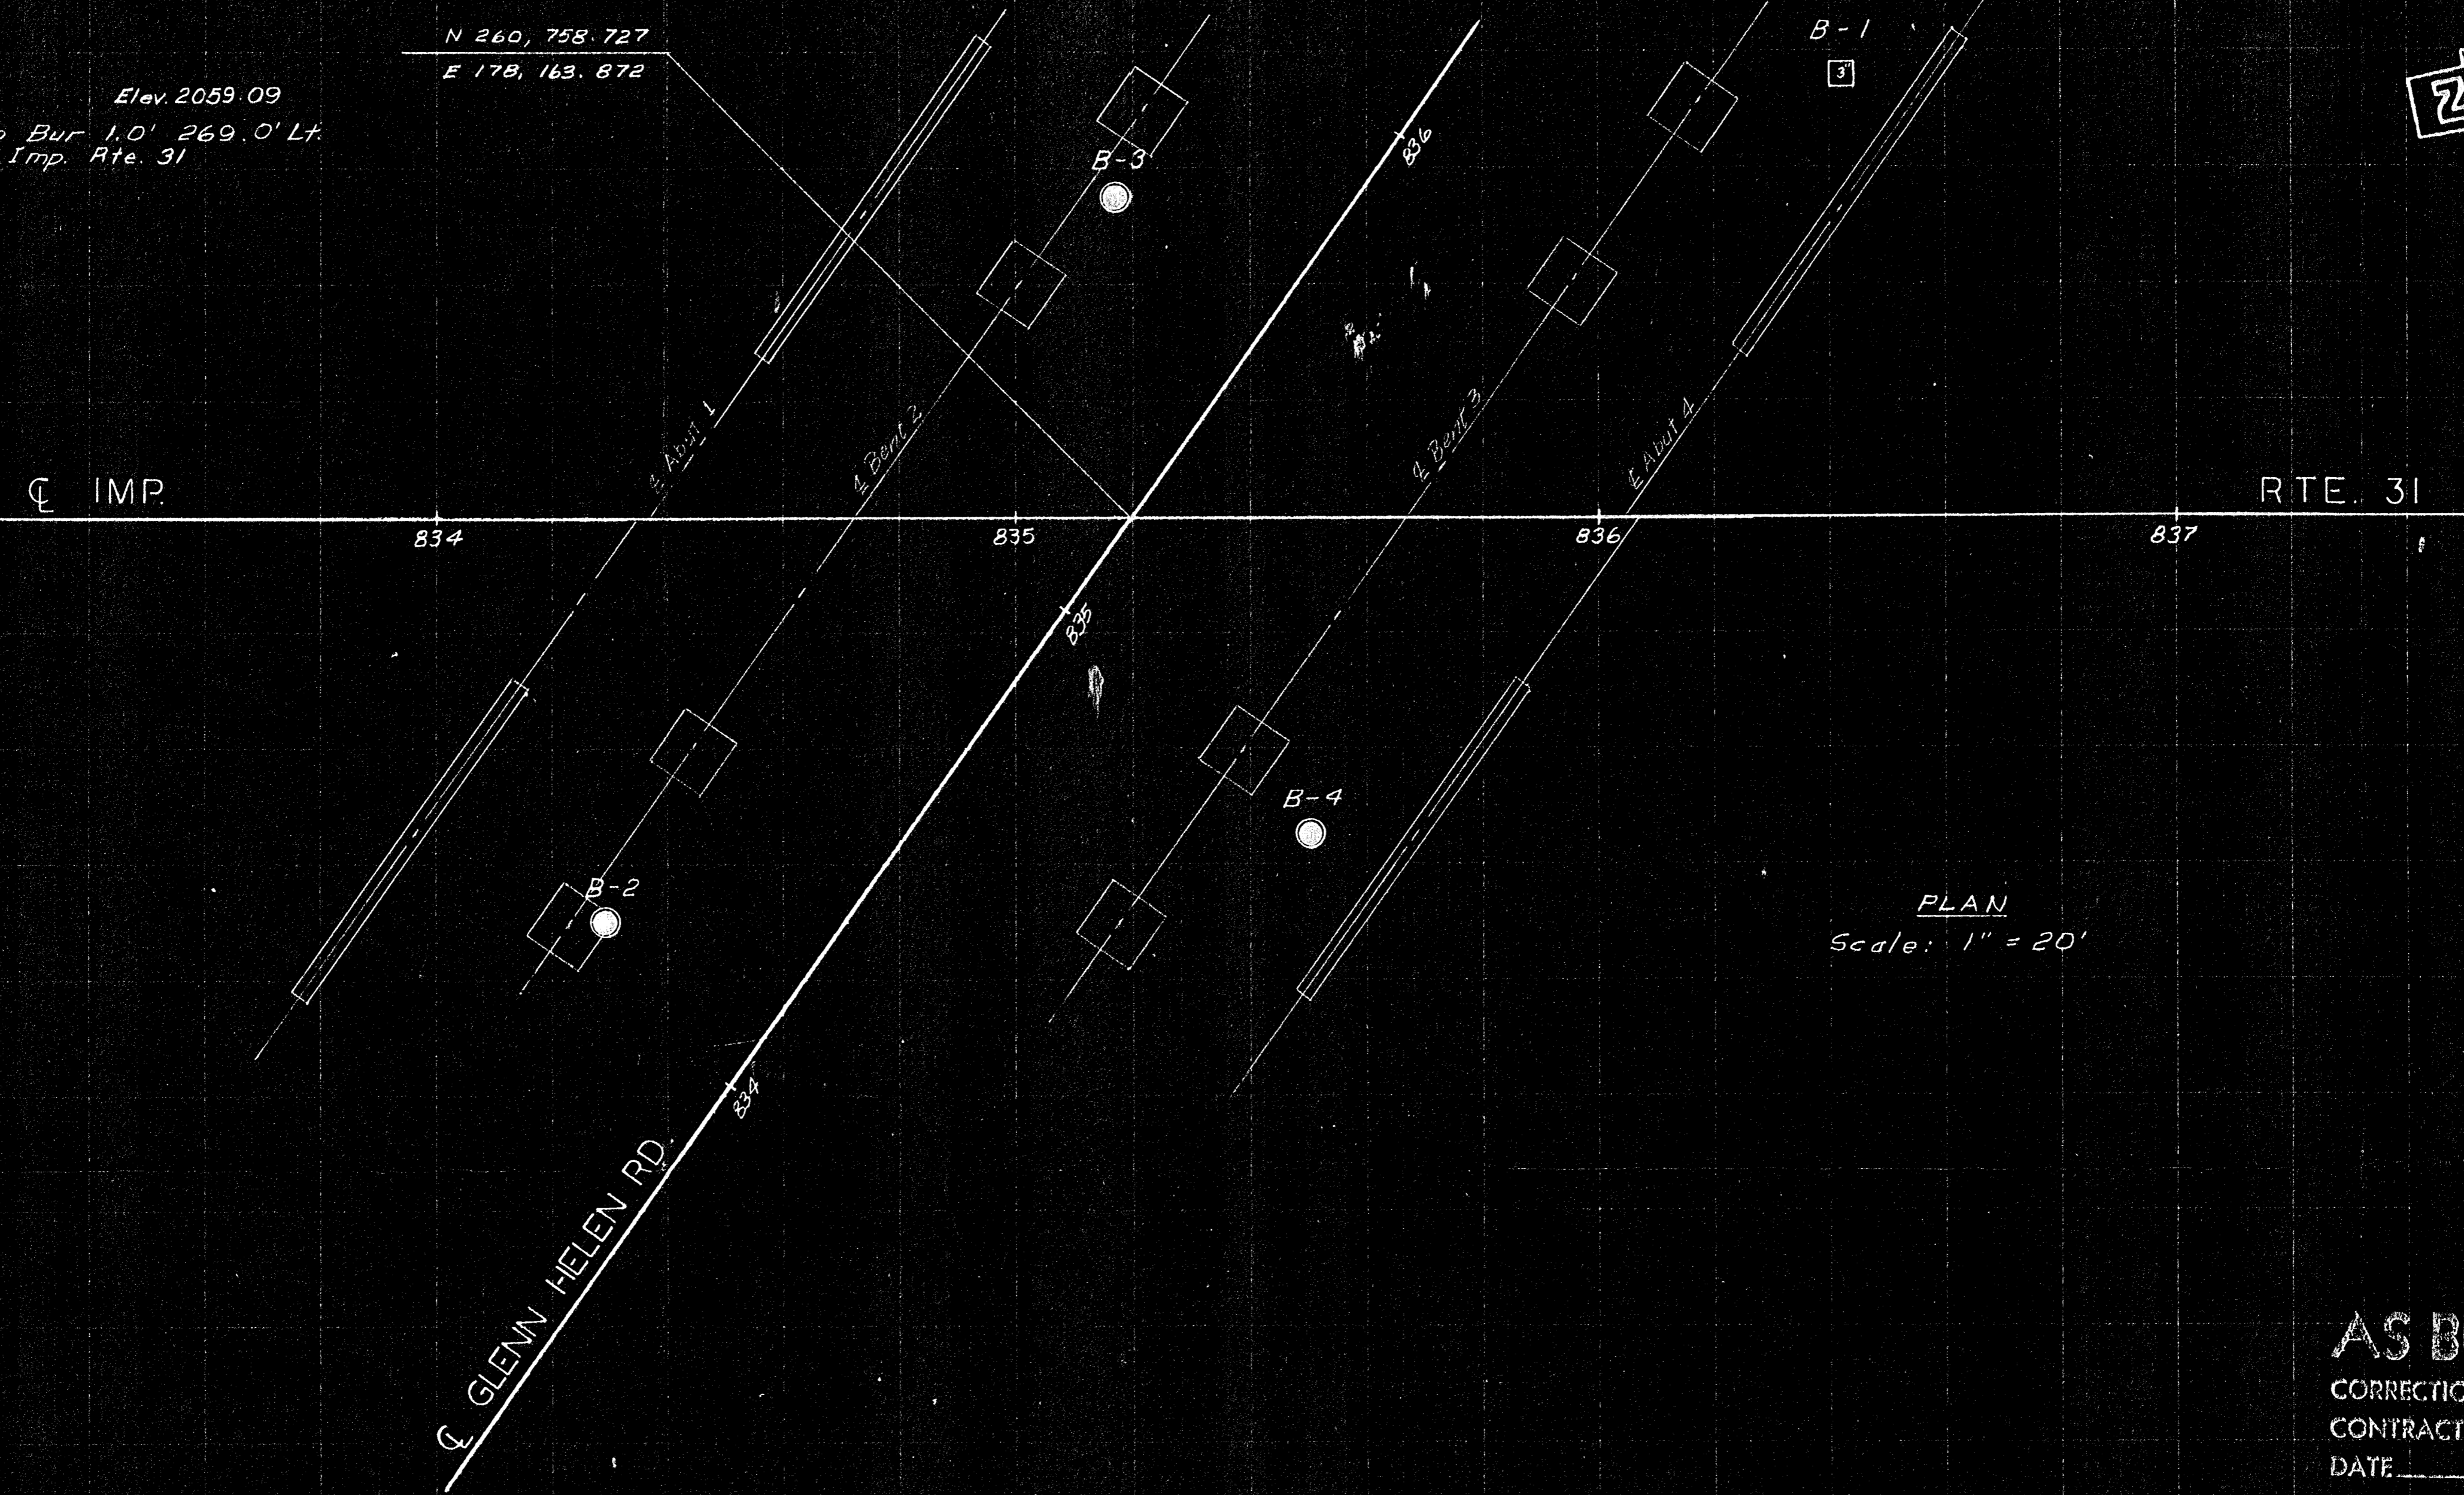


AS BUILT
 CORRECTIONS BY: [Signature]
 CONTRACT NO. 047114
 DATE 7-23-65

NO GROUND WATER ENCOUNTERED
 DURING THIS INVESTIGATION BY
 BRIDGE DEPT. GEOLOGY SECTION
 DATE 10-64


FIELD STUDY	by O. M. GIBBS 10-26-65
DRAWN	by O. M. GIBBS 11-23-65
CHECKED	by O. M. GIBBS 11-23-65

Approved: [Signature]

LEGEND OF EARTH MATERIALS	
GRAVEL	SILTY CLAY or CLAYEY SILT
SAND	PEAT and/or ORGANIC MATTER
SILT	FILL MATERIAL
CLAY	IGNEOUS ROCK
SANDY CLAY or CLAYEY SAND	SEDIMENTARY ROCK
SANDY SILT or SILTY SAND	METAMORPHIC ROCK

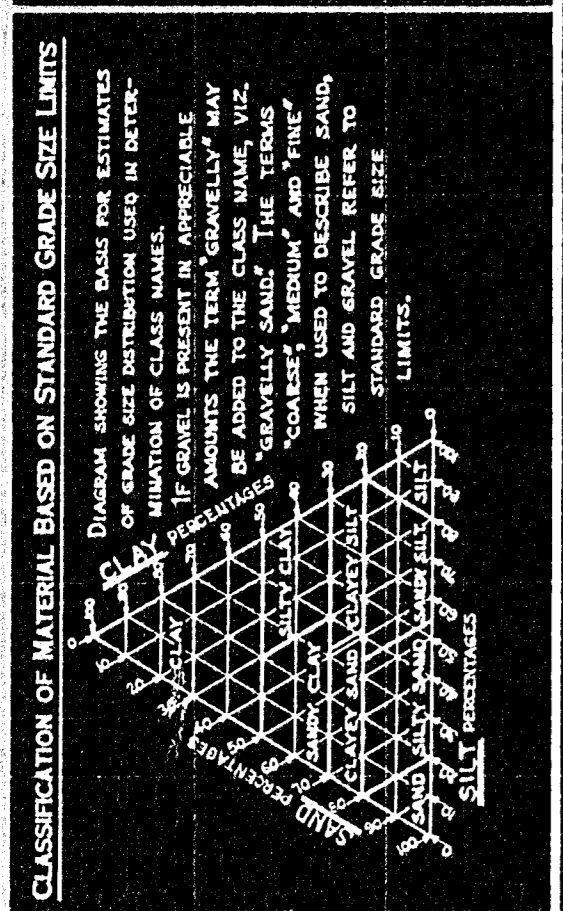

NOTE: Classification of earth material as shown on this sheet is based upon field inspection and is not to be construed to imply mechanical analysis.

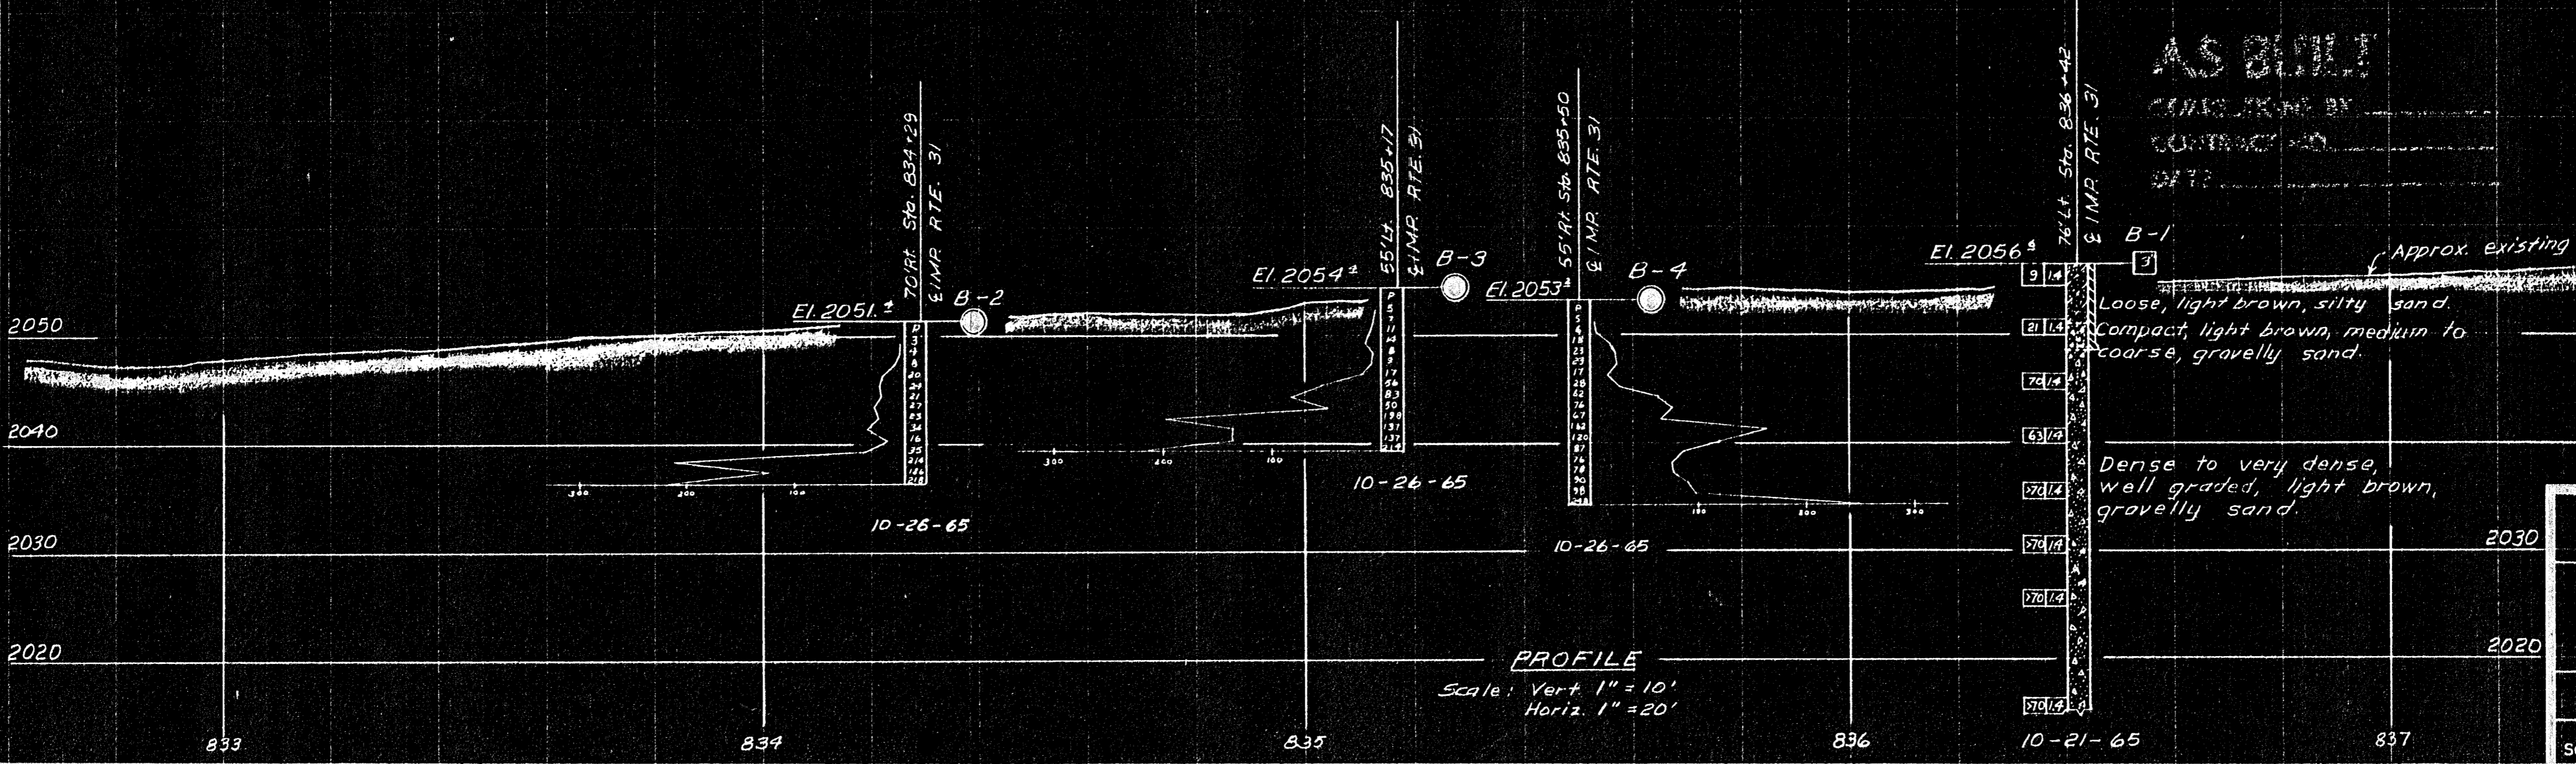

AS BUILT
 CORRECTIONS BY [Signature]
 CONTRACT NO. 047114
 DATE 7-23-65

Approx. existing ground line along E IMP. RTE. 31

BRIDGE DEPARTMENT
 ENGINEERING GEOLOGY SECTION
 246


STATE OF CALIFORNIA
 DEPARTMENT OF PUBLIC WORKS
 DIVISION OF HIGHWAYS

SHEET	OF
8	8

GLENN HELEN ROAD UNDERCROSSING
LOG OF TEST BORINGS

SCALE As Noted	BRIDGE 54-780 R/L	PM 16.0	DRAWING 54180-B
Charge: 08203		PREL. DRAWING NO. PR-	

Devore Overhead

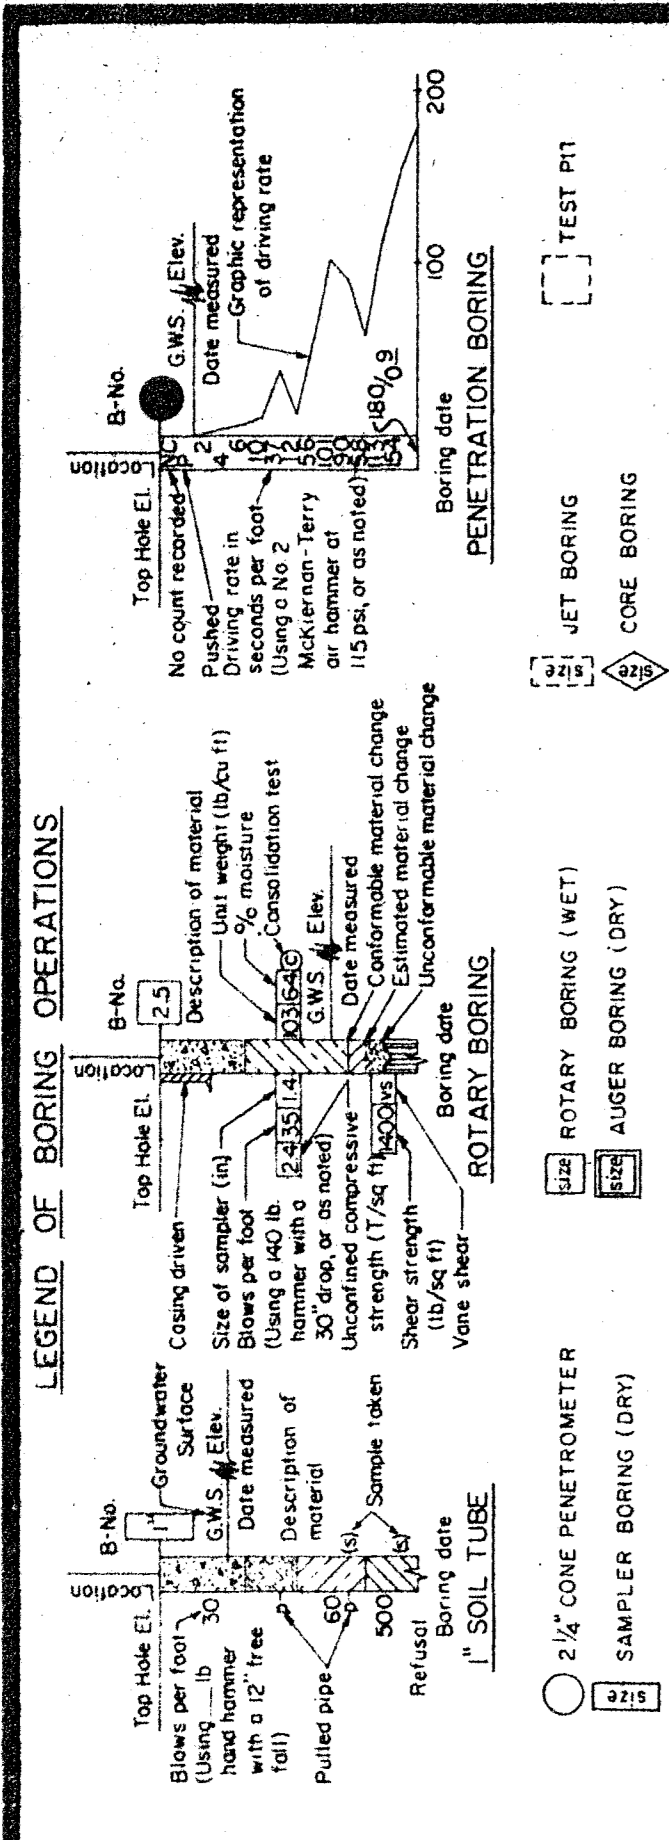

LEGEND OF EARTH MATERIALS

GRAVEL	SAND	SILT	CLAY	SANDY CLAY or CLAYEY SAND	SANDY SILT or SILTY SAND
SILT CLAY or CLAYEY SILT	PEAT and/or ORGANIC MATTER	FILL MATERIAL	IGNEOUS ROCK	SEDIMENTARY ROCK	MORPHIC ROCK

CONSISTENCY CLASSIFICATION FOR SOILS

According to the Standard Penetration Test


Penetration (Blows/Ft.)	Consistency
0-5	Very loose
5-10	Loose
10-20	Slightly compact
20-35	Compact
35-70	Dense
70	Very dense

UNIFIED SOIL CLASSIFICATION SYSTEM

Symbol	Soil Name
MH	Highly Organic Silts and Clays
ML	Low to medium organic silts and clays
OL	Low organic silts and clays
OH	High organic silts and clays
CH	Highly Organic Clays
CL	Low to medium organic clays
CL	Low organic clays
OH	High organic clays
SH	Highly Organic Silts
SH	Low to medium organic silts
SH	Low organic silts
SH	High organic silts
SH	Highly Organic Silts
SH	Low to medium organic silts
SH	Low organic silts
SH	High organic silts

NOTE: Classification of earth material as shown on this sheet is based upon field inspection and is not to be construed to imply mechanical analysis.

BM 85-A-72
Std. br. disc in conc. bur 0.4'
214' Rt. "Imp. Rte 15(31) 846+53
Elev. 2071.30

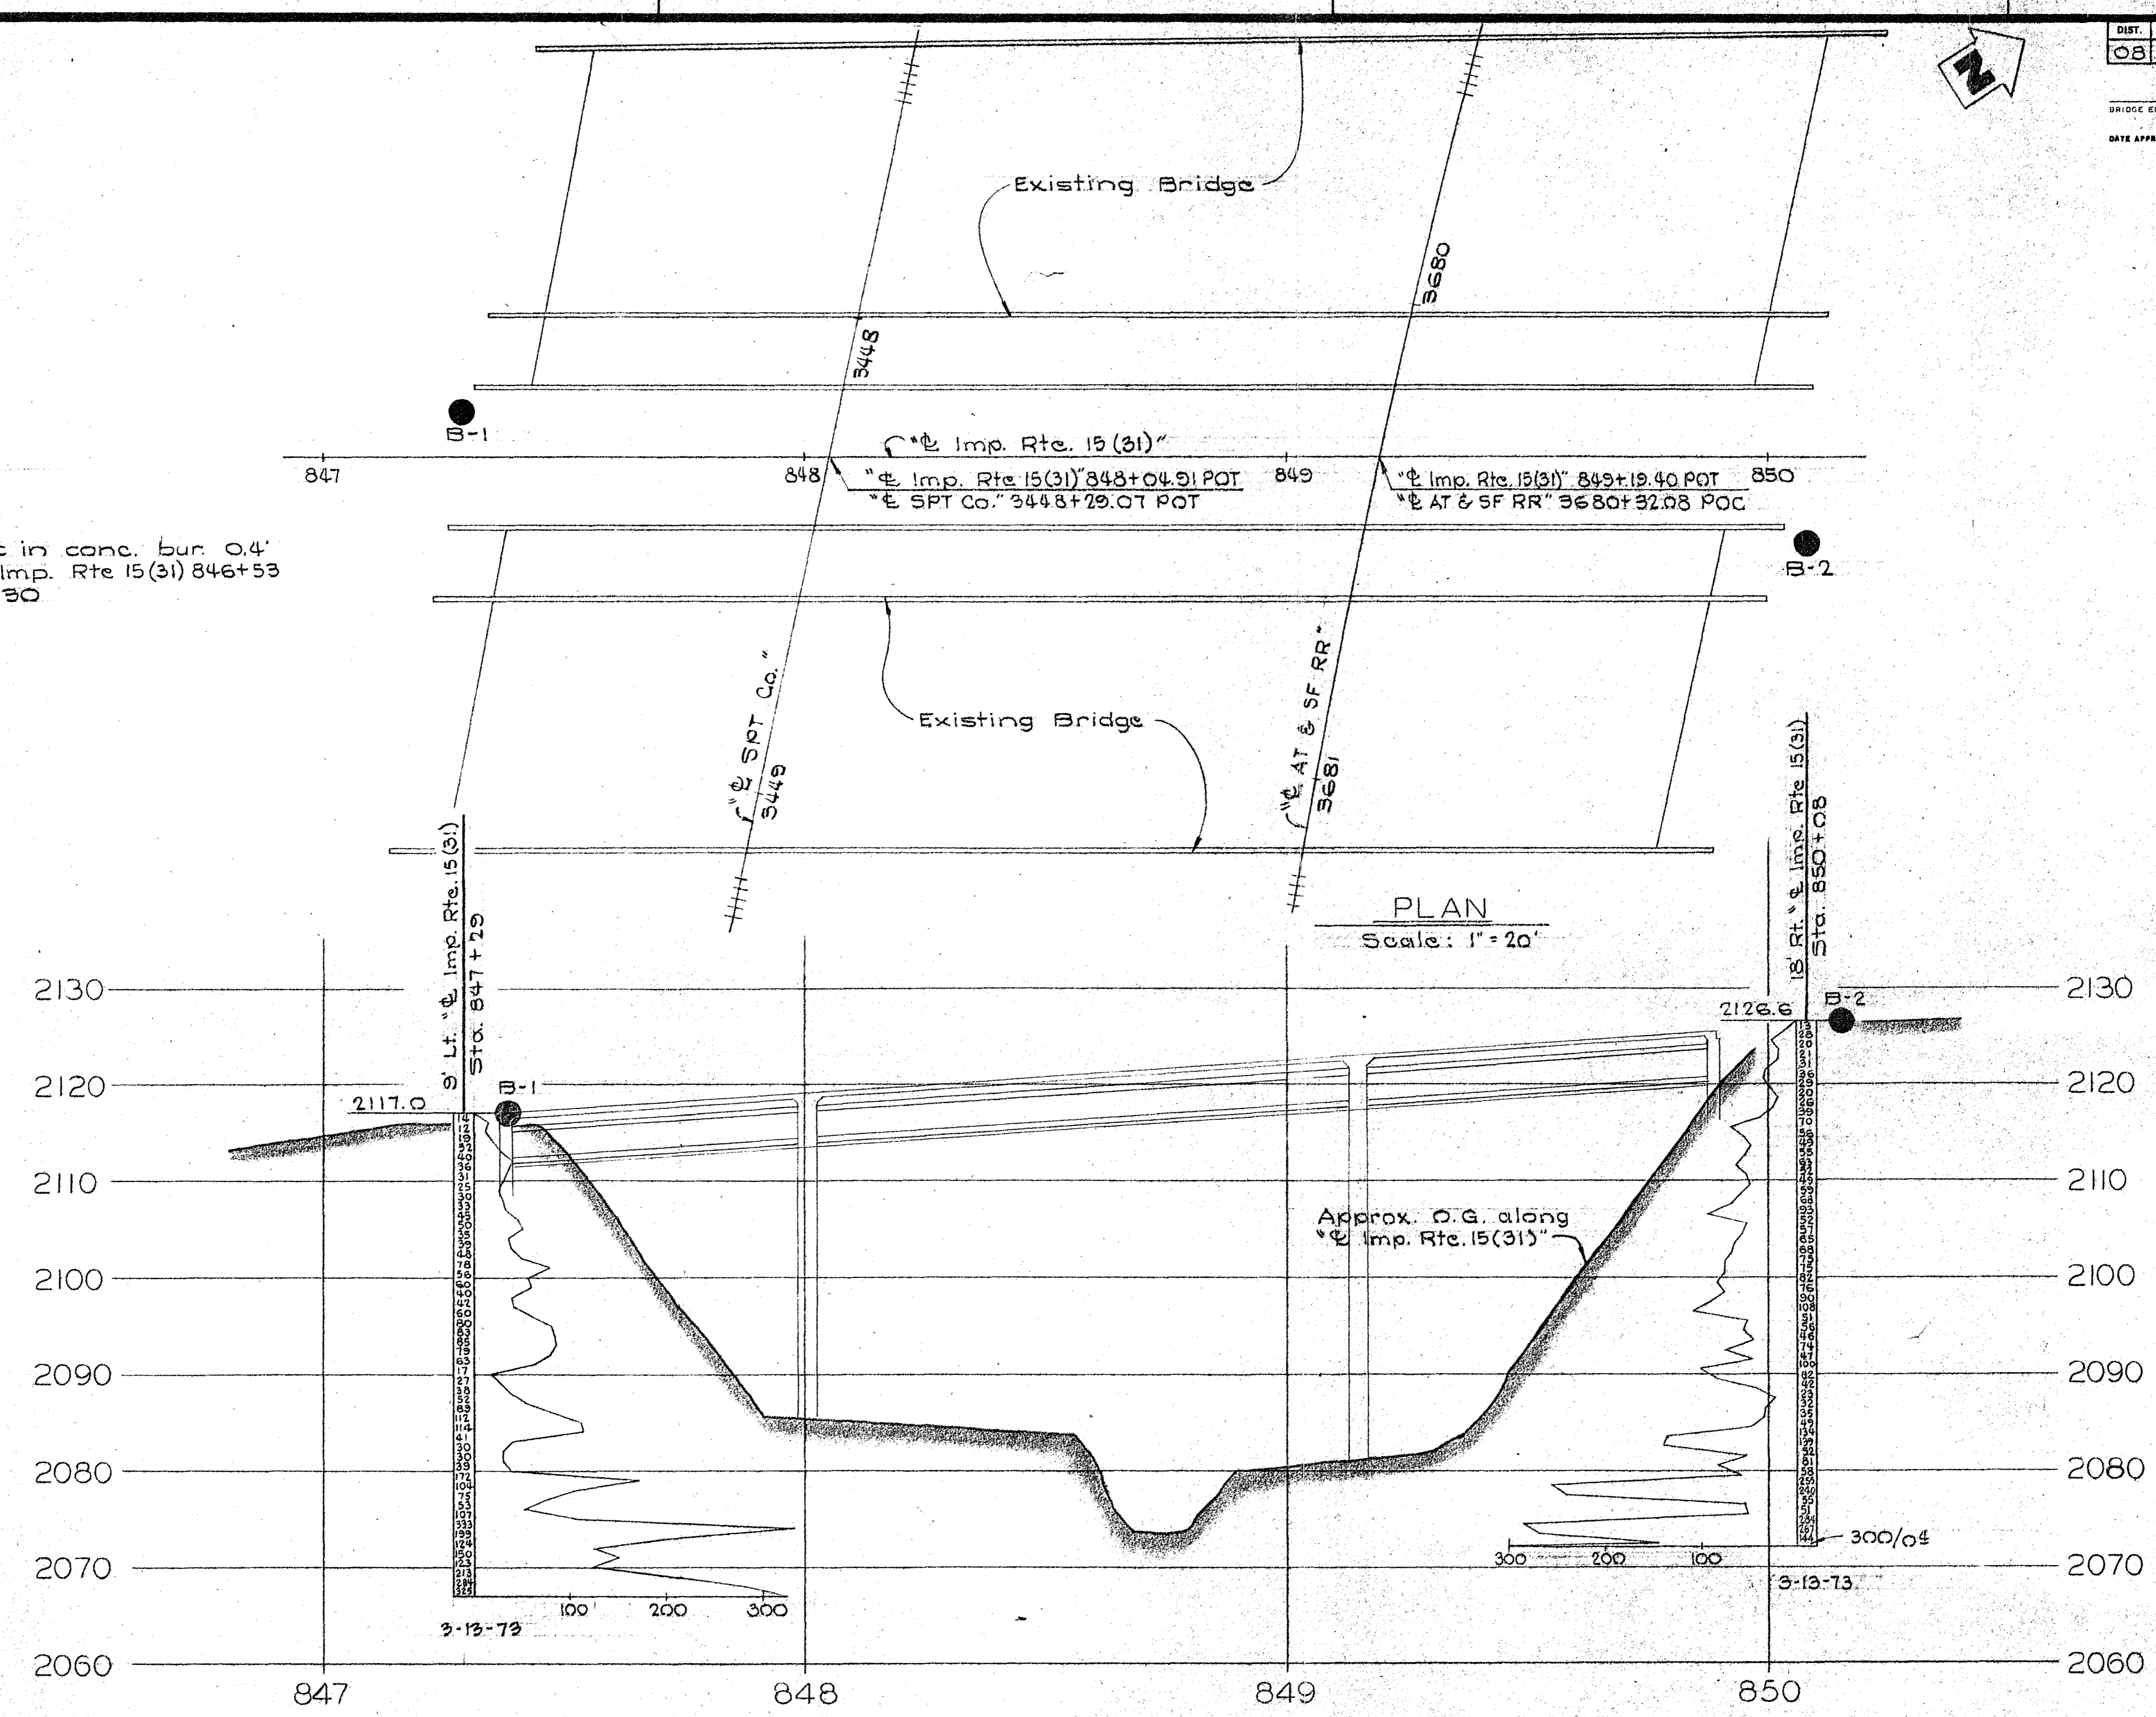

PROFILE
Scale: Hor. 1" = 20'
Vert. 1" = 10'

Note: Structure information obtained from General Plan dated 1-17-73

ENGINEERING GEOLOGY SECTION

FIELD STUDY	By R. Brand 3-13-73	Approved by Robert J. Brand
DRAWN	By KEN JOHNSON	ENGINEERING GEOLOGIST
CHECKED	By R. Brand 10-28-75	CERTIFIED ENGINEERING GEOLOGIST NUMBER 4442

State of CALIFORNIA	OFFICE OF STRUCTURES DESIGN GROUP
DEPARTMENT OF TRANSPORTATION	PROJECT ENGINEER

BRIDGE NO. 54-618 R/L	POST MILE 16.6
DEVORE OVERHEAD (WIDEN)	
LOG OF TEST BORINGS	

CU 08201	WQ 172811
DISREGARD PRINTS BEARING EARLIER REVISION DATES	

DIST.	COUNTY	ROUTE	POST MILES - TOTAL PROJECT	POST MILE	SHEET	TOTAL SHEETS
08	SFB	15 (31)				

PRINTED ON 100% RECYCLED PAPER

FED. ROAD DIV. NO.	STATE	F. A. PROJECT NO.	SHEET NO.	TOTAL SHEETS
7	CALIF.			

DIST.	COUNTY	ROUTE	SECTION	SHEET NO.	TOTAL SHEETS
08	Sbd	31	1467	256	398

DATE APPROVED: November 28, 1966

BENCH MARKS





B.M. # P 62 P.I. 15
 Bathey Stake & Cap Bur. 12'
 560.8' Lt. 850 + 88.89 FOT & IMP. RTE. 31
 Elev 2093.33

B.M. # R 62 P.I. 16
 Bathey Stake & Cap Bur. 12'
 445.4 Lt. 865 + 17.85 PDC 4 W-S CONN
 Elev 2104.82

DESIGN PILE LOADING: 60T
 PILE TYPE: 10BP37
 TOTAL NO. PILES: 8
 LINEAL FT. PILES, PLANS: 396.8
 LINEAL FT. PILES, "AS BUILT": 394.1
 HAMMER: 08 YULCAN

REMARKS:
 Piles at Rt. Br. Abut. 1 pile ftg. only.
 ① Minimum Penetration ✓
 ② Average ✓
 ③ Maximum ✓

NOTE: All other ftgs. constructed to plan elevation, except as shown.
 Spread ftg. @ Abut. 1, Rt. Br. abandoned after washout.
 Pile foundation constructed N. of existing Abut. by C.C.O. # 117.

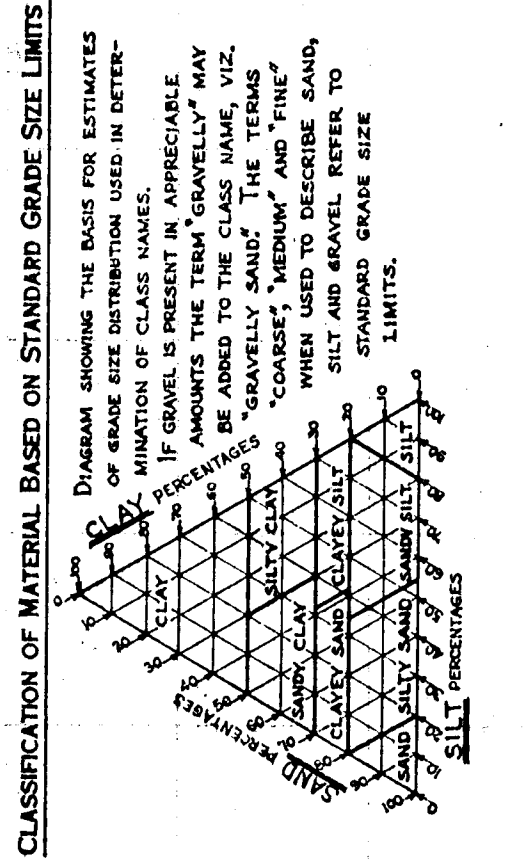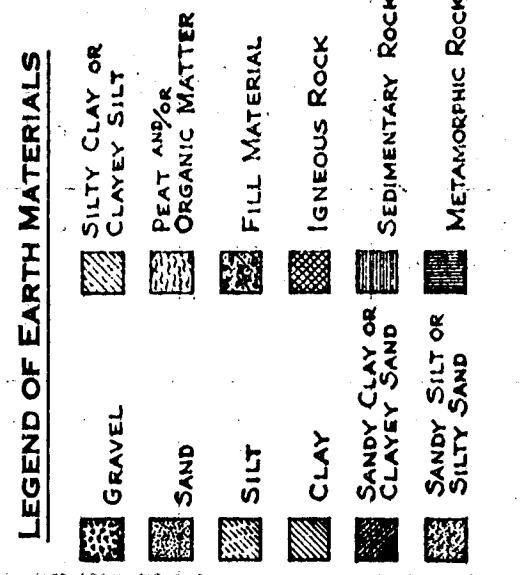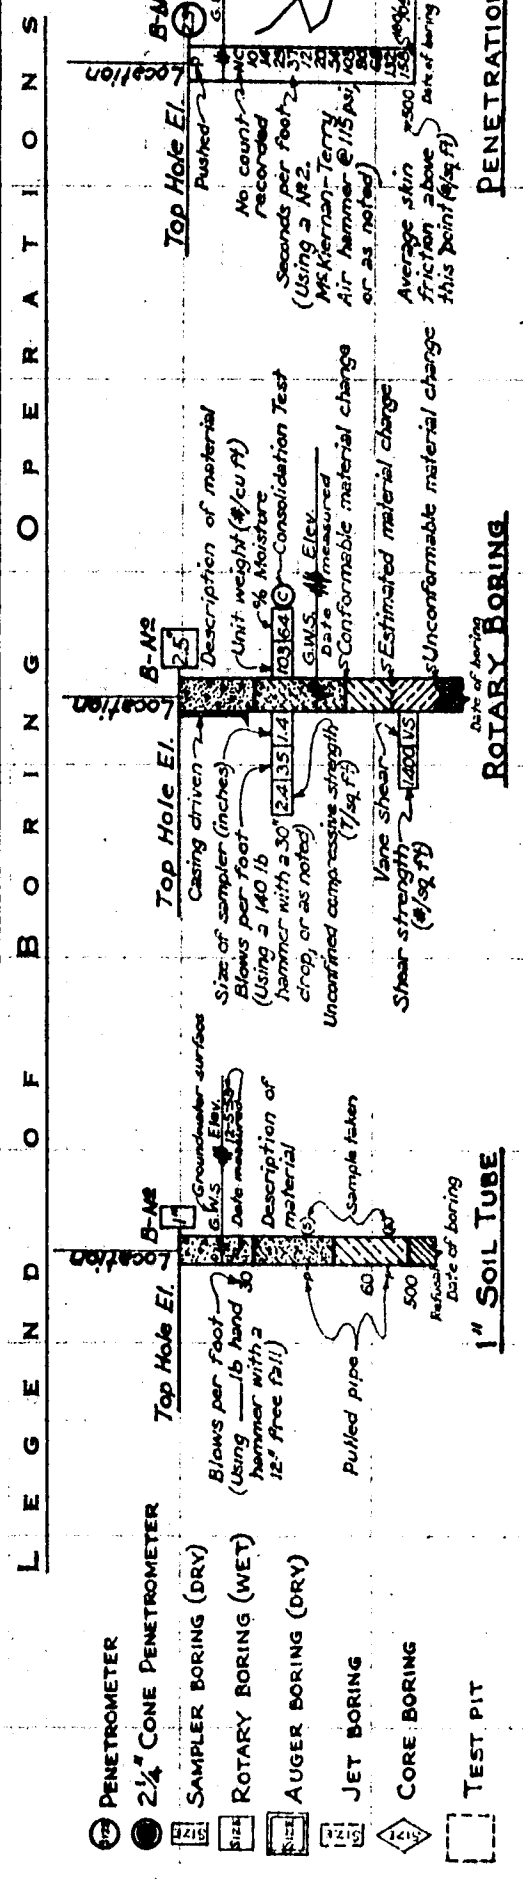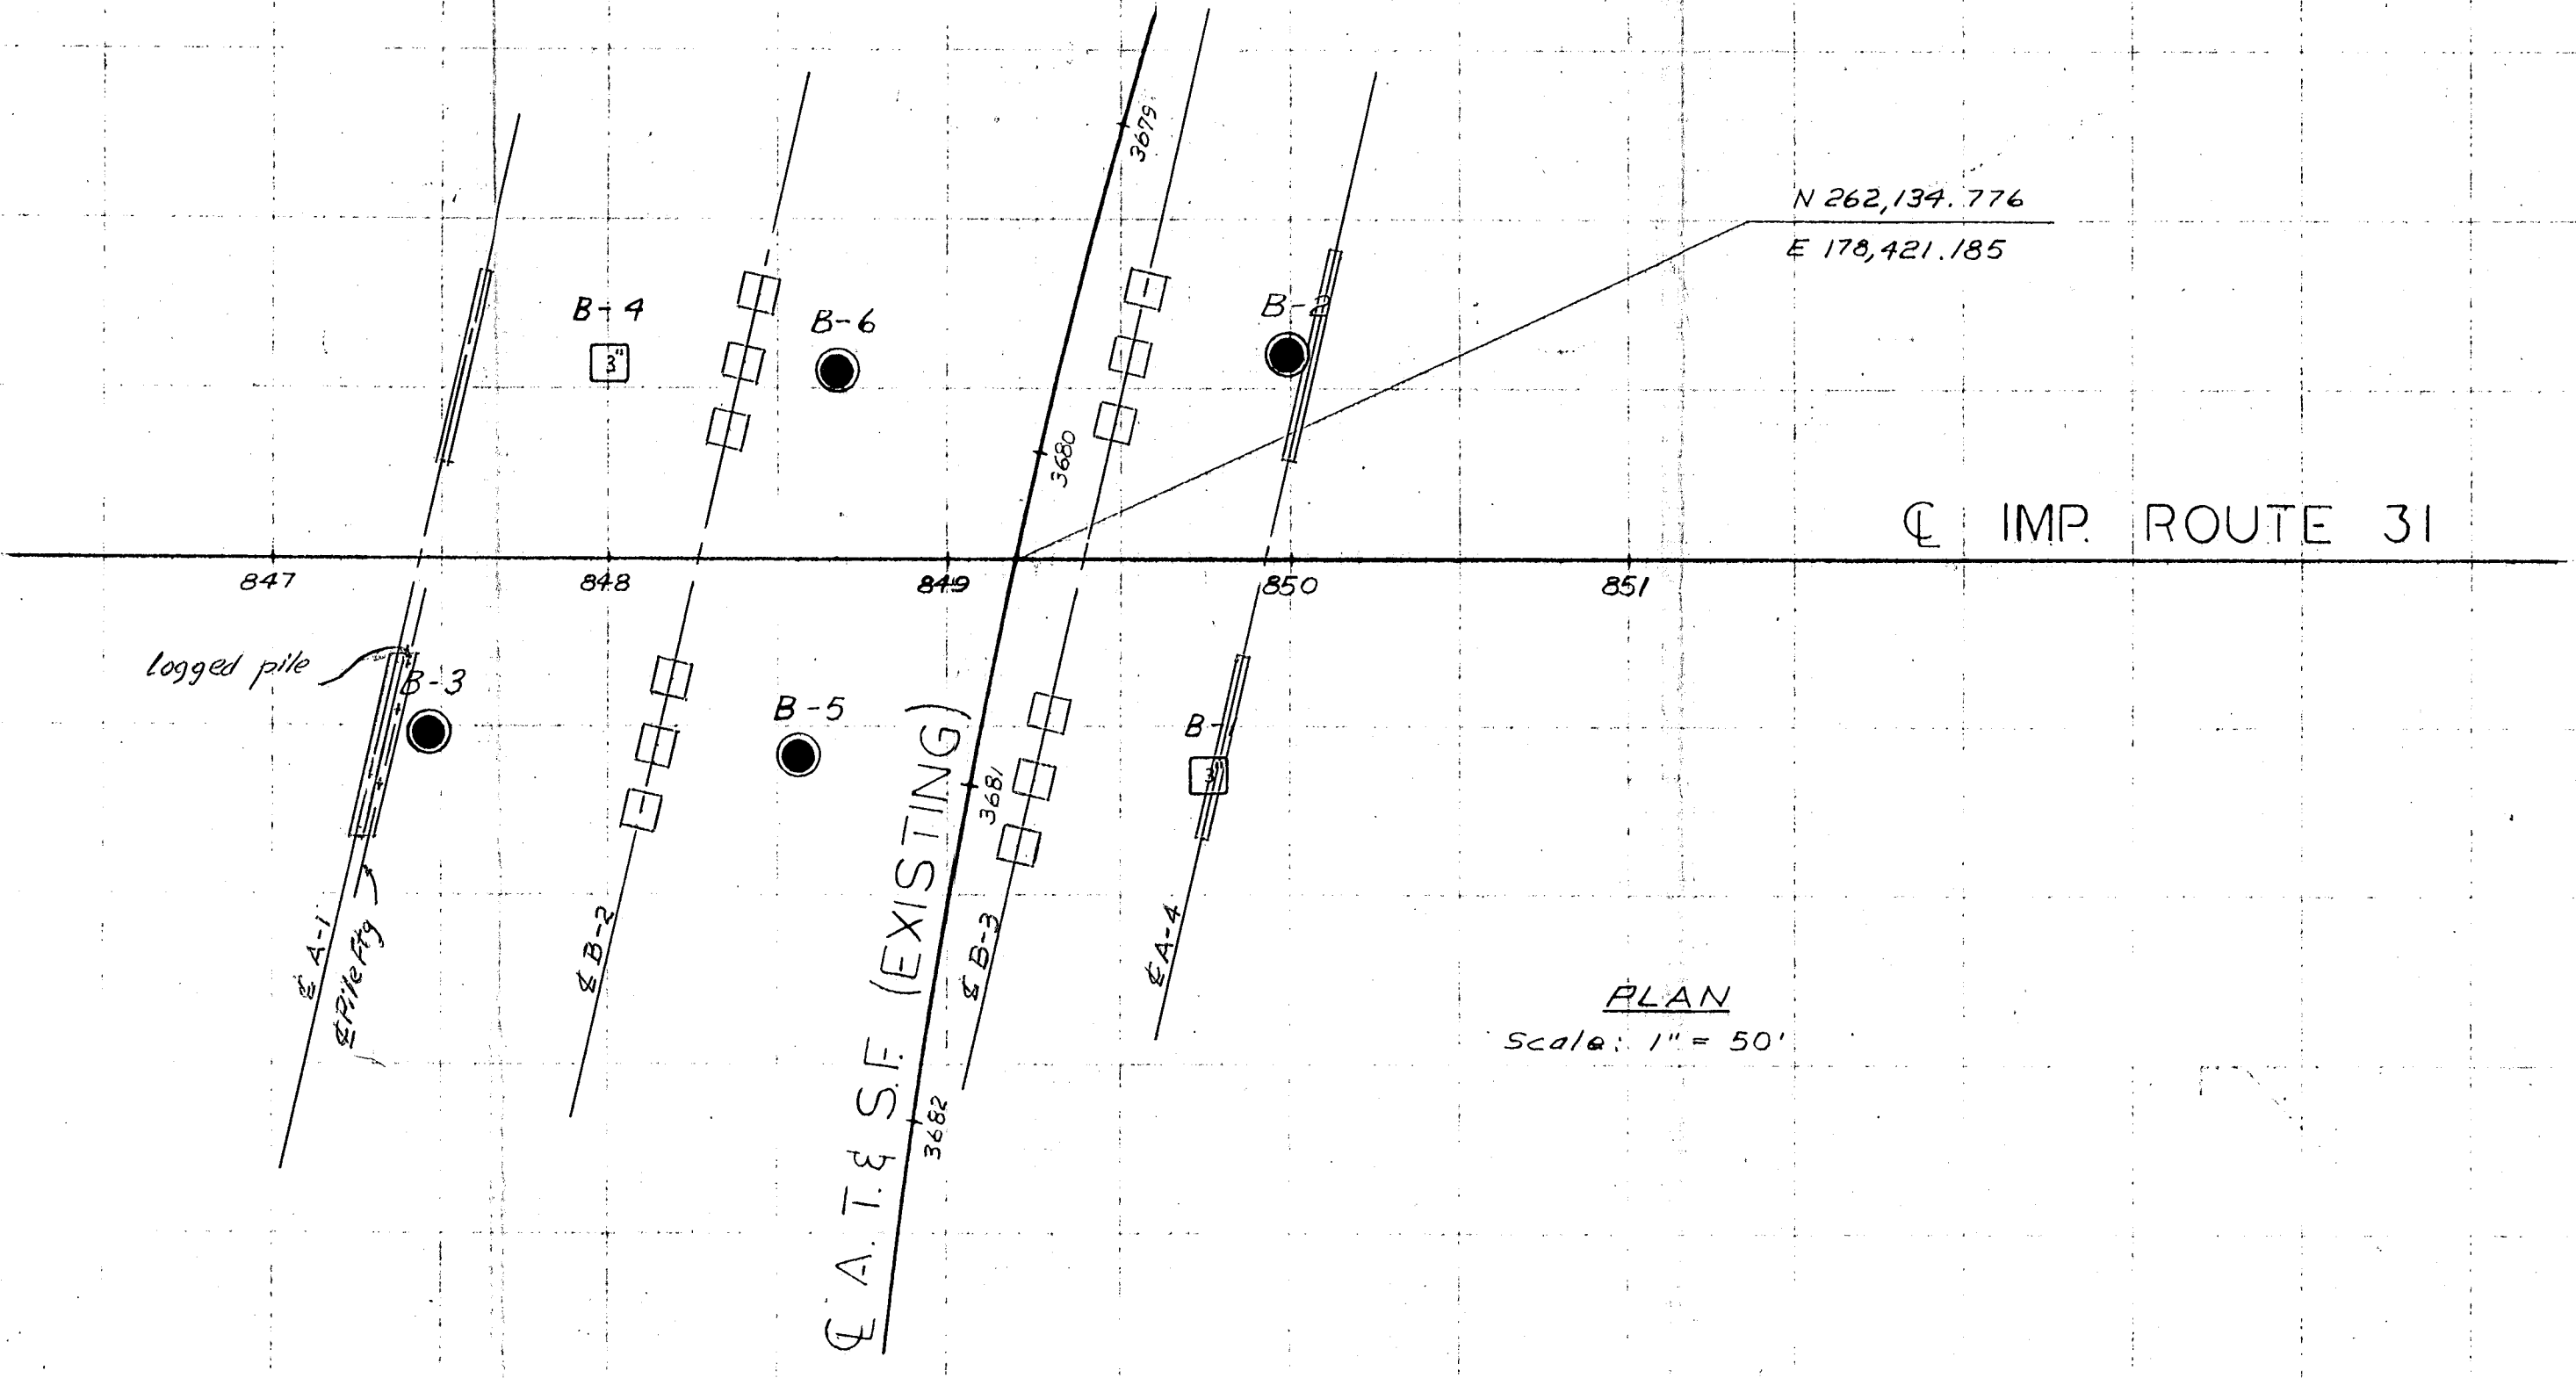


NOTE: Classification of earth material as shown on this sheet is based upon field inspection and is not to be construed to imply mechanical analysis.

FIELD STUDY	By O. MIKES 11-3-65
DRAWN	By G. BOYLE 12-3-65
CHECKED	By O. MIKES 12-6-65

Approval Recommended by: [Signature]

BRIDGE DEPARTMENT
 ENGINEERING GEOLOGY SECTION

256

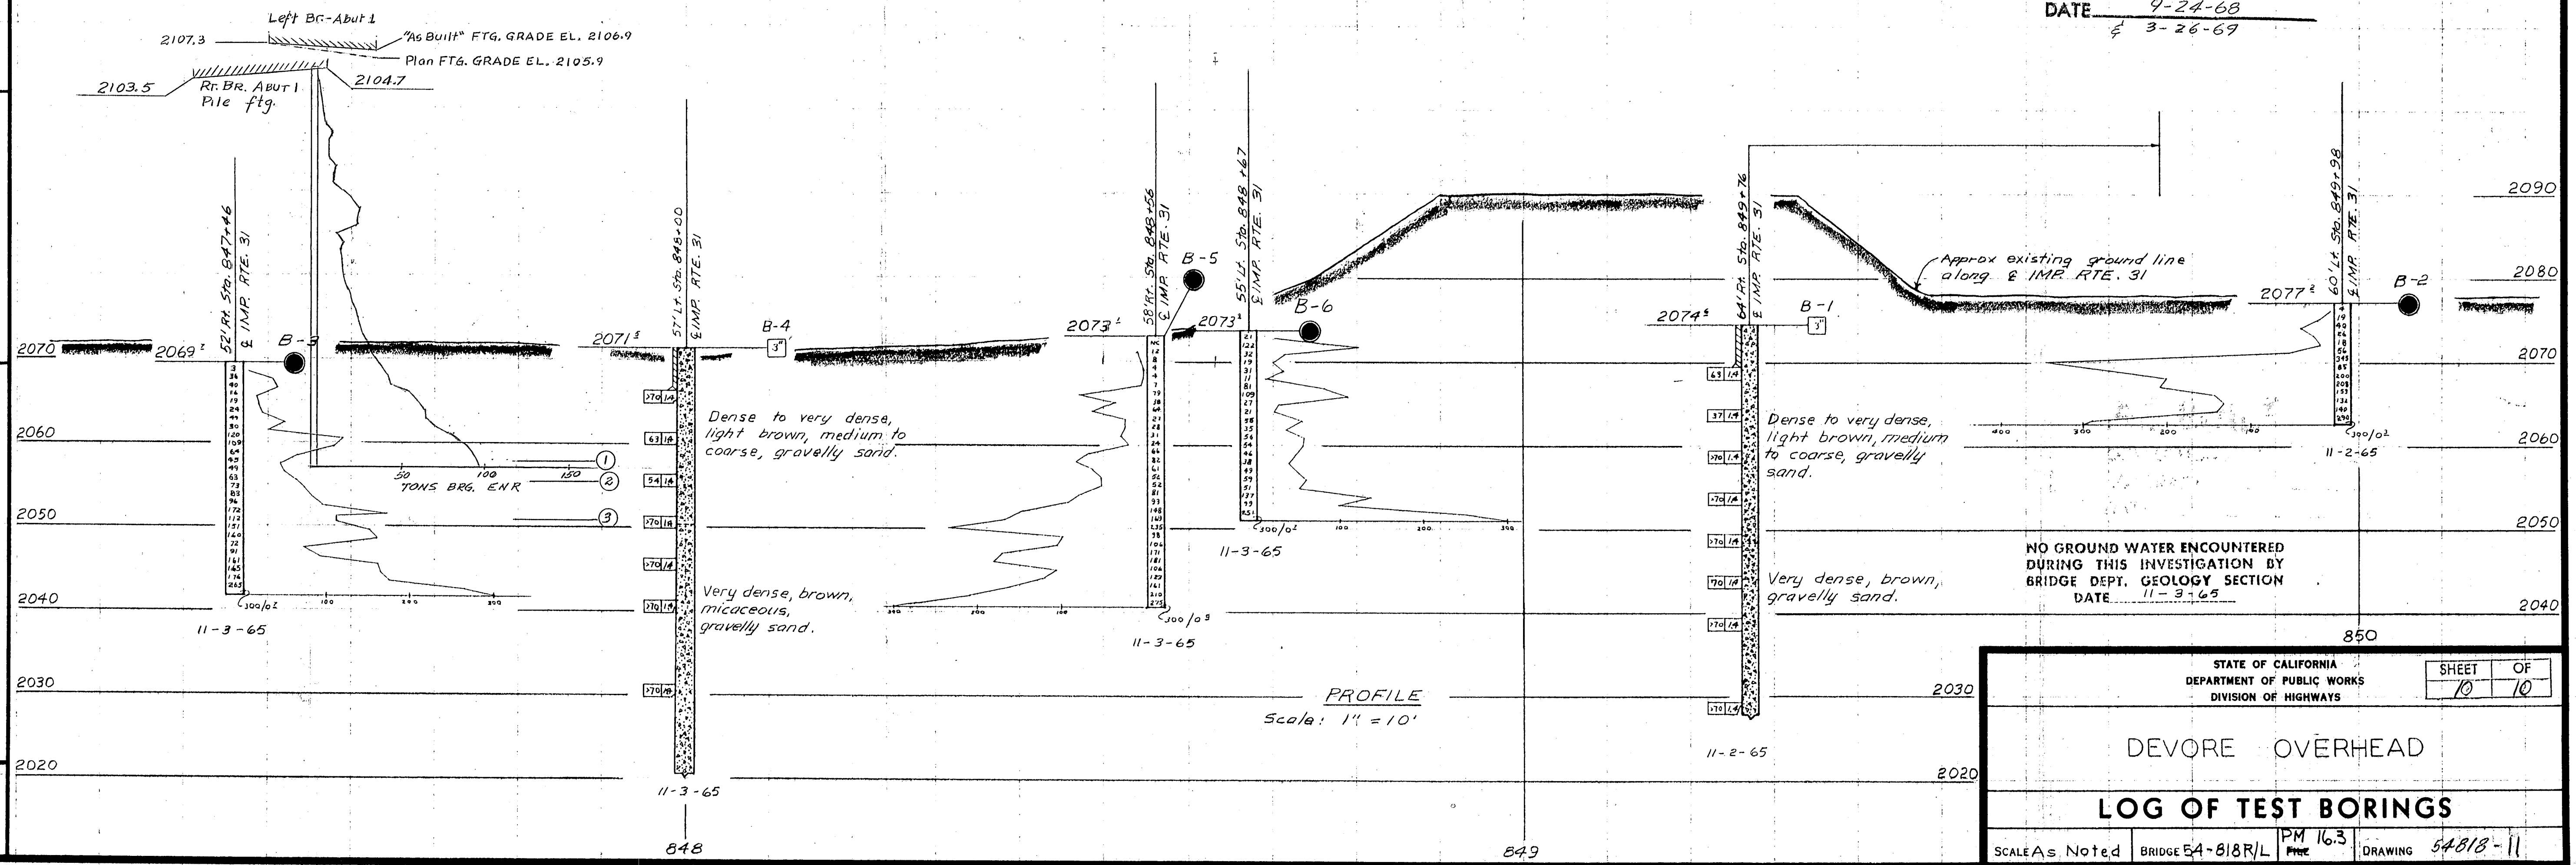

AS BUILT
 CORRECTIONS BY: [Signature]
 CONTRACT NO. 08-049114
 DATE 9-24-68
 3-26-69

NO GROUND WATER ENCOUNTERED DURING THIS INVESTIGATION BY BRIDGE DEPT. GEOLOGY SECTION DATE 11-3-65

STATE OF CALIFORNIA
 DEPARTMENT OF PUBLIC WORKS
 DIVISION OF HIGHWAYS

DEVORE OVERHEAD

LOG OF TEST BORINGS

SCALE As Noted BRIDGE E4-818R/L PM 16.3 DRAWING 54818-11

PREL. DRAWING NO. PR- []

Charge: 08203
 W.A.: 049111



Disregard prints bearing earlier numbers

CHECK PRINT
by _____

BENCH MARK

PNO 173 2120.910
FD STD Brass disk in concrete stamped
"SBD-215-173 1988" 40' Ely of EOD Devore
Rd Bridge at Nly end bridge; 70' Nly of EP
NB SBD 215 at PM 17.3 at top of slope.

PNO 2010 2179.090
FD STD Brass disk in concrete stamped
"D8 SCN SBD-15 PM 16.3 08.04.08" At top
of slope SOUTH of Connector Bridge
from NB SBD 15 to NB SBD 215.

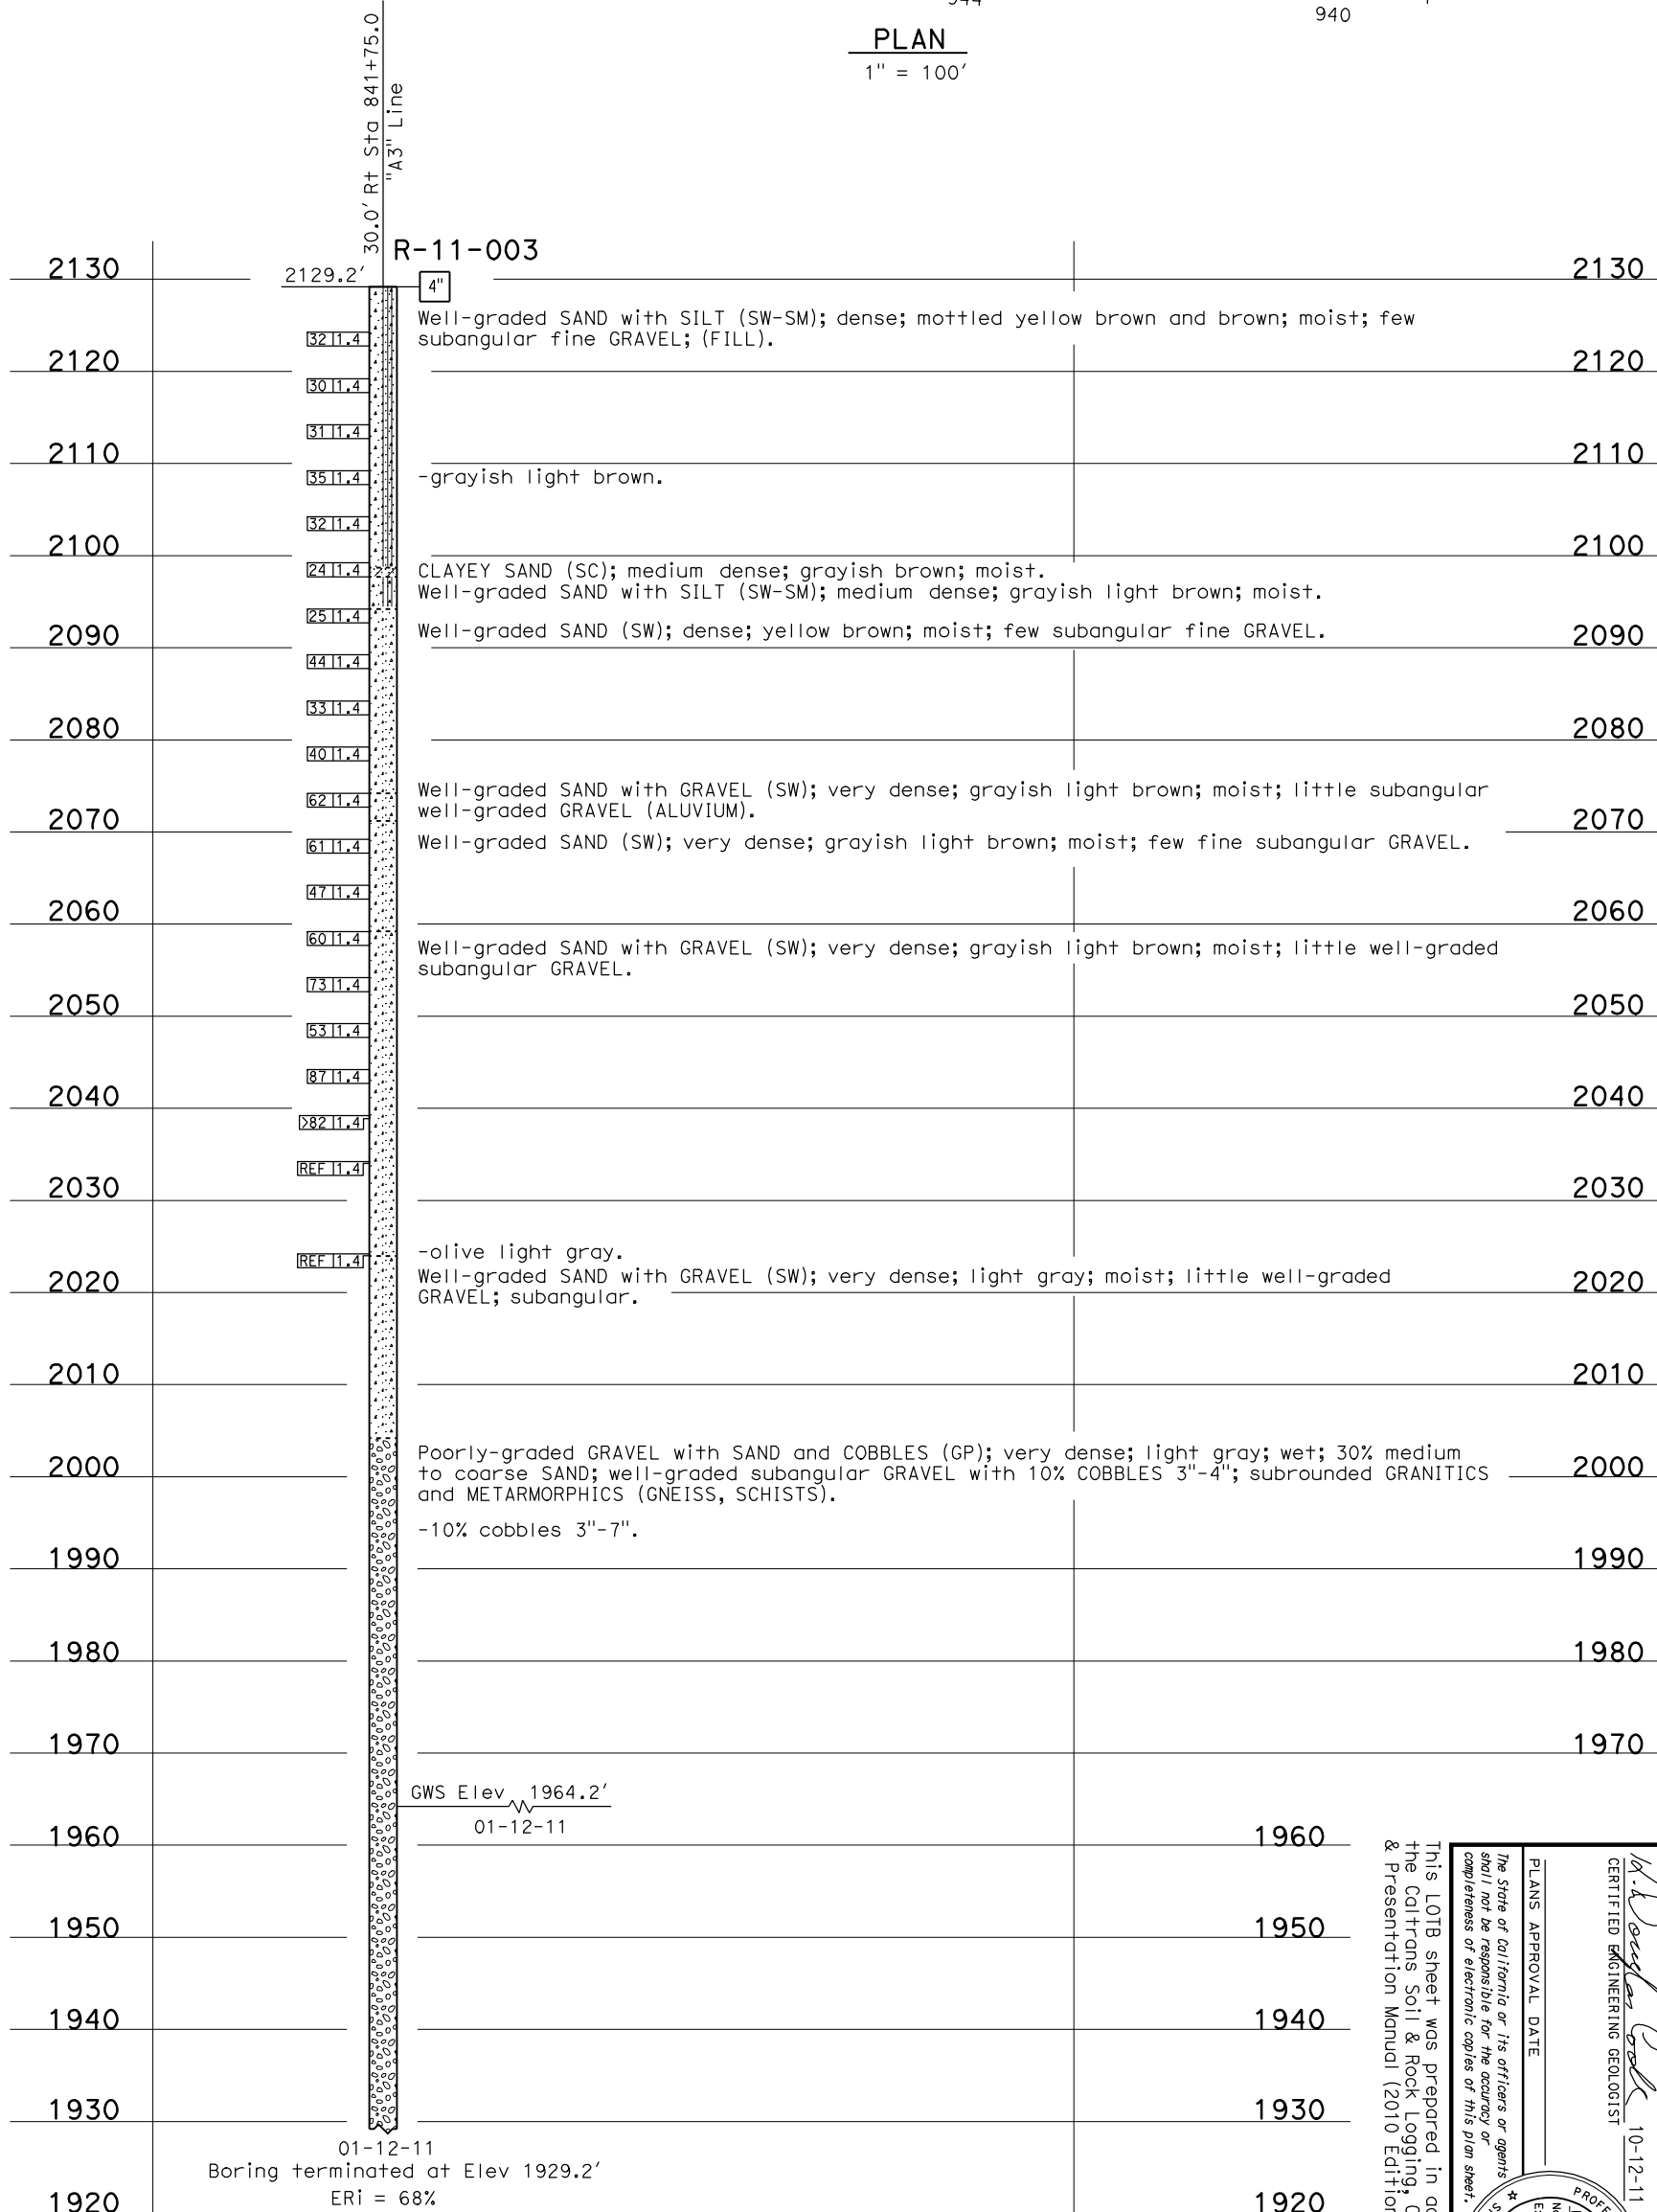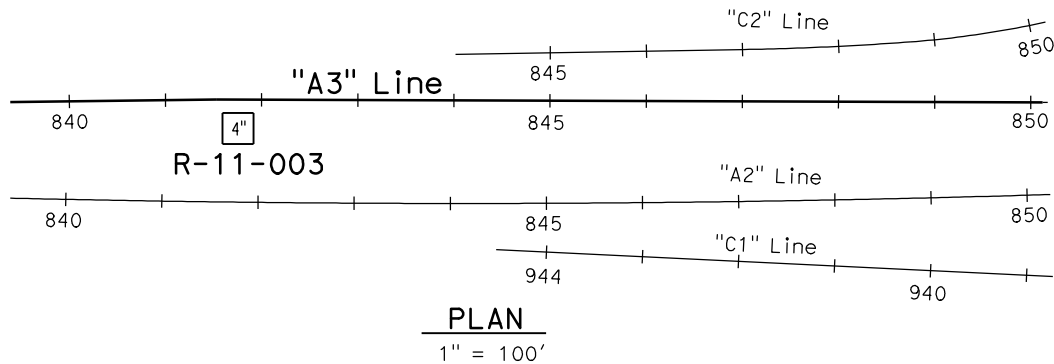

PROFILE
Horiz: 1" = 10'
Vert: 1" = 10'

ENGINEERING SERVICES
FUNCTIONAL SUPERVISOR: NAME: A. Perez-Cobo
DRAWN BY: F. Nguyen 6/11
CHECKED BY: B. Levine/S. Logeswaran

MATERIALS AND GEOTECHNICAL SERVICES
FIELD INVESTIGATION BY: D. Cook, C. Hoodley

STATE OF CALIFORNIA
DEPARTMENT OF TRANSPORTATION

DIVISION OF ENGINEERING SERVICES
DESIGN BRANCH X

DEVORE OH (WIDEN)
LOG OF TEST BORINGS 1 OF 4

BRIDGE NO. 54-0818L/R
POST MILE 15.90
CONTRACT NO.: 08-0K7100

DISSEMINATION BEARING
ENGINEER REVISION DATES

REVISION DATES: SHEET X OF X

ORIGINAL SCALE IN INCHES FOR REDUCED PLANS: 0 1 2 3

FILE => devore-oh1of4.dgn

DIST COUNTY ROUTE POST MILES SHEET TOTAL
08 SBD 15 TOTAL PROJECT NO. SHEETS

M. Douglas Cook 10-12-11
CERTIFIED ENGINEERING GEOLOGIST

PLANS APPROVAL DATE
No. 1391
Exp. 12-31-11
K. Douglas Cook
PROFESSIONAL ENGINEER
GEOLOGIST
STATE OF CALIFORNIA

This LOTB sheet was prepared in accordance with the Caltrans Soil & Rock Logging, Classification, & Presentation Manual (2010 Edition).

Cajon Creek

SEISMIC RETROFIT PROJECT NO. 438

DIST.	COUNTY	ROUTE	POST MILES - TOTAL PROJECT	Sheet No.	Total Sheets
08	Sbd	15	16.07		

STRUCTURAL FOUNDATIONS BRANCH, ENGINEERING SERVICE CENTER


Shau, Khan, Quin
REGISTERED ENGINEER-CIVIL

CAJON CREEK BRIDGE

LOG OF TEST BORINGS 4 OF 4

NOTE: THIS LOG OF TEST BORINGS IS AVAILABLE ON MICROFILM AT OFFICE OF STRUCTURES DESIGN SACRAMENTO, CALIFORNIA

CU: 08109	BRIDGE No.
EA: 413901	54-0781

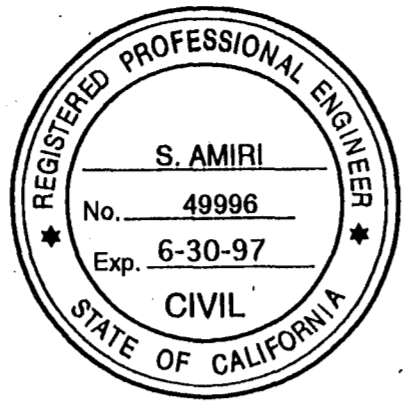

7

Shau, Khan, Quin

November 28, 1965

LEGEND

2 1/2" CONE PENETROMETER
Cone Penetration Test (CPT) - Standard Penetration Test (SPT) equivalent.

3/8" SAMPLER BORING (SB)
SAMPLER BORING (SB) - Standard Penetration Test (SPT) equivalent.

ROTARY BORING (RB)
ROTARY BORING (RB) - Standard Penetration Test (SPT) equivalent.

1" SOIL TUBE
1" SOIL TUBE - Standard Penetration Test (SPT) equivalent.

TEST PIT
TEST PIT - Standard Penetration Test (SPT) equivalent.

LEGEND OF EARTH MATERIALS

GRAVEL
SAND
SILT
CLAY
SANDY CLAY OR CLAYEY SAND
SANDY SILT OR SILTY SAND
SILT CLAY OR CLAYEY SILT
CLAYEY CLAY OR CLAY
SANDY CLAY OR CLAYEY SILT
SANDY SILT OR SILTY SAND
SILT CLAY OR CLAYEY SILT
CLAYEY CLAY OR CLAY
SANDY CLAY OR CLAYEY SILT
SANDY SILT OR SILTY SAND
SILT CLAY OR CLAYEY SILT
CLAYEY CLAY OR CLAY

CLASSIFICATION OF MATERIAL BASED ON STANDARD GRADE SIZE LIMITS

DIAGRAM SHOWING THE BASIS FOR ESTIMATES OF GRADE SIZE DISTRIBUTION USE IN ESTIMATION OF CLAYEY SANDS.


IN ADDITION TO THE "STANDARD GRADE SIZE LIMITS" AND "GRAVELLY SAND", THE TERMS "COARSE SILT", "MEDIUM SILT", AND "FINE SILT" ARE USED TO DESCRIBE THE GRADE SIZE DISTRIBUTION OF SILT AND GRAVEL REFERS TO STANDARD GRADE SIZE LIMITS.

NOTE: Classification of earth material as shown on this sheet is based upon field inspection and is not to be construed to imply mechanical analysis.


FIELD STUDY BY G. LEONARD
DRAWN BY G. LEONARD
CHECKED BY G. LEONARD

BRIDGE DEPARTMENT
ENGINEERING GEOLOGY SECTION

AS BUILT PLANS
Contract No. 08-049114
Date Completed 11-10-69
Document No. 80000217

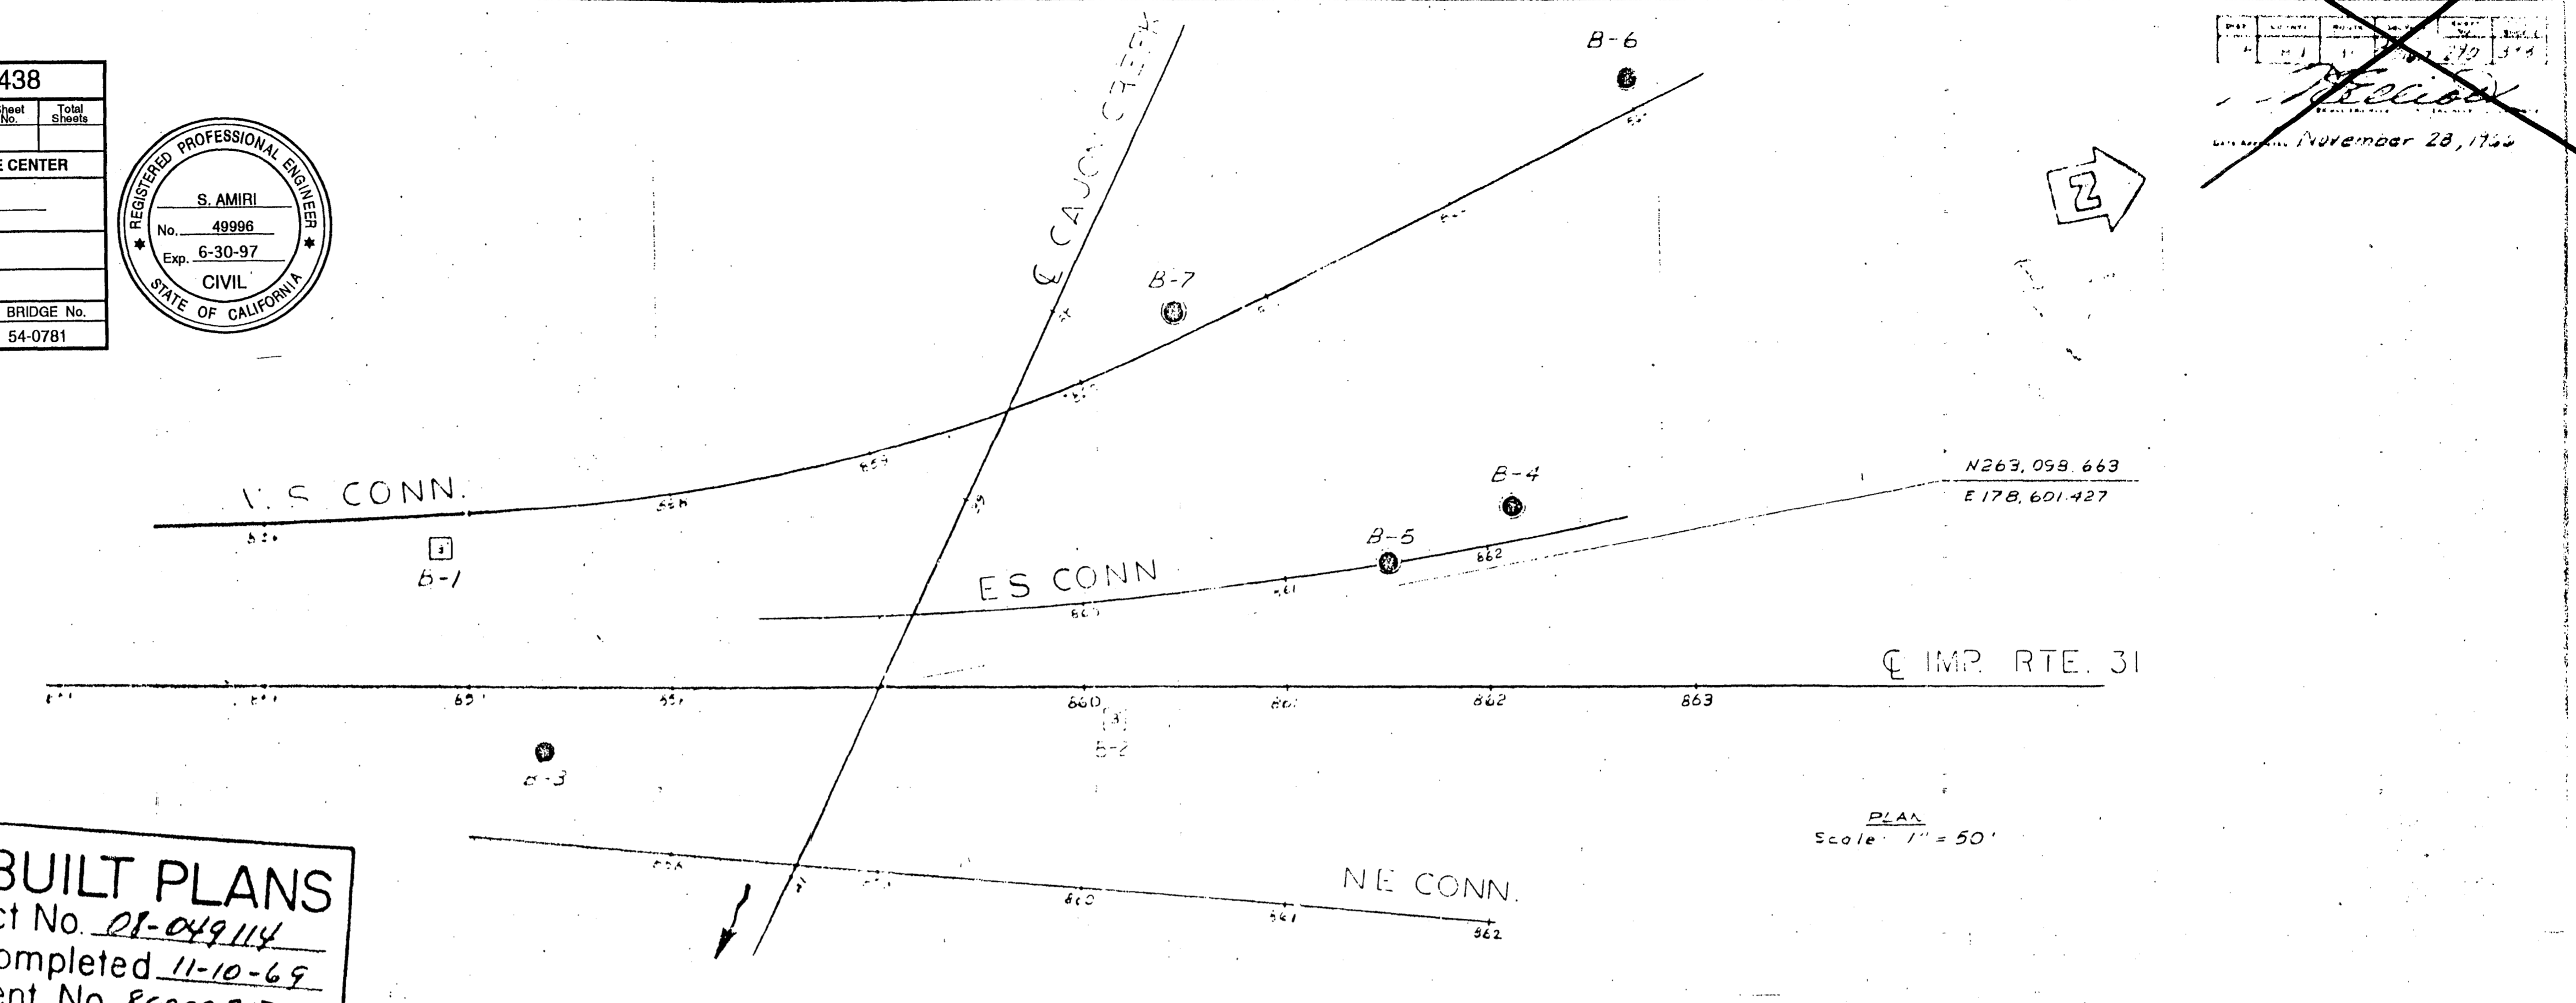

PLAN
Scale: 1" = 50'

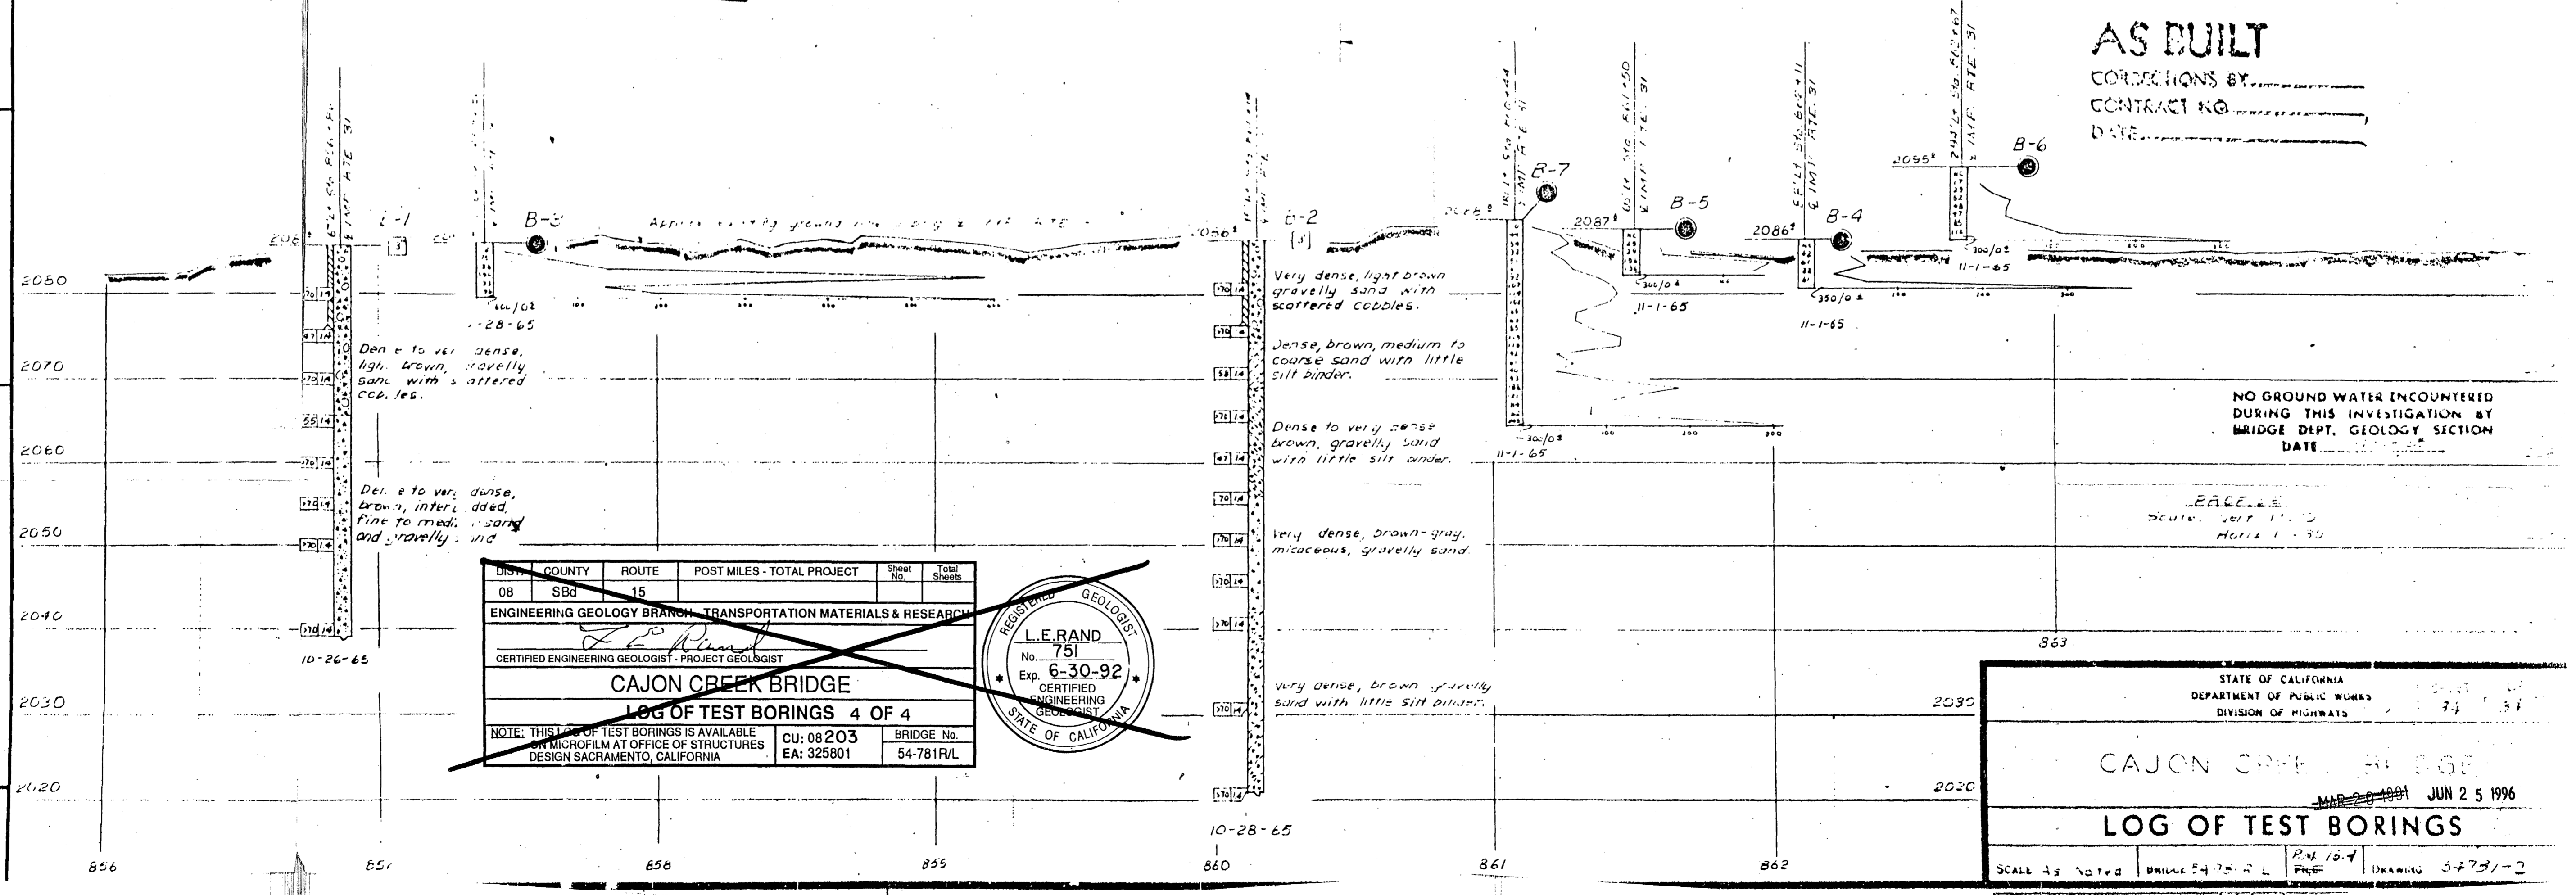

AS BUILT
CORRECTIONS BY _____
CONTRACT NO. _____
DATE _____

NO GROUND WATER ENCOUNTERED DURING THIS INVESTIGATION BY BRIDGE DEPT. GEOLOGY SECTION DATE _____

ENGINEERING GEOLOGY BRANCH, TRANSPORTATION MATERIALS & RESEARCH

L.E. RAND
REGISTERED GEOLOGIST
No. 751
Exp. 6-30-92
CERTIFIED ENGINEERING GEOLOGIST
STATE OF CALIFORNIA

CAJON CREEK BRIDGE

LOG OF TEST BORINGS 4 OF 4

NOTE: THIS LOG OF TEST BORINGS IS AVAILABLE ON MICROFILM AT OFFICE OF STRUCTURES DESIGN SACRAMENTO, CALIFORNIA

CU: 08203	BRIDGE No.
EA: 325801	54-781R/L

STATE OF CALIFORNIA
DEPARTMENT OF PUBLIC WORKS
DIVISION OF HIGHWAYS

CAJON CREEK BRIDGE

LOG OF TEST BORINGS

SCALE 4s Noted BRIDGE 54-781R/L DRAWING 54-781-2

MAR 20 1991 JUN 25 1996

FOR PLAN VIEW, SEE LOG OF TEST BORINGS SHEET 1 OF 4

DIST.	COUNTY	ROUTE	POST MILES TOTAL PROJECT	SHEET NO.	TOTAL SHEETS
08	SGD	15			

L.E. Rand
 CERTIFIED ENGINEERING GEOLOGIST
 No. 751
 Exp. 6-30-92
 REGISTERED GEOLOGIST
 STATE OF CALIFORNIA

PERMITS APPROVAL DATE

LEGEND OF BORING OPERATIONS

2 1/4" CONE PENETROMETER TEST
 No count recorded
 Pushed
 Driving rate in seconds
 Pushed at 150 cfm area
 Measured on top element
 Measured on tip element
 Boring Date

2 1/4" CONE PENETRATION BORING
 Description of material
 Unit weight (buco ft)
 % moisture
 Consolidation test
 Unconfined compression strength (1 sq ft)
 Shear strength (lb/sq ft)
 Vane shear
 Estimated material change
 Unconformable material change
 Boring Date

ROTARY SAMPLE BORING (WET)
 Description of material
 Unit weight (buco ft)
 % moisture
 Consolidation test
 Unconfined compression strength (1 sq ft)
 Shear strength (lb/sq ft)
 Vane shear
 Estimated material change
 Unconformable material change
 Boring Date

2 1/4" CONE PENETROMETER TEST
 No count recorded
 Pushed
 Driving rate in seconds
 Pushed at 150 cfm area
 Measured on top element
 Measured on tip element
 Boring Date

LEGEND OF EARTH MATERIALS


GRAVEL
 SAND
 SILT
 CLAY
 SANDY CLAY or CLAYEY SAND
 SILTY SAND or SANDY SILT
 SILTY CLAY

CLAYEY SILT
 REEFY SAND
 ORGANIC MATTER
 FILL MATERIAL
 IGNEOUS ROCK
 SEDIMENTARY ROCK
 METAMORPHIC ROCK

CONSISTENCY CLASSIFICATION FOR SOILS
 According to the Standard Penetration Test:

Penetration Index (Blows / Ft)	Cohesive	Granular
0-4	Very soft	Very loose
5-9	Soft	Loose
10-19	Stiff	Medium dense
20-29	Very stiff	Dense
30-59	Hard	Very dense
>70	Very hard	

NOTE: Classification of earth material as shown on this sheet is based upon field inspection and is not to be construed to imply mechanical analysis.

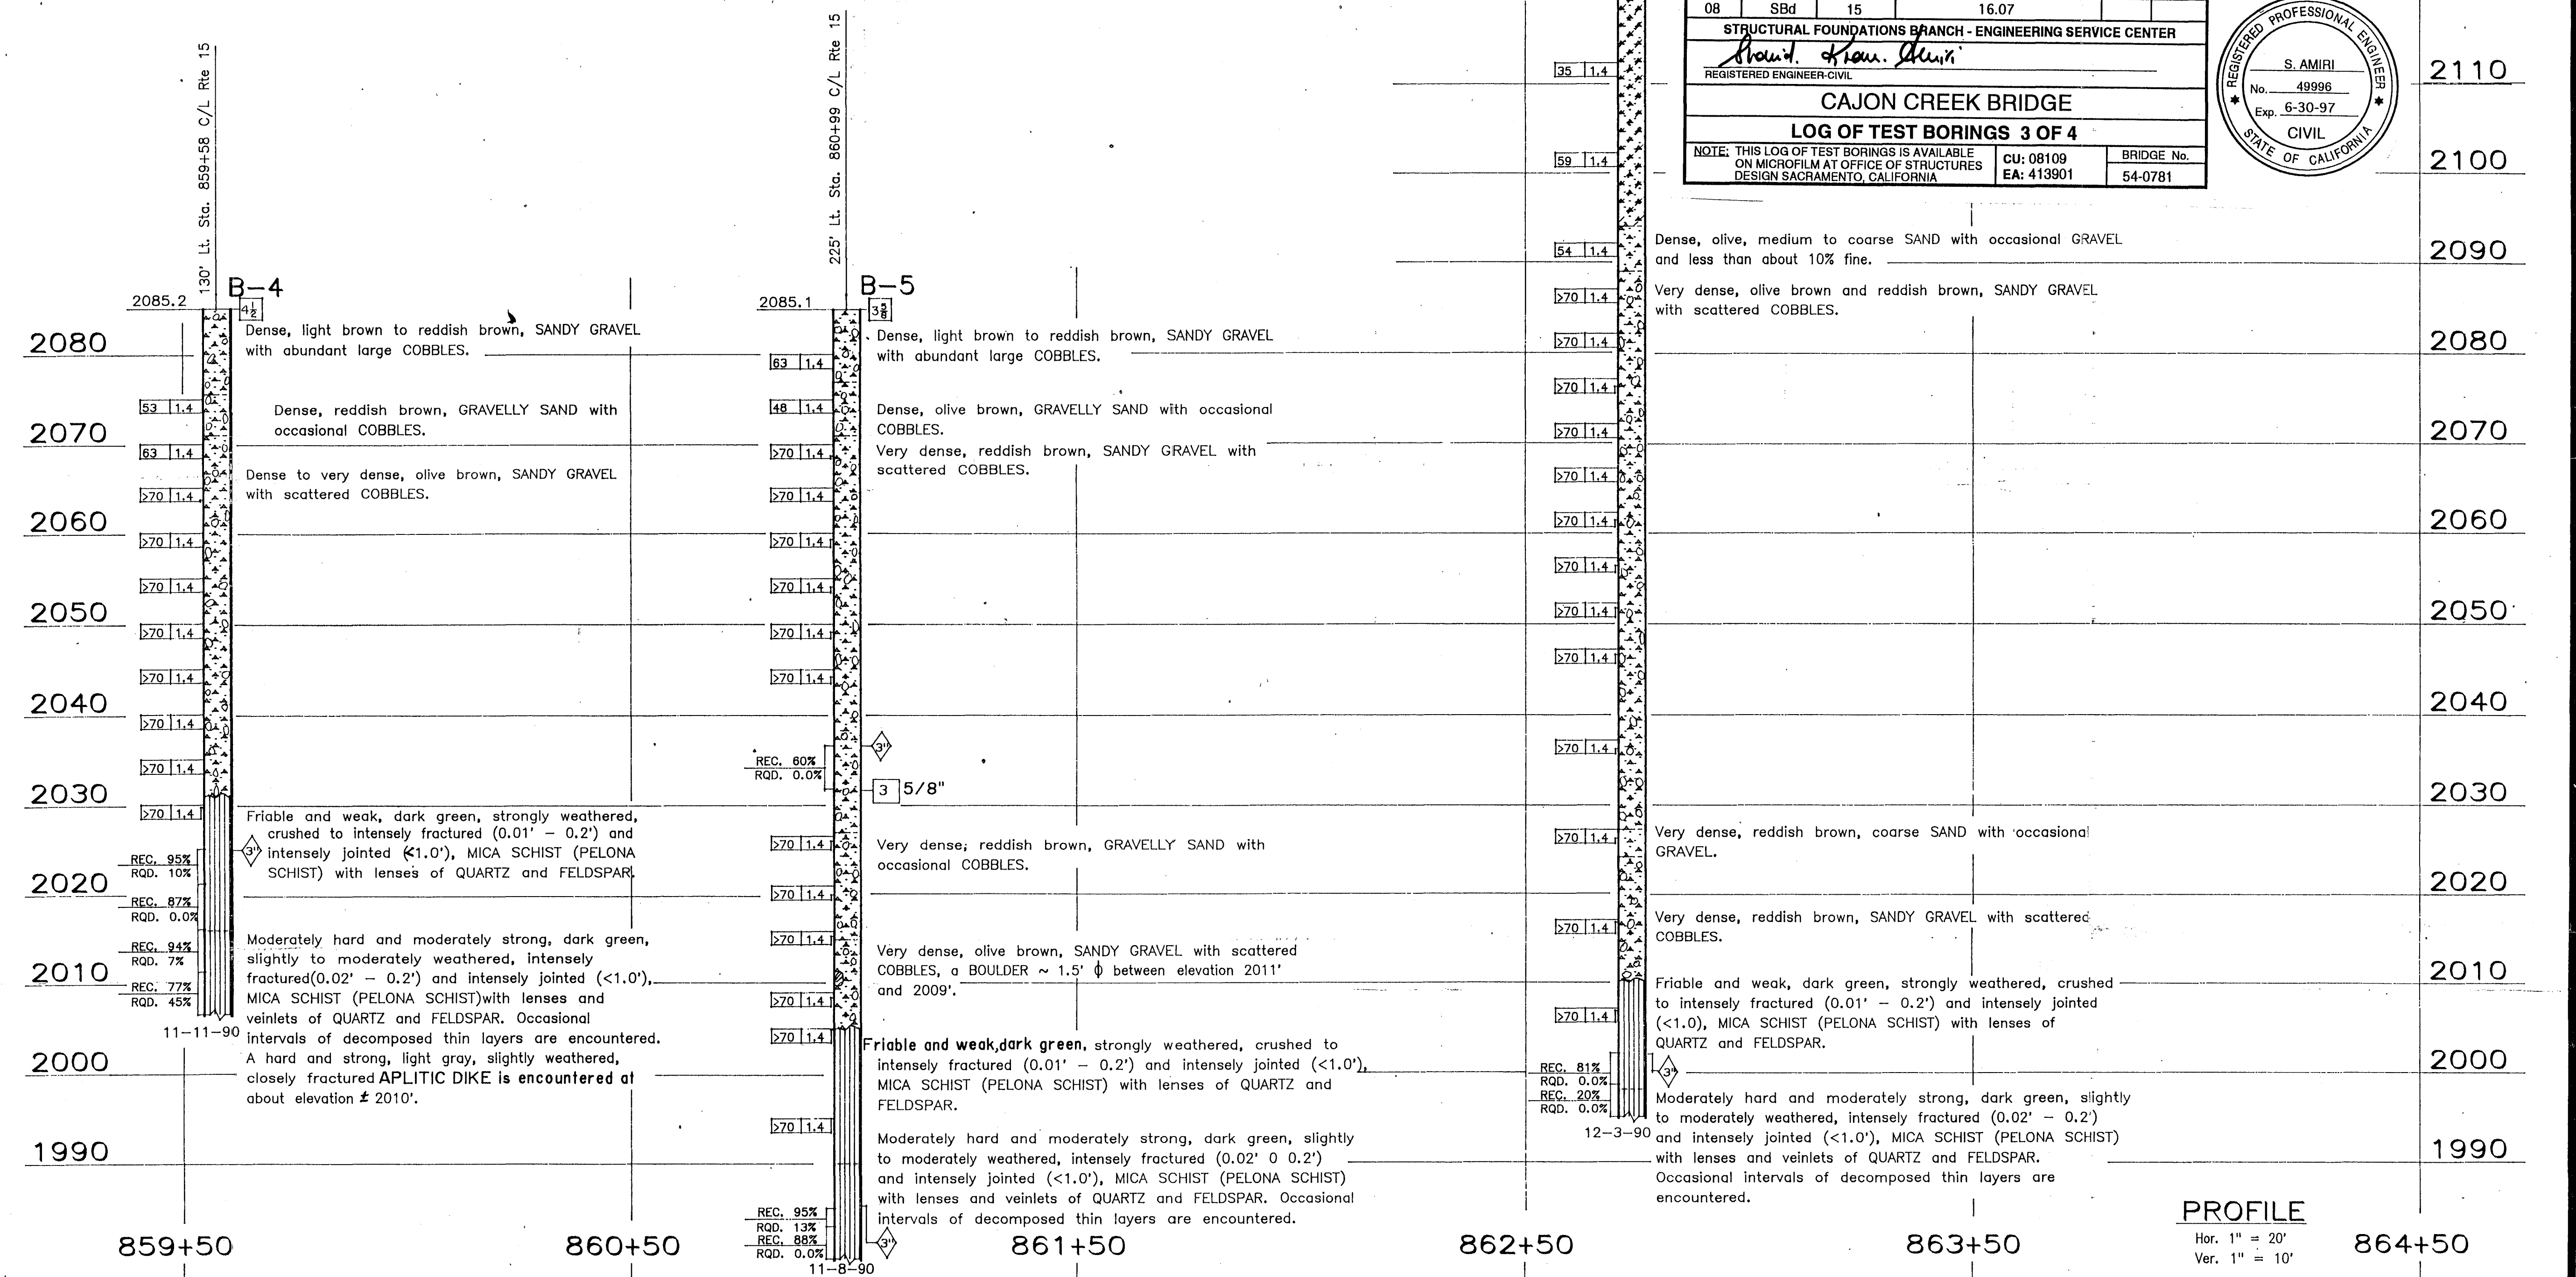

B-6
 2150
 Dense, olive brown, SILTY SANDY GRAVEL with occasional COBBLES (fill material), dry.

2140
 Dense, brown and dark olive, GRAVELLY SILTY SAND (fill material).

SEISMIC RETROFIT PROJECT NO. 438

DIST.	COUNTY	ROUTE	POST MILES - TOTAL PROJECT	Sheet No.	Total Sheets
08	SGD	15	16.07		

STRUCTURAL FOUNDATIONS BRANCH - ENGINEERING SERVICE CENTER
David Alan Stein
 REGISTERED ENGINEER-CIVIL

CAJON CREEK BRIDGE

LOG OF TEST BORINGS 3 OF 4

NOTE: THIS LOG OF TEST BORINGS IS AVAILABLE ON MICROFILM AT OFFICE OF STRUCTURES DESIGN SACRAMENTO, CALIFORNIA

CU: 08109	BRIDGE No.
EA: 413901	54-0781

REGISTERED PROFESSIONAL ENGINEER
 S. AMIRI
 No. 49996
 Exp. 6-30-97
 CIVIL
 STATE OF CALIFORNIA

2130
 Dense, olive, medium to coarse SAND with occasional GRAVEL and less than about 10% fine.

2120
 Very dense, olive brown and reddish brown, SANDY GRAVEL with scattered COBBLES.

2110
 Dense, light brown to reddish brown, SANDY GRAVEL with abundant large COBBLES.

2100
 Dense, light brown to reddish brown, SANDY GRAVEL with abundant large COBBLES.

2090
 Dense, reddish brown, GRAVELLY SAND with occasional COBBLES.

2080
 Dense to very dense, olive brown, SANDY GRAVEL with scattered COBBLES.

2070
 Dense, reddish brown, GRAVELLY SAND with occasional COBBLES.

2060
 Dense, reddish brown, GRAVELLY SAND with occasional COBBLES.

2050
 Dense, reddish brown, GRAVELLY SAND with occasional COBBLES.

2040
 Dense, reddish brown, GRAVELLY SAND with occasional COBBLES.

2030
 Dense, reddish brown, GRAVELLY SAND with occasional COBBLES.

2020
 Very dense, reddish brown, coarse SAND with occasional GRAVEL.

2010
 Very dense, reddish brown, SANDY GRAVEL with scattered COBBLES.

2000
 Friable and weak, dark green, strongly weathered, crushed to intensely fractured (0.01' - 0.2') and intensely jointed (<1.0'), MICA SCHIST (PELONA SCHIST) with lenses of QUARTZ and FELDSPAR.

1990
 Moderately hard and moderately strong, dark green, slightly to moderately weathered, intensely fractured (0.02' - 0.2') and intensely jointed (<1.0'), MICA SCHIST (PELONA SCHIST) with lenses and veinlets of QUARTZ and FELDSPAR. Occasional intervals of decomposed thin layers are encountered.


OFFICE OF TRANSPORTATION MATERIALS & RESEARCH		ENGINEERING GEOLOGY BRANCH		BRIDGE NO. 54-0781RL		CAJON CREEK BRIDGE	
DRAWN BY K. WAHL 2-91 & VICTOR SESTOKAS		2/91		POST MILE 16.07		LOG OF TEST BORINGS 3 OF 4	
CHECKED BY Farmanaz Geronzi		3/91		DIVISION OF STRUCTURES STRUCTURE DESIGN		REVISION DATES (PRELIMINARY STAGE ONLY)	
ORIGINAL SCALE IN INCHES FOR REDUCED PLANS		0 1 2 3		CU 08203 EA 325801		SHEET 01	

DIST.	COUNTY	ROUTE	POST MILES TOTAL PROJECT	SHEET NO.	TOTAL SHEETS
08	SBD	15			
DEANS APPROVAL DATE					

FOR PLAN VIEW, SEE LOG OF TEST BORINGS SHEET 1 OF 4

NOTE:
For Bench Marks and Notes see Sheet 1 of 4.

SEISMIC RETROFIT PROJECT NO. 438					
DIST.	COUNTY	ROUTE	POST MILES - TOTAL PROJECT	Sheet No.	Total Sheets
08	SBD	15	16.07		
STRUCTURAL FOUNDATIONS BRANCH - ENGINEERING SERVICE CENTER					
<i>David Khan Alami</i> REGISTERED ENGINEER-CIVIL					
CAJON CREEK BRIDGE					
LOG OF TEST BORINGS 2 OF 4					
NOTE: THIS LOG OF TEST BORINGS IS AVAILABLE ON MICROFILM AT OFFICE OF STRUCTURES DESIGN SACRAMENTO, CALIFORNIA			CU: 08109 EA: 413901	BRIDGE No. 54-0781	

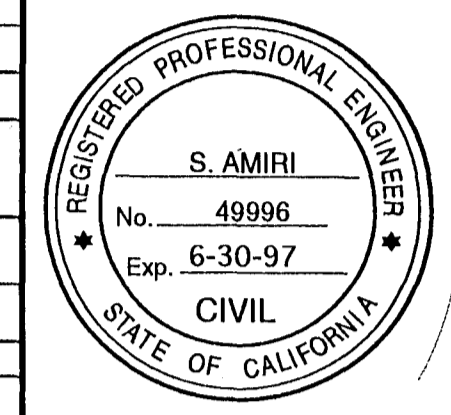

LEGEND OF BORING OPERATIONS

2 1/4" CONE PENETROMETER BORING (DRY)
 No count recorded. Pushed along sleeve in hole. Pressure measured on tip element (150 cm² area) divided by pressure on tip element (10 cm² area).
 B.H.C. Elev. Date measured. Boring Date.

2 1/4" CONE PENETROMETER TEST
 Cone Penetrometer dimensions and testing procedures are in accordance with ASTM Standard D 3441-79, or as noted.

ROTARY SAMPLE BORING (WET)
 Description of material. Unit weight (lb/cu ft). % moisture. Penetration index. (Using a 140 lb. Standard Penetration Test hammer at 15 psf or as noted).
 Date measured. Estimated material change. Unconformable material change. (If 1/4" ft).
 B.H.C. Elev. Date measured. Boring Date.

ROTARY SAMPLE BORING (DRY)
 Description of material. Unit weight (lb/cu ft). % moisture. Penetration index. (Using a 140 lb. Standard Penetration Test hammer at 15 psf or as noted).
 Date measured. Estimated material change. Unconformable material change. (If 1/4" ft).
 B.H.C. Elev. Date measured. Boring Date.

LEGEND OF EARTH MATERIALS


GRAVEL, SAND, SILT, CLAY, SANDY CLAY or CLAYEY SAND, SANDY SILT or SILTY SAND, SILTY CLAY, CLAYEY SILT, PEAT and/or ORGANIC MATTER, FILL MATERIAL, IGNEOUS ROCK, SEDIMENTARY ROCK, METAMORPHIC ROCK.

CONSISTENCY CLASSIFICATION FOR SOILS

According to the Standard Penetration Test

Penetration Index (Blows / Ft)	Cohesive	Non-cohesive
0-4	Very soft	Very loose
5-9	Soft	Loose
10-19	Stiff	Slightly compact
20-34	Very stiff	Compact
35-69	Hard	Dense
>70	Very hard	Very dense

NOTE: Classification of earth material as shown on this sheet is based upon field inspection and is not to be construed to imply mechanical analysis.

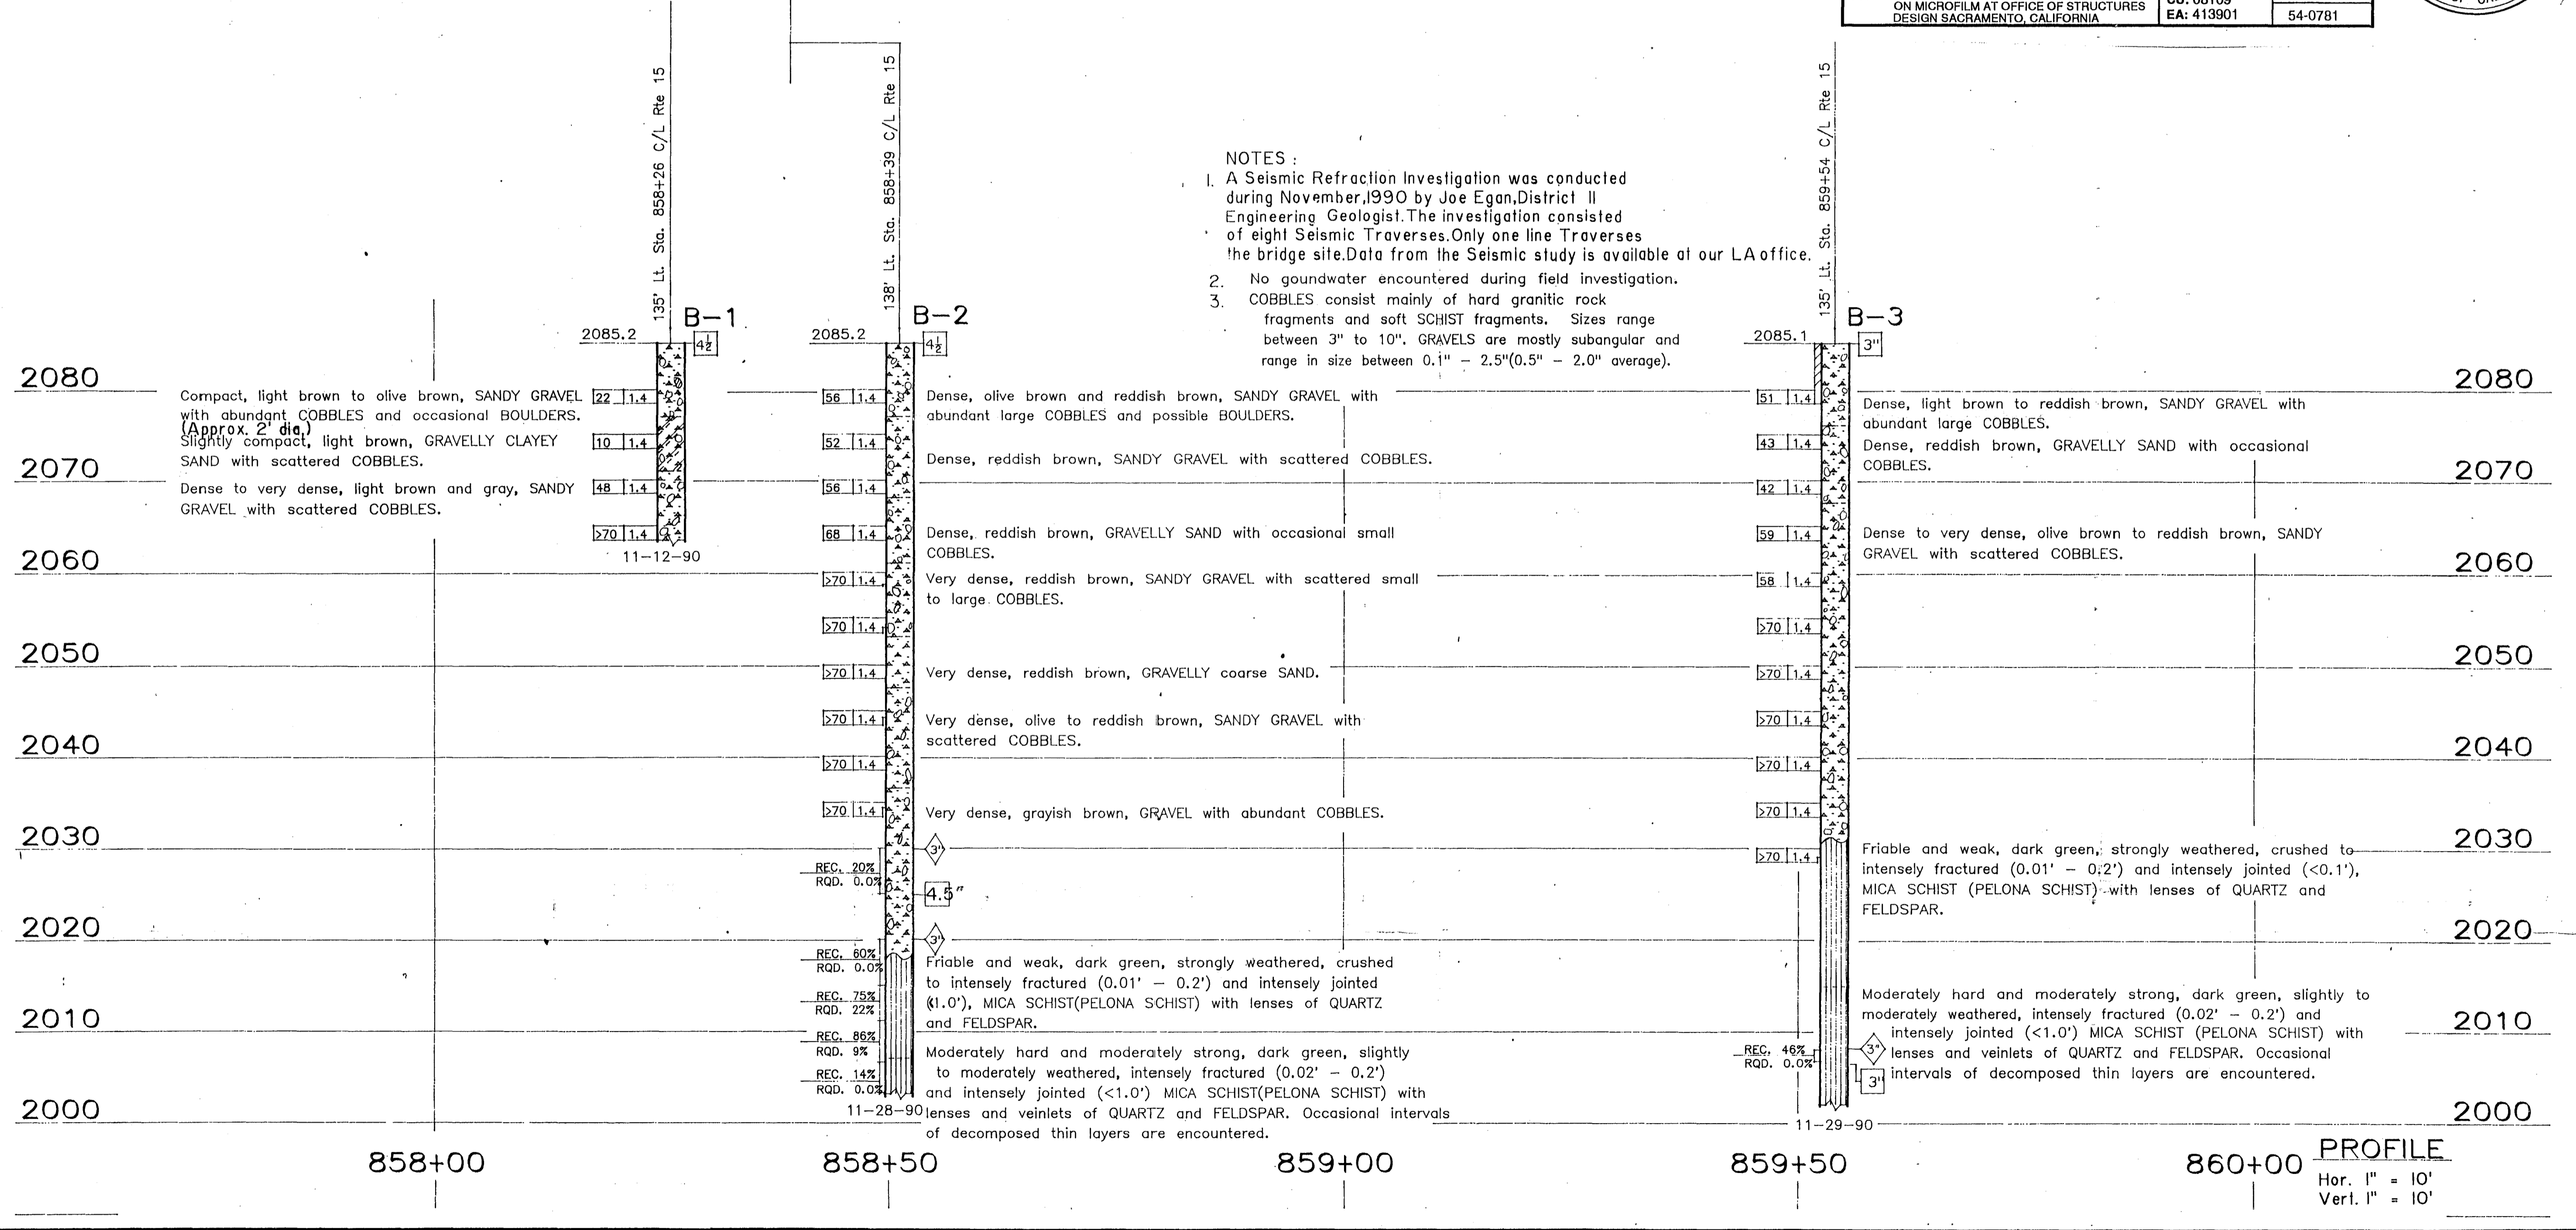

OFFICE OF TRANSPORTATION MATERIALS & RESEARCH		ENGINEERING GEOLOGY BRANCH		BRIDGE NO. 54-0781RL		CAJON CREEK BRIDGE		JUN 25 1996	
DRAWN BY K. WAHL 2-91 & VICTOR SESTOKAS 2/91				POST MILE 16.07		LOG OF TEST BORINGS 2 OF 4		MAR 20 1991	
CHECKED BY				CU 08203 EA 325801		REVISION DATES (PRELIMINARY STAGE ONLY)		SHEET 01	

ORIGINAL SCALE IN INCHES FOR REDUCED PLANS 0 1 2 3

TRANSLAB FILE

DIST.	COUNTY	ROUTE	POST MILES TOTAL PROJECT	SHEET NO.	TOTAL SHEETS
08	SBd	15			

REGISTERED GEOLOGIST
L.E. RAND
 No. 751
 6-30-92
 CERTIFIED ENGINEERING GEOLOGIST
 STATE OF CALIFORNIA

PLANS APPROVAL DATE _____

BENCH MARKS

BM 87-A-72 ELEV. 2088.10
 Std. br. disk in conc. stamped "BM 85-A-72"
 270' RI. Sta. 860+57 @ Rte. 15 bur. 0.7'
 As per Reference 253529 261159

TBM ELEV. 2110.29
 Set chis. mark on Wly side of bent # 6 col. (E-S Conn.)
 4' ± above ground.

TBM ELEV. 2086.40
 Set chis. mark on Wly side of bent # 4 col. (E-S Conn.)
 4' ± above ground

NOTE:
 A horizontal slash was etched on the face of the bent. It was painted with aluminum paint and then blackened with a black felt marker. The TBM elevation was marked above the chis. mark.

SEISMIC RETROFIT PROJECT NO. 438

DIST.	COUNTY	ROUTE	POST MILES - TOTAL PROJECT	Sheet No.	Total Sheets
08	SBd	15	16.07		

STRUCTURAL FOUNDATIONS BRANCH - ENGINEERING SERVICE CENTER


Shahid. Khan. Alux.
 REGISTERED ENGINEER-CIVIL

CAJON CREEK BRIDGE

LOG OF TEST BORINGS 1 OF 4

NOTE: THIS LOG OF TEST BORINGS IS AVAILABLE ON MICROFILM AT OFFICE OF STRUCTURES DESIGN SACRAMENTO, CALIFORNIA

CU: 08109	BRIDGE No.
EA: 413901	54-0781

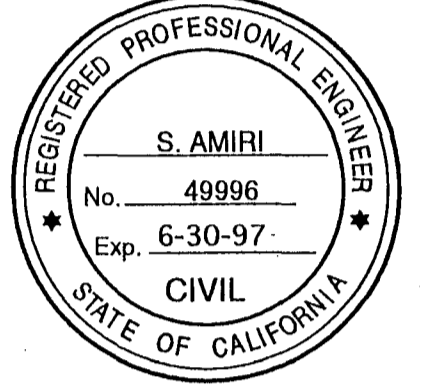

LEGEND OF BORING OPERATIONS

TEST BORING
 B.No. [] Location []
 Top Hole El. []
 Boring Date []
 Penetration Boring
 No. of blows per foot (Using 28 lb. hammer with a 30" drop, or as noted)
 Description of material
 Unit weight (lb/cu ft)
 Date measured
 Consolidation test
 McKeeman-Terry air
 expansion test (1.5 psi. or as noted)
 Friction (lb/ft)
 Tip bearing (lb/sq ft)

POST HOLE WATER BORING (W.B.)
 B.No. [] Location []
 Top Hole El. []
 Boring Date []
 Penetration Boring
 No. of blows per foot (Using 28 lb. hammer with a 30" drop, or as noted)
 Description of material
 Unit weight (lb/cu ft)
 Date measured
 Consolidation test
 McKeeman-Terry air
 expansion test (1.5 psi. or as noted)
 Friction (lb/ft)
 Tip bearing (lb/sq ft)

WATER BORING (W.B.)
 B.No. [] Location []
 Top Hole El. []
 Boring Date []
 Penetration Boring
 No. of blows per foot (Using 28 lb. hammer with a 30" drop, or as noted)
 Description of material
 Unit weight (lb/cu ft)
 Date measured
 Consolidation test
 McKeeman-Terry air
 expansion test (1.5 psi. or as noted)
 Friction (lb/ft)
 Tip bearing (lb/sq ft)

TEST PIT
 B.No. [] Location []
 Top Hole El. []
 Boring Date []
 Penetration Boring
 No. of blows per foot (Using 28 lb. hammer with a 30" drop, or as noted)
 Description of material
 Unit weight (lb/cu ft)
 Date measured
 Consolidation test
 McKeeman-Terry air
 expansion test (1.5 psi. or as noted)
 Friction (lb/ft)
 Tip bearing (lb/sq ft)

JET BORING
 B.No. [] Location []
 Top Hole El. []
 Boring Date []
 Penetration Boring
 No. of blows per foot (Using 28 lb. hammer with a 30" drop, or as noted)
 Description of material
 Unit weight (lb/cu ft)
 Date measured
 Consolidation test
 McKeeman-Terry air
 expansion test (1.5 psi. or as noted)
 Friction (lb/ft)
 Tip bearing (lb/sq ft)

CONCRETE BORING
 B.No. [] Location []
 Top Hole El. []
 Boring Date []
 Penetration Boring
 No. of blows per foot (Using 28 lb. hammer with a 30" drop, or as noted)
 Description of material
 Unit weight (lb/cu ft)
 Date measured
 Consolidation test
 McKeeman-Terry air
 expansion test (1.5 psi. or as noted)
 Friction (lb/ft)
 Tip bearing (lb/sq ft)

LEGEND OF EARTH MATERIALS


GRAVEL	CLAYEY SILT
SAND	PEAT and/or ORGANIC MATTER
SILT	FILL MATERIAL
CLAY	IGNEOUS ROCK
SANDY CLAY or CLAYEY SAND	SEDIMENTARY ROCK
SANDY SILT or SILTY SAND	METAMORPHIC ROCK
SILTY CLAY	

CONSISTENCY CLASSIFICATION FOR SOILS

According to the Standard Penetration Test

Penetration Index (Blows / Ft)	Granular	Cohesive
0-4	Very loose	Very soft
5-9	Loose	Soft
10-19	Slightly compact	Stiff
20-34	Compact	Very stiff
35-69	Dense	Hard
>70	Very dense	Very hard

NOTE: Classification of earth material as shown on this sheet is based upon field inspection and is not to be construed to imply mechanical analysis.

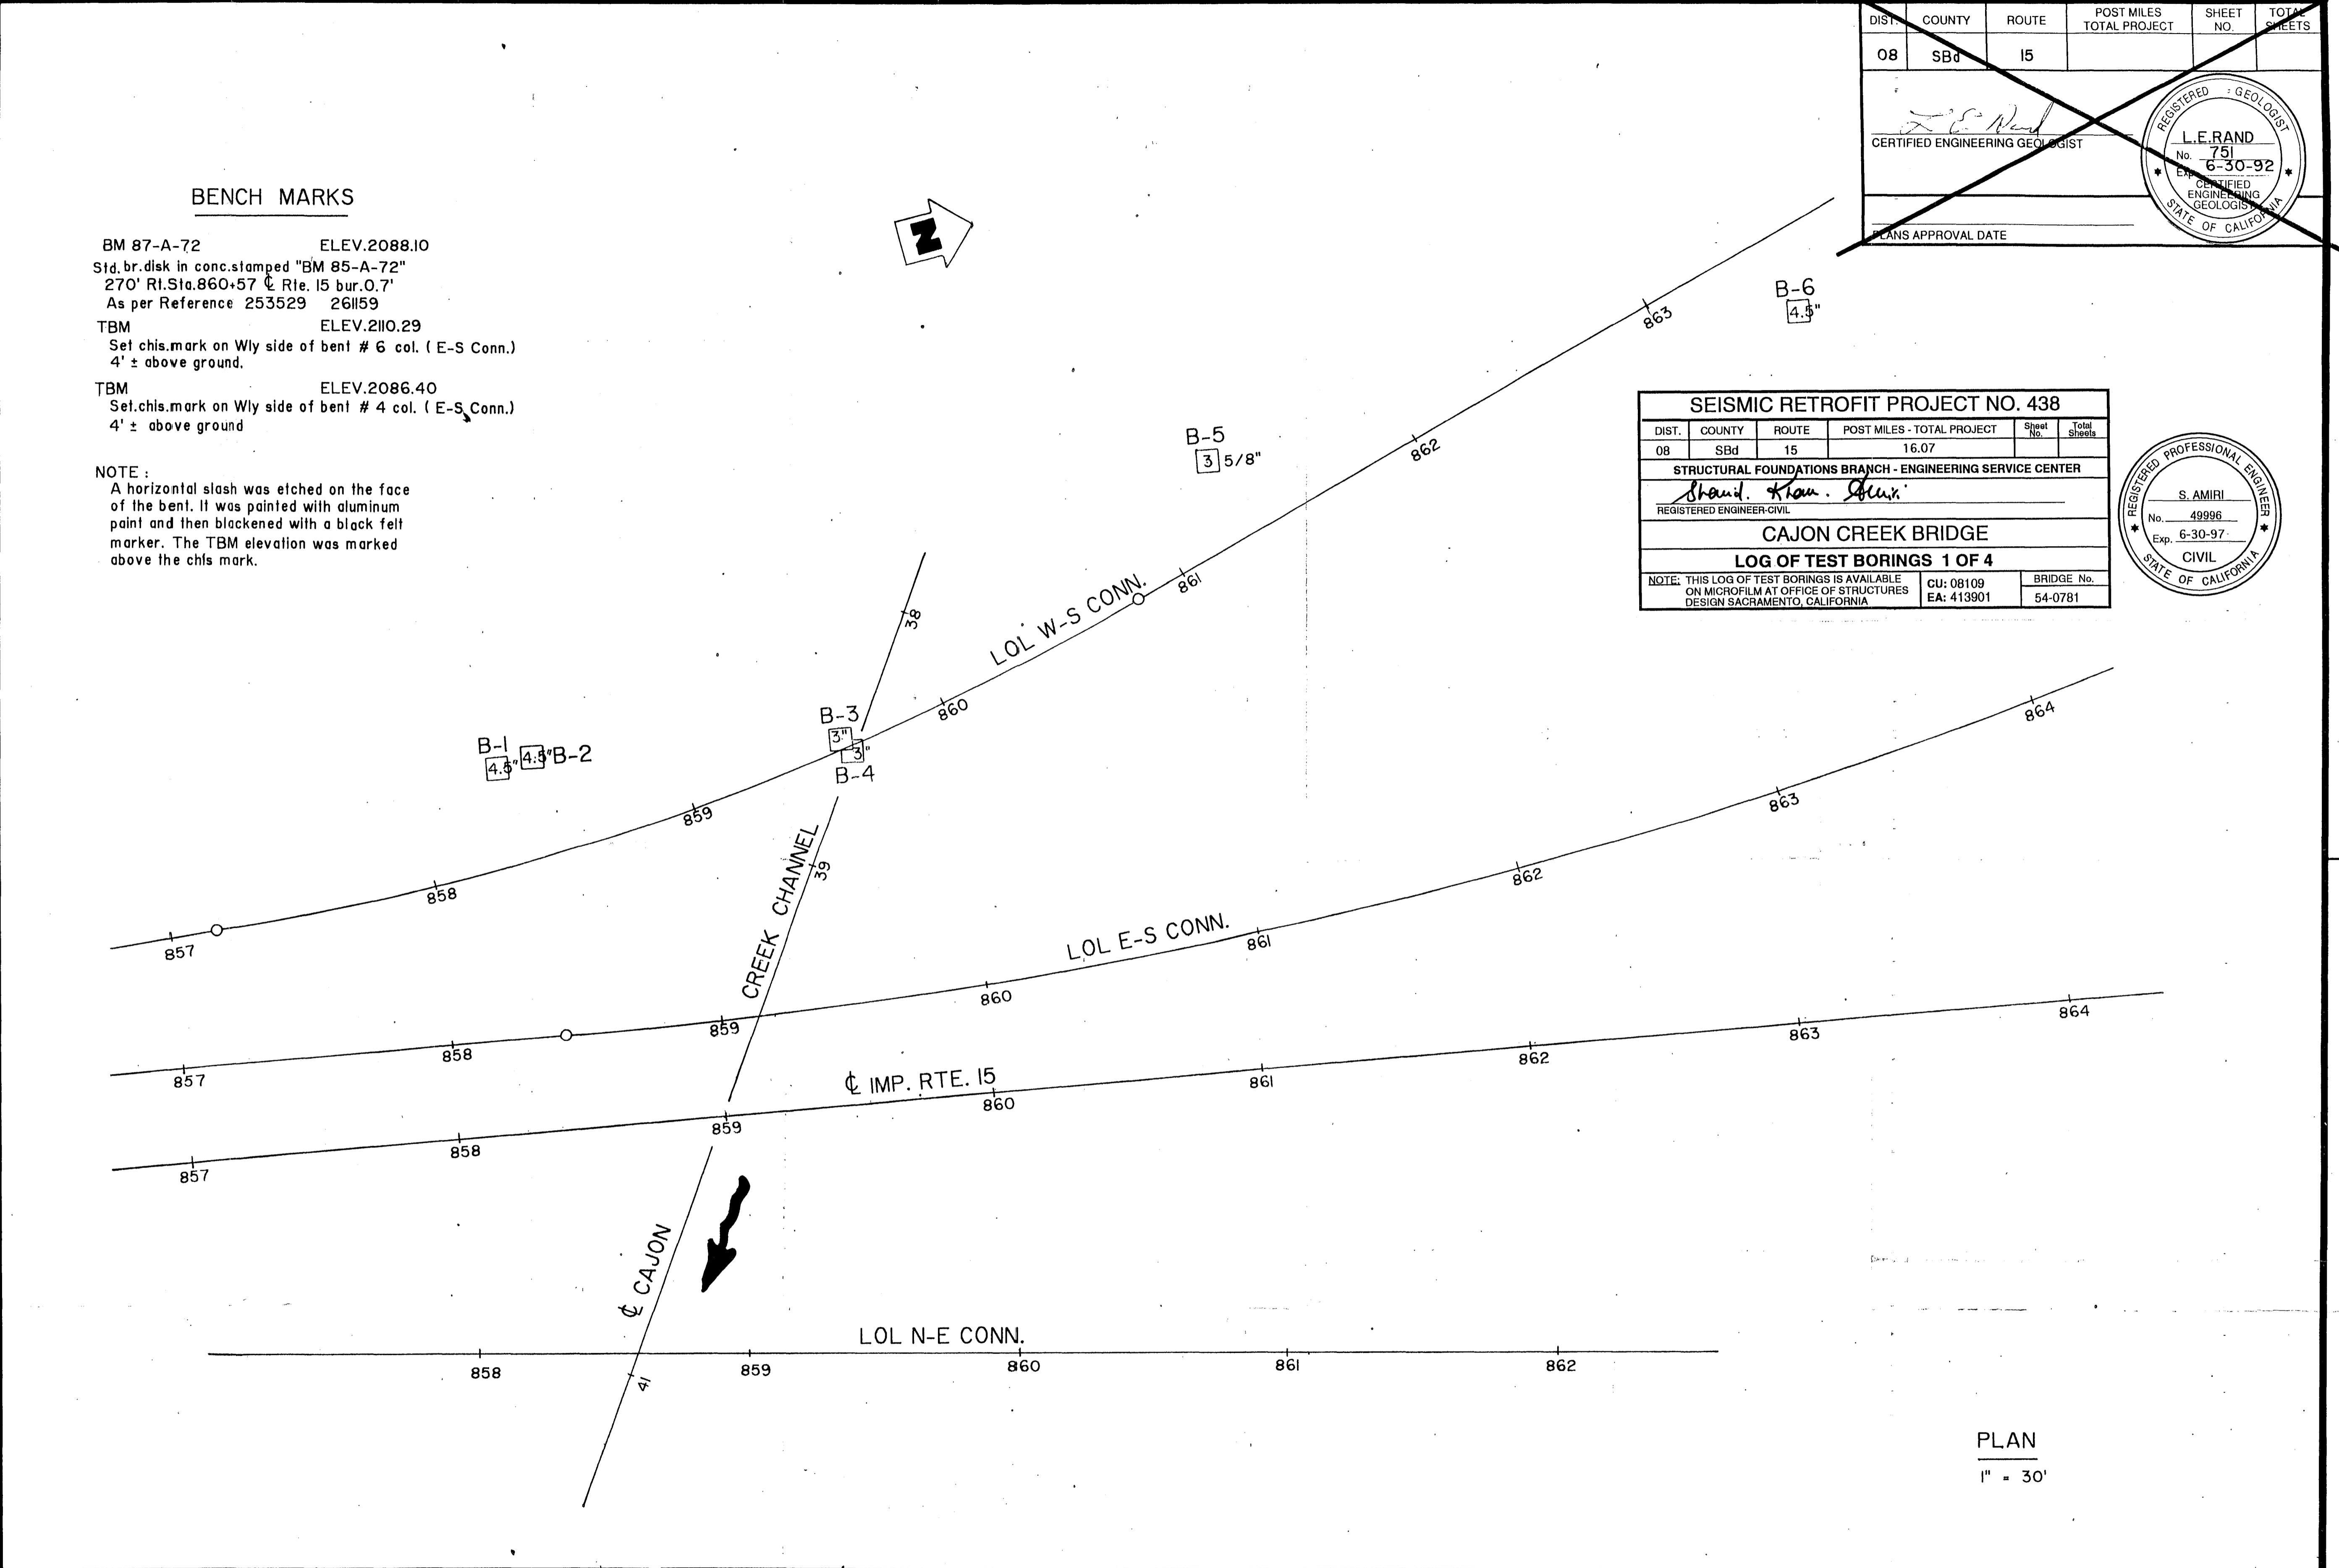

PLAN
 1" = 30'

OFFICE OF TRANSPORTATION MATERIALS & RESEARCH		ENGINEERING GEOLOGY BRANCH		BRIDGE NO. 54-0781RL		CAJON CREEK BRIDGE		JUN 25 1996	
DRAWN BY VICTOR SESTOKAS		2/91		POST MILE 16.07		LOG OF TEST BORINGS 1 OF 4		MAR 25 1991	
CHECKED BY Faramarz Geroni		3/91		CU 08203 EA 325801		DISREGARD PRINTS BEARING EARLIER REVISION DATES		REVISION DATES (PRELIMINARY STAGE ONLY)	

ORIGINAL SCALE IN INCHES FOR REDUCED PLANS: 0 1 2 3

N15 / S215 Separation

DIST	COUNTY	ROUTE	POST MILES TOTAL PROJECT	SHEET NO	TOTAL SHEETS
08	SBd	215			

K. Douglas Cook 10-12-11
 CERTIFIED ENGINEERING GEOLOGIST

PLANS APPROVAL DATE _____

The State of California or its officers or agents shall not be responsible for the accuracy or completeness of electronic copies of this plan sheet.

PROFESSIONAL GEOLOGIST
 K. Douglas Cook
 No. 1391
 Exp. 12-31-11
 CERTIFIED ENGINEERING GEOLOGIST
 STATE OF CALIFORNIA


This LOTB sheet was prepared in accordance with the Caltrans Soil & Rock Logging, Classification, & Presentation Manual (2010 Edition).

Note: No ground water encountered during field investigation.

BENCH MARK

PNO 173 2120.910
 FD STD Brass disk in concrete stamped "SBD-215-173 1988" 40' Ely of EOD Devore Rd Bridge at Nly end bridge; 70' Nly of EP NB SBD 215 at PM 17.3 at top of slope.

PNO 2010 2179.090
 FD STD Brass disk in concrete stamped "D8 SCN SBD-15 PM 16.3 08.04.08" At top of slope SOUTH of Connector Bridge from NB SBD 15 to NB SBD 215.

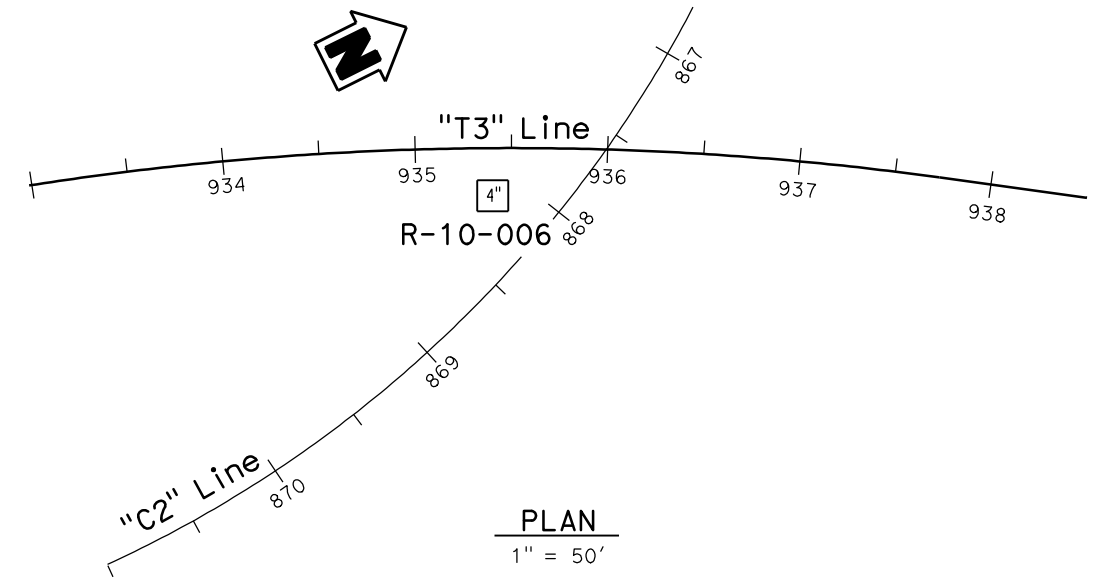

PLAN
1" = 50'

2130	2130.3'	4"	Well-graded SAND with GRAVEL (SW); very dense; moist; light gray; some subangular well-graded GRAVEL.	2130
2120	80 ft. 4		-becomes yellowish brown.	2120
2110	120 ft. 4		-5-10% COBBLES (3-6"); of hard subrounded Granitics and soft Metamorphics (Gneiss, Schist).	2110
2100	100 ft. 4		-yellowish light gray; well-graded GRAVELS.	2100
2090	80 ft. 4			2090
2080	REF ft. 4			2080
2070	REF ft. 4			2070
2060	REF ft. 4			2060
2050	REF ft. 4			2050
2040				2040
2030				2030

12-7-10
 Terminated at Elev 2030.3'
 Eri = 68%

PROFILE
 Horiz: 1" = 10'
 Vert: 1" = 10'

ENGINEERING SERVICES		MATERIALS AND GEOTECHNICAL SERVICES		STATE OF CALIFORNIA		DIVISION OF ENGINEERING SERVICES		BRIDGE NO.		W-S CONNECTOR UC (WIDEN)	
FUNCTIONAL SUPERVISOR		DRAWN BY: W. Tang 06/11		FIELD INVESTIGATION BY:		DEPARTMENT OF TRANSPORTATION		STRUCTURE DESIGN		NEW	
NAME: A. Perez-Cobo		CHECKED BY: B. Levine/S. Logeswaran		D. Cook		DESIGN BRANCH X		POST MILE		LOG OF TEST BORINGS 1 OF 5	
08S CIVIL LOG OF TEST BORINGS SHEET		ORIGINAL SCALE IN INCHES FOR REDUCED PLANS		0 1 2 3		UNIT: 3643		PROJECT NUMBER & PHASE: 08000003661		CONTRACT NO.: 08-0K7100	
						DISREGARD PRINTS BEARING EARLIER REVISION DATES		REVISION DATES		SHEET OF	
								09-07-11		X X	

FILE => wsconn-uc-widen1of 5.dgn

USERNAME => s128198 DATE PLOTTED => 21-OCT-2011 TIME PLOTTED => 12:55


FED. ROAD DIV. NO.	STATE	F. A. PROJECT NO.	SHEET NO.	TOTAL SHEETS
7	CALIF.			

DIST.	COUNTY	ROUTE	SECTION	SHEET NO.	TOTAL SHEETS
08	SBd	15	14/14	318	398

DATE APPROVED: November 28, 1966

DESIGN PILE LOADING: 45T
 PILE TYPE: 10 BP42
 DIAMETER: TIP BUTT
 TOTAL NO. PILES: 60
 LINEAL FT. PILES, PLANS: 1980
 LINEAL FT. PILES, "AS BUILT": 1723.7
 HAMMER: Vulcan 50C


BENCH MARK
 BM #P. 62 P. 18 Elev. 2145.385
 Type "B" man. in med. 714' Rt. 39+
 72.89 P.O.C. 2 Imp. Rt. 15
 N. 264, 283, 869 E 178, 911, 383

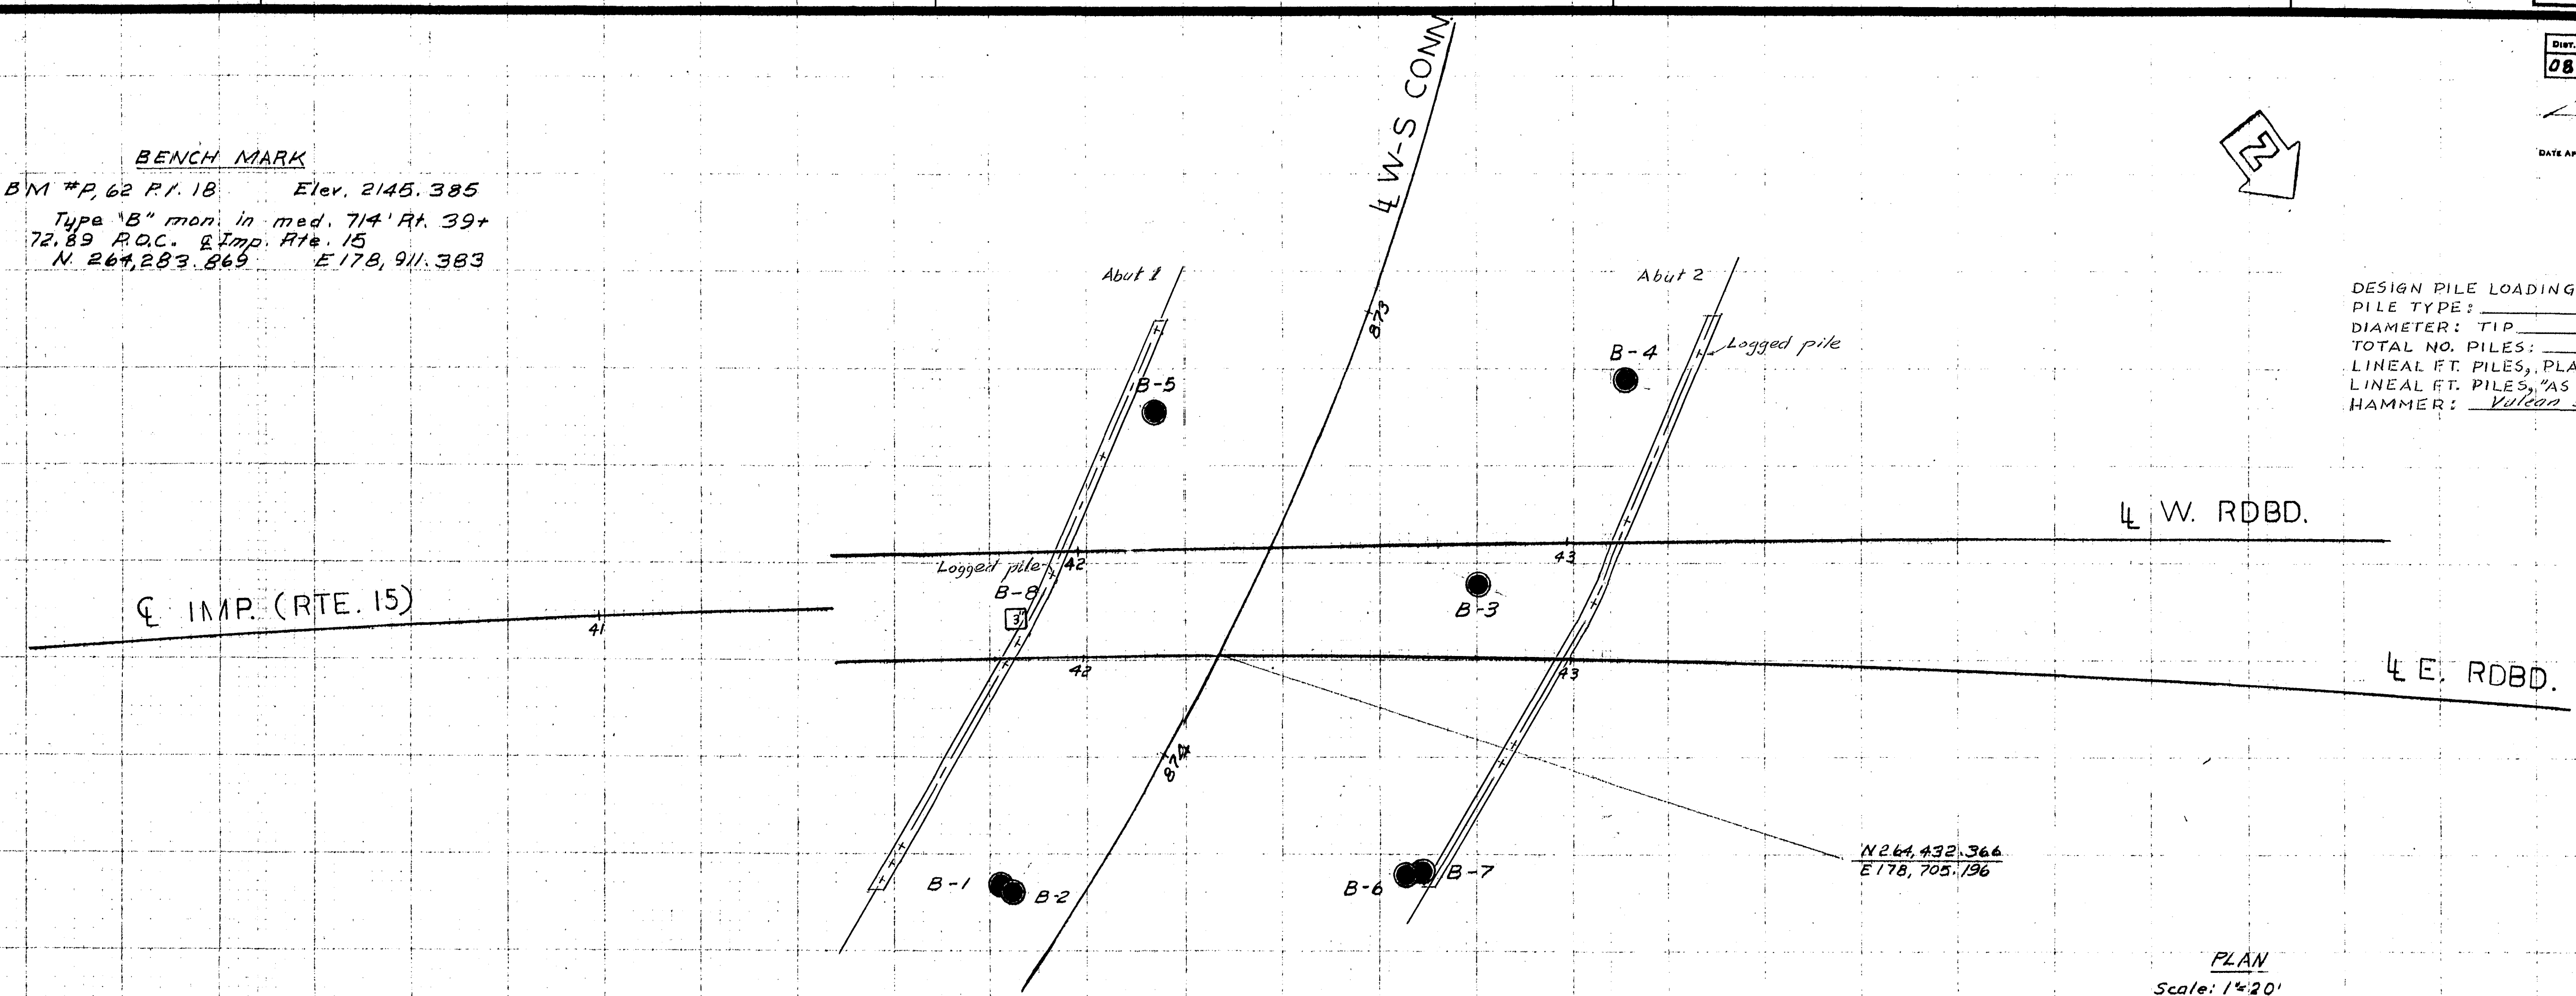

PLAN
Scale: 1"=20'

Note: Boring B-8 shown hereon is Boring B-2 on LTB for Br. No. 54-783


AS BUILT
 CORRECTIONS BY J. Whelan
 CONTRACT NO. 08049114
 DATE 8-20-68

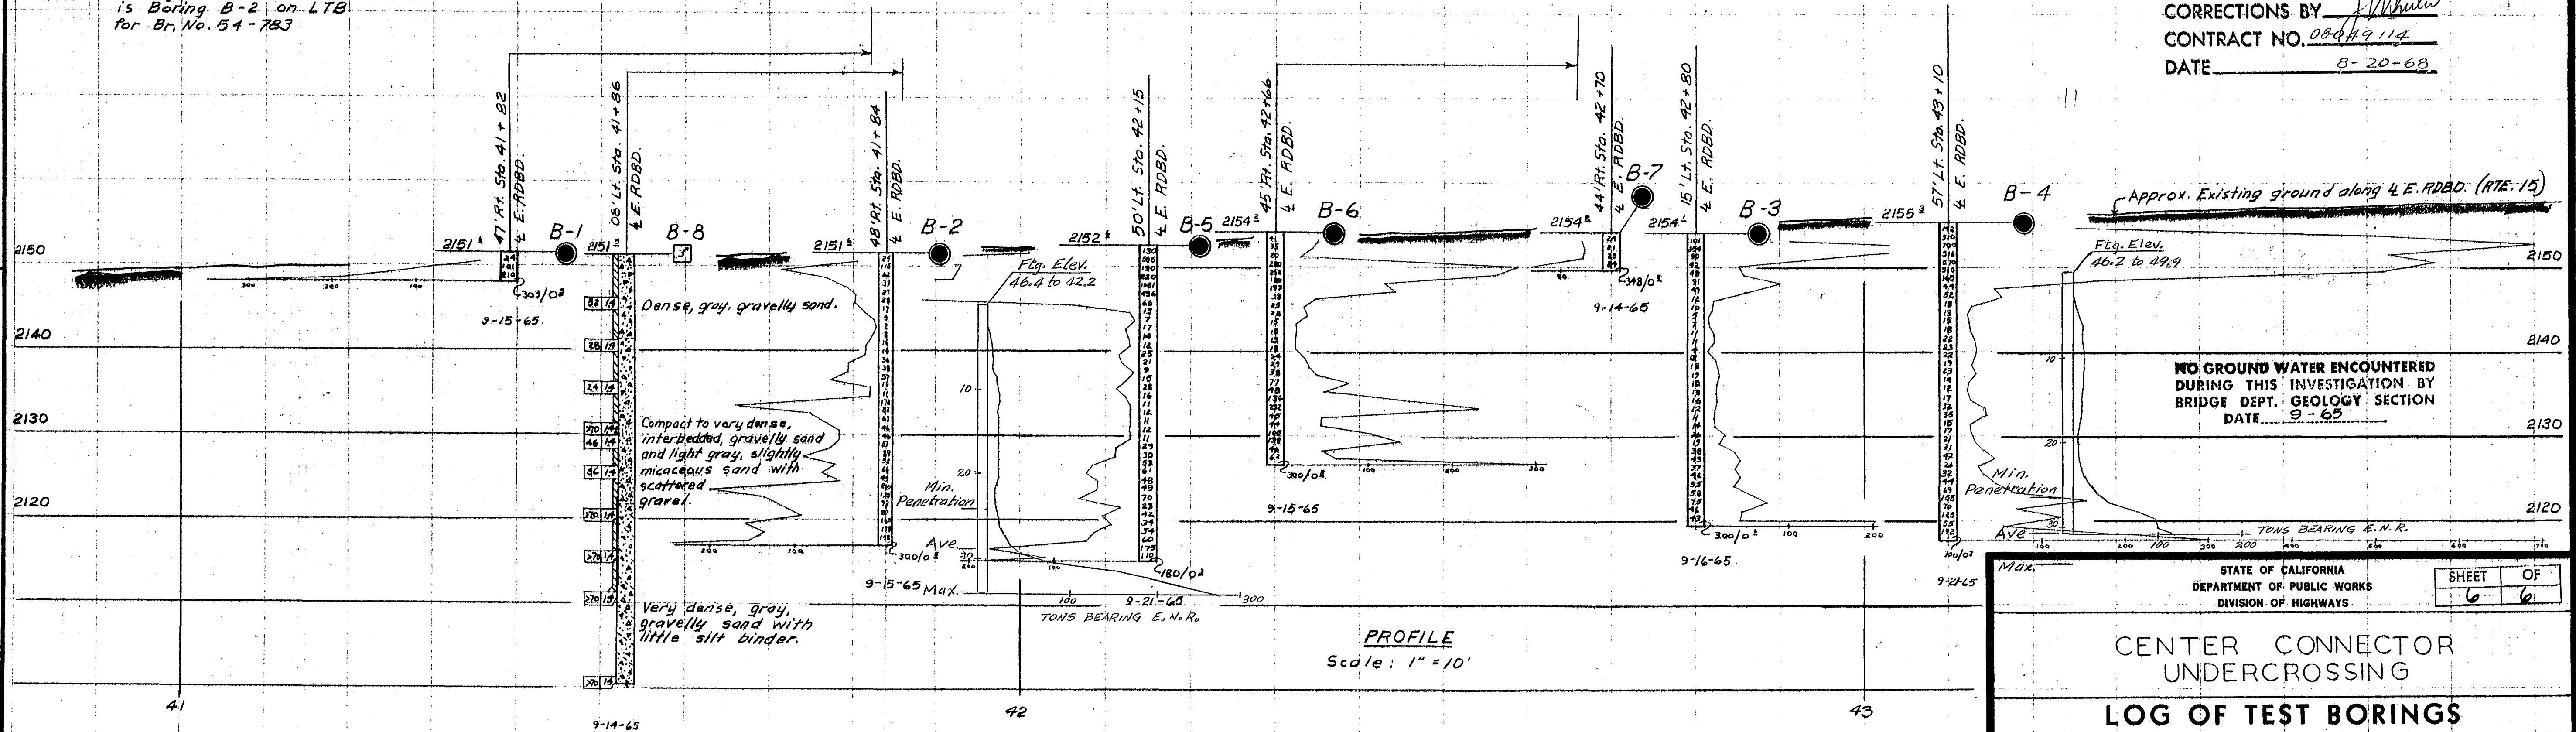

PROFILE
Scale: 1"=10'

FIELD STUDY	BY O. MILES	9-21-65
DRAWN	BY G. BOTLE	11-4-65
CHECKED	BY C. M. W. R. S.	11-15-65

BRIDGE DEPARTMENT
ENGINEERING GEOLOGY SECTION

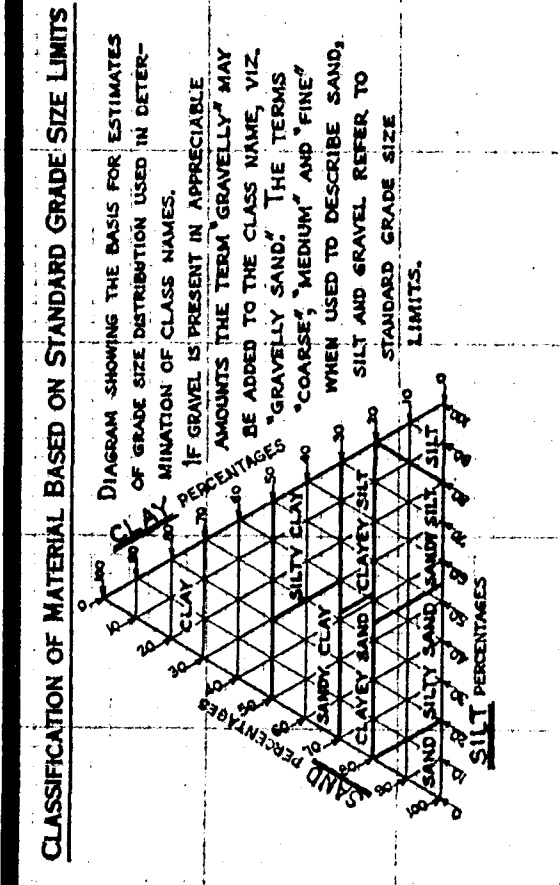

NOTE: Classification of earth material as shown on this sheet is based upon field inspection and is not to be construed to imply mechanical analysis.

STATE OF CALIFORNIA
DEPARTMENT OF PUBLIC WORKS
DIVISION OF HIGHWAYS

CENTER CONNECTOR UNDERCROSSING
LOG OF TEST BORINGS

SCALE As Noted BRIDGE 54-771 R/L PM 13.8 DRAWING 54771-6

SHEET 6 OF 6

PREL. DRAWING NO. PR- []

318

Charge: 08203
WA: 049111

Disregard prints bearing earlier numbers

DIST	COUNTY	ROUTE	POST MILES TOTAL PROJECT	SHEET NO	TOTAL SHEETS
08	SBd	15			

K. Douglas Cook 10-12-11
 CERTIFIED ENGINEERING GEOLOGIST
 PROFESSIONAL GEOLOGIST
 No. 1391
 Exp. 12-31-11
 CERTIFIED ENGINEERING GEOLOGIST
 STATE OF CALIFORNIA

PLANS APPROVAL DATE _____


The State of California or its officers or agents shall not be responsible for the accuracy or completeness of electronic copies of this plan sheet.

This LOTB sheet was prepared in accordance with the Caltrans Soil & Rock Logging, Classification, & Presentation Manual (2010 Edition).


BENCH MARK

PNO 173 2120.910
 FD STD Brass disk in concrete stamped "SBD-215-173 1988" 40' Ely of EOD Devore Rd Bridge at Nly end bridge; 70' Nly of EP NB SBD 215 at PM 17.3 at top of slope.

PNO 2010 2179.090
 FD STD Brass disk in concrete stamped "D8 SCN SBD-15 PM 16.3 08.04.08" At top of slope SOUTH of Connector Bridge from NB SBD 15 to NB SBD 215.

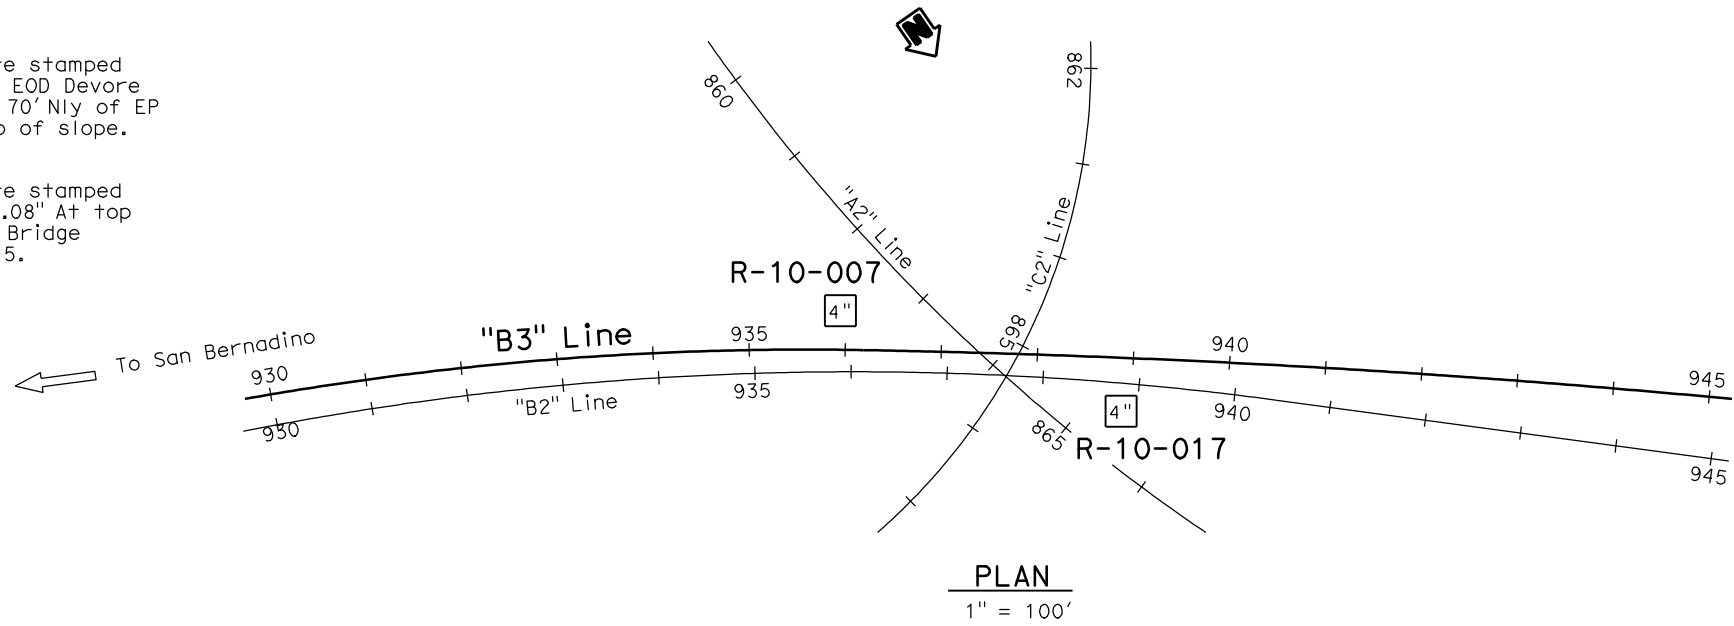

Note: No ground water encountered at the time of field investigation.

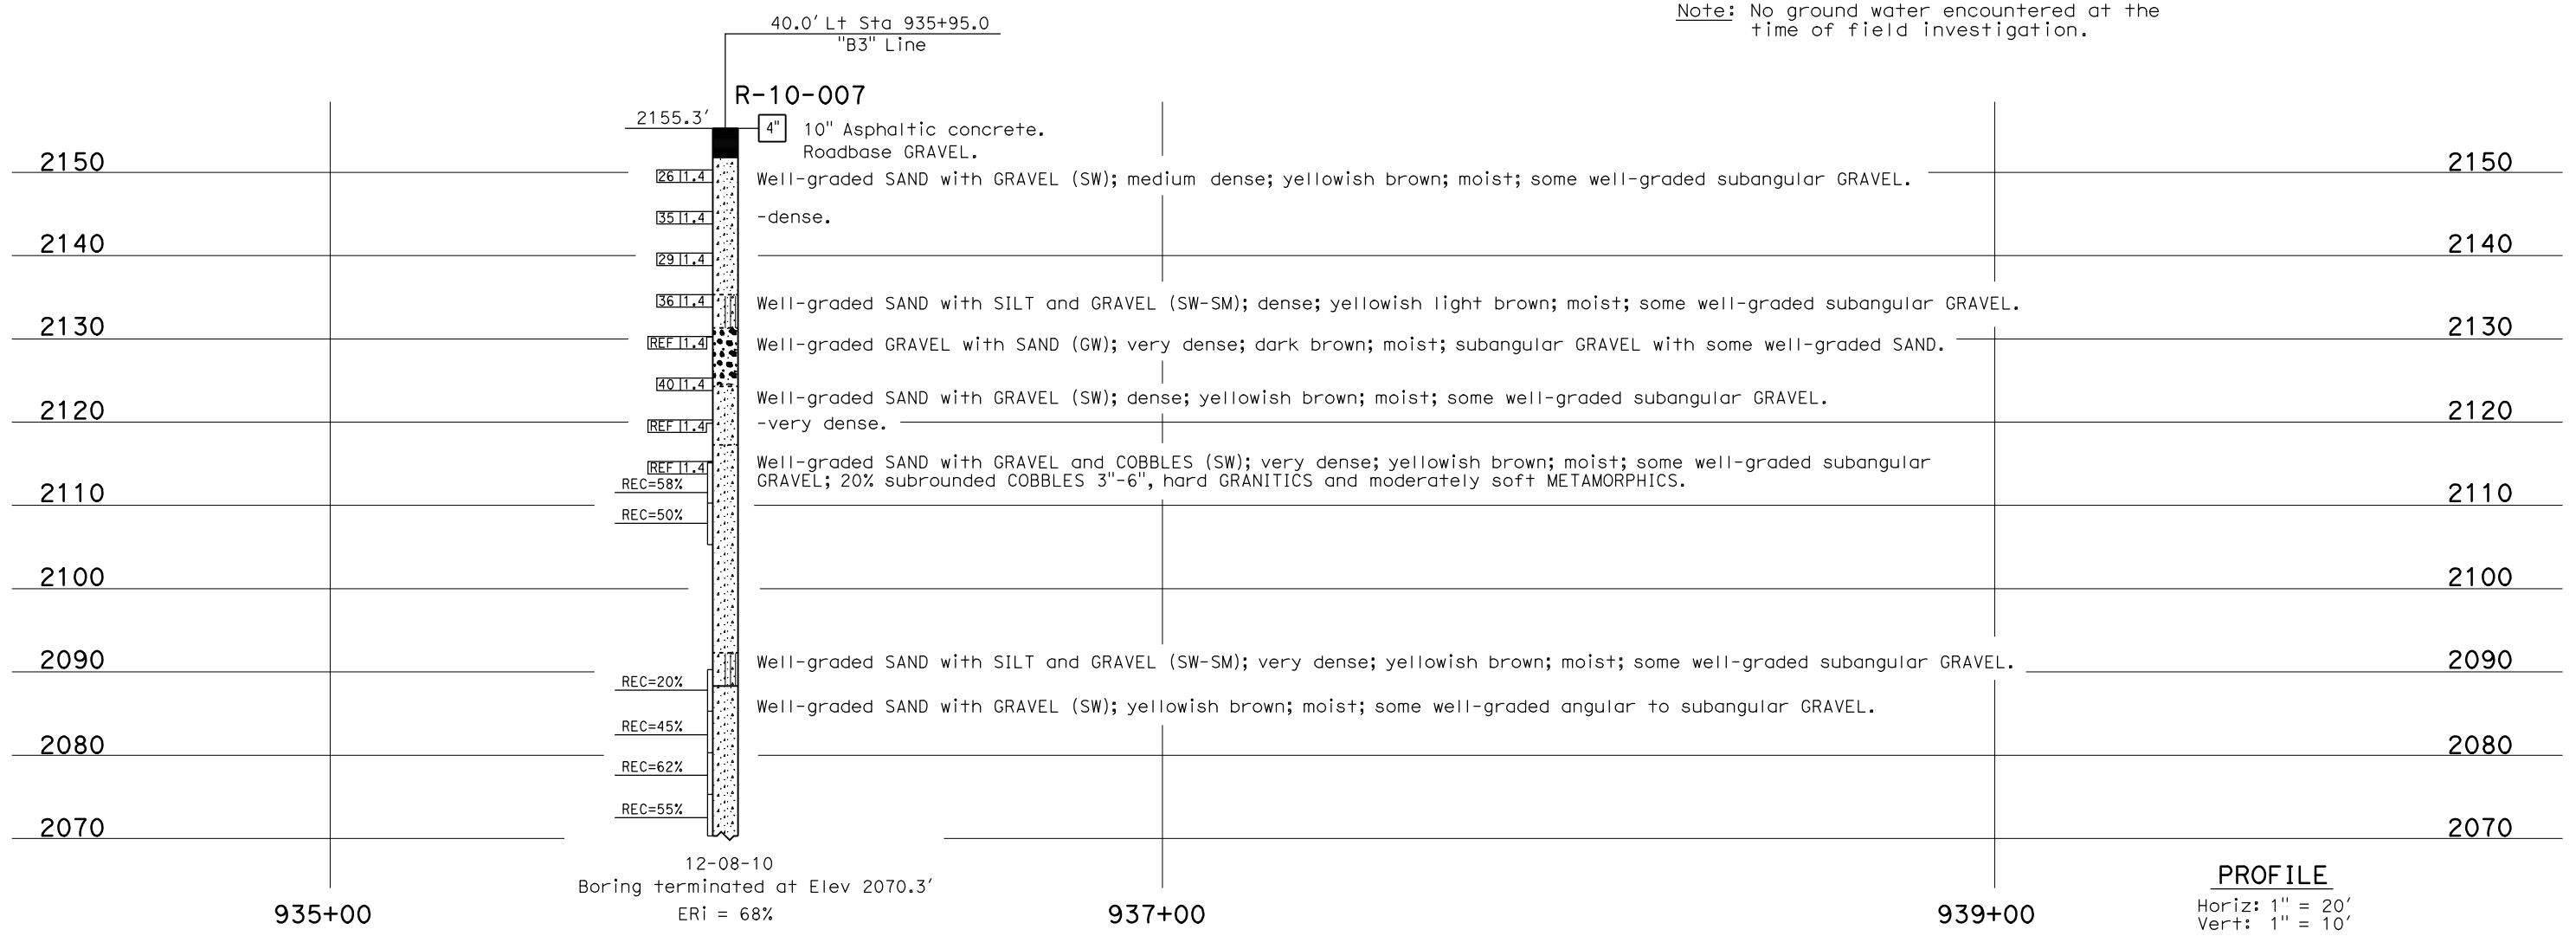

PROFILE

Horiz: 1" = 20'
 Vert: 1" = 10'

ENGINEERING SERVICES		MATERIALS AND GEOTECHNICAL SERVICES		STATE OF CALIFORNIA DEPARTMENT OF TRANSPORTATION		DIVISION OF ENGINEERING SERVICES STRUCTURE DESIGN DESIGN BRANCH X		BRIDGE NO. 54-0783R POST MILE 17.32		15/215 SEPARATION (WIDEN) LOG OF TEST BORINGS 1 OF 6	
FUNCTIONAL SUPERVISOR NAME: A. Perez-Cobo	DRAWN BY: F. Nguyen 6/11 CHECKED BY: B. Levine/S. Logeswaran	FIELD INVESTIGATION BY: D. Cook		UNIT: 3643 PROJECT NUMBER & PHASE: 08000003660		CONTRACT NO.: 08-OK7100		DISREGARD PRINTS BEARING EARLIER REVISION DATES		REVISION DATES 09-21-11 10-03-11	
OGS CIVIL LOG OF TEST BORINGS SHEET										ORIGINAL SCALE IN INCHES FOR REDUCED PLANS	
										FILE => 15-215sep1of6.dgn	

USERNAME => s128198 DATE PLOTTED => 21-OCT-2011 TIME PLOTTED => 12:36

DIST	COUNTY	ROUTE	POST MILES TOTAL PROJECT	SHEET NO	TOTAL SHEETS
08	SBd	15			

K. Douglas Cook 10-12-11
 CERTIFIED ENGINEERING GEOLOGIST

PLANS APPROVAL DATE

The State of California or its officers or agents shall not be responsible for the accuracy or completeness of electronic copies of this plan sheet.

This LOTB sheet was prepared in accordance with the Caltrans Soil & Rock Logging, Classification, & Presentation Manual (2010 Edition).

FOR PLAN VIEW, SEE
 "LOG OF TEST BORINGS 1 OF 6"

Note: No ground water encountered at the time of field investigation.

56.0' Rt Sta 938+90.0
 "B3" Line

R-10-017

4"

2160	2161.6'	Well-graded SAND with SILT and GRAVEL (SW-SM); medium dense; yellowish light brown; moist; some subangular fine GRAVEL.	2160
2150	1811.4		2150
2140	1911.4	Well-graded GRAVEL with SAND and COBBLES (GW); dense; yellowish brown; moist; mostly well-graded subangular GRAVEL; some well-graded SAND; 10% subrounded COBBLES 3"-6" GRANITICS and METAMORPHICS; hard.	2140
2130	4111.4		2130
2120	2011.4	Well-graded SAND with GRAVEL and COBBLES (SW); medium dense; yellowish light brown; moist; some well-graded subangular GRAVEL.	2120
2110	3411.4	-little fine subangular GRAVEL.	2110
2100	6211.4	-very dense; some well-graded subangular GRAVEL.	2100
2090	REF 11.4		2090
2080	REF 11.4	Well-graded GRAVEL with SAND and COBBLES (GW); very dense; yellowish brown; some well-graded SAND; 15% COBBLES 3"-8" subrounded; hard GRANITICS and METAMORPHICS.	2080
2070	REF 11.4		2070
2060	REF 11.4	Well-graded SAND with GRAVEL (SW); very dense; yellowish light brown; moist; little well-graded subangular GRAVEL.	2060
2050	REF 11.4		2050
2040			2040
2030			2030
2020			2020
2010			2010
2000			2000

12-08-10
 Boring terminated at Elev 2001.6'
 ERI = 68%

938+00

940+00

942+00

PROFILE
 Horiz: 1" = 20'
 Vert: 1" = 10'

ENGINEERING SERVICES		MATERIALS AND GEOTECHNICAL SERVICES		STATE OF CALIFORNIA		DIVISION OF ENGINEERING SERVICES		BRIDGE NO.		15/215 SEPARATION (WIDEN)	
FUNCTIONAL SUPERVISOR		DRAWN BY: F. Nguyen 6/11		FIELD INVESTIGATION BY:		STRUCTURE DESIGN		54-0783R		LOG OF TEST BORINGS 2 OF 6	
NAME: A. Perez-Cobo		CHECKED BY: B. Levine/S. Logeswaran		D. Cook		DESIGN BRANCH X		POST MILE			
08S CIVIL LOG OF TEST BORINGS SHEET		ORIGINAL SCALE IN INCHES FOR REDUCED PLANS		0 1 2 3		UNIT: 3643		PROJECT NUMBER & PHASE: 08000003660		CONTRACT NO.: 08-0K7100	
						DISREGARD PRINTS BEARING EARLIER REVISION DATES		REVISION DATES		SHEET OF	
								09-21-11 10-03-11		X X	

FILE => 15-215sep2of6.dgn

DATE PLOTTED => 21-OCT-2011 USERNAME => s128198

LEGEND OF BORING OPERATIONS

PENETRATION BORING
 ROTARY BORING
 JET BORING
 CONE BORING
 TEST PIT

SOIL TUBE
 SOIL SAMPLE


LEGEND OF EARTH MATERIALS

SILTY CLAY OR CLAYEY SILT
 SILT
 SAND
 GRAVEL
 FILL MATERIAL
 ORGANIC MATTER
 INGENOUS ROCK
 SEDIMENTARY ROCK
 METAMORPHIC ROCK


CLASSIFICATION OF MATERIAL BASED ON STANDARD GRADE SIZE LIMITS

Diagram showing the basis and estimates of grade size distribution used in determining classification of materials.


NOTE: Classification of earth material as shown on this sheet is based upon field inspection and is not to be construed to imply mechanical analysis.

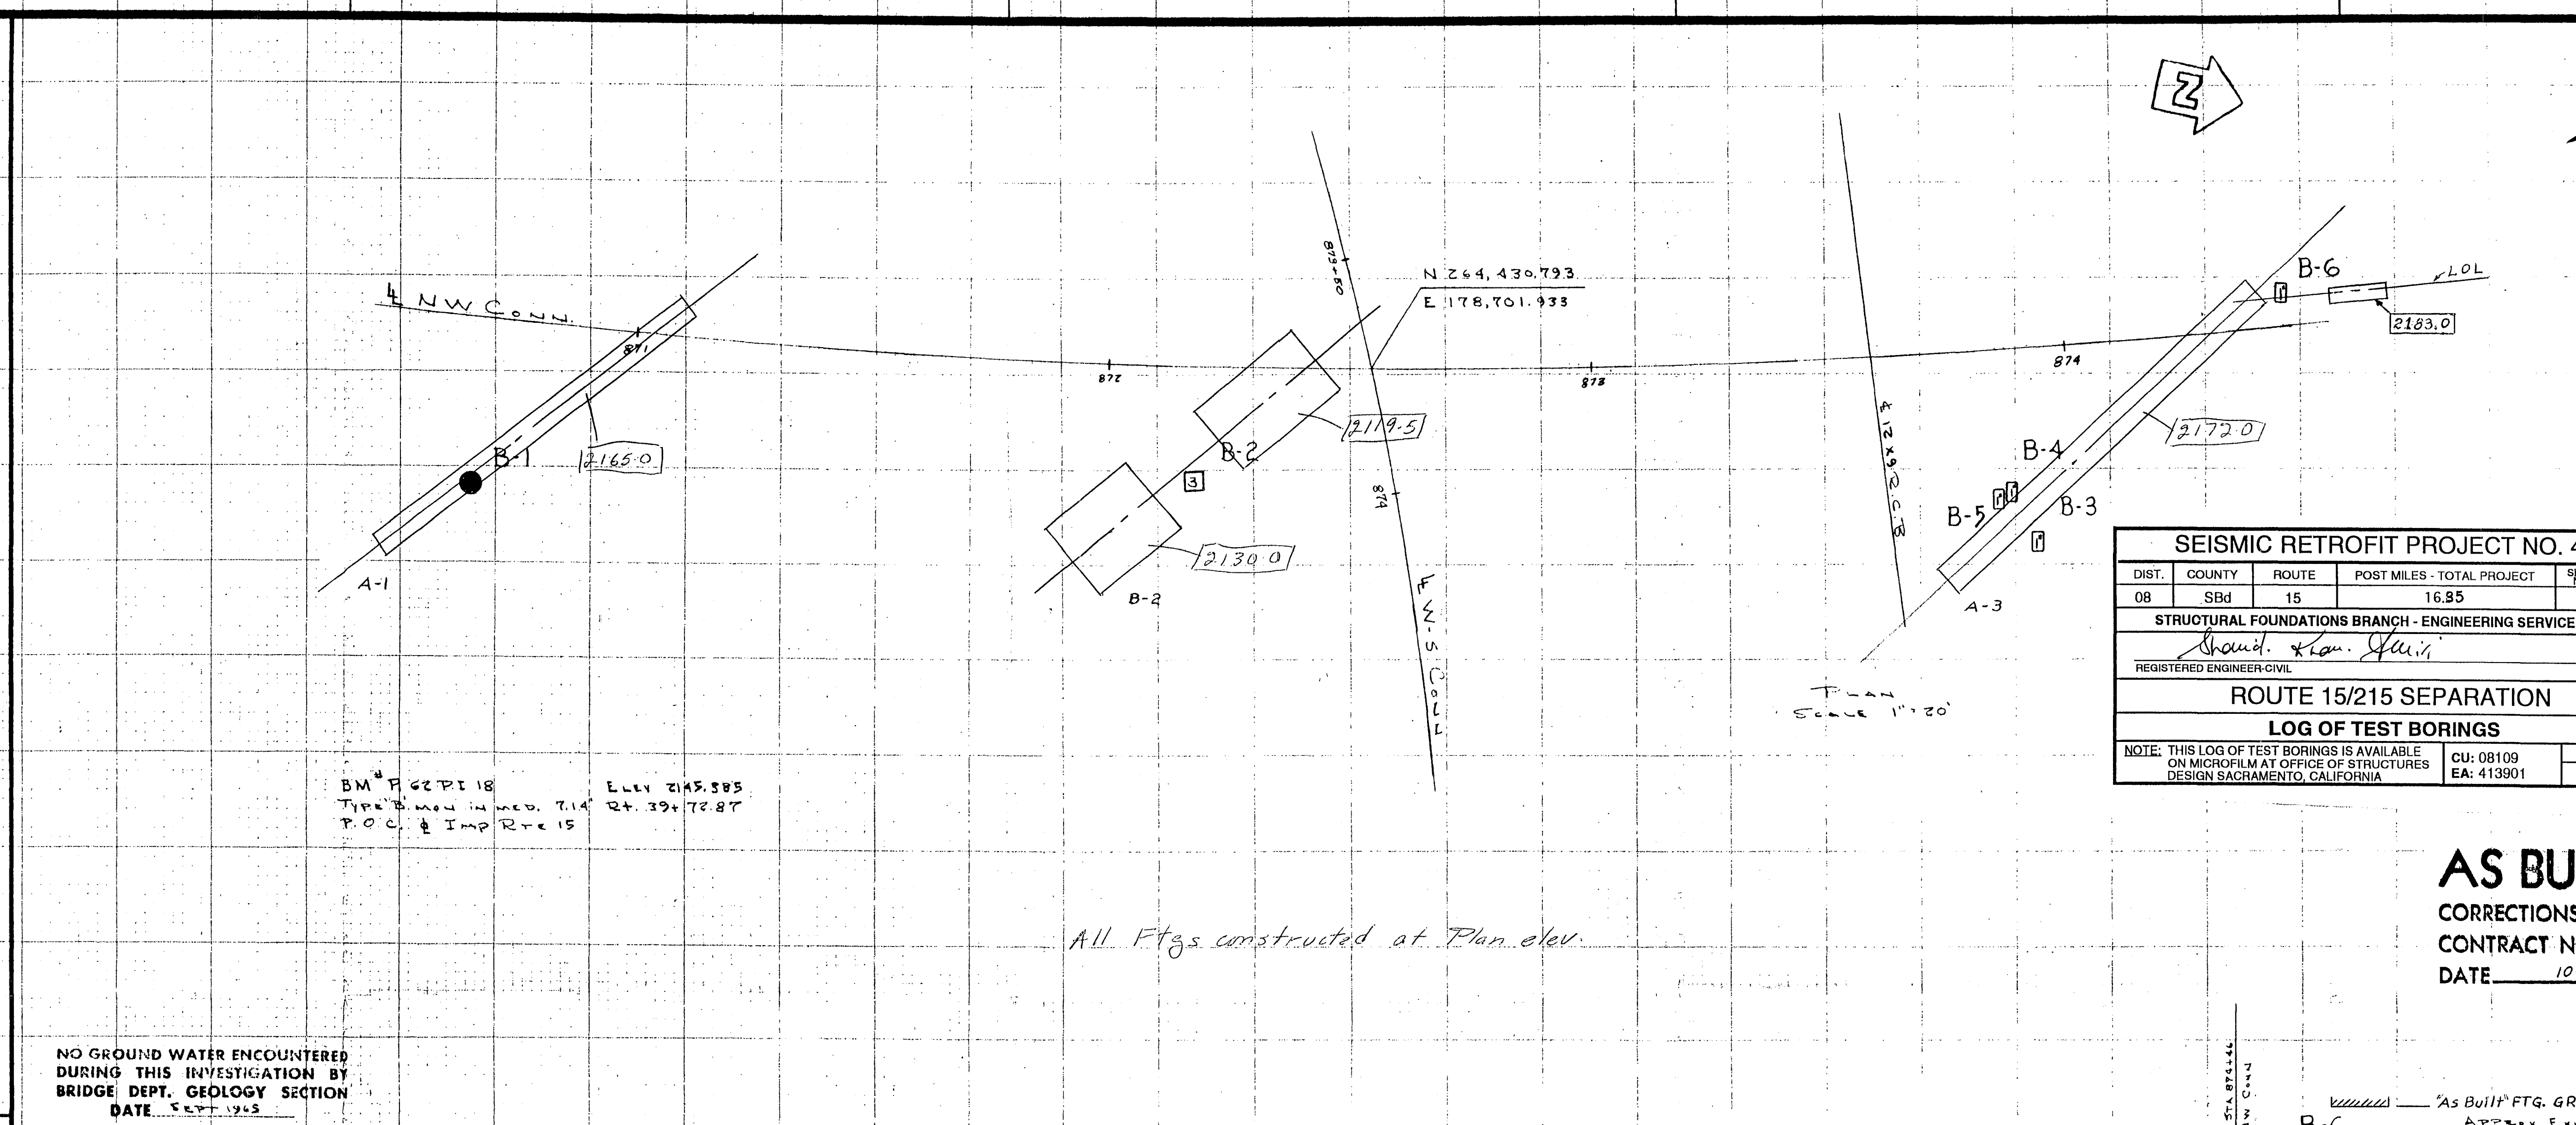

SEISMIC RETROFIT PROJECT NO. 438					
DIST.	COUNTY	ROUTE	POST MILES - TOTAL PROJECT	Sheet No.	Total Sheets
08	SBD	15	16.95		
STRUCTURAL FOUNDATIONS BRANCH - ENGINEERING SERVICE CENTER					
S. AMIRI REGISTERED ENGINEER-CIVIL					
ROUTE 15/215 SEPARATION					
LOG OF TEST BORINGS					
NOTE: THIS LOG OF TEST BORINGS IS AVAILABLE ON MICROFILM AT OFFICE OF STRUCTURES DESIGN SACRAMENTO, CALIFORNIA			CU: 08109 EA: 413901	BRIDGE No. 54-783	

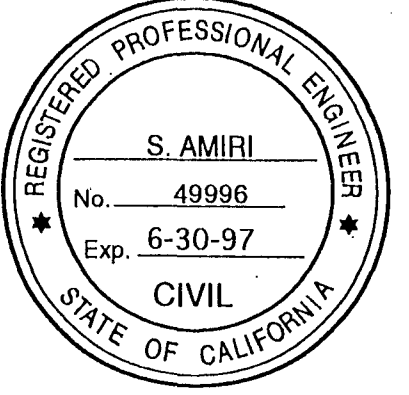

AS BUILT
 CORRECTIONS BY *J. Whalen*
 CONTRACT NO. 08-049114
 DATE 10-14-68

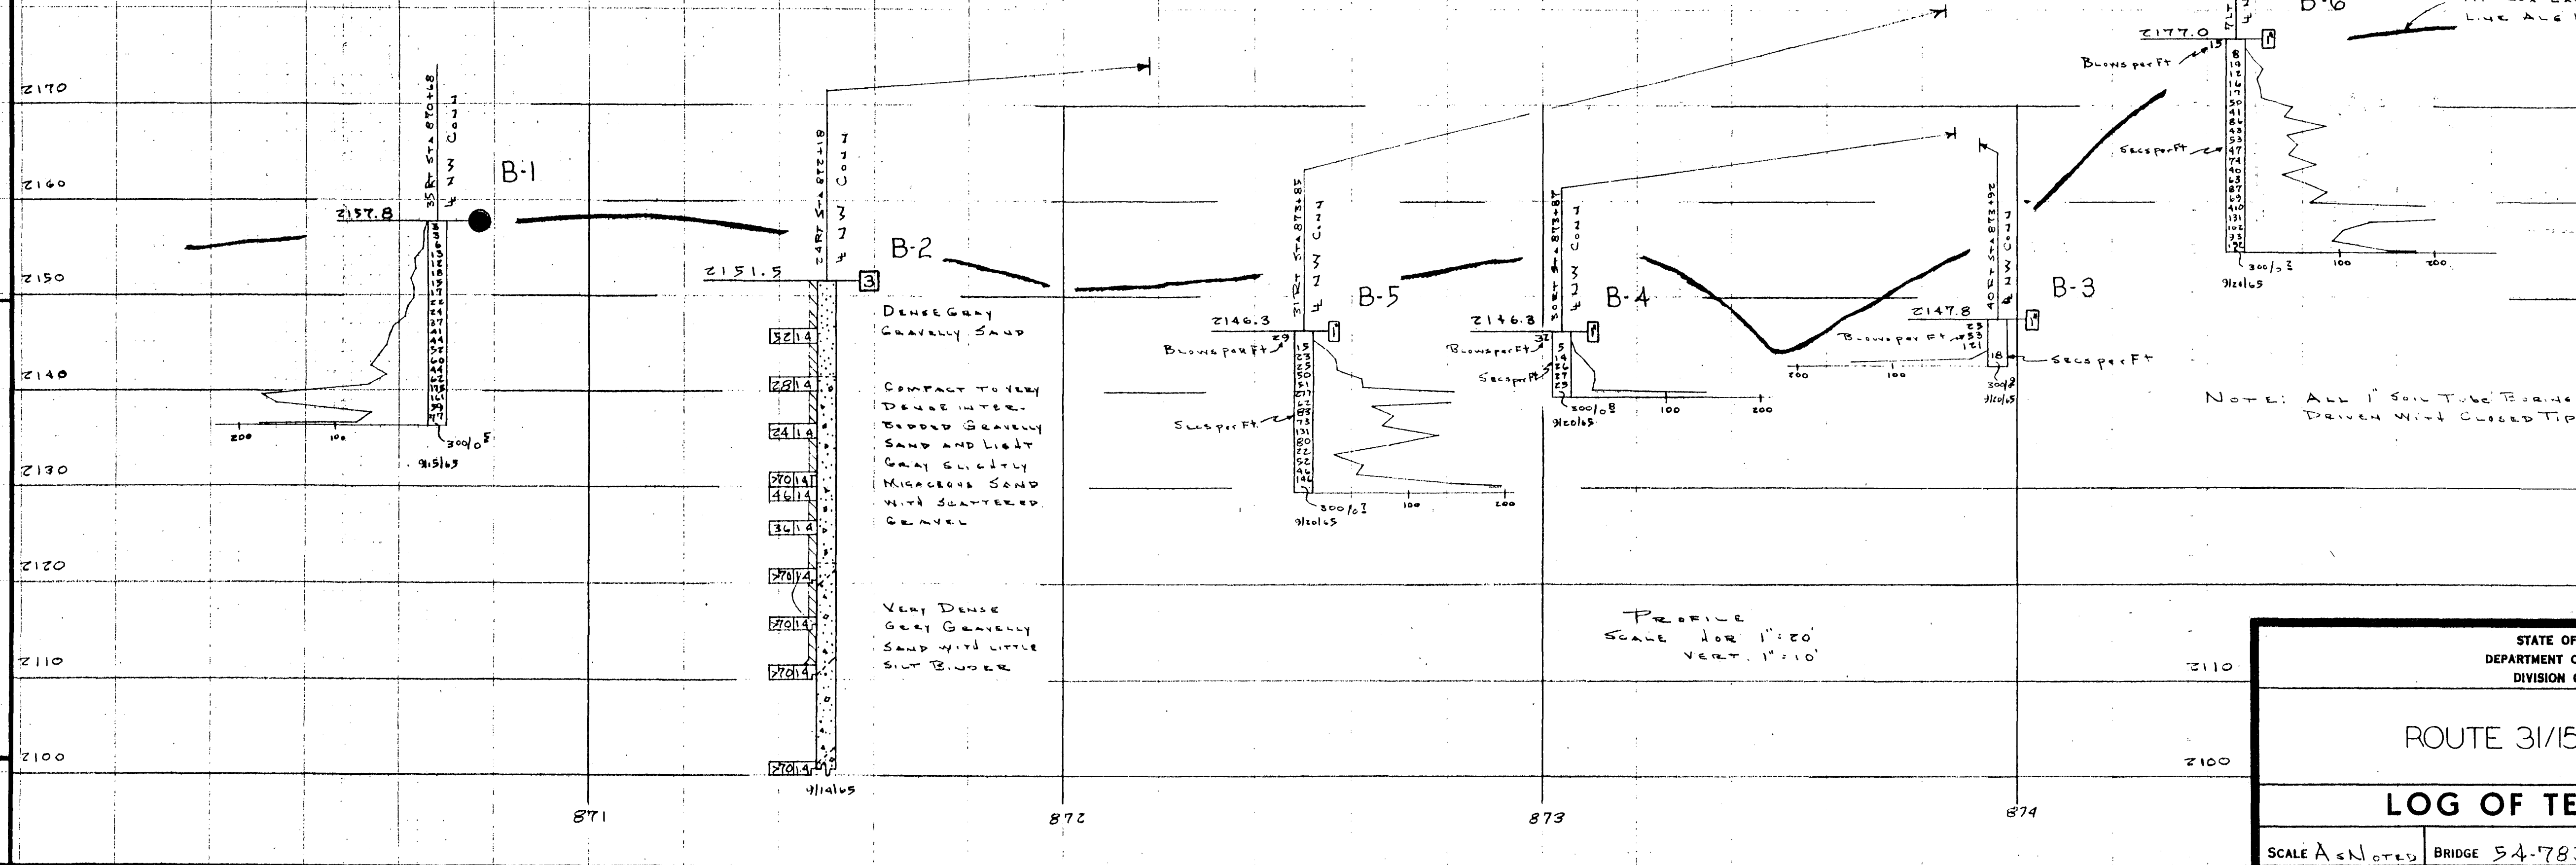

STATE OF CALIFORNIA DEPARTMENT OF PUBLIC WORKS DIVISION OF HIGHWAYS		SHEET	OF
ROUTE 31/15 SEPARATION		7	7
JUN 25 1966			
LOG OF TEST BORINGS			
SCALE A=NOTED	BRIDGE 54-783	PM 16.7	DRAWING 54783-7

BRIDGE DEPARTMENT
ENGINEERING GEOLOGY SECTION

302

Kenwood Avenue



DIST	COUNTY	ROUTE	KILOMETER POST TOTAL PROJECT	SHEET No	TOTAL SHEETS
08	SBd	15			

Hassan Ibrahim REGISTERED CIVIL ENGINEER 7-5-05	
PLANS APPROVAL DATE	

The State of California or its officers or agents shall not be responsible for the accuracy or completeness of electronic copies of this plan sheet.

FOR PLAN VIEW, SEE "LOG OF TEST BORINGS" 1 OF 2

LEGEND OF BORING OPERATIONS


LEGEND OF EARTH MATERIALS

GRAVEL	CLAYEY SILT
SAND	REAL and/or ORGANIC MATTER
SILT	BOULDERS
CLAY	UNCONSOLIDATED ROCK
SANDY CLAY or CLAYEY SAND	SEDIMENTARY ROCK
SANDY SILT or SILTY SAND	METAMORPHIC ROCK
SILTY CLAY	

CONSISTENCY CLASSIFICATION FOR SOILS

Standard Penetration Test (Blows/30cm)	Consistency
0-4	Very Loose
5-10	Loose
11-20	Medium Dense
21-30	Dense
31-50	Very Dense
50	Hard

NOTE: Classification of earth material as shown on this sheet is based upon field inspection and is not to be construed to imply mechanical analysis.

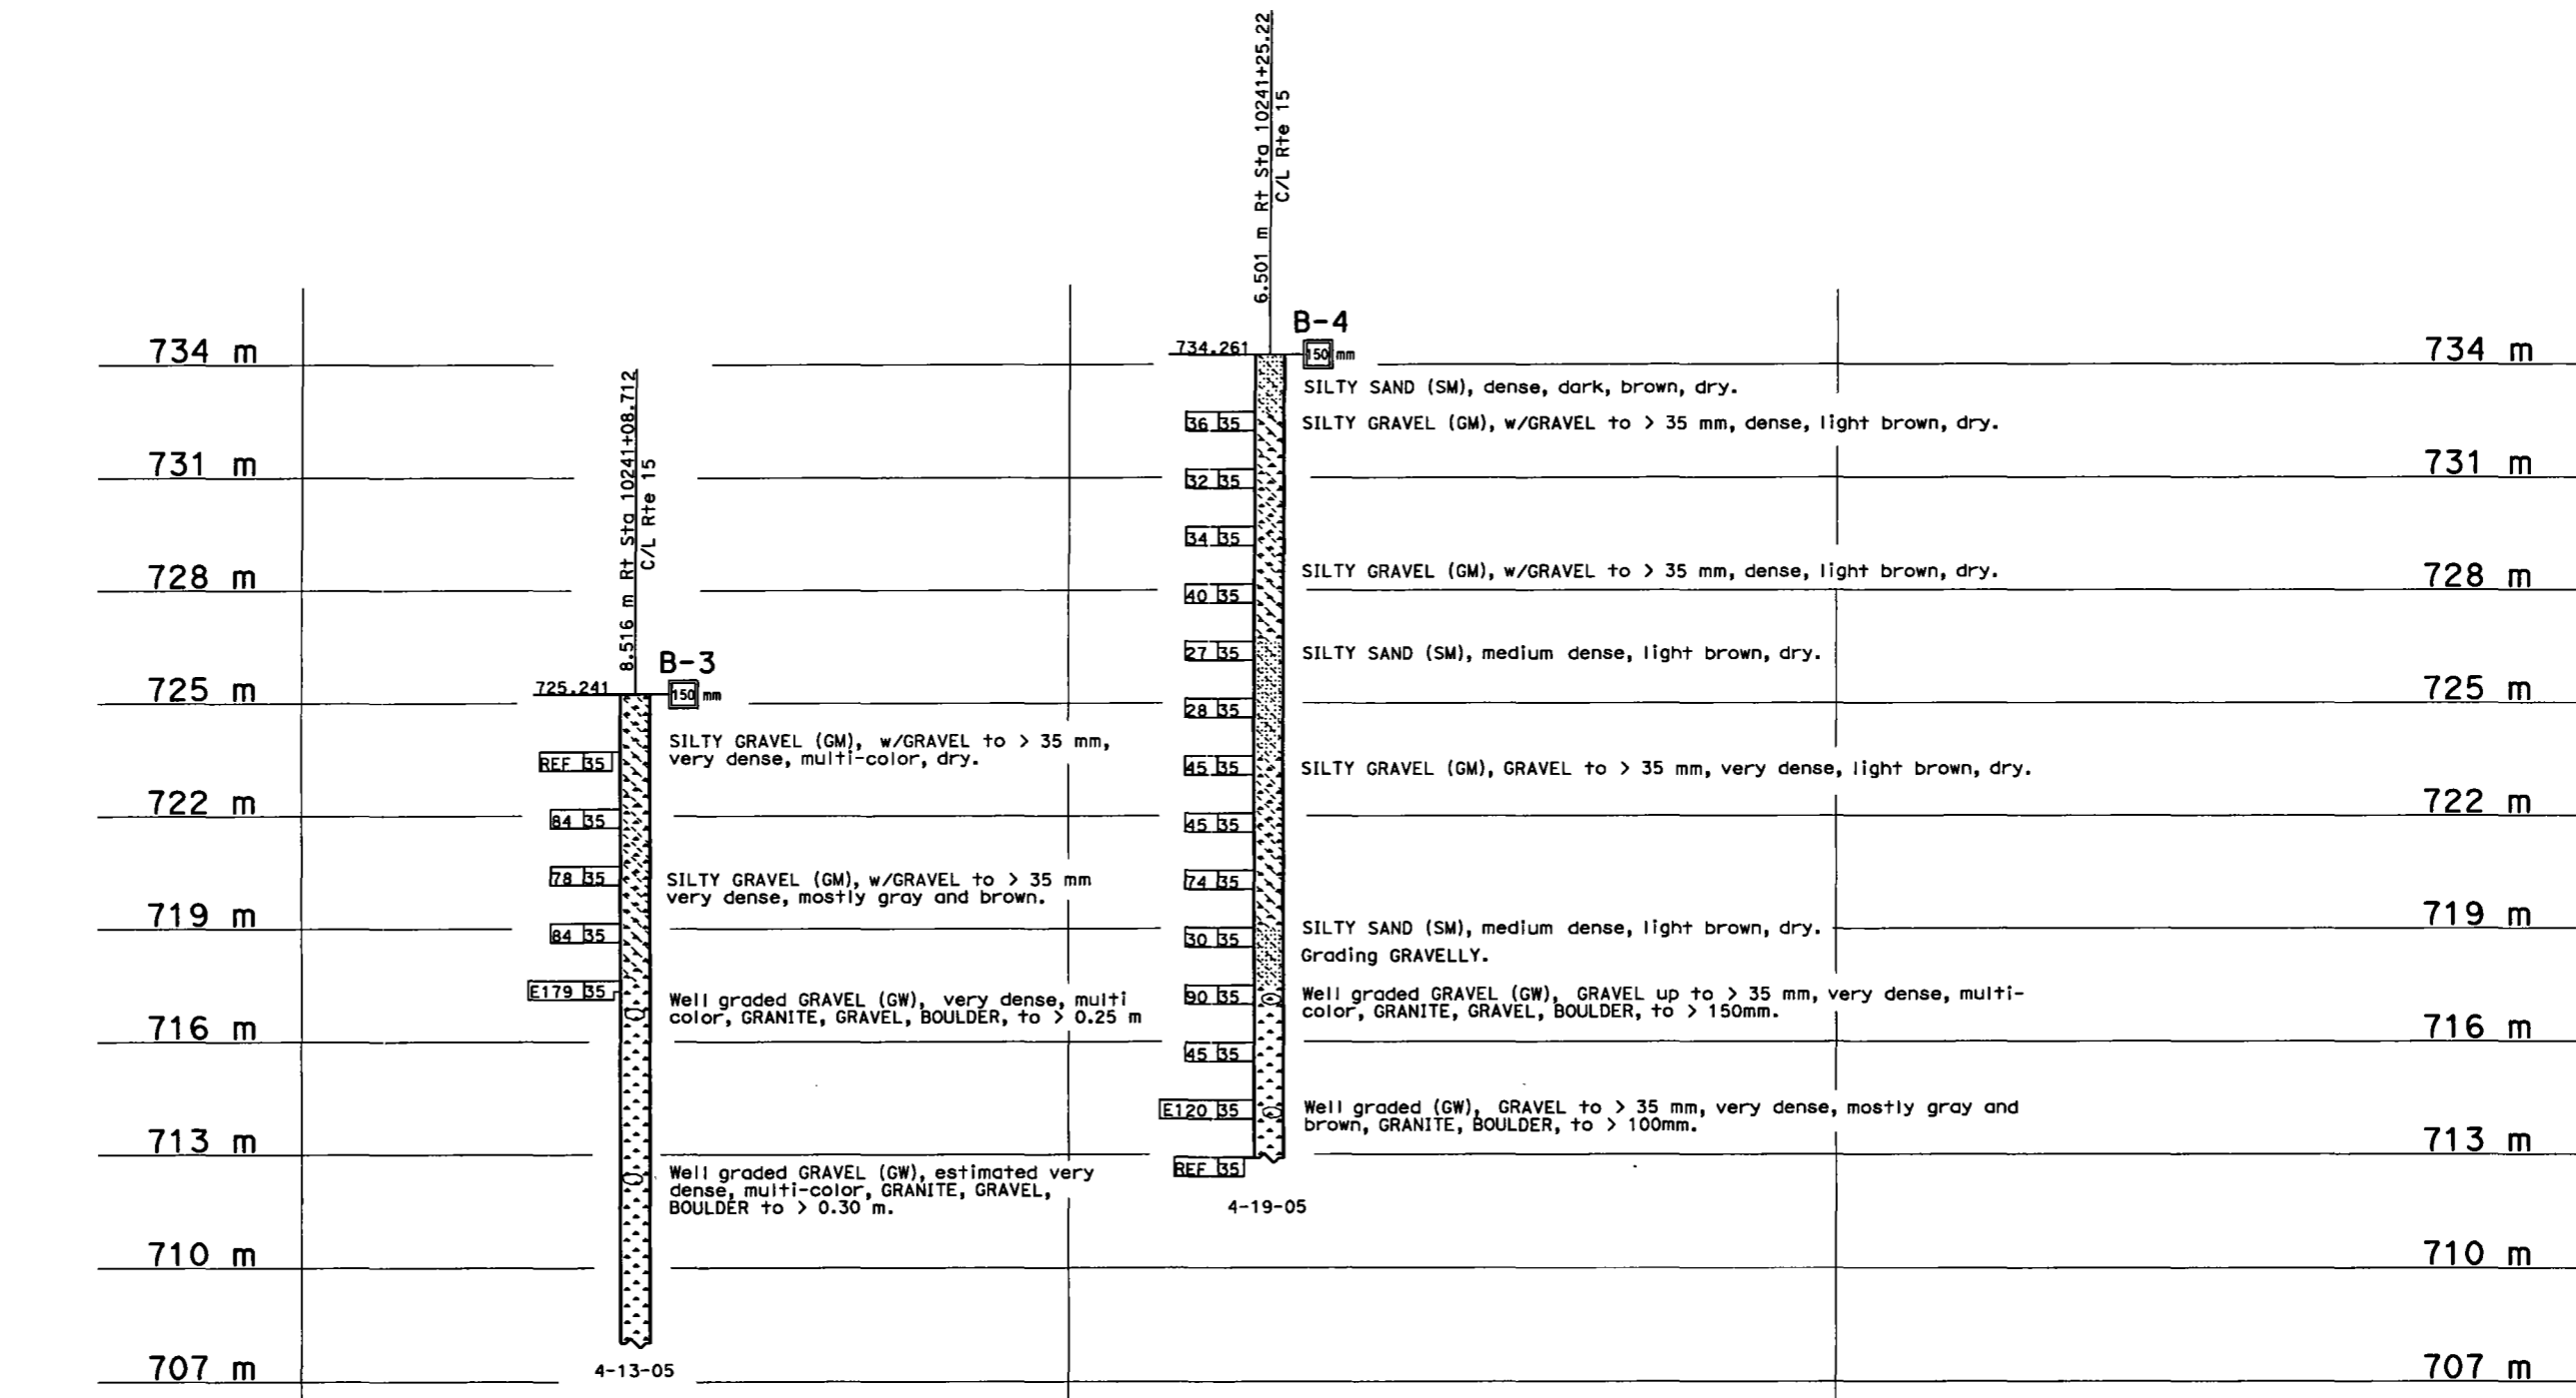

PROFILE
HOR. 1:100
VER. 1:100

ALL DIMENSIONS ARE IN METERS UNLESS OTHERWISE SHOWN

ENGINEERING SERVICES DRAWN BY: W. Tang 05/05 CHECKED BY: H. Ibrahim	GEOTECHNICAL SERVICES FIELD INVESTIGATION BY: H. Ibrahim	STATE OF CALIFORNIA DEPARTMENT OF TRANSPORTATION	BRIDGE NO. 54-0772 KILOMETER POST 24.08	KENWOOD AVENUE UC LOG OF TEST BORINGS 2 OF 2
ORIGINAL SCALE IN MILLIMETERS FOR REDUCED PLANS		CU 08 EA 0A4231	DISREGARD PRINTS BEARING EARLIER REVISION DATES	REVISION DATES (PRELIMINARY STAGE ONLY)



USERNAME => igamarr DATE PLOTTED => 06-JUL-2005 TIME PLOTTED => 10:32

FED. ROAD DIV. NO.	STATE	F. A. PROJECT NO.	SHEET NO.	TOTAL SHEETS
7	CALIF.			

DIST.	COUNTY	ROUTE	SECTION	SHEET NO.	TOTAL SHEETS
08	Sbd	15	14	326	328


BRIDGE ENGINEER CIVIL ENGINEER—LICENSE 5595
 DATE APPROVED *November 23, 1966*

LEGEND OF BORING OPERATIONS


LEGEND OF EARTH MATERIALS

CLASSIFICATION OF MATERIAL BASED ON STANDARD GRADE SIZE LIMITS

NOTE: Classification of earth material as shown on this sheet is based upon field inspection and is not to be construed to imply mechanical analysis.

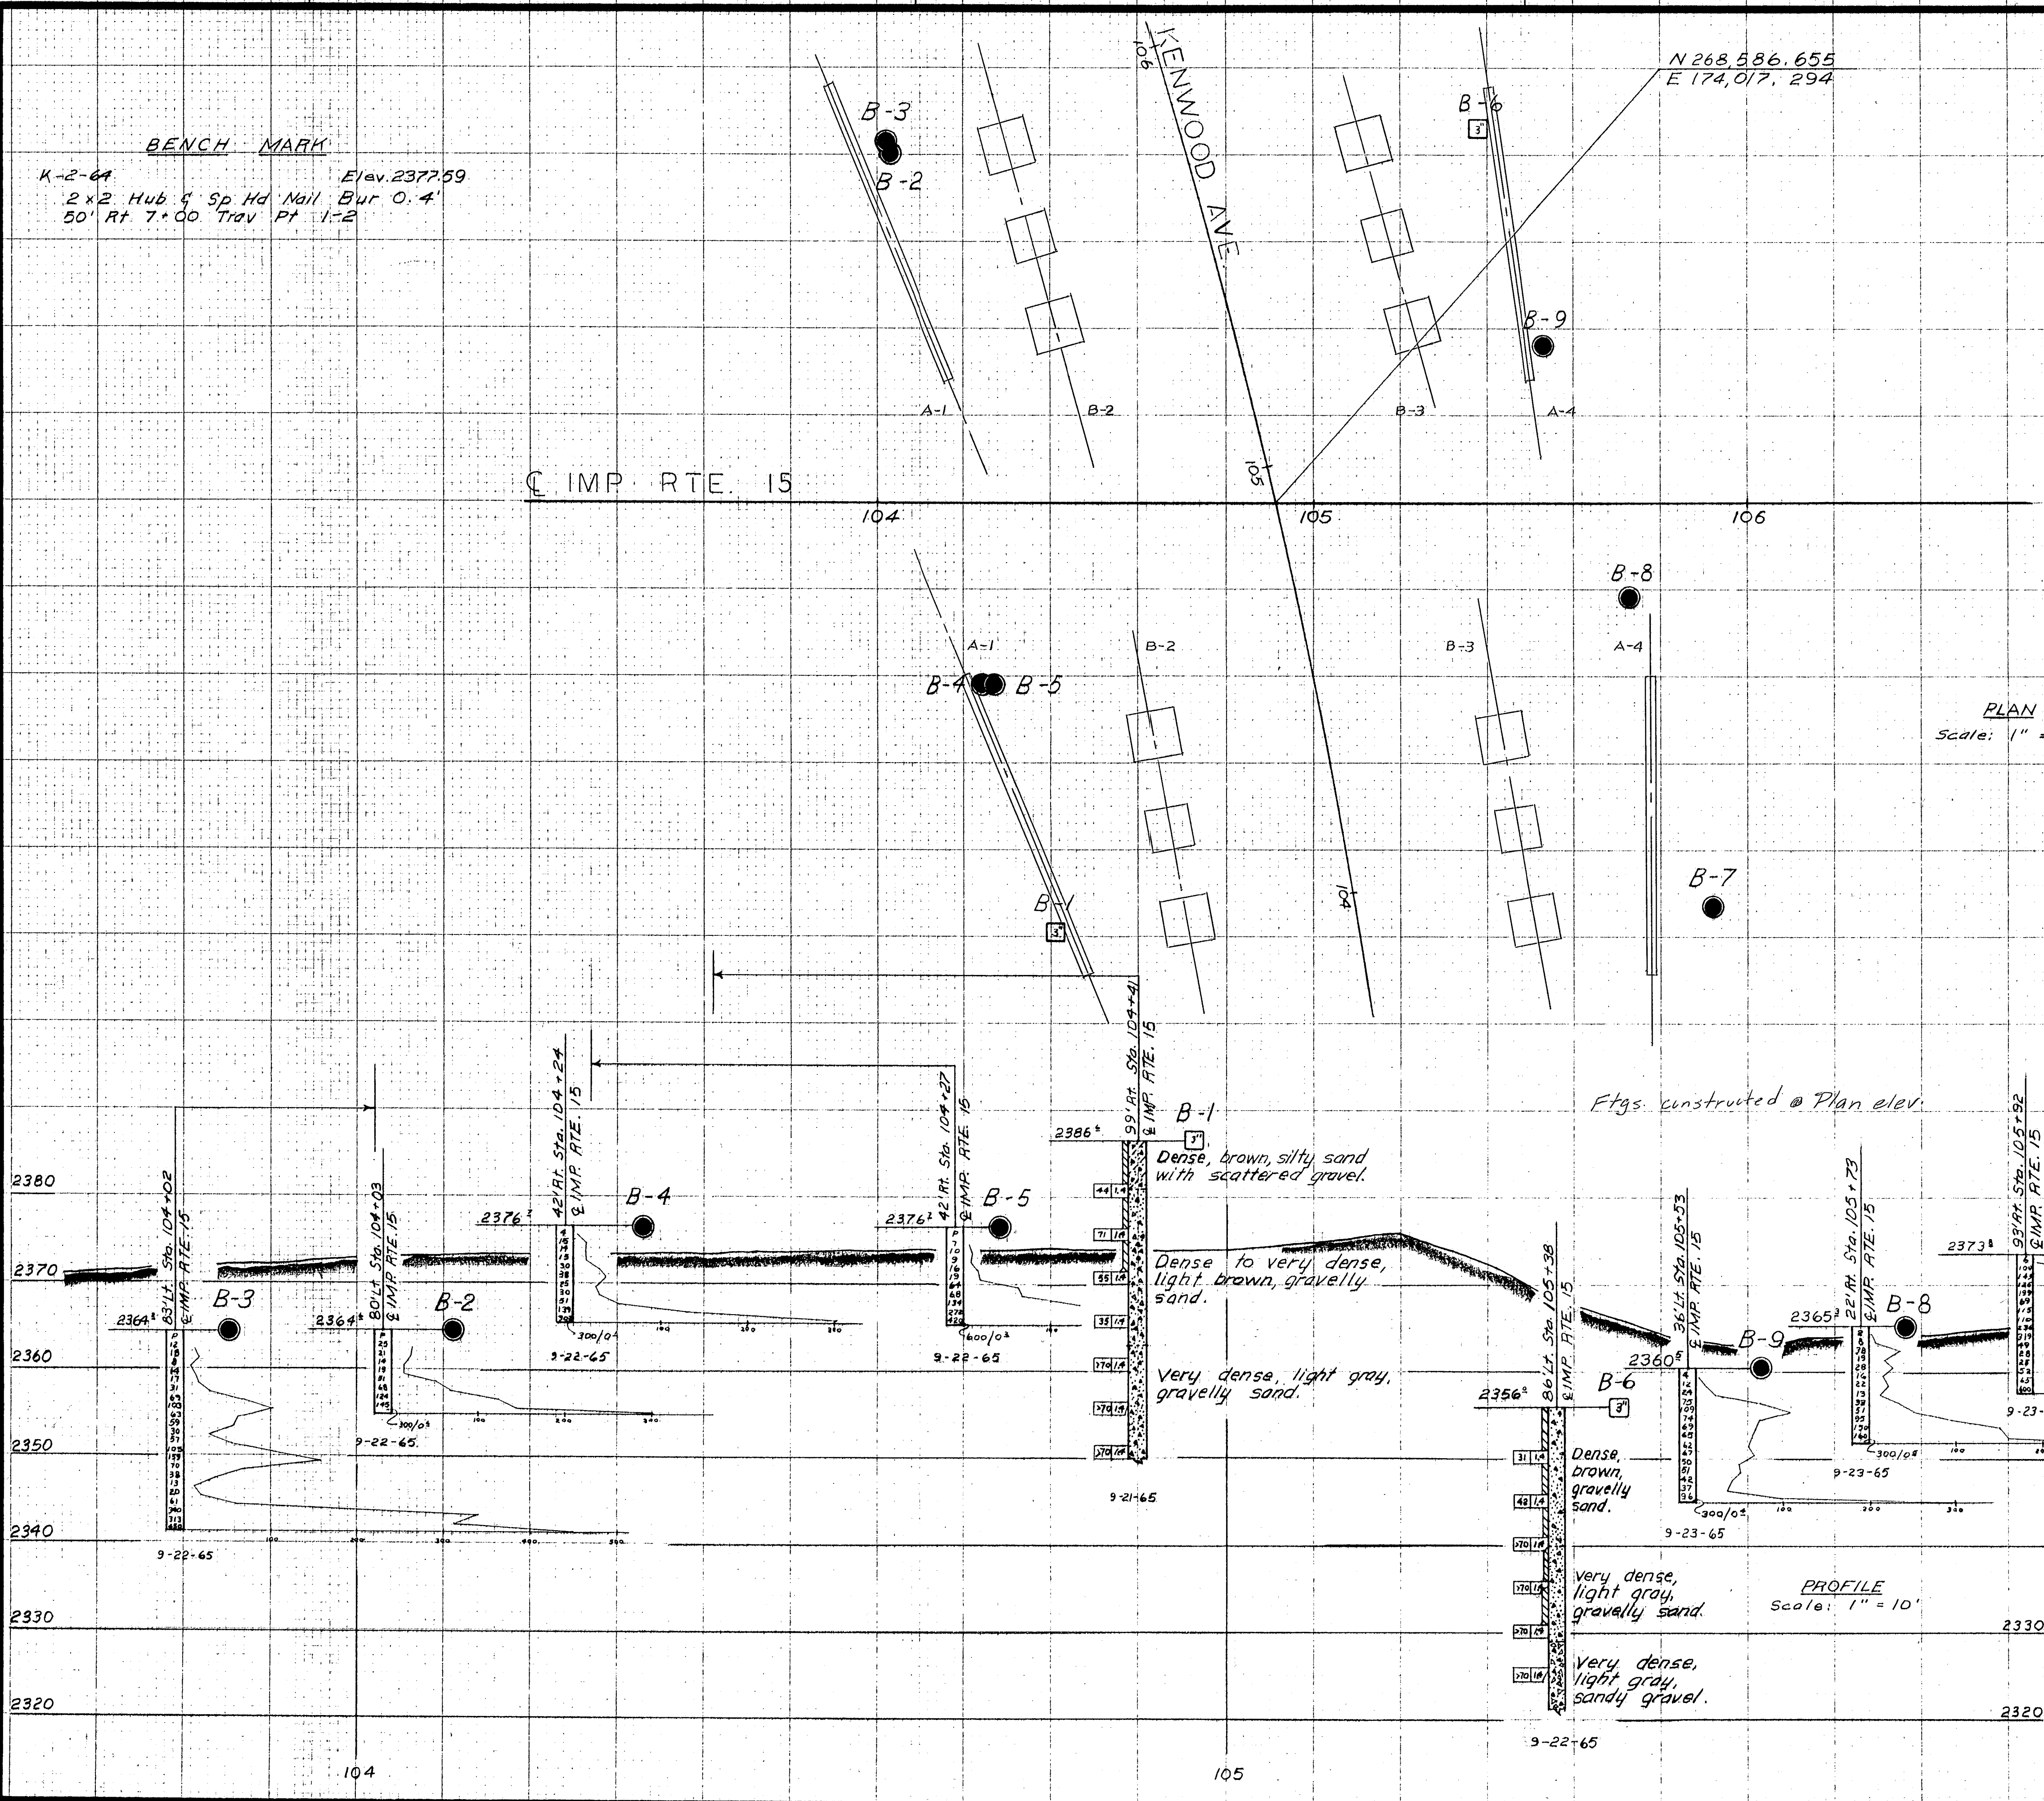

PLAN
Scale: 1" = 20'

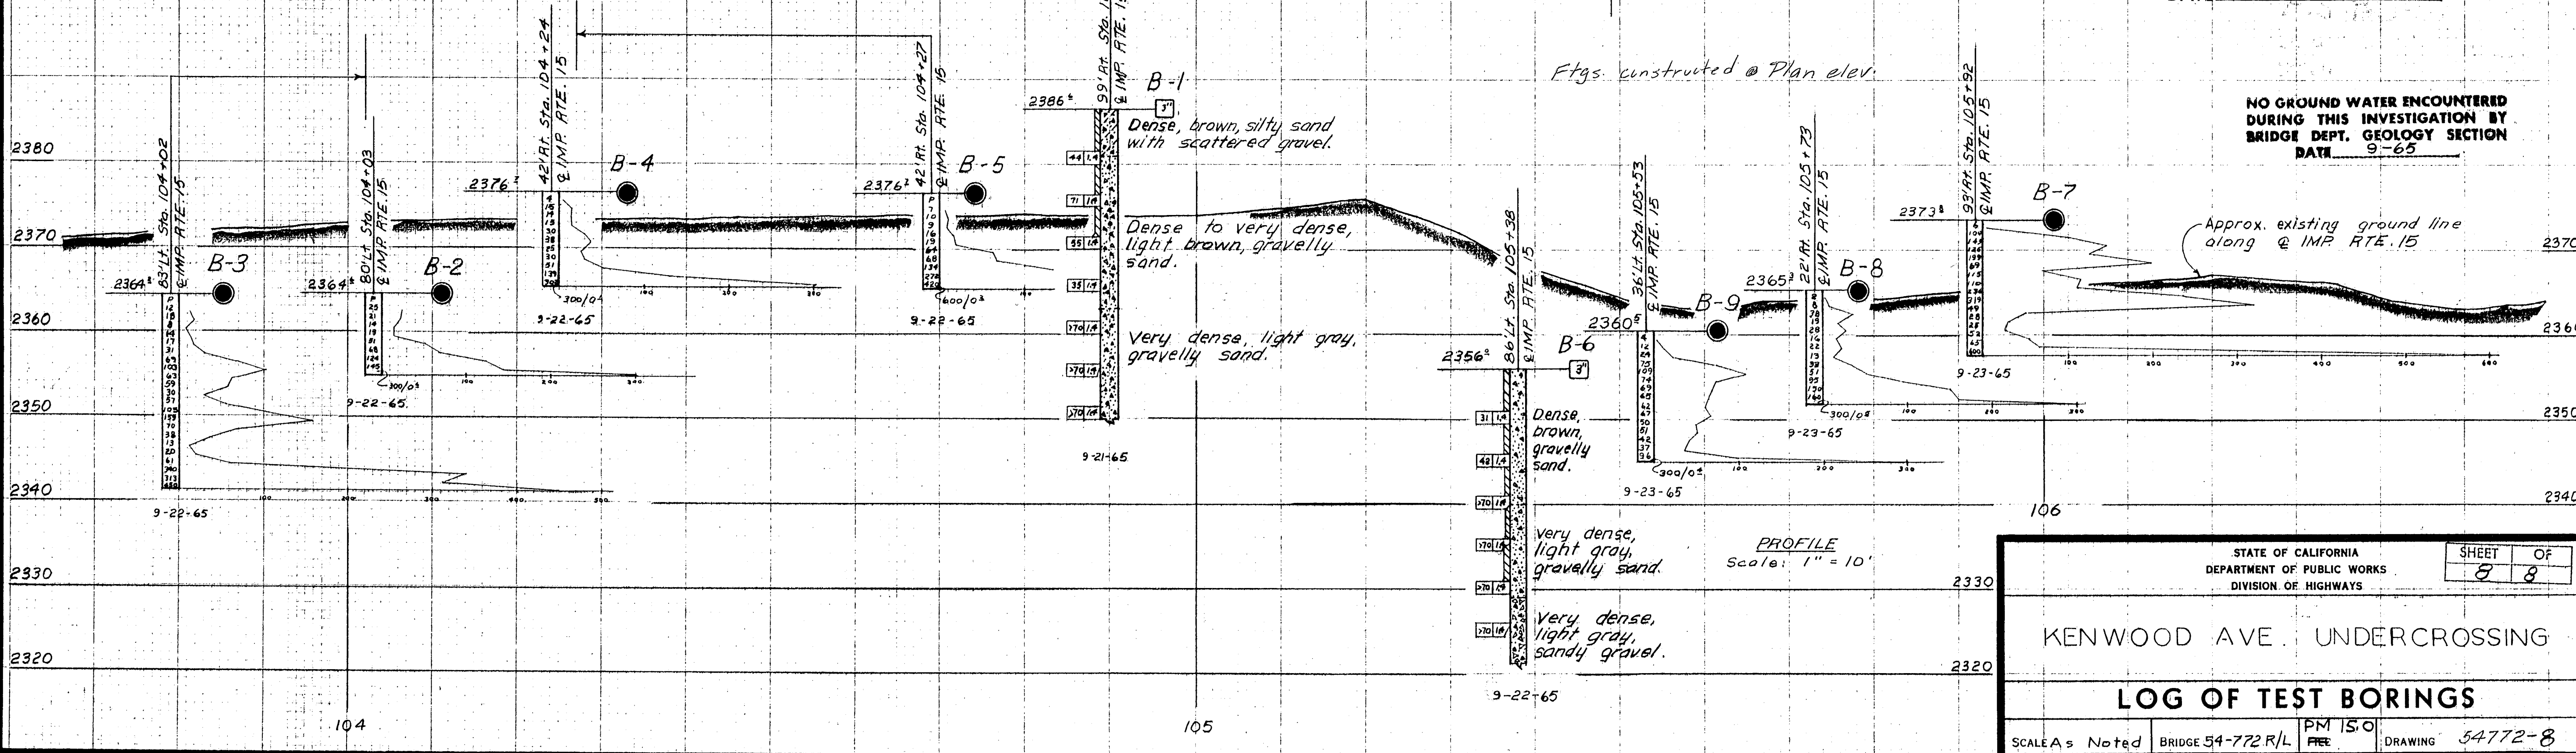

PROFILE
Scale: 1" = 10'

AS BUILT
 CORRECTIONS BY *Whelan*
 CONTRACT NO. 081049114
 DATE 9-20-68

NO GROUND WATER ENCOUNTERED
 DURING THIS INVESTIGATION BY
 BRIDGE DEPT. GEOLOGY SECTION
 DATE 9-65

Approx. existing ground line along @ IMP RTE 15

STATE OF CALIFORNIA
 DEPARTMENT OF PUBLIC WORKS
 DIVISION OF HIGHWAYS

KENWOOD AVE UNDERCROSSING

LOG OF TEST BORINGS

SCALE As Noted BRIDGE 54-772 R/L PM 150 FREE DRAWING 54-772-8

PREL. DRAWING NO. PR- *15/6*

FIELD STUDY BY D. MITCHELL 9-23-65
 BY G. SCHLES 11-8-65
 CHECKED BY G. MITCHELL 11-23-65

BRIDGE DEPARTMENT
 ENGINEERING GEOLOGY SECTION

326

Charge: 08203
 WA 049114

Diagrand prints bearing earlier numbers

54-B 54-0772

CONSISTENCY CLASSIFICATION FOR SOILS
According to the Standard Penetration Test

SPT Blows (0-30)	Consistency	Soil Type
0-4	Very Loose	Very Soft
5-10	Loose	Soft
11-20	Medium Dense	Firm
21-30	Dense	Stiff
31-50	Very Dense	Very Stiff
>50		Hard

LEGEND OF EARTH MATERIALS

- GRAVEL
- SAND
- SILT
- CLAY
- CLAYEY SILT
- PEAT and/or ORGANIC MATTER
- COBBLES and/or Boulders
- LONGICIOUS ROCK
- SEDIMENTARY ROCK
- SHALE, CLAY or SILTY CLAY
- SANDY SILT or SILTY SAND
- SILTSTONE or SILTY SILT
- SANDSTONE or SILTY SAND
- SILT CLAY

LEGEND OF BORING OPERATIONS

- 57 mm CONE PENETRATION (DRY)
- ROTARY SAMPLE BORING (DRY)
- DIAMOND CORE BORING (DRY)
- TEST PIT
- JET BORING
- ELECTRONIC CONE PENETROMETER

LEGEND OF BORING OPERATIONS (continued)


- 57 mm CONE PENETRATION BORING (WET)
- ROTARY SAMPLE BORING (WET)
- DIAMOND CORE BORING (WET)
- TEST PIT
- JET BORING
- ELECTRONIC CONE PENETROMETER

LEGEND OF BORING OPERATIONS (continued)

- 57 mm CONE PENETRATION BORING (WET)
- ROTARY SAMPLE BORING (WET)
- DIAMOND CORE BORING (WET)
- TEST PIT
- JET BORING
- ELECTRONIC CONE PENETROMETER

LEGEND OF BORING OPERATIONS (continued)

- 57 mm CONE PENETRATION BORING (WET)
- ROTARY SAMPLE BORING (WET)
- DIAMOND CORE BORING (WET)
- TEST PIT
- JET BORING
- ELECTRONIC CONE PENETROMETER

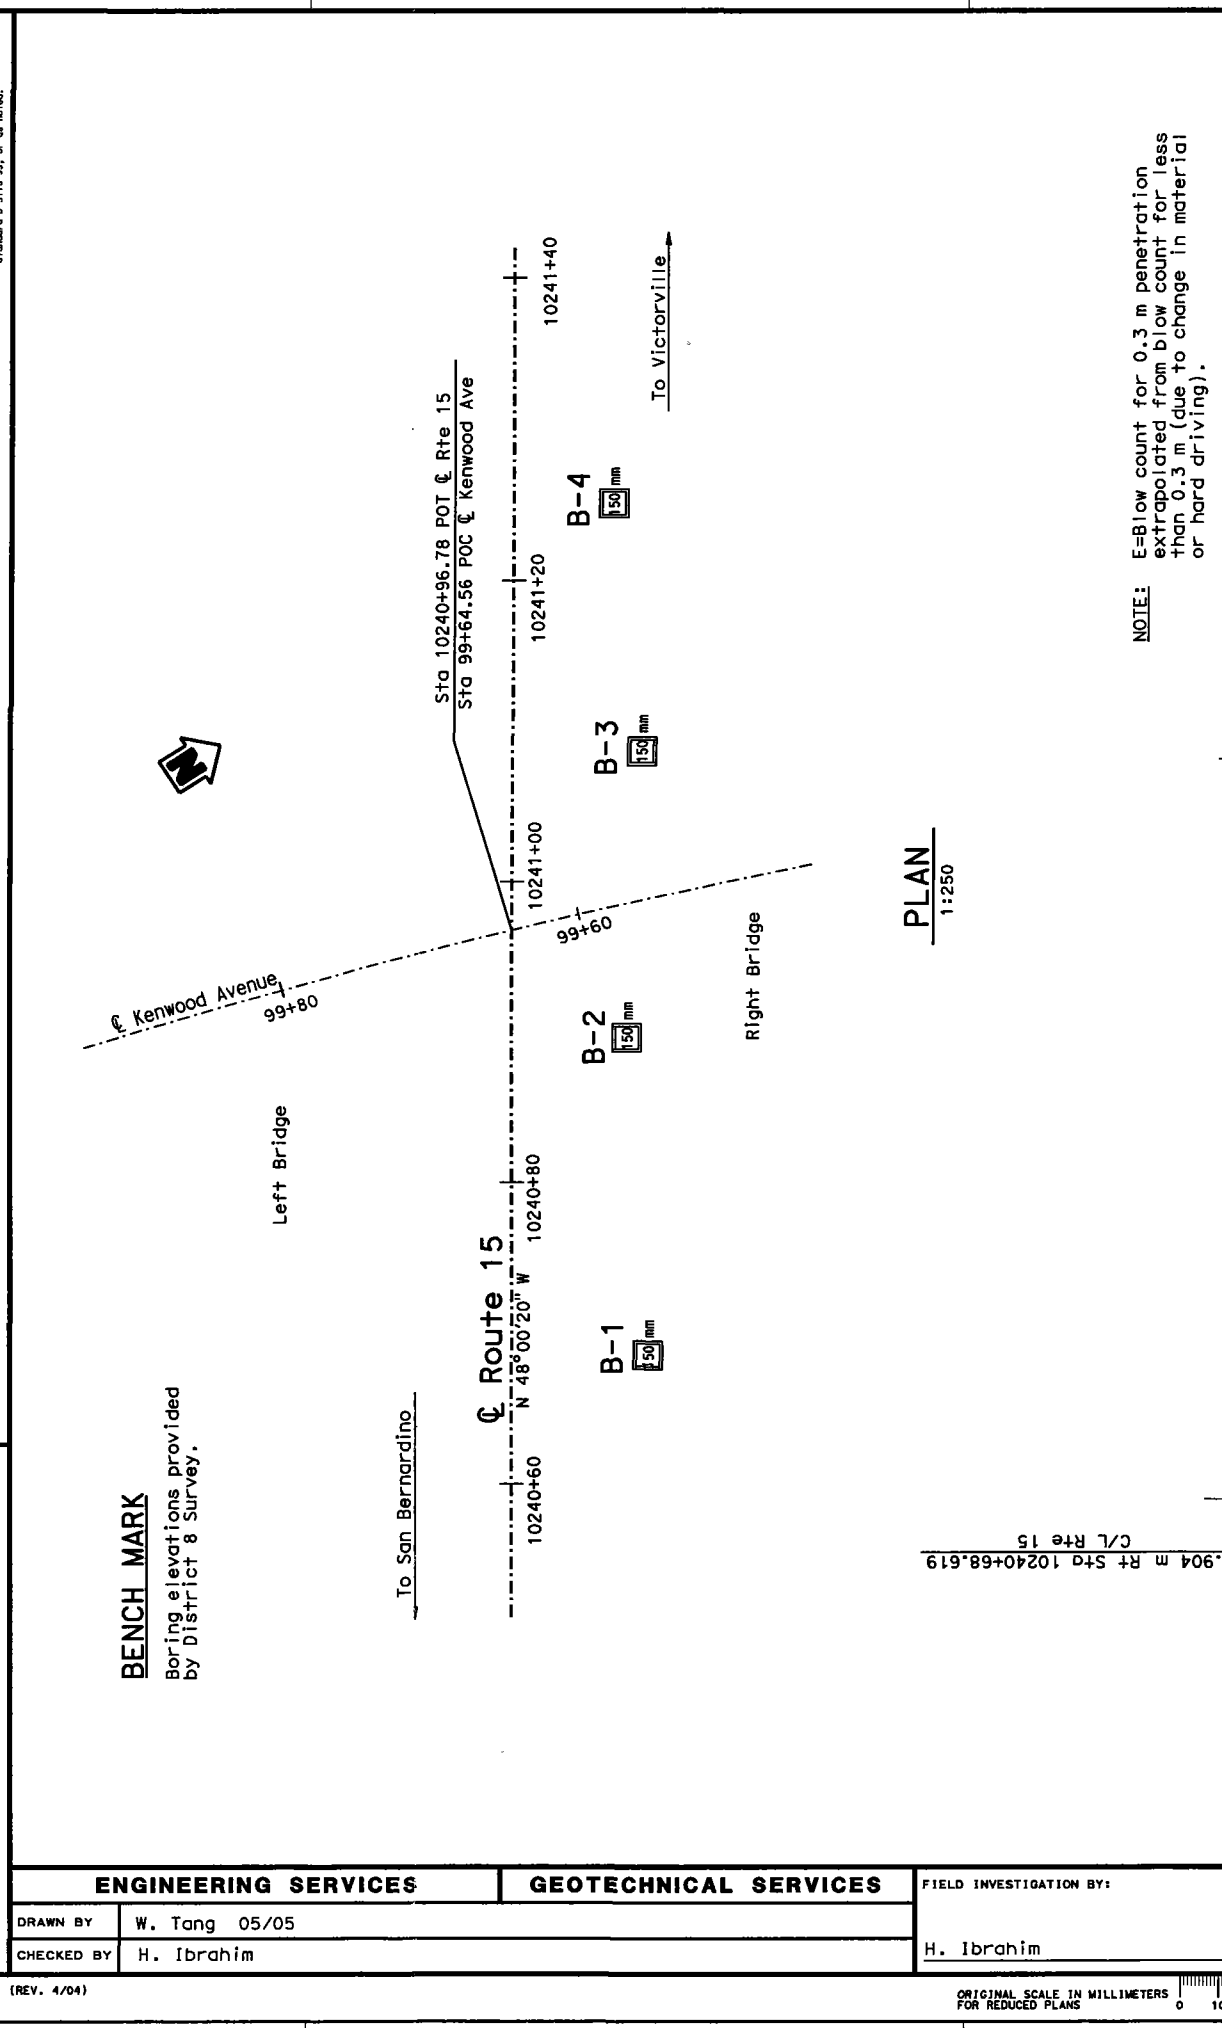

NOTE: E-Blow count for 0.3 m penetration extrapolated from blow count for less than 0.3 m (due to change in material or hard driving).

Boring No.	Top Hole E.L.	Bottom Hole E.L.	Penetration (blows/300mm)	Soil Description	Remarks
B-1	731.87	25.55	28.35	SILTY SAND (SM), medium dense, dark brown, dry.	
B-2	728.00	25.55	46.35	SILTY SAND (SM) with GRAVEL up to >35 mm, very dense, light brown.	
B-3	725.00	27.35	20.35	SILTY SAND (SM), medium dense, dark brown, dry, with GRAVEL up to 25 mm.	
B-4	722.00	55.35	57.35	SILTY GRAVEL (GM), very dense, light gray, dry, GRAVEL to >35 mm.	
B-1	719.00	43.35	55.35	Well graded GRAVEL (GW), very dense, multi color, fresh very hard GRAVEL to >35 mm.	
B-2	716.00	REF. 35			
B-3	713.00				
B-4	710.00				
B-1	707.00				
B-2	704.00				
B-3	701.00				
B-4	698.00				

ALL DIMENSIONS ARE IN METERS UNLESS OTHERWISE SHOWN

ENGINEERING SERVICES		GEOTECHNICAL SERVICES		FIELD INVESTIGATION BY: H. Ibrahim		STATE OF CALIFORNIA DEPARTMENT OF TRANSPORTATION		BRIDGE NO. 54-0772		KENWOOD AVENUE UC	
DRAWN BY W. Tang 05/05		CHECKED BY H. Ibrahim		H. Ibrahim		DIVISION OF STRUCTURES STRUCTURE DESIGN		KILOMETER POST 24.08		LOG OF TEST BORINGS 1 OF 2	
CU 08 EA 0A4231		DISREGARD PRINTS BEARING EARLIER REVISION DATES		REVISION DATES (PRELIMINARY STAGE ONLY)		7-5-05		SHEET 1 OF 2			

DIST	COUNTY	ROUTE	KILOMETER TOTAL PROJECT	POST TOTAL PROJECT	SHEET No	TOTAL SHEETS
08	Sbd	15				

REGISTERED CIVIL ENGINEER
7-5-05
Hassan Ibrahim
No. C59016
Exp. 6-30-07
CIVIL
STATE OF CALIFORNIA

PLANS APPROVAL DATE

The State of California or its officers or agents shall not be responsible for the accuracy or completeness of electronic copies of this plan sheet.



PROFILE
HOR. 1:100
VER. 1:100



DIST	COUNTY	ROUTE	POST MILES TOTAL PROJECT	SHEET NO	TOTAL SHEETS
08	SBd	15			


K. Douglas Cook 10-24-11
 CERTIFIED ENGINEERING GEOLOGIST

PLANS APPROVAL DATE _____
 The State of California or its officers or agents shall not be responsible for the accuracy or completeness of electronic copies of this plan sheet.

This LOTB sheet was prepared in accordance with the Caltrans Soil & Rock Logging, Classification, & Presentation Manual (2010 Edition).


BENCH MARK

Set TBM @ Kenwood at @ SB 15 Off-Ramp located at B3 1000+00 and K3 10+00 on Kenwood Line 792+74. Assumed Elev 2354.0' (Topo) NAVD 1988.

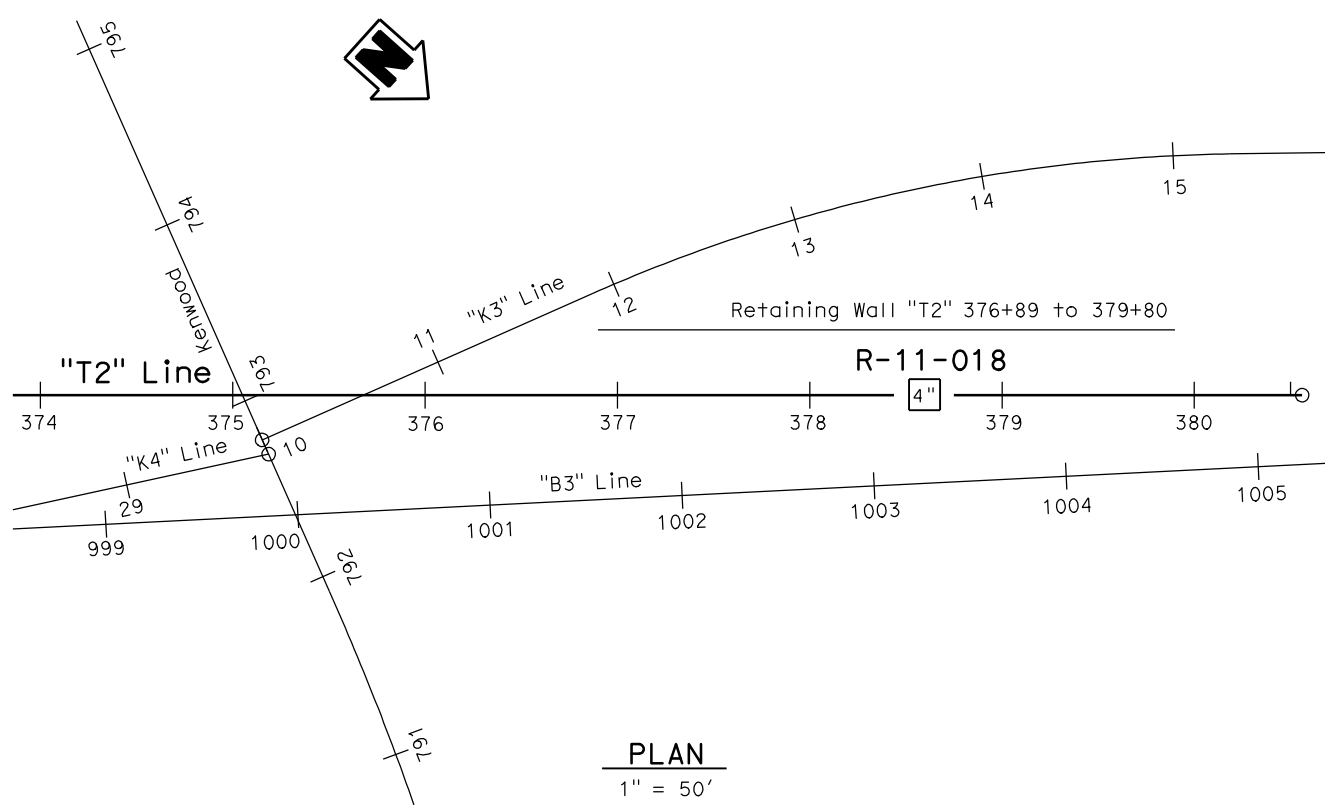

PLAN
1" = 50'

Note: Ground water was not encountered at the time of this field investigation.

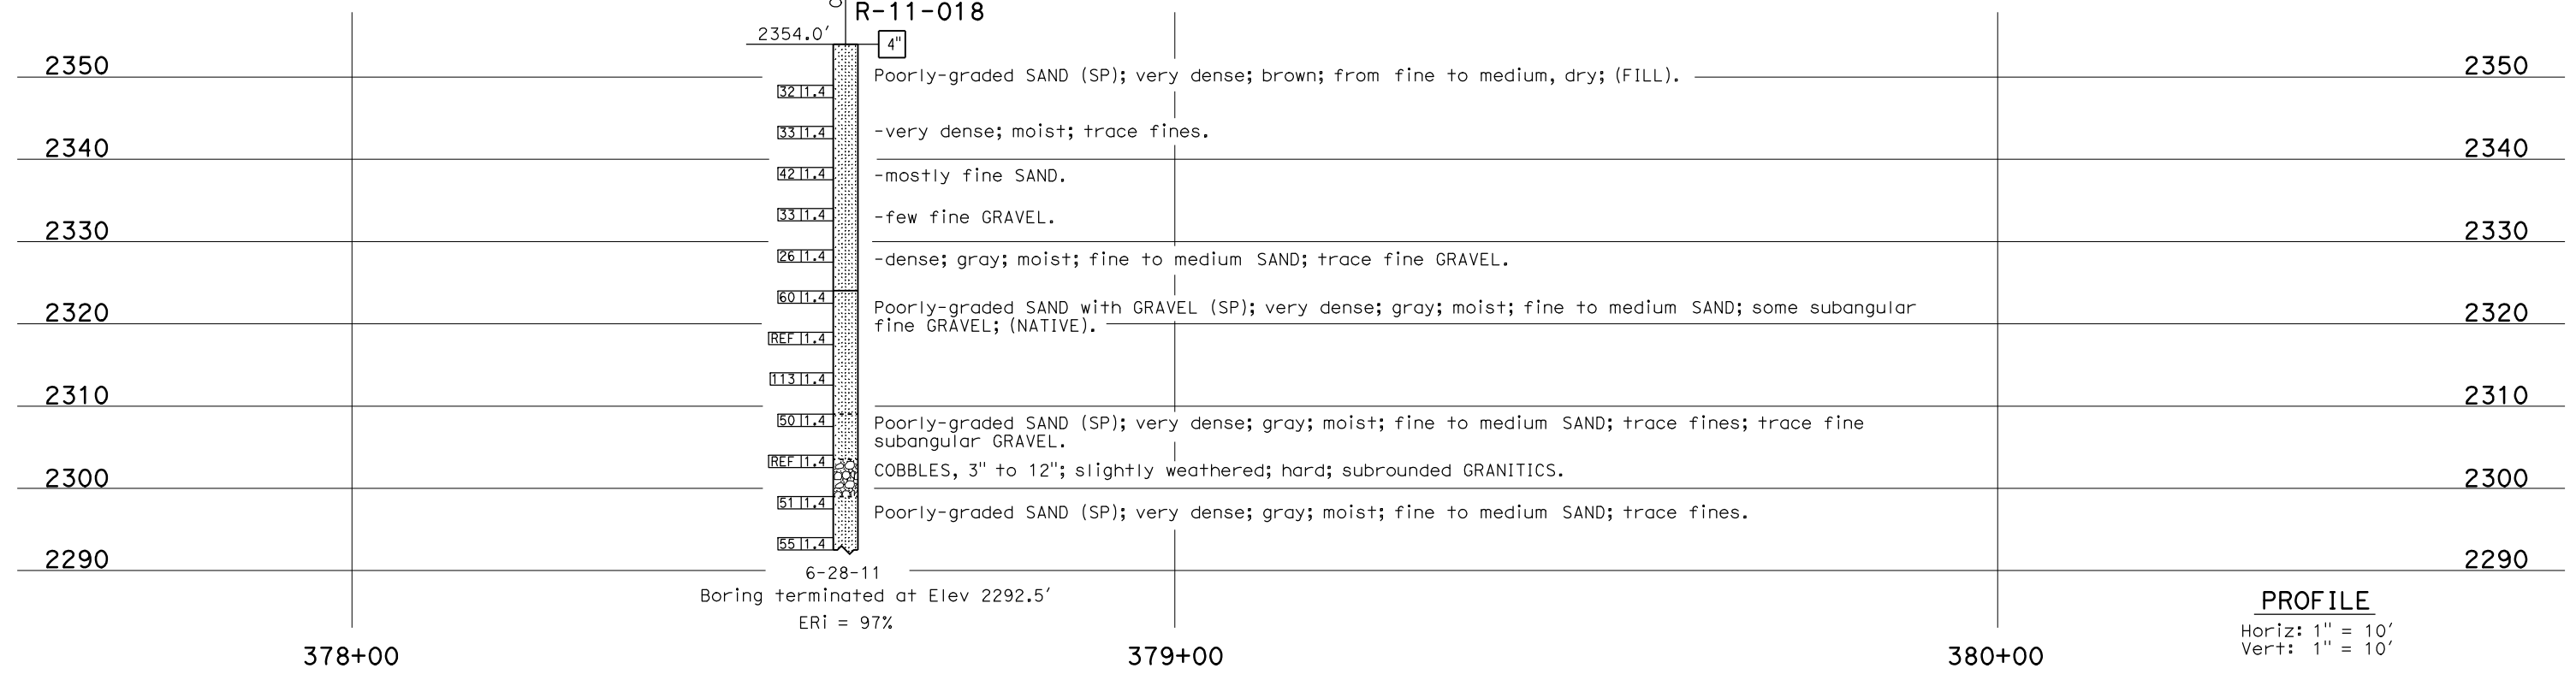


PROFILE
Horiz: 1" = 10'
Vert: 1" = 10'

ENGINEERING SERVICES		MATERIALS AND GEOTECHNICAL SERVICES		STATE OF CALIFORNIA		DIVISION OF ENGINEERING SERVICES		BRIDGE NO.		RETAINING WALL "T2" 376+89 TO 379+80 LF	
FUNCTIONAL SUPERVISOR		DRAWN BY: F. Nguyen 9/11		DEPARTMENT OF TRANSPORTATION		STRUCTURE DESIGN		NEW		LOG OF TEST BORINGS 1 OF 3	
NAME: A. Perez-Cobo		CHECKED BY: B. Levine		FIELD INVESTIGATION BY:		DESIGN BRANCH X		POST MILE			
				S. Logeswaran				R15.04			
OGS CIVIL LOG OF TEST BORINGS SHEET				ORIGINAL SCALE IN INCHES FOR REDUCED PLANS				UNIT: 3643		REVISION DATES	
				PROJECT NUMBER & PHASE: 08000003660				CONTRACT NO.: 08-0K7100		SHEET OF	
				FILE => rwt2-1of3.dgn				DISREGARD PRINTS BEARING EARLIER REVISION DATES		X X	

DATE PLOTTED => 25-OCT-2011 USERNAME => s128198 TIME PLOTTED => 08:17

DIST	COUNTY	ROUTE	POST MILES TOTAL PROJECT	SHEET NO	TOTAL SHEETS
08	Sbd	15			
<i>K. Douglas Cook</i> 10-12-11 CERTIFIED ENGINEERING GEOLOGIST					
PLANS APPROVAL DATE					
<small>The State of California or its officers or agents shall not be responsible for the accuracy or completeness of electronic copies of this plan sheet.</small>					

Note: No ground water encountered during field investigation.

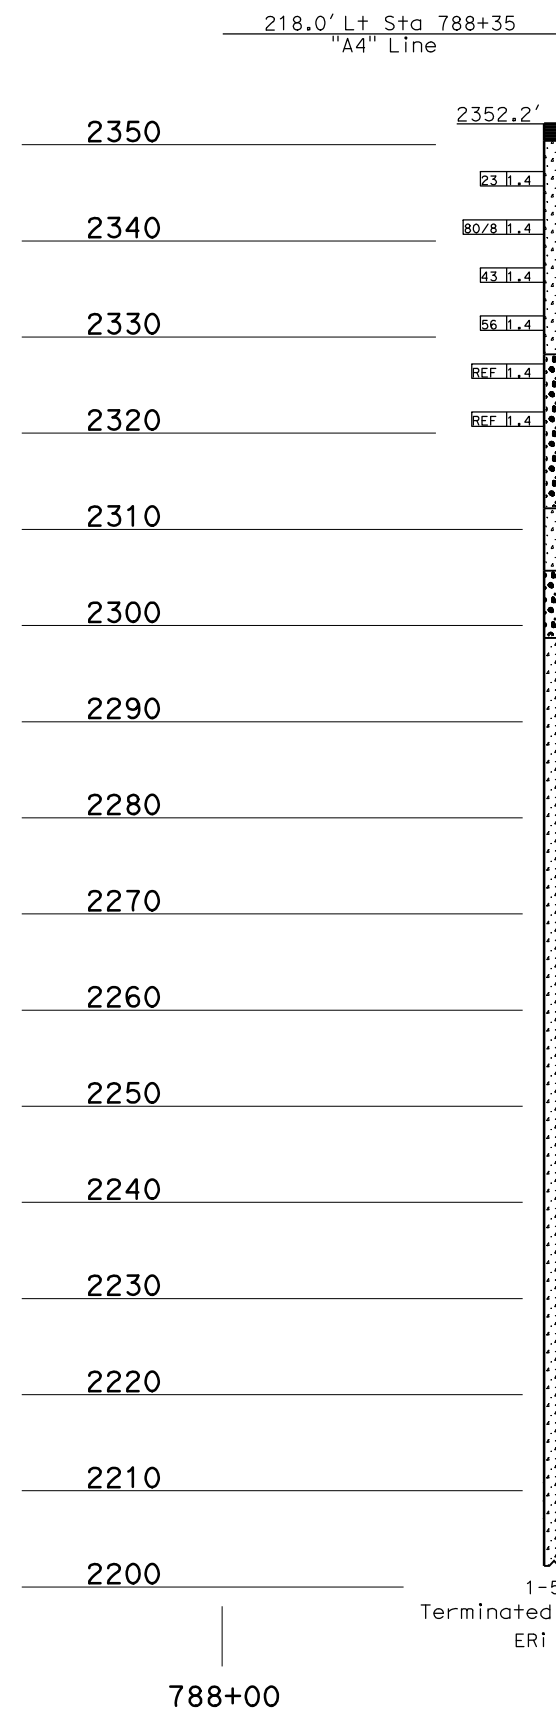

R-11-015

4" ASPHALT CONCRETE (6"); Base GRAVEL (12").

Well-graded SAND with GRAVEL (SW); medium dense; gray; moist; little subangular fine GRAVEL; (FILL).

Well-graded SAND with GRAVEL (SW); very dense; brown; moist; some well-graded subangular GRAVEL; (ALLUVIUM).

-dense; yellowish brown.

-very dense.

Well-graded GRAVEL with SAND (GW); very dense; grayish light brown; moist; mostly subangular GRAVEL; some well-graded SAND.

-10% COBBLES, 3-6"; hard; subangular; GRANITICS.

Well-graded SAND with GRAVEL (SW); yellowish brown; moist; some well-graded subangular GRAVEL.


Well-graded GRAVEL with SAND (GW); yellowish brown; moist; subangular GRAVEL; some well-graded SAND.

Well-graded SAND with GRAVEL and COBBLES (SW); yellowish brown; moist; some well-graded subangular GRAVEL; 10% COBBLES, 3-8", hard, subrounded GRANITICS.

BENCH MARK

PNO 173 2120.910
 FD STD Brass disk in concrete stamped "SBD-215-173 1988" 40' Ely of EOD Devore Rd Bridge at Nly end bridge; 70' Nly of EP NB SBD 215 at PM 17.3 at top of slope.

PNO 2010 2179.090
 FD STD Brass disk in concrete stamped "D8 SCN SBD-15 PM 16.3 08.04.08" At top of slope SOUTH of Connector Bridge from NB SBD 15 to NB SBD 215.

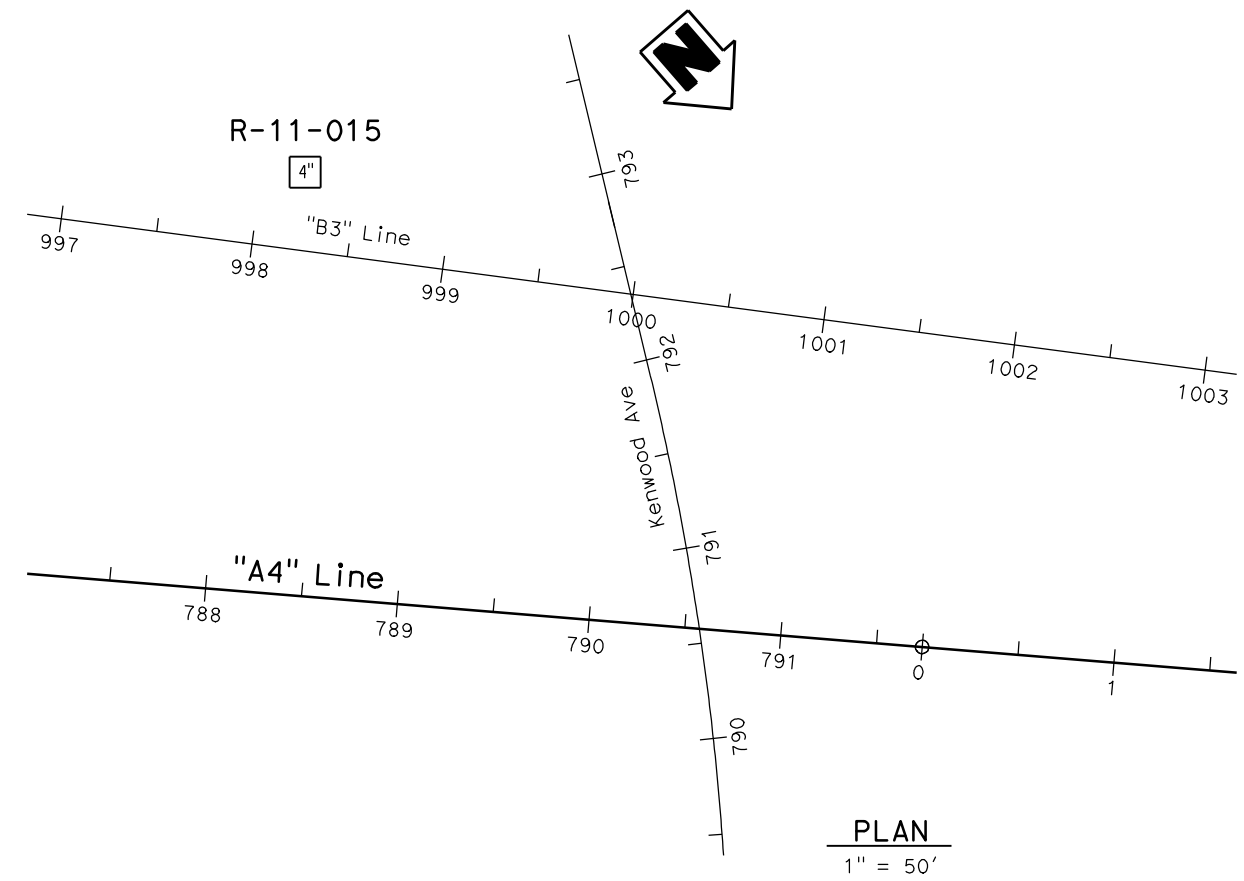

PLAN
1" = 50'

PROFILE
 Horiz: 1" = 10'
 Vert: 1" = 10'

ENGINEERING SERVICES		MATERIALS AND GEOTECHNICAL SERVICES		STATE OF CALIFORNIA DEPARTMENT OF TRANSPORTATION		DIVISION OF ENGINEERING SERVICES STRUCTURE DESIGN DESIGN BRANCH X		BRIDGE NO. SB TRUCK BYPASS/SB 215 MAINLINE	
FUNCTIONAL SUPERVISOR NAME: A. Perez-Cobo	DRAWN BY: W. Tang 06/11	FIELD INVESTIGATION BY: D. Cook		PROJECT NUMBER & PHASE: 08000003661		CONTRACT NO.: 08-OK7100		LOG OF TEST BORINGS 1 OF 3	
CHECKED BY: B. Levine/S. Logeswaran		REVISION DATES		DISREGARD PRINTS BEARING EARLIER REVISION DATES		SHEET OF		X X	
OGS CIVIL LOG OF TEST BORINGS SHEET		ORIGINAL SCALE IN INCHES FOR REDUCED PLANS		UNIT: 3643		FILE => sb-truck-bypass1of3.dgn		09-06-11 10-06-11	


DATE PLOTTED => 21-OCT-2011 USERNAME => s128198 TIME PLOTTED => 12:32

DIST	COUNTY	ROUTE	POST MILES TOTAL PROJECT	SHEET NO	TOTAL SHEETS
08	SBd	15			

10-12-11
 CERTIFIED ENGINEERING GEOLOGIST
 K. Douglas Cook
 No. 1391
 Exp. 12-31-11
 CERTIFIED ENGINEERING GEOLOGIST
 STATE OF CALIFORNIA

PLANS APPROVAL DATE _____
 The State of California or its officers or agents shall not be responsible for the accuracy or completeness of electronic copies of this plan sheet.

BENCH MARK
 PNO 173 2120.910
 FD STD Brass disk in concrete stamped "SBD-215-173 1988" 40' Ely of EOD Devore Rd Bridge at Nly end bridge; 70' Nly of EP NB SBD 215 at PM 17.3 at top of slope.
 PNO 2010 2179.090
 FD STD Brass disk in concrete stamped "D8 SCN SBD-15 PM 16.3 08.04.08" At top of slope SOUTH of Connector Bridge from NB SBD 15 to NB SBD 215.

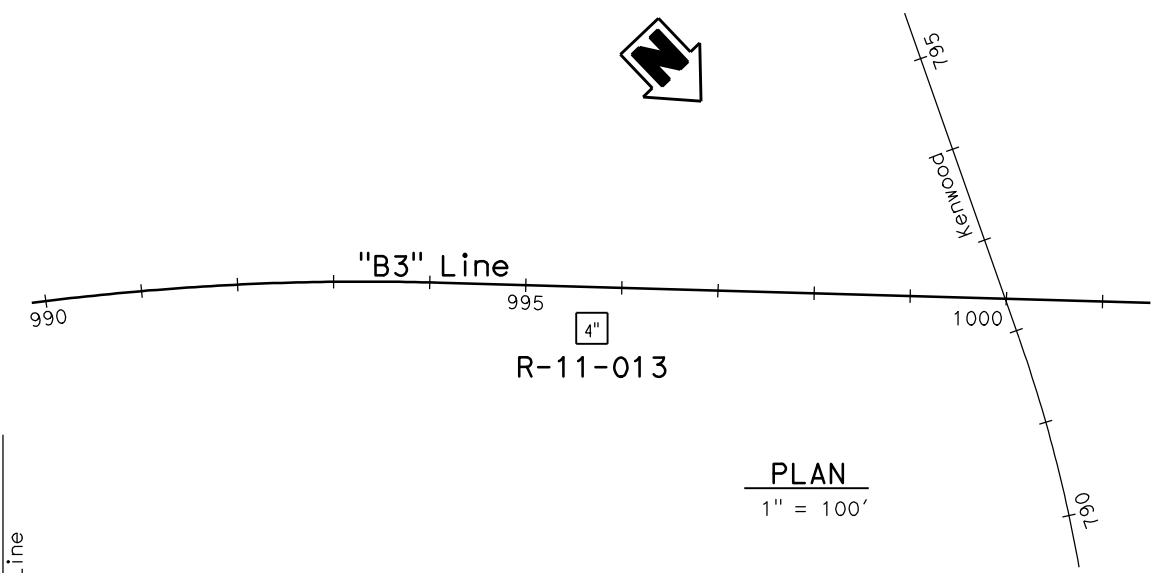

Note: Ground water was not encountered at the time of this field investigation.



ELEVATION	DEPTH (ft)	DESCRIPTION	ELEVATION
2360	43.0'	R-11-013	2360
2350	54.0'	Well-graded SAND with SILT and GRAVEL (SW-SM); very dense; yellowish brown; moist; some well-graded subangular GRAVEL.	2350
2340	64.0'	Well-graded SAND with GRAVEL (SW); very dense; yellowish brown; moist; some well-graded subangular GRAVEL.	2340
2330	74.0'	Well-graded SAND with SILT and GRAVEL (SW-SM); medium dense; light olive brown; moist; mostly well-graded SAND; some fines; few well-graded subangular GRAVEL.	2330
2320	84.0'	Well-graded SAND with GRAVEL (SW); very dense; yellowish brown; moist; some well-graded subangular GRAVEL.	2320
2310	94.0'	-30% COBBLES 3"-10"; hard; subrounded GRANITICS and soft METAMORPHICS.	2310
2300	104.0'	-10% COBBLES 3"-6".	2300
2290	114.0'	-15% COBBLES 3"-8".	2290
2280	124.0'	Well-graded SAND with GRAVEL (SW); yellowish brown; moist; some well-graded subrounded GRAVEL.	2280
2270	134.0'	Well-graded SAND with GRAVEL and COBBLES (SW); yellowish brown; moist; some well-graded subrounded GRAVEL; 20% COBBLES 3"-6"; hard; subrounded; GRANITICS.	2270
2260	144.0'	Boring terminated at Elev 2268.3' ERI = 68%	2260

PROFILE
 Horiz: 1" = 10'
 Vert: 1" = 10'

ENGINEERING SERVICES		MATERIALS AND GEOTECHNICAL SERVICES		STATE OF CALIFORNIA		DIVISION OF ENGINEERING SERVICES		BRIDGE NO.		SB 215 MAINLINE OVER KENWOOD	
FUNCTIONAL SUPERVISOR		DRAWN BY: F. Nguyen 6/11		FIELD INVESTIGATION BY:		STRUCTURE DESIGN		NEW		LOG OF TEST BORINGS 1 OF 3	
NAME: A. Perez-Cobo		CHECKED BY: B. Levine/S. Logeswaran		M. Wilson		DESIGN BRANCH X		R14.95			
OGS CIVIL LOG OF TEST BORINGS SHEET		ORIGINAL SCALE IN INCHES FOR REDUCED PLANS		0 1 2 3		UNIT: 3643		PROJECT NUMBER & PHASE: 08000003660		CONTRACT NO.: 08-OK7100	
						DISREGARD PRINTS BEARING EARLIER REVISION DATES		REVISION DATES		SHEET OF	
								08-28-11 10-04-11		X X	

FILE => sb215m1n-knwd1of3.dgn

USERNAME => s128198 DATE PLOTTED => 21-OCT-2011 TIME PLOTTED => 12:51

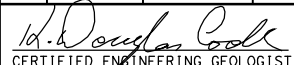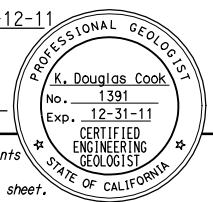DIST	COUNTY	ROUTE	POST MILES TOTAL PROJECT	SHEET No	TOTAL SHEETS
08	SBd	15			
 CERTIFIED ENGINEERING GEOLOGIST			10-12-11		
PLANS APPROVAL DATE					
The State of California or its officers or agents shall not be responsible for the accuracy or completeness of electronic copies of this plan sheet.					


This LOTB sheet was prepared in accordance with the Caltrans Soil & Rock Logging, Classification, & Presentation Manual (2010 Edition).

BENCH MARK

PNO 173 2120.910
 FD STD Brass disk in concrete stamped "SBD-215-173 1988" 40' Ely of EOD Devore Rd Bridge at Nly end bridge; 70' Nly of EP NB SBD 215 at PM 17.3 at top of slope.

PNO 2010 2179.090
 FD STD Brass disk in concrete stamped "D8 SCN SBD-15 PM 16.3 08.04.08" At top of slope SOUTH of Connector Bridge from NB SBD 15 to NB SBD 215.

R-11-012

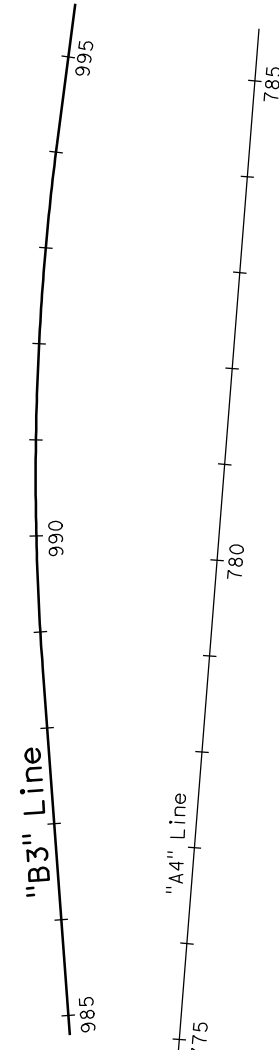

PLAN
1" = 100'

To San Bernardino

Note: Ground water was not encountered at the time of this field investigation.

Elevation	Notes
2350	4" Asphalt concrete on grade.
2340	Well-graded SAND with GRAVEL (SW); very dense; grayish light brown; moist; little subangular well-graded GRAVEL.
2330	-yellowish brown.
2320	Well-graded SAND with GRAVEL and COBBLES (SW); very dense; yellowish brown; moist; little well-graded subangular GRAVEL, 10% COBBLES 3"-6", subrounded, hard, GRANITICS.
2310	-very dense.
2300	Well-graded SAND with GRAVEL (SW); very dense; yellowish light brown; moist; little well-graded subangular GRAVEL.
2290	
2280	
2270	METAMORPHIC ROCK (MICA SCHISTS); olive dark gray; decomposed; very soft; (lean CLAY with fine GRAVEL (CL)).
2260	-HORNFELS; grayish brown; intensely weathered; moderately soft; intensely fractured.
2250	-SCHISTS; olive gray; intensely weathered; soft.
2240	-SCHISTS; light gray; soft; very intensely fractured; BRECCIATED (lean CLAY with GRAVEL (CL); moist; some SAND; little angular fine GRAVEL).
2230	-SCHISTS; olive gray; intensely weathered; moderately soft; intensely fractured.
2220	-moderately weathered.
2210	-SCHISTS; dark gray; intensely weathered; moderately soft; very intensely fractured; BRECCIATED (CLAYEY GRAVEL (GC); hard; moist; mostly fine angular GRAVEL; some fines).
2200	-QUARTZITE; dark gray; moderately weathered; moderately hard; very intensely fractured.
2190	-light gray.
2180	
2170	

Elevation	Notes
2200	
2190	
2180	
2170	

PROFILE
 Horiz: 1" = 20'
 Vert: 1" = 10'

989+50 990+50

Boring terminated at Elev 2173.8'
 ERI = 68%

ENGINEERING SERVICES		MATERIALS AND GEOTECHNICAL SERVICES		STATE OF CALIFORNIA		DIVISION OF ENGINEERING SERVICES		BRIDGE NO.		SB I-215 CONNECTOR			
FUNCTIONAL SUPERVISOR		DRAWN BY: F. Nguyen 6/11		FIELD INVESTIGATION BY:		DEPARTMENT OF TRANSPORTATION		NEW		LOG OF TEST BORINGS 1 OF 4			
NAME: A. Perez-Cobo		CHECKED BY: B. Levine/S. Logeswaran		D. Cook				R14.64					
06S CIVIL LOG OF TEST BORINGS SHEET		ORIGINAL SCALE IN INCHES FOR REDUCED PLANS		UNIT: 3643		PROJECT NUMBER & PHASE: 08000003660		CONTRACT NO.: 08-0K7100		DISREGARD PRINTS BEARING EARLIER REVISION DATES		REVISION DATES	
										08-28-11 10-24-11		SHEET OF	
												X X	

BENCH MARK

PNO 173 2120.910
 FD STD Brass disk in concrete stamped
 "SBD-215-173 1988" 40' Ely of EOD Devore
 Rd Bridge at Nly end bridge; 70' Nly of EP
 NB SBD 215 at PM 17.3 at top of slope.

PNO 2010 2179.090
 FD STD Brass disk in concrete stamped
 "D8 SCN SBD-15 PM 16.3 08.04.08" At top
 of slope SOUTH of Connector Bridge
 from NB SBD 15 to NB SBD 215.

DIST	COUNTY	ROUTE	POST MILES TOTAL PROJECT	SHEET NO	TOTAL SHEETS
08	SBd	15			



10-12-11
 CERTIFIED ENGINEERING GEOLOGIST

K. Douglas Cook
 No. 1391
 Exp. 12-31-11
 CERTIFIED ENGINEERING GEOLOGIST
 STATE OF CALIFORNIA

PLANS APPROVAL DATE

The State of California or its officers or agents shall not be responsible for the accuracy or completeness of electronic copies of this plan sheet.

Note: No ground water encountered during field investigation.

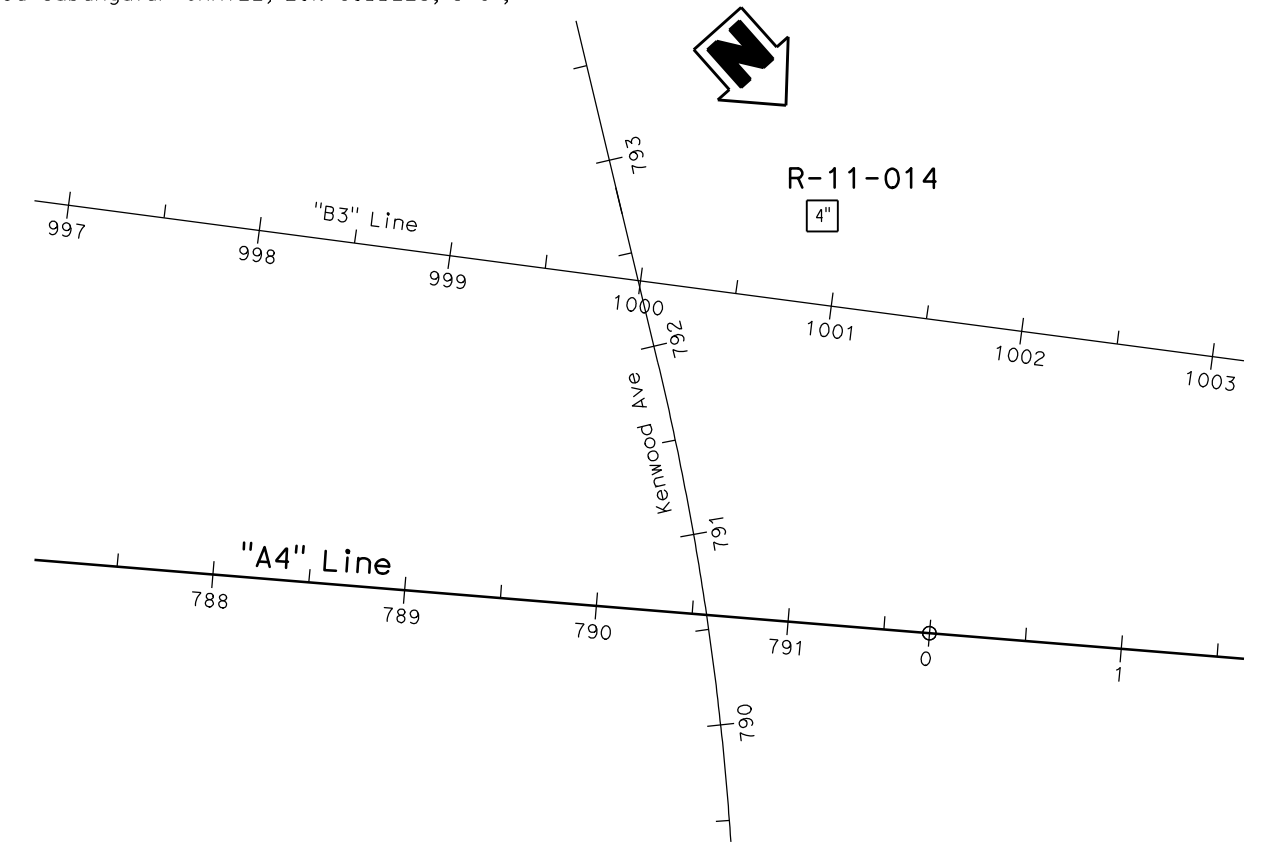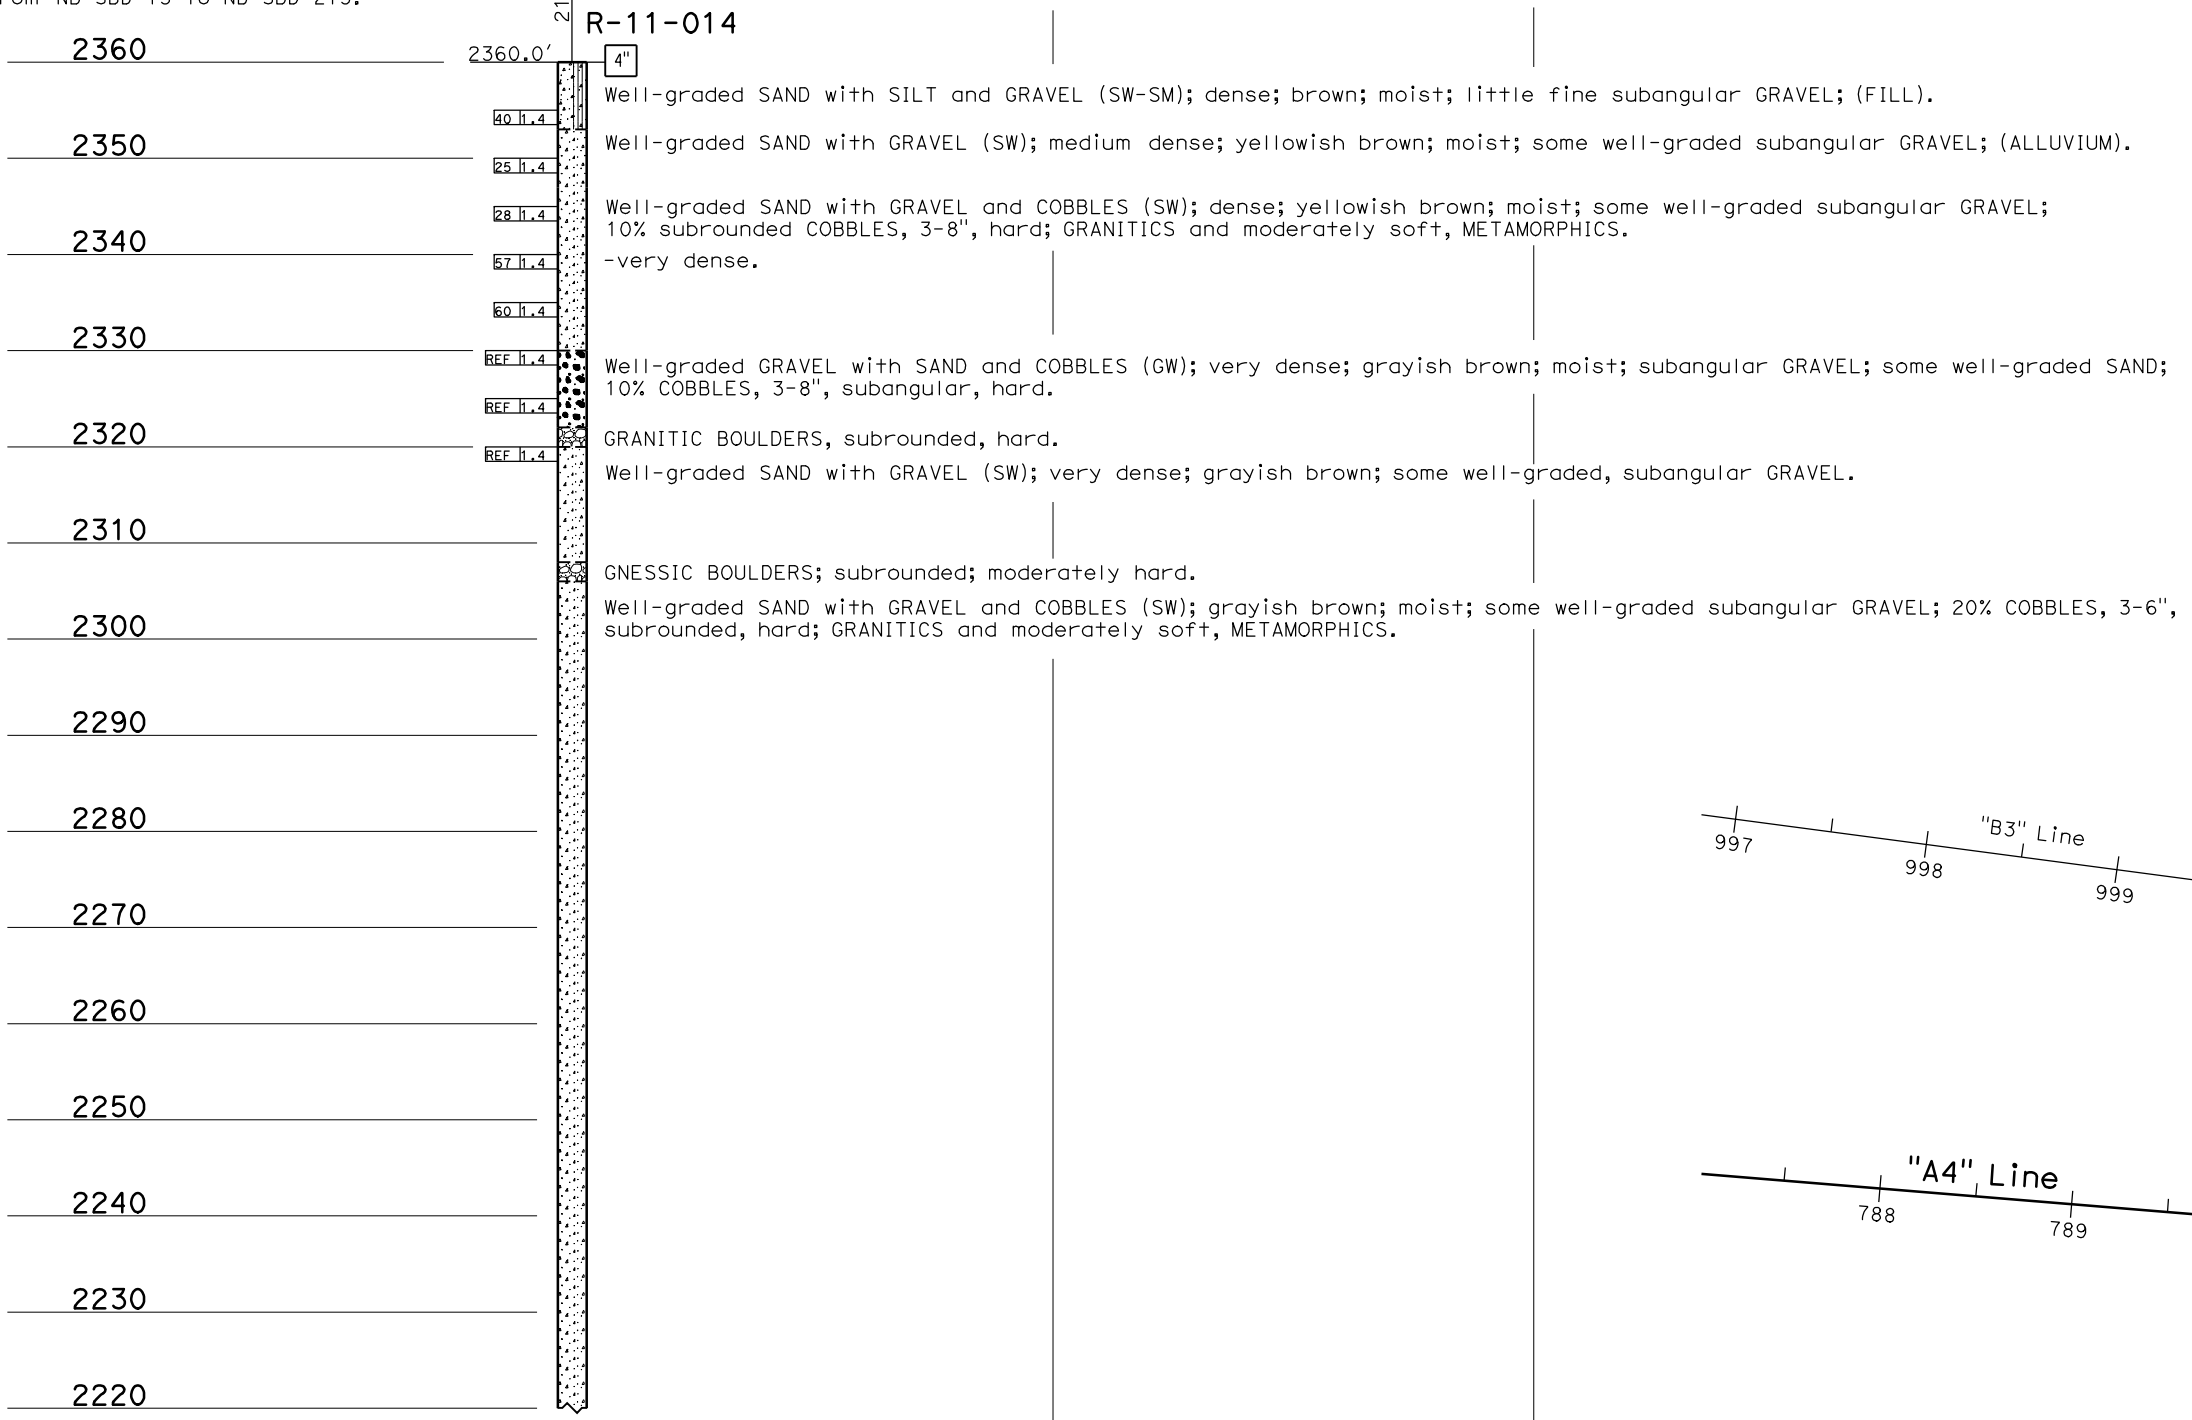

PLAN
 1" = 50'

PROFILE

Horiz: 1" = 10'
 Vert: 1" = 10'

2-2-11
 Terminated at Elev 2220.0'

ERi = 68%

791+00

791+50

792+00

ENGINEERING SERVICES		MATERIALS AND GEOTECHNICAL SERVICES		STATE OF CALIFORNIA		DIVISION OF ENGINEERING SERVICES		BRIDGE NO.		SB 215 MAINLINE AND SB 15	
FUNCTIONAL SUPERVISOR		DRAWN BY: W. Tang 06/11		DEPARTMENT OF TRANSPORTATION		STRUCTURE DESIGN		NEW		LOG OF TEST BORINGS 1 OF 3	
NAME: A. Perez-Cobo		CHECKED BY: B. Levine/S. Logeswaran		FIELD INVESTIGATION BY: D. Cook		DESIGN BRANCH X		R15.00			
08S CIVIL LOG OF TEST BORINGS SHEET		ORIGINAL SCALE IN INCHES FOR REDUCED PLANS		UNIT: 3643		PROJECT NUMBER & PHASE: 08000003660		CONTRACT NO.: 08-OK7100		DISREGARD PRINTS BEARING EARLIER REVISION DATES	
				0 1 2 3		FILE => sb215mainline1of3.dgn		REVISION DATES		SHEET OF	
								09-06-11 10-06-11		X X	

USERNAME => s128198 DATE PLOTTED => 21-OCT-2011 TIME PLOTTED => 12:50

Oakie Flats

No As-Builts nor any LOTBs for the Oakie Flats Road Undercrossing, Caltrans Bridge No. 54-0916 can be located within the online Caltrans GEODog database <https://geodog.dot.ca.gov/>.

Cleghorn Creek

FED. ROAD DIST. NO.	STATE	P.A. PROJECT NO.	SHEET NO.	TOTAL SHEETS
7	CALIF.			

DIST.	COUNTY	ROUTE	SECTION	SHEET NO.	TOTAL SHEETS
08	SBD	15	14	336	378

DATE APPROVED: November 28, 1966

SEISMIC RETROFIT PROJECT NO. 434

DIST.	COUNTY	ROUTE	POST MILES - TOTAL PROJECT	SHEET NO.	TOTAL SHEETS
08	SBD	15	R18.5		

STRUCTURAL FOUNDATIONS BRANCH - ENGINEERING SERVICE CENTER

R.C. Doria
REGISTERED ENGINEER-CIVIL


CLEGHORN CREEK BRIDGE

LOG OF TEST BORINGS 2 OF 2

NOTE: THIS LOG OF TEST BORINGS IS AVAILABLE ON MICROFILM AT OFFICE OF STRUCTURES DESIGN SACRAMENTO, CALIFORNIA

CU: 08109 EA: 413501 BRIDGE No. 54-0773

THE STATE OF CALIFORNIA OR ITS OFFICERS OR AGENTS SHALL NOT BE RESPONSIBLE FOR THE ACCURACY OR COMPLETENESS OF ELECTRONIC COPIES OF THIS PLAN SHEET.

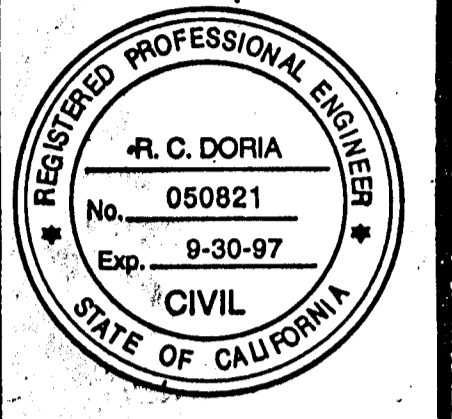


LEGEND OF BORING OPERATIONS

1" SOIL TUBE

PHENOMETER
2 1/2" CORE PHENOMETER
SAMPLER BORING (SBC)
ROTRARY BORING (RTB)
AUGER BORING (OBY)
JET BORING
CORE BORING
TEST PIT

LEGEND OF EARTH MATERIALS

SILTY CLAY OR CLAYEY SILT
PEAT
ORGANIC MATTER
FILL MATERIAL
GENUINE ROCK
SANDY CLAY OR CLAYEY SAND
SANDY SILT
GRAVEL
SAND
SILT
CLAY
SANDY CLAY OR CLAYEY SAND
SANDY SILT
SILT
CLAY
SANDY CLAY OR CLAYEY SAND
SANDY SILT
GRAVEL
SAND
SILT
CLAY
SANDY CLAY OR CLAYEY SAND
SANDY SILT

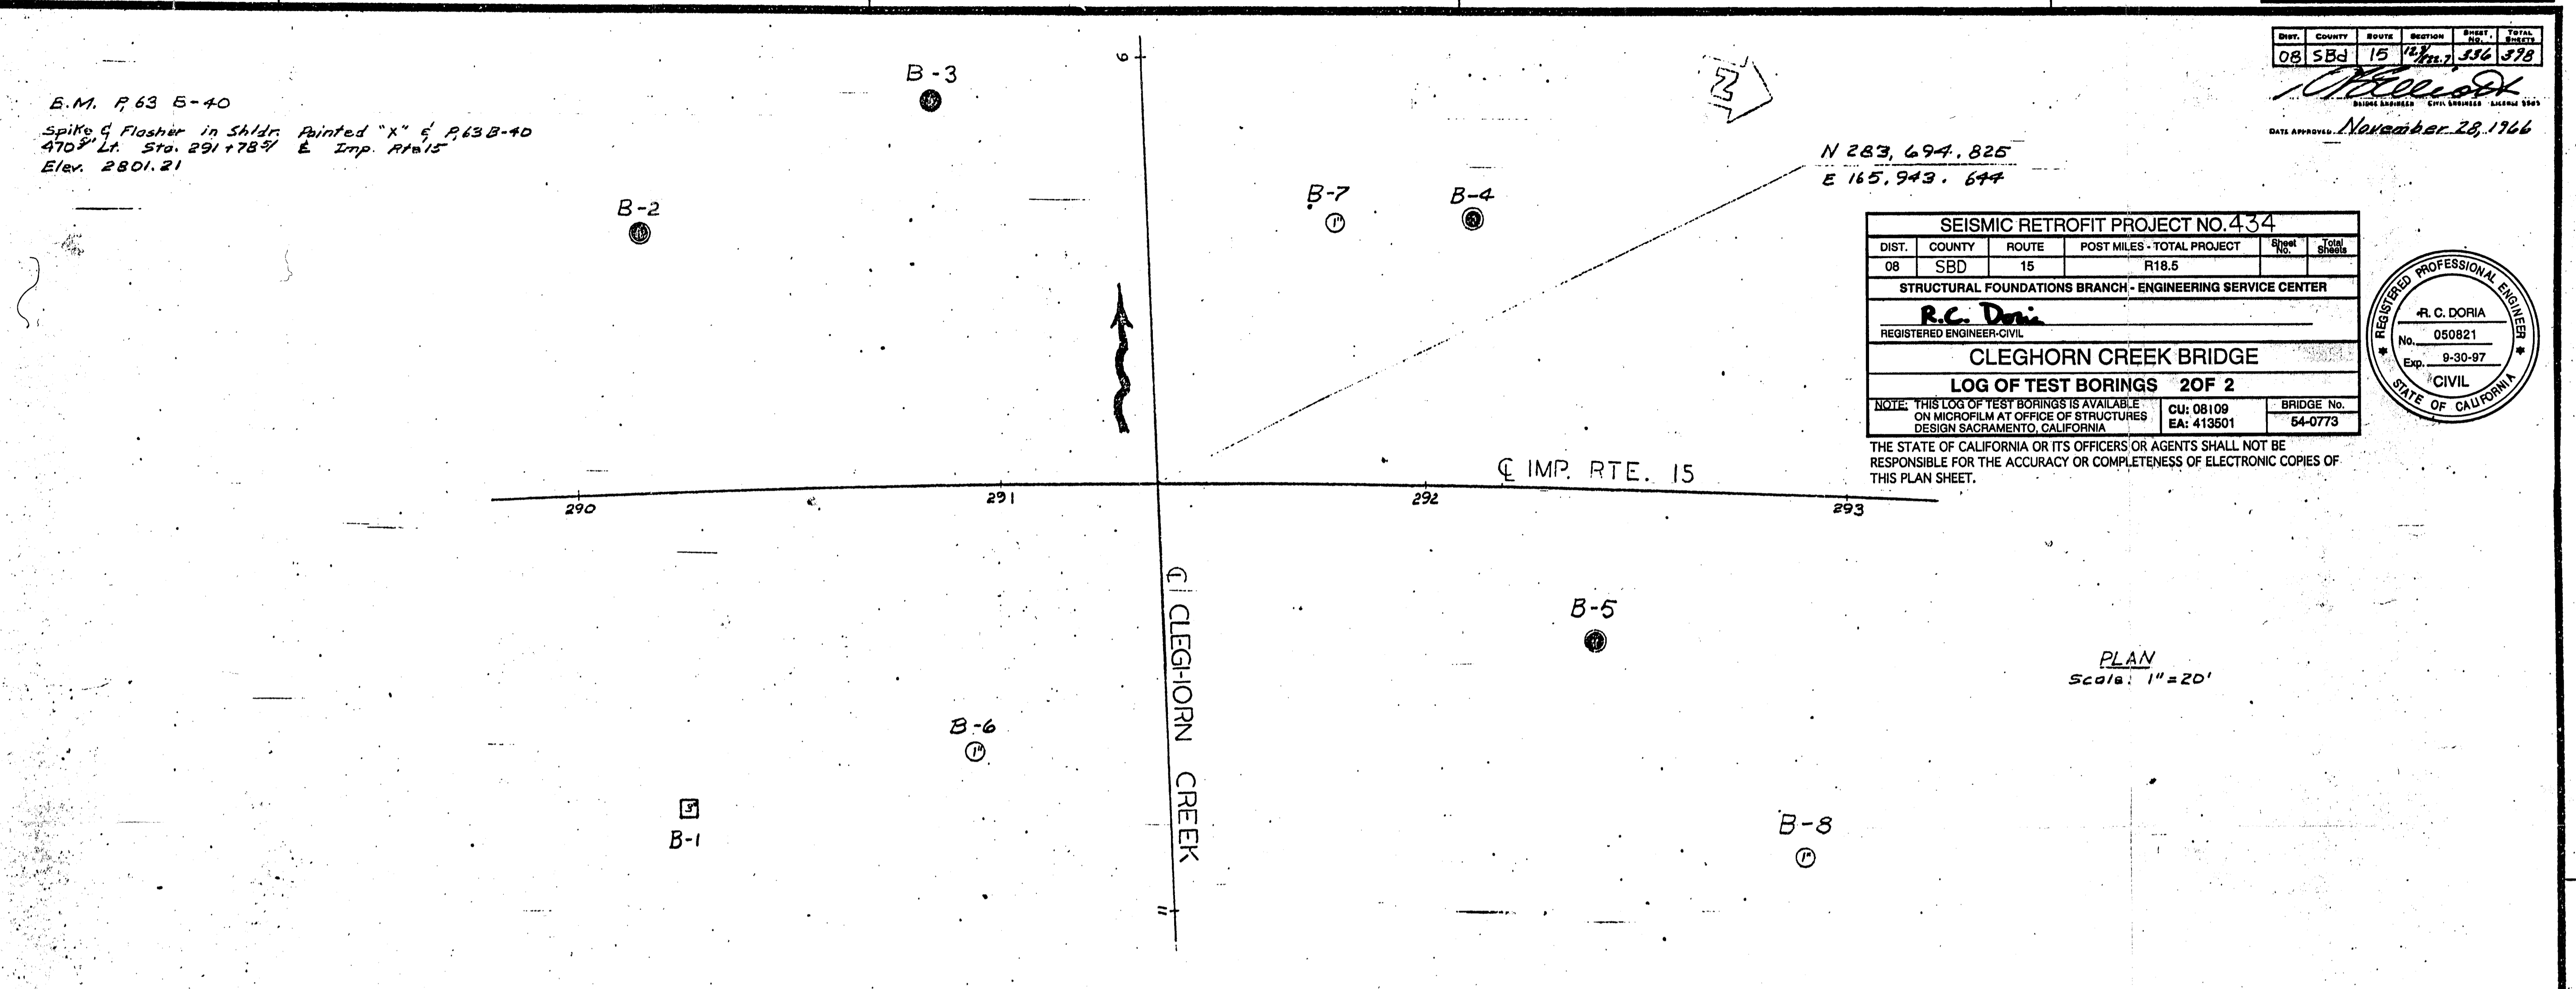

PLAN
Scale: 1"=20'

FIELD STUDY

BY: O. M. KES.	10-7-65
DRAWN BY: G. B. GILG	11-20-66
CHECKED BY: O. M. KES.	12-27-65

Approved: _____


**BRIDGE DEPARTMENT
ENGINEERING GEOLOGY SECTION**

236

NOTE:
Borings Numbered B-1, B-7, B-8 were driving 1" closed tip (COBRA)

AS BUILT PLANS
Contract No. 08-049114
Date Completed 11-10-69
Document No. 80000217

AS BUILT
CORRECTIONS BY _____
CONTRACT NO. _____
DATE _____

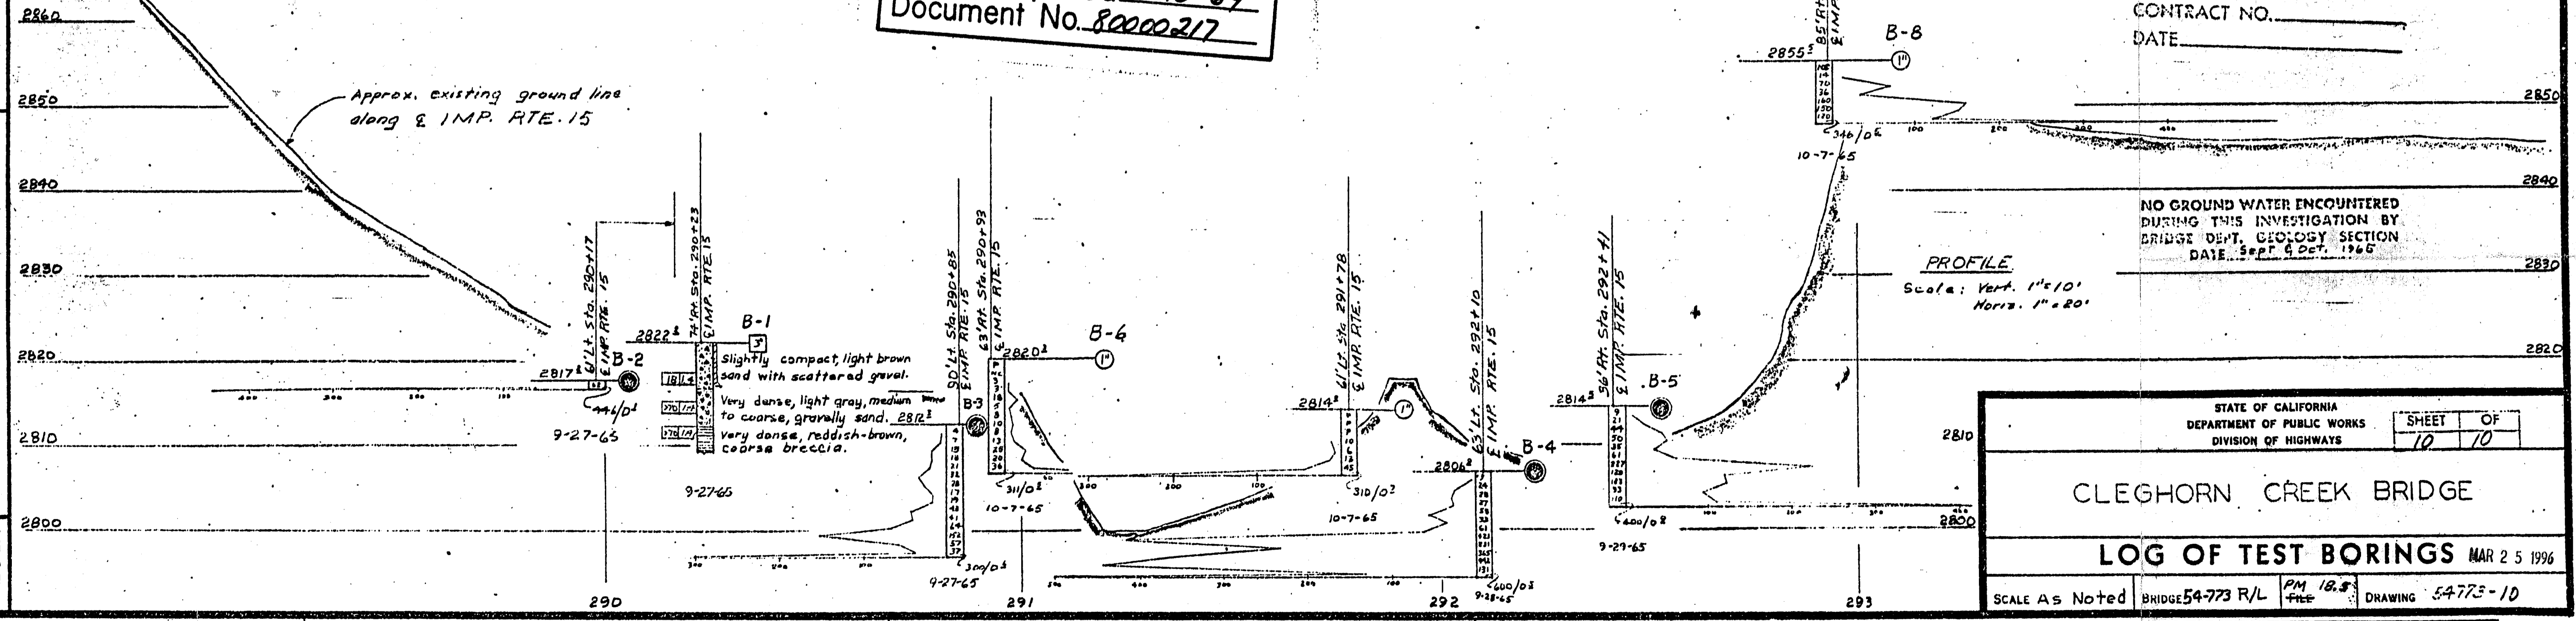

PROFILE
Scale: Vert. 1"=10'
Horiz. 1"=20'

NO GROUND WATER ENCOUNTERED
DURING THIS INVESTIGATION BY
BRIDGE DEPT. GEOLOGY SECTION
DATE: Sept. 4, Oct. 1965

STATE OF CALIFORNIA
DEPARTMENT OF PUBLIC WORKS
DIVISION OF HIGHWAYS

SHEET 10 OF 10

CLEGHORN CREEK BRIDGE

LOG OF TEST BORINGS MAR 25 1996

SCALE As Noted BRIDGE 54-773 R/L PM 18.5 FILE DRAWING 54-773-10

Charge: 08203 WA: 049111 prints bearing earlier numbers PREL. DRAWING NO. FR- _____

LEGEND OF BORING OPERATIONS

LEGEND OF EARTH MATERIALS

GRAVEL	SAND	CLAY	CLAYEY SAND	SANDY SILT	SILT	SILT CLAY
CLAYEY SILT	PEAT AND/OR ORGANIC MATERIAL	FILL MATERIAL	MASSIVE ROCK	SEDIMENTARY ROCK	METAMORPHIC ROCK	METASANDSTONE

CONSISTENCY CLASSIFICATION FOR SOILS


Penetration (Blows Ft)	Granular		Cohesive	
	Very Loose	Loose	Very Soft	Soft
10-19	Slightly compact	Medium dense	Stiff	Very Stiff
20-34	Compact	Dense	Hard	Very Hard
35-59				
>70				

NOTE: Classification of earth material as shown on this sheet is based upon field inspection and is not to be construed to imply mechanical analysis.

ELEVATION	DEPTH (ft)	DESCRIPTION	ELEVATION
2890	0	91' Rt. Sta. 293+13 C/L Rte 15 A. C. pavement and base material.	2890
2880	10	Dense, brown, GRAVELLY (25%), SILTY (25%), fine to medium SAND, moist, fill materials.	2880
2870	20	Dense, brown, GRAVELLY (25%), SILTY (25%), fine to medium SAND, moist, fill materials, intermittent GRAVELLY zones, occasional COBBLES, fill materials.	2870
2860	30	Dense, brown, GRAVELLY (25%), SILTY (25%), fine to medium SAND, moist, fill materials, intermittent GRAVELLY zones, fill.	2860
2850	40	Dense, brown, GRAVELLY (25%), SILTY (25%), fine to medium SAND, moist, fill materials, intermittent GRAVELLY zones, fill.	2850
2840	50	Compact, brown, GRAVELLY (15%), SILTY (35%), fine to medium SAND, moist, fill.	2840
2830	60	Dense, brown, GRAVELLY (20%), SILTY (30%), fine to medium SAND, occasional COBBLES, moist, fill materials.	2830
2820	70	Dense, dark brownish gray, GRAVELLY (30%) SILTY (20%), fine to medium SAND, moist, O.G.	2820
2810	80	Very dense, COBBLE-BOULDER zone.	2810
2800	90	Very dense, brown to dark gray, GRAVELLY (20%), medium to coarse SAND, moist, numerous, COBBLES, occasional BOULDERS.	2800
2790	100	Very dense, gray, GRAVEL-SAND mix (50%-50%), numerous COBBLES and BOULDERS.	2790
2780	110	Very dense, gray, GRAVEL-SAND mixes with abundant COBBLES and BOULDERS.	2780
2770	120	Gray, COBBLES and BOULDERS (75%) with brown SAND and GRAVEL infill.	2770
2760	130	Gray, COBBLES and BOULDERS (30%) with brown SAND and GRAVEL interbeds.	2760
2750	140	SAND with occasional GRAVEL and COBBLES.	2750
2740	150	Brown, GRAVELLY, coarse SAND mixed with GRAVEL and COBBLES (50%-50%).	2740
2730	160	GWS E. 2790.0	2730
2720	170	12-13-95 Gray, GRAVEL interbedded with low plasticity CLAYEY SILT (60%-40%), occasional COBBLES, slightly moist.	2720
2710	180	Gray to dark gray, COBBLES, interbedded with GRAVELLY, low plasticity, CLAYEY SILT, moist, occasional medium to coarse SAND seams, very moist.	2710
	190	Dark gray, interbeds (50%-50%) of SILTY fine to medium SAND and SANDY non plastic SILT, moist.	
	200	Brown to gray, low plasticity, SILTY CLAY, moist, qu=4.25 tsf; interbedded (60%-40%) with GRAVEL-COBBLE-SAND mix.	
	210	GRAVELLY (20%), COBBLY (10%) SAND (70%).	
	220	Greenish brown, low plasticity, CLAYEY SILT, interbedded (50%-50%) with GRAVELLY SAND and occasional COBBLES, moist.	
	230	Very soft to soft, brown, SANDSTONE, fine to medium SAND size particles. Bedrock, friable in part.	
	240	Soft, brown to reddish brown, SANDSTONE, medium to coarse SAND size with GRAVEL size elements, friable.	
	250	Completely decomposed, bluish white, SERPENTINE, interbedded (50%-50%) with moderately hard, bluish white, intensely weathered MARBLE.	
	260	Soft, greenish white, partially decomposed, MARBLE, friable.	
	270	Soft to moderately hard, greenish white, partially decomposed to intensely weathered, MARBLE, partly friable.	
	280	Meta-conglomerate. (Brown SILTY fine SAND with GRAVEL size with soft, reddish brown cementations, dry).	
	290	Meta-conglomerate. (Reddish brown, moderately plastic, SILTY CLAY, moist). Su=1.25 tsf, qu=3.0 tsf	
	300	Soft, white with convoluted blue streaks; SILTY CLAY, qu=4.0 tsf, friable, Meta-conglomerate.	
	310	Moderately soft, reddish brown, highly weathered, moderately fractured, Meta-conglomerate.	
	320	Moderately soft, brownish gray, highly weathered, Meta-conglomerate, slightly fractured.	
	330	Moderately soft, brownish gray, highly weathered, Meta-conglomerate, occasional slickensides, slightly fractured.	
	340	Soft to moderately soft, brownish gray, Meta-conglomerate, completely decomposed layer consisting of medium SAND to GRAVEL; from elev. 2713.6 to elev. 2712.3, soft intervals are friable.	

BENCH MARK

TBM ELEV. 2890.54'
FD. POINT ON A.C. SHOULDER LOCATED ±96' RT.
292+90 C/L RTE 15. BASED ON GRID GRADE
ELEVATION SHOWN ON "AS BUILT" GENERAL
PLAN, APPROVED 11-28-66

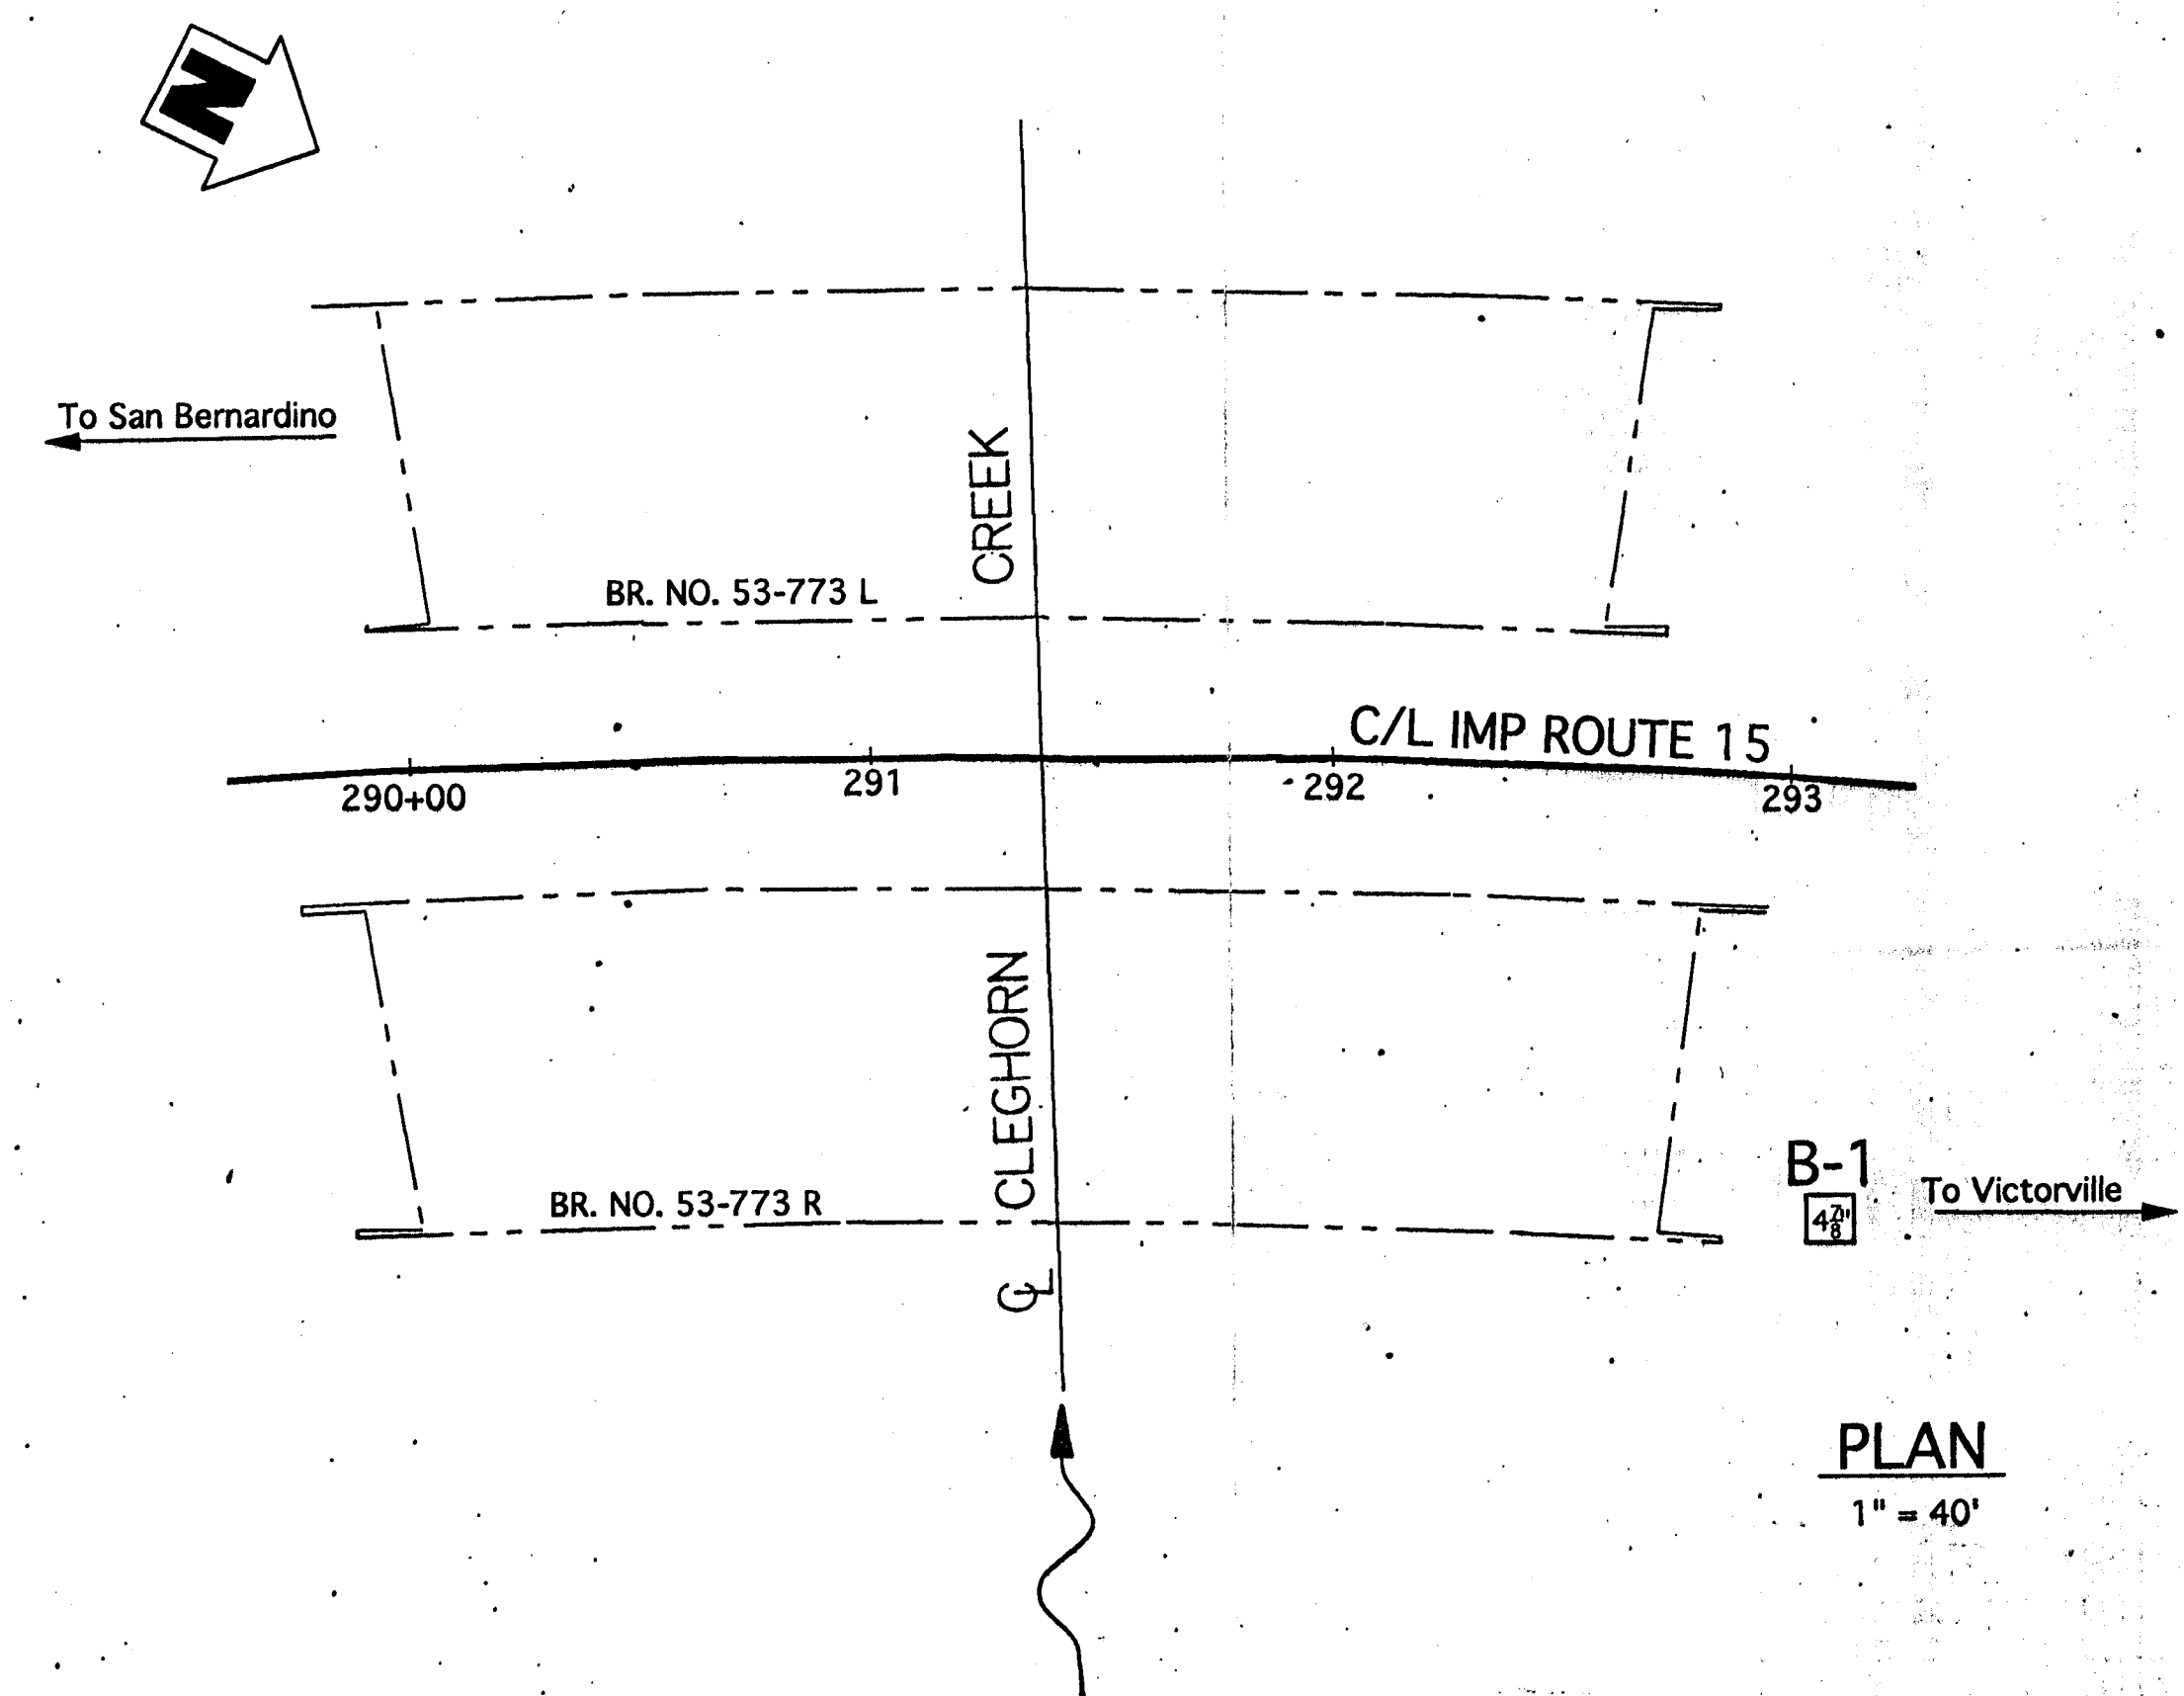

DIST	COUNTY	ROUTE	POST MILES TOTAL PROJECT	SHEET NO.	TOTAL SHEETS
08	SBd	15			

R.C. DORIA
REGISTERED ENGINEER

PROFESSIONAL ENGINEER
R. C. DORIA
No. 50821
Exp. 9-30-97
CIVIL
STATE OF CALIFORNIA

PLANS APPROVAL DATE

THE STATE OF CALIFORNIA OR ITS OFFICERS OR AGENTS SHALL NOT BE RESPONSIBLE FOR THE ACCURACY OR COMPLETENESS OF ELECTRONIC COPIES OF THIS PLAN SHEET.

PLAN
1" = 40'

PROFILE
1" = 10'

ENGINEERING SERVICE CENTER	STRUCTURE FOUNDATIONS	FIELD INVESTIGATION BY: R. DORIA	State of CALIFORNIA DEPARTMENT OF TRANSPORTATION	DIVISION OF STRUCTURES STRUCTURE DESIGN	BRIDGE NO. 54-0773 POST MILE R.18.5	SEISMIC RETROFIT PROJECT NO. 434	CLEGHORN CREEK BRIDGE MAR 25 1996	LOG OF TEST BORINGS	1 OF 2
DRAWN BY K. Wall	2/96								
CHECKED BY									

CU: 08109
EA: 413501

DISREGARD PRINTS BEARING EARLIER REVISION DATES

REVISION DATES (PRELIMINARY STAGE ONLY)

NO.	DATE	DESCRIPTION

SHEET OF

Debris Cone Creek

PRINTED ON 1025 PAPER/CLOTH

FED. ROAD DIV. NO.	STATE	F. A. PROJECT NO.	SHEET NO.	TOTAL SHEETS
7	CALIF.		318	398

DATE APPROVED November 28, 1966

BRIDGE ENGINEER CIVIL ENGINEER—LICENSE 5084

LEGEND OF BORING OPERATIONS

	24" CONE PENETROMETER
	24" SAMPLER BORING (SB)
	ROTARY BORING (RB)
	AUGER BORING (AB)
	JET BORING
	CORE BORING
	TEST PIT

LEGEND OF EARTH MATERIALS

	SILTY CLAY OR CLAYEY SILT
	PEATY MATTER
	ORGANIC MATTER
	FILL MATERIAL
	IGNEOUS ROCK
	SEDIMENTARY ROCK
	METAMORPHIC ROCK
	GRAVEL
	SAND
	SILT
	CLAY
	SANDY CLAY OR CLAYEY SAND
	SILTY SAND OR SILTY CLAY

CLASSIFICATION OF MATERIAL BASED ON STANDARD GRADE SIZE LIMITS

Divisions showing the basis for estimates of size distribution used in determining the classification of material.


GRAVEL	SAND	SILT	CLAY
75 to 100%	75 to 100%	75 to 100%	75 to 100%
50 to 75%	50 to 75%	50 to 75%	50 to 75%
25 to 50%	25 to 50%	25 to 50%	25 to 50%
0 to 25%	0 to 25%	0 to 25%	0 to 25%

NOTE: Classification of earth material as shown on this sheet is based upon field inspection and is not to be construed to imply mechanical analysis.


FIELD STUDY BY G. M. ...
DRAWN BY T. M. ...
CHECKED BY O. M. ...

BRIDGE DEPARTMENT
ENGINEERING GEOLOGY SECTION

348

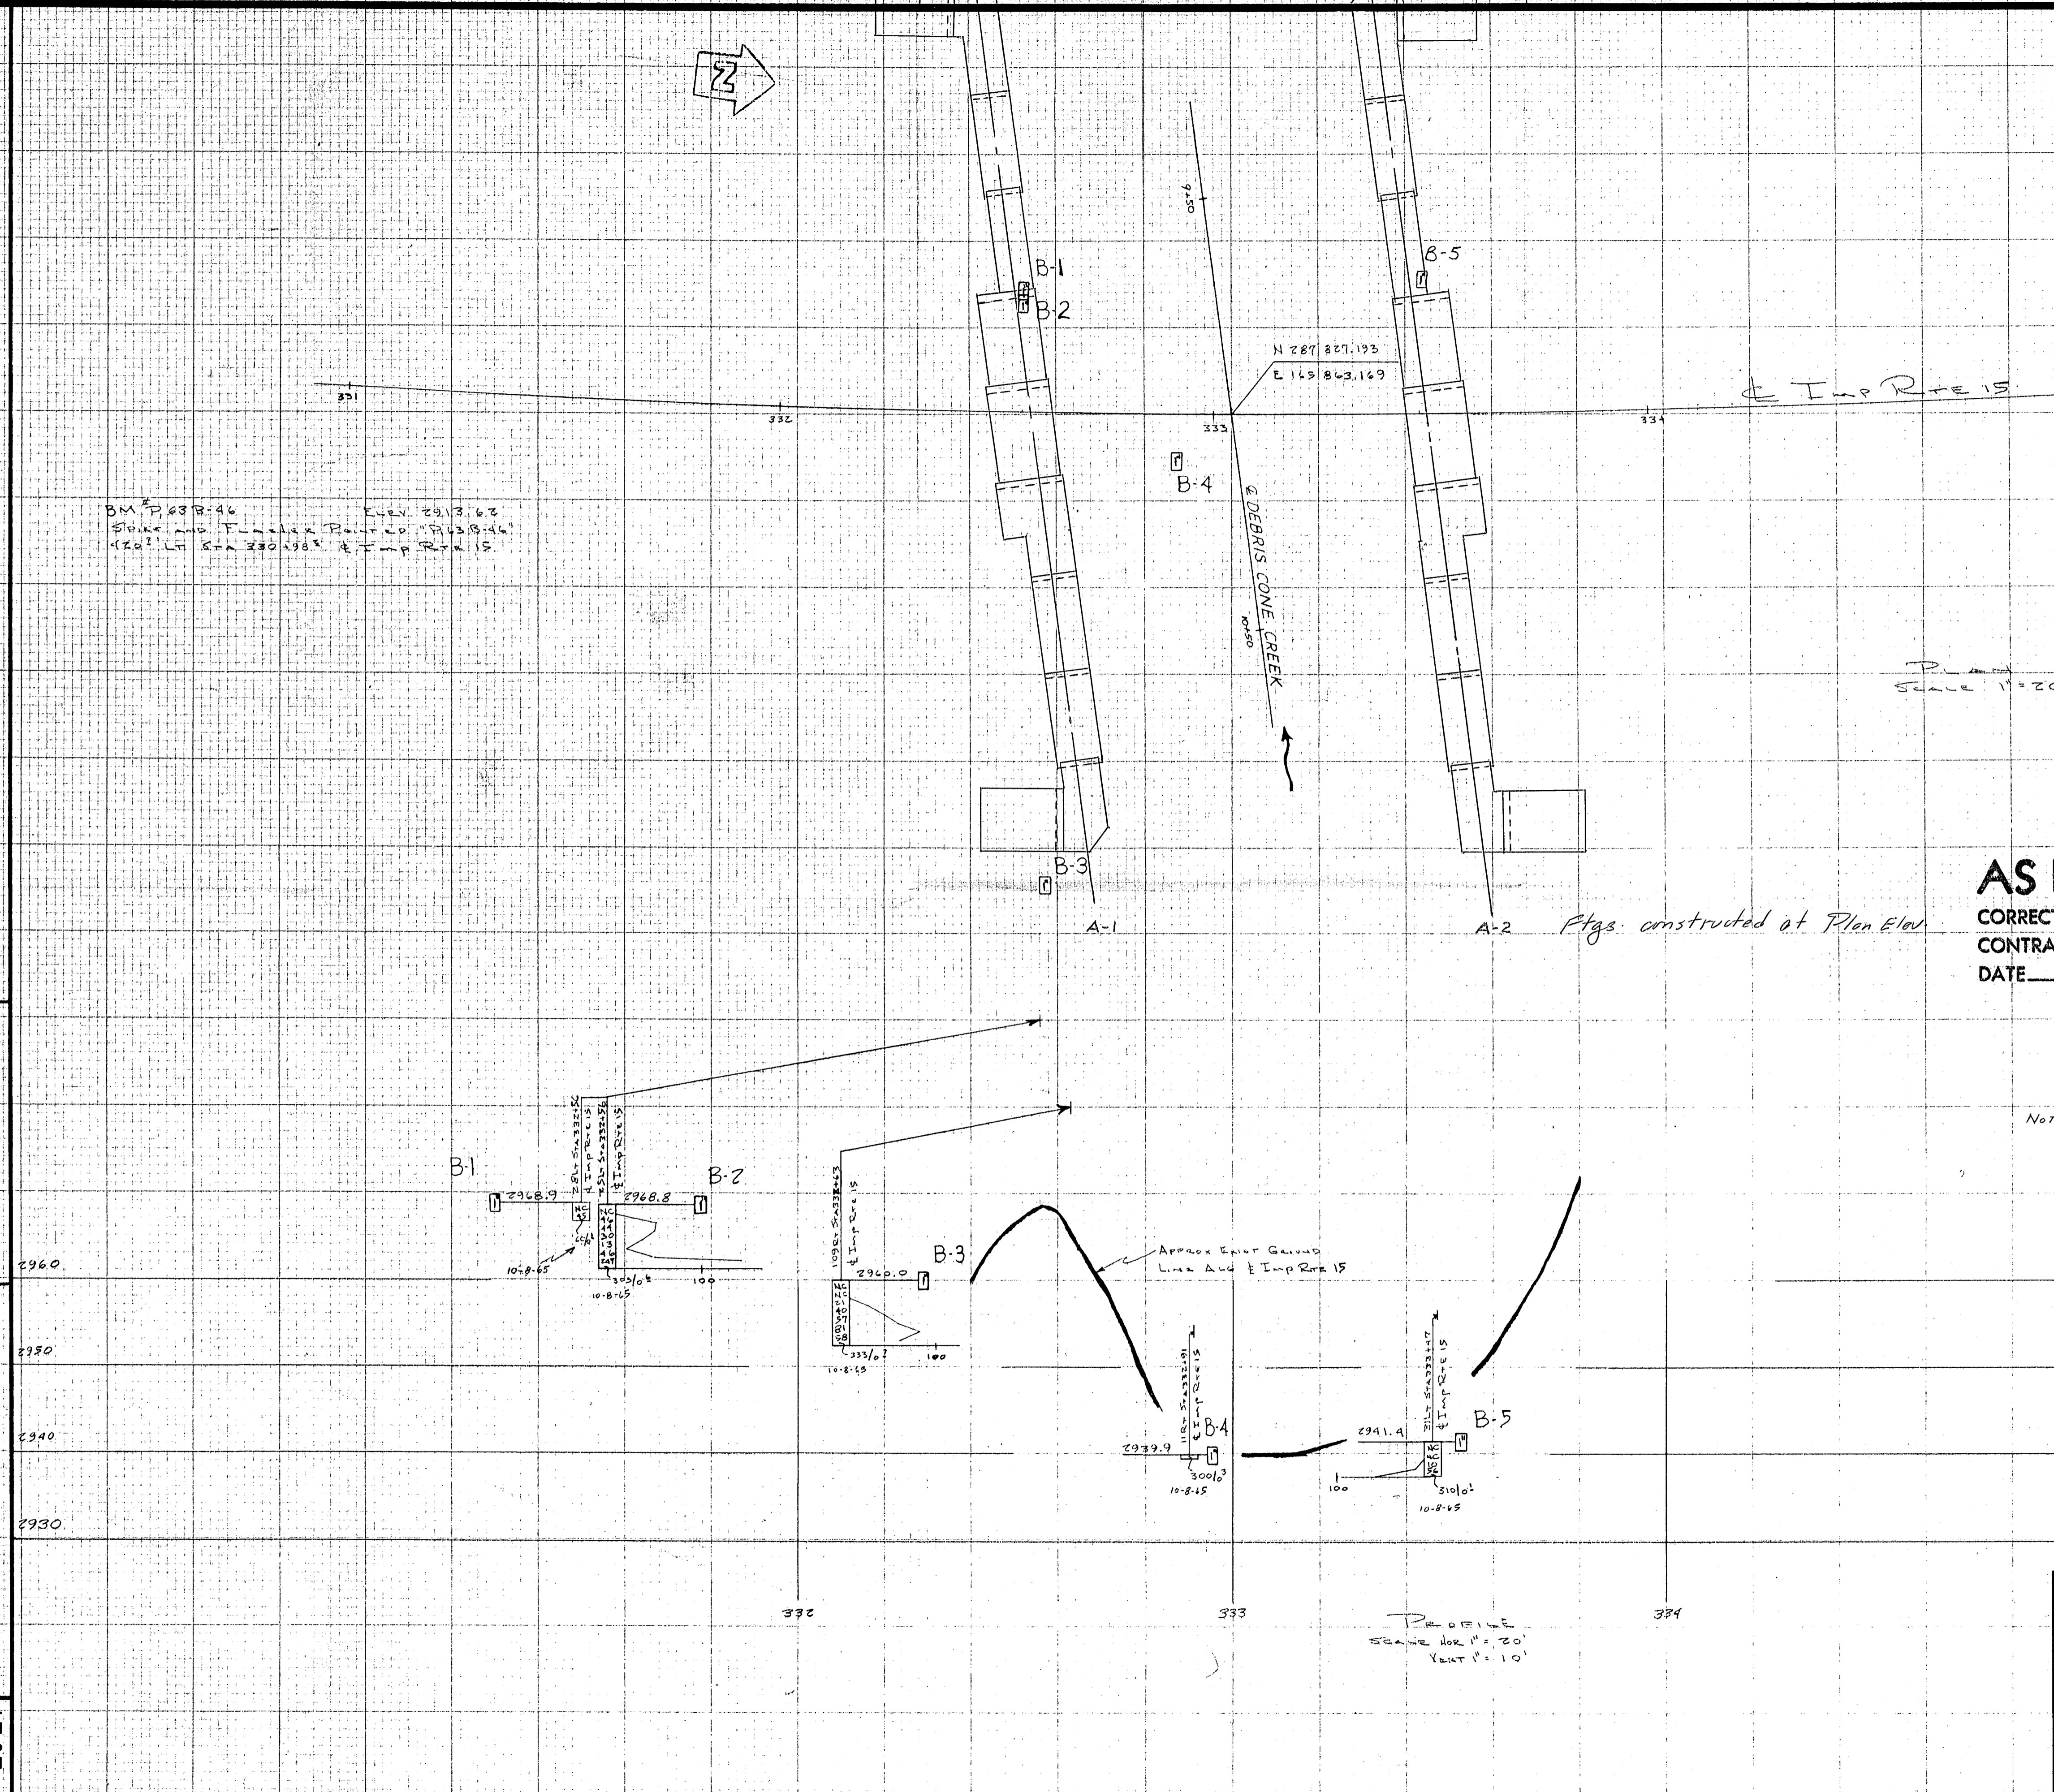

B-1
B-2
B-3
B-4
B-5

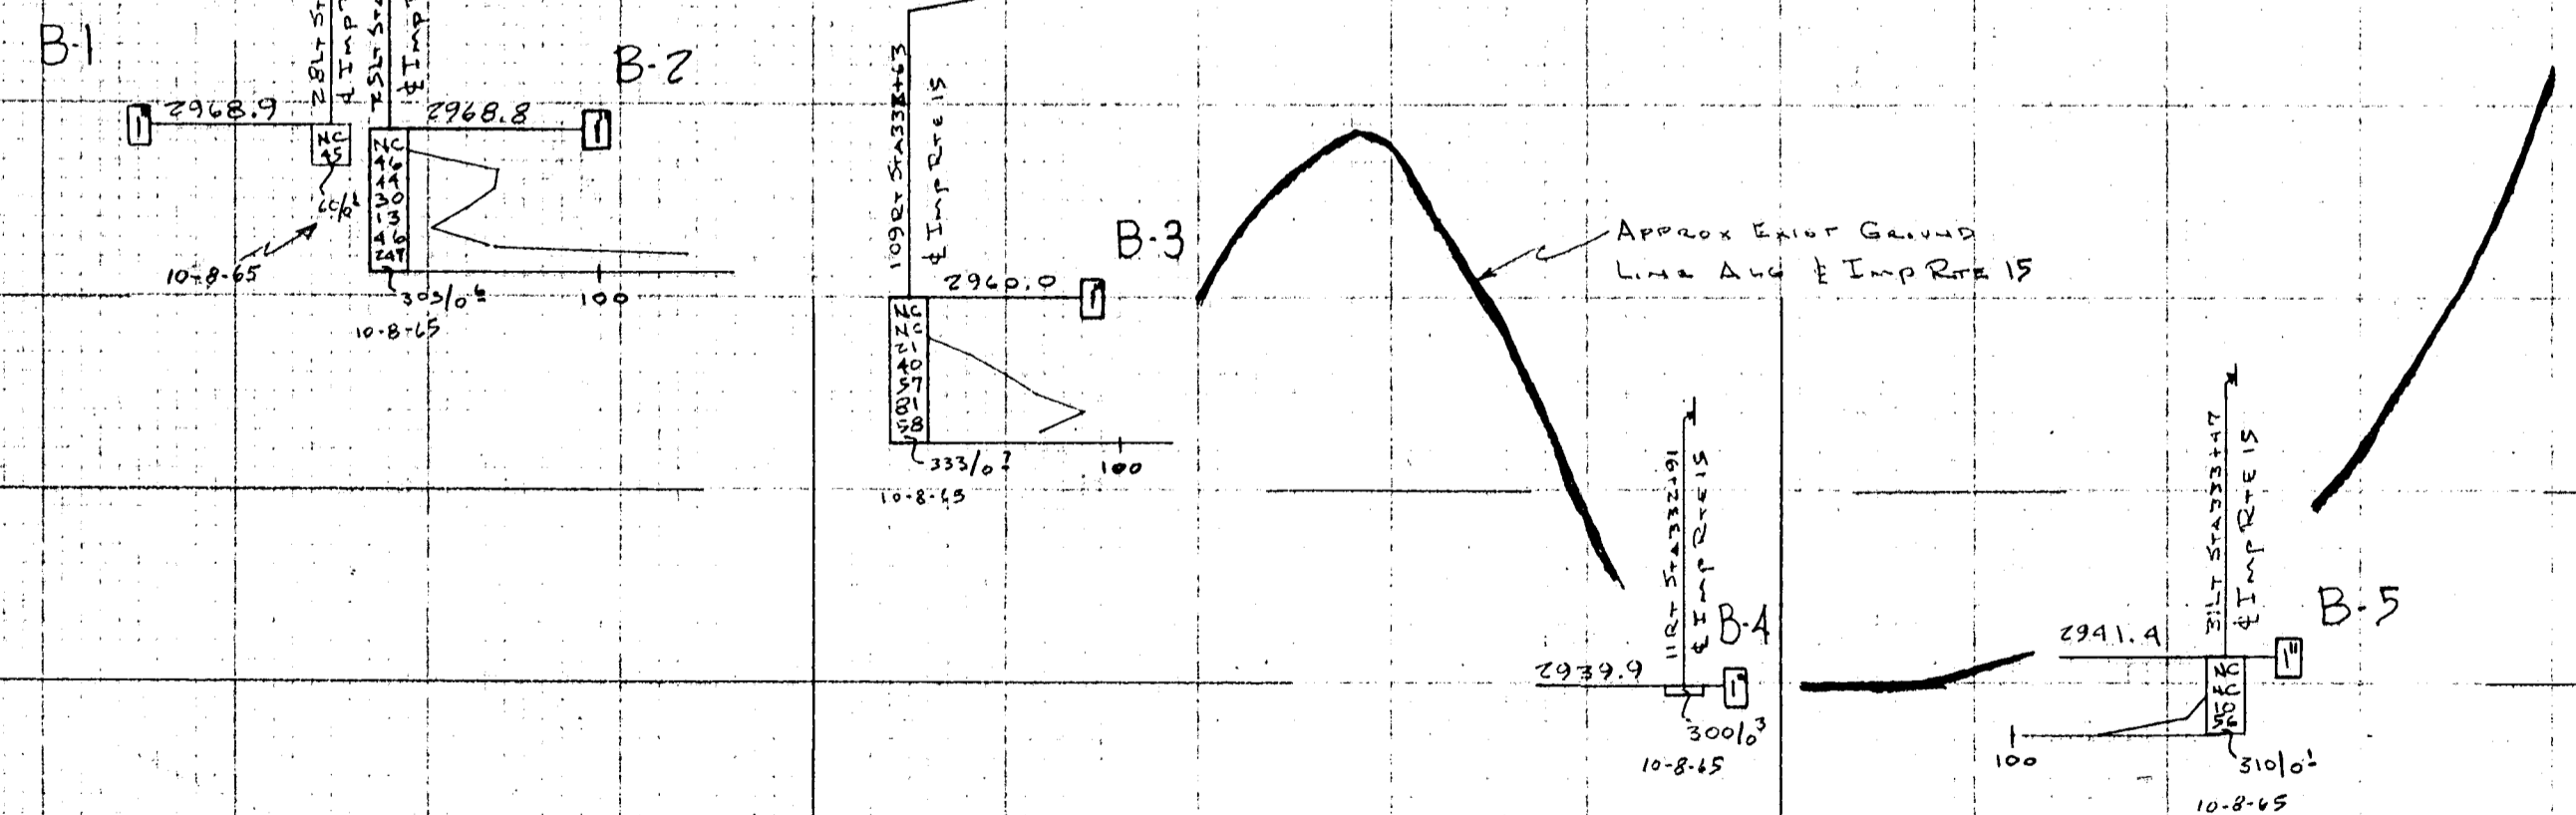

AS BUILT
CORRECTIONS BY J. Whelan
CONTRACT NO. 081049114
DATE 10-16-68

NO GROUND WATER ENCOUNTERED DURING THIS INVESTIGATION BY BRIDGE DEPT., GEOLOGY SECTION DATE OCT 1965

NOTE: All 1" SOIL TUBE BORINGS (COBRA) DRIVEN WITH CLOSED TIP

STATE OF CALIFORNIA
DEPARTMENT OF PUBLIC WORKS
DIVISION OF HIGHWAYS

DEBRIS CONE CREEK
LOG OF TEST BORINGS




SCALE As Noted BRIDGE 54774 RL PM 193 DRAWING 54774-10

SHEET	OF
12	12

Change 08207
W.O. 04911




Disregard prints bearing earlier numbers → PREL. DRAWING NO. PR-

Brush Creek

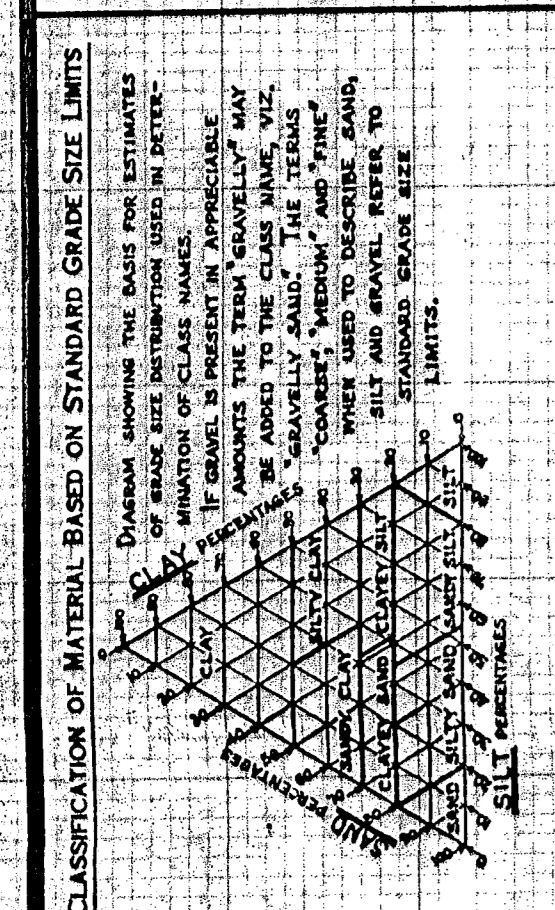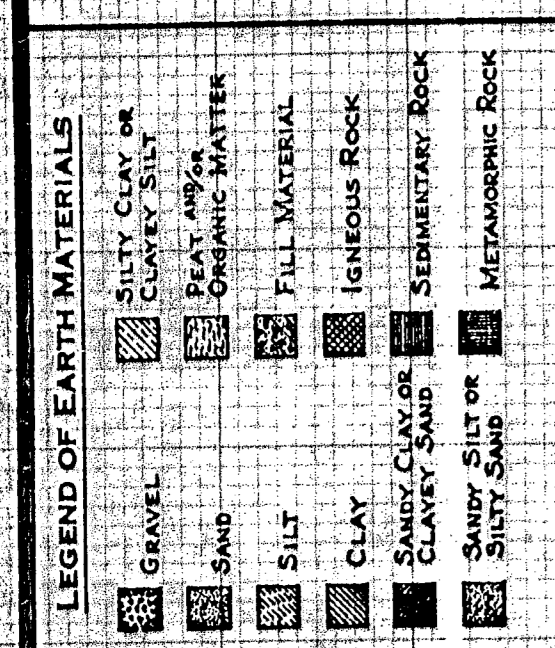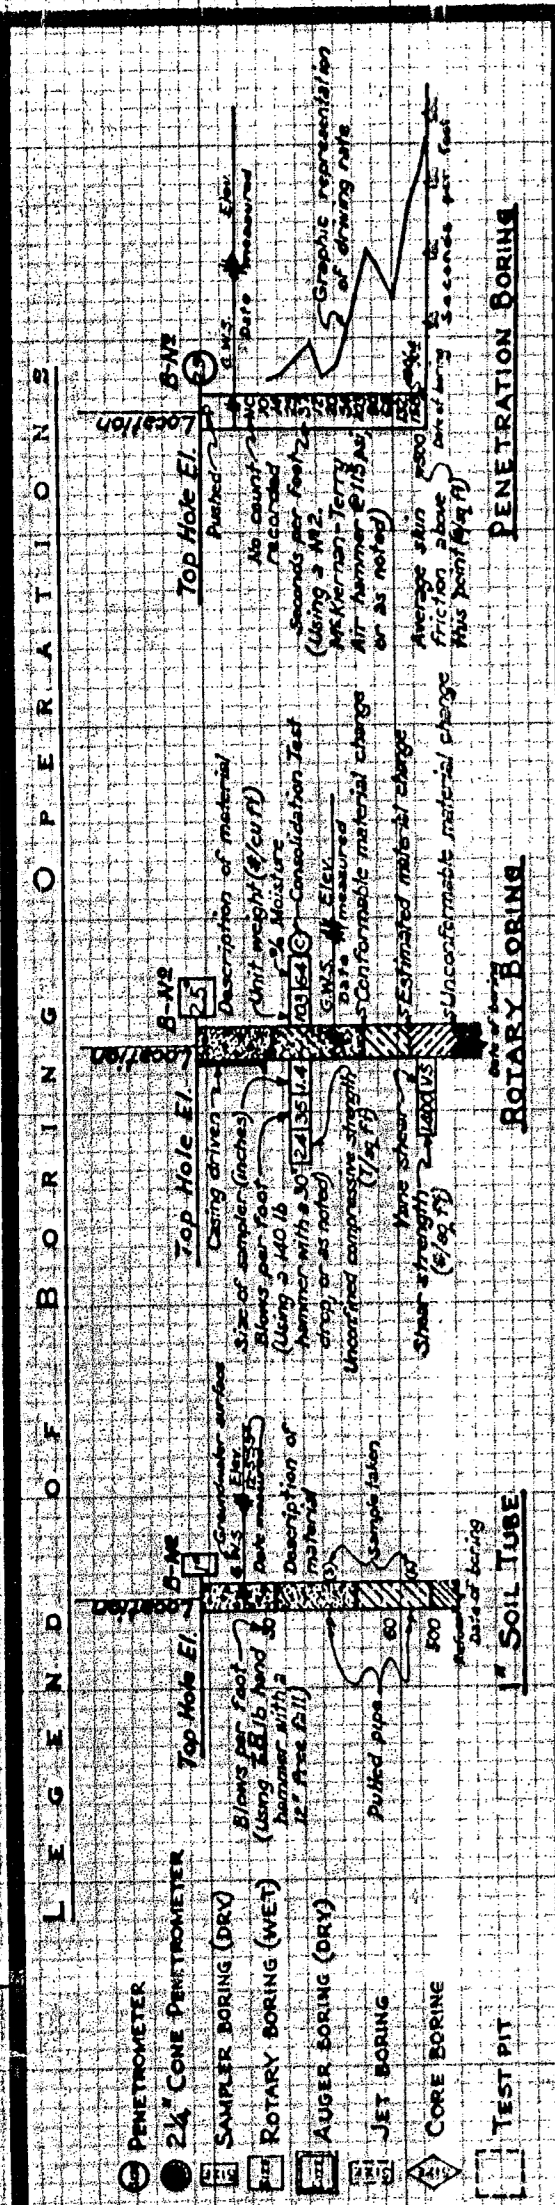

NOTE: Classification of earth material as shown on this sheet is based upon field inspection and is not to be construed to imply mechanical analysis.

BM AT-AG3 ELEV 2928.77
 IN 12 IN WINDMILL WATERMETER
 BIDDING POINT STA 348+98.3 ELEV 2928.77
 BM 50-A-23 ELEV 2935.96
 BATTERY POINT + CAP 4812 L. STA
 219+63.3 ELEV 2928.77

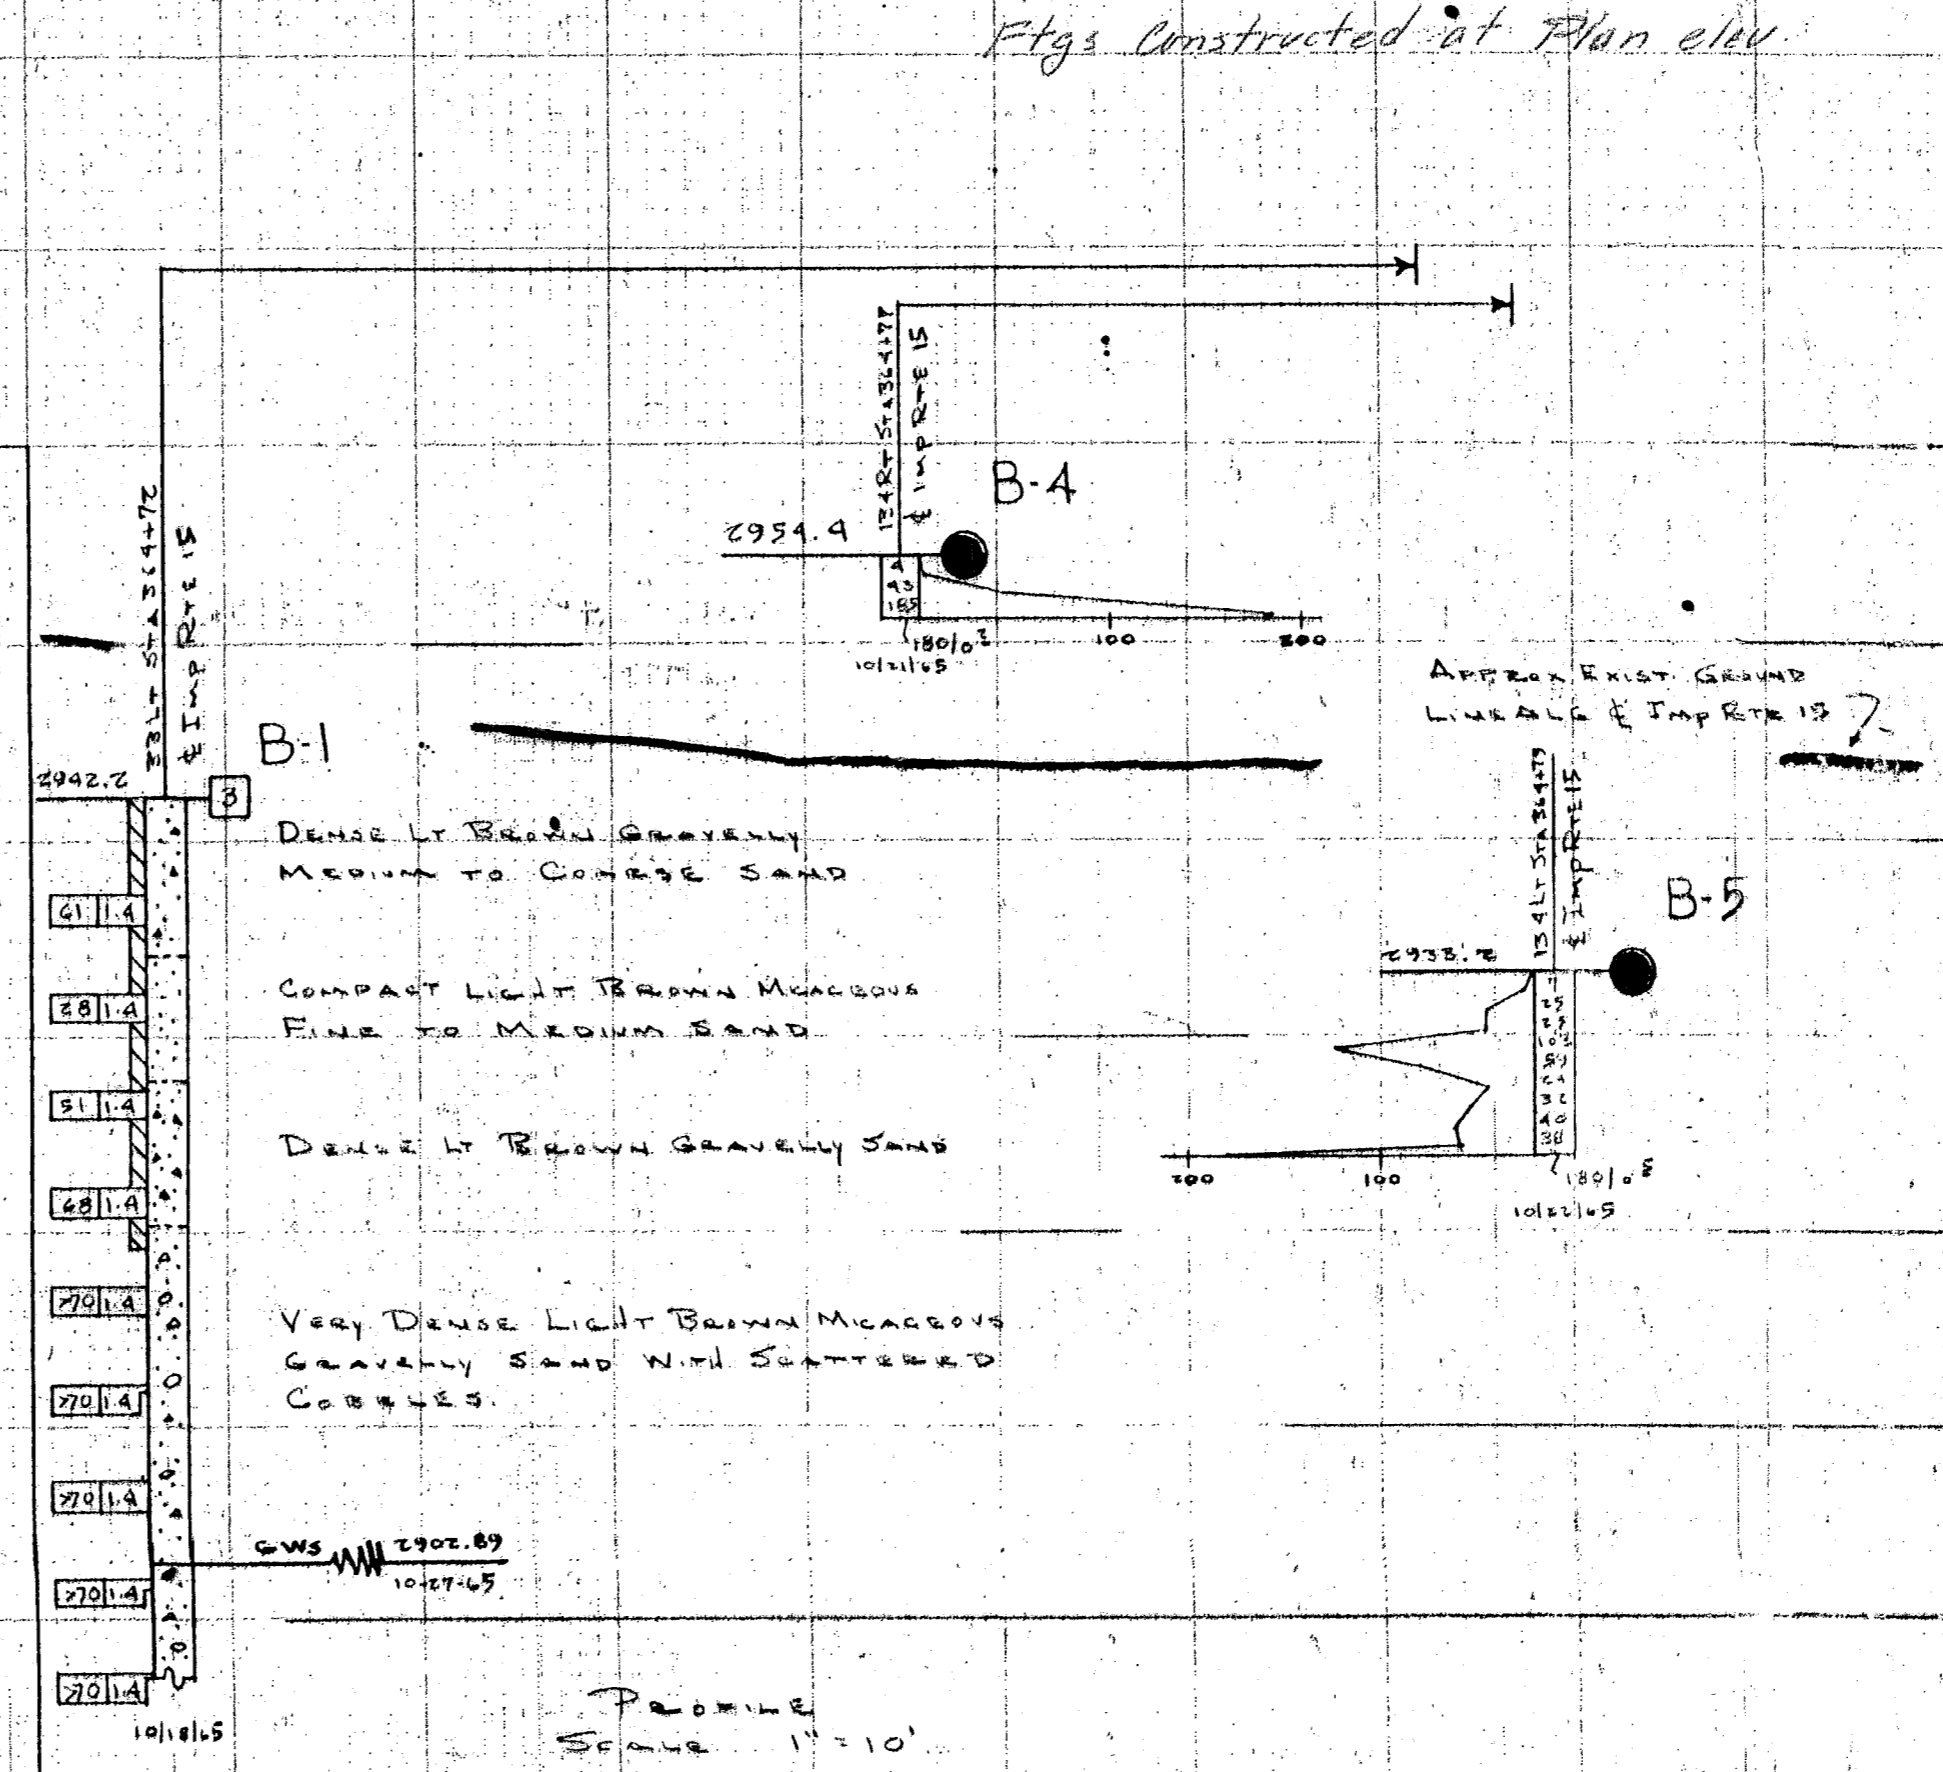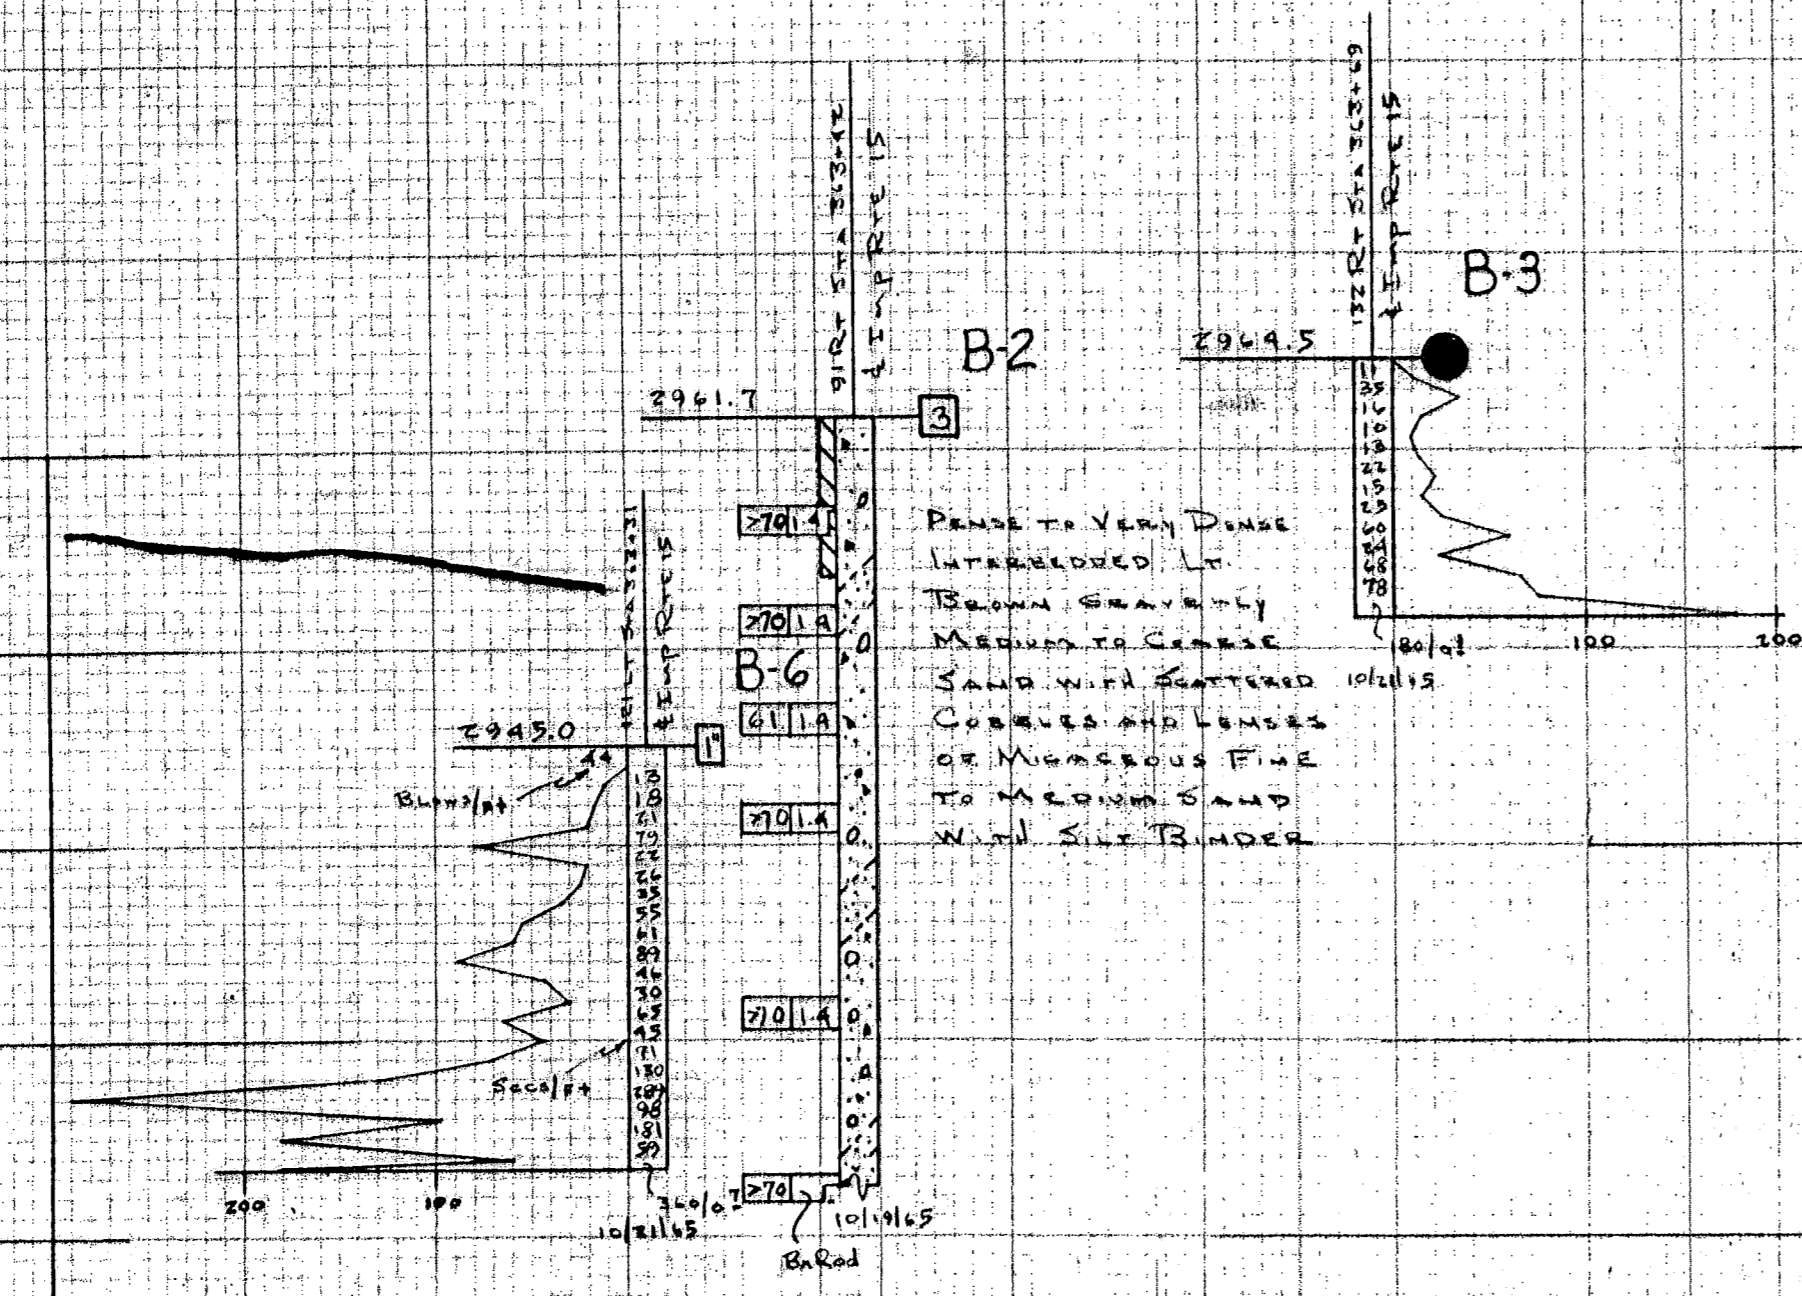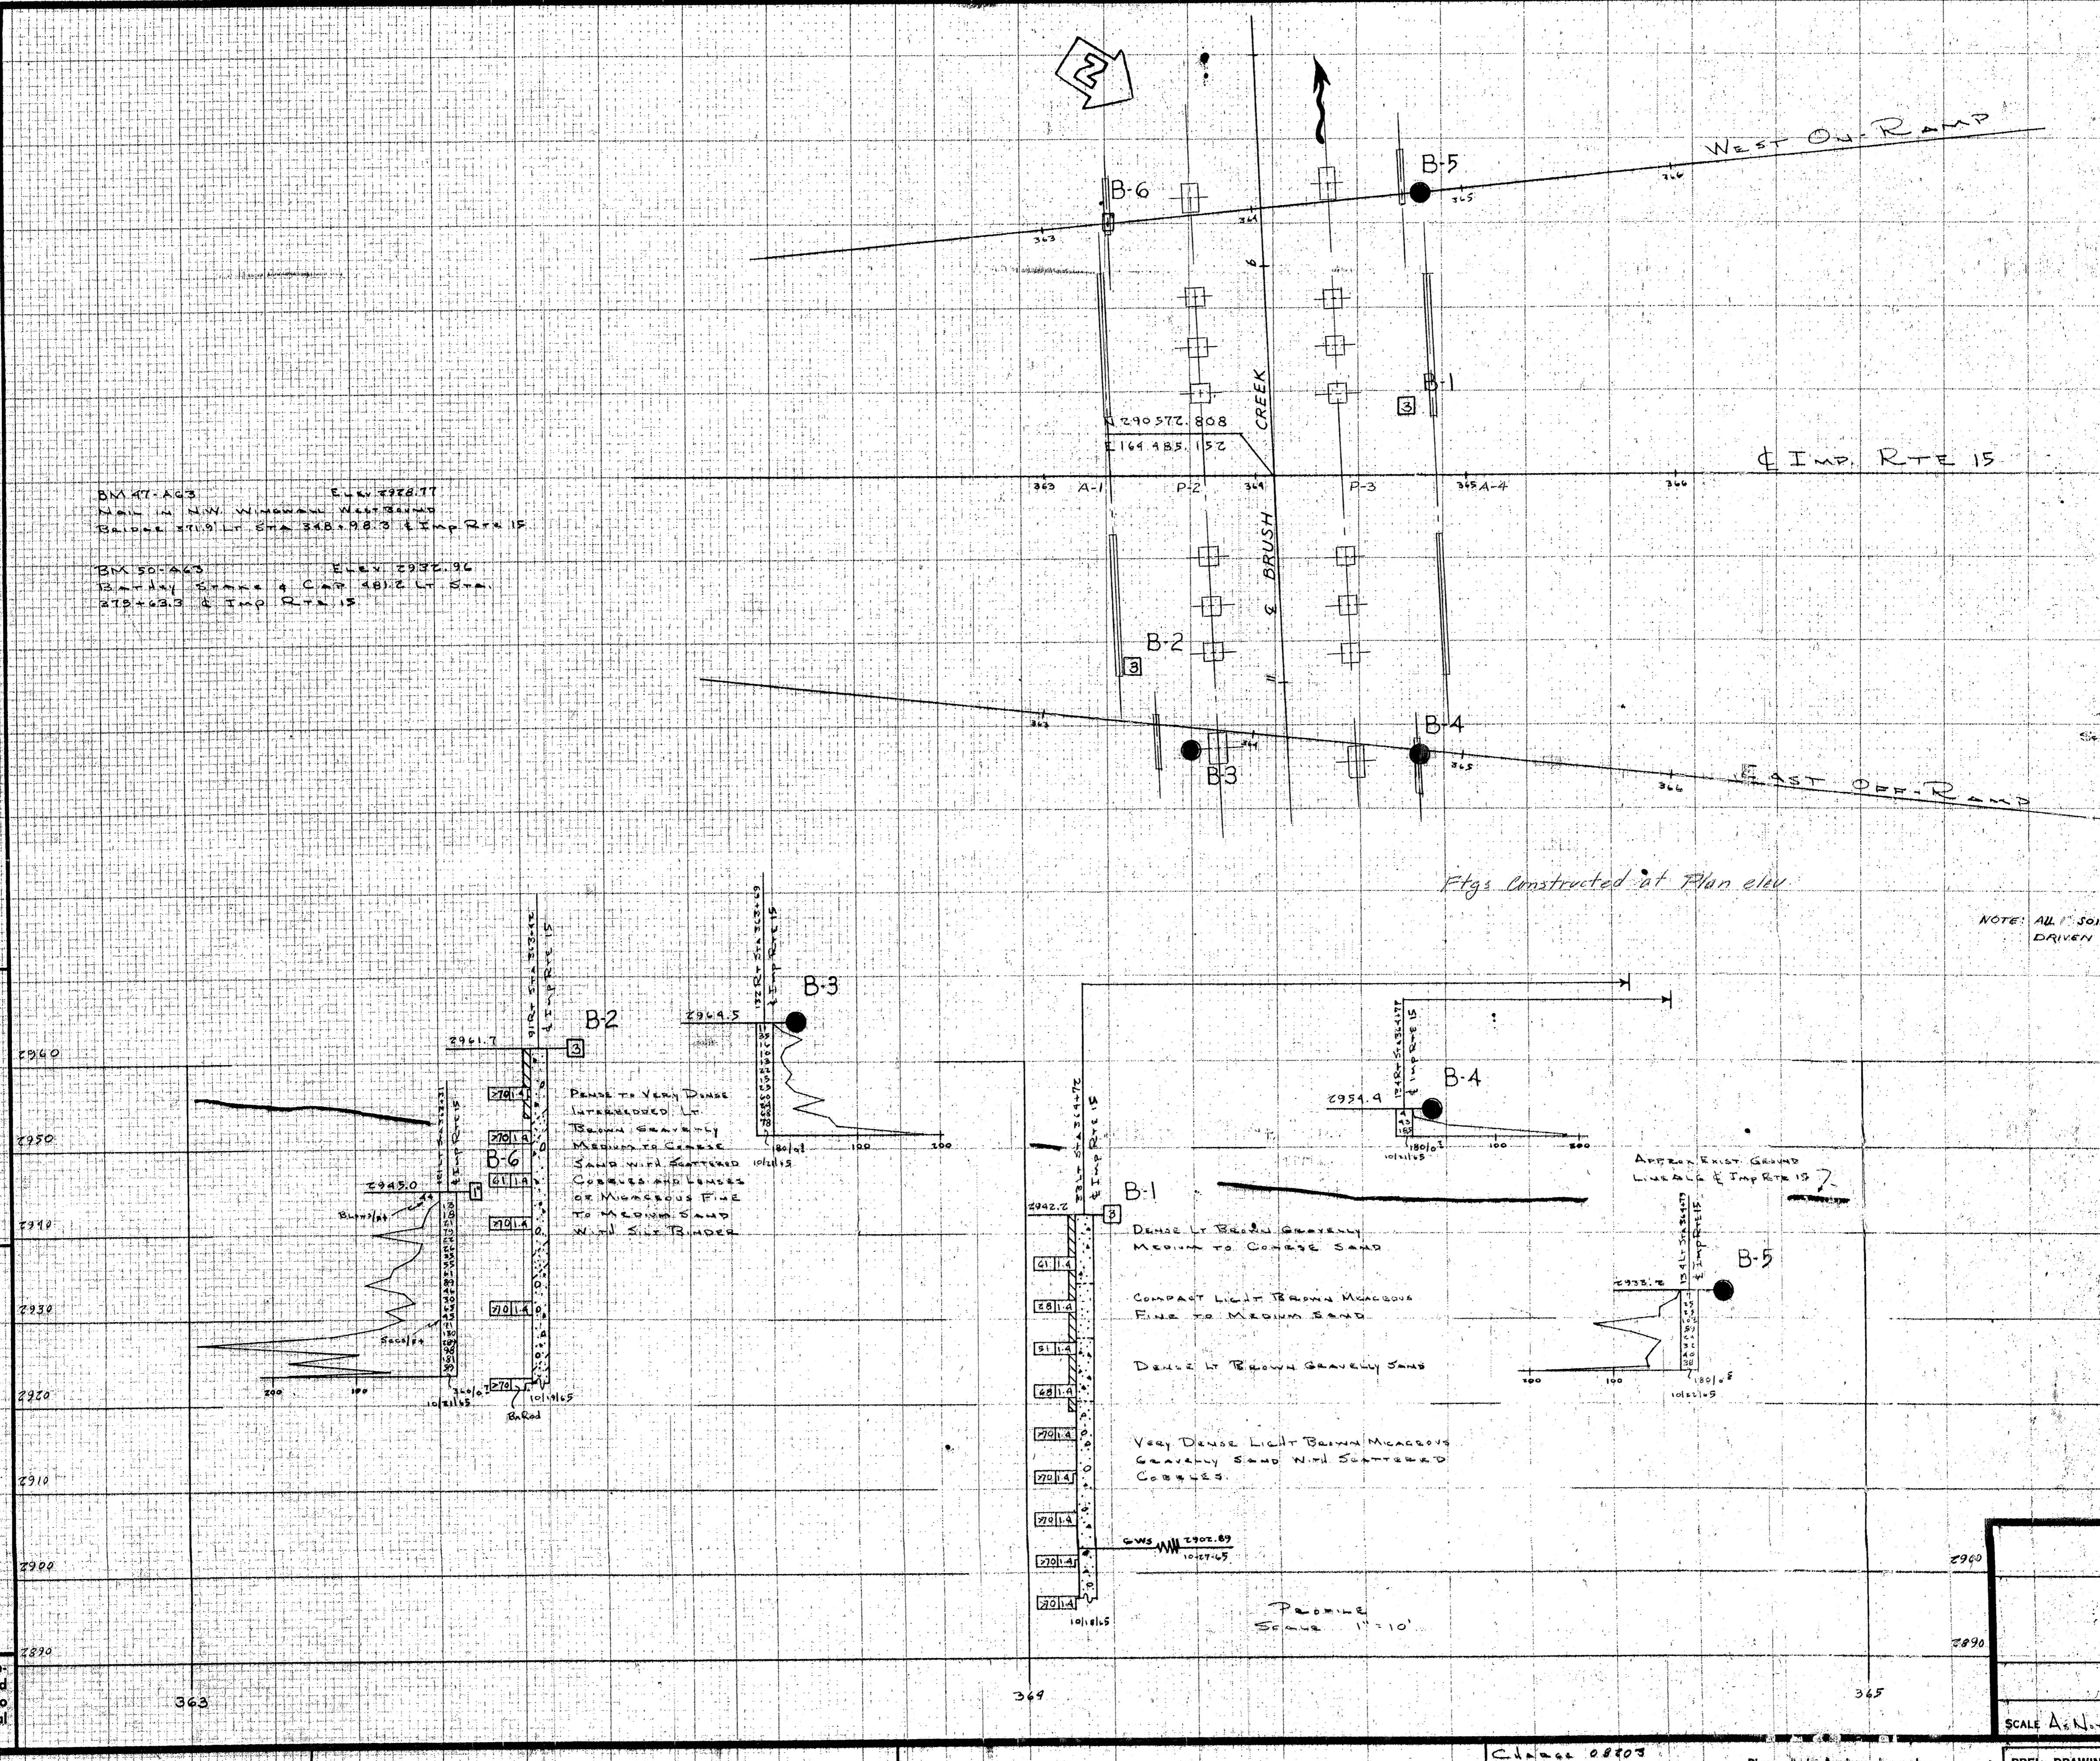

NOTE: ALL 1" SOIL TUBE BORINGS (CORE) DRIVEN WITH CLOSED TIP

AS BUILT
 CORRECTIONS BY *J. Whalen*
 CONTRACT NO. 08-049114
 DATE 10-16-68

STATE OF CALIFORNIA
 DEPARTMENT OF PUBLIC WORKS
 DIVISION OF HIGHWAYS

BRUSH CREEK
LOG OF TEST BORINGS

SCALE: AS NOTED
 BRIDGE: 54-775
 DATE: PM 19.9
 DRAWING: 54116

SHEET 12 OF 12
 PREL. DRAWING NO. PR-

CHECKED BY: O. MIKES 11-15-68
 Approved: *[Signature]*
 Engineering Council

BRIDGE DEPARTMENT
 ENGINEERING GEOLOGY SECTION


Change 08903

Dispersal print: 8 copies each: 1 number

PREL. DRAWING NO. PR-

Cleghorn Canyon Road UC


LEGEND OF BORINGS OPERATIONS

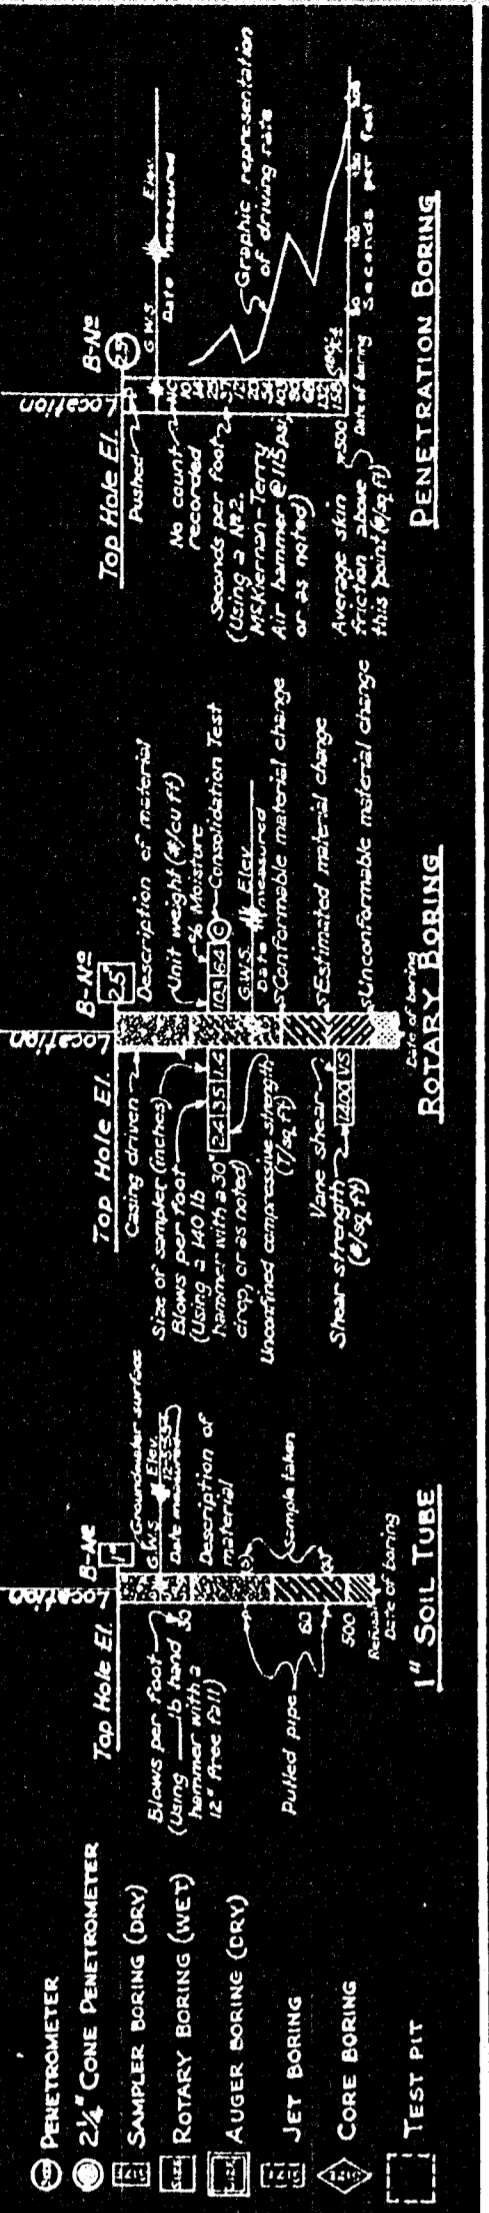

LEGEND OF EARTH MATERIALS



CLASSIFICATION OF MATERIAL BASED ON STANDARD GRADE SIZE LIMITS

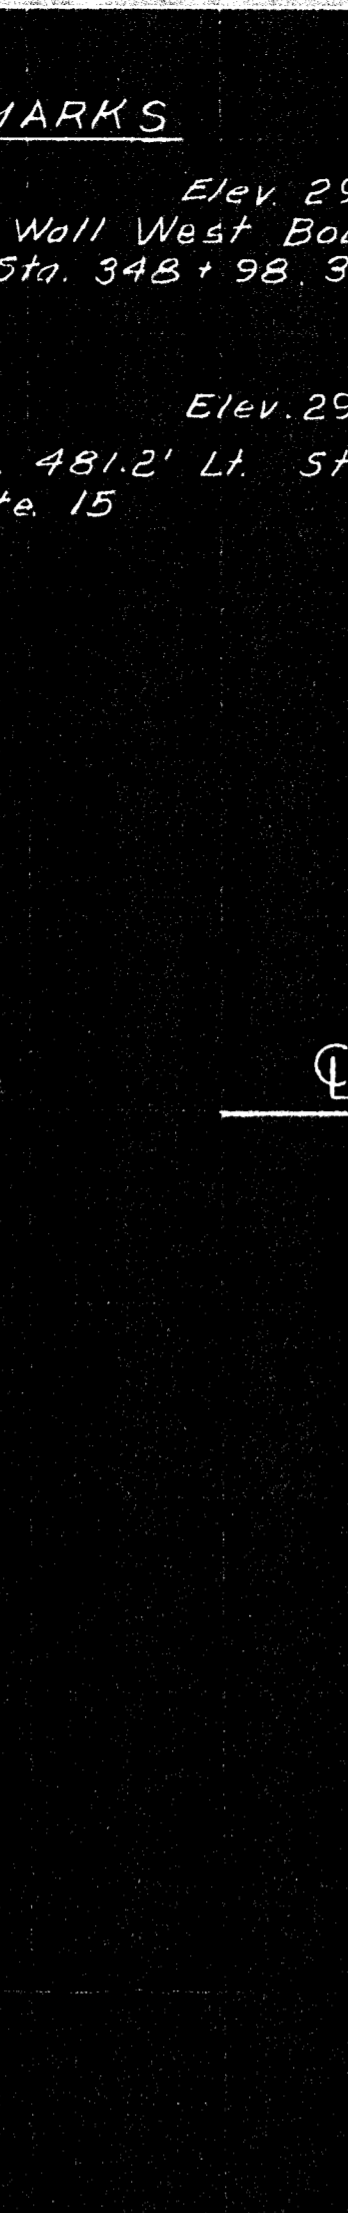


NOTE: Classification of earth material as shown on this sheet is based upon field inspection and is not to be construed to imply mechanical analysis.

BENCH MARKS


47-A-63 Elev. 2928.77
Nail in NW Wing Wall West Bound Bridge 371.9' Lt. Sta. 348+98.3 & Imp. Rte. 15

50-A-63 Elev. 2932.96
Bathey Stake & Cap. 481.2' Lt. Sta. 375+633 & Imp. Rte. 15

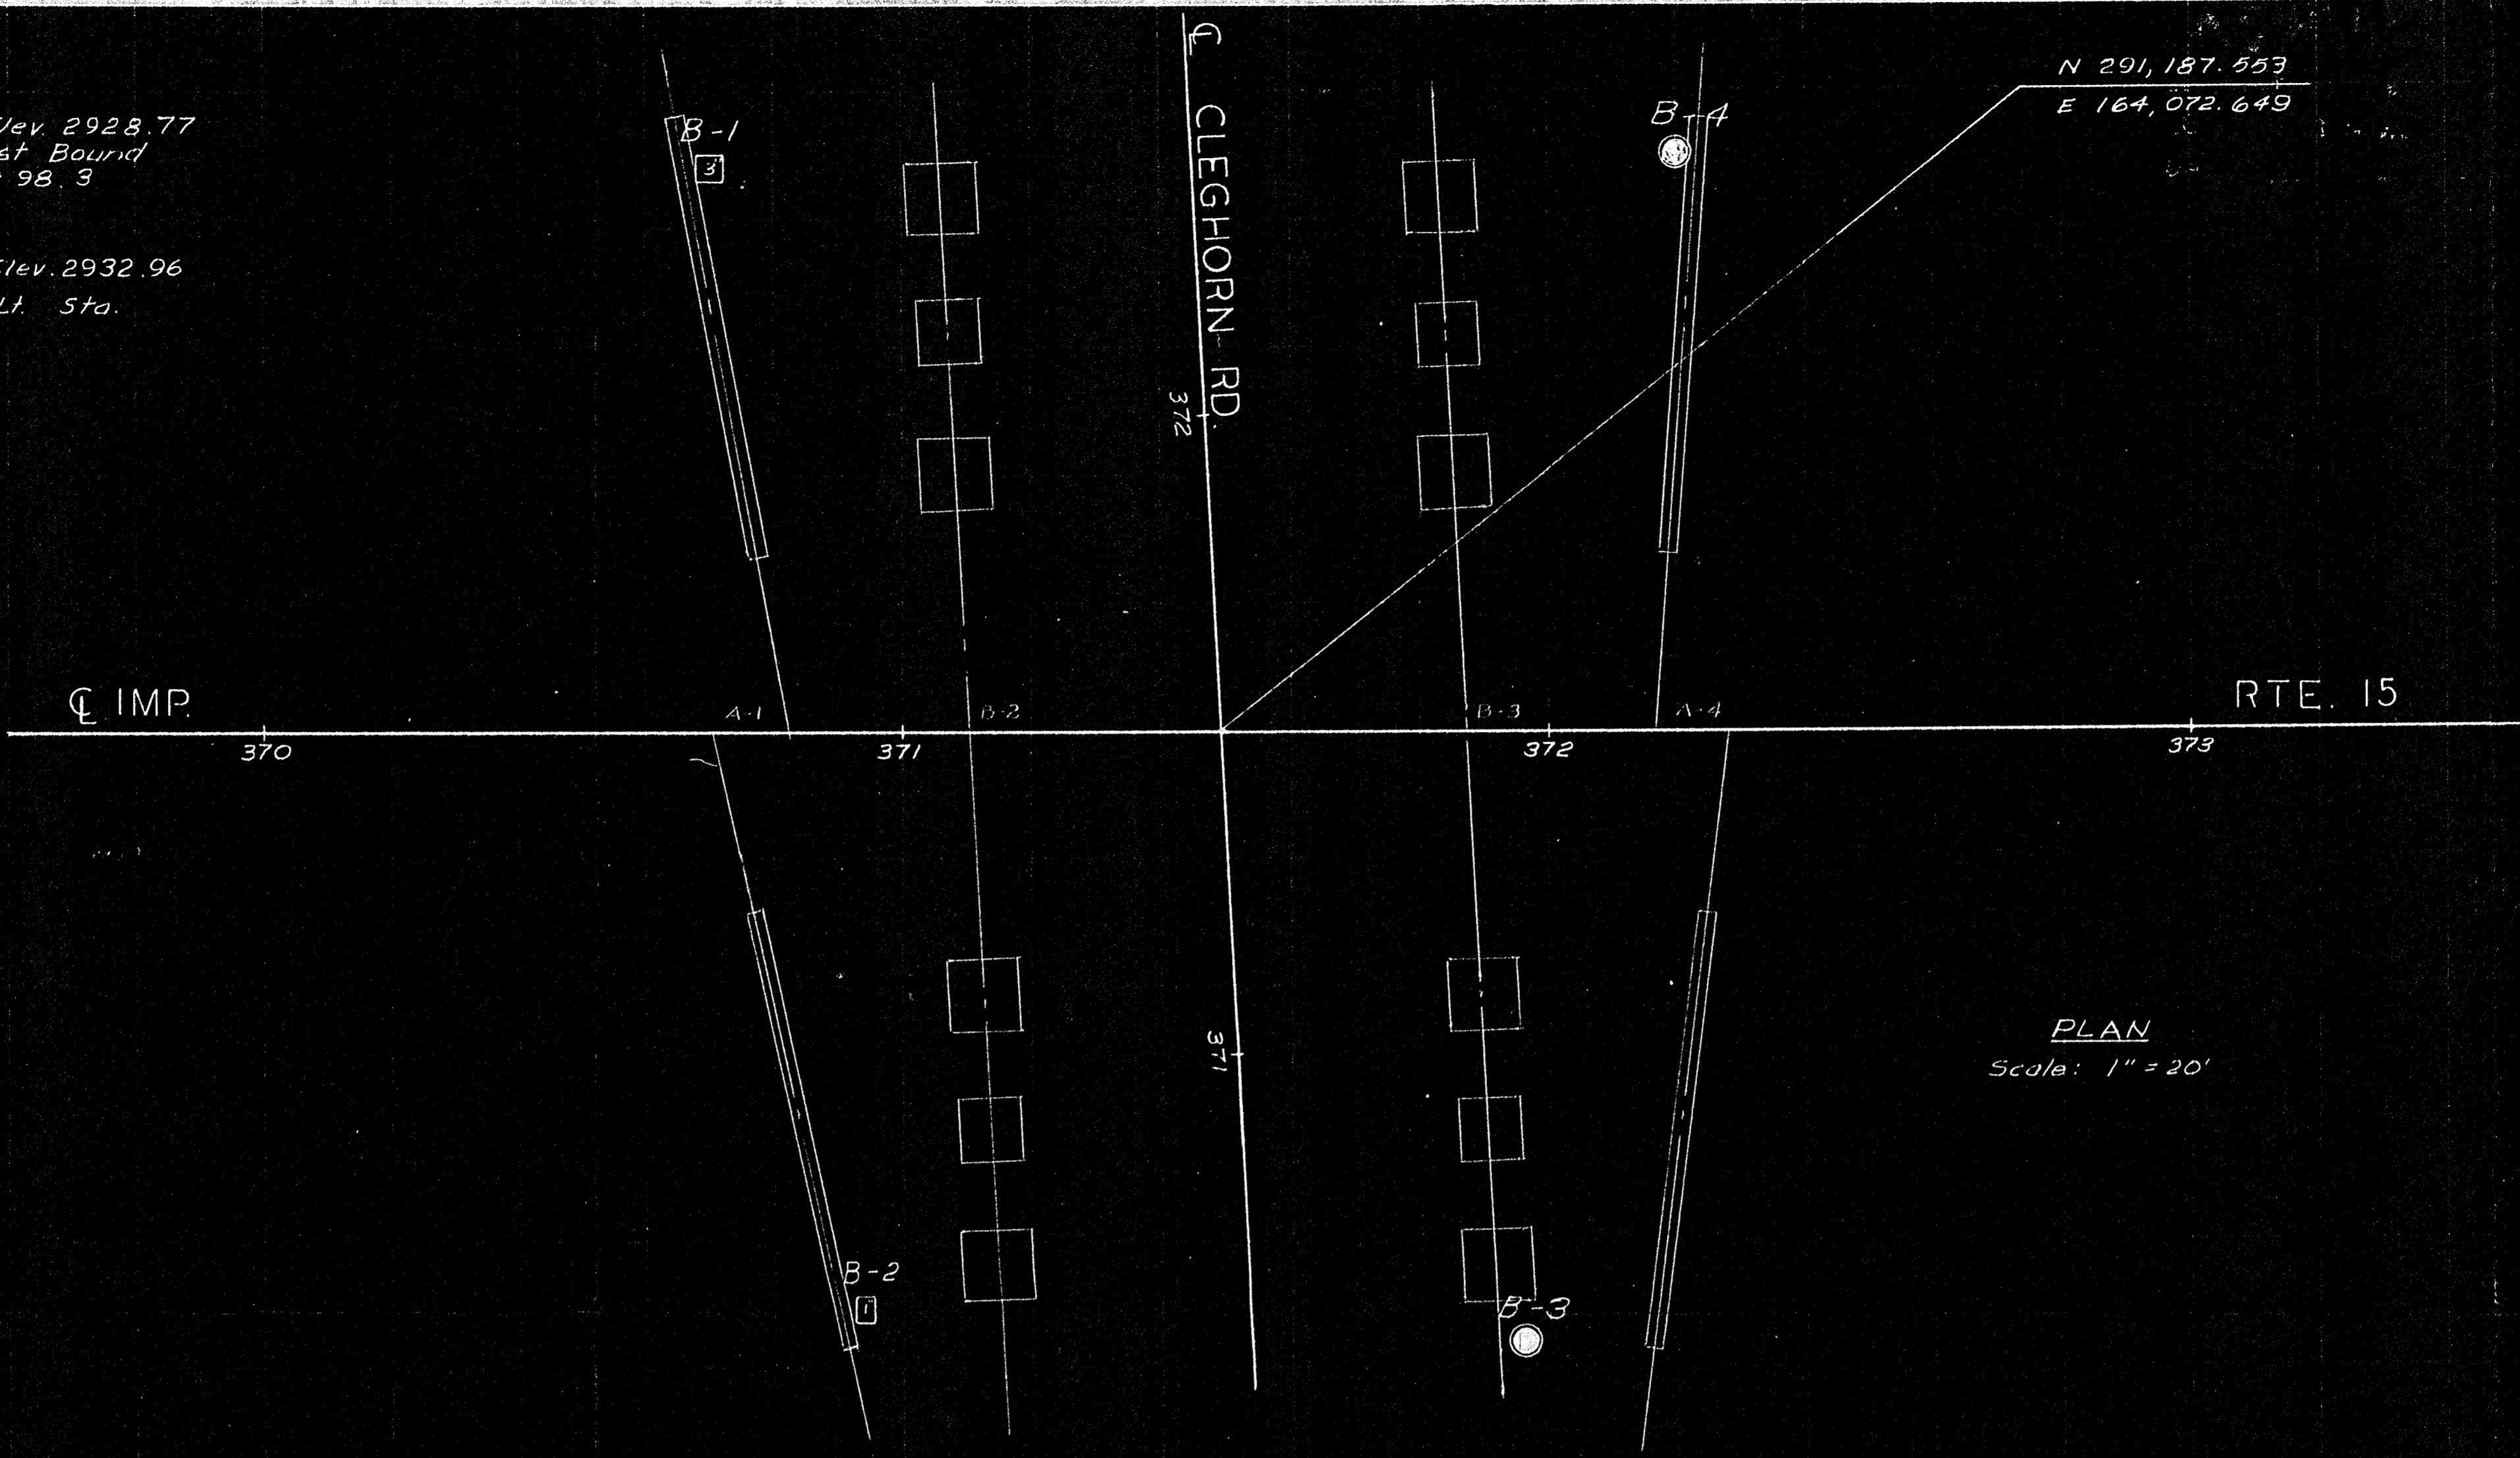

PLAN
Scale: 1" = 20'

AS BUILT
CORRECTIONS BY: *[Signature]*
CONTRACT NO. *049111*
DATE: *10-17-65*

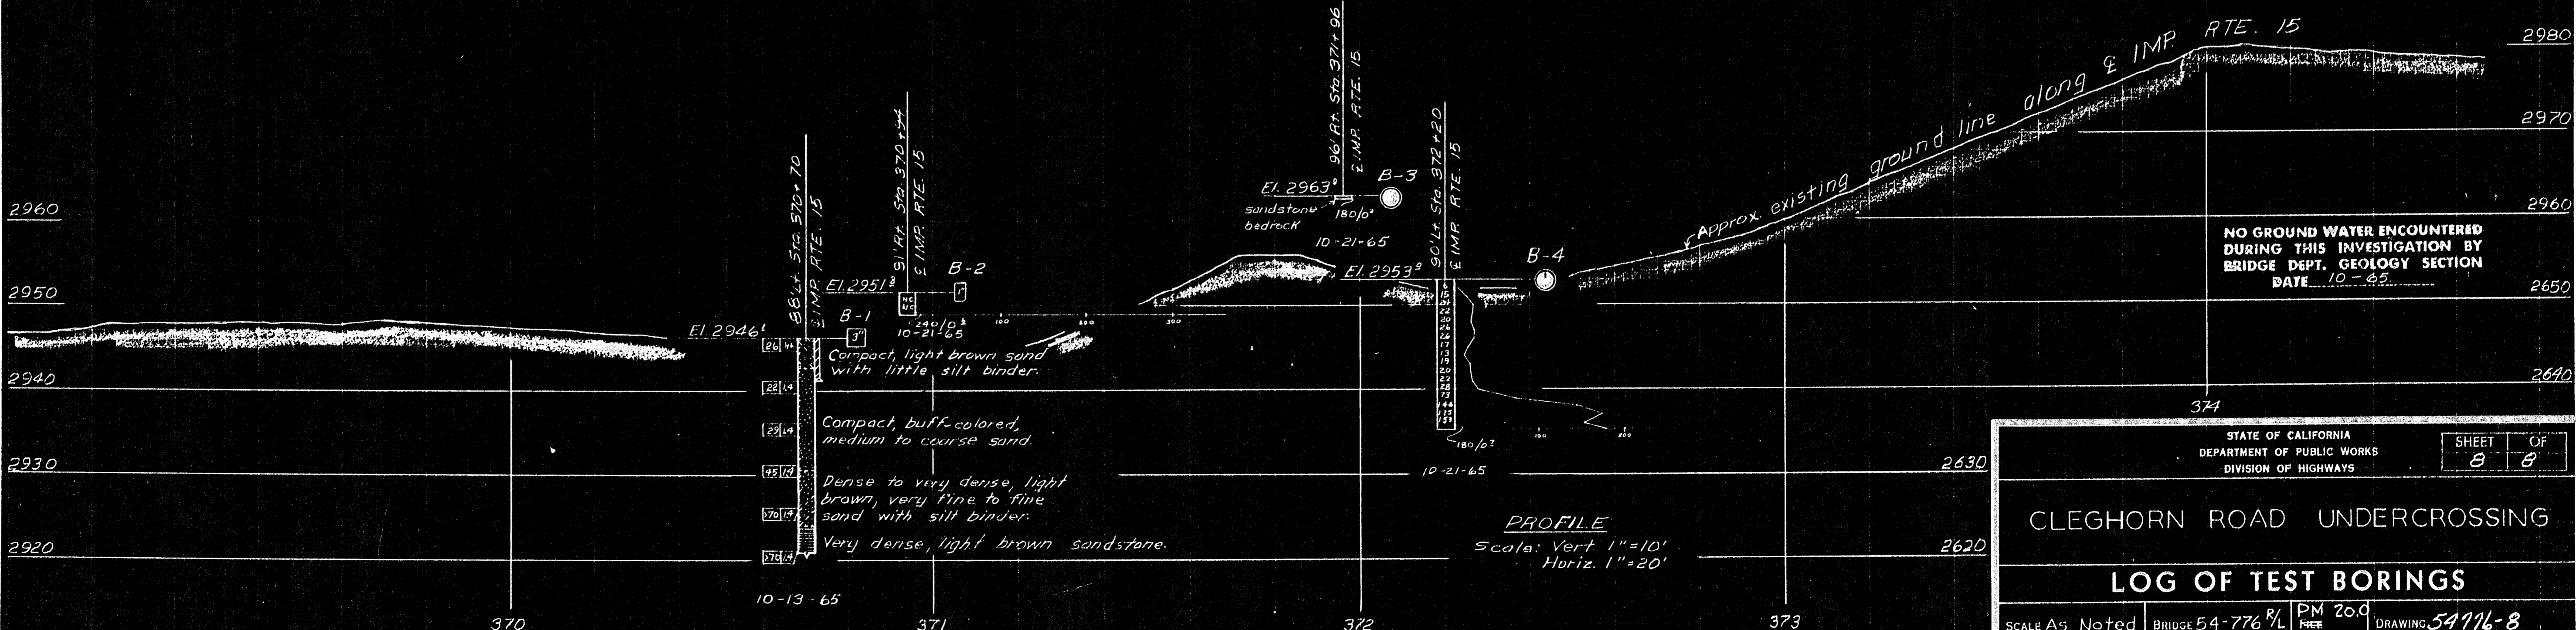

PROFILE
Scale: Vert 1" = 10'
Horiz. 1" = 20'

NO GROUND WATER ENCOUNTERED DURING THIS INVESTIGATION BY BRIDGE DEPT. GEOLOGY SECTION DATE: 10-65

STATE OF CALIFORNIA DEPARTMENT OF PUBLIC WORKS DIVISION OF HIGHWAYS		SHEET 8 OF 8
CLEGHORN ROAD UNDERCROSSING		
LOG OF TEST BORINGS		
SCALE AS NOTED	BRIDGE 54-776 R/L	PM 20d
		FREE
		DRAWING 54776-B

FIELD STUDY BY: O. W. H. S. 10-21-65
 DRAWN BY: G. B. W. 11-22-65
 CHECKED BY: O. W. H. S. 11-24-65
 Approved & Recommended by: *[Signature]*
 Engineer & Geologist

BRIDGE DEPARTMENT
ENGINEERING GEOLOGY SECTION


368

Charge: 09203
WA: 049111


Disregard prints bearing earlier numbers

PREL. DRAWING NO. PR- *[Blank]*



East Fork Cajon Creek

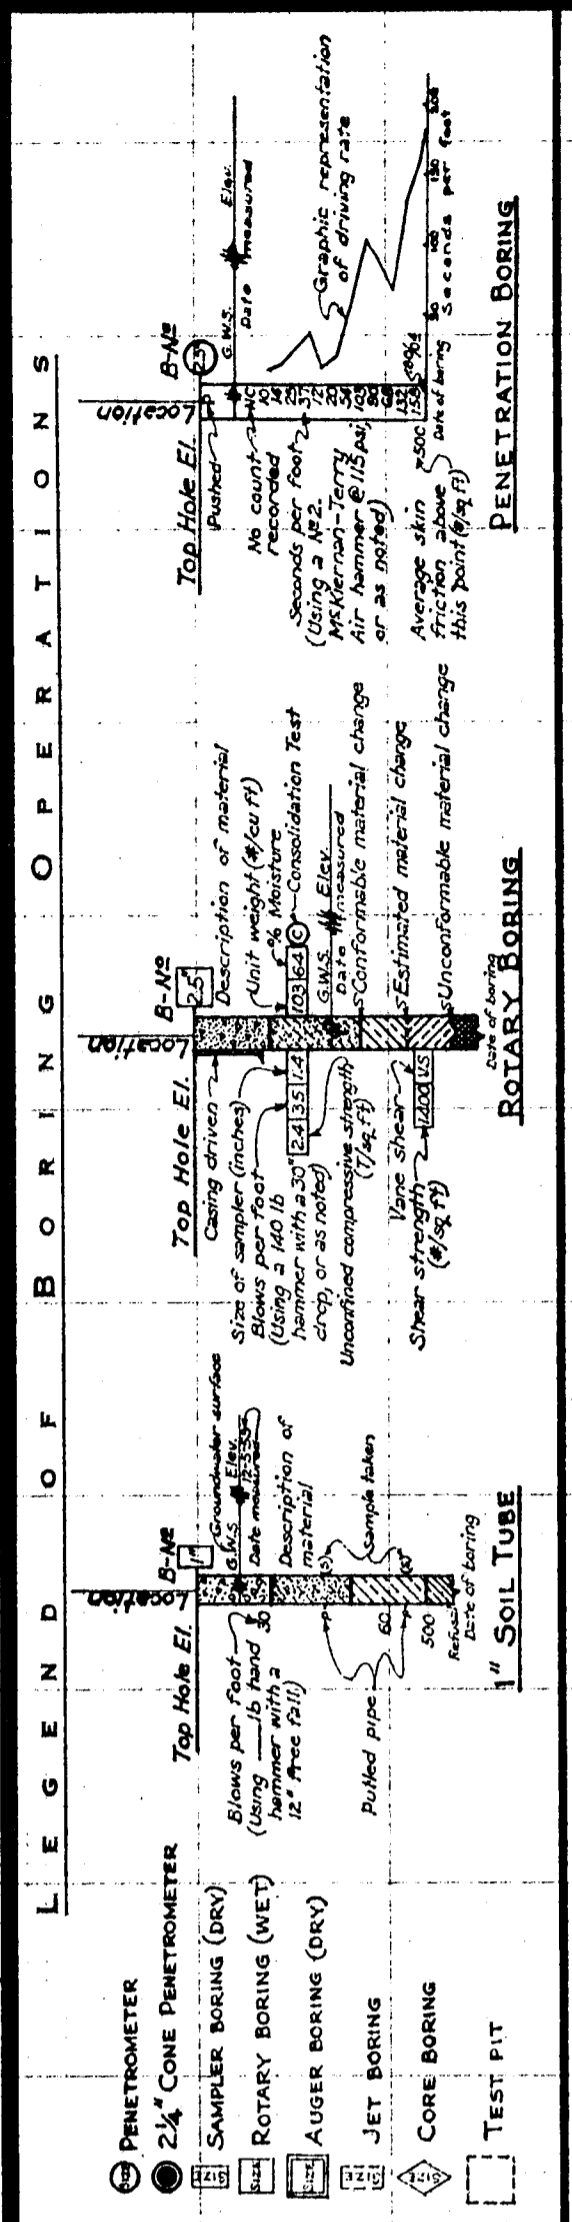


BENCH MARK
 BM 47-B-49
 Nail in lead in Bridge wheel guard
 773 Rt Sta. 406+52.2 E. East Rd Bd. RTE. 15
 Elev. 2996.86

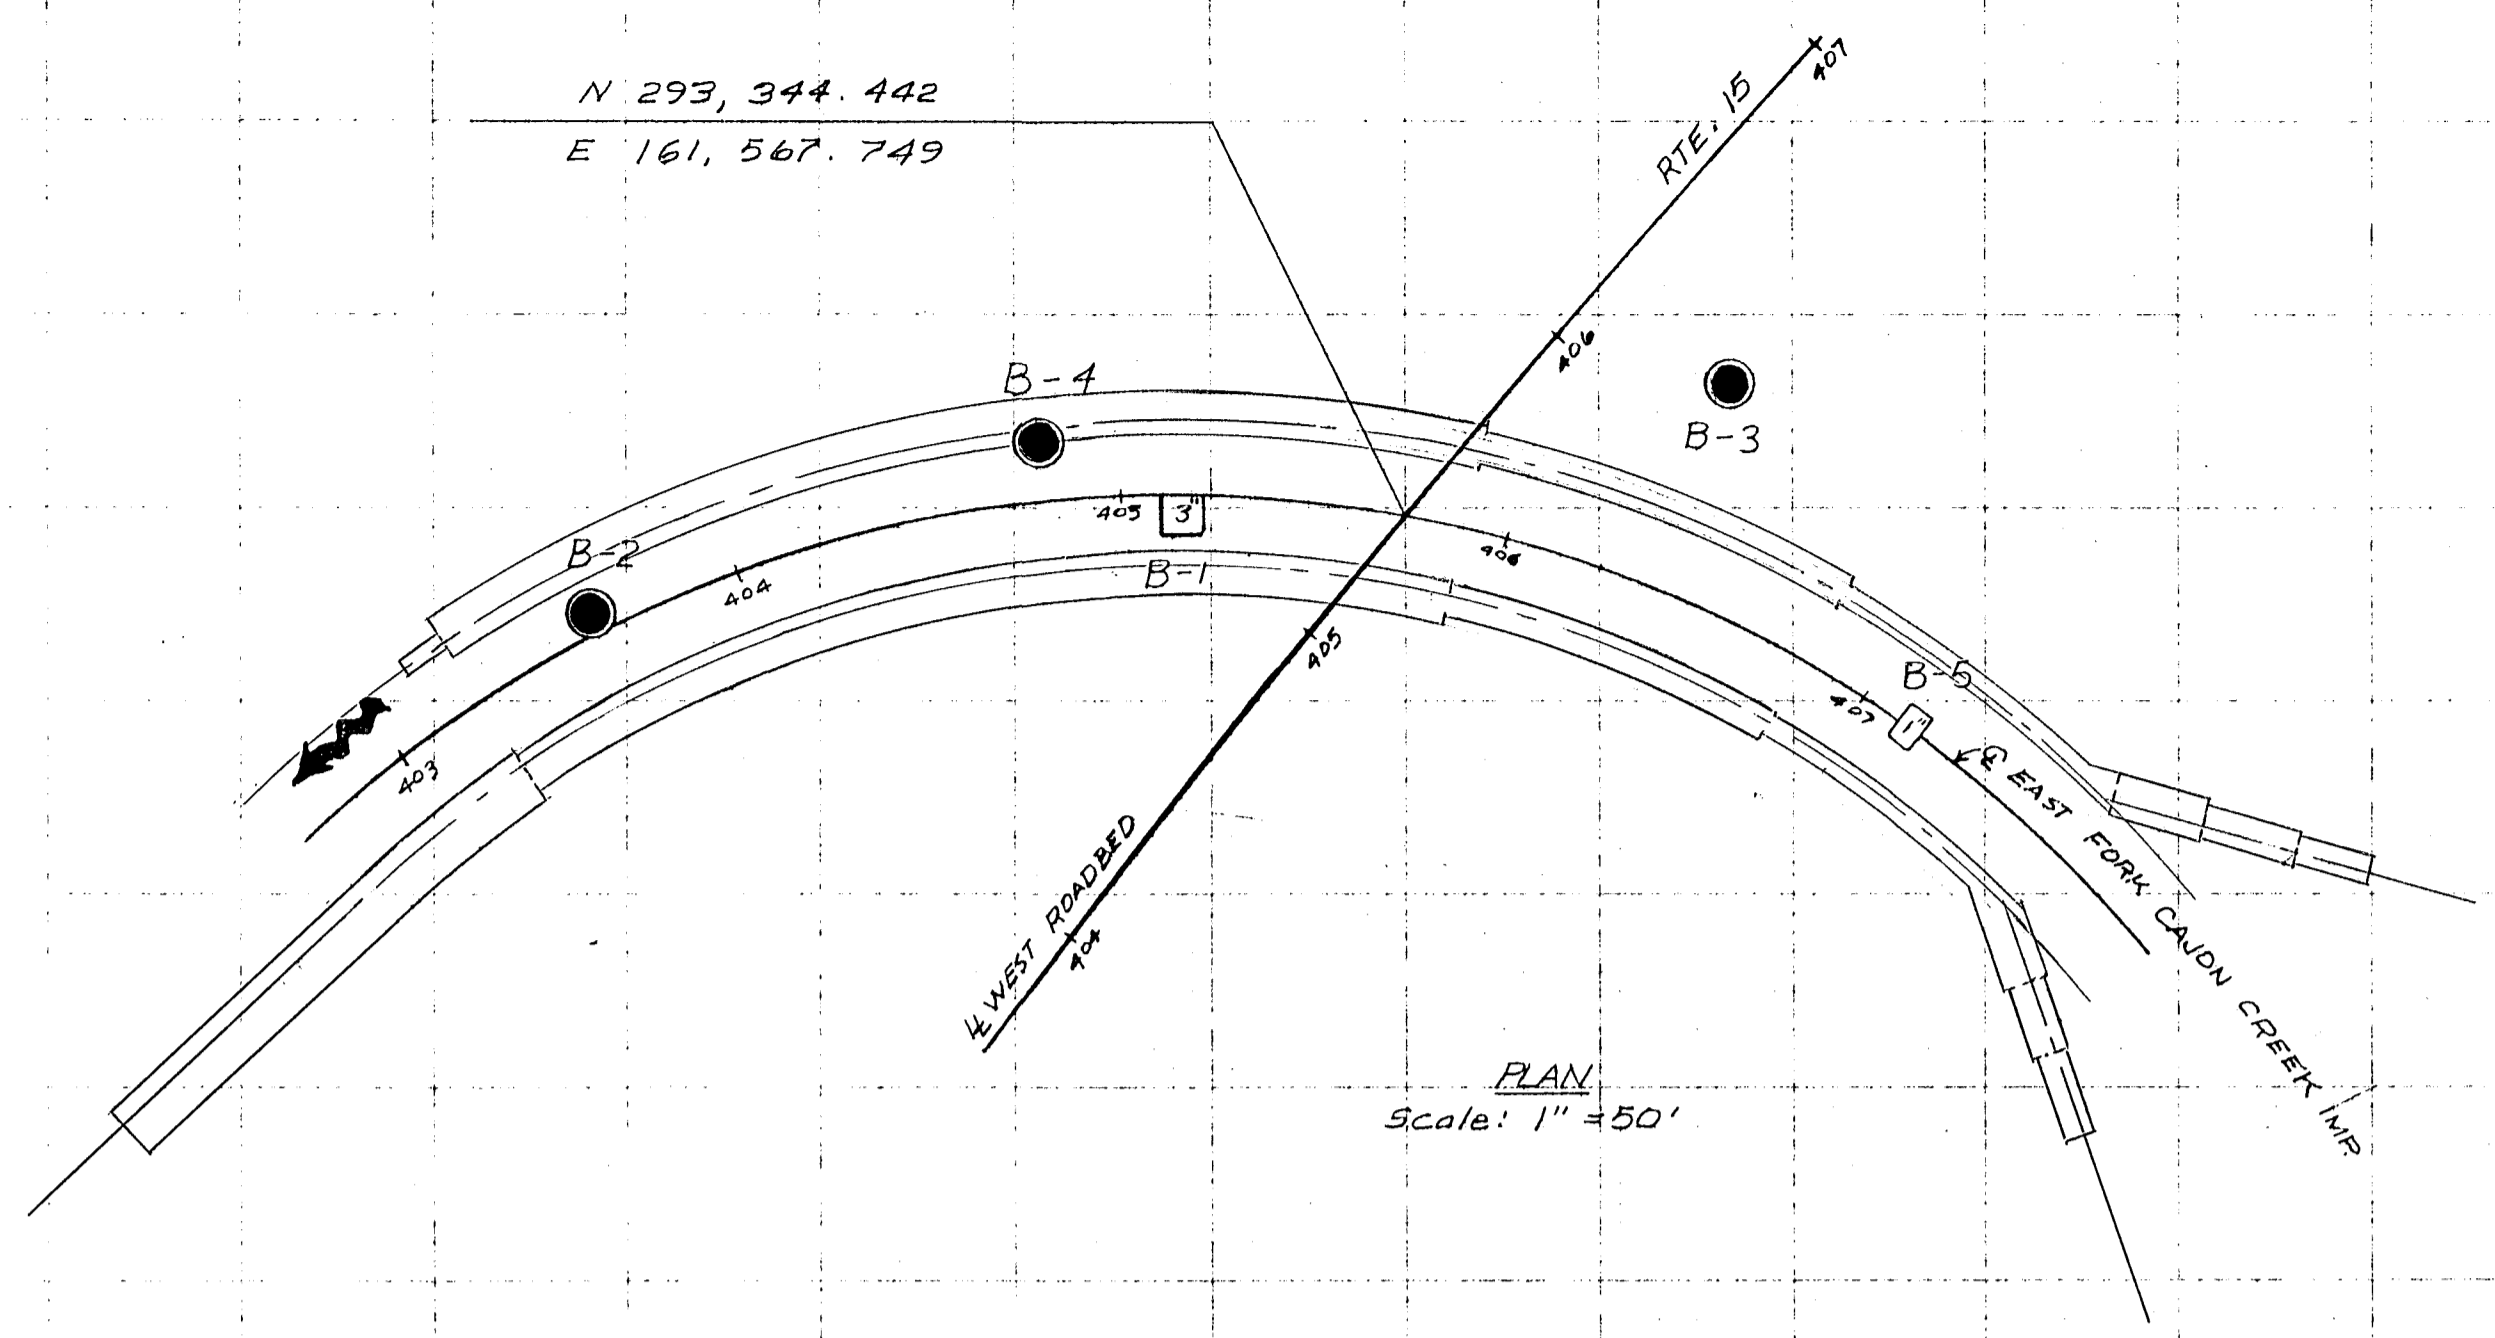

Rtgs. constructed at Plan elevation

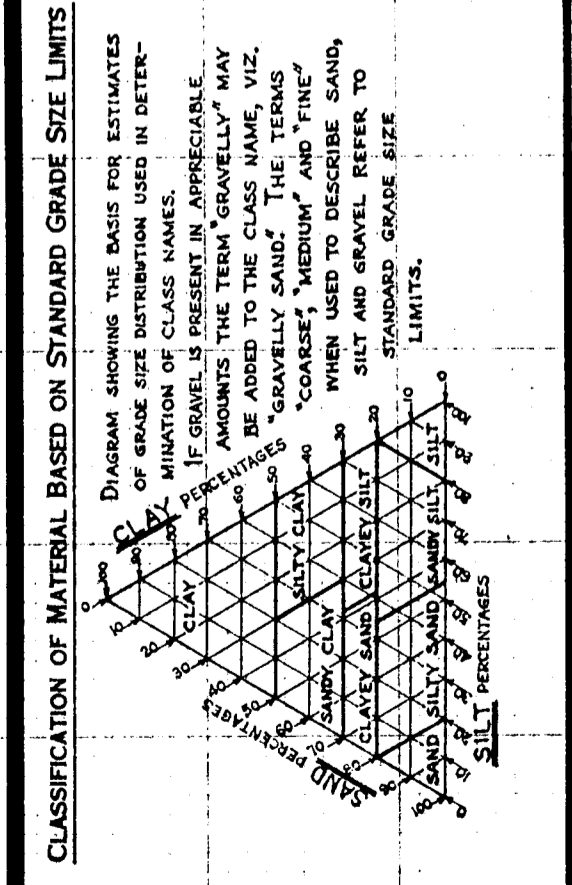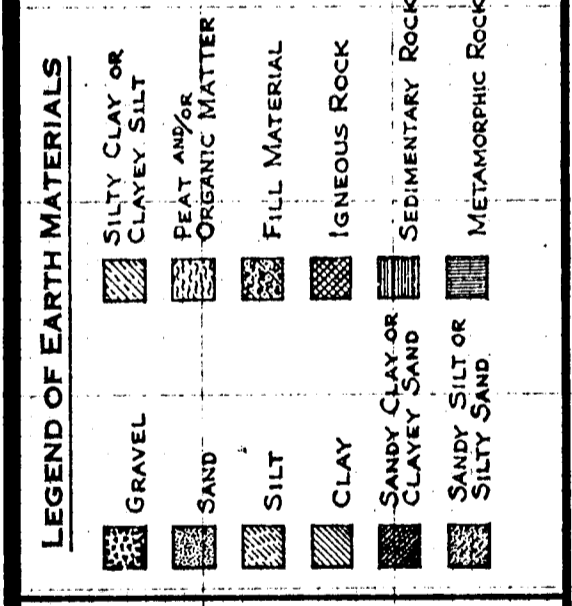

NOTE: Classification of earth material as shown on this sheet is based upon field inspection and is not to be construed to imply mechanical analysis.

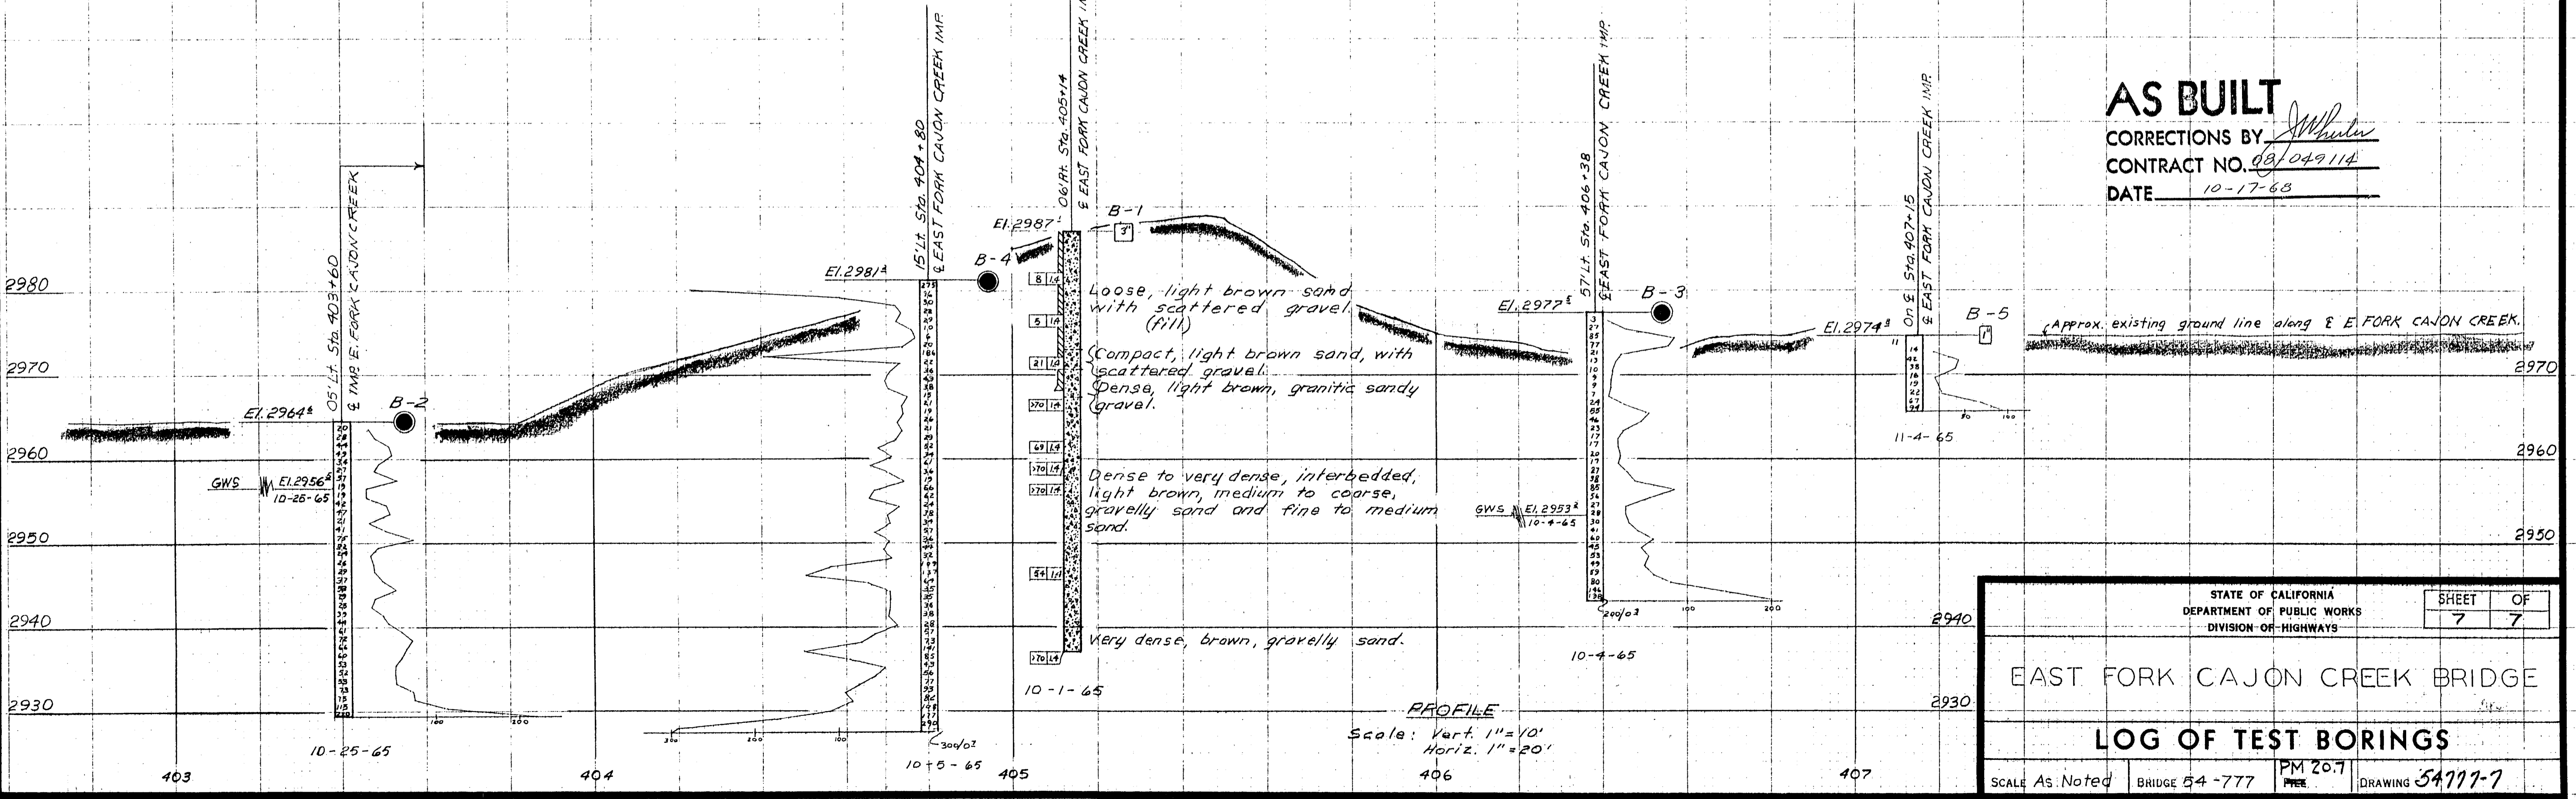

AS BUILT
 CORRECTIONS BY *J. Whelan*
 CONTRACT NO. 681049114
 DATE 10-17-63

STATE OF CALIFORNIA
 DEPARTMENT OF PUBLIC WORKS
 DIVISION OF HIGHWAYS

SHEET 7 OF 7

EAST FORK CAJON CREEK BRIDGE

LOG OF TEST BORINGS

SCALE As Noted BRIDGE 54-777 PM 20.7 PREL. DRAWING NO. PR-54777-7

FIELD STUDY BY O. MIKES 11-4-65
 DRAWN BY G. B. WILKIE 11-24-65
 CHECKED BY O. MIKES 12-5-65
 Approval Recommended by *[Signature]*
 Regional Geologist



BRIDGE DEPARTMENT
 ENGINEERING GEOLOGY SECTION

375


Charge: 08203
 W.A.: 049111

Disregard prints bearing earlier numbers → PREL. DRAWING NO. PR-

SR-138 / I-15 Separation

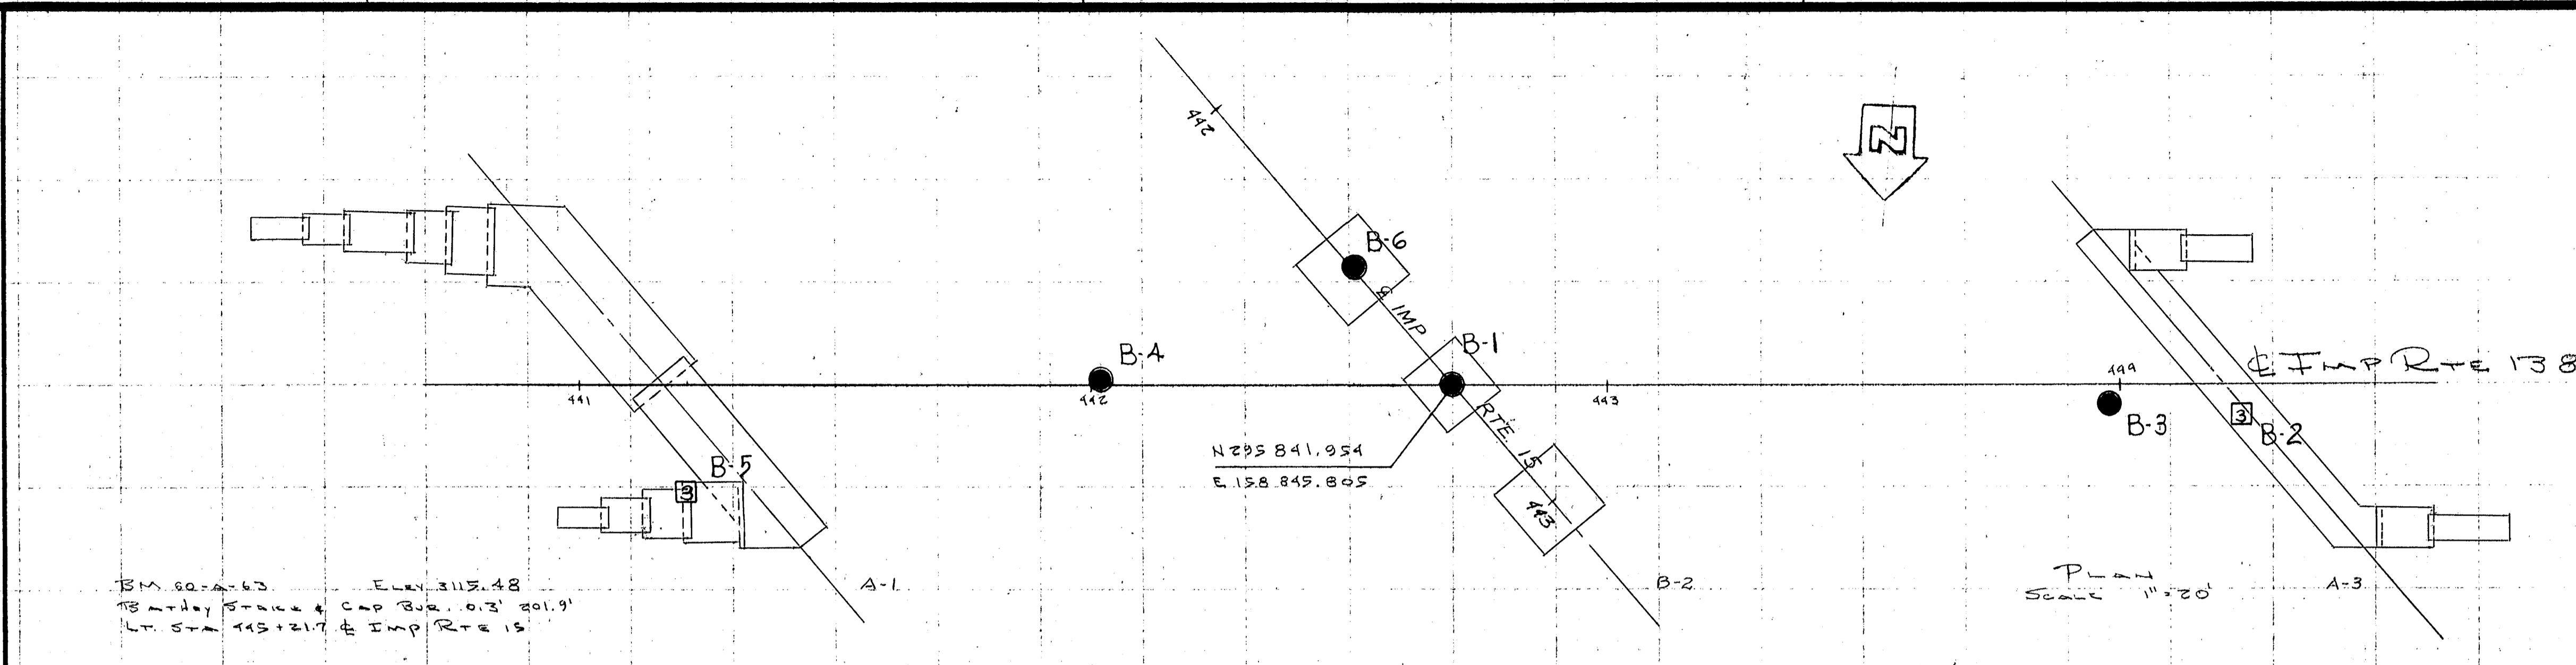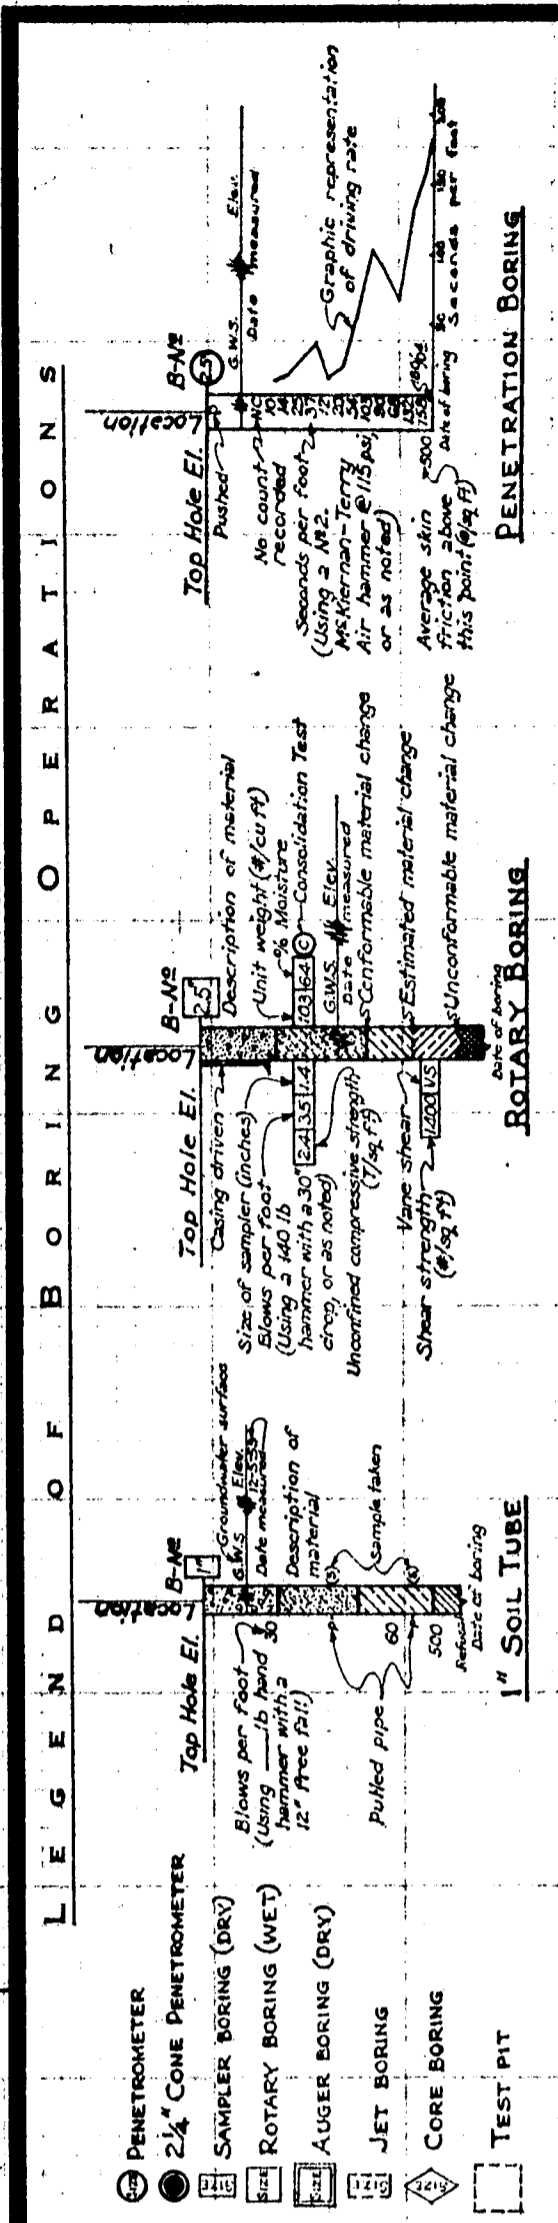


NO GROUND WATER ENCOUNTERED DURING THIS INVESTIGATION BY BRIDGE DEPT. GEOLOGY SECTION
DATE 10-18-68

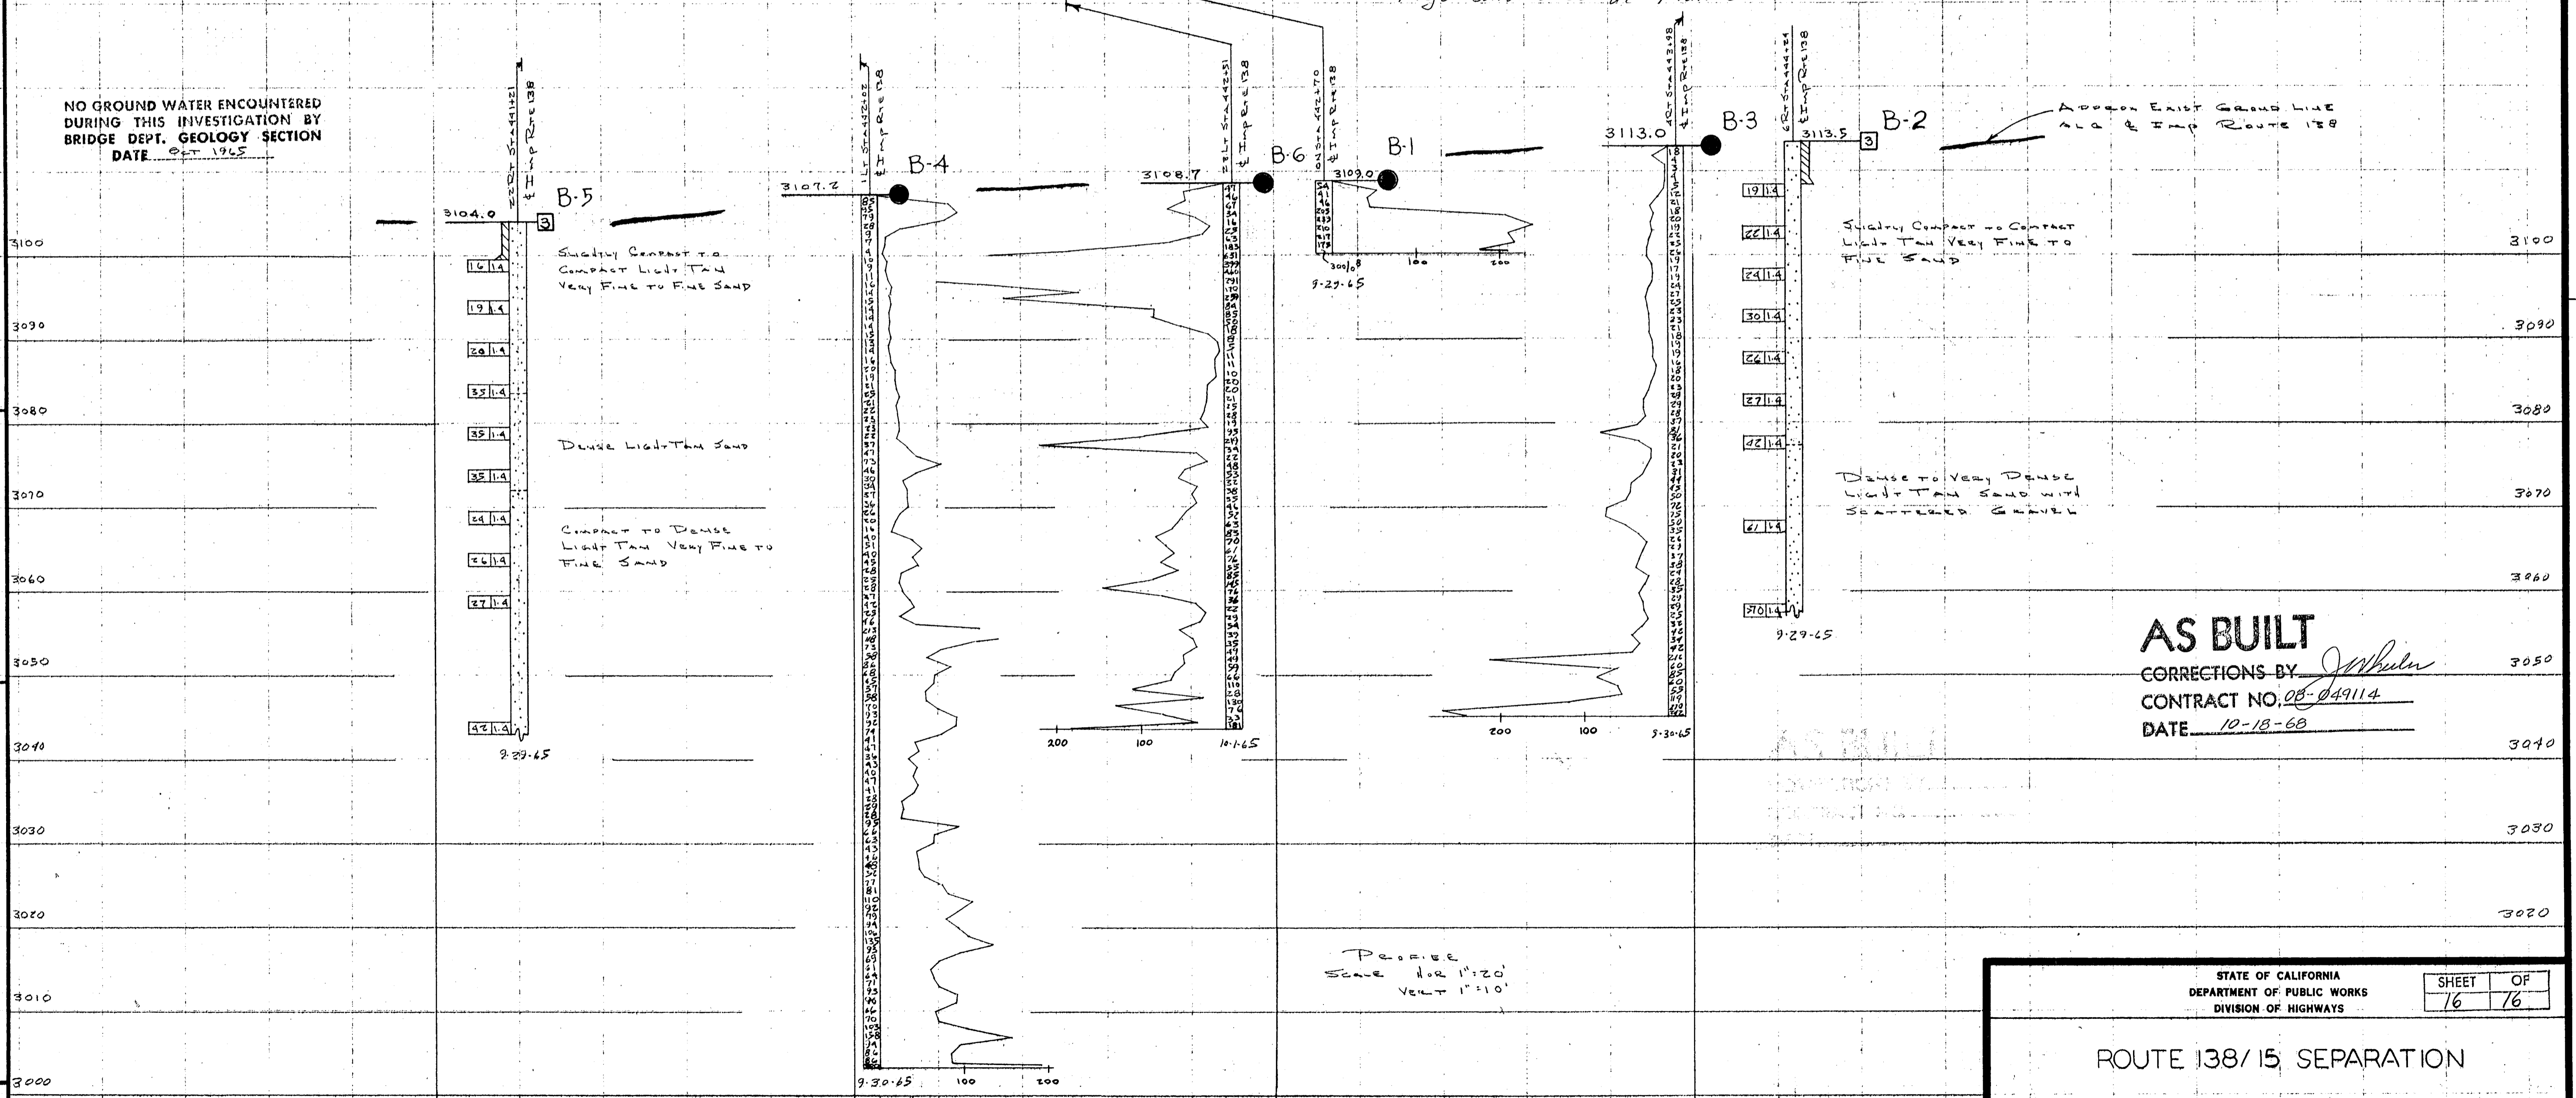

FIELD STUDY
DRAWN BY: O. MIKES 10-11-68
CHECKED BY: T. BURKE 11-3-68
BY: O. MIKES 11-15-68
Approval Recommended by: [Signature]
Expanding Geologist

LEGEND OF EARTH MATERIALS

GRAVEL	SILTY CLAY OR CLAYEY SILT
SAND	PEAT AND/OR ORGANIC MATTER
SILT	FILL MATERIAL
CLAY	IGNEOUS ROCK
SANDY CLAY OR CLAYEY SAND	SEDIMENTARY ROCK
SILT SAND	METAMORPHIC ROCK

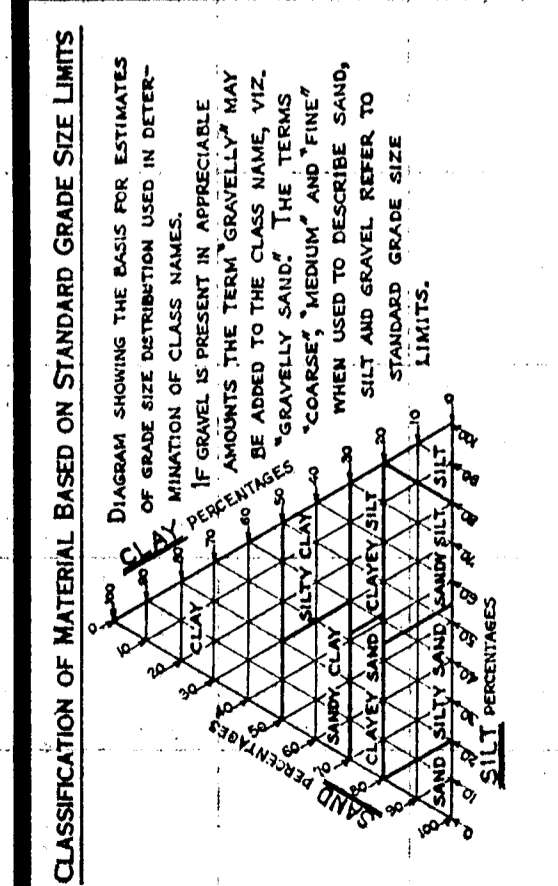

AS BUILT
CORRECTIONS BY: [Signature]
CONTRACT NO. 08-049114
DATE 10-18-68

STATE OF CALIFORNIA
DEPARTMENT OF PUBLIC WORKS
DIVISION OF HIGHWAYS

SHEET 16 OF 16

ROUTE 138/15 SEPARATION


LOG OF TEST BORINGS

SCALE A₂ NOTED BRIDGE 54-778 PM 214 FREE DRAWING 54778-16

391

BENCH MARK

541057A, 120PRHV
 N1936423.713
 E6718204.417
 Elev 3139.68
 NAVD29
 1" IP/ALCAP Stnd SBS138541057A
 130.95 Ft Lt C Rte 138
 Sta 780+93.67

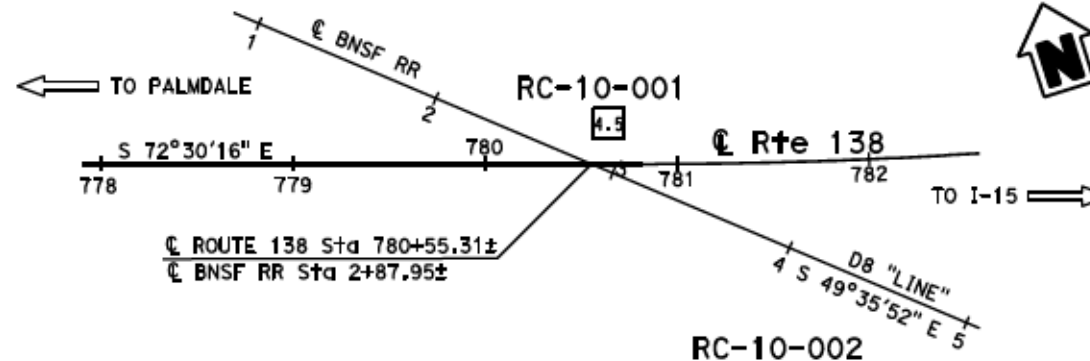

PLAN
 1" = 50'

DIST	COUNTY	ROUTE	POST MILES TOTAL PROJECT	SHEET No.	TOTAL SHEETS
08	SBd	138			


Chris Hadley 12-27-12
 CERTIFIED ENGINEERING GEOLOGIST DATE

Chris Hadley
 No. 2509
 Exp. 11-29-15
 PROFESSIONAL GEOLOGIST
 STATE OF CALIFORNIA

PLANS APPROVAL DATE _____

The State of California or its officers or agents shall not be responsible for the accuracy or completeness of electronic copies of this plan sheet.

This LOTB sheet was prepared in accordance with the Caltrans Soil & Rock Logging, Classification, & Presentation Manual (2010 Edition).
 See 2010 Standard Plans A10F and A10G for Soil Legend, and A10H for Rock Legend.

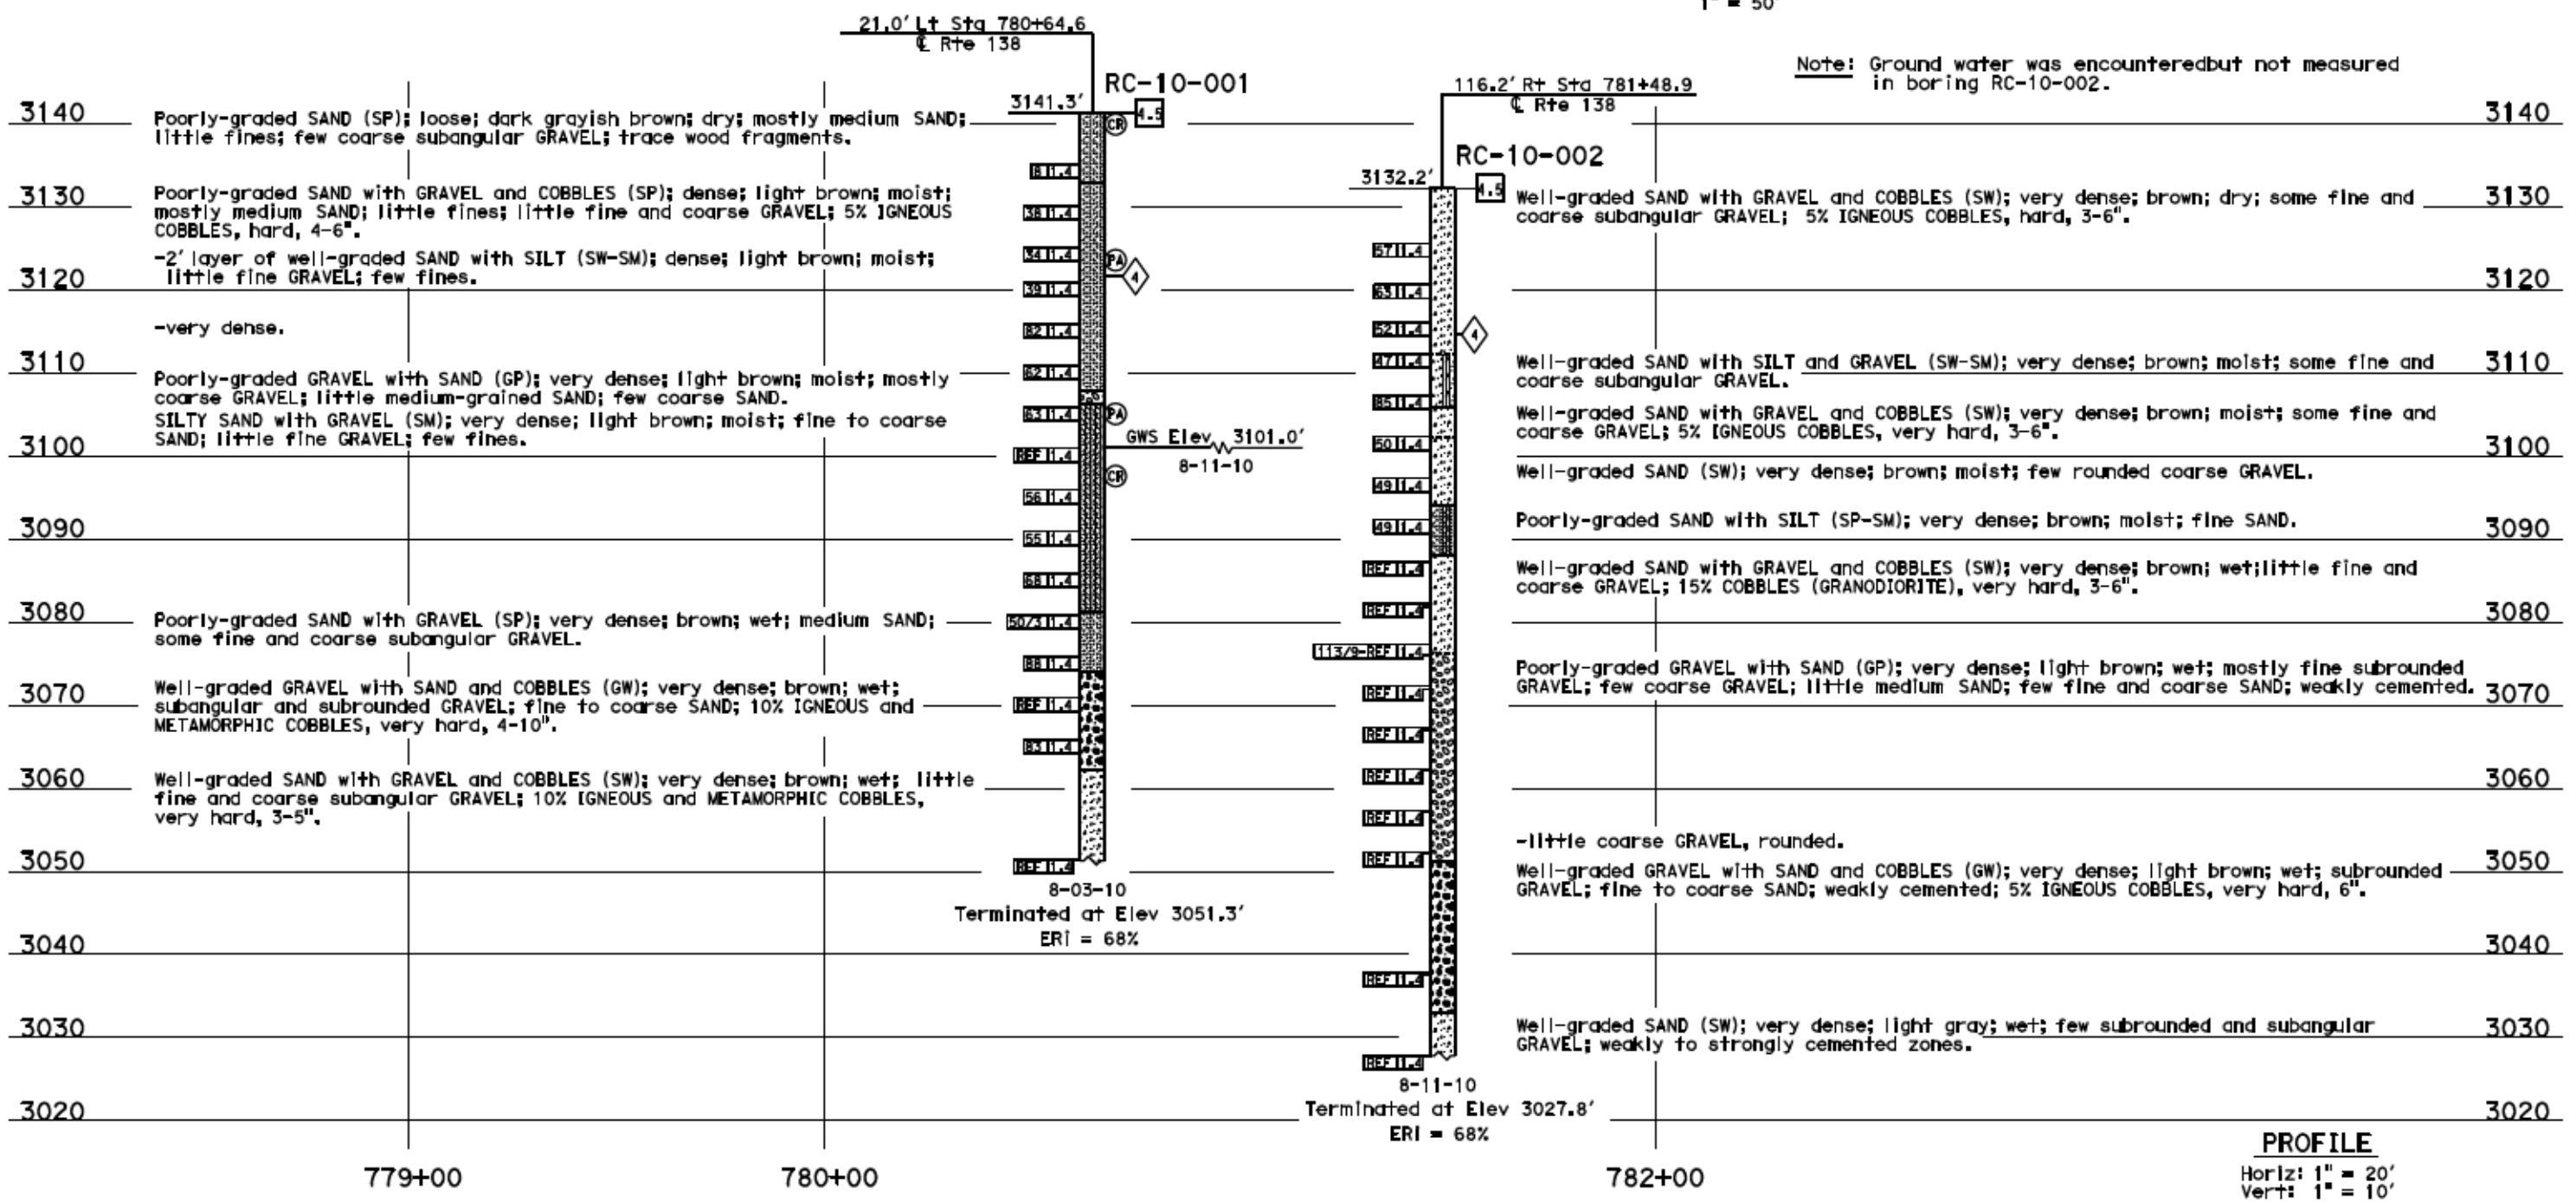


PROFILE
 Horiz: 1" = 20'
 Vert: 1" = 10'

ENGINEERING SERVICES		MATERIALS AND GEOTECHNICAL SERVICES		STATE OF CALIFORNIA		DIVISION OF ENGINEERING SERVICES		BRIDGE NO.		RETAINING WALL NO. 782	
FUNCTIONAL SUPERVISOR		DRAWN BY: F. Nguyen		DEPARTMENT OF TRANSPORTATION		STRUCTURE DESIGN		RW 780		LOG OF TEST BORINGS	
NAME: S. Wei		CHECKED BY: M. Wilson		FIELD INVESTIGATION BY: J. Klabeckl		DESIGN BRANCH X		POST MILE 14.7			
ORS CIVIL LOG OF TEST BORINGS SHEET		ORIGINAL SCALE IN INCHES FOR REDUCED PLANS		UNIT: 3643		PROJECT NUMBER & PHASE: 08000006091		CONTRACT NO.: 08-3401U1		REVISION DATES	
				FILE => rw782.dgn				DESIGNER PRINTS BEARING EARLIER REVISION DATES		SHEET 1 OF 1	

DIST	COUNTY	ROUTE	POST MILES TOTAL PROJECT	SHEET No	TOTAL SHEETS
08	SBd	138			

Chris Hoodley
 CERTIFIED ENGINEERING GEOLOGIST
 12-27-12
 No. 2309
 Exp. 11-23-13
 PROFESSIONAL GEOLOGIST
 CERTIFIED ENGINEERING GEOLOGIST
 STATE OF CALIFORNIA

PLANS APPROVAL DATE _____
 The State of California or its officers or agents shall not be responsible for the accuracy or completeness of electronic copies of this plan sheet.

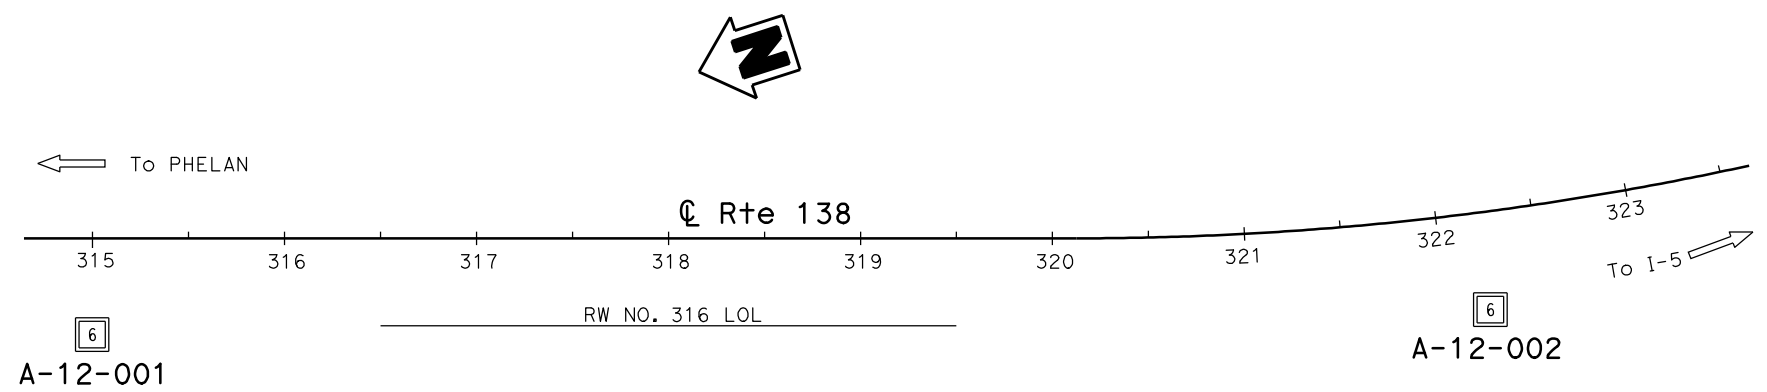


BENCH MARK

SET STD BRASS DISK STAMPED "SBd 138 GPS 6.10 1999", 35' W'LY Y.S. Rte 138, 100' p1=16,18' N'LY OF CALL BOX AT N'LY END OF TURNOUT PM 6.10. NAD83 (VERTICAL) ZONE 5

PLAN
1" = 50'

Note: No ground water encountered during field investigation.


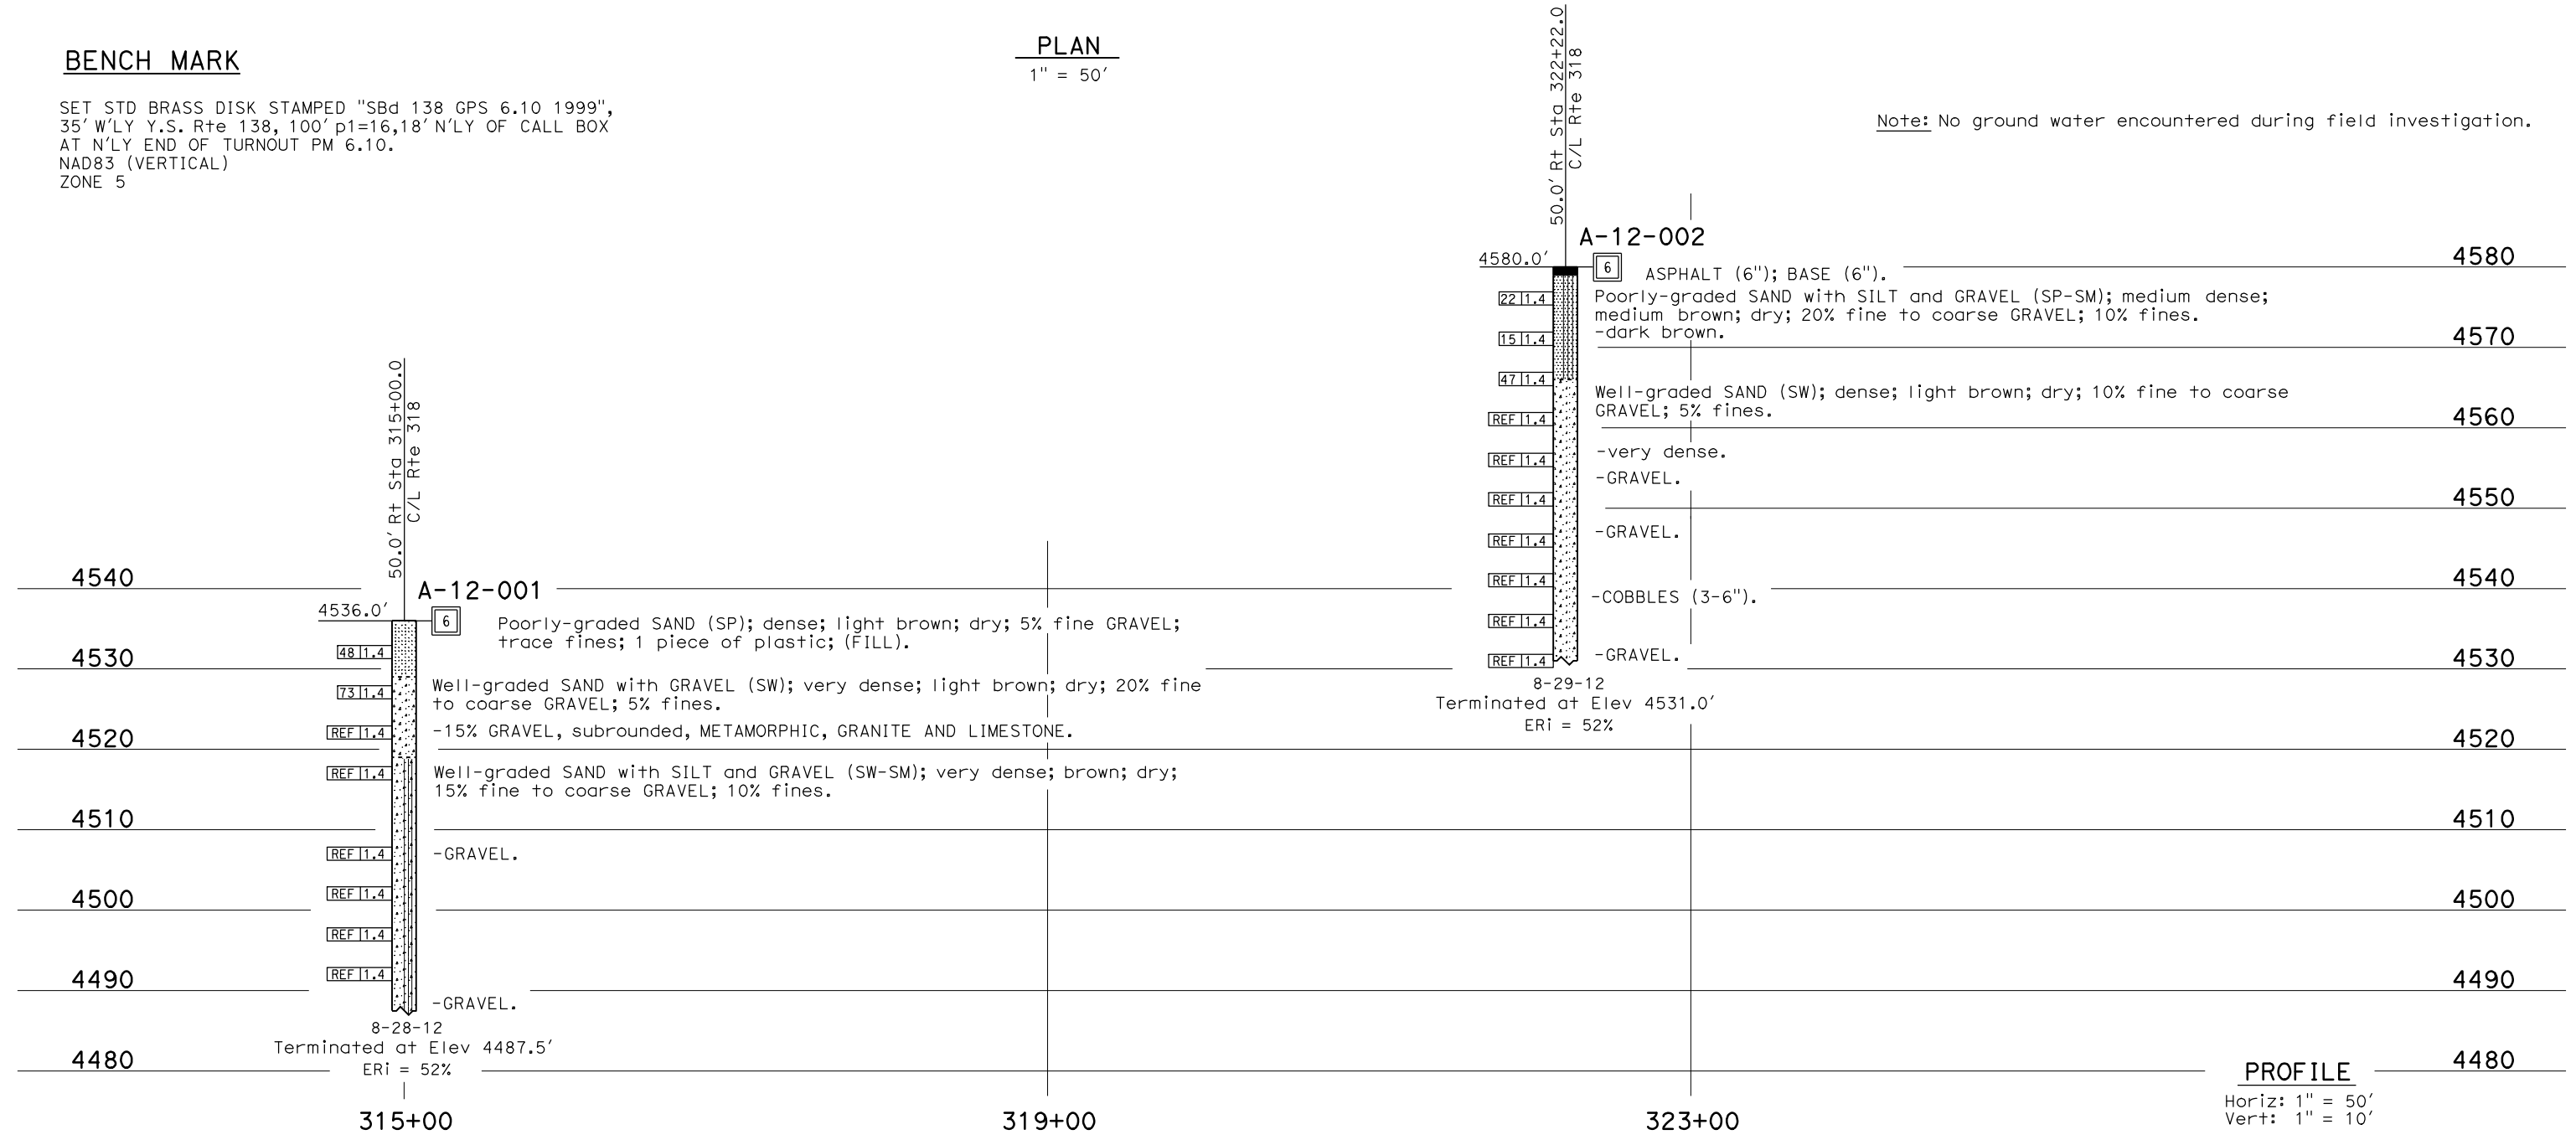


PROFILE
 Horiz: 1" = 50'
 Vert: 1" = 10'

ENGINEERING SERVICES		MATERIALS AND GEOTECHNICAL SERVICES		STATE OF CALIFORNIA		DIVISION OF ENGINEERING SERVICES		BRIDGE NO.		RETAINING WALL NO. 316	
FUNCTIONAL SUPERVISOR		DRAWN BY: W. Tang 10/12		DEPARTMENT OF TRANSPORTATION		STRUCTURE DESIGN		RW316		LOG OF TEST BORINGS	
NAME: S. Wei		CHECKED BY: M. Wilson		FIELD INVESTIGATION BY: C. Hoodley		DESIGN BRANCH X		POST MILE 6.0/6.1			
065 CIVIL LOG OF TEST BORINGS SHEET		ORIGINAL SCALE IN INCHES FOR REDUCED PLANS		UNIT: 3643		PROJECT NUMBER & PHASE: 08000006091		CONTRACT NO.: 08-3401U1		DISREGARD PRINTS BEARING EARLIER REVISION DATES	
				0 1 2 3		REVISION DATES		SHEET OF		X X	
				FILE => rw316.dgn		10-15-12 11-14-12 12-27-12 12-14-12					

USERNAME => s128444 DATE PLOTTED => 28-DEC-2012 TIME PLOTTED => 13:41

DIST	COUNTY	ROUTE	POST MILES TOTAL PROJECT	SHEET NO	TOTAL SHEETS
08	SBd	138			

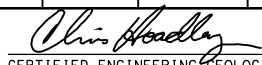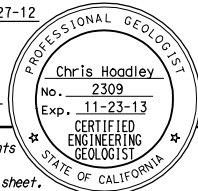
 CERTIFIED ENGINEERING GEOLOGIST 12-27-12


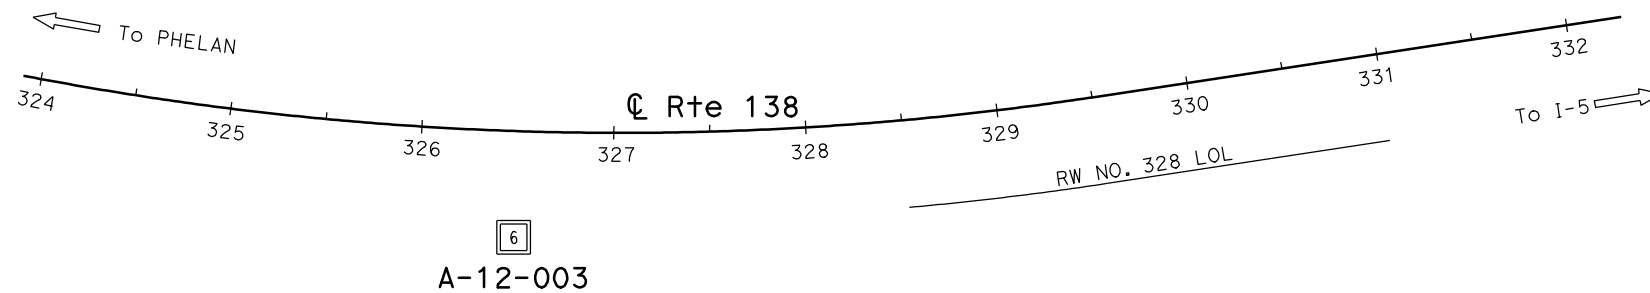
PLANS APPROVAL DATE _____

The State of California or its officers or agents shall not be responsible for the accuracy or completeness of electronic copies of this plan sheet.

This LOTB sheet was prepared in accordance with the Caltrans Soil & Rock Logging, Classification, & Presentation Manual (2010 Edition). See 2010 Standard Plans A10F and A10G for Soil Legend, and A10H for Rock Legend.

BENCH MARK


SET STD DISK IN CONC DN 1" STAMPED "P1-71 P1-16",
 3' FROM E.O. IN AC TURNOUT ON RT AT PM 6.2
 NAD83 (VERTICAL)
 ZONE 5



PLAN

1" = 50'

Note: No ground water encountered during field investigation.

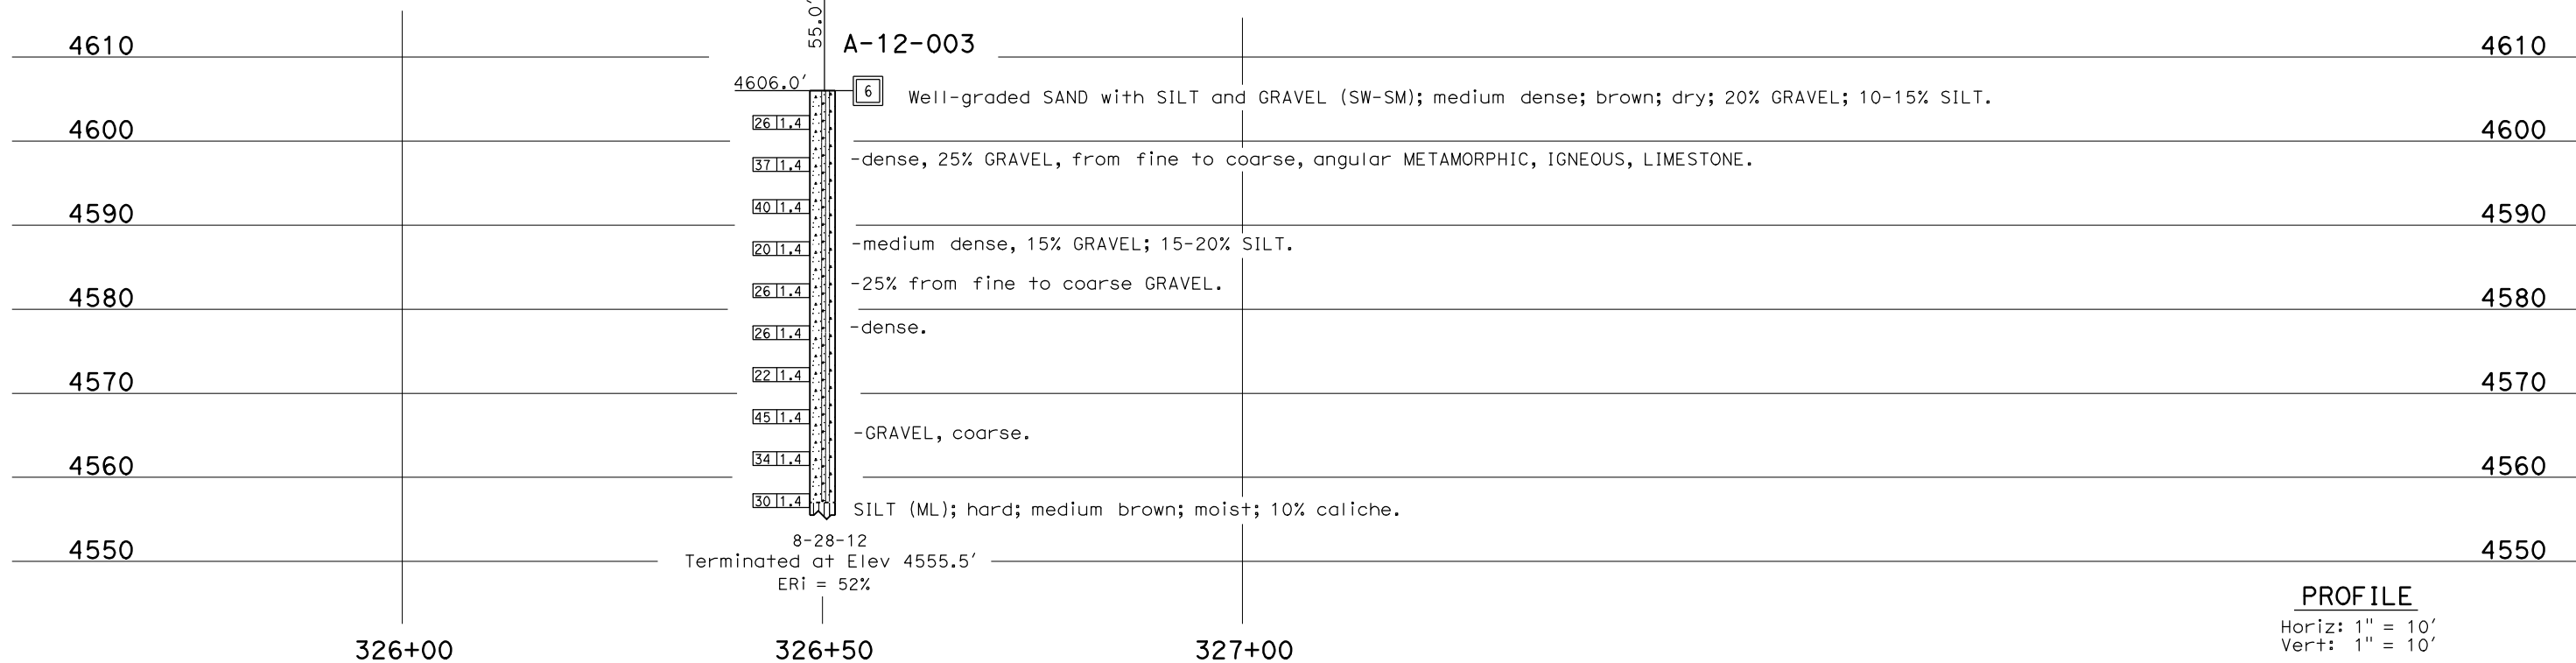

PROFILE

Horiz: 1" = 10'
 Vert: 1" = 10'

ENGINEERING SERVICES		MATERIALS AND GEOTECHNICAL SERVICES		STATE OF CALIFORNIA		DIVISION OF ENGINEERING SERVICES		BRIDGE NO.		RETAINING WALL NO. 328	
FUNCTIONAL SUPERVISOR		DRAWN BY: W. Tang 10/12		DEPARTMENT OF TRANSPORTATION		STRUCTURE DESIGN		POST MILE		LOG OF TEST BORINGS	
NAME: S. Wei		CHECKED BY: M. Wilson		FIELD INVESTIGATION BY: C. Hoodley		DESIGN BRANCH X		6.2			
065 CIVIL LOG OF TEST BORINGS SHEET		ORIGINAL SCALE IN INCHES FOR REDUCED PLANS		UNIT: 3643		PROJECT NUMBER & PHASE: 08000006091		CONTRACT NO.: 08-3401U1		DISREGARD PRINTS BEARING EARLIER REVISION DATES	
				0 1 2 3		FILE => rw328.dgn		REVISION DATES		SHEET OF	
								10-15-12 11-09-12 12-18-12 12-14-12		X X	

USERNAME => s128444 DATE PLOTTED => 28-DEC-2012 TIME PLOTTED => 13:41

DIST	COUNTY	ROUTE	POST MILES TOTAL PROJECT	SHEET No.	TOTAL SHEETS
08	SBd	138			

Chris Hoadley
 CERTIFIED ENGINEERING GEOLOGIST 12-27-12 DATE

PLANS APPROVAL DATE


Chris Hoadley
 No. 2309
 Exp. 11-23-13
 CERTIFIED ENGINEERING GEOLOGIST
 STATE OF CALIFORNIA

The State of California or its officers or agents shall not be responsible for the accuracy or completeness of electronic copies of this plan sheet.

This LOTB sheet was prepared in accordance with the Caltrans Soil & Rock Logging, Classification, & Presentation Manual (2010 Edition).
 See 2010 Standard Plans A10F and A10G for Soil Legend, and A10H for Rock Legend.


BENCH MARK

Set STD brass stamped "SBd 138 GPS 7.00 1999", 50' W'ly Y.S. Rte 138 at top of cut in saddle area, at PM 7.0 NAD 83 (Vertical) Zone 5.

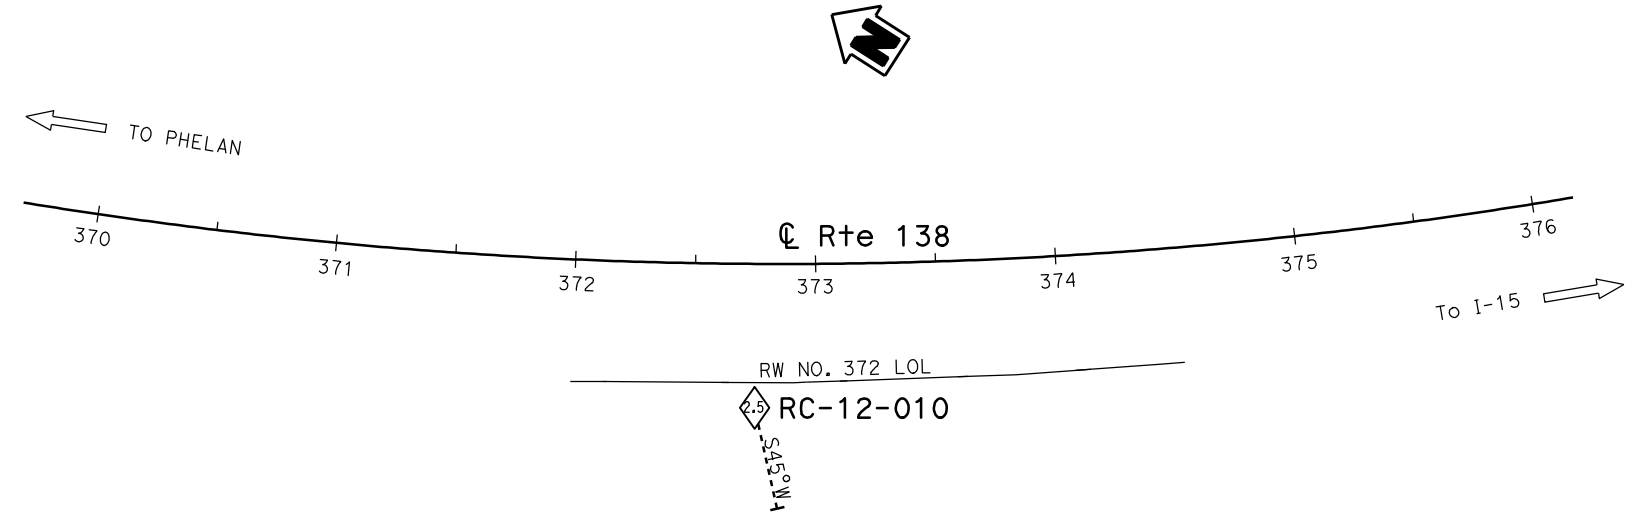

PLAN
 1" = 40'

Note: No ground water encountered during field investigation.

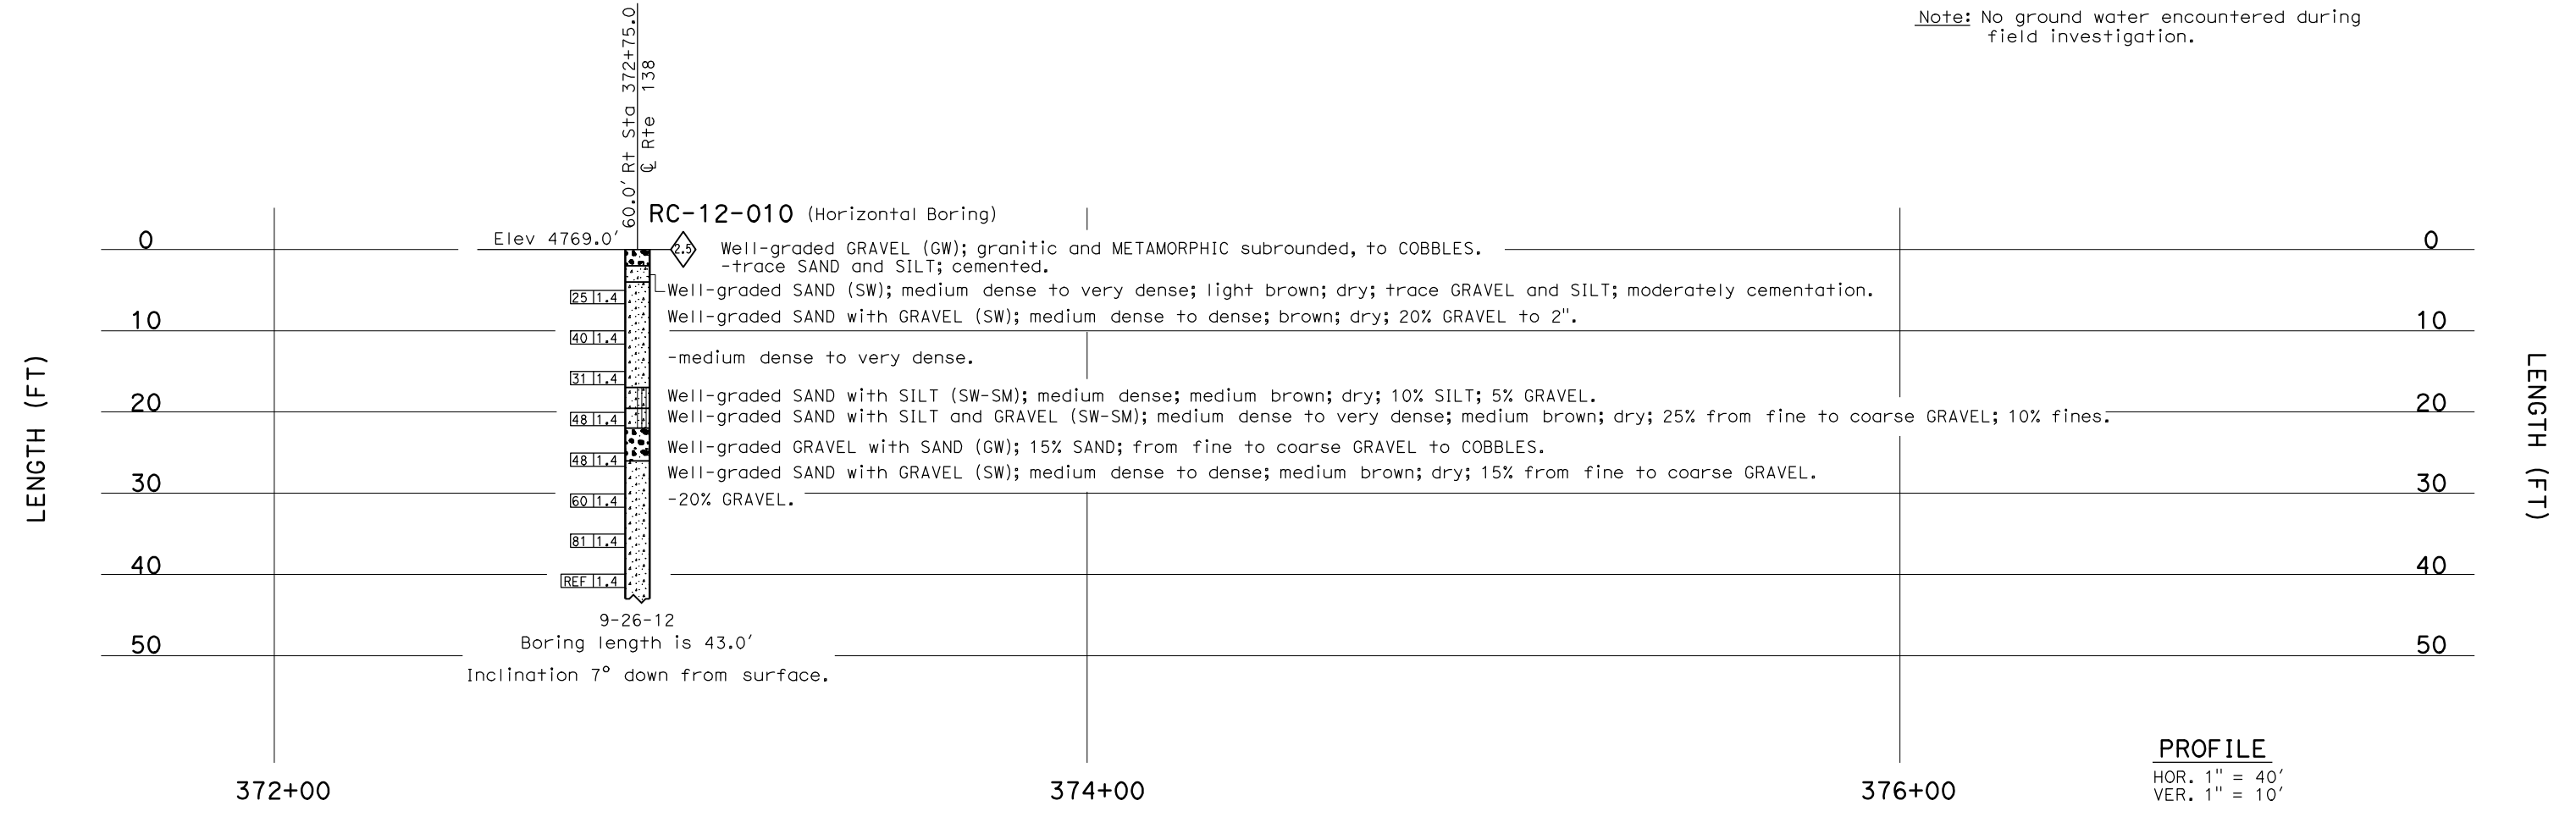

PROFILE
 HOR. 1" = 40'
 VER. 1" = 10'

ENGINEERING SERVICES		MATERIALS AND GEOTECHNICAL SERVICES		STATE OF CALIFORNIA		DIVISION OF ENGINEERING SERVICES		BRIDGE NO.		RETAINING WALL NO. 372	
FUNCTIONAL SUPERVISOR		DRAWN BY: F. Nguyen		DEPARTMENT OF TRANSPORTATION		STRUCTURE DESIGN		RW 372		LOG OF TEST BORINGS	
NAME: S. Wei		CHECKED BY: M. Wilson		FIELD INVESTIGATION BY: C. Hoadley		DESIGN BRANCH X		POST MILE 7.0			
065 CIVIL LOG OF TEST BORINGS SHEET		ORIGINAL SCALE IN INCHES FOR REDUCED PLANS		UNIT: 3643		PROJECT NUMBER & PHASE: 0800006091		CONTRACT NO.: 08-3401U1		DISREGARD PRINTS BEARING EARLIER REVISION DATES	
				0 1 2 3		FILE => rw372.dgn		REVISION DATES		SHEET OF	
								10-18-12 10-30-12 12-27-12 12-14-12		X X	

USERNAME => s128444 DATE PLOTTED => 28-DEC-2012 TIME PLOTTED => 13:41