
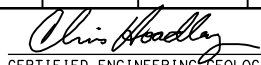


DIST	COUNTY	ROUTE	POST MILES TOTAL PROJECT	SHEET No	TOTAL SHEETS
08	SBd	138			

  
 CERTIFIED ENGINEERING GEOLOGIST 12-27-12

PLANS APPROVAL DATE \_\_\_\_\_


*The State of California or its officers or agents shall not be responsible for the accuracy or completeness of electronic copies of this plan sheet.*

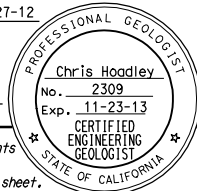

This LOTB sheet was prepared in accordance with the Caltrans Soil & Rock Logging, Classification, & Presentation Manual (2010 Edition). See 2010 Standard Plans A10F and A10G for Soil Legend, and A10H for Rock Legend.

**BENCH MARK**


SET STD DISK IN CONC DN 3"  
 STAMPED "P1-71-P1-21",  
 29' RIGHT OF ?? PM 7.12  
 NAD83 (VERTICAL)  
 ZONE 5

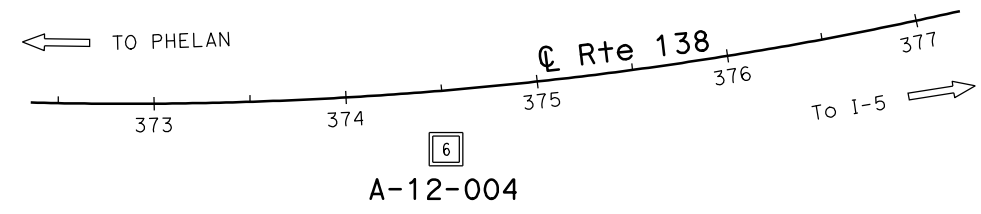

A-12-004

**PLAN**  
 1" = 50'

Note: No ground water encountered during field investigation.

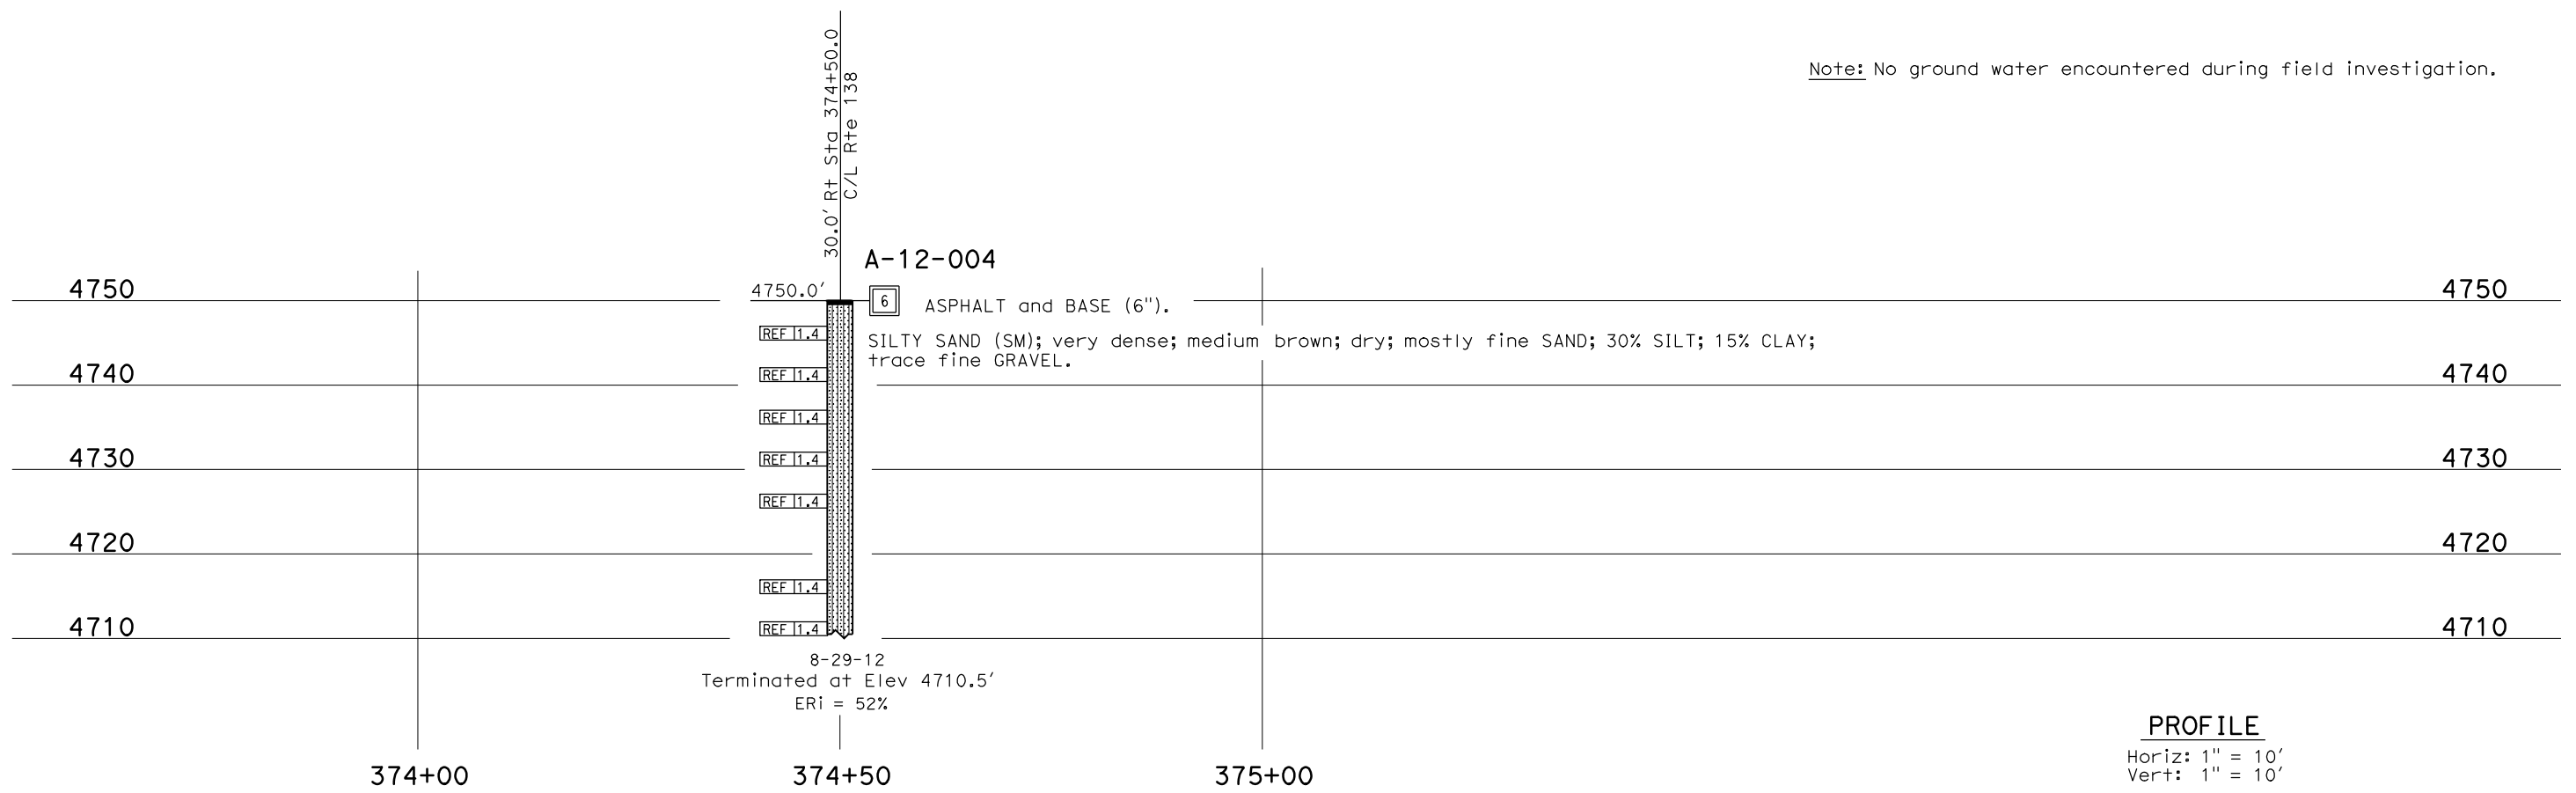

**PROFILE**  
 Horiz: 1" = 10'  
 Vert: 1" = 10'

<b>ENGINEERING SERVICES</b>		<b>MATERIALS AND GEOTECHNICAL SERVICES</b>		<b>STATE OF CALIFORNIA</b>		<b>DIVISION OF ENGINEERING SERVICES</b>		<b>BRIDGE NO.</b>		<b>RETAINING WALL NO. 376</b>	
FUNCTIONAL SUPERVISOR		DRAWN BY: W. Tang 10/12		FIELD INVESTIGATION BY:		STRUCTURE DESIGN		POST MILE		<b>LOG OF TEST BORINGS</b>	
NAME: S. Wei		CHECKED BY: M. Wilson		C. Hoodley		<b>DESIGN BRANCH X</b>		7.1			
065 CIVIL LOG OF TEST BORINGS SHEET		ORIGINAL SCALE IN INCHES FOR REDUCED PLANS		0 1 2 3		UNIT: 3643		PROJECT NUMBER & PHASE: 08000006091		CONTRACT NO.: 08-3401U1	
						DISREGARD PRINTS BEARING EARLIER REVISION DATES		REVISION DATES		SHEET OF	
								11-09-12 12-07-12		X X	

FILE => rw376.dgn

USERNAME => s128444 DATE PLOTTED => 28-DEC-2012 TIME PLOTTED => 13:41

DIST	COUNTY	ROUTE	POST MILES TOTAL PROJECT	SHEET No	TOTAL SHEETS
08	SBd	138			

*Chris Hoodley* 12-27-12  
 CERTIFIED ENGINEERING GEOLOGIST


PLANS APPROVAL DATE \_\_\_\_\_

*The State of California or its officers or agents shall not be responsible for the accuracy or completeness of electronic copies of this plan sheet.*

This LOTB sheet was prepared in accordance with the Caltrans Soil & Rock Logging, Classification, & Presentation Manual (2010 Edition). See 2010 Standard Plans A10F and A10G for Soil Legend, and A10H for Rock Legend.

**BENCH MARK**


FD 6X6" CONC R/W MONUMENT 100' RT  
 STATION 674+48.18 EC, PM8.64.  
 NAD83 (VERTICAL)  
 ZONE 5

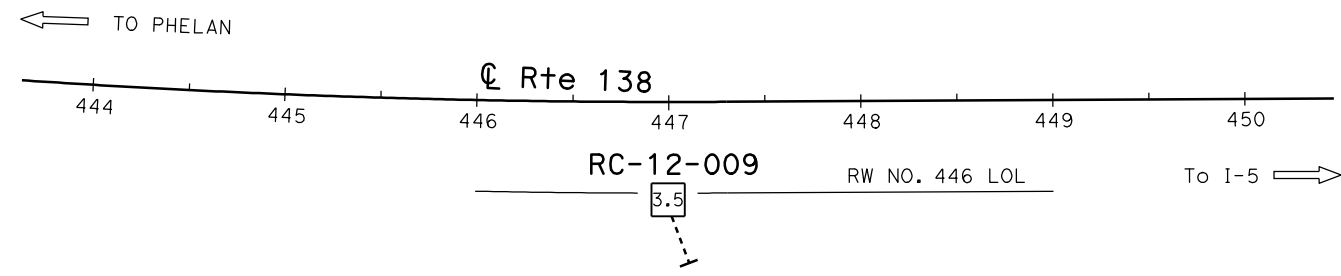

**PLAN**

1" = 50'

Note: No ground water encountered during field investigation.

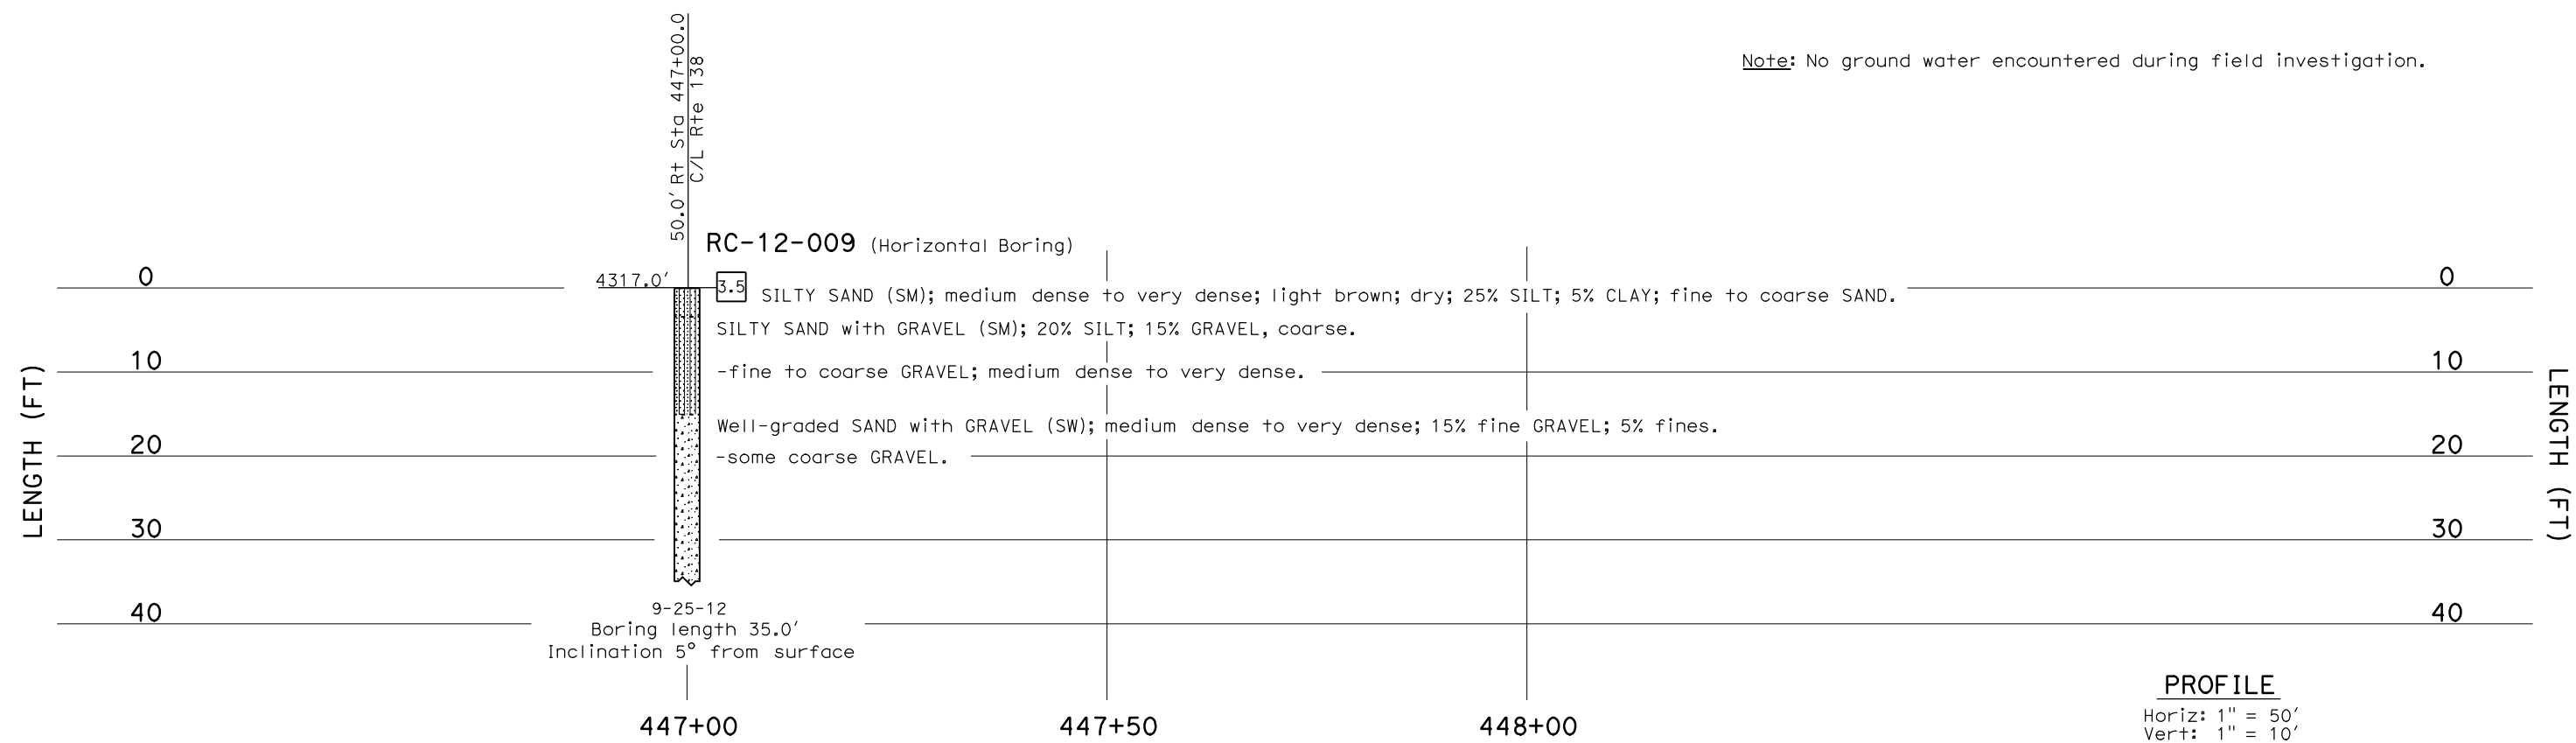



**PROFILE**

Horiz: 1" = 50'  
 Vert: 1" = 10'

<b>ENGINEERING SERVICES</b>		<b>MATERIALS AND GEOTECHNICAL SERVICES</b>		<b>STATE OF CALIFORNIA DEPARTMENT OF TRANSPORTATION</b>		<b>DIVISION OF ENGINEERING SERVICES STRUCTURE DESIGN DESIGN BRANCH X</b>		<b>BRIDGE NO. RW446 POST MILE 8.5</b>		<b>RETAINING WALL NO. 446 LOG OF TEST BORINGS</b>	
FUNCTIONAL SUPERVISOR NAME: S. Wei	DRAWN BY: W. Tang 10/12 CHECKED BY: M. Wilson	FIELD INVESTIGATION BY: C. Hoodley		UNIT: 3643 PROJECT NUMBER & PHASE: 08000006091		CONTRACT NO.: 08-3401U1		DISREGARD PRINTS BEARING EARLIER REVISION DATES		REVISION DATES 10-15-12 11-14-12 12-07-12	
O&S CIVIL LOG OF TEST BORINGS SHEET				ORIGINAL SCALE IN INCHES FOR REDUCED PLANS		FILE => rw446.dgn		SHEET OF X X		DATE PLOTTED => 13:41 USERNAME => s128444	




DIST	COUNTY	ROUTE	POST MILES TOTAL PROJECT	SHEET No	TOTAL SHEETS
08	SBd	138			

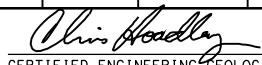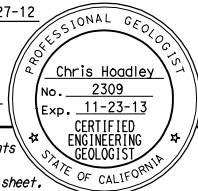  
 CERTIFIED ENGINEERING GEOLOGIST 12-27-12  


PLANS APPROVAL DATE \_\_\_\_\_

The State of California or its officers or agents shall not be responsible for the accuracy or completeness of electronic copies of this plan sheet.

This LOTB sheet was prepared in accordance with the Caltrans Soil & Rock Logging, Classification, & Presentation Manual (2010 Edition). See 2010 Standard Plans A10F and A10G for Soil Legend, and A10H for Rock Legend.

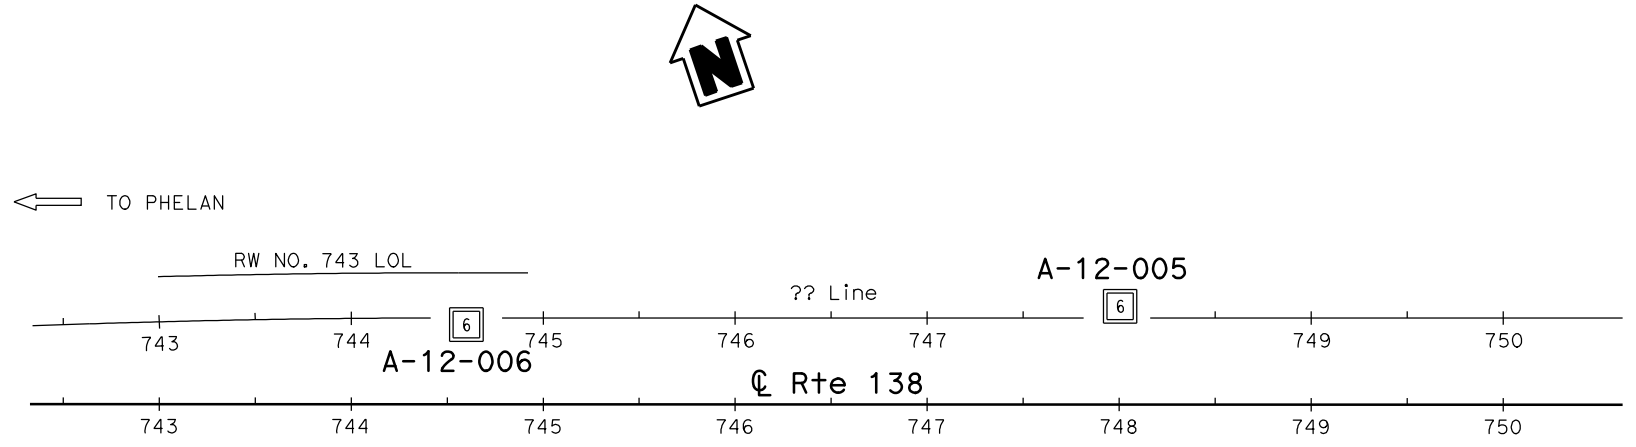


**BENCH MARK**

SET STD DISK STAMPED "SBd 138 GPS 9 1999" 100' +/- N'LY Y.S. Rte 138 ON TOP OF CUT S'WLY OF R/R OVERCROSS, 23' S'LY SPLIT R/R TRACKS, 10' W'LY CONC ENCASED CMP, PM14.1. NAD83 (VERTICAL) ZONE 5

PLAN  
1" = 50'

Note: No ground water encountered during field investigation.

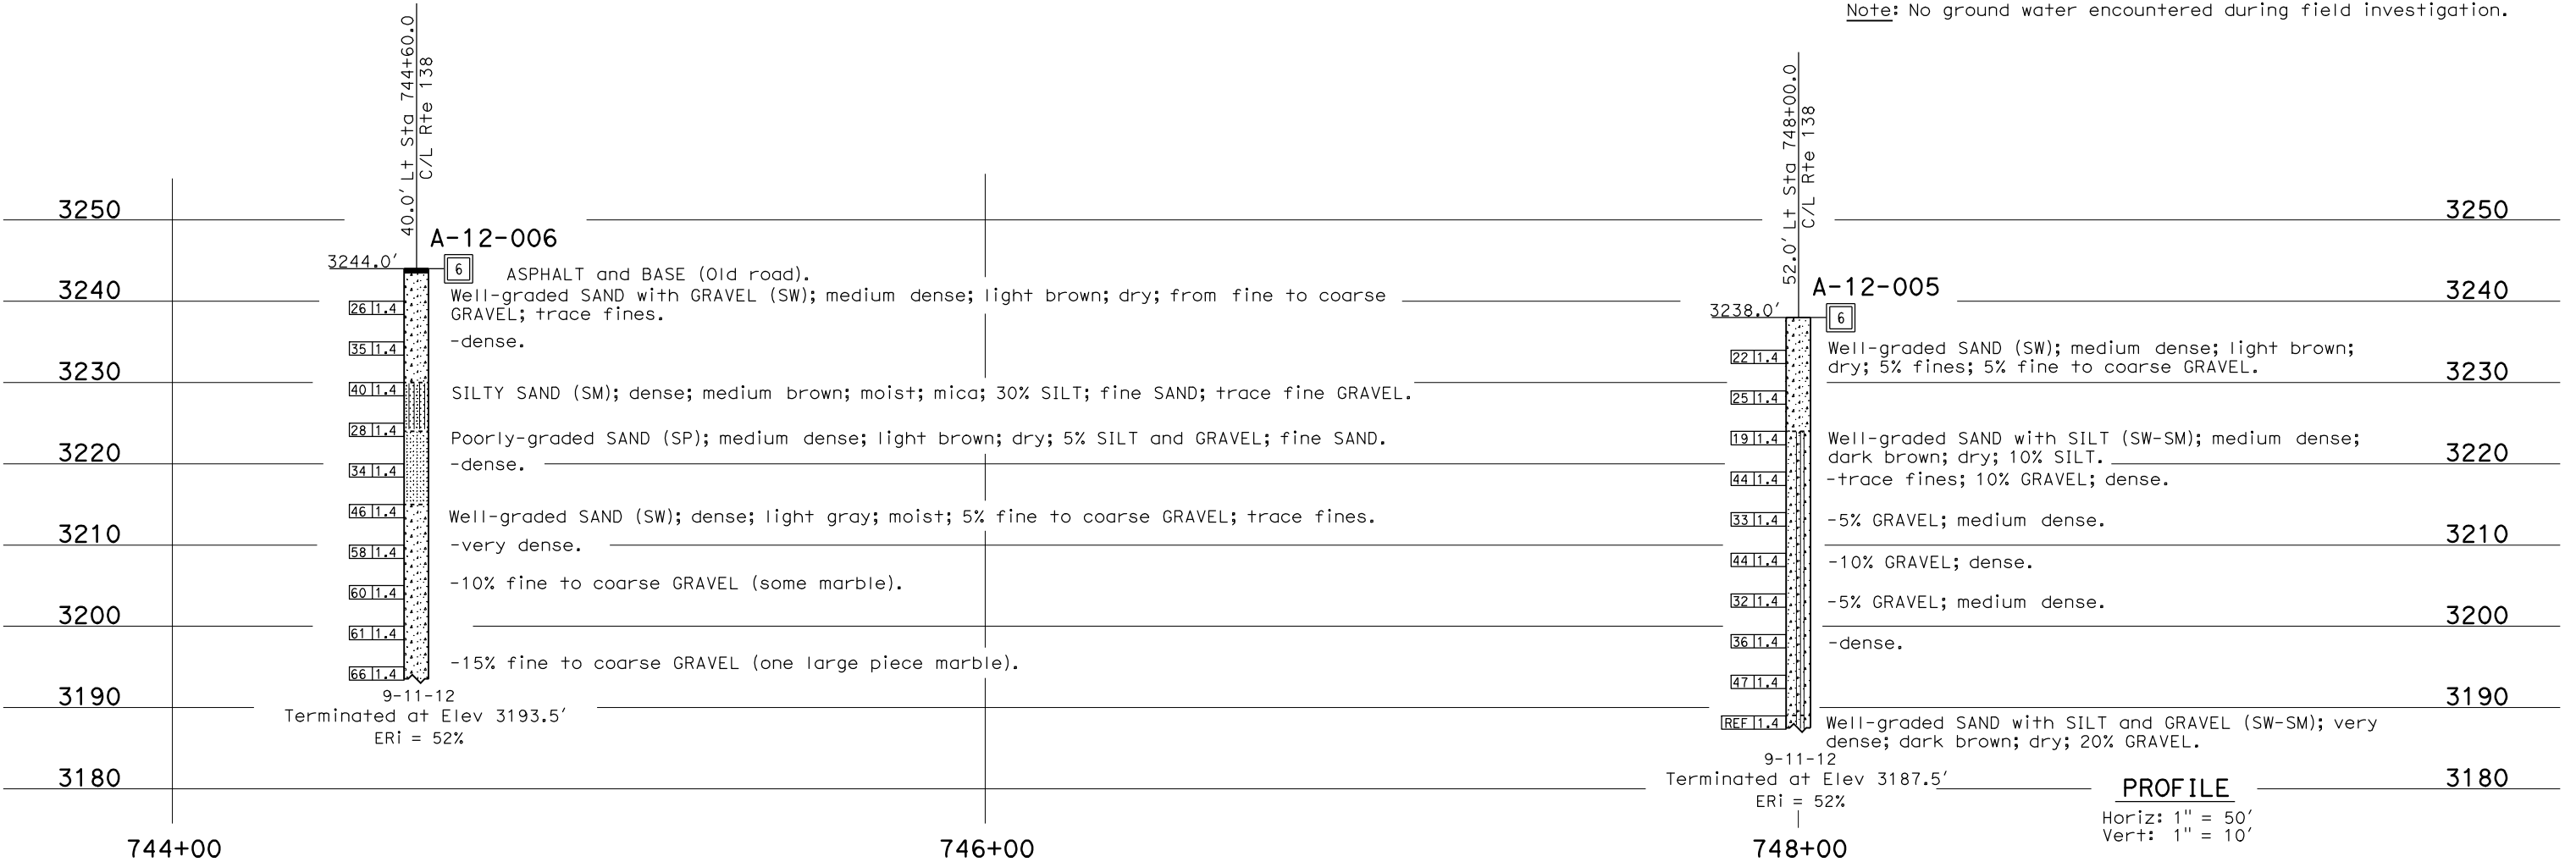

<b>ENGINEERING SERVICES</b>		<b>MATERIALS AND GEOTECHNICAL SERVICES</b>		<b>STATE OF CALIFORNIA DEPARTMENT OF TRANSPORTATION</b>		<b>DIVISION OF ENGINEERING SERVICES STRUCTURE DESIGN DESIGN BRANCH X</b>		<b>BRIDGE NO.</b>		<b>RETAINING WALL NO. 743 LOG OF TEST BORINGS</b>	
FUNCTIONAL SUPERVISOR	DRAWN BY: W. Tang 10/12	FIELD INVESTIGATION BY:		UNIT: 3643		PROJECT NUMBER & PHASE: 08000006091		CONTRACT NO.: 08-3401U1		DISREGARD PRINTS BEARING EARLIER REVISION DATES	
NAME: S. Wei	CHECKED BY: M. Wilson	C. Hoodley		ORIGINAL SCALE IN INCHES FOR REDUCED PLANS		FILE => rw743.dgn		REVISION DATES		SHEET	OF
085 CIVIL LOG OF TEST BORINGS SHEET										X	X

USERNAME => s128444 DATE PLOTTED => 28-DEC-2012 TIME PLOTTED => 13:41

## Gish Overhead




## Alray Overhead



**CIDH Pile Footing:**  
 Pile type: 16" CIDH  
 Total Piles: 101  
 Lin. Ft., Plans: 2,585  
 Lin. Ft., As built: 2,621  
 MATERIAL EXCAVATED FROM CIDH piles conformed substantially to that shown on this LOG of Test Borings. No ground water encountered.

**SPREAD FOOTING:**  
 Foundation material encountered AT spread footing (E.L.) locations conformed to that shown on this log of Test Borings. No footing elevation REVISIONS Required. Ground water NOT Encountered.

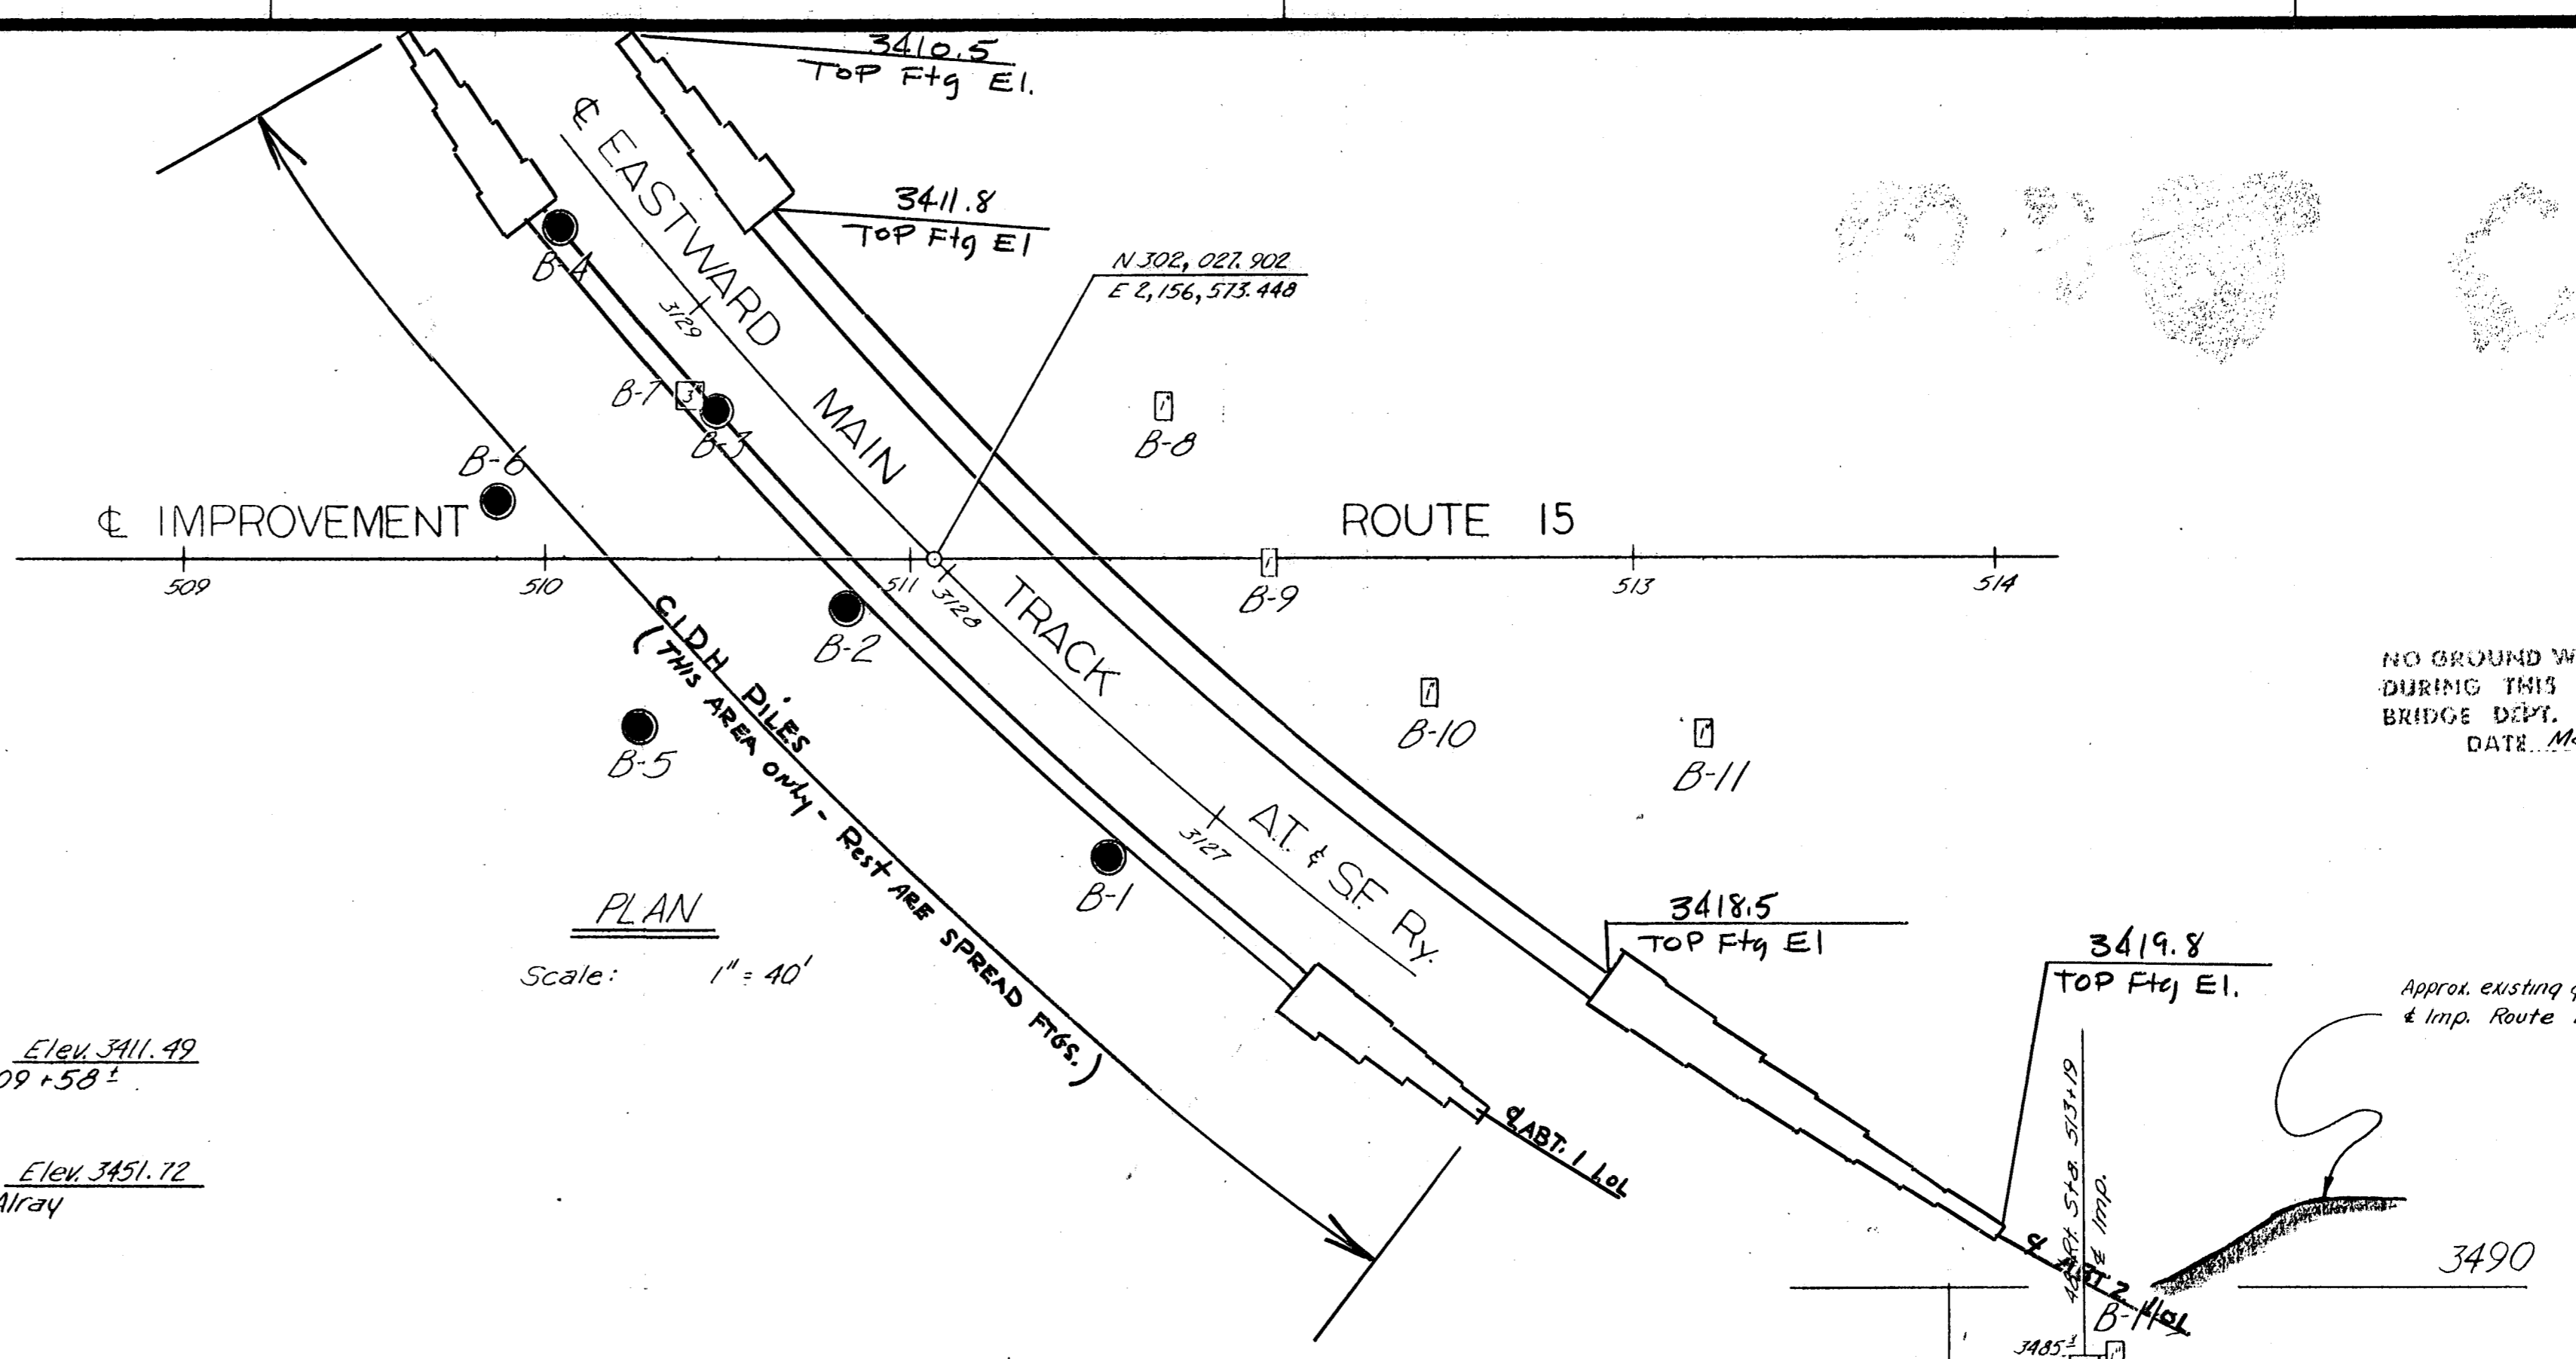


**BENCH MARKS**

BM B Alray 65 Elev. 3411.49  
 Spd. nail in 2" x 2" hub buried 0.8' 156' ± Lt. 509+58 ±  
 POT & Imp.




BM 52-A-50 Elev. 3451.72  
 Spd. nail in lead in S'ly end of E'ly abut. of Alray Underpass. Bridge No. 54-23

NO GROUND WATER ENCOUNTERED DURING THIS INVESTIGATION BY BRIDGE DEPT. GEOLOGY SECTION DATE March, 1967

Approx. existing ground line along & Imp. Route 15

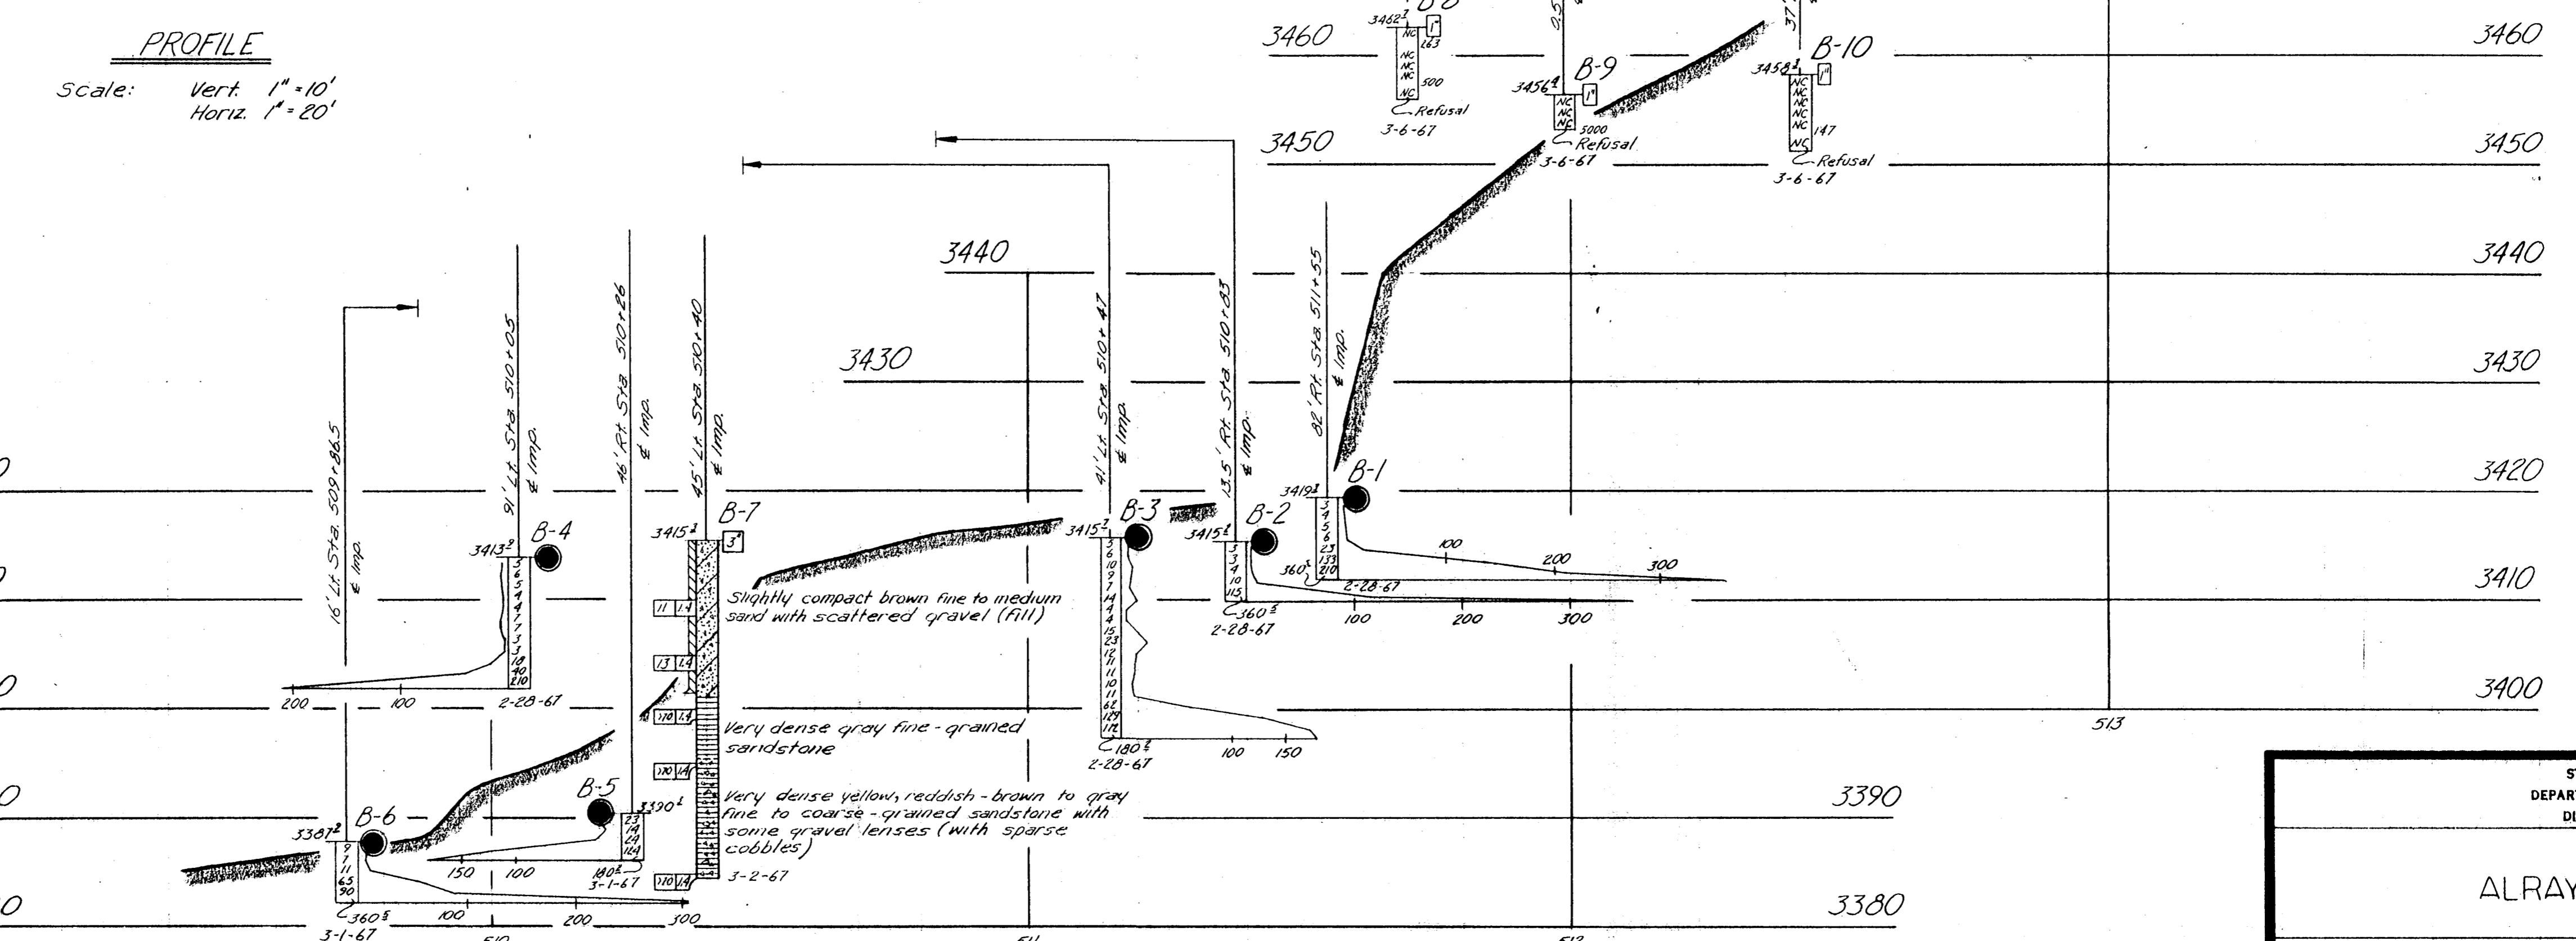

**AS BUILT**  
 CORRECTIONS BY R. P. Sommers  
 CONTRACT NO. 08-049124  
 DATE 12/68

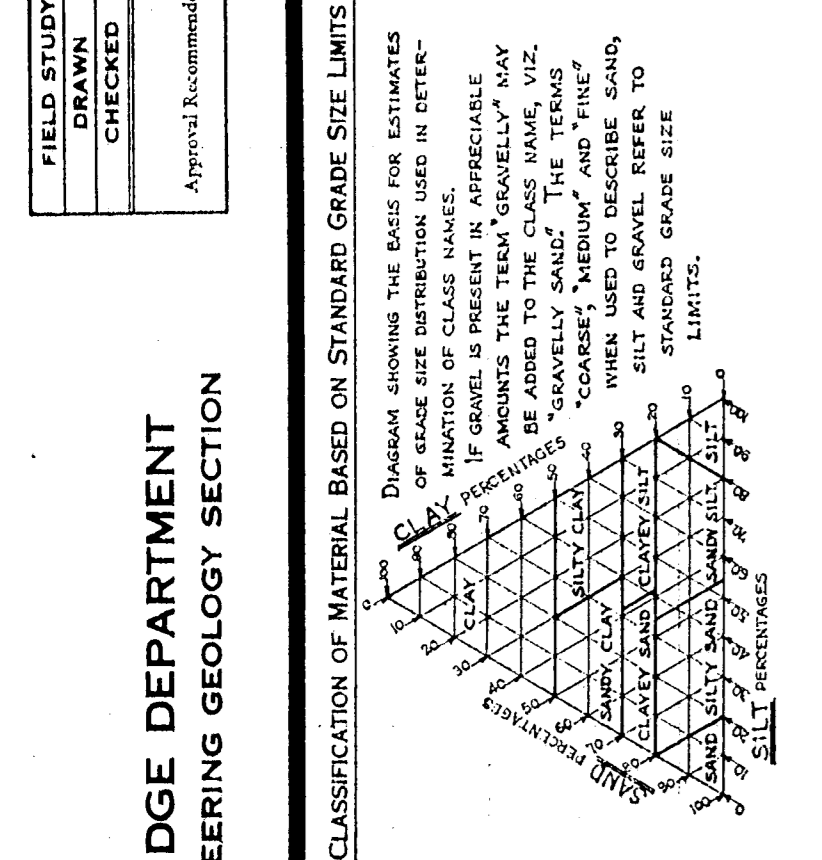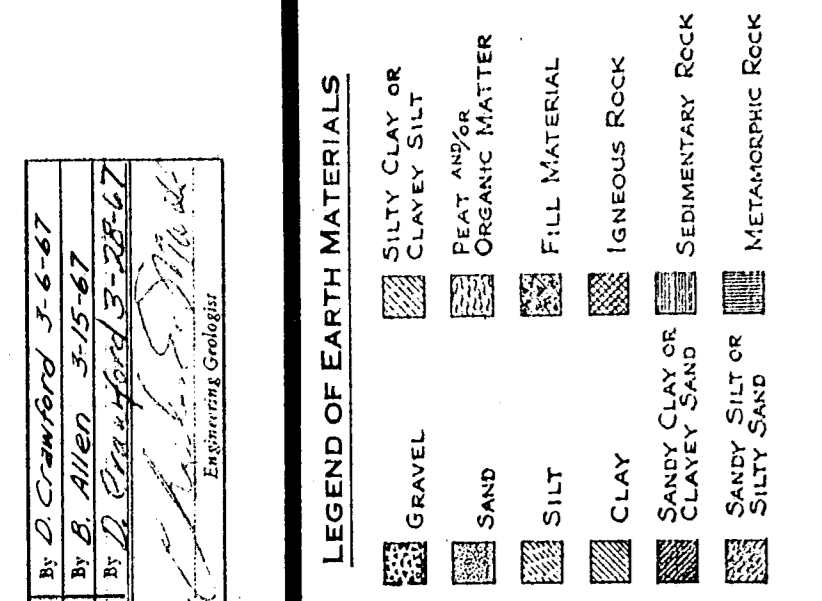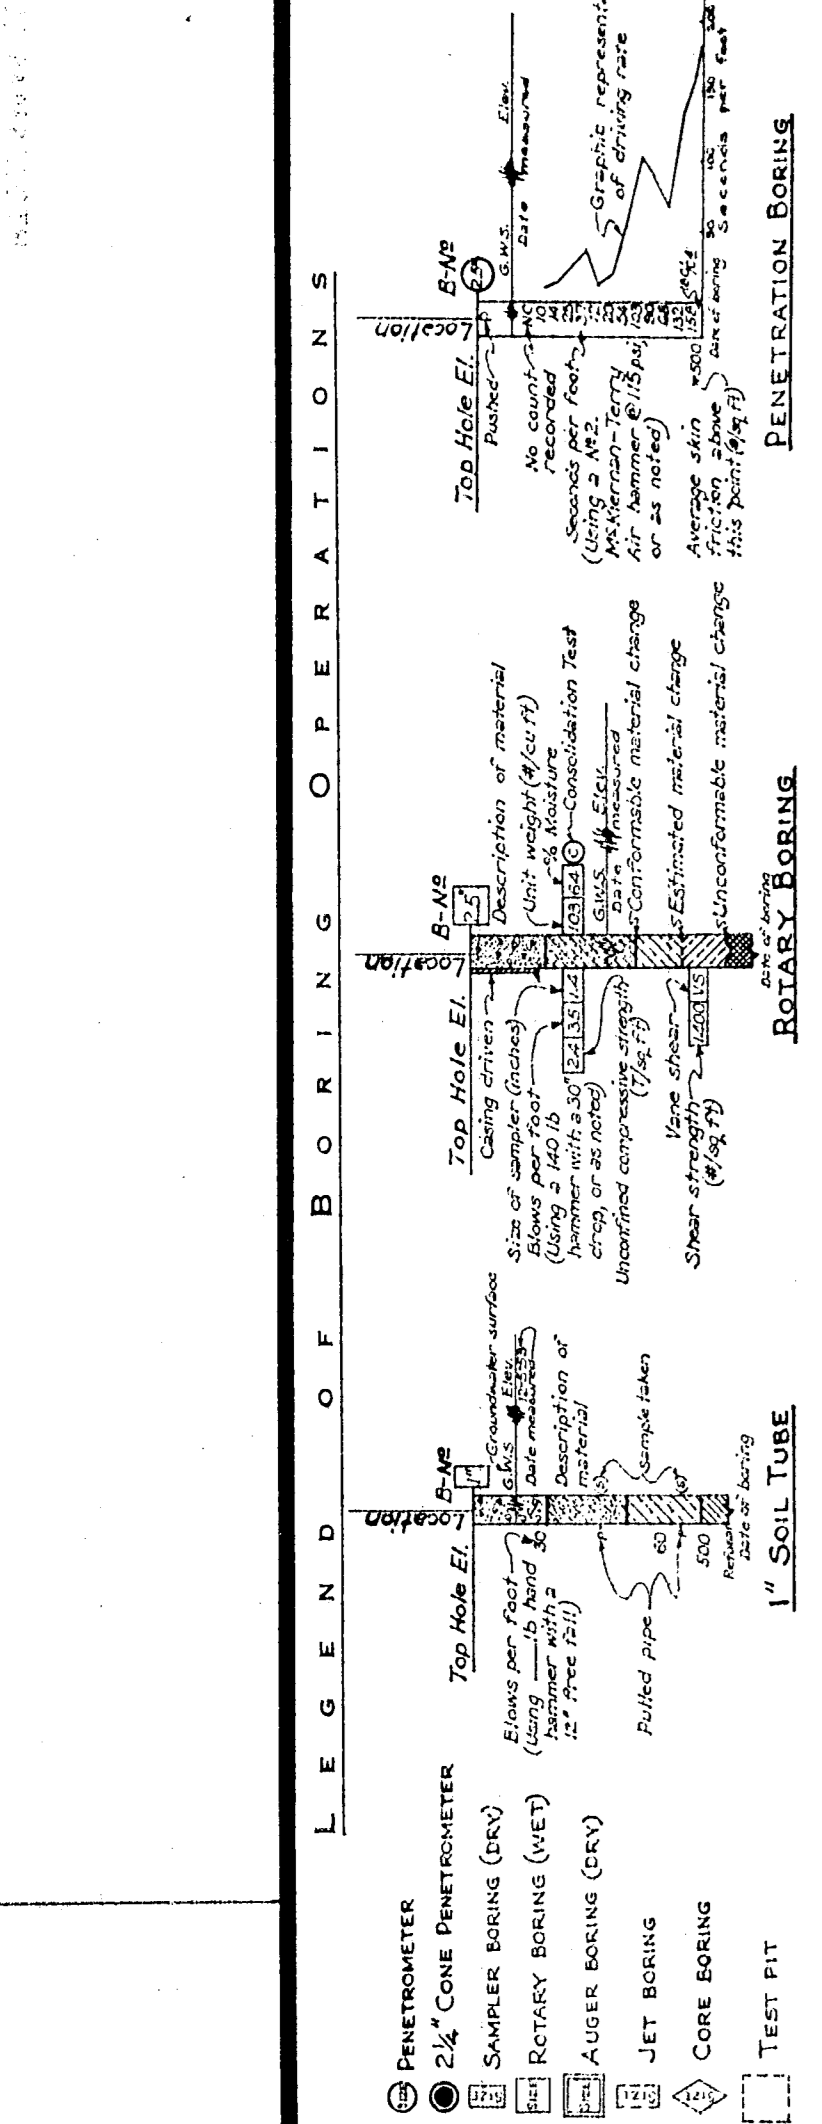

NOTE: Classification of earth material as shown on this sheet is based upon field inspection and is not to be construed to imply mechanical analysis.

BRIDGE DEPARTMENT  
 ENGINEERING GEOLOGY SECTION

STATE OF CALIFORNIA  
 DEPARTMENT OF PUBLIC WORKS  
 DIVISION OF HIGHWAYS

ALRAY OVERHEAD  
 LOG OF TEST BORINGS

SCALE As Noted BRIDGE 54-797 P.M. 22.7 DRAWING

SHEET 105 OF 114

## North Alray Overhead





## South Forest Road

**No As-Builts nor any LOTBs for the South Forest Road Undercrossing (Santa Fe Rd) Caltrans Bridge No. 54-0940R can be located within the online Caltrans GEODog database <https://geodog.dot.ca.gov/>.**



Oak Hill Road OC

BM # 7 A 57 Elev. 4077.76  
 Spha. no. 1 in 1e.20 SA cor. P.C. DI 40.5  
 Rt. Ex. W P.3 Ba (B) Lt. 66 +04

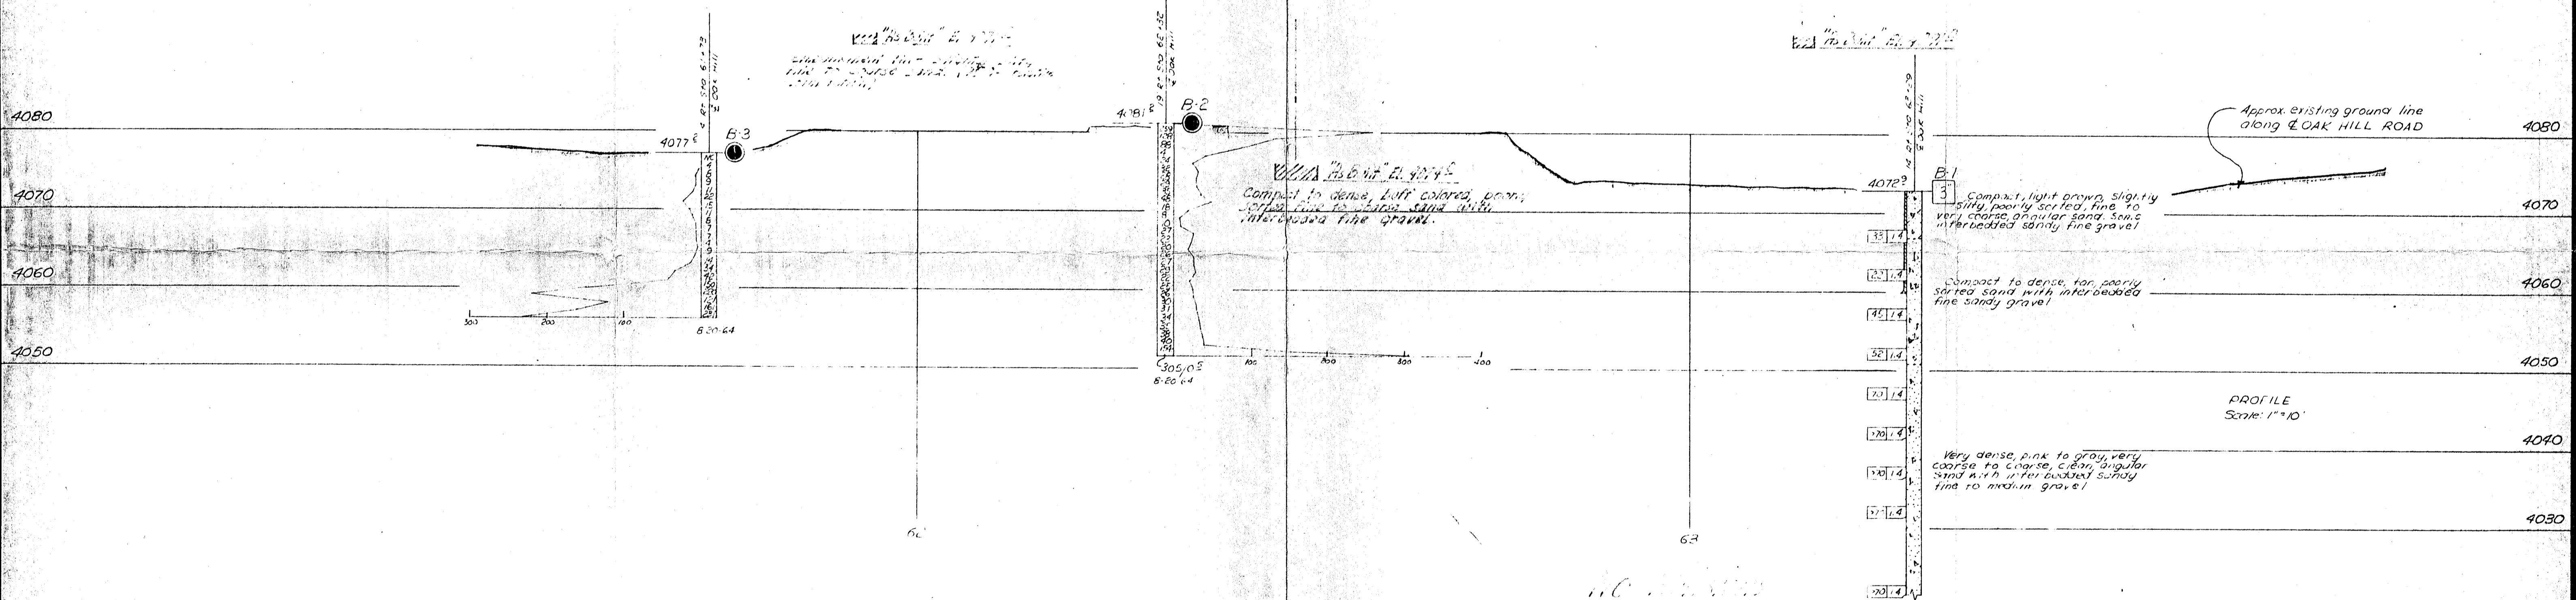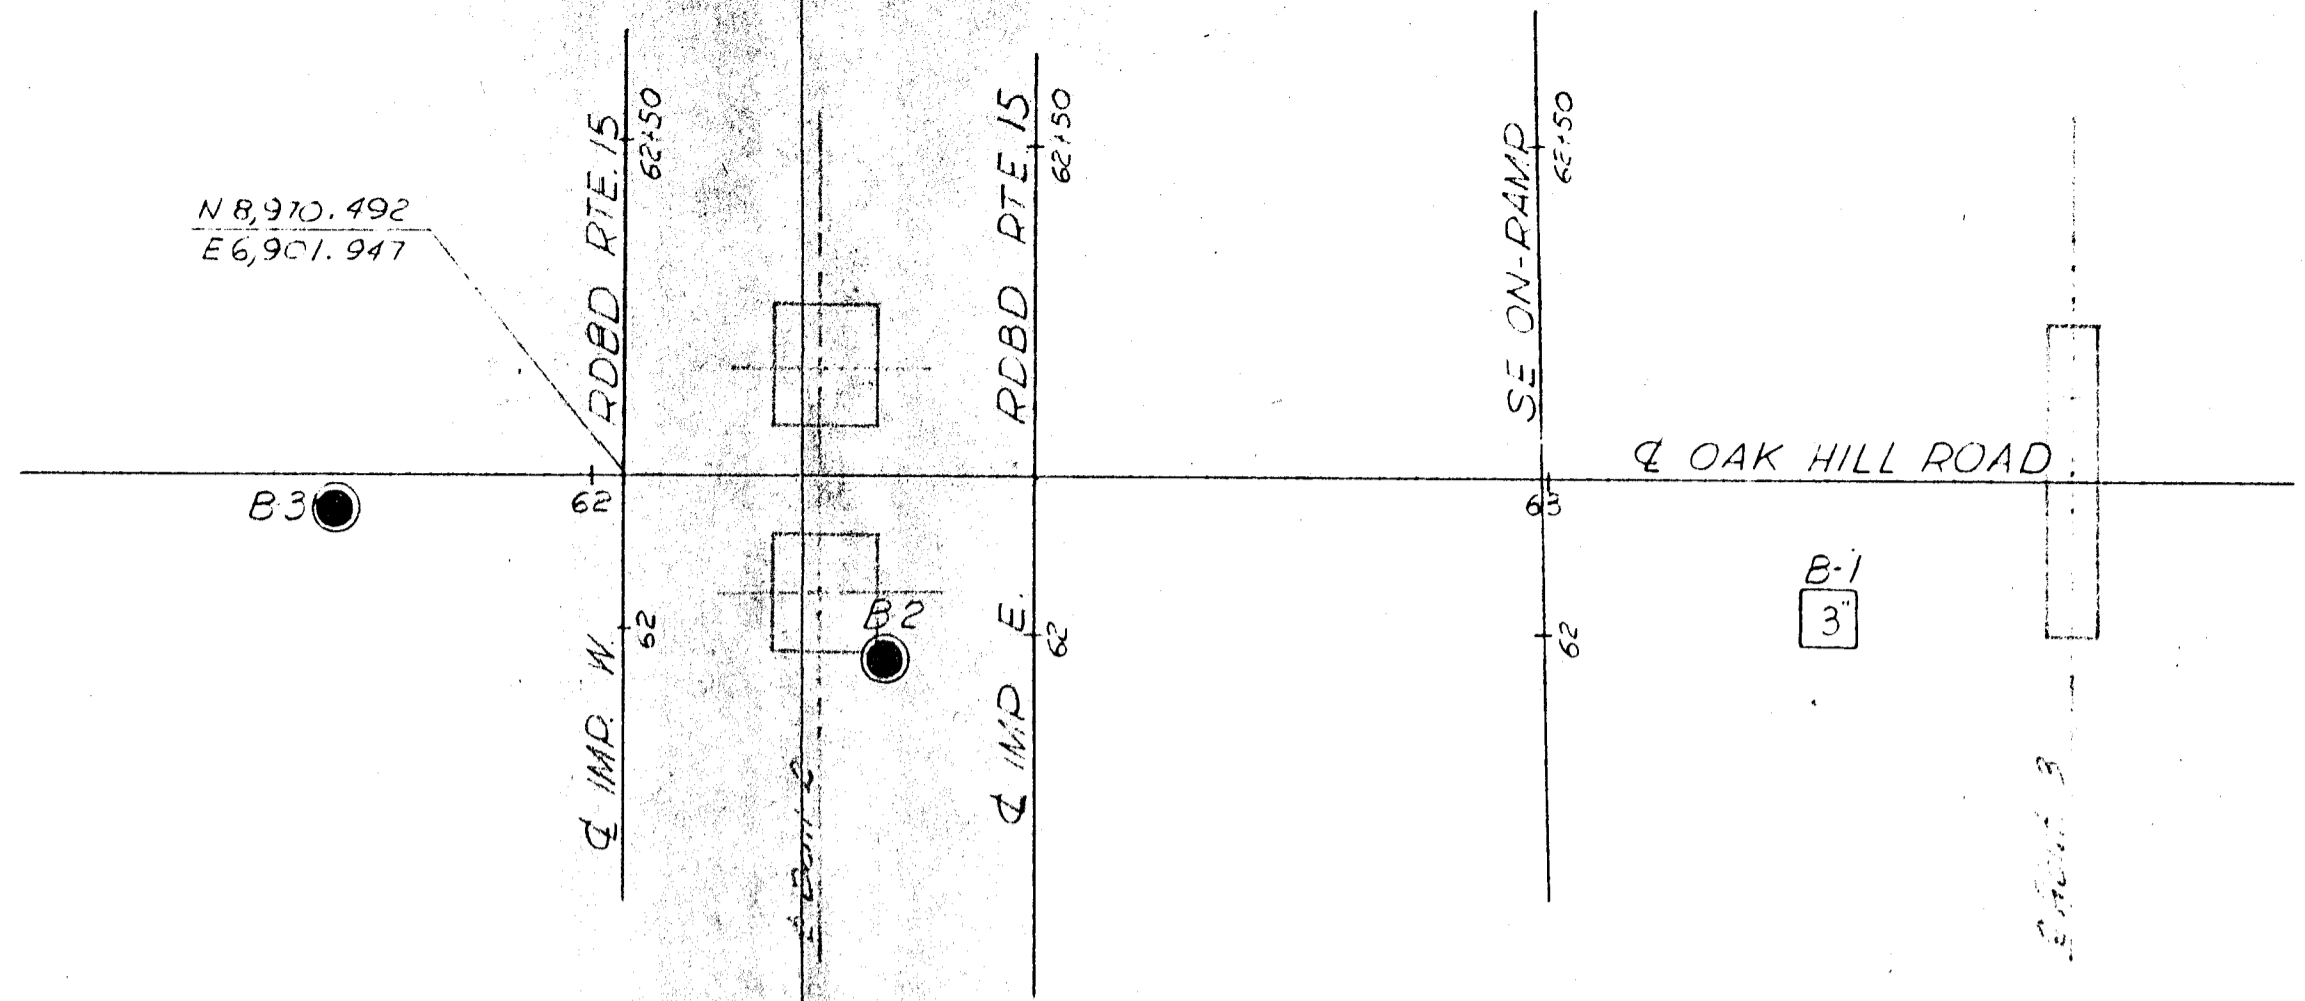


AS BUILT  
 CORRECTIONS BY  
 CONTRACT NO.  
 DATE

NO GROUND WATER ENCOUNTERED  
 DURING THIS INVESTIGATION BY  
 BRIDGE DEPT. GEOLOGY SECTION  
 DATE AUGUST 1964

SHEET	OF
12	12

FIELD STUDY BY C.G. B...  
 CHECKED BY...  
 DATE...

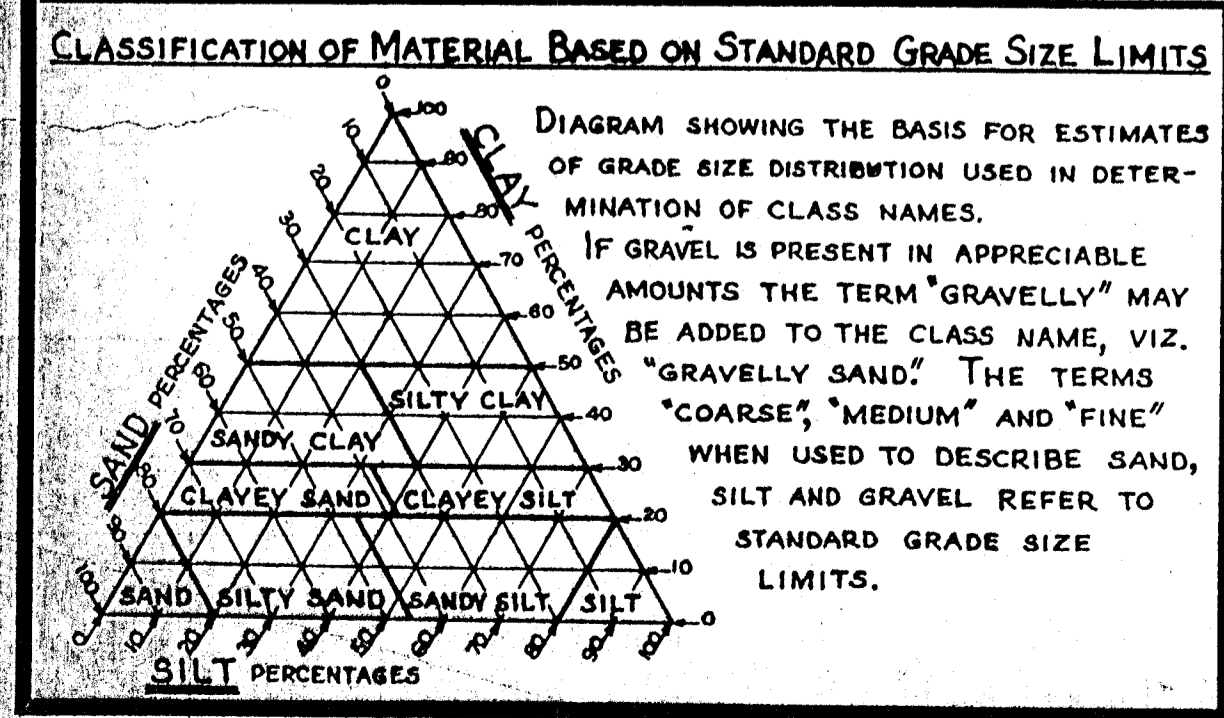

LEGEND OF EARTH MATERIALS

GRAVEL	SILTY CLAY OR CLAYEY SILT
SAND	PEAT AND/OR ORGANIC MATTER
SILT	FILL MATERIAL
CLAY	IGNEOUS ROCK
SANDY CLAY OR CLAYEY SAND	SEDIMENTARY ROCK
SANDY SILT OR SILTY SAND	METAMORPHIC ROCK

LEGEND OF BORING OPERATIONS

● PENETROMETER	○ 2 1/4" CONE PENETROMETER
□ SAMPLER BORING (DRY)	□ ROTARY BORING (WET)
□ AUGER BORING (DRY)	□ JET BORING
□ CORE BORING	□ TEST PIT

NOTE  
 Classification of earth material as shown on this sheet is based upon field inspection and is not to be construed to imply mechanical analysis.

STATE OF CALIFORNIA  
 DEPARTMENT OF PUBLIC WORKS  
 DIVISION OF HIGHWAYS

OAK HILL ROAD OVERCROSSING

LOG OF TEST BORINGS

SCALE As Noted BRIDGE 54-740 FILE PM 286 DRAWING 54740-10

Charge: 08201 WA: 039641

## Ranchero Road OC

No As-Builts nor any LOTBs for the Ranchero Road OC Caltrans Bridge No. 54-1285 can be located within the online Caltrans GEODog database <https://geodog.dot.ca.gov/>.

Logs of nearby borings performed for infiltration basins were found in the database.



Caliente Rd

Barstow Fwy

16

A-19-001

A-19-003

CHP Officer Richard D. Duvall Memorial Hwy

A-19-002

Ranchero Rd

Marposa Rd




LOGGED BY <b>K. Barker</b>	BEGIN DATE <b>2-27-19</b>	COMPLETION DATE <b>2-27-19</b>	BOREHOLE LOCATION (Lat/Long or North/East and Datum) <b>34° 23' 1.22" / -117° 24' 56.72" NAD83</b>	HOLE ID <b>A-19-001</b>
DRILLING CONTRACTOR <b>Caltrans</b>			BOREHOLE LOCATION (Offset, Station, Line)	SURFACE ELEVATION <b>-3880.0 ft NAVD88</b>
DRILLING METHOD <b>Hollow-Stem Auger</b>			DRILL RIG <b>CS 2000 (truck)</b>	BOREHOLE DIAMETER <b>8 in</b>
SAMPLER TYPE(S) AND SIZE(S) (ID) <b>SPT (1.4")</b>			SPT HAMMER TYPE <b>Automatic</b>	HAMMER EFFICIENCY, ERI <b>94%</b>
BOREHOLE BACKFILL AND COMPLETION <b>grout</b>			GROUNDWATER READINGS <b>N/A</b>	AFTER DRILLING (DATE) <b></b>
				TOTAL DEPTH OF BORING <b>50.0 ft</b>

ELEVATION (ft)	DEPTH (ft)	Material Graphics	DESCRIPTION	Sample Location	Sample Number	Blows per 6 in.	Blows per foot	Recovery (%)	RQD (%)	Moisture Content (%)	Dry Unit Weight (pcf)	Shear Strength (tsf)	Drilling Method	Casing Depth	Remarks
3878.00	0		Well-graded SAND with CLAY (SW-SC); dark brown; moist; few to little medium plasticity fines; few fine GRAVEL.												
3876.00	4		SILTY SAND (SM); medium dense; brown; dry; mostly fine and medium SAND; little fines.	S-1	13 6 9	15									
3874.00	6														
3872.00	8														
3870.00	10		Dense; few fine GRAVEL ; weak cementation.	S-2	5 12 14	26									
3868.00	12														
3866.00	14														
3864.00	16		CLAYEY SAND (SC); very dense; dark brown; dry; mostly fine and medium SAND; little fines; moderate cementation.	S-3	11 25 25	50									
3862.00	18														
3860.00	20			S-4	21 22 26	48									
3858.00	22														
3856.00	24														
	25														

(continued)

S BR - STANDARD RTE 15 INFILTRATION BASINS.GPJ CALTRANS LIBRARY (FEB 2017).GLB 3/1/19

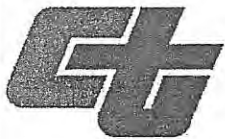

Department of Transportation  
Division of Engineering Services  
Geotechnical Services  
Office of Geotechnical Design - South

REPORT TITLE <b>BORING RECORD</b>				HOLE ID <b>A-19-001</b>	
DIST. <b>08</b>	COUNTY <b>SBD</b>	ROUTE <b>15</b>	POSTMILE <b>30.4</b>	PROJECT ID <b>0815000244</b>	
PROJECT OR BRIDGE NAME					
BRIDGE NUMBER		PREPARED BY		DATE	SHEET 1 of 2

ELEVATION (ft)	DEPTH (ft)	Material Graphics	DESCRIPTION	Sample Location	Sample Number	Blows per 6 in.	Blows per foot	Recovery (%)	RQD (%)	Moisture Content (%)	Dry Unit Weight (pcf)	Shear Strength (tsf)	Drilling Method	Casing Depth	Remarks	
3854.00	25		SILTY SAND (SM); very dense; brown; dry; mostly fine and medium SAND; little fines; moderate cementation.	S-5	13	38										
	26					17										
	27					21										
3852.00	28		Well-graded SAND with SILT (SW-SM); dense; brown; dry; mostly from fine to coarse SAND; weak cementation.	S-6	9	25										
	29					12										
	30					13										
3848.00	32		Very dense; uncemented.	S-7	12	43										
	33					20										
	34					23										
3846.00	34		Trace fine GRAVEL.	S-8	12	40										
	35					17										
	36					23										
3844.00	36			S-9	12	43										
	37					18										
	38					25										
3842.00	38															
3840.00	40															
3838.00	42															
3836.00	44															
3834.00	46															
3832.00	48															
3830.00	50		Bottom of borehole at 50.0 ft bgs													
	51															
3828.00	52		This Boring Record was developed in accordance with the Caltrans Soil & Rock Logging, Classification, and Presentation Manual (2010) except as noted on the Soil or Rock Legend or below.													
	53															
3826.00	54															
	55															

5 BR - STANDARD RTE-15 INFILTRATION BASINS.GPJ CALTRANS LIBRARY (FEB 2017).GLB 3/1/19



Department of Transportation  
 Division of Engineering Services  
 Geotechnical Services  
 Office of Geotechnical Design - South


REPORT TITLE <b>BORING RECORD</b>				HOLE ID <b>A-19-001</b>	
DIST. <b>08</b>	COUNTY <b>SBD</b>	ROUTE <b>15</b>	POSTMILE <b>30.4</b>	PROJECT ID <b>0815000244</b>	
PROJECT OR BRIDGE NAME					
BRIDGE NUMBER		PREPARED BY		DATE	
				SHEET <b>2 of 2</b>	



LOGGED BY <b>K. Barker</b>	BEGIN DATE <b>2-26-19</b>	COMPLETION DATE <b>2-26-19</b>	BOREHOLE LOCATION (Lat/Long or North/East and Datum) <b>34° 23' 3.93" / -117° 24' 53.21" NAD83</b>	HOLE ID <b>A-19-002</b>
DRILLING CONTRACTOR <b>Caltrans</b>			BOREHOLE LOCATION (Offset, Station, Line)	SURFACE ELEVATION <b>~3871.0 ft NAVD88</b>
DRILLING METHOD <b>Hollow-Stem Auger</b>			DRILL RIG <b>CS 2000 (truck)</b>	BOREHOLE DIAMETER <b>8 in</b>
SAMPLER TYPE(S) AND SIZE(S) (ID) <b>SPT (1.4")</b>			SPT HAMMER TYPE <b>Automatic</b>	HAMMER EFFICIENCY, ERI <b>94%</b>
BOREHOLE BACKFILL AND COMPLETION <b>grout</b>			GROUNDWATER READINGS <b>N/A</b>	AFTER DRILLING (DATE) <b></b>
				TOTAL DEPTH OF BORING <b>50.0 ft</b>

ELEVATION (ft)	DEPTH (ft)	Material Graphics	DESCRIPTION	Sample Location	Sample Number	Blows per 6 in.	Blows per foot	Recovery (%)	ROD (%)	Moisture Content (%)	Dry Unit Weight (pcf)	Shear Strength (tsf)	Drilling Method	Casing Depth	Remarks			
3869.00	1		Well-graded SAND with CLAY and GRAVEL (SW-SC); medium dense; dark brown; moist; little to some fine and coarse GRAVEL.	S-1	3 4 5	9												
3867.00	2																	
3865.00	3																	
3863.00	4																	
3861.00	5																	
3859.00	6		CLAYEY SAND (SC); dense; dark brown; moist; mostly fine and mediu SAND; little fines.	S-2	10 12 16	28												
3857.00	7																	
3855.00	8																	
3853.00	9		Medium dense.	S-3	26 6 9	15												
3851.00	10		Well-graded SAND (SW); medium dense; brown; dry; few fine GRAVEL.															
3849.00	11																	
3847.00	12		Dense.	S-4	7 10 12	22												
	13																	
	14																	

(continued)

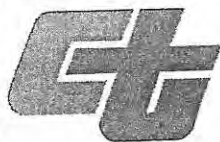

Department of Transportation  
 Division of Engineering Services  
 Geotechnical Services  
 Office of Geotechnical Design - South

REPORT TITLE <b>BORING RECORD</b>				HOLE ID <b>A-19-002</b>
DIST. <b>08</b>	COUNTY <b>SBD</b>	ROUTE <b>15</b>	POSTMILE <b>30.4</b>	PROJECT ID <b>0815000244</b>
PROJECT OR BRIDGE NAME				
BRIDGE NUMBER	PREPARED BY	DATE	SHEET <b>1 of 2</b>	

6 BR - STANDARD RTE 15 INFILTRATION BASINS.GPJ, CALTRANS LIBRARY (FEB 2017), G.L.B. 3/1/19

ELEVATION (ft)	DEPTH (ft)	Material Graphics	DESCRIPTION	Sample Location	Sample Number	Blows per 6 in.	Blows per foot	Recovery (%)	RCD (%)	Moisture Content (%)	Dry Unit Weight (pcf)	Shear Strength (tsf)	Drilling Method	Casing Depth	Remarks	
3845.00	25		Weak cementation. Well-graded SAND (SW) (continued).  Very dense.	S-5	13 14 17	31										
3843.00	28															
3841.00	30					S-6	10 14 20	34								
3839.00	32															
3837.00	34															
3835.00	36					S-7	13 17 20	37								
3833.00	38															
3831.00	40					S-8	13 19 22	41								
3829.00	42															
3827.00	44															
3825.00	46			S-9	10 17 26	43										
3823.00	48															
3821.00	50		Bottom of borehole at 50.0 ft bgs													
3819.00	52		This Boring Record was developed in accordance with the Caltrans Soil & Rock Logging, Classification, and Presentation Manual (2010) except as noted on the Soil or Rock Legend or below.													
3817.00	54															
	55															

5 BR - STANDARD RTE 15 INFILTRATION BASINS.GPJ CALTRANS LIBRARY (FEB 2017).CLB 3/1/19



Department of Transportation  
 Division of Engineering Services  
 Geotechnical Services  
 Office of Geotechnical Design - South

REPORT TITLE <b>BORING RECORD</b>				HOLE ID <b>A-19-002</b>	
DIST. 08	COUNTY SBD	ROUTE 15	POSTMILE 30.4	PROJECT ID 0815000244	
PROJECT OR BRIDGE NAME					
BRIDGE NUMBER		PREPARED BY		DATE	SHEET 2 of 2



LOGGED BY <b>K. Barker</b>	BEGIN DATE <b>2-26-19</b>	COMPLETION DATE <b>2-26-19</b>	BOREHOLE LOCATION (Lat/Long or North/East and Datum) <b>34° 22' 55.38" / -117° 24' 55.29" NAD83</b>	HOLE ID <b>A-19-003</b>
DRILLING CONTRACTOR <b>Caltrans</b>	BOREHOLE LOCATION (Offset, Station, Line)			SURFACE ELEVATION <b>-3883.0 ft NAVD88</b>
DRILLING METHOD <b>Hollow-Stem Auger</b>	DRILL RIG <b>CS 2000 (truck)</b>			BOREHOLE DIAMETER <b>8 in</b>
SAMPLER TYPE(S) AND SIZE(S) (ID) <b>SPT (1.4")</b>	SPT HAMMER TYPE <b>Automatic</b>			HAMMER EFFICIENCY, ERI <b>94%</b>
BOREHOLE BACKFILL AND COMPLETION <b>grout</b>	GROUNDWATER READINGS	DURING DRILLING <b>N/A</b>	AFTER DRILLING (DATE)	TOTAL DEPTH OF BORING <b>51.5 ft</b>

ELEVATION (ft)	DEPTH (ft)	Material Graphics	DESCRIPTION	Sample Location	Sample Number	Blows per 6 in.	Blows per foot	Recovery (%)	RCD (%)	Moisture Content (%)	Dry Unit Weight (pcf)	Shear Strength (tsf)	Drilling Method	Casing Depth	Remarks
0	0														
3881.00	1		CLAYEY SAND (SC); dark brown; moist; mostly from fine to coarse SAND; little fines; few fine GRAVEL.												
3879.00	2														
3877.00	3														
3875.00	4		SILTY SAND (SM); dense; brown; dry; mostly from fine to coarse SAND; little fines; few fine GRAVEL.												
3873.00	5														
3871.00	6			S-1	11	30									
3869.00	7				14										
3867.00	8				16										
3865.00	9														
3863.00	10		Very dense; trace fine GRAVEL; moderate cementation.	S-2	17	36									
3861.00	11				17										
3859.00	12				19										
3867.00	13														
3865.00	14			S3	11	32									
3863.00	15				15										
3861.00	16				17										
3859.00	17														
3866.00	18		Weak cementation.	S-4	15	43									
3864.00	19				19										
3862.00	20				24										
3860.00	21														
3858.00	22		Few fine and coarse GRAVEL.												
3856.00	23														
3854.00	24														
3852.00	25														

(continued)

5 BR - STANDARD RTE 15 INFILTRATION BASINS.GPJ - CALTRANS LIBRARY (FEB 2017).GLB 3/1/19



Department of Transportation  
 Division of Engineering Services  
 Geotechnical Services  
 Office of Geotechnical Design - South

REPORT TITLE <b>BORING RECORD</b>				HOLE ID <b>A-19-003</b>	
DIST. <b>08</b>	COUNTY <b>SBD</b>	ROUTE <b>15</b>	POSTMILE <b>30.4</b>	PROJECT ID <b>0815000244</b>	
PROJECT OR BRIDGE NAME					
BRIDGE NUMBER		PREPARED BY		DATE	SHEET <b>1 of 2</b>

5 BR - STANDARD, RTE 15 INFILTRATION BASINS.GPJ CALTRANS LIBRARY (FEB 2017).GLB 3/1/19

ELEVATION (ft)	DEPTH (ft)	Material Graphics	DESCRIPTION	Sample Location	Sample Number	Blows per 6 in.	Blows per foot	Recovery (%)	RQD (%)	Moisture Content (%)	Dry Unit Weight (pcf)	Shear Strength (tsf)	Drilling Method	Casing Depth	Remarks
3857.00	25		Dense, SILTY SAND (SM) (continued).		S-5	15	30								
	26		Poorly graded SAND with SILT (SP-SM); dense; brown; dry; mostly fine SAND; weak cementation.			13									
	27					17									
3855.00	28														
	29														
3853.00	30		Very dense; fine and medium SAND; trace fine GRAVEL; no cementation.		S-6	11	46								
	31					21									
	32					25									
3851.00	33														
	34														
3849.00	35														
	36				S-7	11	35								
	37					16									
3847.00	38					19									
	39														
3845.00	40														
	41				S-8	13	41								
	42					19									
	43					22									
3841.00	44														
	45														
3839.00	46		Few fine GRAVEL.		S-9	12	43								
	47					21									
	48					22									
3837.00	49														
	50														
3835.00	51		Well-graded SAND with SILT (SW-SM); very dense; brown; dry.		S-10	15	50								
	52					21									
	53					29									
3833.00	54		Bottom of borehole at 51.5 ft bgs												
	55														
3829.00			This Boring Record was developed in accordance with the Caltrans Soil & Rock Logging, Classification, and Presentation Manual (2010) except as noted on the Soil or Rock Legend or below.												



Department of Transportation  
 Division of Engineering Services  
 Geotechnical Services  
 Office of Geotechnical Design - South

REPORT TITLE <b>BORING RECORD</b>				HOLE ID <b>A-19-003</b>	
DIST. 08	COUNTY SBD	ROUTE 15	POSTMILE 30.4	PROJECT ID 0815000244	
PROJECT OR BRIDGE NAME					
BRIDGE NUMBER		PREPARED BY		DATE	SHEET 2 of 2

## West Hesperia Overhead





FED. ROAD DIV. NO.	STATE	PROJ. NO.	FISCAL YEAR	SHEET NO.	TOTAL SHEETS
7	CAL.				


DATE	DRAWN BY	ROUTE	SECTION	SHEET NO.	TOTAL SHEETS
VIII	SBD	31	C		

BENCH MARK 20-B-57  
 Solid nail in Lead of SE'y cor.  
 01 36' at 104' 100' C<sub>2</sub>'  
 EI 3801.87

PLAN  
 Scale: 1" = 50'

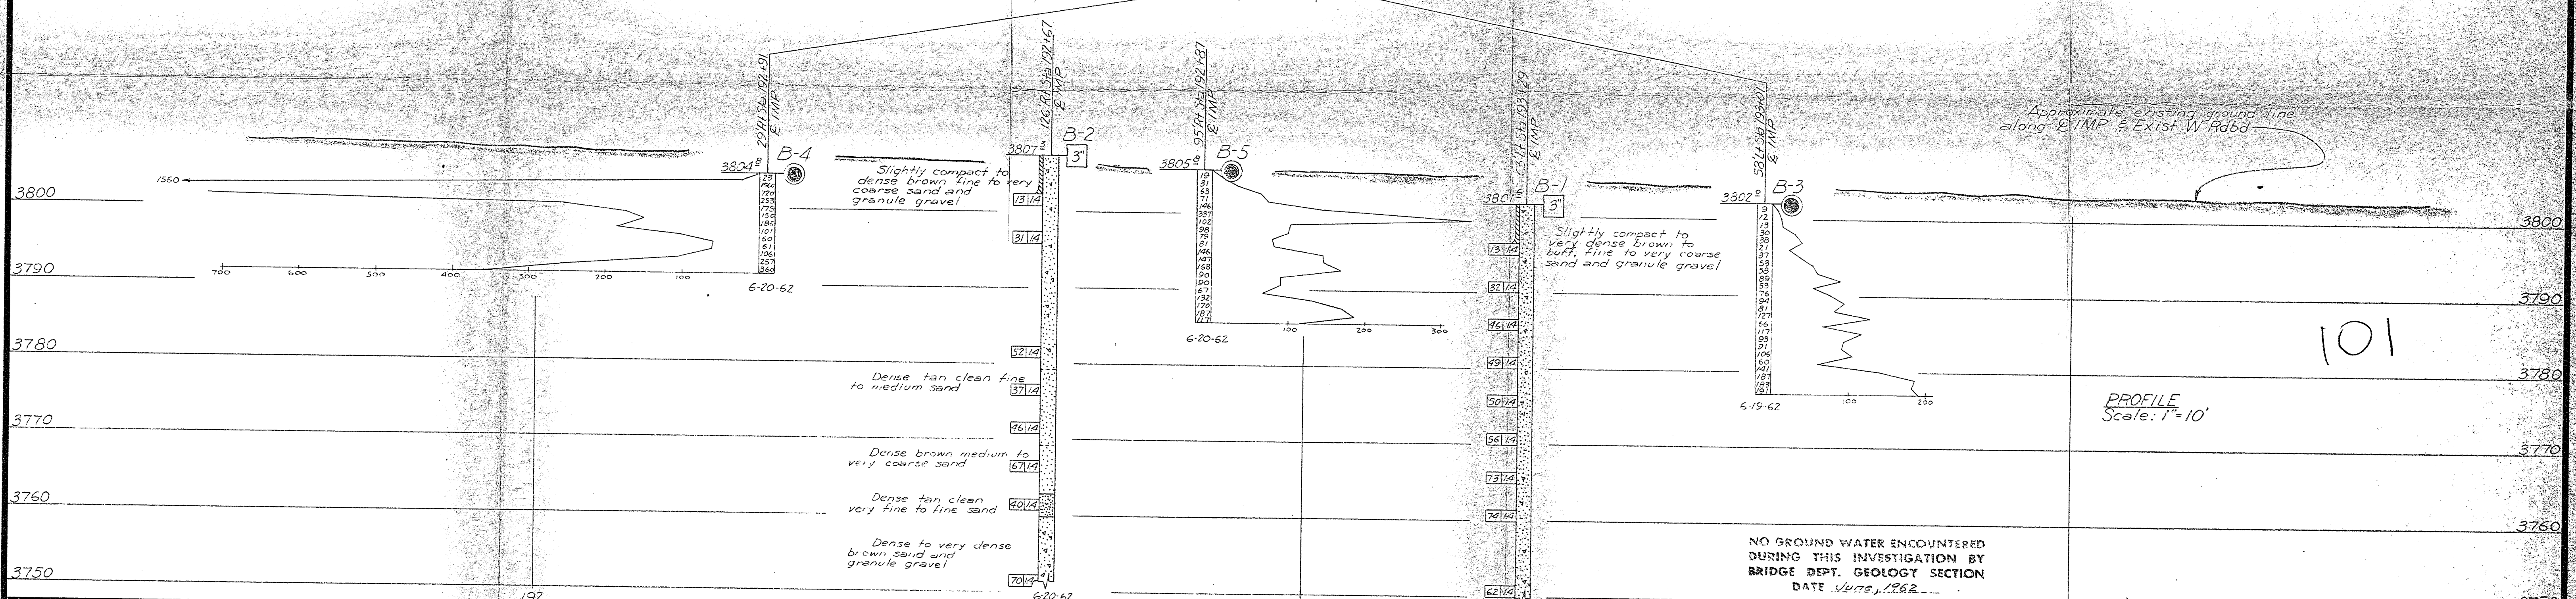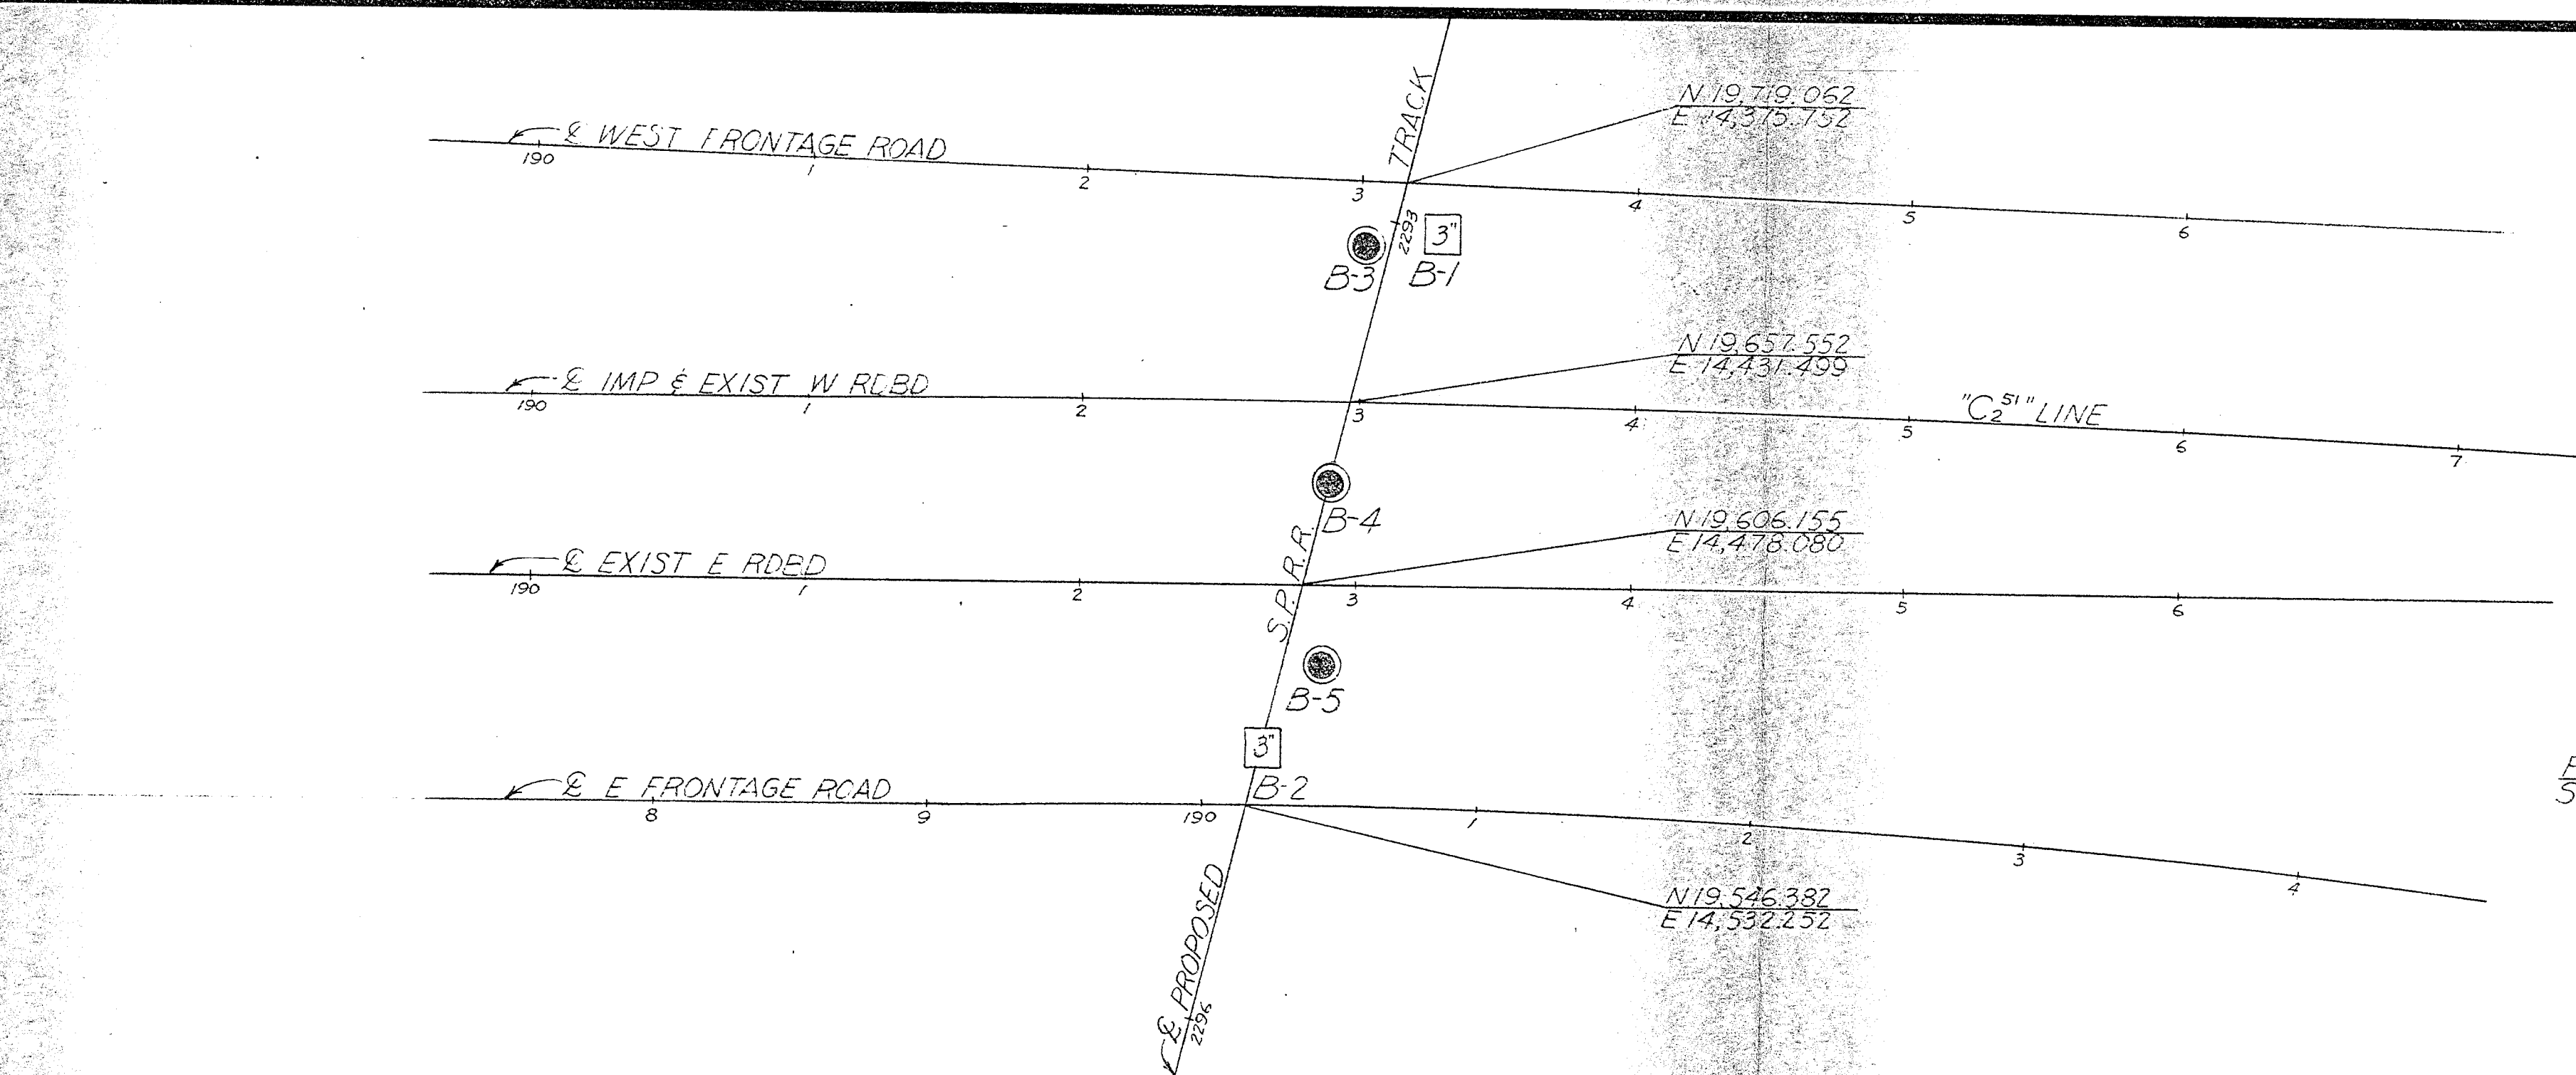

FIELD STUDY  
 by Espen 6-20-62  
 DRAWN  
 by Eskine 7-10-62  
 CHECKED  
 by Egan 7-11-62  
 Approval Recommended by  
 [Signature]  
 Engineer in Charge  
 Alvin H. Kistner, Engineer

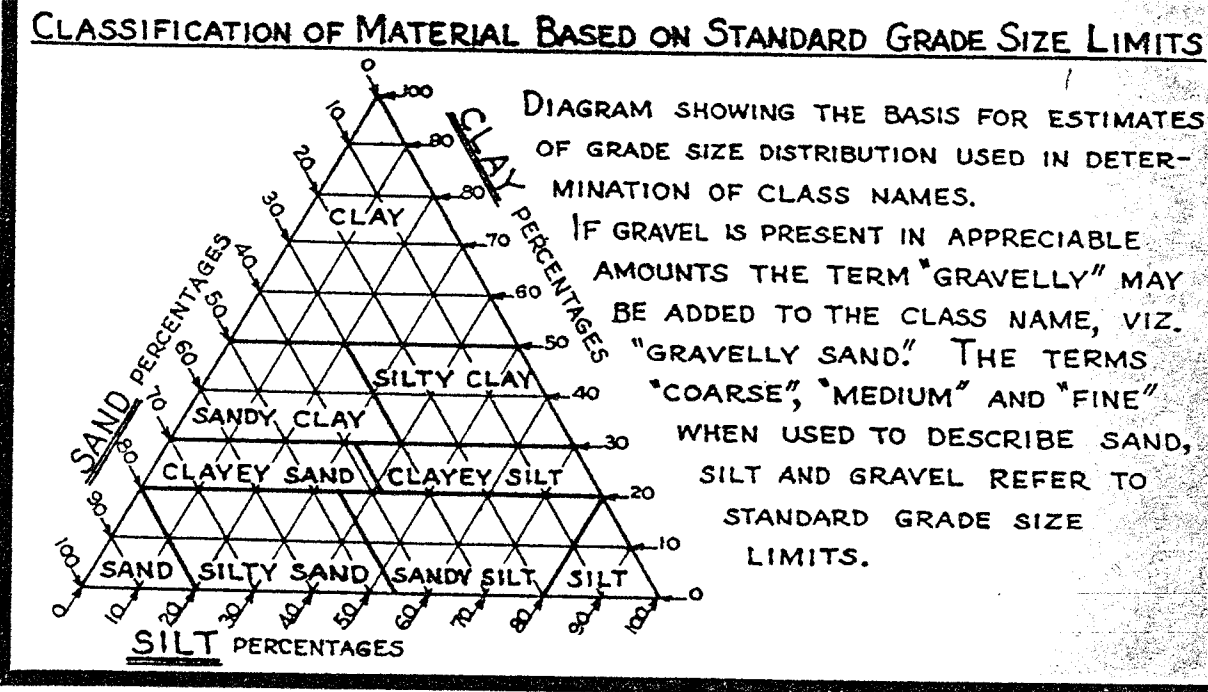

**LEGEND OF EARTH MATERIALS**

GRAVEL	SILTY CLAY OR CLAYEY SILT
SAND	PEAT AND/OR ORGANIC MATTER
SILT	FILL MATERIAL
CLAY	IGNEOUS ROCK
SANDY CLAY OR CLAYEY SAND	SEDIMENTARY ROCK
SANDY SILT OR SILTY SAND	METAMORPHIC ROCK

**LEGEND OF BORING OPERATIONS**

- PENETROMETER
- 2 1/4" CONE PENETROMETER
- SAMPLER BORING (DRY)
- ROTARY BORING (WET)
- AUGER BORING (DRY)
- JET BORING
- CORE BORING
- TEST PIT

**1" SOIL TUBE**

**ROTARY BORING**

**PENETRATION BORING**

**NOTE**

Classification of earth material as shown on this sheet is based upon field inspection and is not to be construed to imply mechanical analysis.

STATE OF CALIFORNIA  
 DEPARTMENT OF PUBLIC WORKS  
 DIVISION OF HIGHWAYS

**WEST HESPERIA OVERHEAD**

**LOG OF TEST BORINGS**


Scale As Noted BRIDGE 54-664 FILE DRAWING



## N15-N395 Connector OC

DATE	BY	CHKD	APP'D
JAN 13 1984			


BM # 24-B-57  
 Spd. nail in 2x8 Rwd. A111 buried  
 7' 39" At Sta 231+00  
 Elev. 3731.64

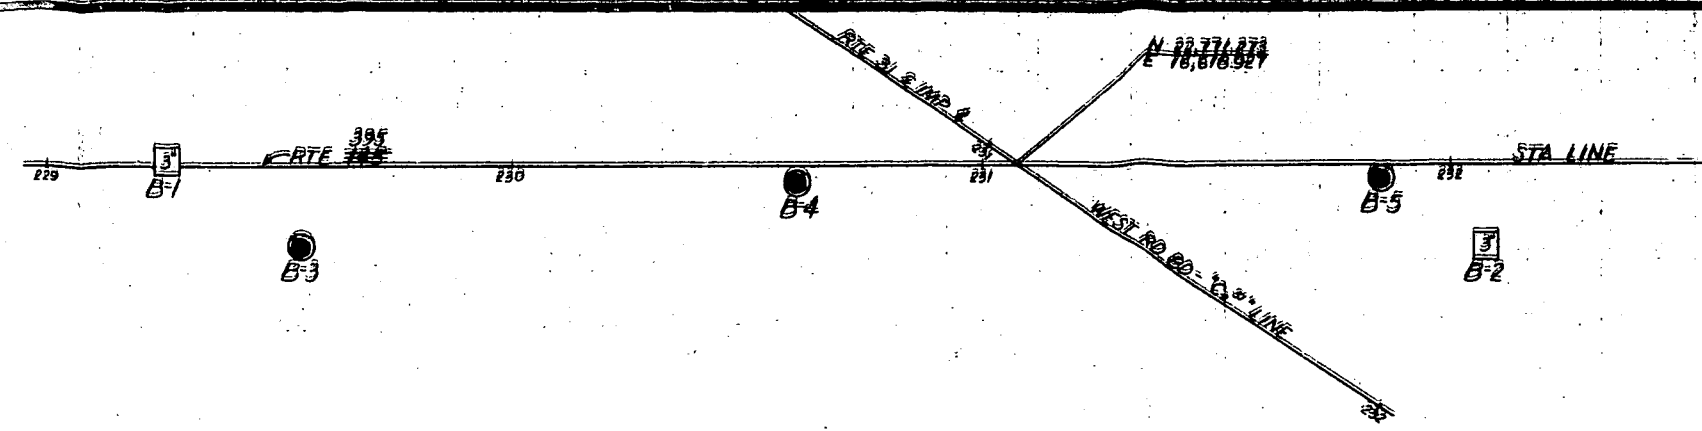

**REDUCED PLAN**  
 USE SCALE BELOW


BRIDGE DEPARTMENT

Approximate existing ground line along Rte 145

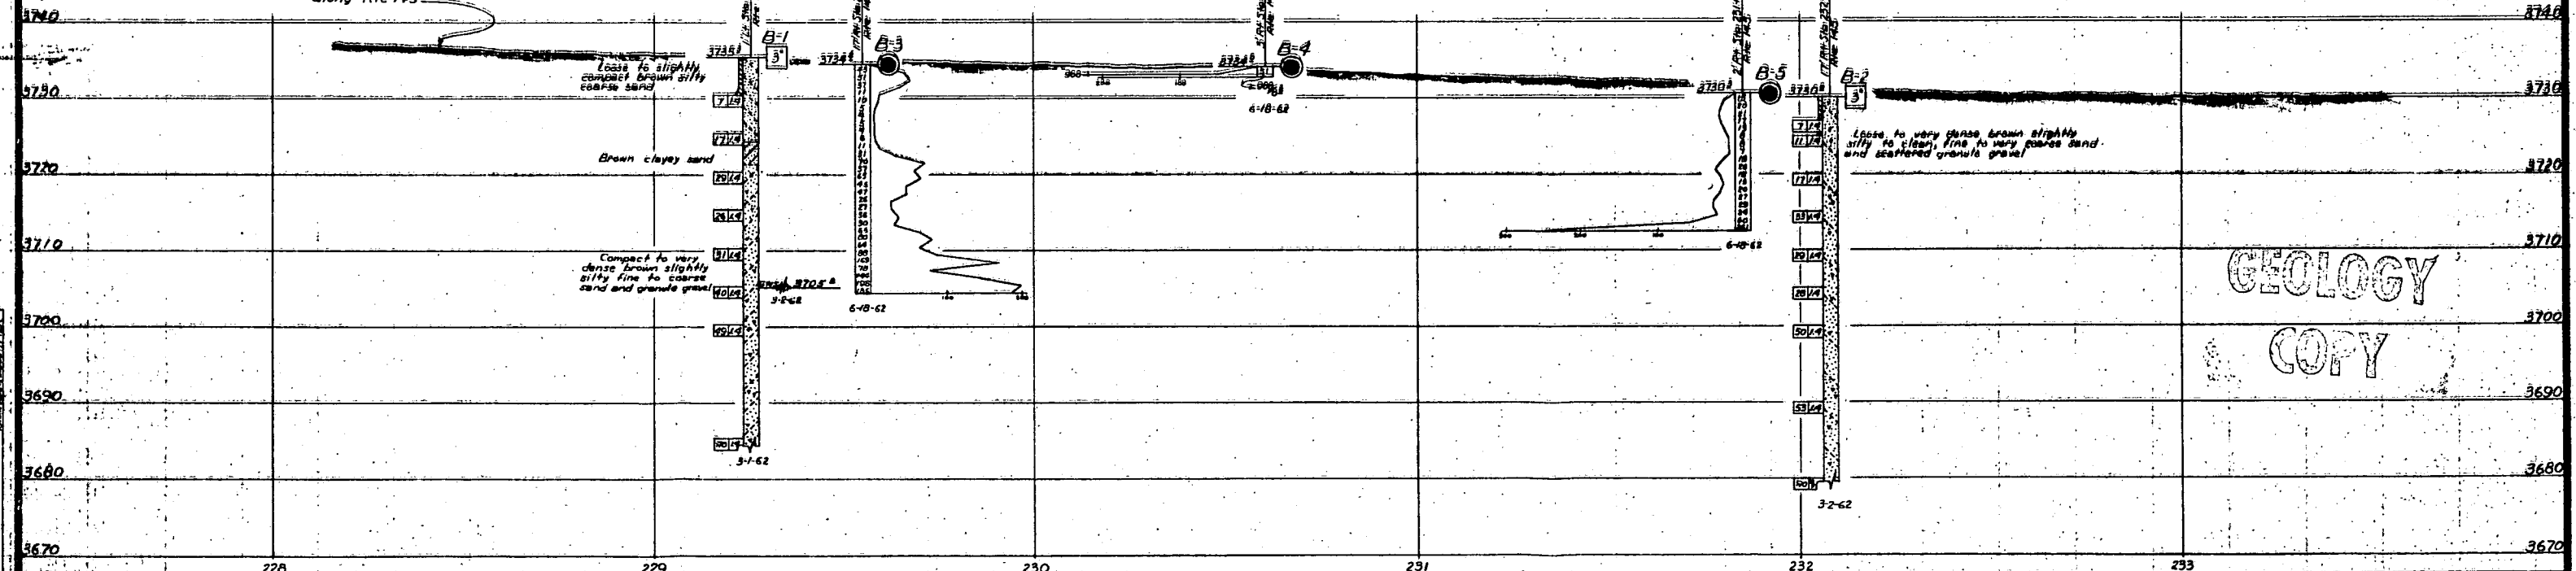

GEOLOGY  
 COPY

**CLASSIFICATION OF MATERIAL BASED ON STANDARD GRADE SIZE LIMITS**

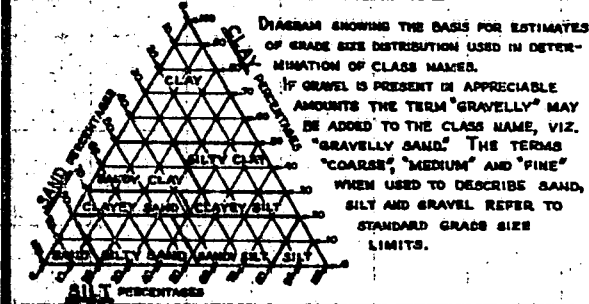

**LEGEND OF EARTH MATERIALS**

- GRAVEL
- SAND
- SILT
- CLAY
- SANDY CLAY OR CLAYEY SAND
- SANDY SILT OR SILTY SAND
- SILTY CLAY OR CLAYEY SILT
- PEAT AND/OR ORGANIC MATTER
- FILL MATERIAL
- IGNEOUS ROCK
- SEDIMENTARY ROCK
- METAMORPHIC ROCK

**LEGEND OF BORING OPERATIONS**

- PENETROMETER
- 2 1/2" CONE PENETROMETER
- SAMPLER BORING (DRY)
- ROTARY BORING (WET)
- AUGER BORING (DRY)
- JET BORING
- CORE BORING
- TEST PIT

**NOTE**

Classification of earth material as shown on this sheet is based upon field inspection and is not to be construed to imply mechanical analysis.

STATE OF CALIFORNIA DEPARTMENT OF PUBLIC WORKS DIVISION OF HIGHWAYS	
BHEET	OF
12	12
395/15 RTE 145 SEPARATION	
<b>LOG OF TEST BORINGS</b>	
SCALE Horiz. 1"=20' Vert. 1"=10'	BRIDGE 54-665 FILE DRAWING SALS-10

## Joshua Street (Palm Avenue) OC


(New VIII-58d-15)

FED. ROAD DIV. NO.	STATE	PROJ. NO.	FISCAL YEAR	SHEET NO.	TOTAL SHEETS
7	CAL.				

VIII SBD	COUNTY	ROUTE	SECTION	SHEET NO.	TOTAL SHEETS
VIII SBD		31	C	82	82

ENGINEER: *[Signature]*  
 DATE APPROVED: January 13, 1964

**BENCH MARK #26-B-57**  
 Spyd. nail in 2"x2" Fwd. Hub buried 1'  
 39' Rt Sta 251+00 "C<sub>2</sub>" Line  
 EL. 3680.75

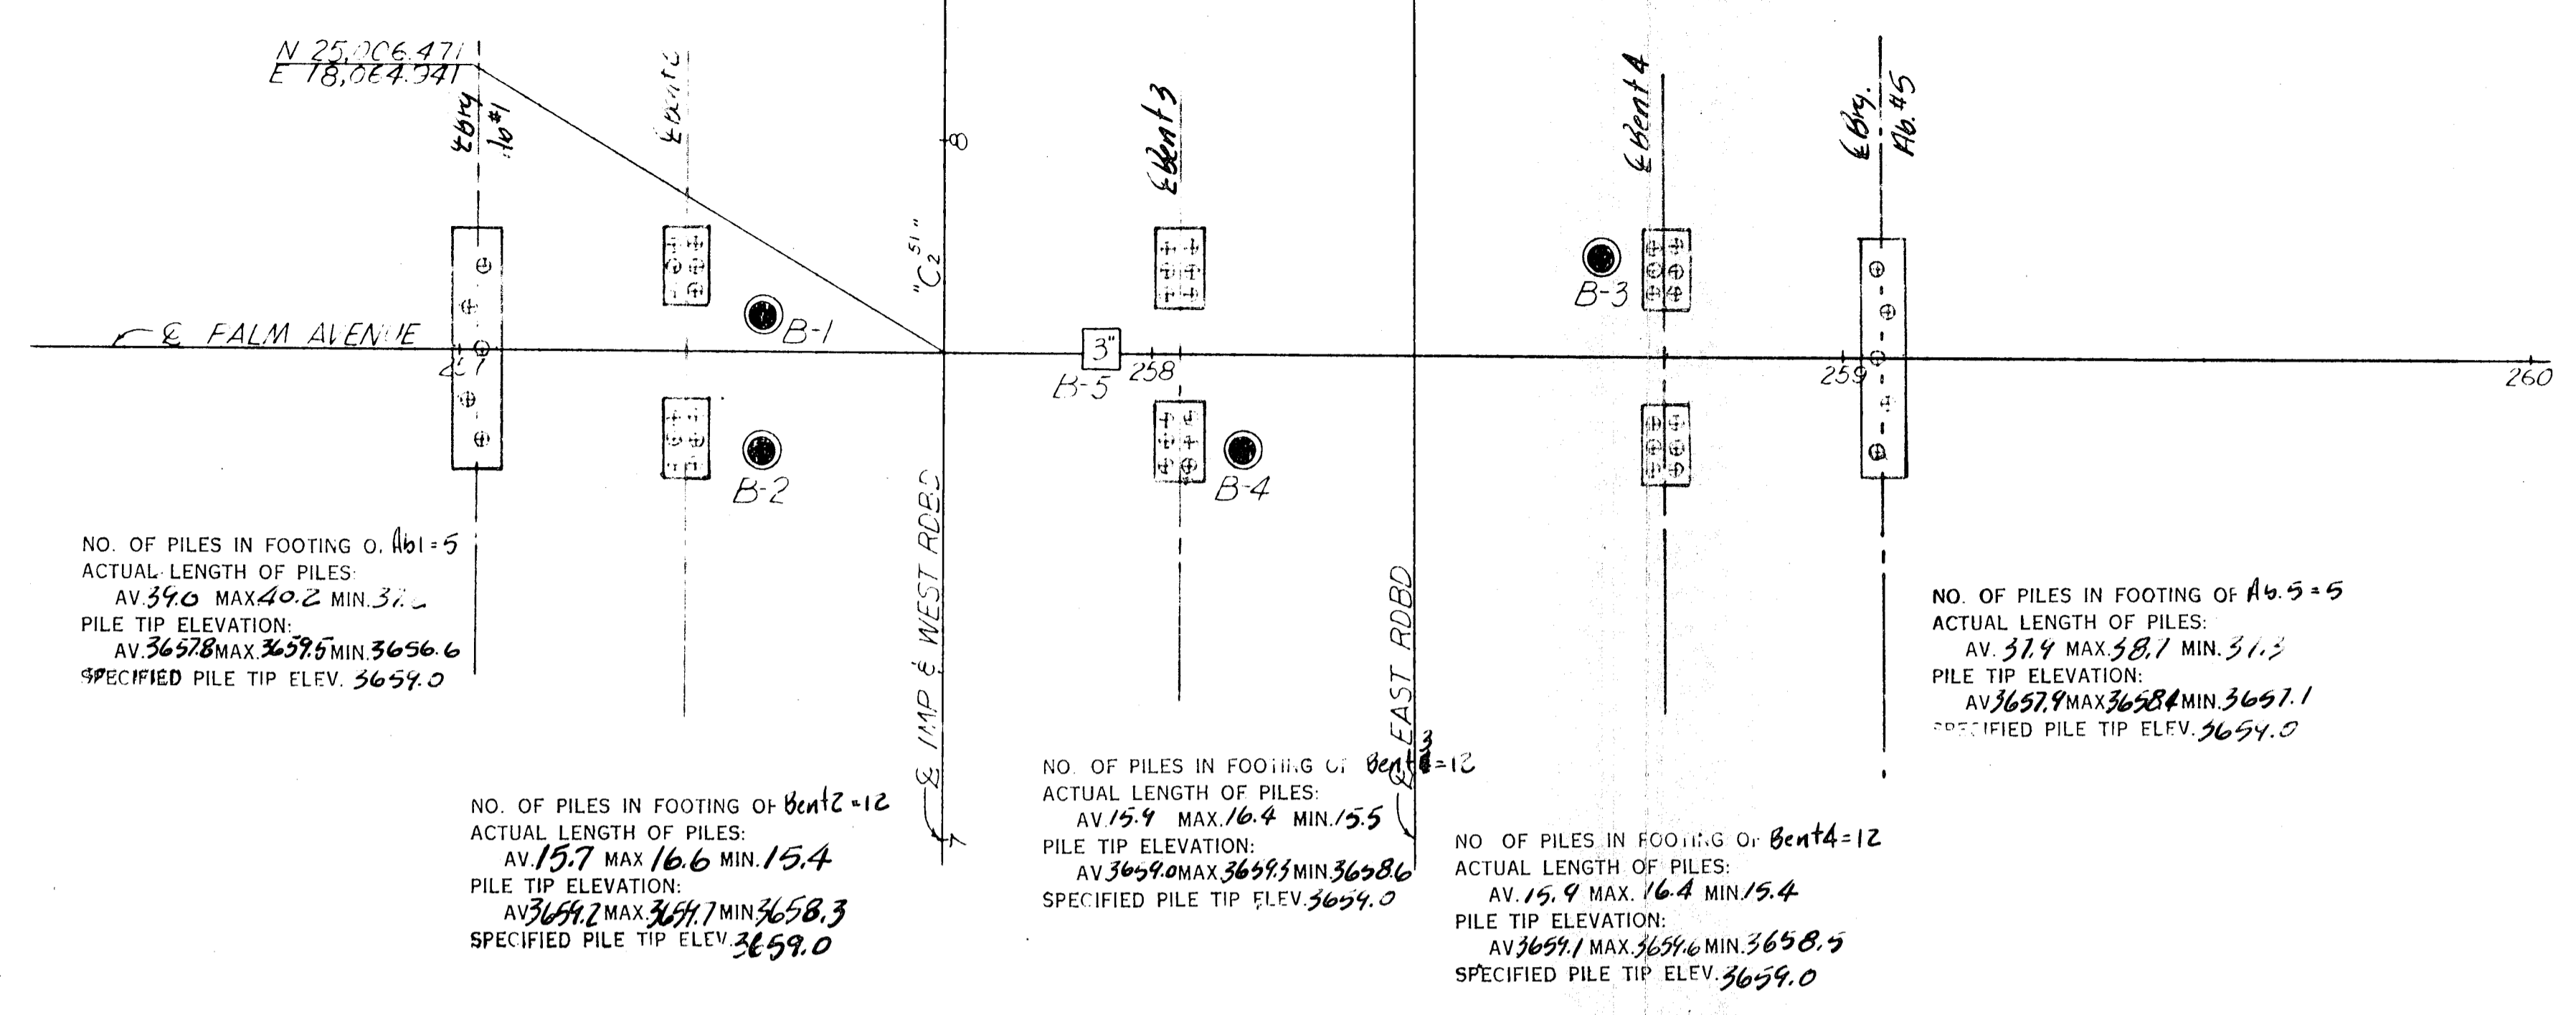

NO. OF PILES IN FOOTING OF Bent 1-5  
 ACTUAL LENGTH OF PILES:  
 AV. 39.0 MAX. 40.2 MIN. 37.2  
 PILE TIP ELEVATION:  
 AV. 3657.8 MAX. 3659.5 MIN. 3656.6  
 SPECIFIED PILE TIP ELEV. 3659.0

NO. OF PILES IN FOOTING OF Bent 3-5  
 ACTUAL LENGTH OF PILES:  
 AV. 31.9 MAX. 33.1 MIN. 31.3  
 PILE TIP ELEVATION:  
 AV. 3657.9 MAX. 3658.4 MIN. 3657.1  
 SPECIFIED PILE TIP ELEV. 3659.0

NO. OF PILES IN FOOTING OF Bent 2-12  
 ACTUAL LENGTH OF PILES:  
 AV. 15.7 MAX. 16.6 MIN. 15.4  
 PILE TIP ELEVATION:  
 AV. 3654.2 MAX. 3657.7 MIN. 3653.3  
 SPECIFIED PILE TIP ELEV. 3659.0


NO. OF PILES IN FOOTING OF Bent 4-12  
 ACTUAL LENGTH OF PILES:  
 AV. 15.9 MAX. 16.4 MIN. 15.5  
 PILE TIP ELEVATION:  
 AV. 3659.0 MAX. 3659.5 MIN. 3658.6  
 SPECIFIED PILE TIP ELEV. 3659.0

NO. OF PILES IN FOOTING OF Bent 4-12  
 ACTUAL LENGTH OF PILES:  
 AV. 15.9 MAX. 16.4 MIN. 15.4  
 PILE TIP ELEVATION:  
 AV. 3659.1 MAX. 3659.6 MIN. 3658.5  
 SPECIFIED PILE TIP ELEV. 3659.0


~~PILE DATA  
 TYPE OF PILE  
 HAMMER DATA  
 PILE DIAMETER: TIP BUTT  
 PILE DESIGN LOAD =  
 FOR THE STRUCTURE:  
 NUMBER OF PILES  
 EST. LENGTH OF PILING~~

PILE DATA  
 TYPE OF PILE C10H  
 HAMMER DATA P4C Ayer Rig  
 PILE DIAMETER: TIP 16" BUTT 16"  
 PILE DESIGN LOAD = 45 T  
 FOR THE STRUCTURE:  
 NUMBER OF PILES = 46  
 EST. LENGTH OF PILING = 950 lf.  
 ACTUAL = 954.2 lf.

AS BUILT  
 CONDITIONS BY PPS  
 CONTRACT NO. 0803962A (64-BV13C29-T)  
 DATE 8/24/64

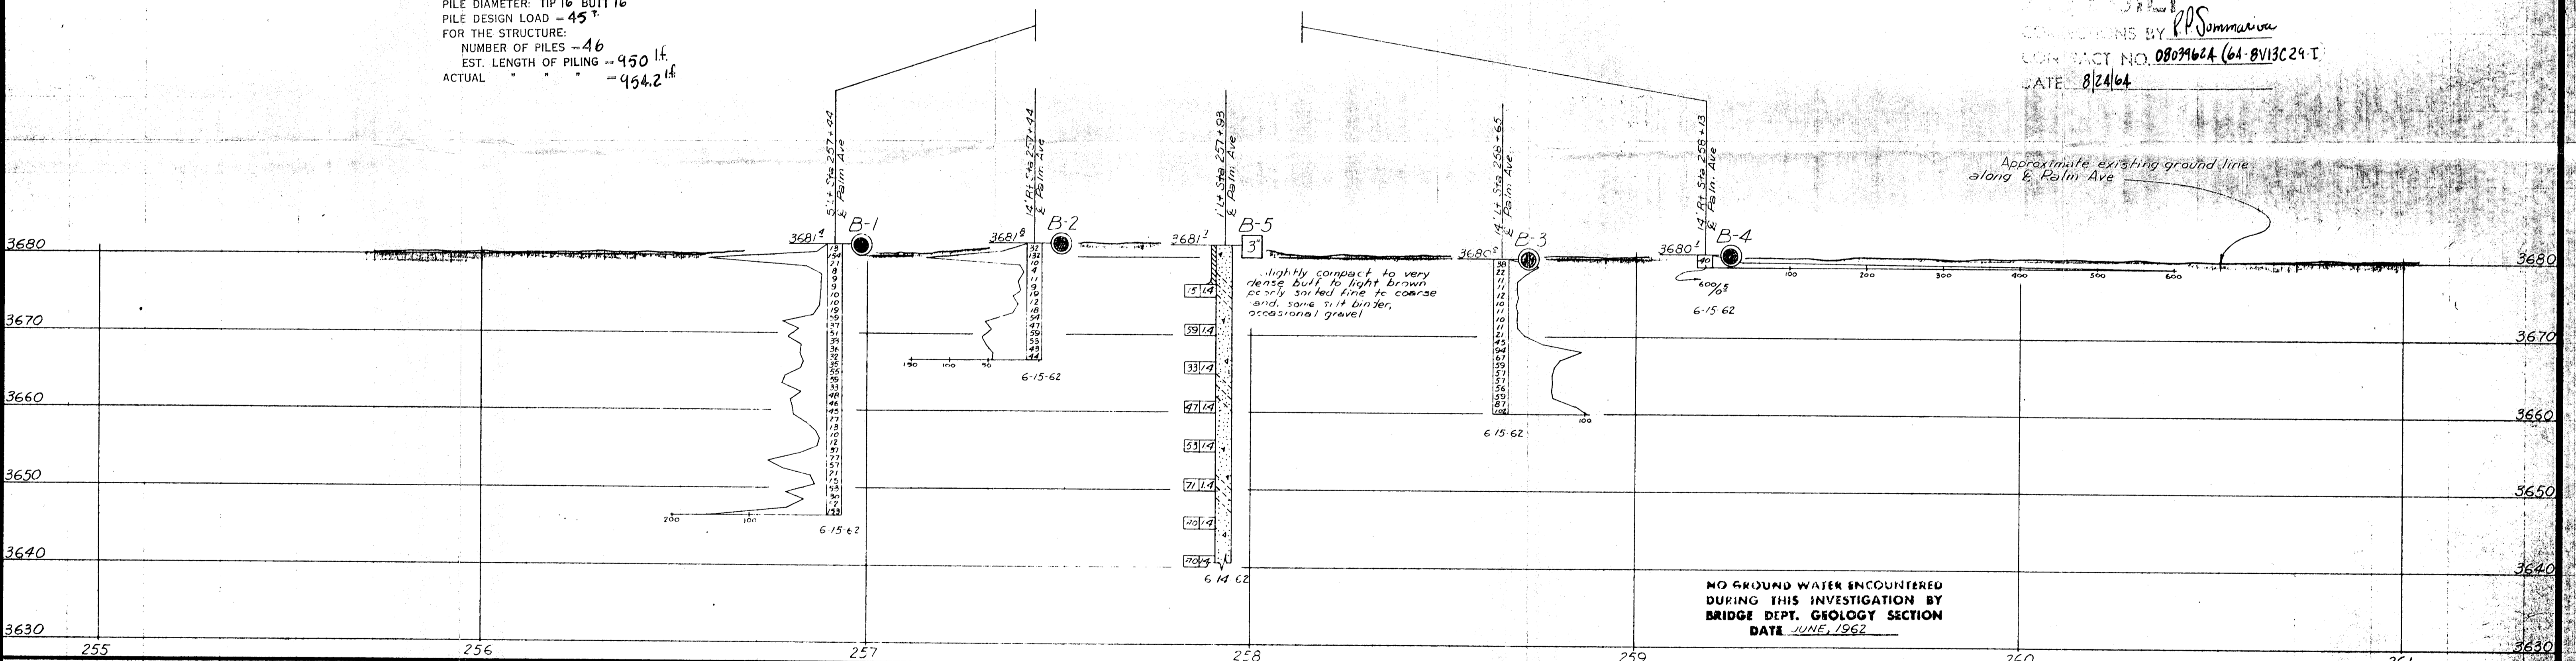


FIELD STUDY  
 DRAWN  
 CHECKED  
 Approved Recommended by: *[Signature]*  
 Charles E. Pope  
 Major, Bureau of Highways

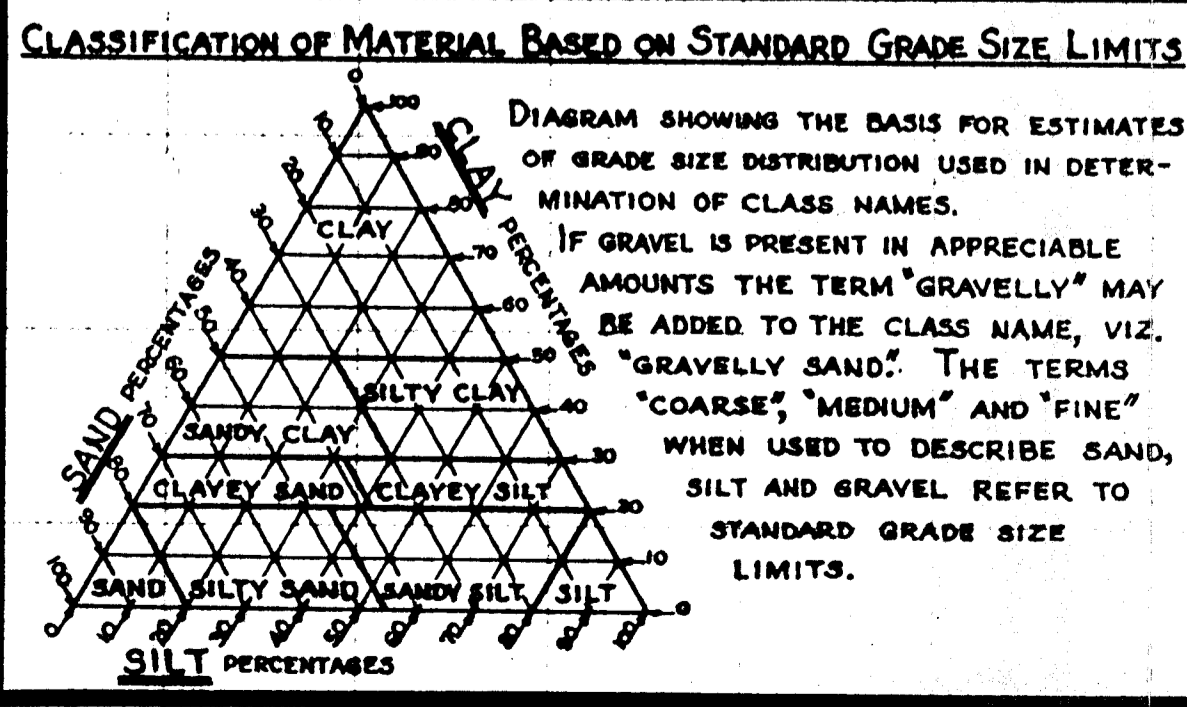

**LEGEND OF EARTH MATERIALS**

GRAVEL	SILTY CLAY OR CLAYEY SILT
SAND	PEAT AND/OR ORGANIC MATTER
SILT	FILL MATERIAL
CLAY	IGNEOUS ROCK
SANDY CLAY OR CLAYEY SAND	SEDIMENTARY ROCK
SANDY SILT OR SILTY SAND	METAMORPHIC ROCK

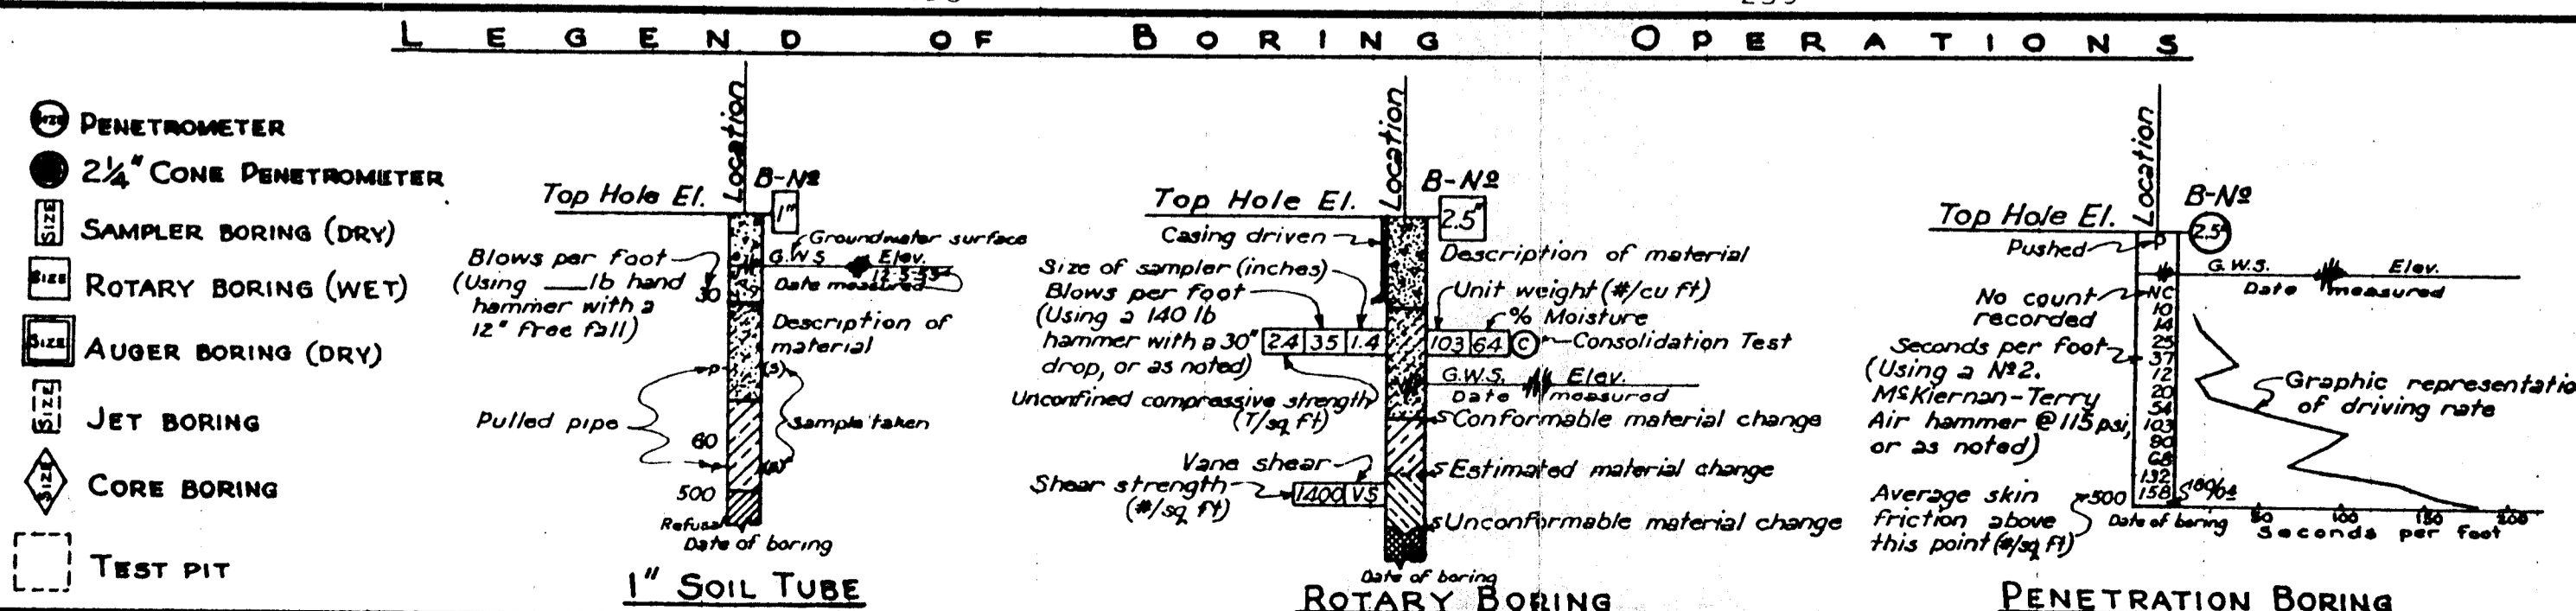

**NOTE**  
 Classification of earth material as shown on this sheet is based upon field inspection and is not to be construed to imply mechanical analysis.

STATE OF CALIFORNIA  
 DEPARTMENT OF PUBLIC WORKS  
 DIVISION OF HIGHWAYS

**SHEET 9 OF 9**

**PALM AVENUE OVERCROSSING**

**LOG OF TEST BORINGS**

Scale: Horiz. 1"=20', Vert. 1"=10'  
 BRIDGE 54-666 FILE DRAWING 54666-9

PRINTED ON CLEARPRINT 1303 H

BRIDGE DEPARTMENT


82



Main Street

The State of California or its officers or agents shall not be responsible for the accuracy or completeness of electronic copies of this plan sheet.

October 5, 1964

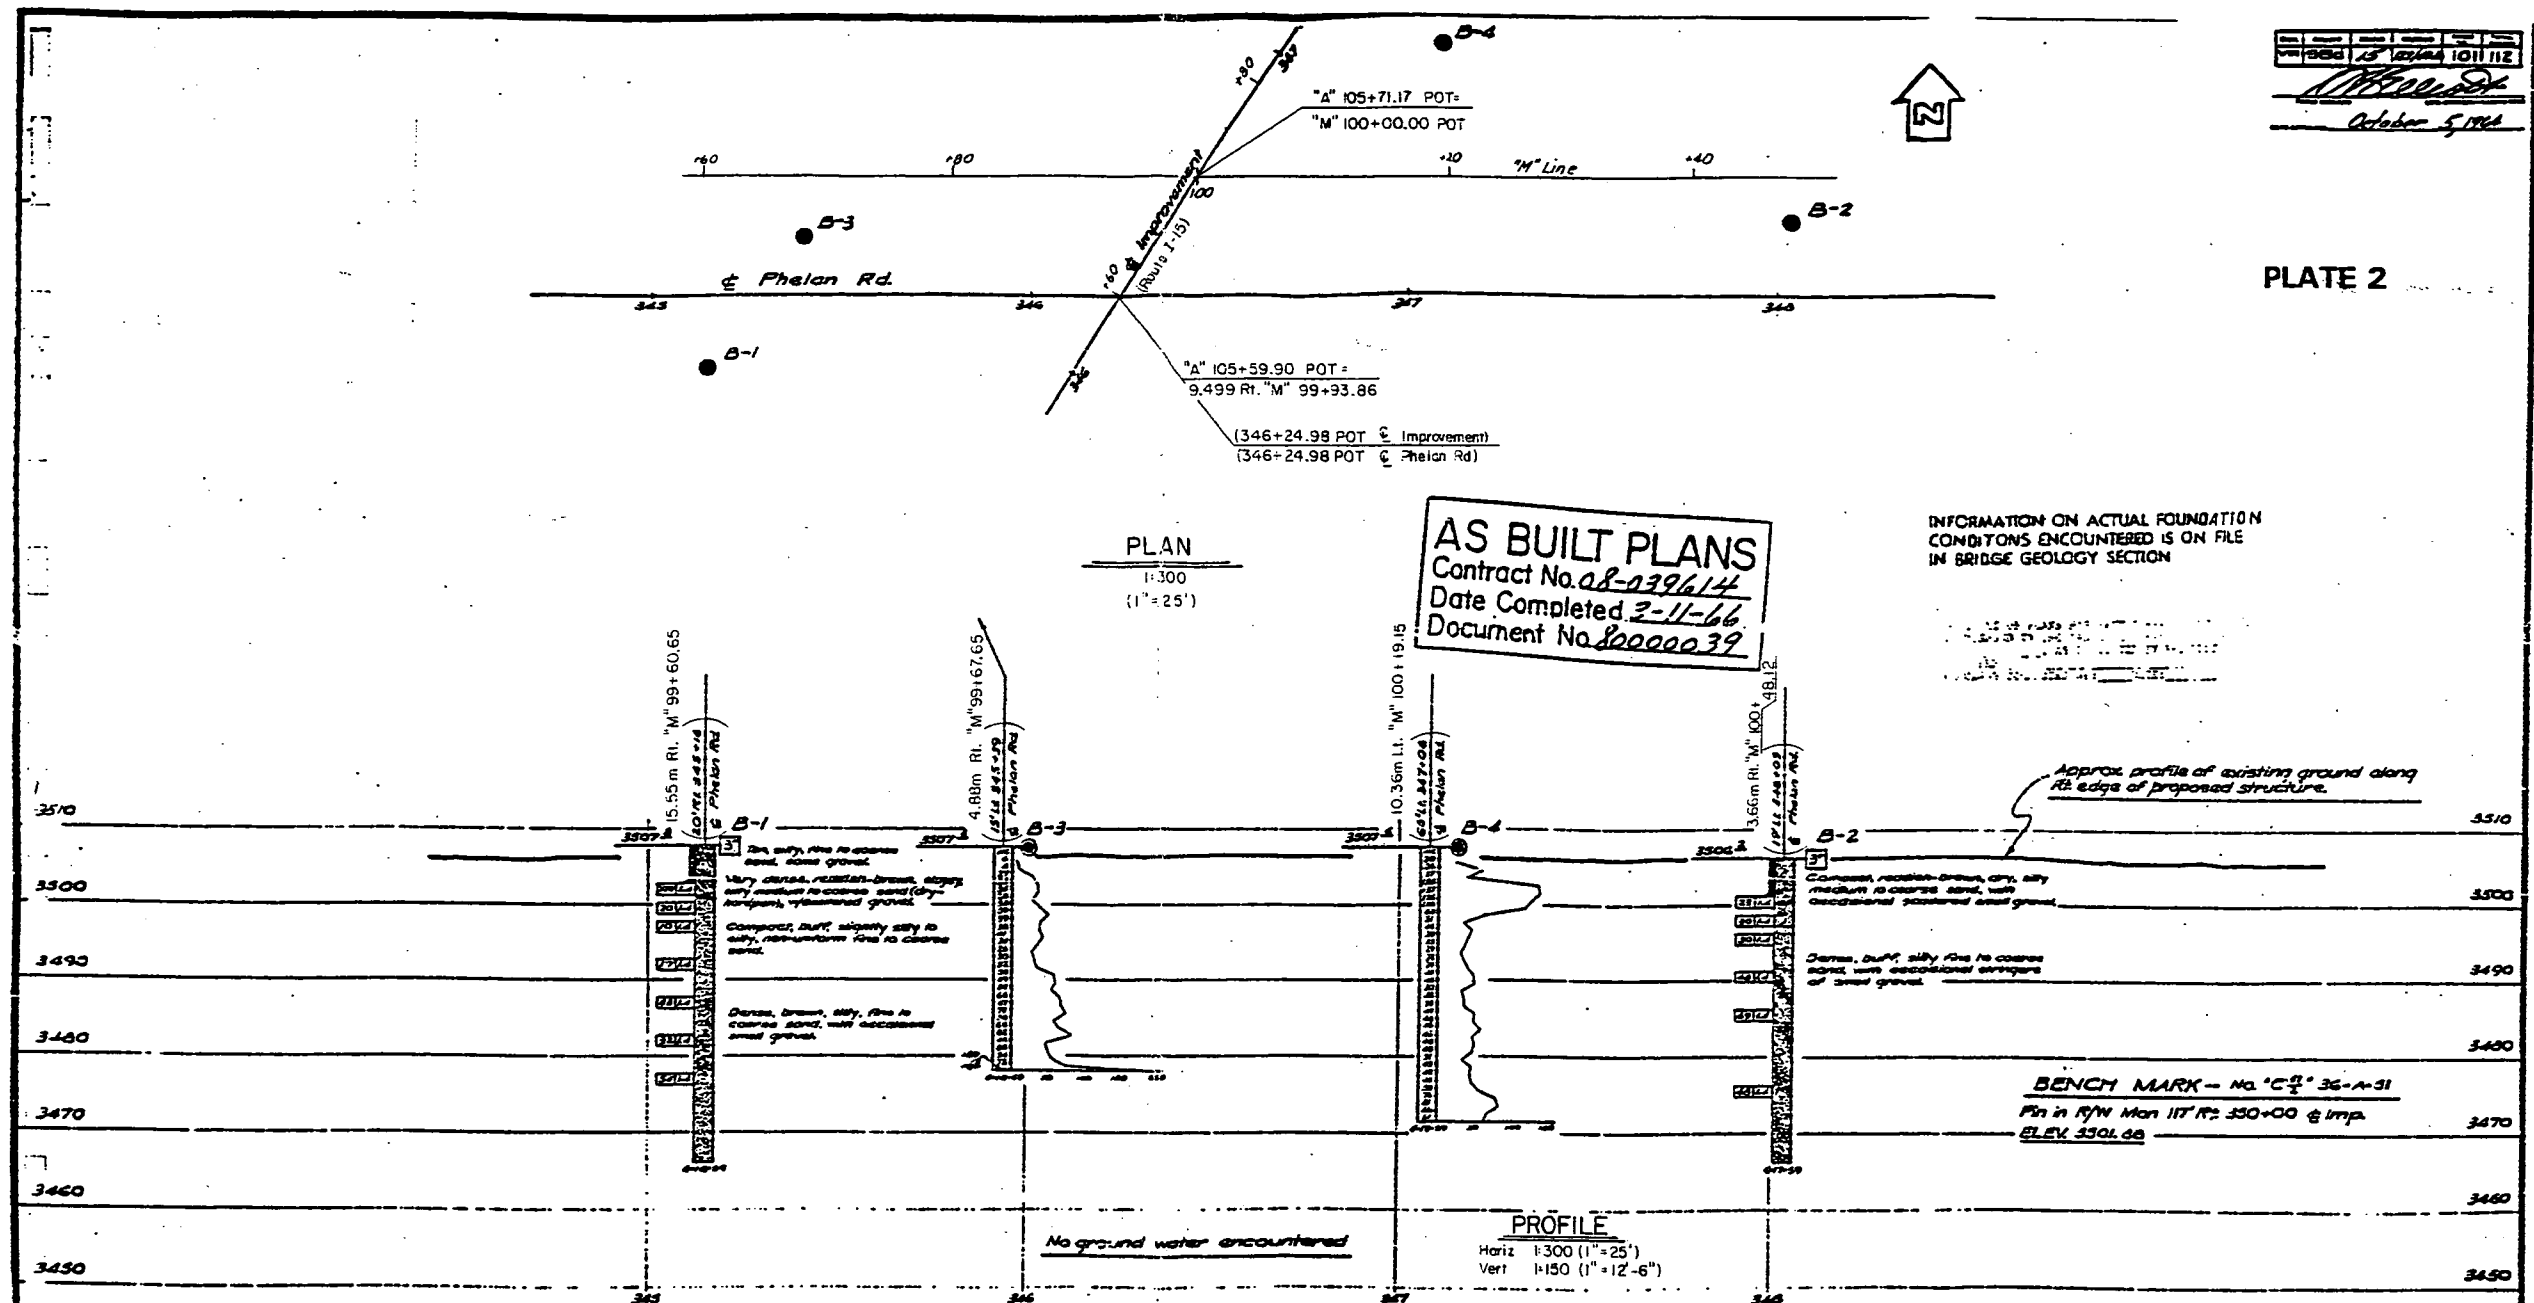

**AS BUILT PLANS**  
 Contract No. 08-039614  
 Date Completed 3-11-66  
 Document No. 80000039

INFORMATION ON ACTUAL FOUNDATION CONDITIONS ENCOUNTERED IS ON FILE IN BRIDGE GEOLOGY SECTION

<b>CLASSIFICATION OF MATERIAL BASED ON STANDARD GRADE SIZE LIMITS</b> 	<b>LEGEND OF EARTH MATERIALS</b> <ul style="list-style-type: none"> <li>GRAVEL</li> <li>SAND</li> <li>SILT</li> <li>CLAY</li> <li>SANDY CLAY OR CLAYEY SAND</li> <li>SANDY SILT OR SILTY SAND</li> <li>SILTY CLAY OR CLAYEY SILT</li> <li>PEAT AND/OR ORGANIC MATTER</li> <li>FILL MATERIAL</li> <li>INCONSOLUBLE ROCK</li> <li>SEDIMENTARY ROCK</li> <li>METAMORPHIC ROCK</li> </ul>	<b>LEGEND OF BORING OPERATIONS</b> <ul style="list-style-type: none"> <li>PLAN OF ANY BORING</li> <li>PENETRATOR</li> <li>2 1/2" CORE PENETRATOR</li> <li>SAMPLER BORING (DRY)</li> <li>ROTARY BORING (WET)</li> <li>AUGER BORING (DRY)</li> <li>JET BORING</li> <li>CORE BORING</li> <li>TEST PIT</li> </ul>			<b>NOTES</b> The contractor's attention is directed to Section 2, Article 16 of the Standard Specifications and to the Special Provisions accompanying this set of plans. Classification of earth material as shown on this sheet is based upon field inspection and is not to be construed to imply mechanical analysis.
		<b>PHELAN RD. OC</b> <b>LOG OF TEST BORINGS</b> SHEET 17 OF 17 SCALE: HORIZ. 1"=25' VERT. 1"=12'-6" DRAWING 54624-12			

DESIGN OVERSIGHT	NOTE: ADDITIONAL AS-BUILT FOUNDATION DATA MAY BE AVAILABLE AT THE DIVISION OF NEW TECHNOLOGY, MATERIALS AND RESEARCH 5900 FOLSOM BOULEVARD, SACRAMENTO, CALIFORNIA 95819	DESIGN BY M. Maechler	CHECKED E. Tsal	PREPARED FOR THE <b>STATE OF CALIFORNIA</b> DEPARTMENT OF TRANSPORTATION	PROJECT ENGINEER M. Maechler	BRIDGE NO. 54624	<b>MAIN STREET OVERCROSSING</b> <b>AS-BUILT LOG OF TEST BORINGS</b>
SIGNOFF DATE	DETAILS BY C. Houghton	CHECKED E. Tsal	CU 08325		POST MILE 5472	DISREGARD PRINTS BEARING EARLIER REVISION DATES	
	QUANTITIES BY E. Wong	CHECKED Y. Ton	EA 37020K		54-1273	REVISION DATES (PRELIMINARY STAGE ONLY)	

ORIGINAL SCALE IN INCHES FOR REDUCED PLANS



DIST.	COUNTY	ROUTE	KILOMETER POSTS TOTAL PROJECT	SHEET NO.	TOTAL SHEETS
08	SBd			17	18


REGISTERED ENGINEERING GEOLOGIST  
 JEFFREY L. JOHNSON  
 No. 1889  
 STATE OF CALIFORNIA

PLANS APPROVAL DATE


0.5m remove of embankment

25/6


0.58

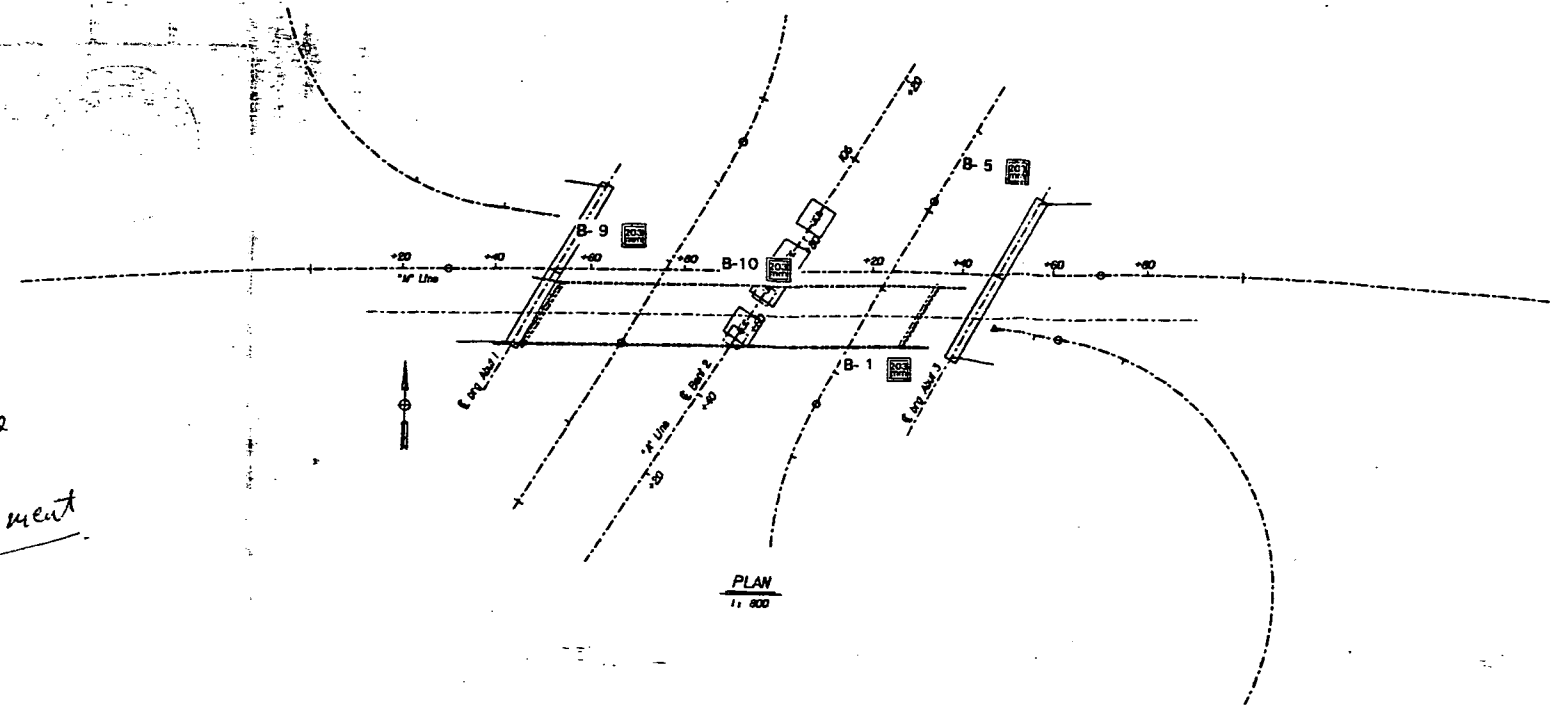

**LEGEND OF BORING OPERATIONS**

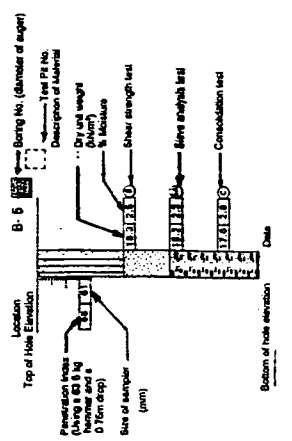

**NOTES:**  
 -BLOWS ARE CONVERTED TO STANDARD PENETRATION TEST DATA.  
 -BORING ELEVATIONS ARE BASED ON TOPOGRAPHY FROM CONCEPTUAL GEOMETRIC DRAWING, MAIN STREET/ RTE 15 INTERCHANGE (12/14/85).

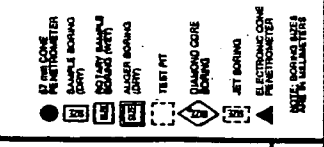


**CONSISTENCY CLASSIFICATION FOR SOIL**

According to the Standard Penetration Test

Penetration Index (Blows / 30 cm)	Consistency
0-4	Very Loose
5-9	Loose
10-19	Slightly compact
20-29	Compact
30-39	Dense
40-49	Very Dense
50-59	Very Hard
60-69	Hard
70-79	Very Hard

NOTE: Classification of earth material as shown on this sheet is based upon field inspection and is not to be construed to imply mechanical analysis.

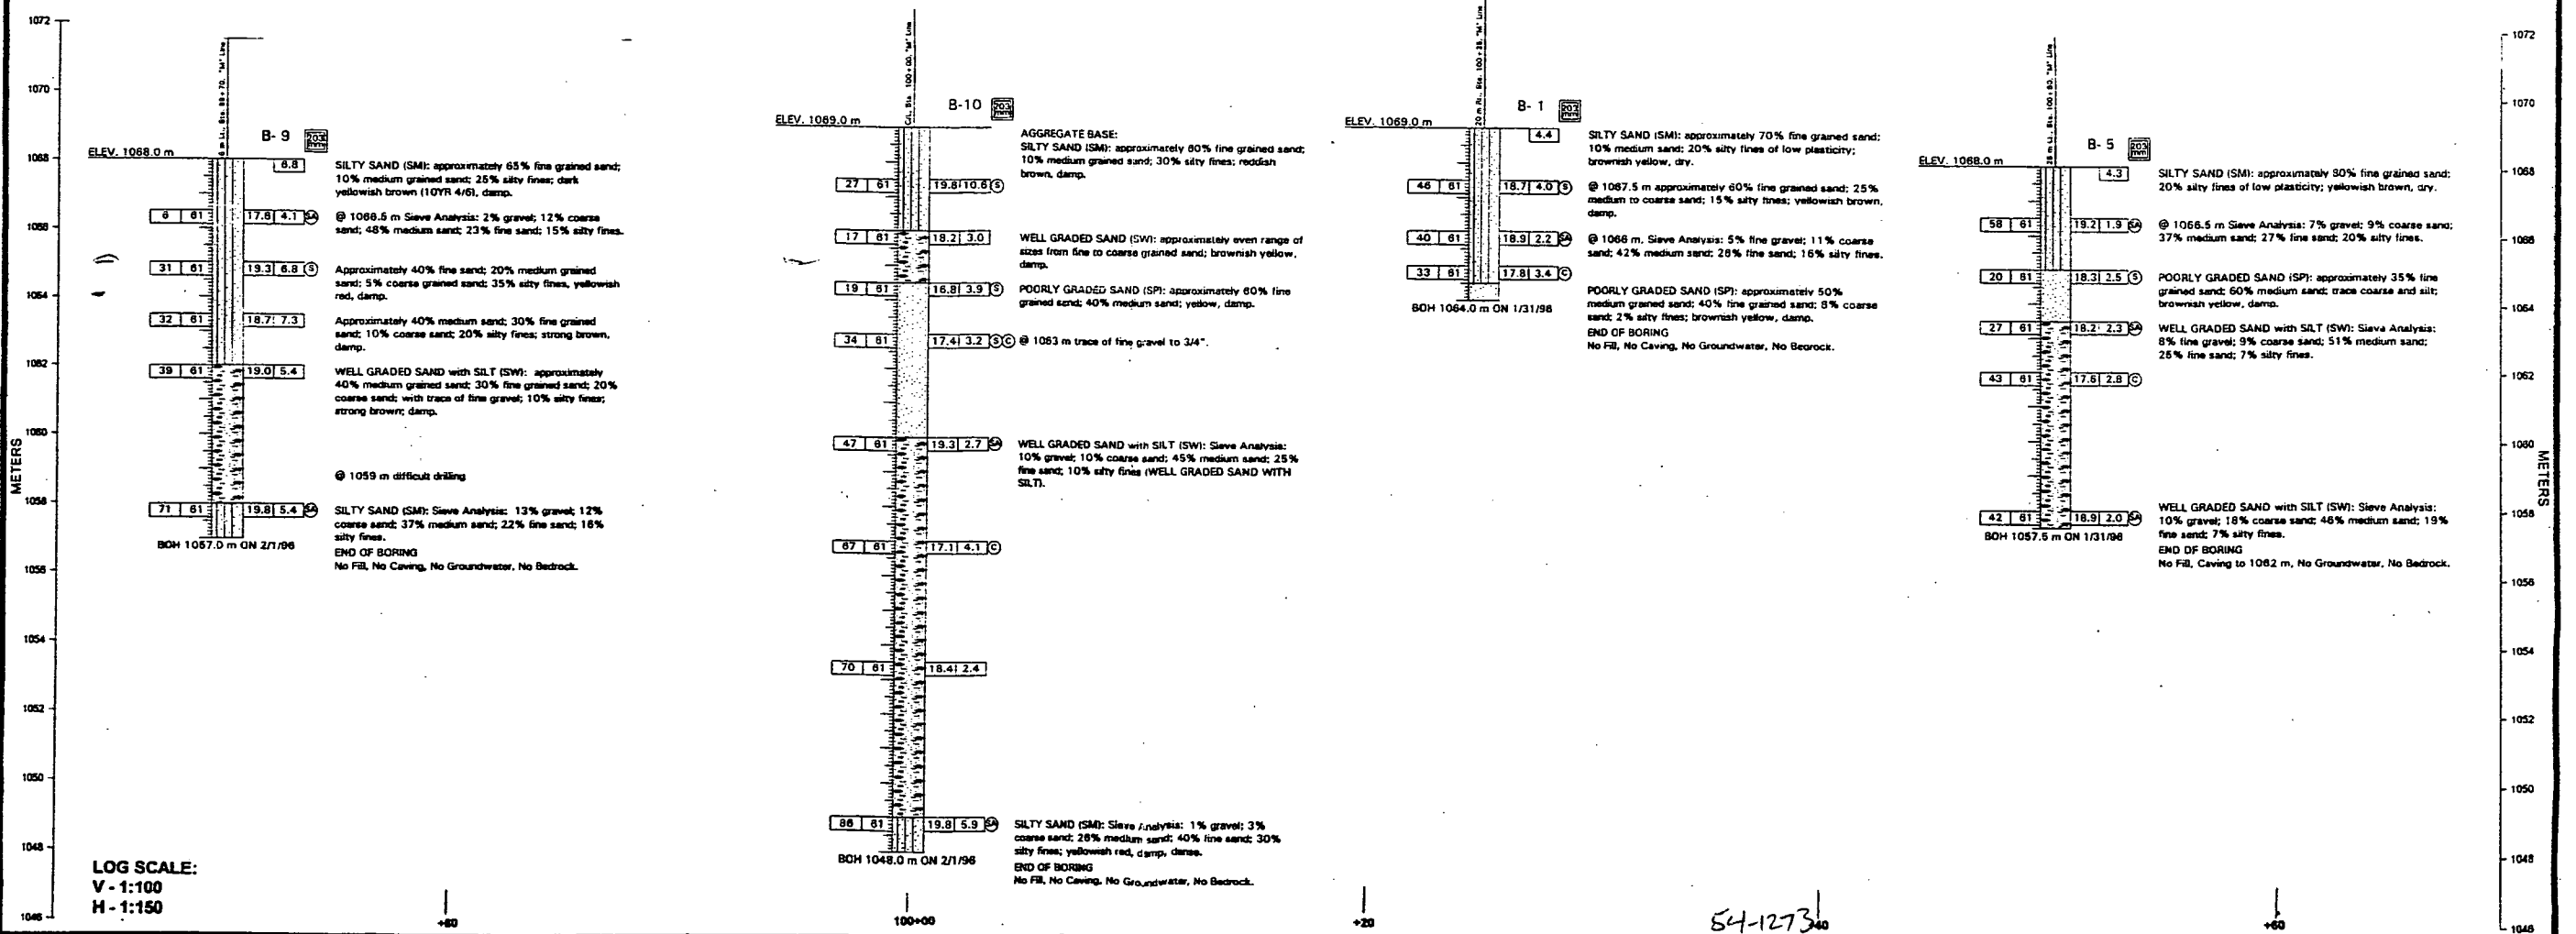

<b>ENGINEERING SERVICE CENTER</b>	<b>STRUCTURE FOUNDATIONS</b>	FIELD INVESTIGATION BY: J. JOHNSON LOR Geotechnical Group, Inc. 6121 Quail Valley Court Riverside, California 92507	State of CALIFORNIA DEPARTMENT OF TRANSPORTATION	DIVISION OF STRUCTURES STRUCTURE DESIGN	BRIDGE NO. 54-624 KILOMETER POST 15-53.9/55.9	<b>MAIN STREET OVERCROSSING</b> <b>LOG OF TEST BORINGS</b>
DRAWN BY JJJ	CHECKED BY JPL					REVISION DATES (PRELIMINARY STAGE ONLY) 4/96 11/96 4/97 6/97

ORIGINAL V-SCALE IN MILLIMETERS FOR REDUCED PLANS

54-127340

# California Aqueduct







## Bear Valley Road OC




BENCH MARK "C 5/1" 55-A-51  
 Brass Pin in R/W Mon. 118' Rt.  
 540+00 & Imp.  
 ELEV. 3157.34

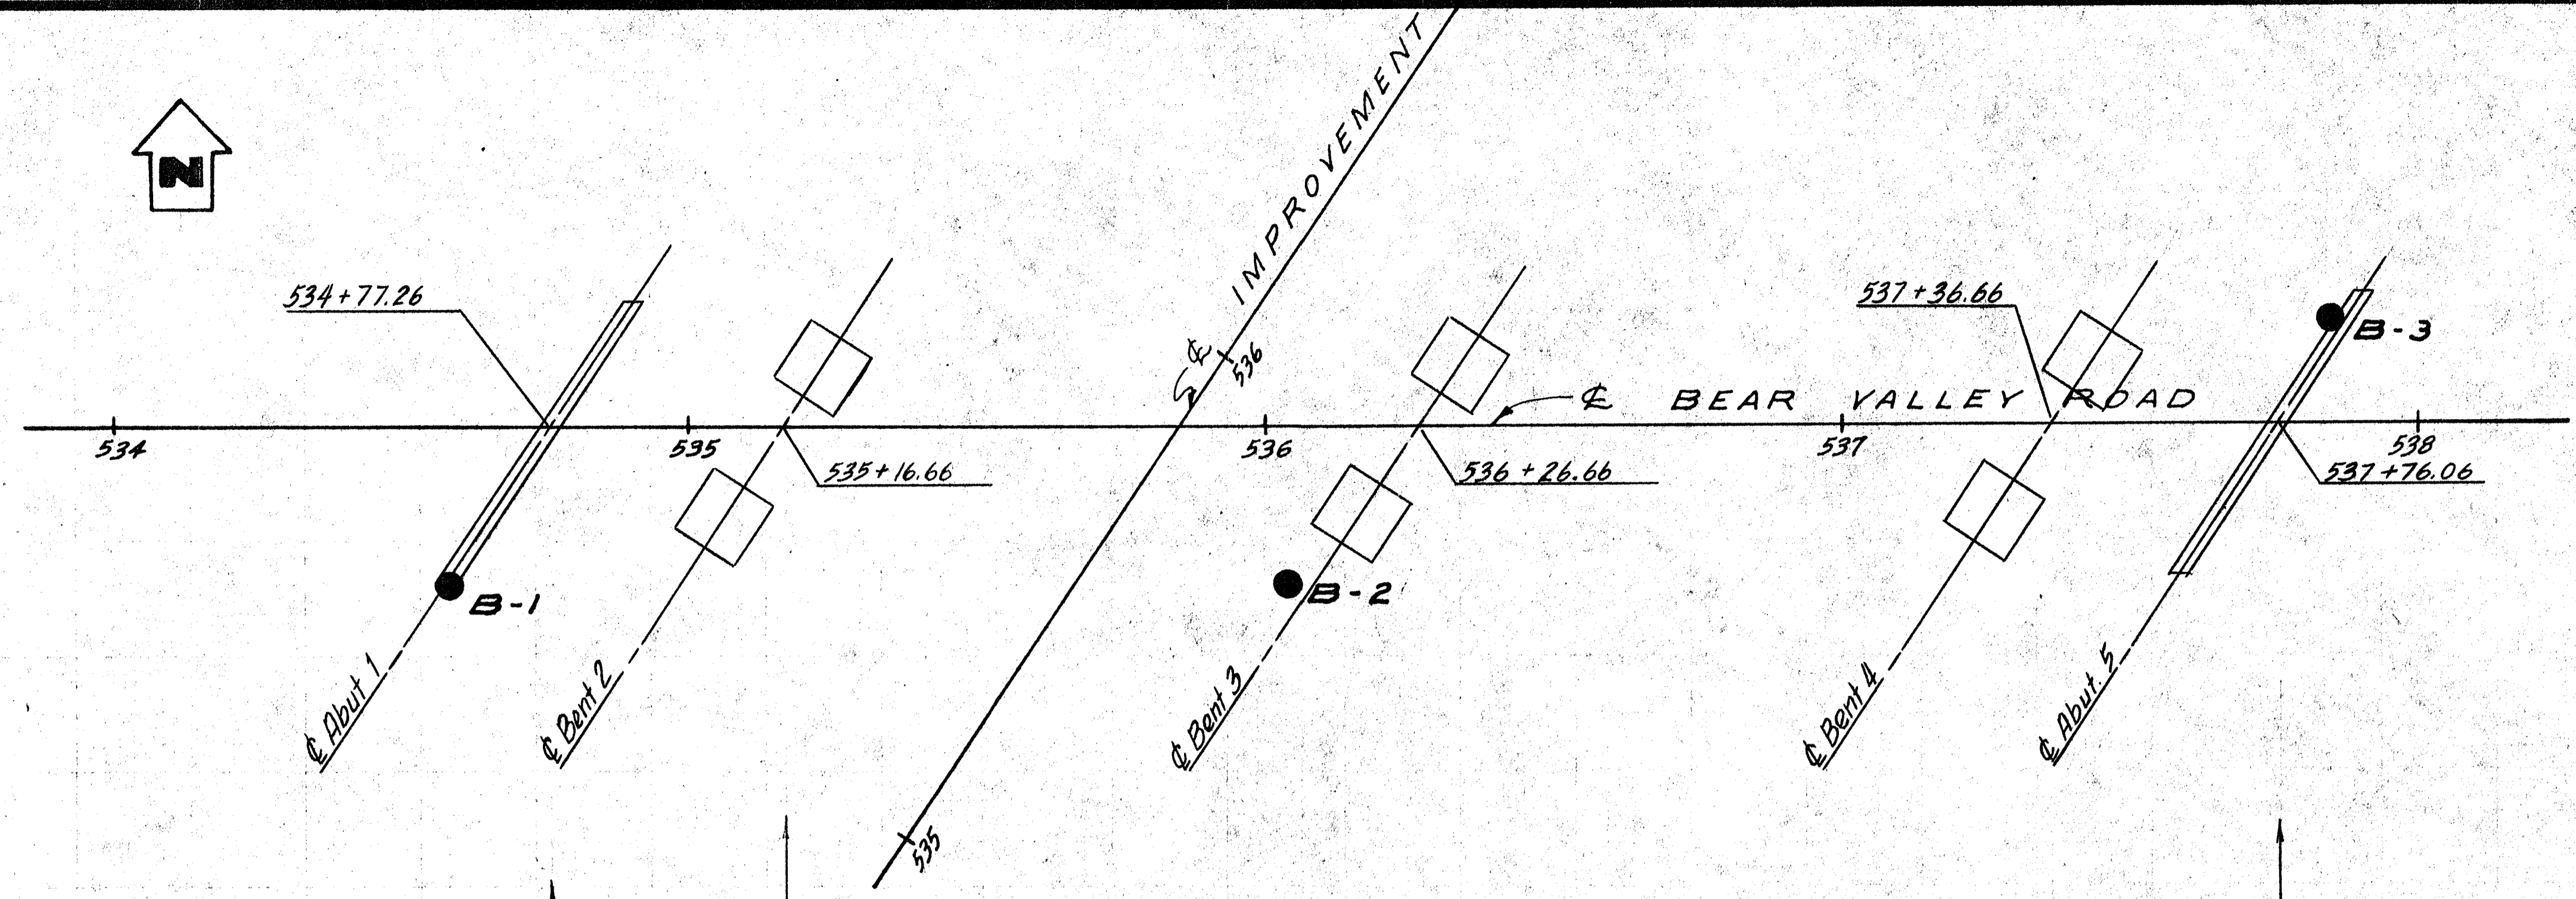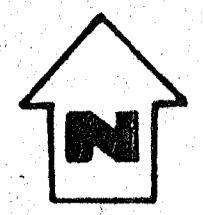

BRIDGE DEPARTMENT


Approx. profile of exist ground along Rt. edge of proposed structure.

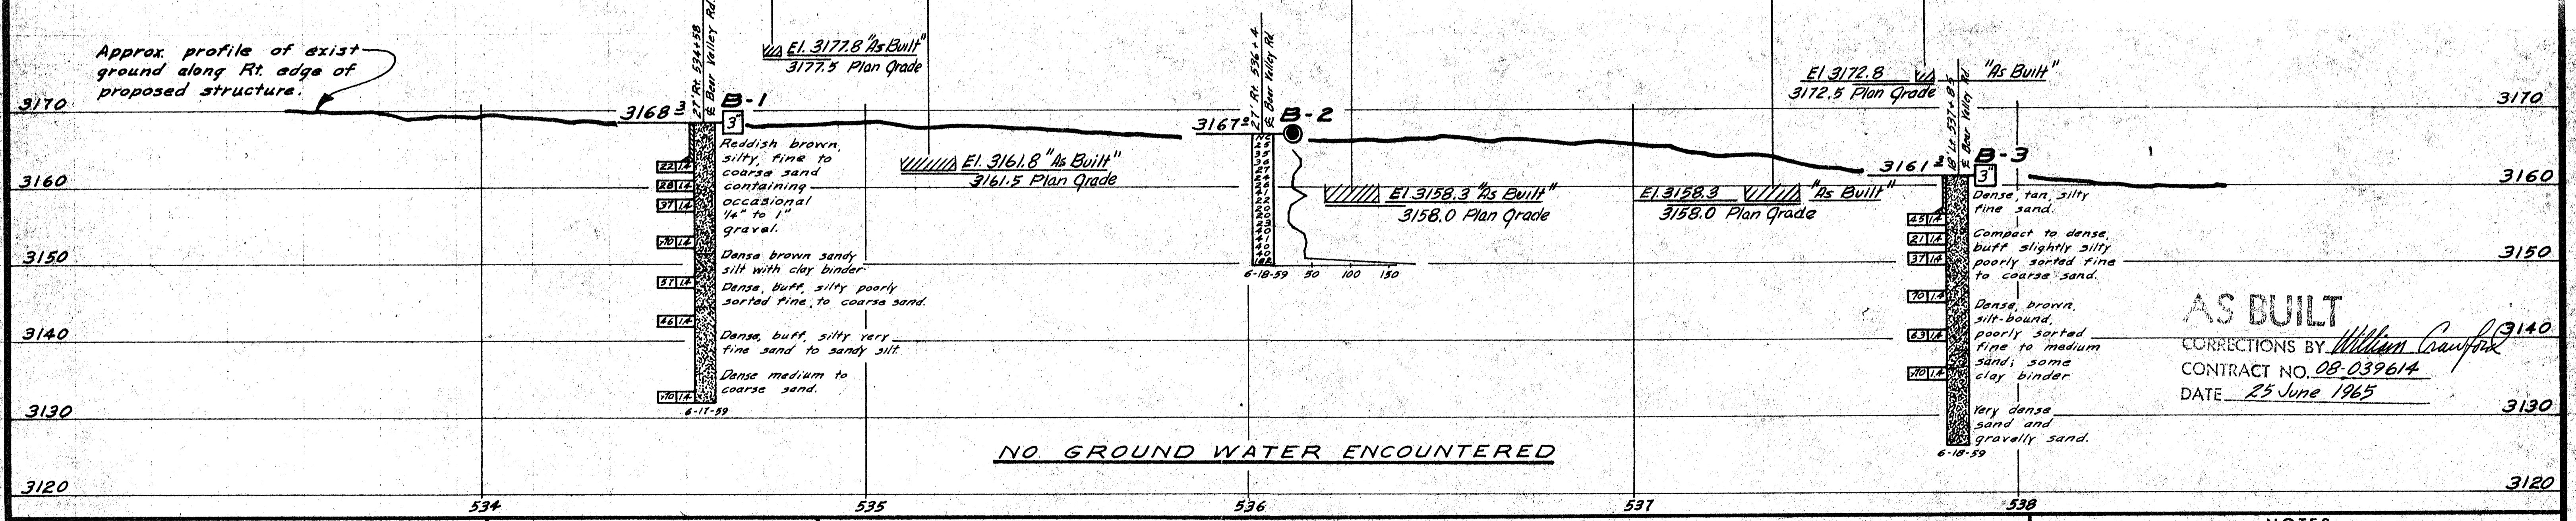

**AS BUILT**  
 CORRECTIONS BY *William Crawford*  
 CONTRACT NO. *08-039614*  
 DATE *25 June 1965*

**NO GROUND WATER ENCOUNTERED**

**CLASSIFICATION OF MATERIAL BASED ON STANDARD GRADE SIZE LIMITS**

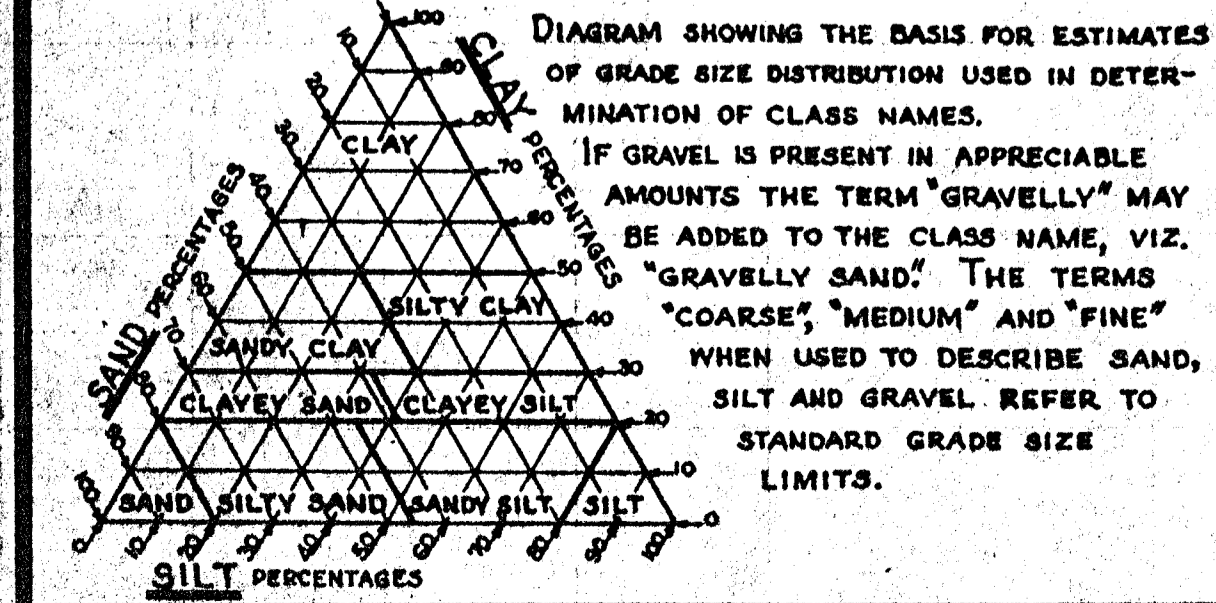

**LEGEND OF EARTH MATERIALS**

- GRAVEL
- SAND
- SILT
- CLAY
- SANDY CLAY OR CLAYEY SAND
- SANDY SILT OR SILTY SAND
- SILTY CLAY OR CLAYEY SILT
- PEAT AND/OR ORGANIC MATTER
- FILL MATERIAL
- IGNEOUS ROCK
- SEDIMENTARY ROCK
- METAMORPHIC ROCK

**LEGEND OF BORING OPERATIONS**

- PLAN OF ANY BORING
  - PENETROMETER
  - 2 1/2" CONE PENETROMETER
  - SAMPLER BORING (DRY)
  - ROTARY BORING (WET)
  - AUGER BORING (DRY)
  - JET BORING
  - CORE BORING
  - TEST PIT
- 

**NOTES**

The contractor's attention is directed to Section 2, Article (c) of the Standard Specifications and to the Special Provisions accompanying this set of plans. Classification of earth material as shown on this sheet is based upon field inspection and is not to be construed to imply mechanical analysis.


STATE OF CALIFORNIA  
 DEPARTMENT OF PUBLIC WORKS  
 DIVISION OF HIGHWAYS

BEAR VALLEY CUTOFF O.C.

**LOG OF TEST BORINGS**

Horiz. 1"=20'  
 SCALE Vert. 1"=10'  
 BRIDGE 54-625 FILE DRAWING 54625-12



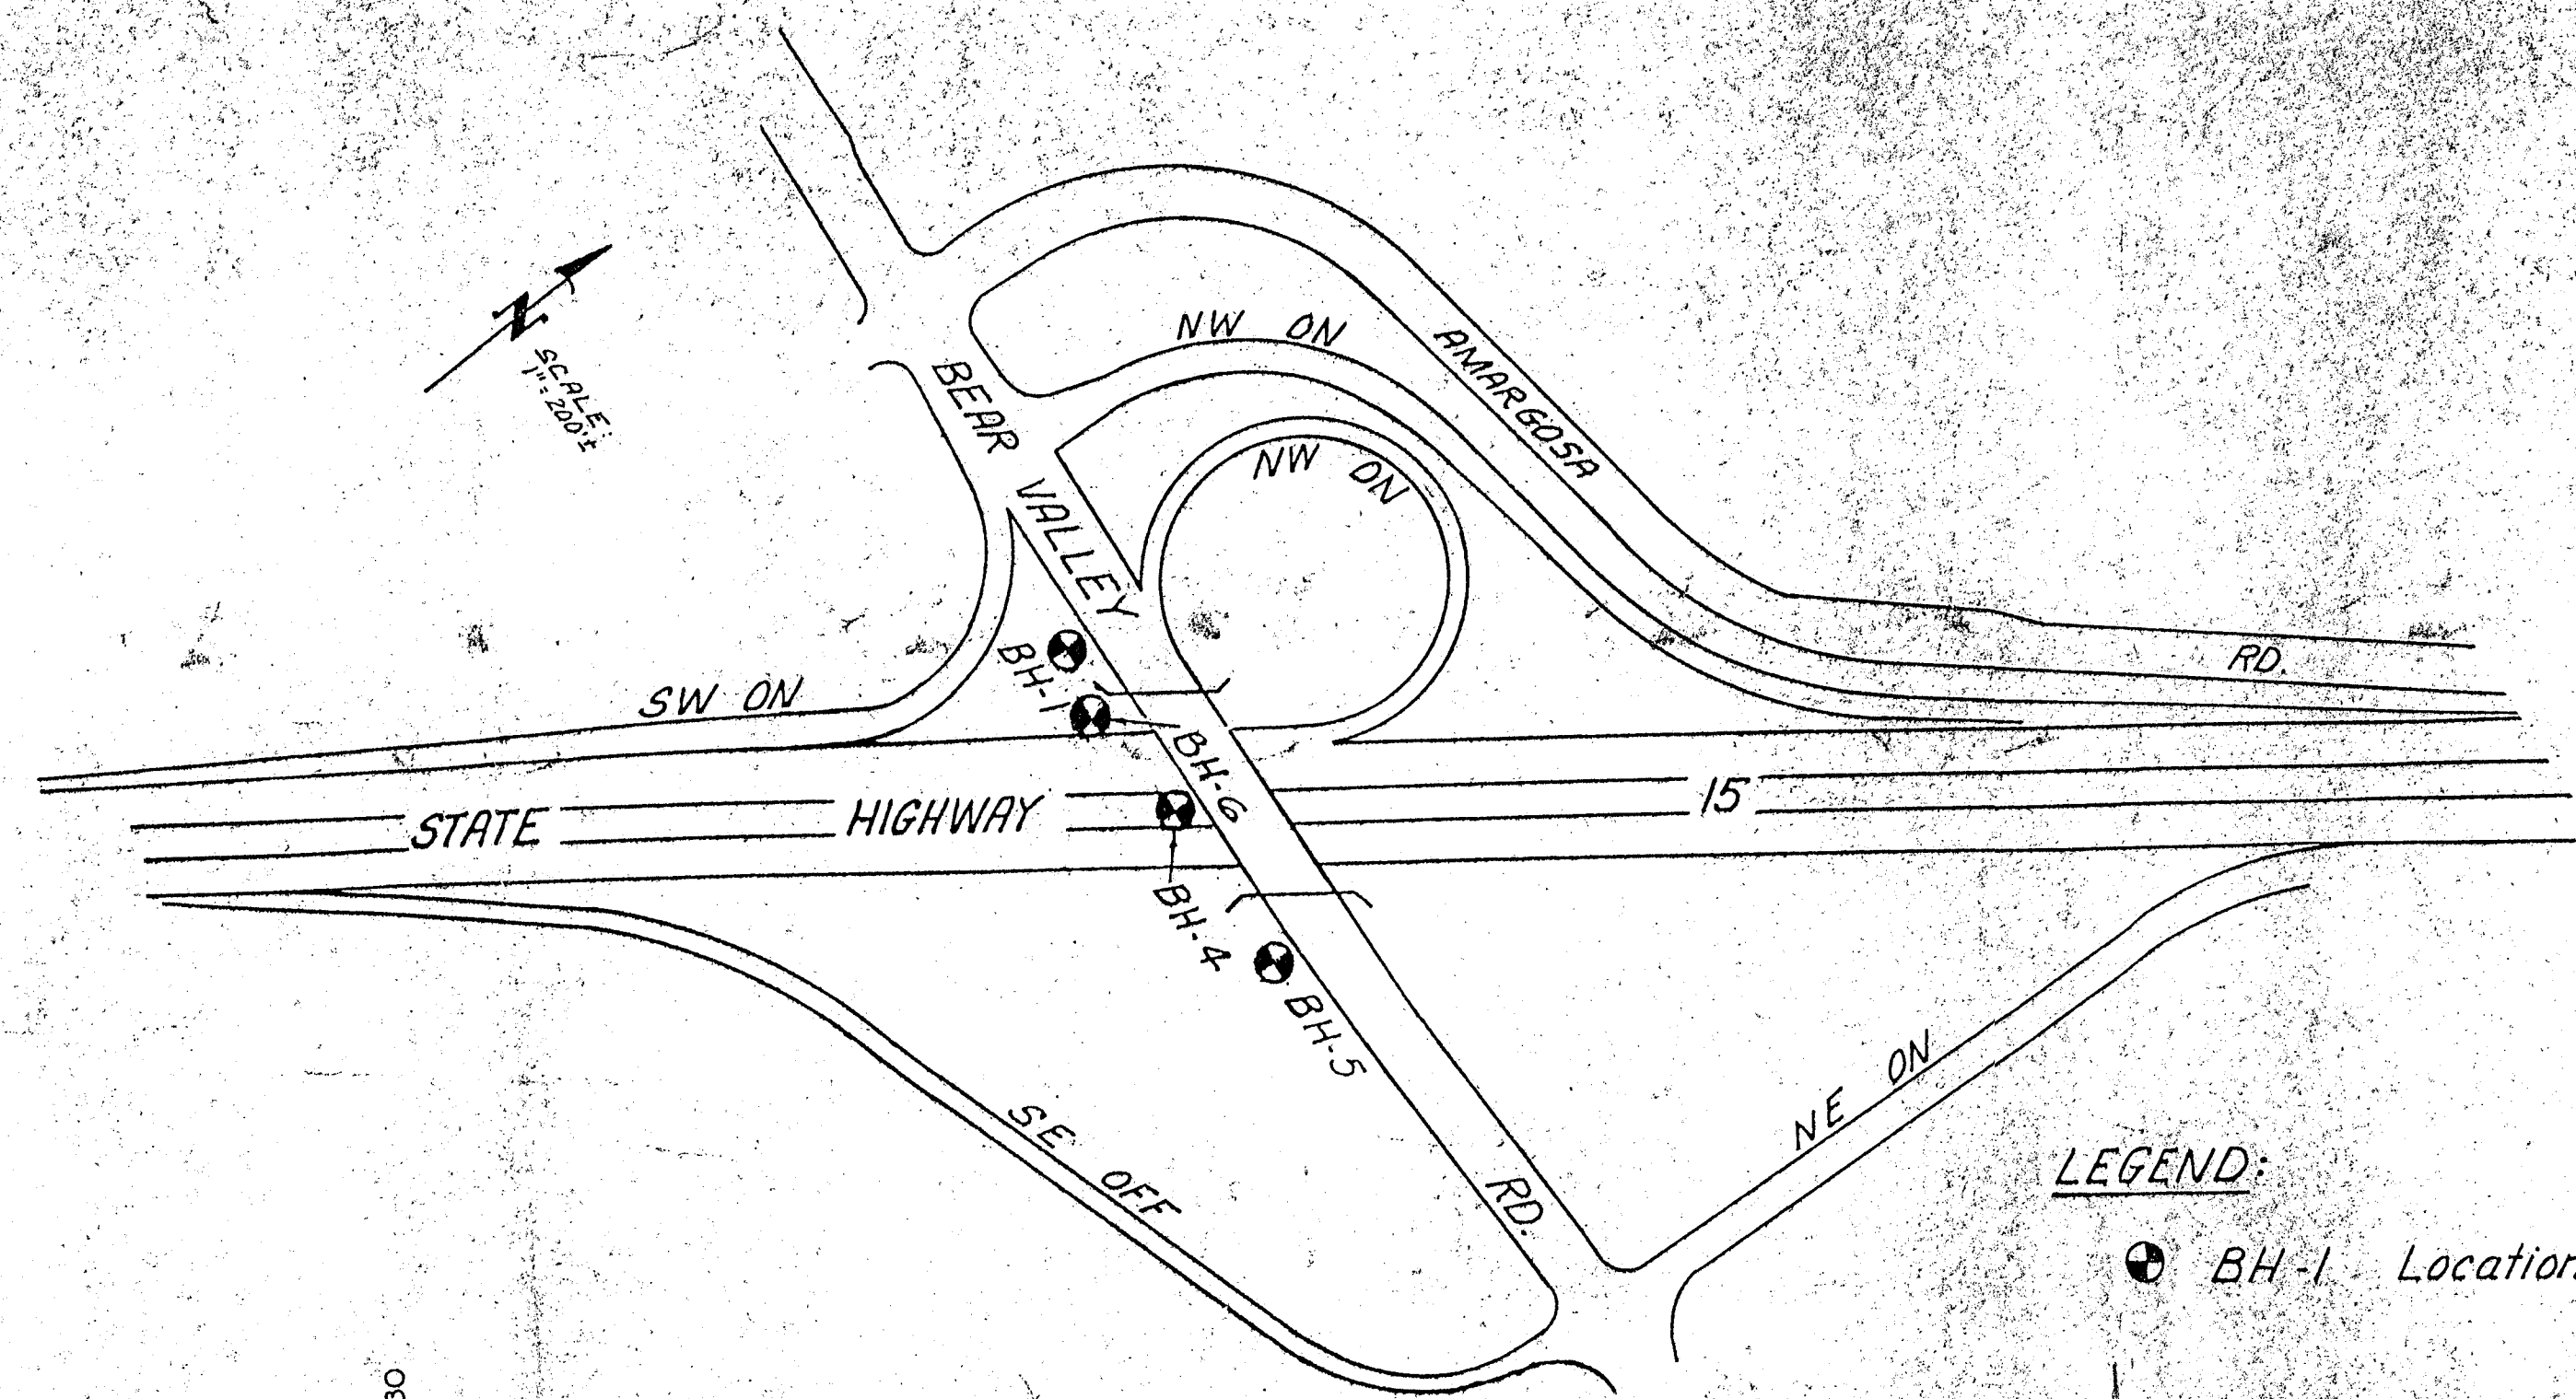

LEGEND:  
 ● BH-1 Location of Test Boring (Typ)

**LEGEND OF BORING OPERATIONS**

**LEGEND OF EARTH MATERIALS**

**CONSISTENCY CLASSIFICATION FOR SOILS**

**LEGEND OF PENETRATION TESTS**

**LEGEND OF SAMPLE BORING (MET)**


**LEGEND OF PENETRATION TESTS**

**LEGEND OF EARTH MATERIALS**

**CONSISTENCY CLASSIFICATION FOR SOILS**

**LEGEND OF PENETRATION TESTS**

**LEGEND OF SAMPLE BORING (MET)**

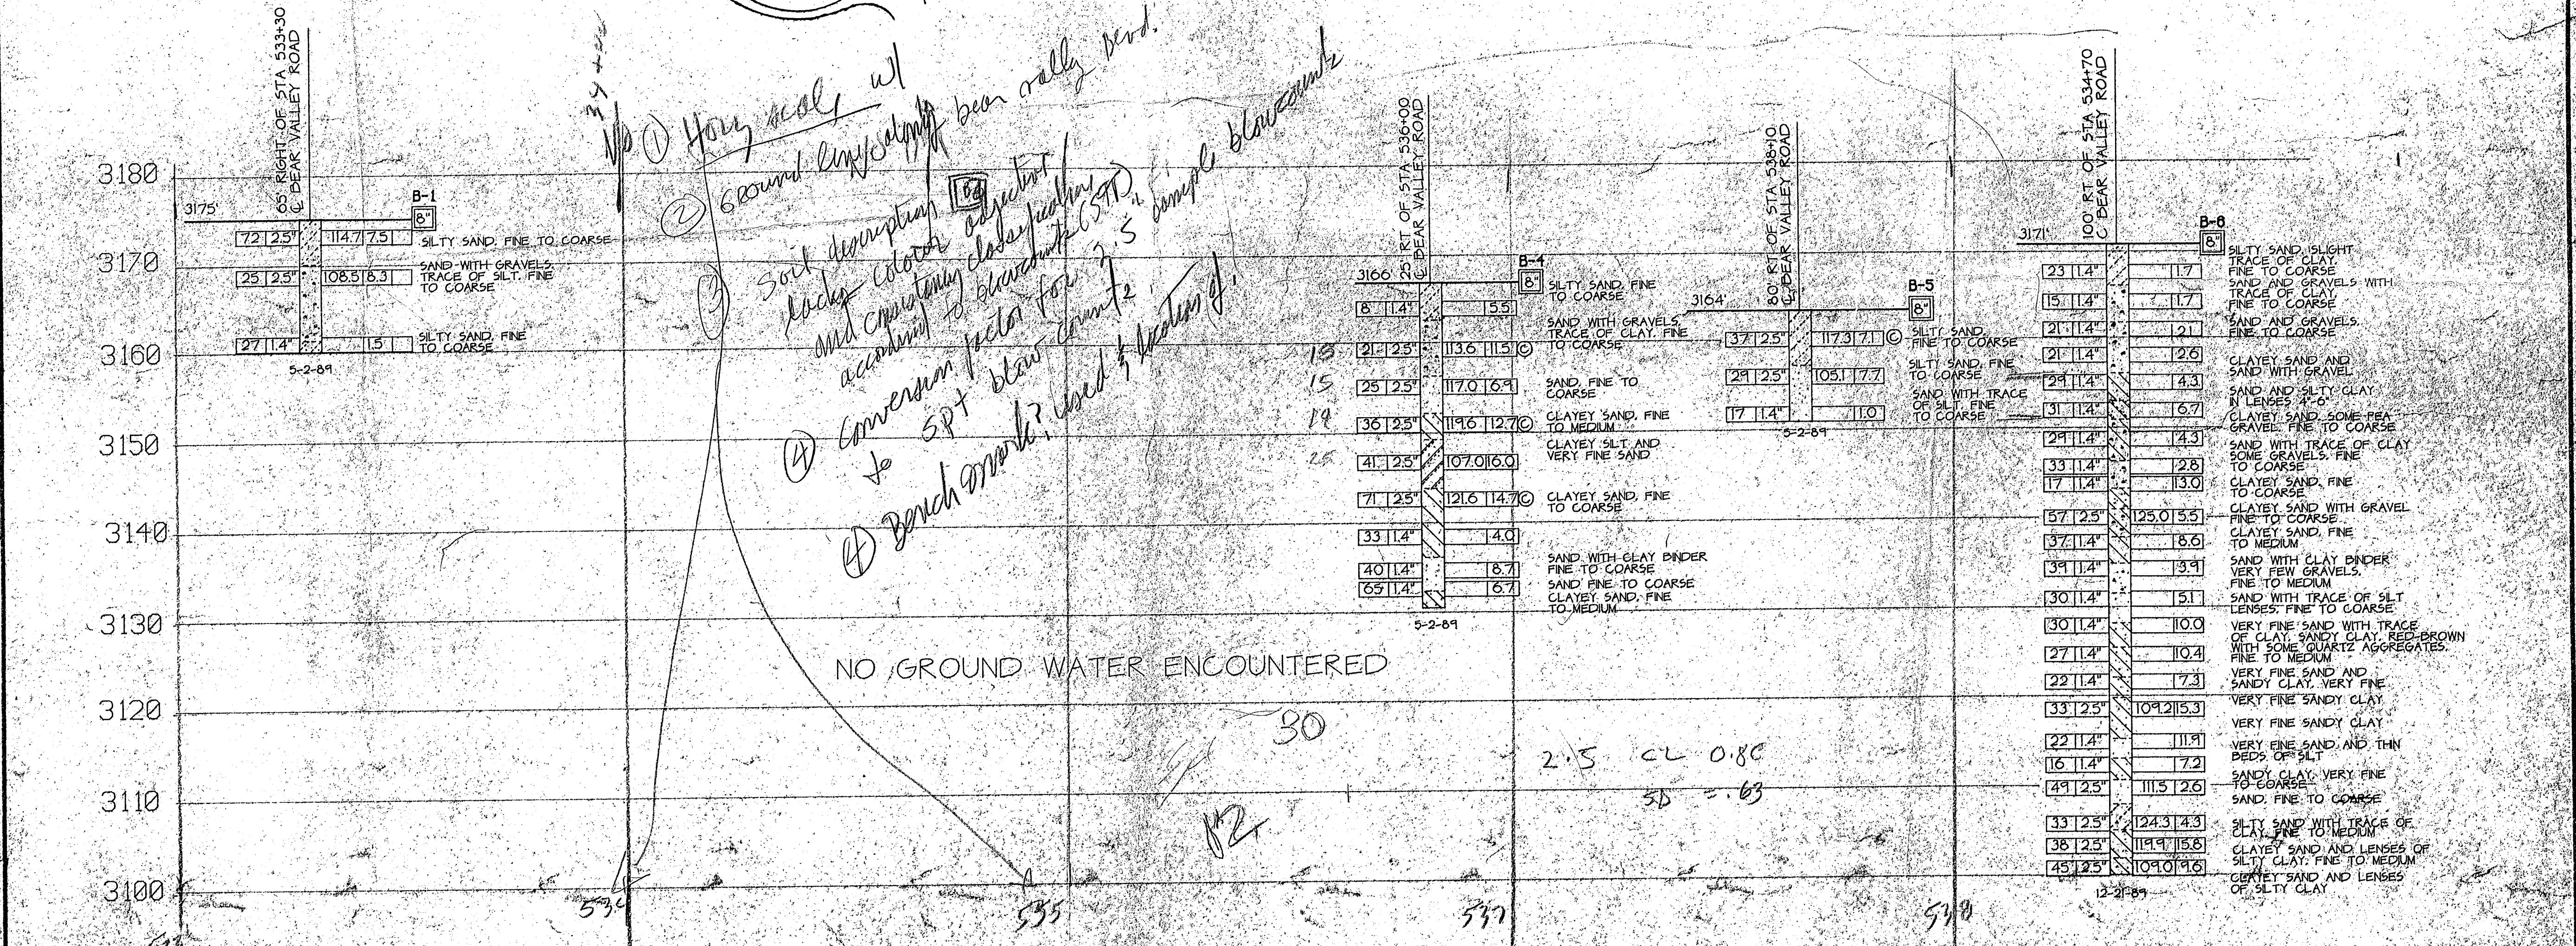

DESIGN OVERSIGHT	DRAWN BY: N. BEDLION	FIELD INVESTIGATOR: R.F. CARDUCCI	DATE: 5-2 & 12-21-87	BRIDGE NO.: 64-625	POST-MILE: 37.6	PROJECT ENGINEER: Victor Lee	REVISION DATES (PRELIMINARY-STAGE ONLY)	SHEET NO. OF 15
DATE: 5-2-87	CHECKED BY: R.F. CARDUCCI	DATE: 5-2-87		BRIDGE NO.: 64-625	POST-MILE: 37.6	PROJECT ENGINEER: Victor Lee		SHEET NO. OF 15

ORIGINAL SCALE IN INCHES FOR REDUCED PLANS



# La Mesa Nisqualli Road OC

BENCHMARKS

MONUMENTS	COORDINATES		ELEVATIONS	DESCRIPTION
	NORTHING	EASTING		
AE Pt. No.1005	609471.897	2061071.613	935.301	Found 1" IP of the centerline Intersection of Nisqually Road and Mariposa Road, Station 159+80.161 centerline 1-15, 33.916 meters right.
AE Pt. No.1076	609571.976	2061087.730	933.858	Set 600 Spk 1 m westerly of the northbound edge of pavement 1-15, Station 160+78.653 centerline 1-15, 2.838 meters right.

DIST	COUNTY	ROUTE	KILOMETER POST TOTAL PROJECT	SHEET No	TOTAL SHEETS
8	SBd	15	61.5 / 63.4		

REGISTERED CIVIL ENGINEER DATE



PLANS APPROVAL DATE

CITY OF VICTORVILLE  
14343 CIVIC DRIVE  
VICTORVILLE, CA 92393

EARTH MECHANICS, INC  
17660 NEWHOPE STREET, SUITE E  
FOUNTAIN VALLEY, CA 92708

NOTES

52mm samples were taken using a California split-barrel sampler with an inside diameter (I.D) of 62mm and an outside diameter (O.D) of 83mm.  
A rope and cathode hammer system consisting of a hammer weight of 63.5kN falling a distance of 762mm was used to advance the drive sampler(s)  
This LOTB sheet (Boring Record) was prepared in accordance with the Caltrans Soil and Rock Classification Logging, Classification and Presentation Manual (June 2007)

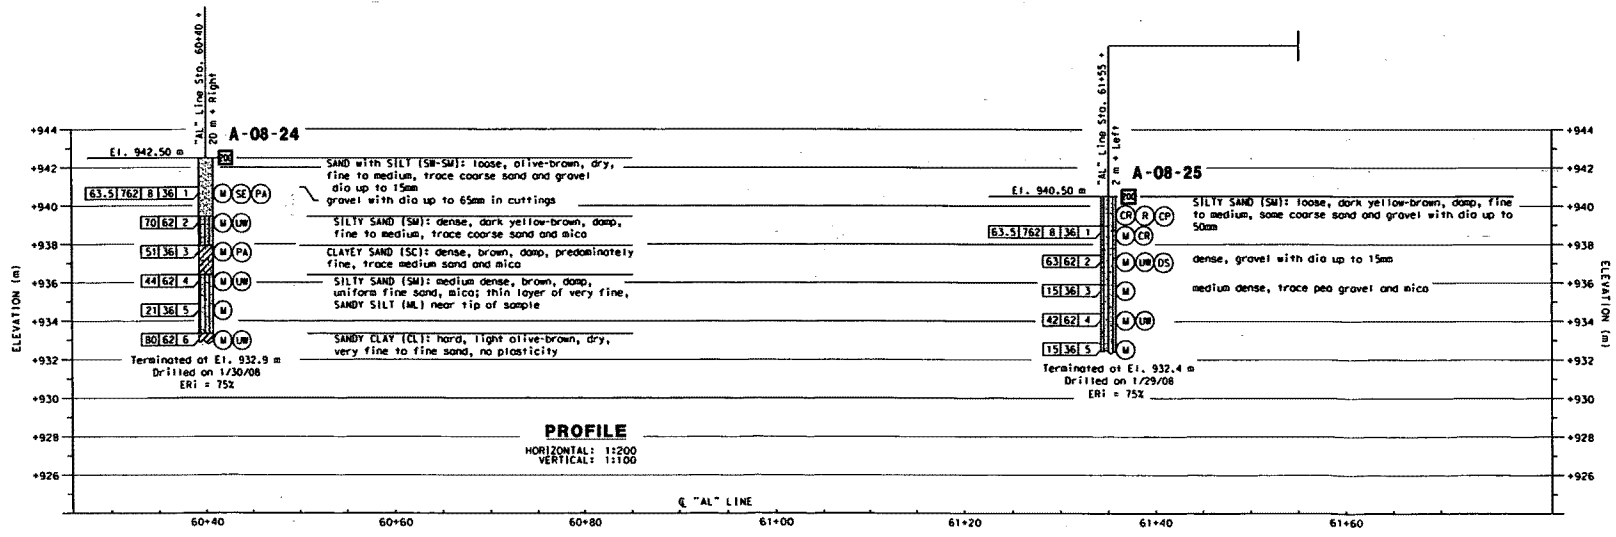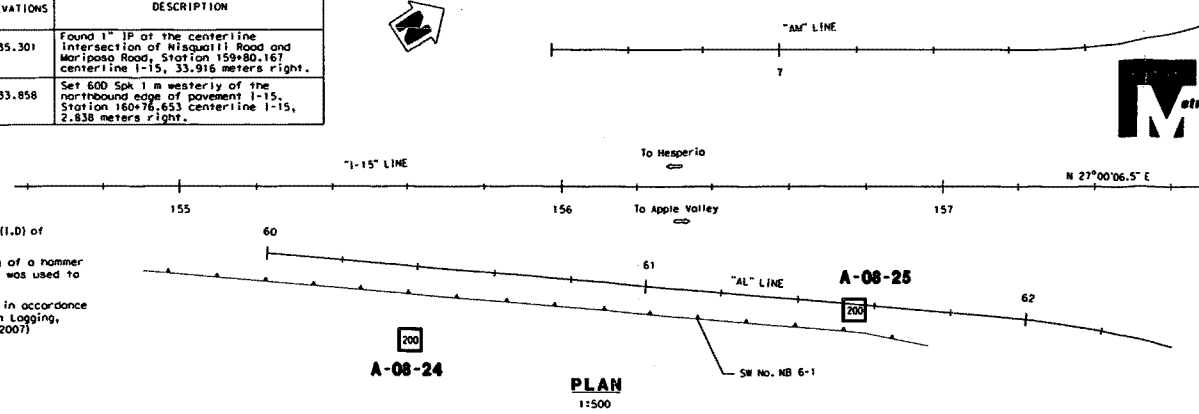

ENGINEERING SERVICES		GEOTECHNICAL SERVICES		PREPARED FOR THE STATE OF CALIFORNIA DEPARTMENT OF TRANSPORTATION		BRIDGE NO. XX-XXXX		SOUND WALL NO. NB 6-1	
FUNCTIONAL SUPERVISOR NAME: K. Arulraj	DRAWN BY: E. Brown	FIELD INVESTIGATION BY: R. Jie	PROJECT ENGINEER	E. Brown		SHEET NO. XX		LOG OF TEST BORINGS	
CHECKED BY: R. Dunganon		ORIGINAL SCALE IN MILLIMETERS FOR REDUCED PLANS		CU E.A. 0404501		REVISION DATES (PRELIMINARY STAGE ONLY)		SHEET OF XX XX	

BENCHMARKS

MONUMENTS	COORDINATES		ELEVATIONS	DESCRIPTION
	NORTHING	EASTING		
AE Pt. No. 1005	609471.897	2061071.613	935.301	Found 1" IP of the centerline intersection of Miguaiti Road and Mariposa Road, Station 159+80.167 centerline I-15, 33.916 meters right.
AE Pt. No. 1076	609571.976	2061087.730	933.858	Set 600 Spk 1 m westerly of the northbound edge of pavement I-15, Station 160+76.653 centerline I-15, 2.838 meters right.

NOTES

62mm samples were taken using a California split-barrel sampler with an inside diameter (I.D.) of 62mm and an outside diameter (O.D.) of 83mm. A rope and cathead hammer system consisting of a hammer weight of 63.5kN falling a distance of 762mm was used to advance the drive sampler(s).

This LOTB sheet (Boring Record) was prepared in accordance with the Caltrans Soil and Rock Classification Logging, Classification and Presentation Manual (June 2007)



DIST	COUNTY	ROUTE	MILEAGE PER POST	TOTAL PROJECT	SHEET No	TOTAL SHEETS
8	Sbd	15	61.5 / 63.4			


REGISTERED CIVIL ENGINEER DATE

PLANS APPROVAL DATE


The State of California or its officers or agents shall not be responsible for the accuracy or completeness of electronic copies of this plan sheet.

CITY OF VICTORVILLE  
14343 CIVIC DRIVE  
VICTORVILLE, CA 92393

EARTH MECHANICS, INC  
17660 NEWHOPE STREET, SUITE E  
FOUNTAIN VALLEY, CA 92708

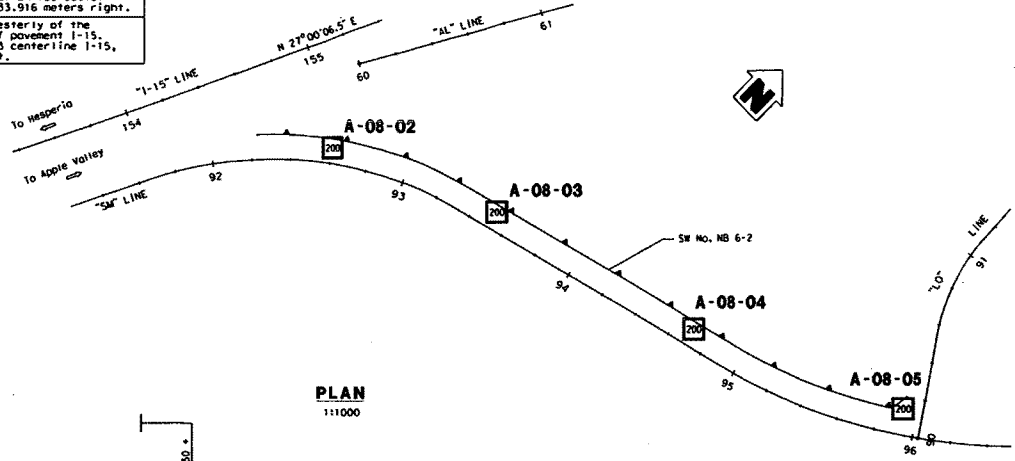

PLAN  
1:11000

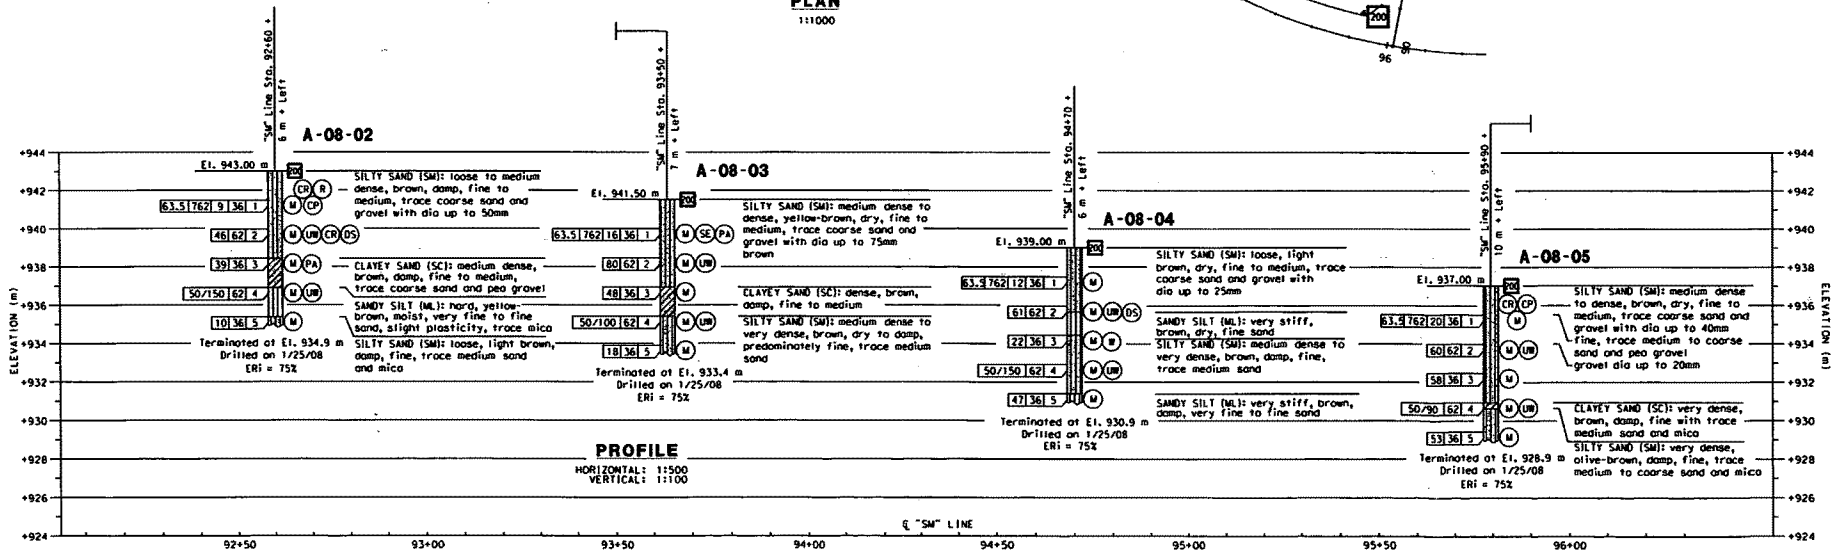

PROFILE  
HORIZONTAL: 1:1500  
VERTICAL: 1:100

<b>ENGINEERING SERVICES</b>		<b>GEOTECHNICAL SERVICES</b>		<b>PREPARED FOR THE STATE OF CALIFORNIA DEPARTMENT OF TRANSPORTATION</b>		<b>SOUND WALL NO. NB 6-2 LOG OF TEST BORINGS</b>	
FUNCTIONAL SUPERVISOR NAME: R. Arundel	Drawn by: E. Brown	FIELD INVESTIGATION BY: R. Jie	E. Brown PROJECT ENGINEER	BRIDGE NO. XX-XXXX	REVISION DATES (PRELIMINARY STAGE ONLY)		
CHECKED BY: R. Gunorjon			CU EA 0404501	ALLOWED POST XX, XX			
ORIGINAL SCALE IN MILLIMETERS FOR REDUCED PLANS				DISCARD PRINTS BEARING LATER REVISION DATES		SHEET OF XX XX	

DATE PLOTTED BY: WJH




MONUMENTS	COORDINATES		ELEVATIONS	DESCRIPTION
	NORTHING	EASTING		
AE Pt. No.1005	609471.897	2061071.613	935.301	Found 1" IP of the centerline intersection of Misquahili Road and Moriposo Road, Station 159+00.167 centerline 1-15, 33.916 meters right.
AE Pt. No.1076	609571.976	2061087.730	933.858	Set 600 Spk 1 m westerly of the northbound edge of pavement 1-15, Station 160+76.653 centerline 1-15, 2.838 meters right.

**NOTES**

62mm samples were taken using a California split-barrel sampler with an inside diameter (I.D.) of 62mm and an outside diameter (O.D.) of 83mm.

A rope and cathead hammer system consisting of a hammer weight of 63.5kN falling a distance of 762mm was used to advance the drive sampler(s).

This LOGB sheet (Boring Record) was prepared in accordance with the Caltrans Soil and Rock Classification Logging, Classification and Presentation Manual (June 2007)

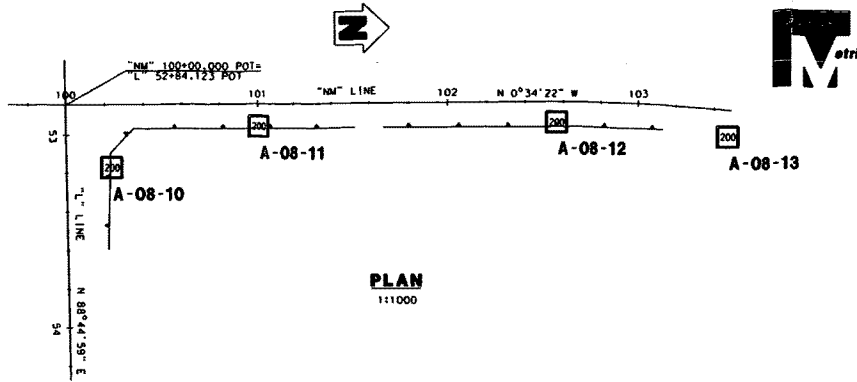

DIST	COUNTY	ROUTE	KILOMETER POST TOTAL PROJECT	SHEET NO.	TOTAL SHEETS
8	SBd	15	61.5 / 63.4		


REGISTERED CIVIL ENGINEER DATE

PLANS APPROVAL DATE


The State of California or its officers or agents shall not be responsible for the accuracy or completeness of electronic copies of this plan sheet.

CITY OF VICTORVILLE  
14343 CIVIC DRIVE  
VICTORVILLE, CA 92393

EARTH MECHANICS, INC  
17660 NEWHOPE STREET, SUITE E  
FOUNTAIN VALLEY, CA 92708

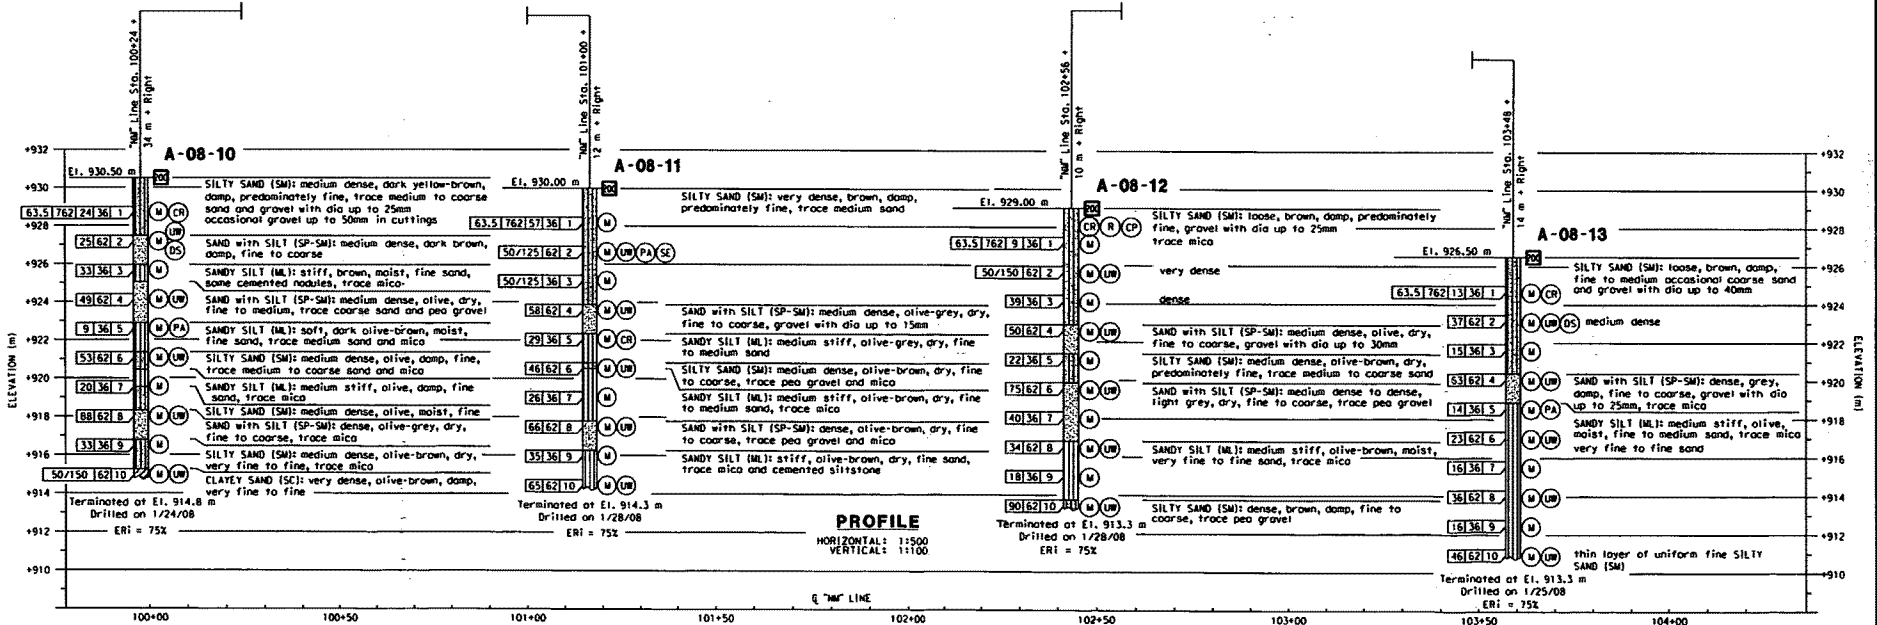

<b>ENGINEERING SERVICES</b>		<b>GEOTECHNICAL SERVICES</b>		<b>PREPARED FOR THE STATE OF CALIFORNIA DEPARTMENT OF TRANSPORTATION</b>		<b>BRIDGE NO. XX-XXXX</b>		<b>RETAINING WALL NO. NB 6-3 (A/B)</b>			
FUNCTIONAL SUPERVISOR	NAME: K. Arulmoji	DRAWN BY: E. Brown	CHECKED BY: R. Gunarajan	FIELD INVESTIGATION BY: R. Jie	E. Brown	PROJECT ENGINEER	DATE: 11/28/08	<b>LOG OF TEST BORINGS</b>			
ORIGINAL SCALE IN MILLIMETERS FOR REDUCED PLANS						CUJ E.A. 0404501		REVISION DATES (PRELIMINARY STATE ONLY)			
DATE PLOTTED => DATE						FILE => REQUEST		SHEET OF XX XX			

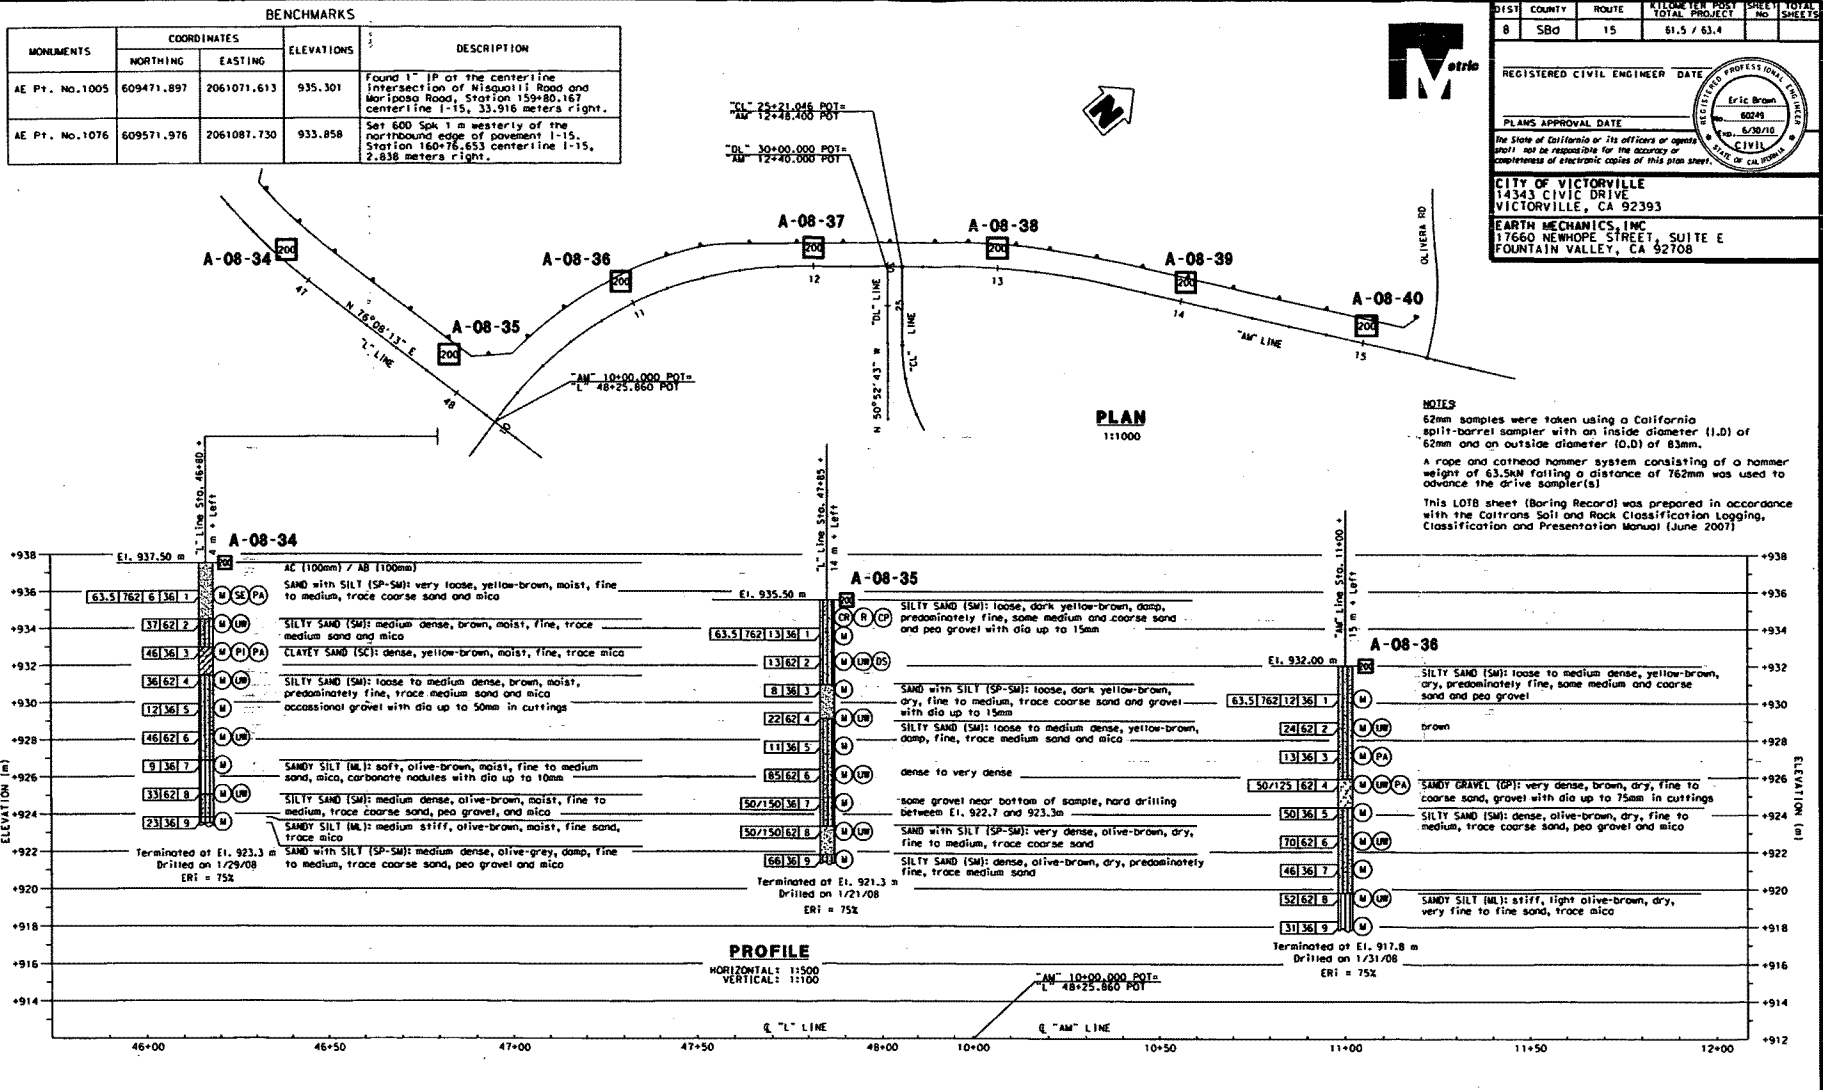

<b>ENGINEERING SERVICES</b>		<b>GEOTECHNICAL SERVICES</b>		<b>PREPARED FOR THE STATE OF CALIFORNIA DEPARTMENT OF TRANSPORTATION</b>		<b>RETAINING WALL NO. NB 6-5 LOG OF TEST BORINGS (1 OF 2)</b>	
FUNCTIONAL SUPERVISOR NAME: R. Arjuntol	DRAWN BY: E. Brown	CHECKED BY: R. Gunarajan	FIELD INVESTIGATION BY: R. Jie	E. Brown PROJECT ENGINEER	ISSUE NO.: XX-XXXX EVALUATED BY: XX.XX FILE # 0404501	DISPREP. PRINTS BEHIND EMBLETTED REVISION SHEET	REVISION DATES PRELIMINARY STAGE QUALITY
DATE CIVIL LOG OF TEST BORINGS SHEET (EMBL) (REV. 2-8-08)				ORIGINAL SCALE IN MILLIMETERS FOR REDUCED PLANS	CU E.A. 0404501	FILE # 0404501	SHEET OF XX XX

MONUMENTS	COORDINATES		ELEVATIONS	DESCRIPTION
	NORTHING	EASTING		
AE Pt. No.1005	609471.897	2061071.613	935.301	Found 1" IP of the centerline intersection of Nisqually Road and Mariposa Road, Station 159+80.167 centerline I-15, 33.916 meters right.
AE Pt. No.1076	609571.976	2061087.730	933.858	Set 60D Spk 1 m westerly of the northbound edge of pavement I-15, Station 160+76.653 centerline I-15, 2.838 meters right.



DIST	COUNTY	ROUTE	KILOMETER POST TOTAL PROJECT	SHEET No	TOTAL SHEETS
8	SBd	15	61.5 / 63.4		


REGISTERED CIVIL ENGINEER DATE \_\_\_\_\_  
 Eric Brown 6049  
 5/30/10  
 CIVIL  
 STATE OF CALIFORNIA

PLANS APPROVAL DATE \_\_\_\_\_


The State of California or its officers or agents shall not be responsible for the accuracy or completeness of electronic copies of this plan sheet.

CITY OF VICTORVILLE  
 14343 CIVIC DRIVE  
 VICTORVILLE, CA 92393

EARTH MECHANICS, INC  
 17660 NEWHOPE STREET, SUITE E  
 FOUNTAIN VALLEY, CA 92708

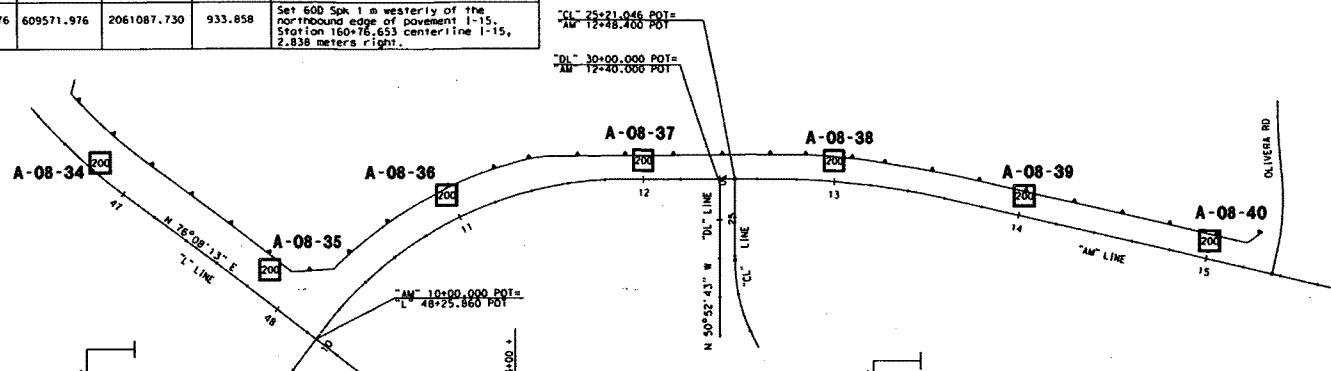

NOTES:  
 62mm samples were taken using a California split-barrel sampler with an inside diameter (I.D) of 62mm and an outside diameter (O.D) of 83mm.  
 A rope and cathead hammer system consisting of a hammer weight of 63.5kN falling a distance of 762mm was used to advance the drive sampler(s).  
 This LOTB sheet (Boring Record) was prepared in accordance with the Caltrans Soil and Rock Classification Logging, Classification and Presentation Manual (June 2007)

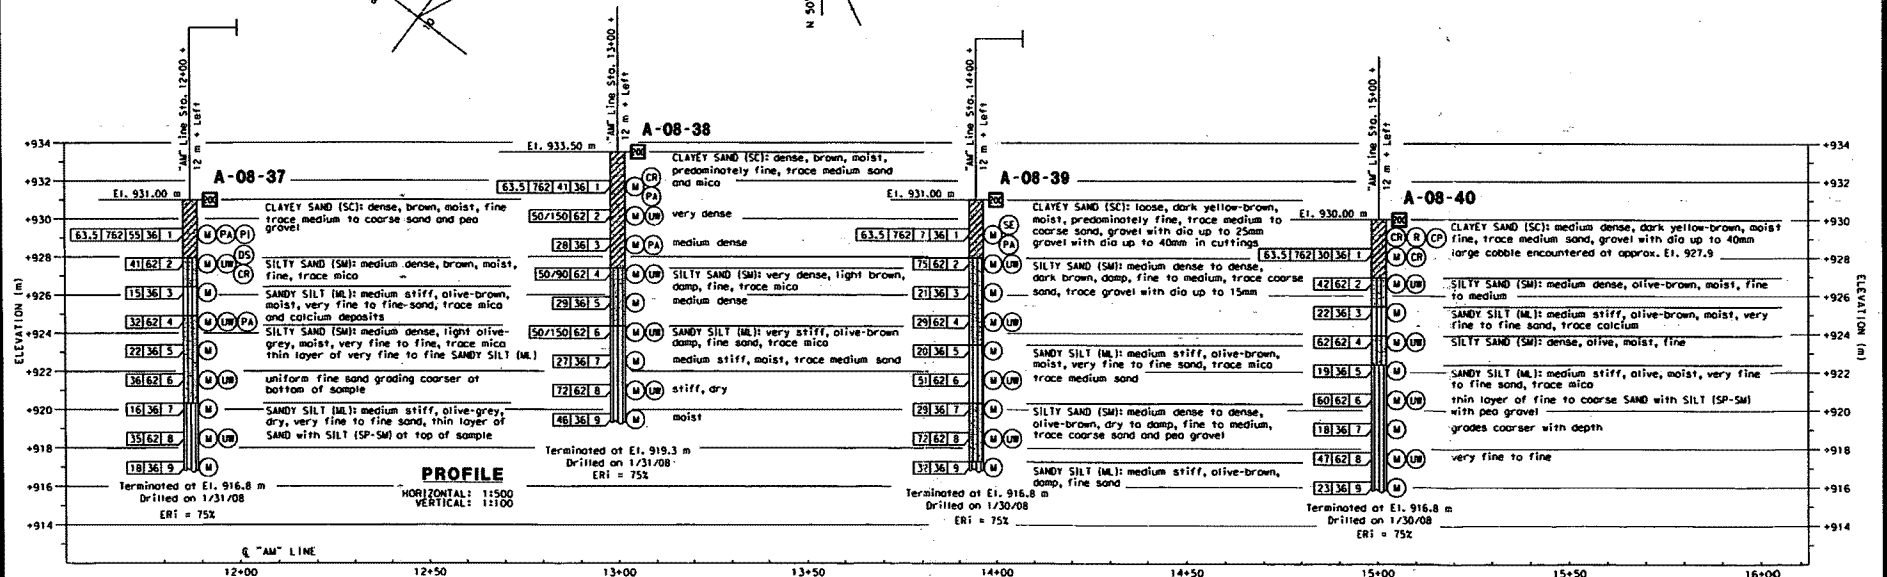



<b>ENGINEERING SERVICES</b>		<b>GEOTECHNICAL SERVICES</b>		<b>PREPARED FOR THE STATE OF CALIFORNIA DEPARTMENT OF TRANSPORTATION</b>		<b>BRIDGE NO. XX-XXXX</b>		<b>RETAINING WALL NO. NB 6-5</b>	
FUNCTIONAL SUPERVISOR	NAME: K. Arulmani	DRAWN BY: E. Brown	CHECKED BY: R. Gunjanon	FIELD INVESTIGATION BY: R. Jie	PROJECT ENGINEER	CLU E A 0404501	FILE # 3 REQUEST	<b>LOG OF TEST BORINGS (2 OF 2)</b>	
DATE PLOTTED: 03-04-2010						DATE PLOTTED: 03-04-2010			



MONUMENTS	COORDINATES		ELEVATIONS	DESCRIPTION
	NORTHING	EASTING		
AE Pt. No.1005	609471.897	2061071.613	935.301	Found 1" IP at the centerline intersection of Nisqualli Road and Mariposa Road, Station 159+80.167 centerline 1-15, 33.916 meters right.
AE Pt. No.1076	609571.976	2061087.730	933.858	Set 600 Spk 1 m westerly of the northbound edge of pavement 1-15, Station 160+76.653 centerline 1-15, 2.838 meters right.

**NOTES**

62mm samples were taken using a California split-barrel sampler with an inside diameter (I.D.) of 62mm and an outside diameter (O.D.) of 83mm. A rope and cathead hammer system consisting of a hammer weight of 83.5kg falling a distance of 762mm was used to advance the drive sampler(s). This LOG sheet (Boring Record) was prepared in accordance with the Caltrans Soil and Rock Classification Logging, Classification and Presentation Manual (June 2007).

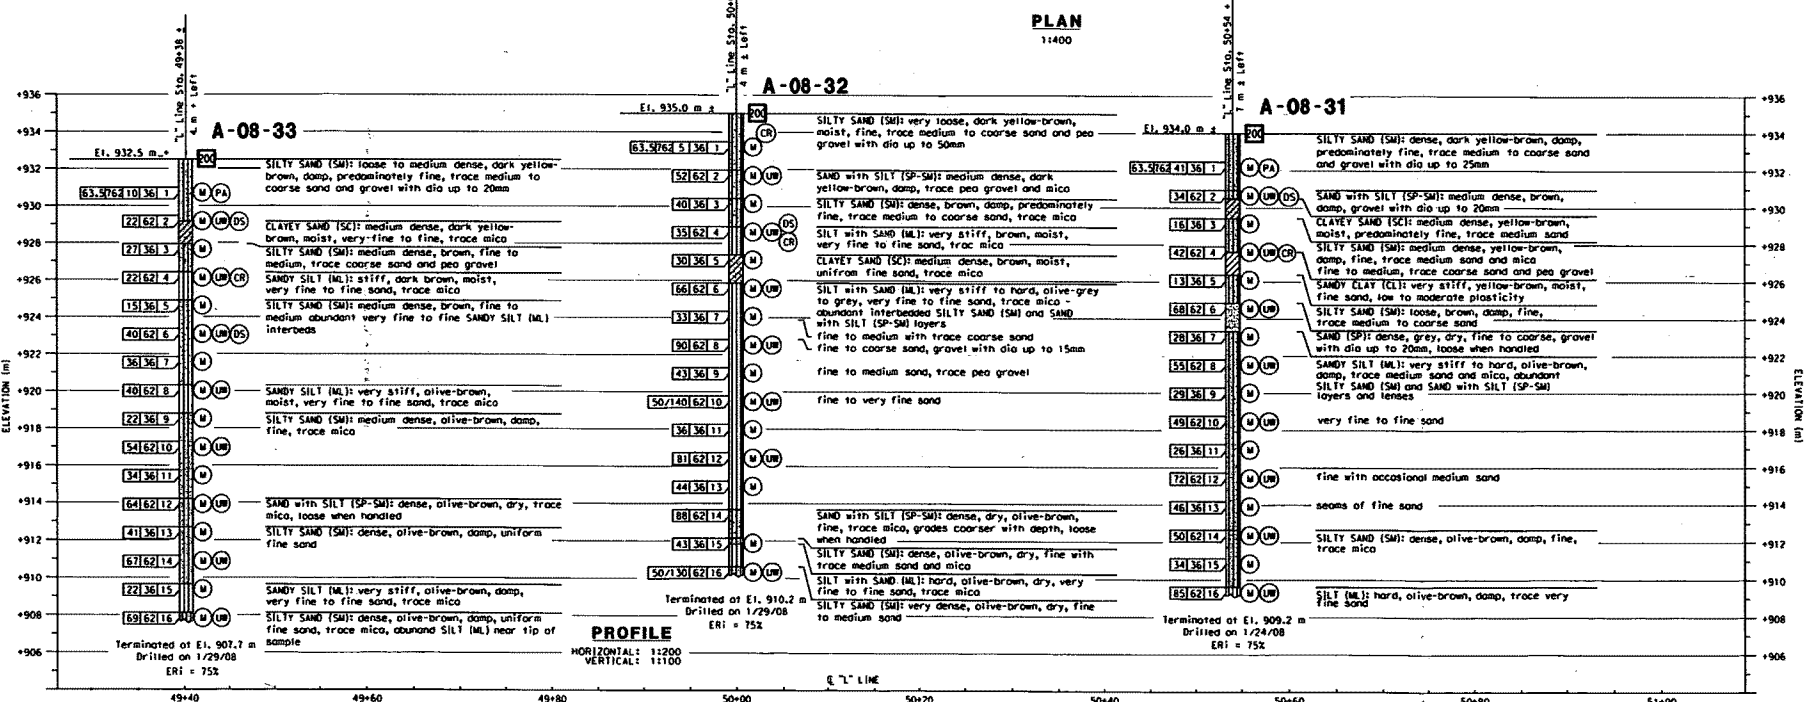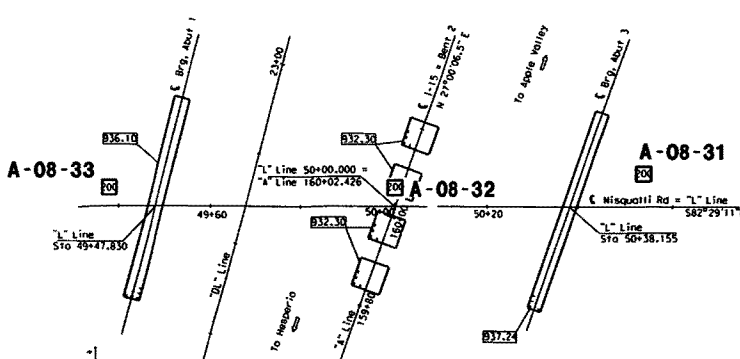

X DESIGN OVERSIGHT X SIGN OFF DATE	<b>GEOTECHNICAL SERVICES</b> DRAWN BY: E. Brown CHECKED BY: R. GUNORANJON		FIELD INVESTIGATION BY: R. Jie		<b>PREPARED FOR THE STATE OF CALIFORNIA DEPARTMENT OF TRANSPORTATION</b> PROJECT ENGINEER: E. Brown		BRIDGE NO. 54-1284 ALLOWED POST 62.41		<b>LA MESA ROAD - NISQUALLI ROAD OVERCROSSING</b> <b>LOG OF TEST BORINGS NO. 3</b>	
	ORIGINAL SCALE IN MILLIMETERS FOR REDUCED PLANS		HORIZONTAL: 1:1200 VERTICAL: 1:100		CU 08224 EA 044501		SHEET 24 OF 24		SHEET 24 OF 24	

CU CIVIL LOG OF TEST BORINGS SHEET (EML159) (REV. 2-4-08)

FILE -> REQUEST

**REGISTERED CIVIL ENGINEER** DATE: 6/28/10  
 Eric Brown  
 No. 6249  
 CIVIL  
 STATE OF CALIFORNIA

**CITY OF VICTORVILLE**  
 14343 CIVIC DRIVE  
 VICTORVILLE, CA 92393


**PARSONS BRINCKERHOFF**  
 985 EAST CARNEGIE DRIVE, SUITE 210  
 SAN BERNARDINO, CA 92408

**EARTH MECHANICS, INC**  
 17650 NEWHOPE STREET, SUITE E  
 FOUNTAIN VALLEY, CA 92708

## SR 18/I 15 Separation

PROJECT NO.	7	STATE	CAL.	FISCAL YEAR	1954	TOTAL SHEETS	52	CURRENT SHEET	52
DATE	VII 584	NO.	31	CLASS.	C	NO.	9	SCALE	AS SHOWN

February 14, 1955

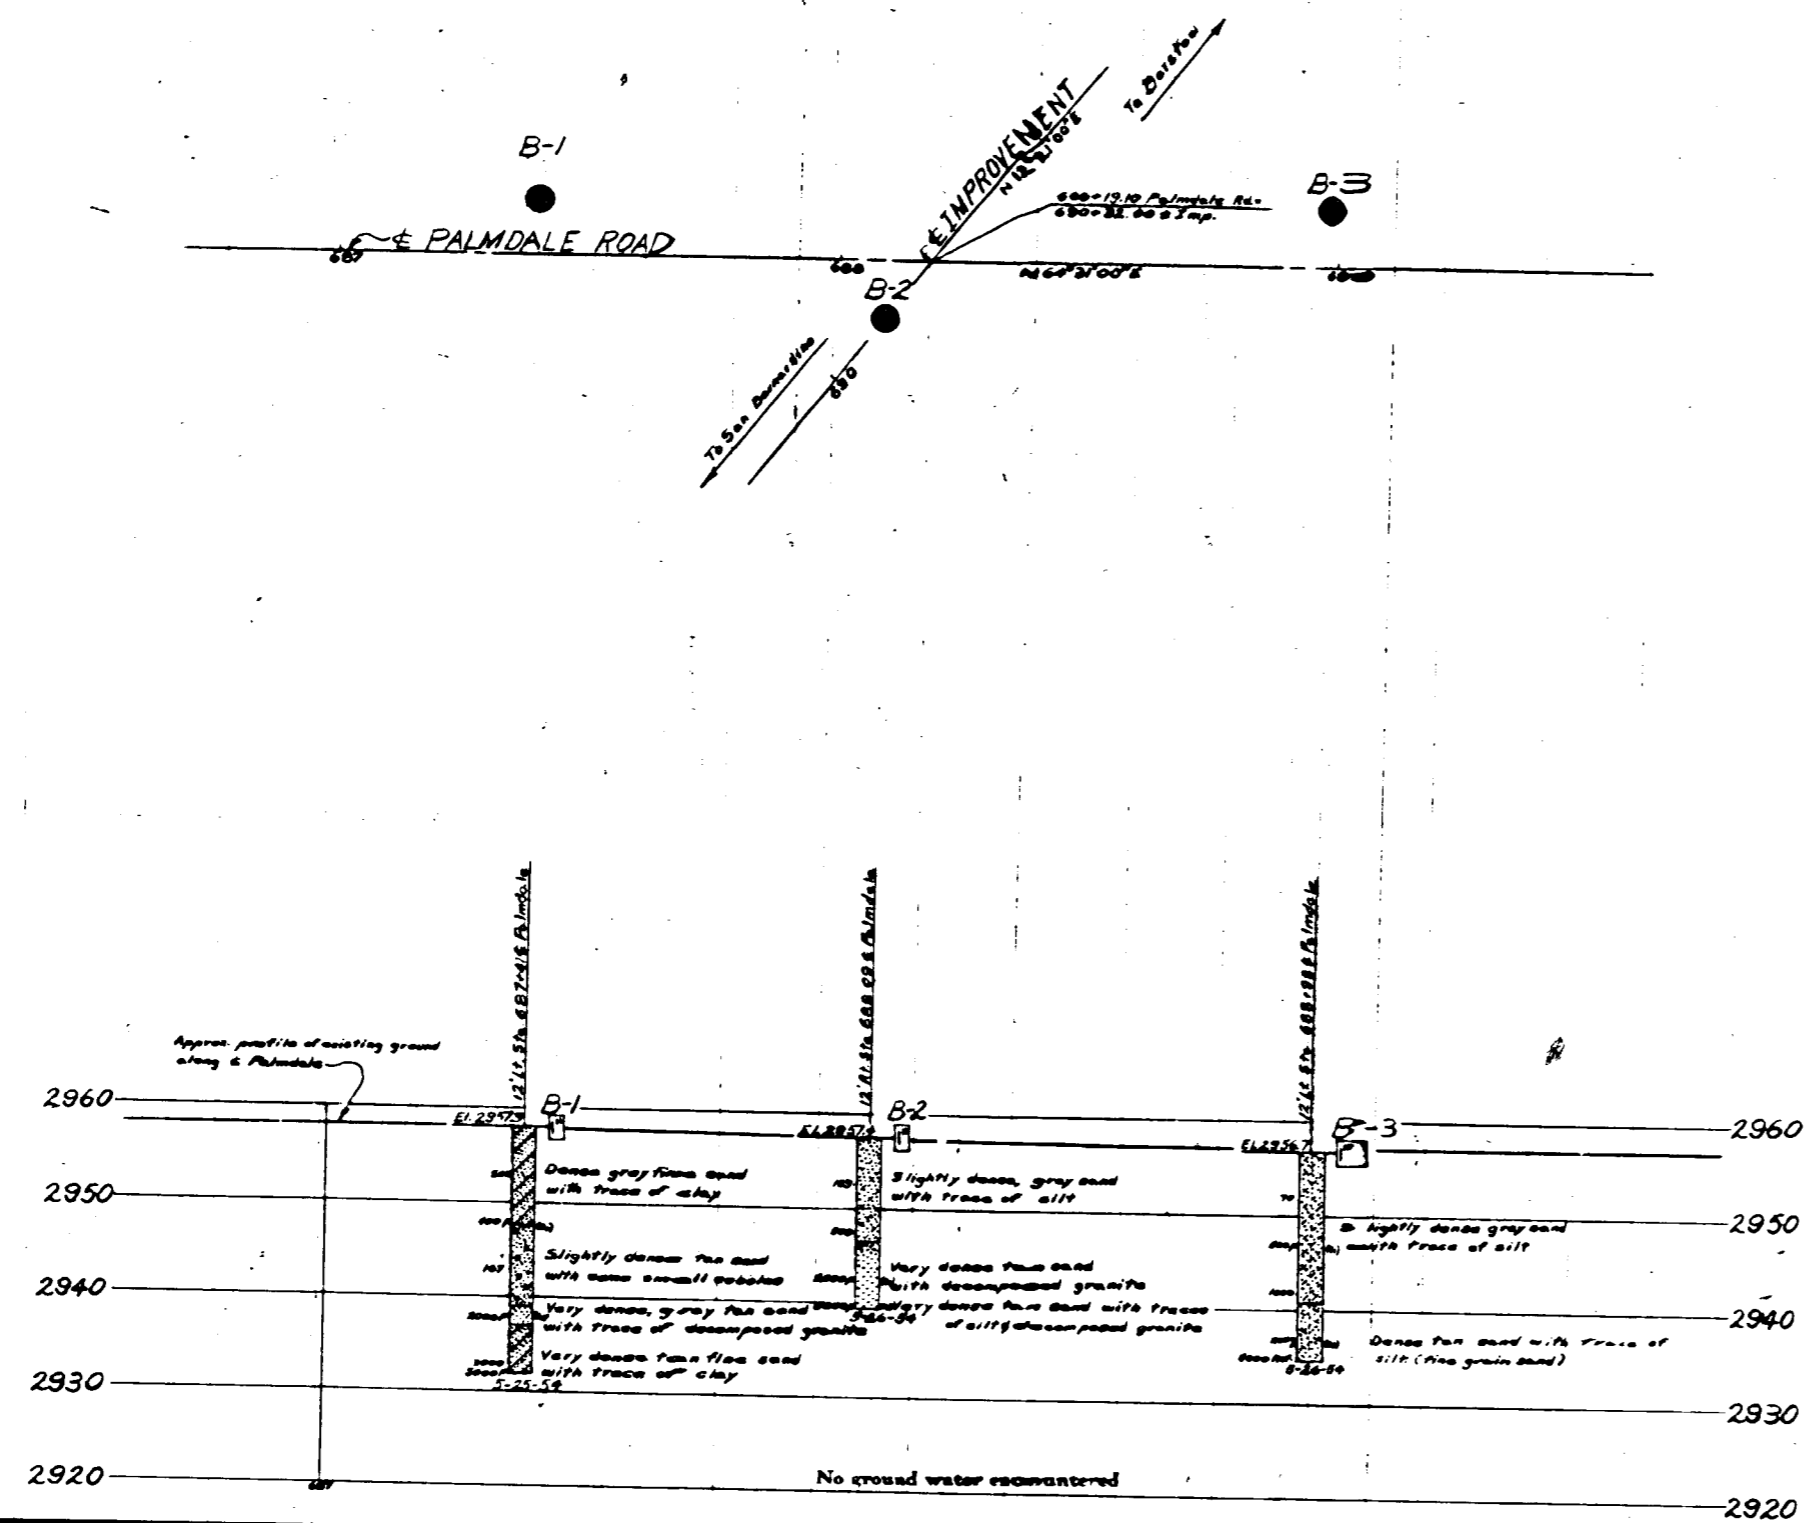


Test Boring By Bridge Dept.

B.M. "C" 70-A-53  
 2x2 Rod Head Sp. Hd. Nail buried 1" 166' 17" "C" 70-A-53  
 El. 2940.00

B.M. "C" 70-B-53  
 2x2 Rod Head Sp. Hd. Nail buried 1" 167' 17" "C" 70-B-53  
 El. 2958.92  
 Related - Hub 125' right of Sta. 67+32 E. of Sta. 176

**AS BUILT**  
 CORRECTIONS BY *J. M. Watson*  
 DATE 12-27-55

FIELD STUDY  
 DRAWN  
 CHECKED  
 Approved by *J. M. Watson*  
 Date 12-27-55

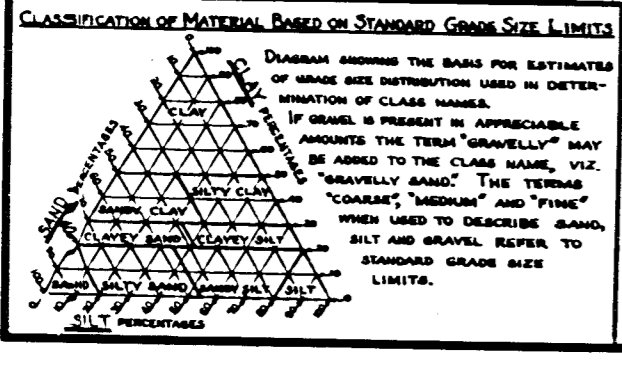

**LEGEND OF EARTH MATERIALS**

GRAVEL	SILTY CLAY OR CLAYEY SILT
SAND	PEAT AND/OR ORGANIC MATTER
SILT	FILL MATERIAL
CLAY	IGNEOUS ROCK
SANDY CLAY OR CLAYEY SAND	SEDIMENTARY ROCK
SANDY SILT OR SILTY SAND	METAMORPHIC ROCK

**LEGEND OF BORING OPERATIONS**

- PLAN OF ANY BORING
- PENETROMETER
- 2 1/2" CONE PENETROMETER
- SAMPLER BORING (DRY)
- ROTARY BORING (WET)
- AUGER BORING (DRY)
- JET BORING
- CORE BORING
- TEST PIT

**NOTES**

The contractor's attention is directed to Section 2, Article (c) of the Standard Specifications and to the Special Provisions accompanying this set of plans. Classification of earth material as shown on this sheet is based upon field inspection and is not to be construed to imply mechanical analysis.

STATE OF CALIFORNIA  
 DEPARTMENT OF PUBLIC WORKS  
 DIVISION OF HIGHWAYS

**PALMDALE ROAD O.C.**

**LOG OF TEST BORINGS**

Scale: Vert. 1"=10', Horiz. 1"=20'

BRIDGE 54-470 FILE E-54 DRAWING C-3406-9


BRIDGE DEPARTMENT



DEPT.	COUNTY	ROUTE	POST MILES - TOTAL PROJECT
08	SBD	18, 15	98.9/98.9 - 101/101

Robert W. Reynolds #165  
 CERTIFIED ENGINEERING GEOLOGIST  
 DATE APPROVED July 8, 1974


PLAN  
 Scale: 1" = 20'

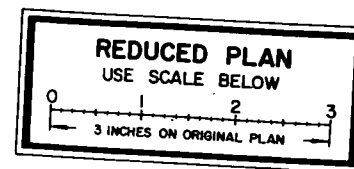

PROFILE  
 Scale: Vert. 1" = 10'  
 Horiz. 1" = 20'

BENCH MARK  
 B.M. #69-A-70 Elev. 2956.73  
 T Bar and cap 90' Lt. 687+50 & Rte. 15.

INFORMED WITH THE RESULTS OF  
 BORING TESTS CONDUCTED BY  
 ENGINEER GEOLOGIST  
 DATE August 1973

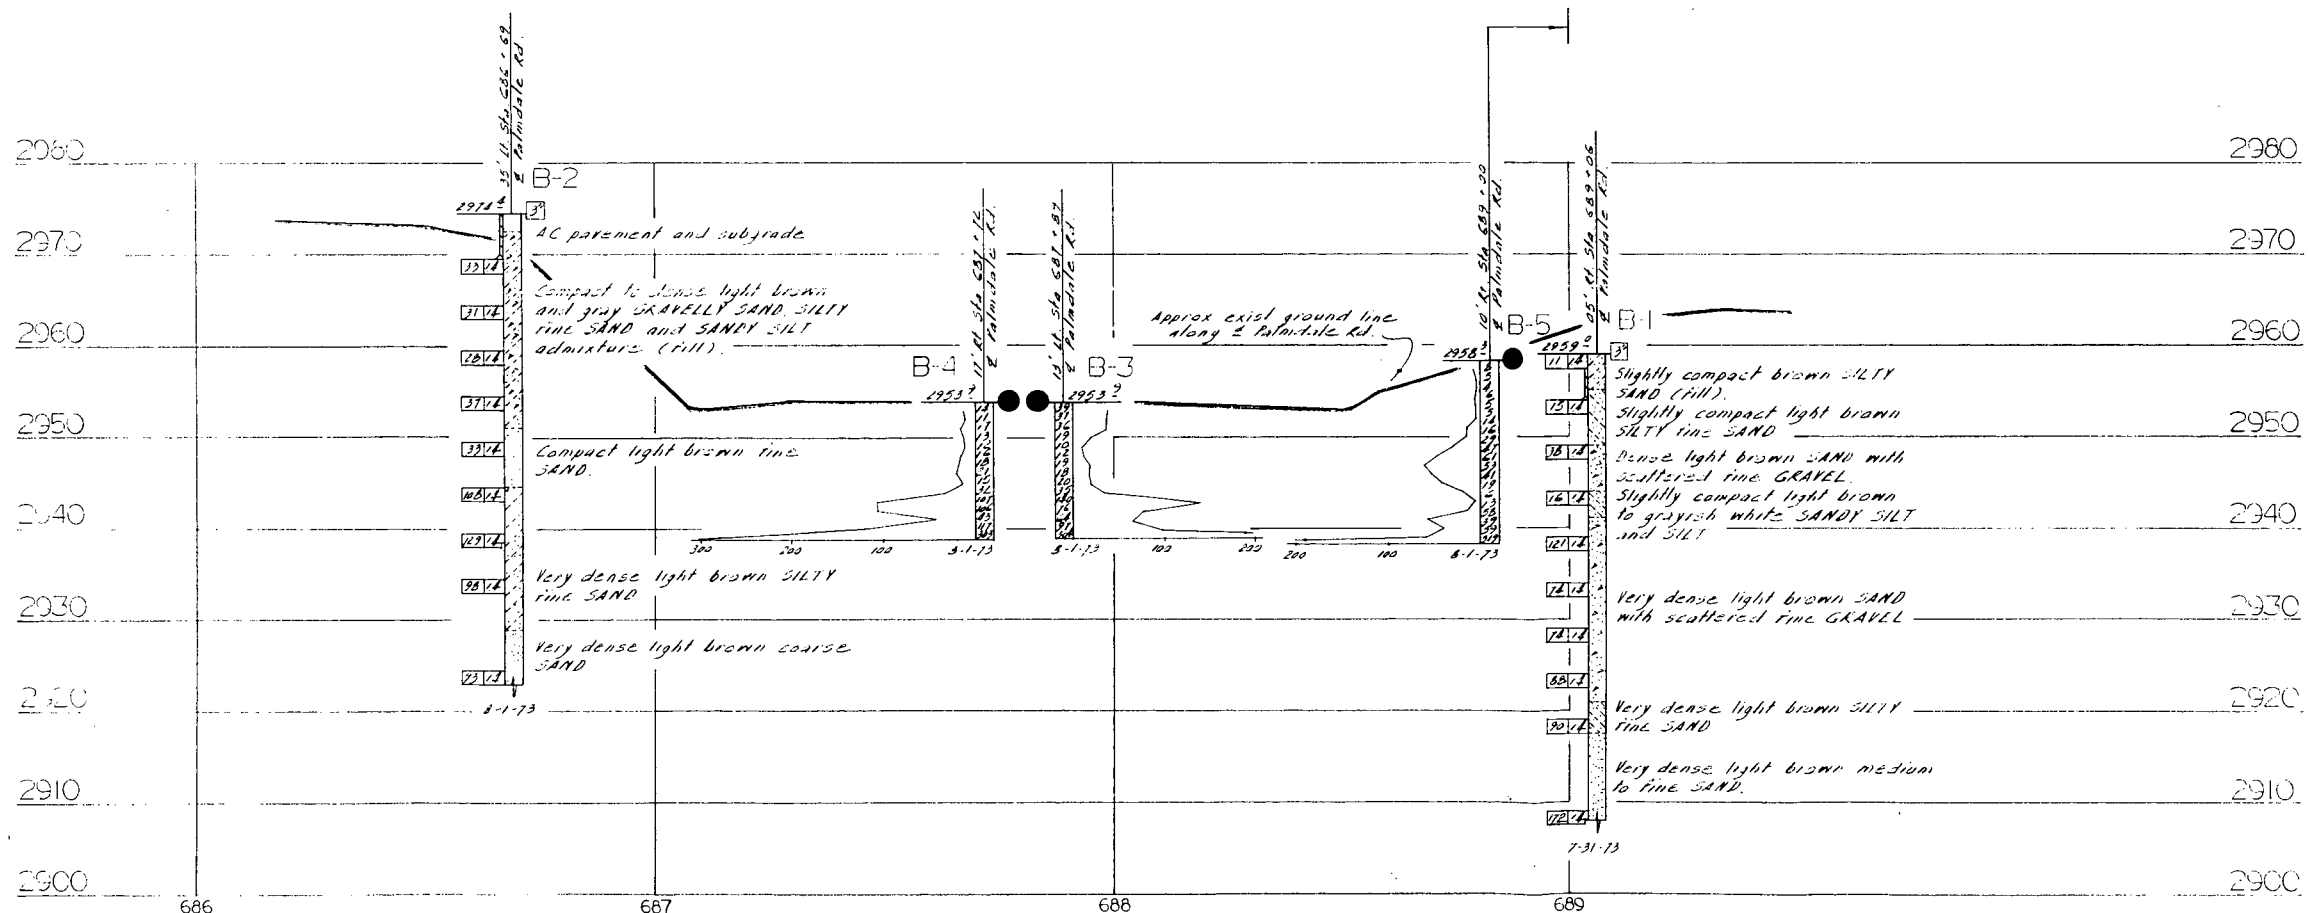

**LEGEND OF BORING OPERATIONS**

**LEGEND OF EARTH MATERIALS**

**LEGEND OF BORING OPERATIONS**

**LEGEND OF EARTH MATERIALS**

**LEGEND OF BORING OPERATIONS**

**LEGEND OF EARTH MATERIALS**

**CONSISTENCY CLASSIFICATION FOR SOILS**

According to the Standard Proctor Test  
 ASTM Designation D 1556-67

Penetration (Blows/Ft)	Cohesive	
	Granular	Very soft
0-5	Very loose	Soft
5-10	Loose	Stiff
10-20	Slightly compact	Very stiff
20-35	Compact	Hard
35-70	Dense	Very dense
> 70		

**UNIFIED SOIL CLASSIFICATION SYSTEM**

CL	CLAY	High Plasticity
ML	CLAY	Medium Plasticity
OL	CLAY	Low Plasticity
CH	CLAY	High Plasticity
MH	CLAY	Medium Plasticity
OH	CLAY	Low Plasticity
GM	CLAY	Medium Plasticity
SM	CLAY	Low Plasticity
GC	CLAY	High Plasticity
MC	CLAY	Medium Plasticity
OC	CLAY	Low Plasticity
GM	CLAY	Medium Plasticity
SM	CLAY	Low Plasticity
GC	CLAY	High Plasticity
MC	CLAY	Medium Plasticity
OC	CLAY	Low Plasticity

**ENGINEERING GEOLOGY SECTION**

FIELD STUDY	By D. Mikes 8-3-73	Approval Recommended By	Charles E. Frank
DRAWN	By J. Law 8-8-73	ENGINEERING GEOLOGIST	
CHECKED	By M. Collins 9-5-73	CERTIFIED ENGINEERING GEOLOGIST NUMBER	40

**State of CALIFORNIA DEPARTMENT OF TRANSPORTATION**

BRIDGE DEPARTMENT DESIGN SECTION **2**

BRIDGE NO. 54-470  
 POST MILE 96.57

PALMDALE ROAD SEPARATION (RTE 18/15)  
 LOG OF TEST BORINGS

ORIGINAL SCALE IN INCHES FOR REDUCED PLANS

CU 08202  
 WO 131811

Disregard prints bearing earlier revision dates

REVISION DATES (PRELIMINARY STAGE ONLY)

SHEET 12 OF 12

# GEOLOGY





Roy Rogers Drive OC



DIST	COUNTY	ROUTE	POST MILES TOTAL PROJECT	SHEET NO.	TOTAL SHEETS
8	SBd	15	40.7 - 41.8	2	5

*Steven P. Alford*  
 GEOTECHNICAL PROFESSIONAL  
 12-7-90  
 PLANS APPROVAL DATE

REGISTERED CIVIL ENGINEER  
 STEVEN P. ALFORD  
 No. 34276  
 Exp. 9/30/91  
 STATE OF CALIFORNIA

**LEIGHTON AND ASSOCIATES, INC.**

**LEGEND OF BORING OPERATIONS**

**2 1/4" CONE PENETRATION BORING**  
 No. count recorded  
 Pressure measured along sleeve friction element (150 cm<sup>2</sup> area) measured on top element (10 cm<sup>2</sup> area)  
 Pressure measured on top element (10 cm<sup>2</sup> area) measured on top element

**ROTARY SAMPLE BORING (WET)**  
 Description of material  
 Unit weight (lb/cu ft)  
 Date measured  
 Penetration index  
 Date measured  
 Shear strength (lb/100 ft<sup>2</sup>)  
 Vane shear (lb/100 ft<sup>2</sup>)  
 Blow count (blows/ft)  
 Date measured  
 Refusal

**ROTARY SAMPLE BORING (DRY)**  
 Description of material  
 Unit weight (lb/cu ft)  
 Date measured  
 Penetration index  
 Date measured  
 Shear strength (lb/100 ft<sup>2</sup>)  
 Vane shear (lb/100 ft<sup>2</sup>)  
 Blow count (blows/ft)  
 Date measured  
 Refusal

**2 1/4" CONE PENETRATION BORING**  
 No. count recorded  
 Pressure measured along sleeve friction element (150 cm<sup>2</sup> area) measured on top element (10 cm<sup>2</sup> area)  
 Pressure measured on top element (10 cm<sup>2</sup> area) measured on top element

**Legend For Test Samples**

- Q - Value
- Consolidation
- Maximum Density
- Gradation
- Atterberg Test
- Direct Shear
- pH
- Resistivity
- Soluble Sulfates
- Sand Equivalent
- Bulk Sample

**LEGEND OF EARTH MATERIALS**

GRAVEL  
 SAND  
 SILT  
 CLAY  
 SANDY CLAY or CLAYEY SAND  
 CLAYEY SILT or SILTY SAND  
 SILTY CLAY


CLAYEY SILT  
 PEAT and/or ORGANIC MATERIAL  
 FILL MATERIAL  
 IGNEOUS ROCK  
 SEDIMENTARY ROCK  
 METAMORPHIC ROCK

**CONSISTENCY CLASSIFICATION FOR SOILS**

According to the Standard Penetration Test

Penetration Index (Blows/Ft)	Consistency
0-4	Very loose
5-9	Loose
10-14	Slightly compact
15-19	Medium dense
20-34	Dense
35-59	Very dense
>70	Very hard

NOTE: Classification of earth material as shown on this sheet is based upon field inspection and is not to be considered to imply mechanical analysis.

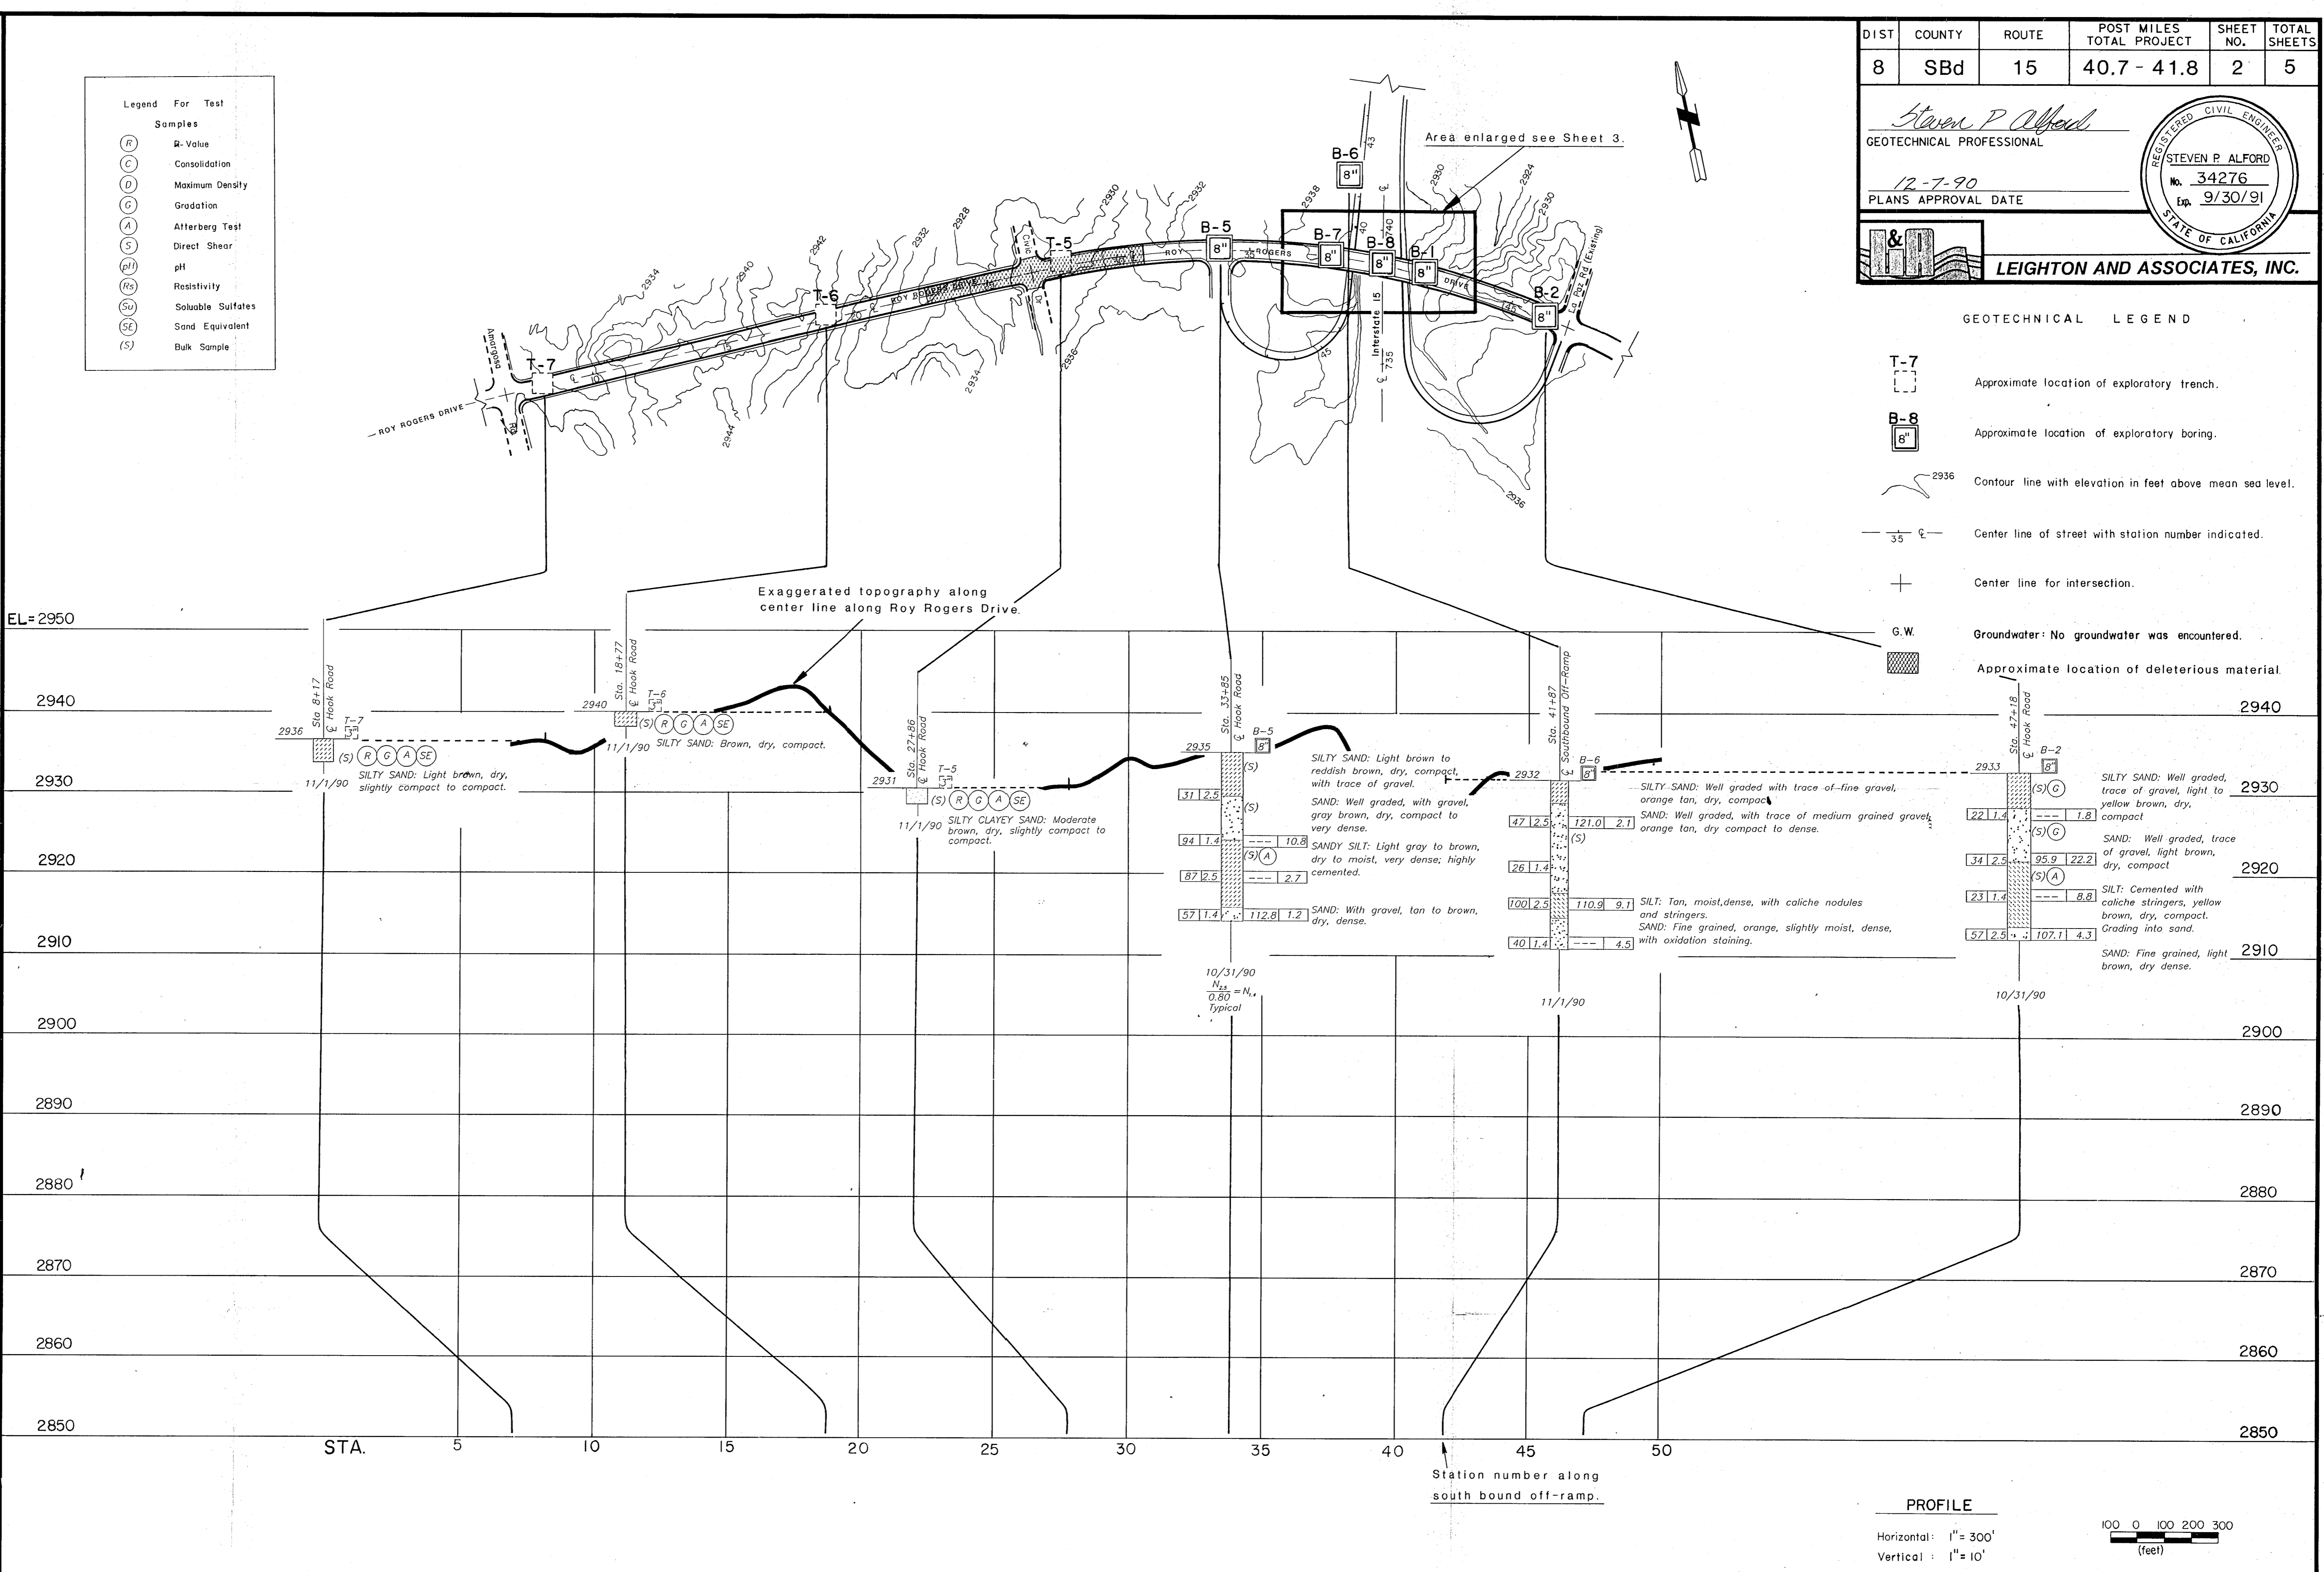

**GEOTECHNICAL LEGEND**

- T-7: Approximate location of exploratory trench.
- B-8: Approximate location of exploratory boring.
- 2936: Contour line with elevation in feet above mean sea level.
- 35: Center line of street with station number indicated.
- +
- G.W.: Groundwater: No groundwater was encountered.
- Approximate location of deleterious material

**PROFILE**

Horizontal: 1" = 300'  
 Vertical: 1" = 10'


100 0 100 200 300 (feet)

DESIGN OVERSIGHT	DRAWN BY: MILES D. KENNEY 12/7/90	GREG UECKER/FRED WINKLER FIELD INVESTIGATOR	LEIGHTON & ASSOCIATES, INC. P.N. 12900307-03	BRIDGE NO.: 54-1118	ROY ROGERS DRIVE OVERCROSSING
SIGN OFF DATE	CHECKED BY: STEVEN P. ALFORD 12/7/90	DATE: 10/31/90 & 11/1/90	PROJECT ENGINEER	POST MILE: 40.52	LOG OF TEST BORINGS
ORIGINAL SCALE IN INCHES FOR REDUCED PLANS			CU 08103 EA 251901	DISREGARD PRINTS BEARING EARLIER REVISION DATES	REVISION DATES (PRELIMINARY STAGE ONLY)
				SHEET 2	OF 5










DIST	COUNTY	ROUTE	POST MILES TOTAL PROJECT	SHEET NO.	TOTAL SHEETS
8	SBd	15	40.7 - 41.8	4	5

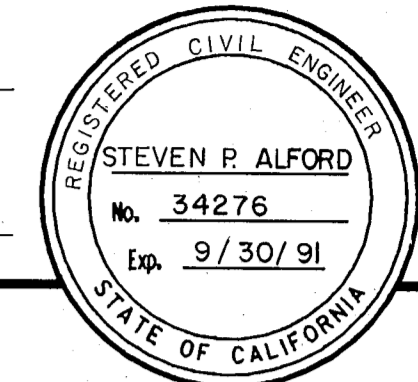*Steven P. Alford*  
 GEOTECHNICAL PROFESSIONAL  
 12-7-90  
 PLANS APPROVAL DATE  
  
**LEIGHTON AND ASSOCIATES, INC.**



- GEOTECHNICAL LEGEND**
- T-4 Approximate location of exploratory trench.
  - B-5 Approximate location of exploratory boring.
  - 2936 Contour line with elevation in feet above mean sea level.
  - 750 Center line of street with station number indicated.
  - 35 Station number along south-bound Interstate 15 entrance from Hook Rd.
  - G.W. Groundwater: No groundwater was encountered.
  - Approximate location of deleterious material.

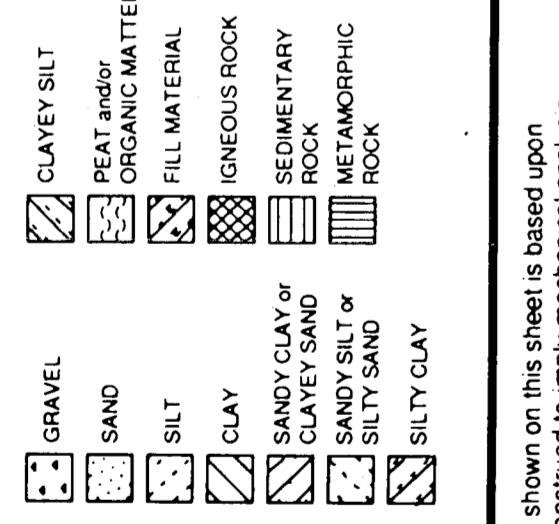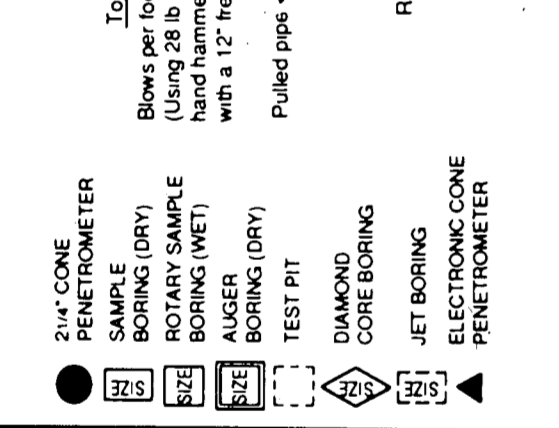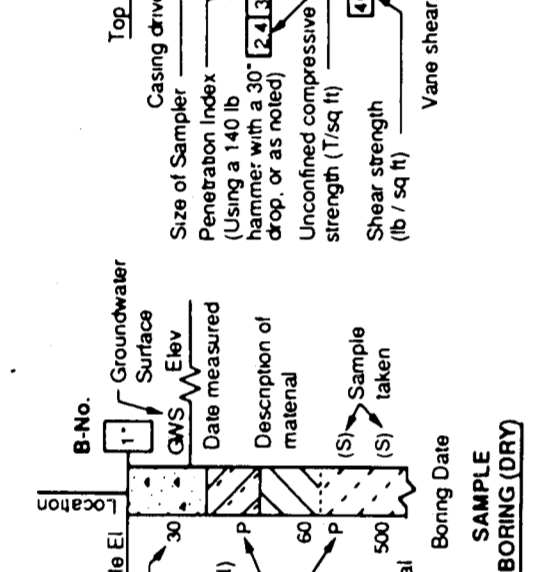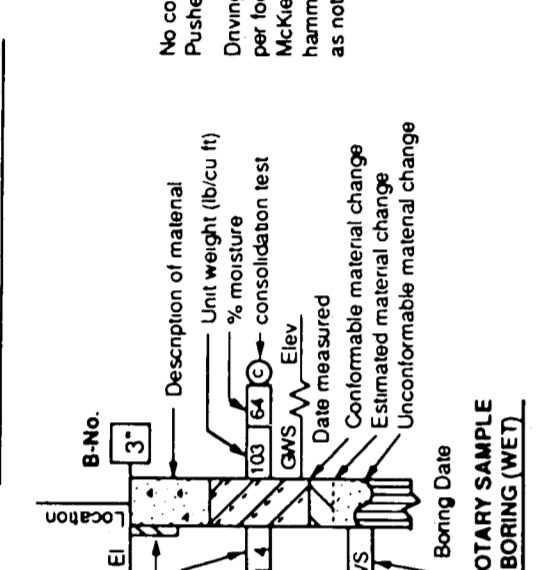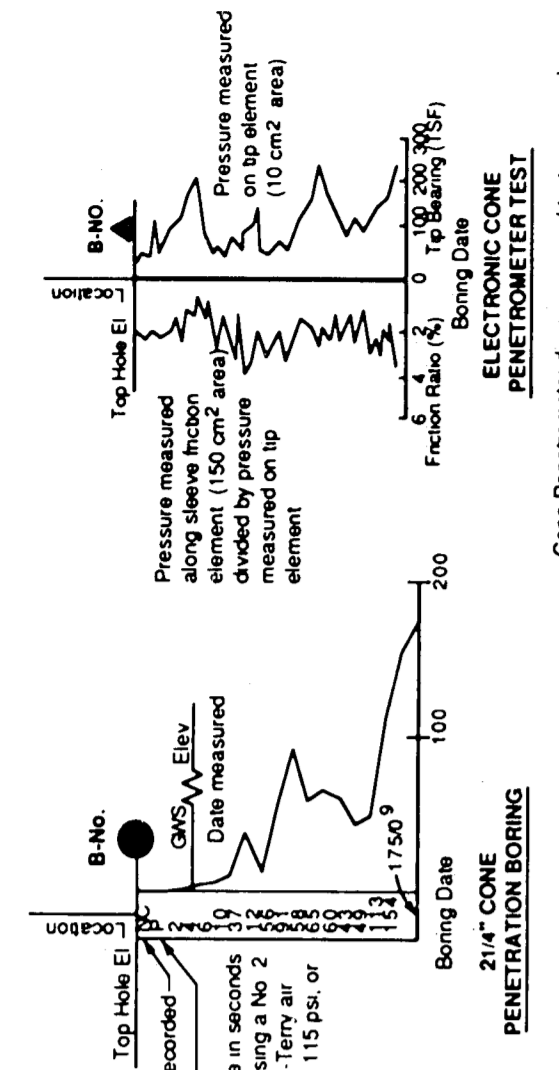

**CONSISTENCY CLASSIFICATION FOR SOILS**

Penetration Index (Blows/Ft)	Soil Description
0-4	Very loose
5-9	Loose
10-19	Slightly compact
20-29	Compact
30-39	Very compact
>40	Very hard

NOTE: Classification of earth material as shown on this sheet is based upon field inspection and is not to be construed to imply mechanical analysis.

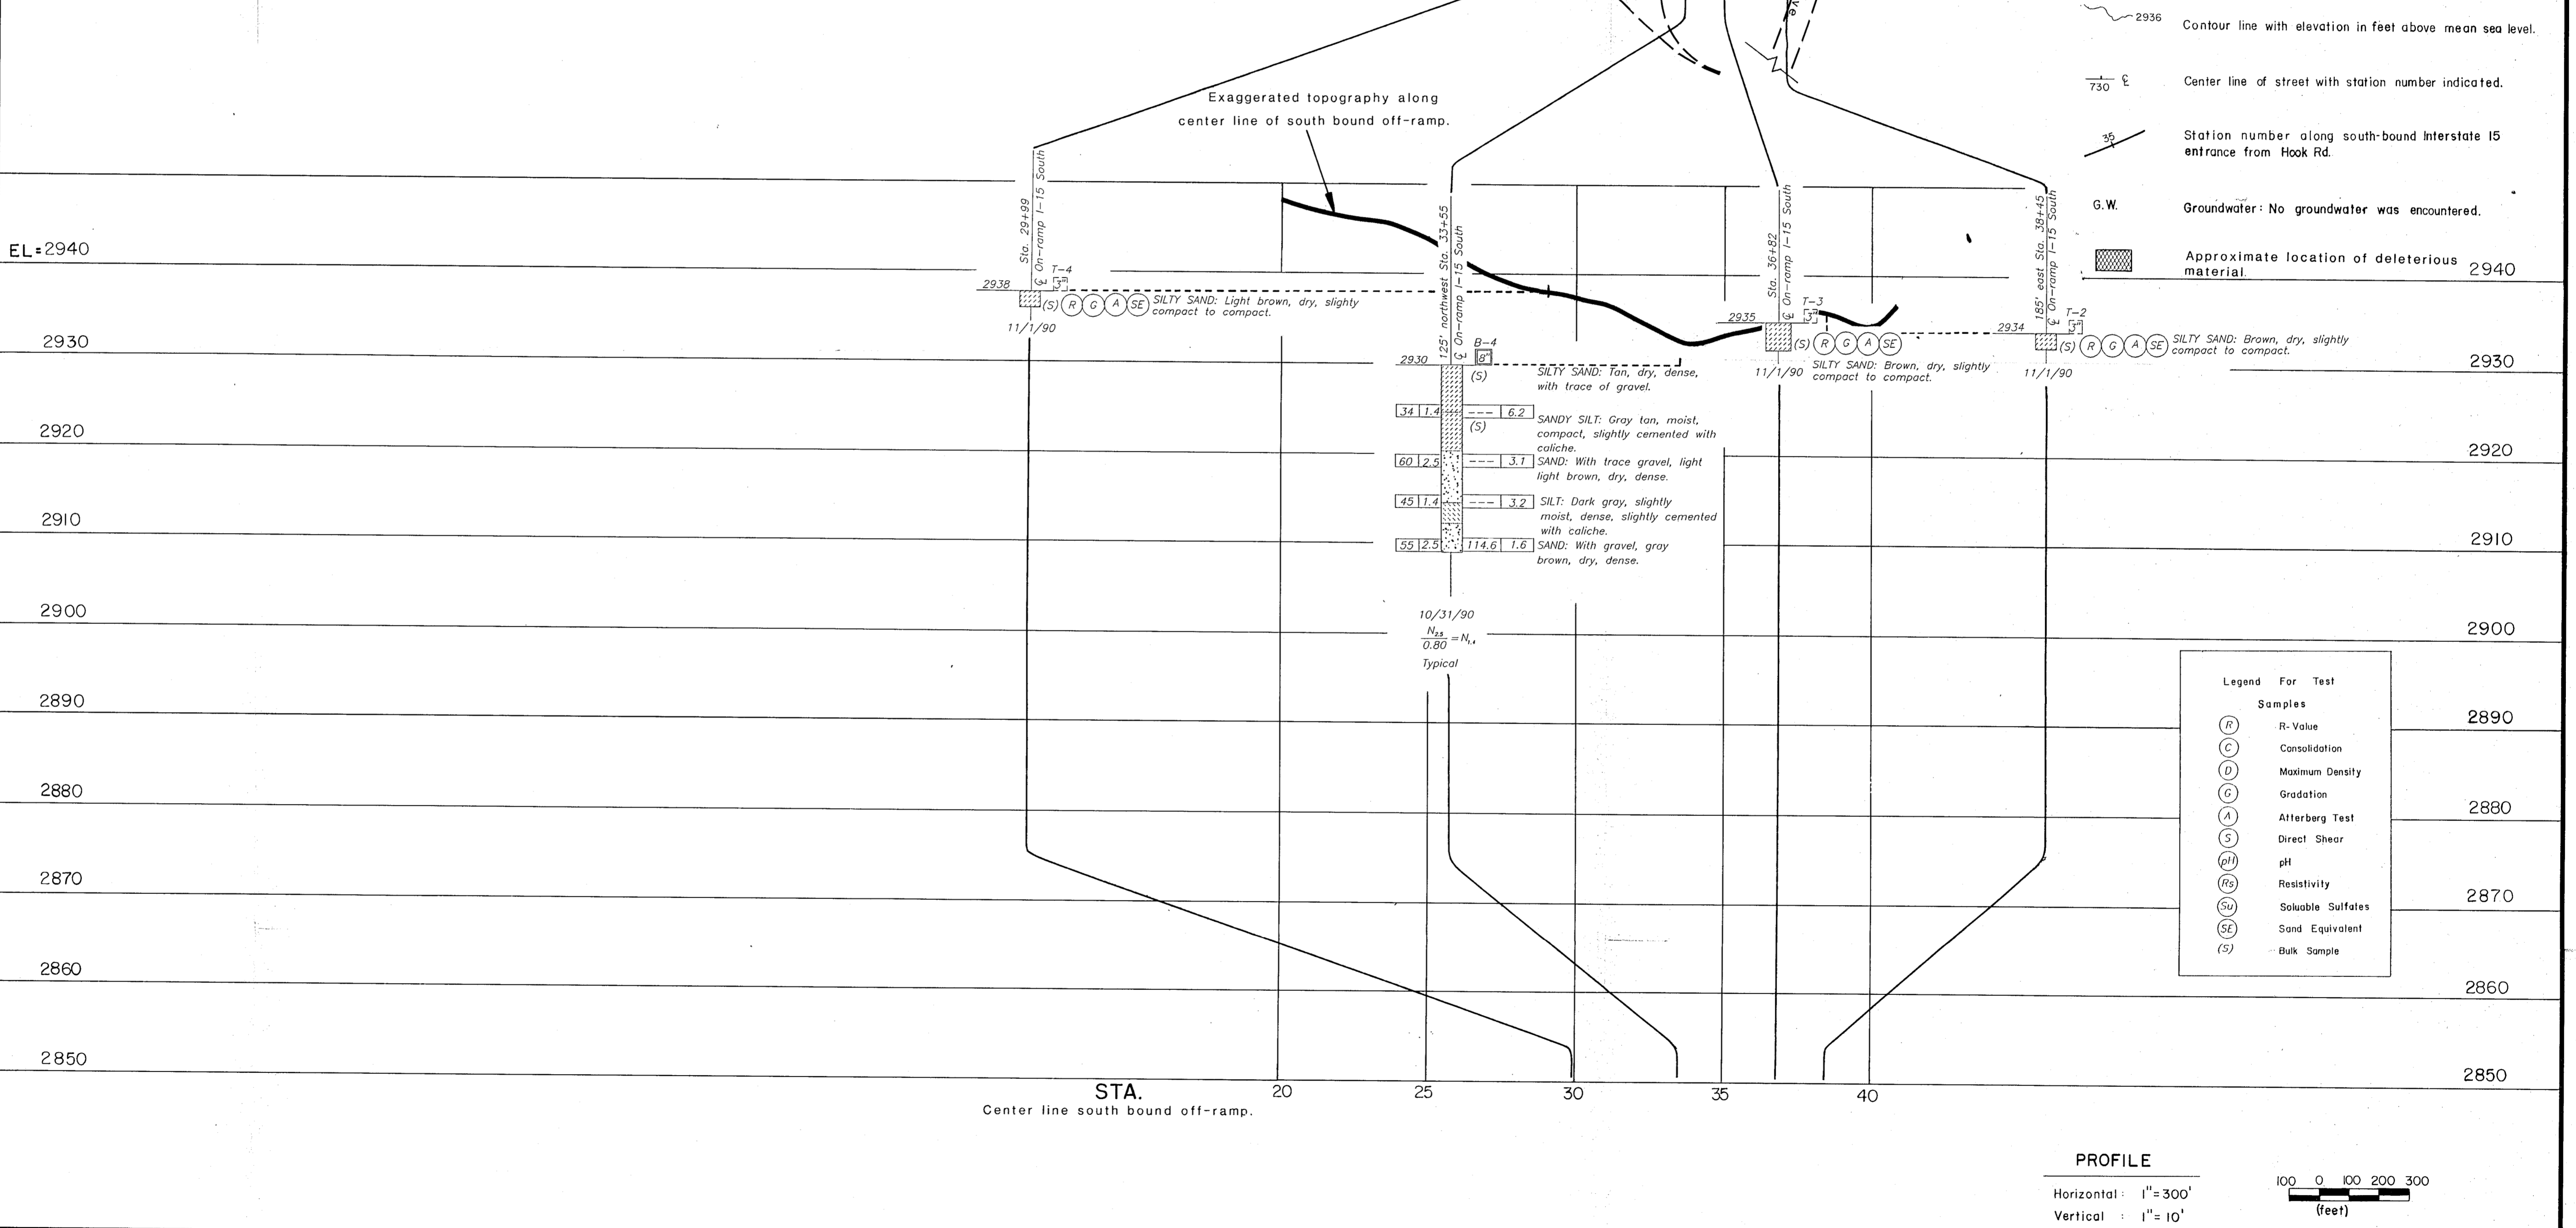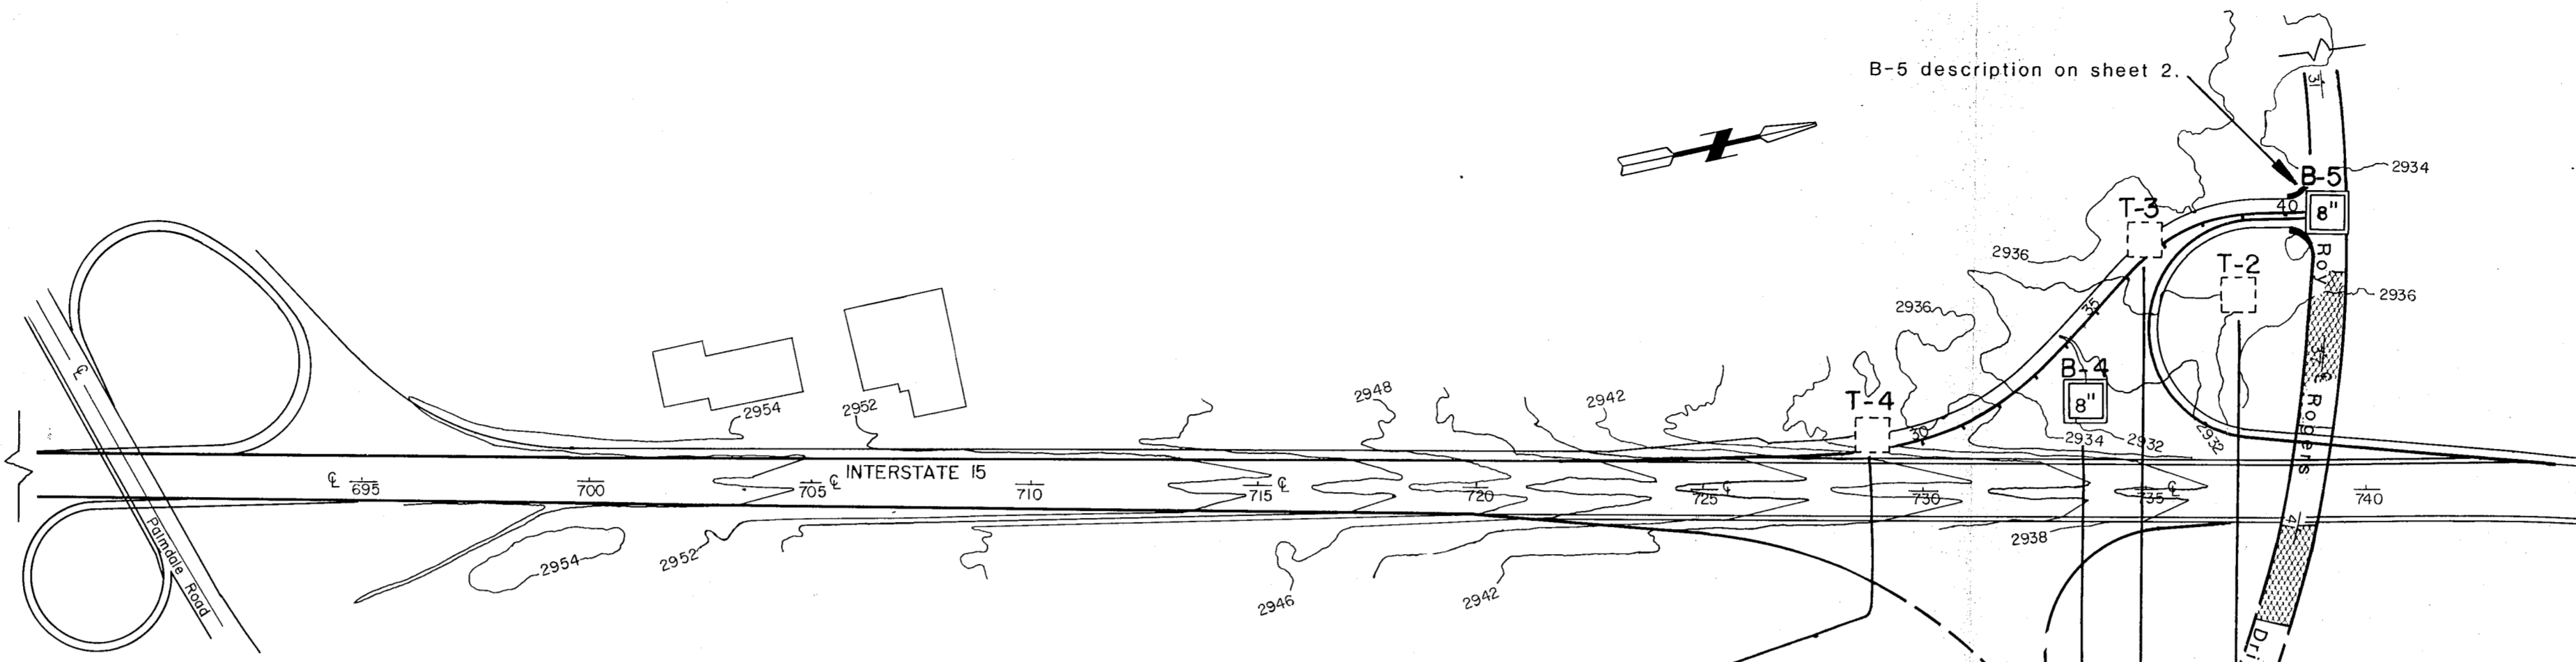

**Legend For Test Samples**

- (R) R-Value
- (C) Consolidation
- (D) Maximum Density
- (G) Gradation
- (A) Atterberg Test
- (S) Direct Shear
- (pH) pH
- (R<sub>s</sub>) Resistivity
- (Su) Soluble Sulfates
- (SE) Sand Equivalent
- (S) Bulk Sample


**PROFILE**  
 Horizontal: 1" = 300'  
 Vertical: 1" = 10'

DESIGN OVERSIGHT	DRAWN BY MILES D. KENNEY 12/7/90	FIELD INVESTIGATOR GREG UECKER/FRED WINKLER	LEIGHTON & ASSOCIATES, INC.	BRIDGE NO. 54-1118	ROY ROGERS DRIVE OVERCROSSING	
SIGN OFF DATE	CHECKED BY STEVEN P. ALFORD 12/7/90	DATE 10/31/90 & 11/1/90	P.N. 12900307-03	POST MILE 40.52		
PREPARED FOR THE <b>STATE OF CALIFORNIA</b> DEPARTMENT OF TRANSPORTATION				LOG OF TEST BORINGS		
ORIGINAL SCALE IN INCHES FOR REDUCED PLANS				CU 08103 EA 251901	DISREGARD PRINTS BEARING EARLIER REVISION DATES	
				REVISION DATES (PRELIMINARY STAGE ONLY)		
				SHEET 4 OF 5		



DIST	COUNTY	ROUTE	POST MILES TOTAL PROJECT	SHEET NO.	TOTAL SHEETS
8	SBd	15	40.7 - 41.8	5	5

Steve P. Alford  
 GEOTECHNICAL PROFESSIONAL  
 12-7-90  
 PLANS APPROVAL DATE

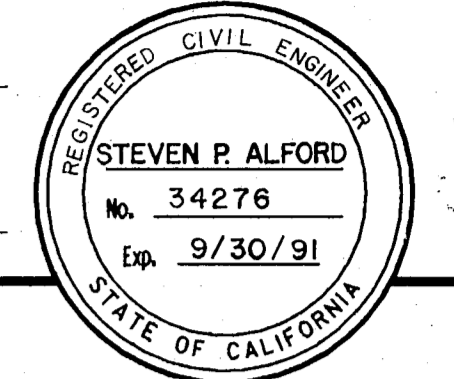

**LEIGHTON AND ASSOCIATES, INC.**

GEOTECHNICAL LEGEND

- T-9 [Symbol] Approximate location of exploratory trench.
- B-3 [Symbol] Approximate location of exploratory boring.
- 2930 [Symbol] Contour line with elevation in feet above mean sea level.
- 730 [Symbol] Center line of street with station number indicated.
- 30 [Symbol] Station number along north bound Interstate 15 exit for Hook Rd.
- G.W. [Symbol] Groundwater: No groundwater was encountered.
- [Symbol] Approximate location of deleterious material.

**LEGEND OF BORING OPERATIONS**

**2 1/4" CONE PENETRATION BORING**

**ROTARY SAMPLE BORING (WET)**

**SAMPLE BORING (DRY)**


**LEGEND OF EARTH MATERIALS**

**CONSISTENCY CLASSIFICATION FOR SOILS**

According to the Standard Penetration Test


Penetration (Blows / Ft)	Cohesive
0-5	Very soft
5-10	Soft
10-19	Slightly compact
20-34	Compact
35-59	Dense
>70	Very dense

NOTE: Classification of earth material as shown on this sheet is based upon field inspection and is not to be construed to imply mechanical analysis.

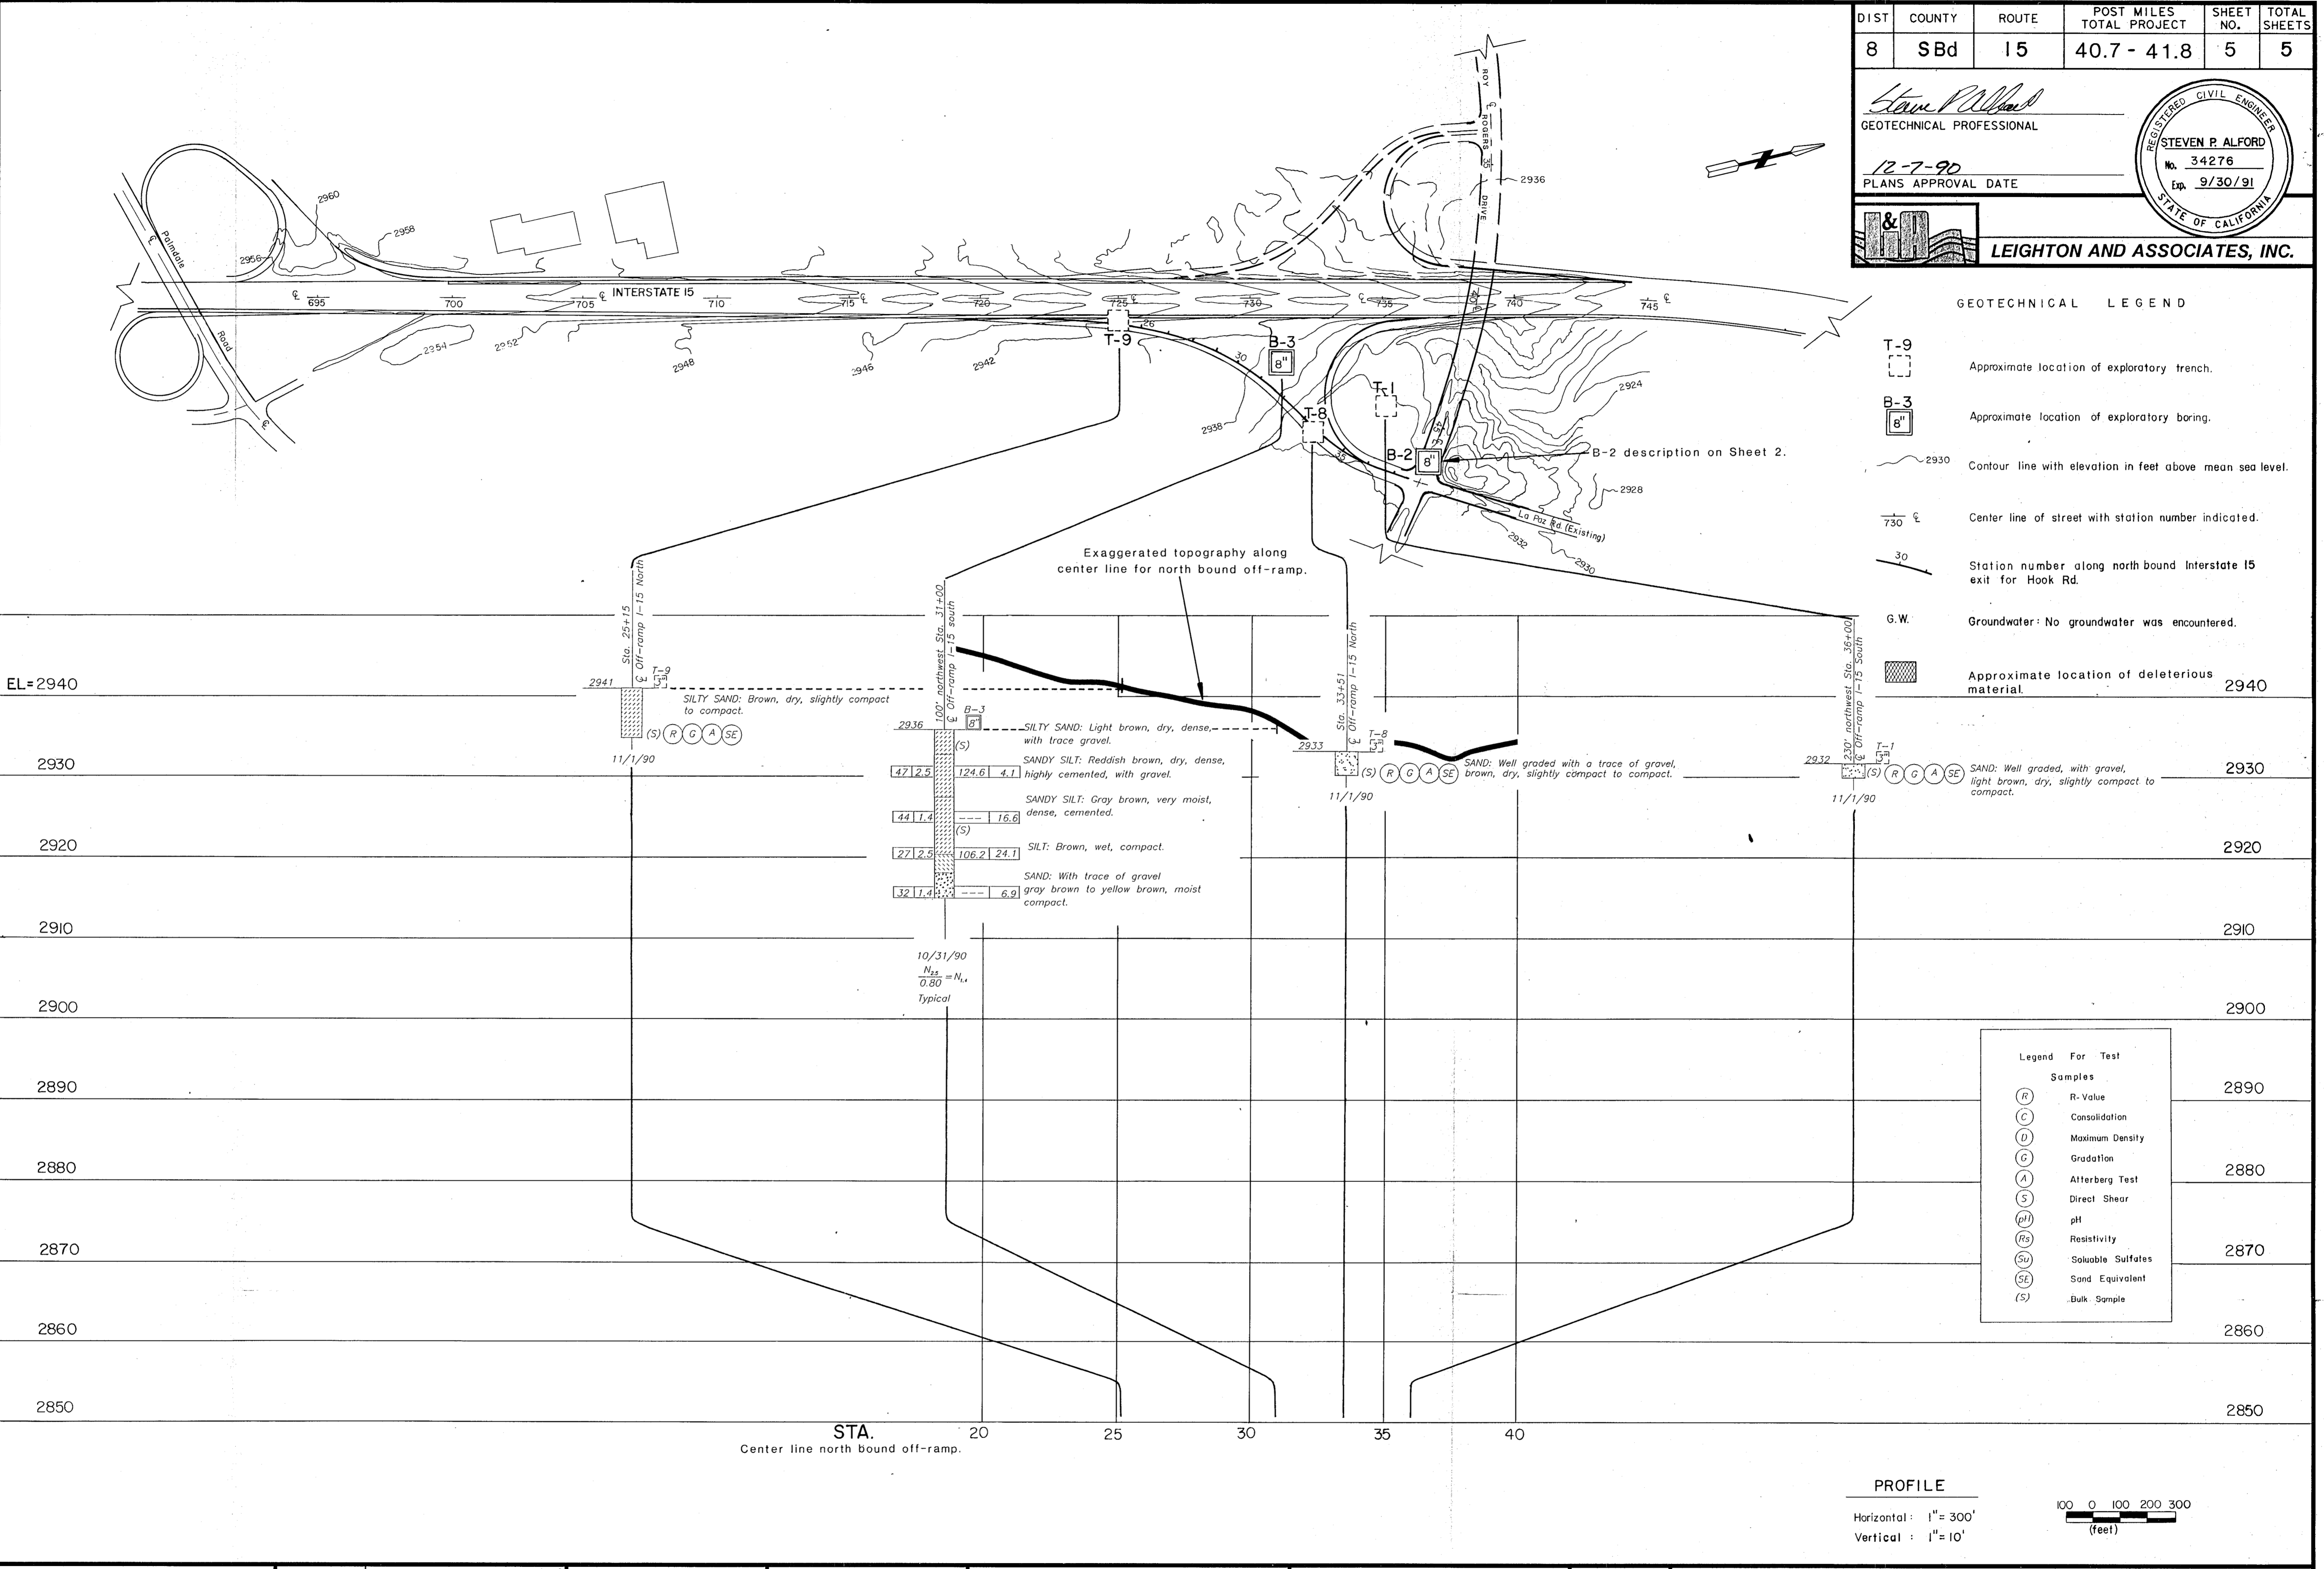

Legend For Test Samples

(R)	R-Value
(C)	Consolidation
(D)	Maximum Density
(G)	Gradation
(A)	Atterberg Test
(S)	Direct Shear
(pH)	pH
(RS)	Resistivity
(Su)	Soluble Sulfates
(SE)	Sand Equivalent
(S)	Bulk Sample

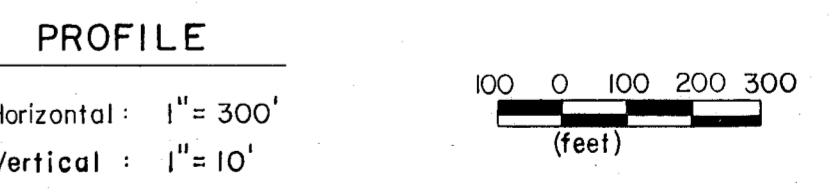


DESIGN OVERSIGHT	DRAWN BY MILES D. KENNEY 12/7/90	FIELD INVESTIGATOR GREG UECKER/FRED WINKLER	LEIGHTON & ASSOCIATES, INC.	BRIDGE NO. 54-1118	ROY ROGERS DRIVE OVERCROSSING <b>LOG OF TEST BORINGS</b>
SIGN OFF DATE	CHECKED BY STEVEN P. ALFORD 12/7/90	DATE 10/31/90 & 11/1/90	P.N. 12900307-03	POST MILE 40.52	
ORIGINAL SCALE IN INCHES FOR REDUCED PLANS				CU 08103 EA 251901	DISREGARD PRINTS BEARING EARLIER REVISION DATES
REVISION DATES (PRELIMINARY STAGE ONLY)					SHEET 5 OF 5





DIST	COUNTY	ROUTE	POST MILES TOTAL PROJECT	SHEET NO.	TOTAL SHEETS
8	SBd	15	40.7 - 41.8	1	6

Stephen M. Poole  
 GEO/TECHNICAL PROFESSIONAL  
 5/6/92  
 PLANS APPROVAL DATE

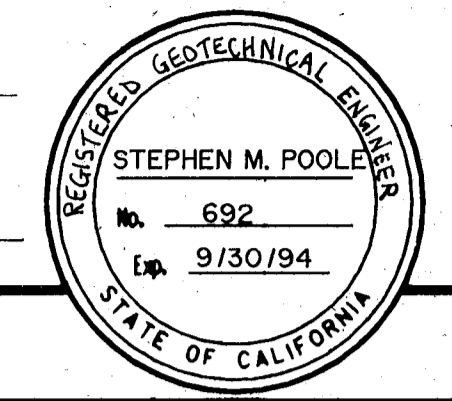

**LEIGHTON AND ASSOCIATES, INC.**

**LEGEND OF BORING OPERATIONS**

**2 1/4" CONE PENETRATION BORING**  
 No record recorded. Pumping. Driving rate in seconds per foot (Using a No. 2 Mcrometer 1/16" or as noted).  
 Top Hole El. Boring Date

**ROTARY SAMPLE BORING (WET)**  
 Description of material. Unit weight (lb/cu ft). Consolidation test. Date measured. Estimated material change. Unrecoverable material change.  
 Top Hole El. Casing driven. Boring Date

**ROTARY SAMPLE BORING (DRY)**  
 Description of material. Date measured. Sample length. Retriever.  
 Top Hole El. Boring Date

**CONE BORING**  
 Top Hole El. Boring Date

**TEST PIT**  
 Top Hole El. Boring Date

**DIAMOND CONE BORING**  
 Top Hole El. Boring Date

**TEST PIT**  
 Top Hole El. Boring Date

**CONE BORING**  
 Top Hole El. Boring Date

**TEST PIT**  
 Top Hole El. Boring Date

**LEGEND OF EARTH MATERIALS**


GRAVEL  
 SAND  
 SILT  
 CLAY  
 SANDY CLAY or SANDY SILT  
 SILTY SAND  
 SILTY CLAY

CLAYEY SILT  
 PEAT and/or ORGANIC MATTER  
 FILL MATERIAL  
 IGNEOUS ROCK  
 SEDIMENTARY ROCK  
 METAMORPHIC ROCK  
 AGGREGATE BASE

**CONSISTENCY CLASSIFICATION FOR SOILS**

According to the Standard Penetration Test

Penetration (Blows/Ft)	Cohesive	
	Granular	Cohesive
0-4	Very loose	Very soft
5-9	Loose	Soft
10-19	Slightly compact	Stiff
20-34	Compact	Very stiff
35-59	Dense	Hard
>70	Very dense	Very hard

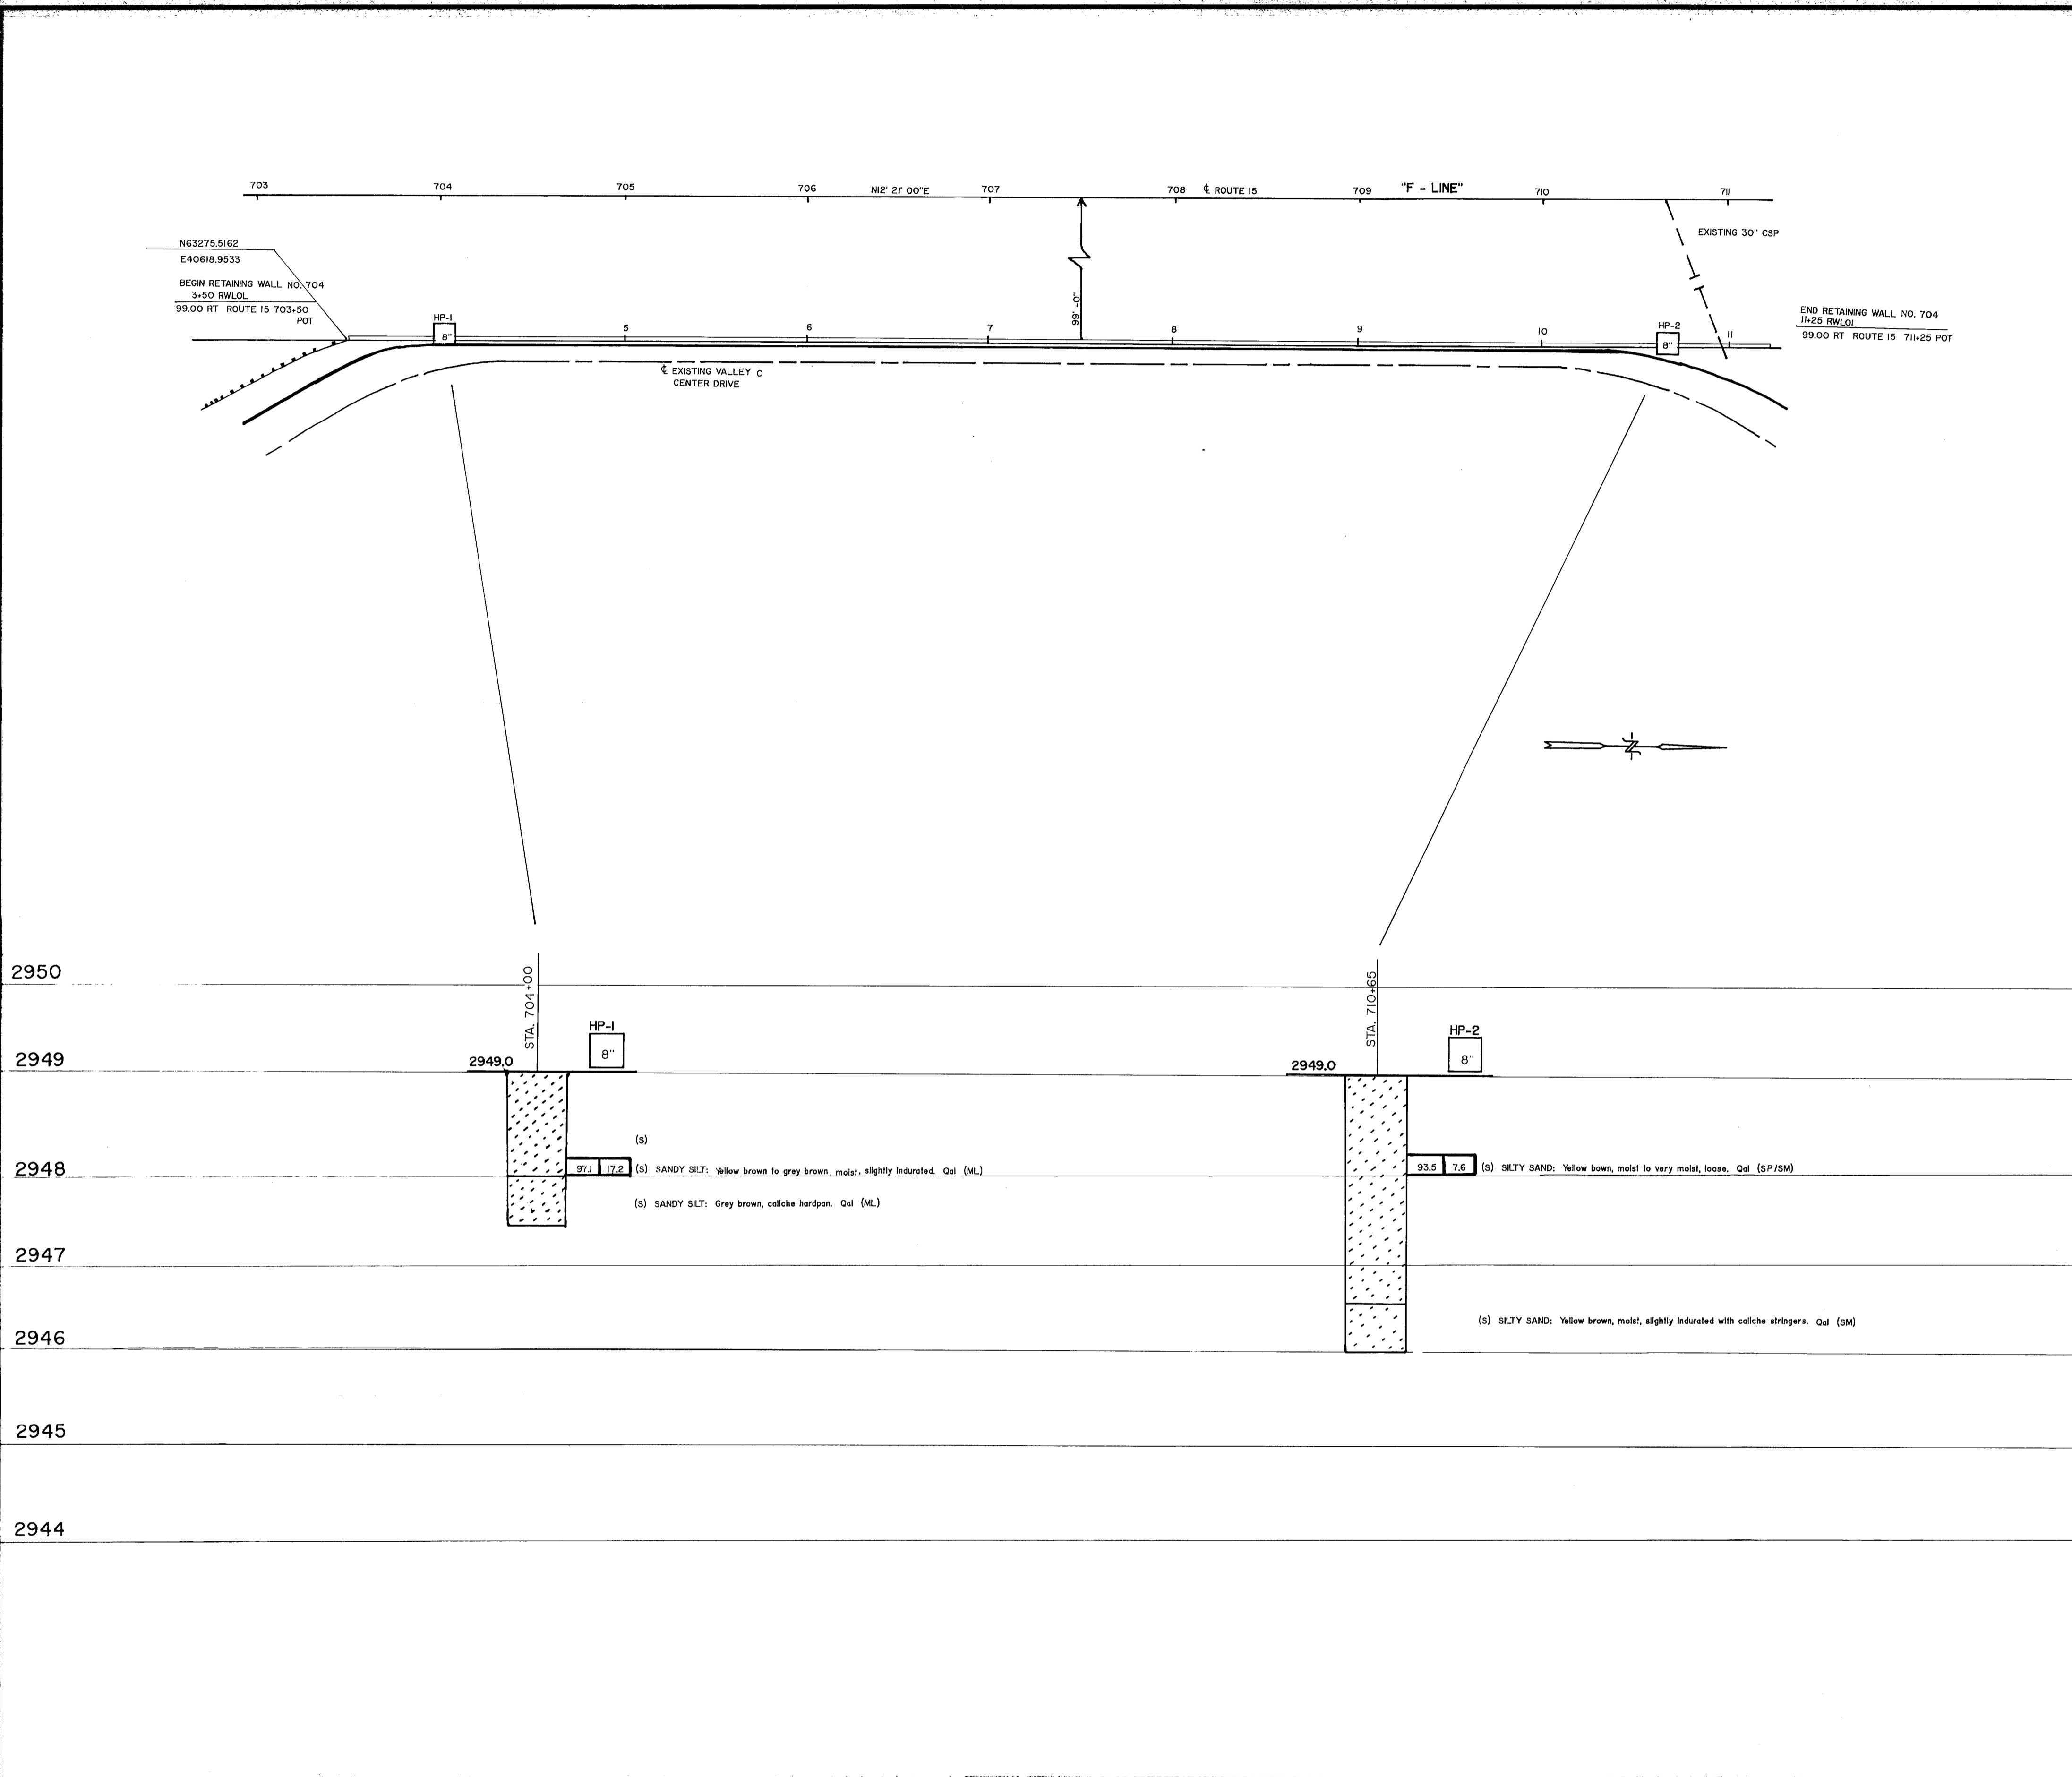



DESIGN OVERSIGHT	DRAWN BY WENDY WEESIES 02/13/92	GREG UECKER/FRED WINKLER FIELD INVESTIGATOR	LEIGHTON & ASSOCIATES, INC. 12900307-04	PREPARED FOR THE <b>STATE OF CALIFORNIA</b> DEPARTMENT OF TRANSPORTATION	PROJECT ENGINEER	BRIDGE NO. 54-1118	RETAINING WALL NO.704
SIGN OFF DATE	CHECKED BY SMP 02/14/92	DATE 11/15/91				POST MILE	<b>LOG OF TEST BORINGS</b>

ORIGINAL SCALE IN INCHES FOR REDUCED PLANS 0 2 3

CU EA 251904	DISREGARD PRINTS BEARING EARLIER REVISION DATES	REVISION DATES (PRELIMINARY STAGE ONLY)	SHEET OF
-----------------	---	---	----------






DIST	COUNTY	ROUTE	POST MILES TOTAL PROJECT	SHEET NO.	TOTAL SHEETS
8	SBd	15	40.7 - 41.8	6	6

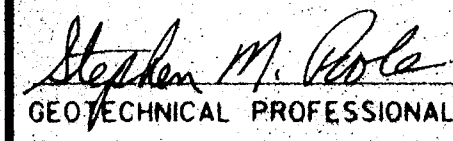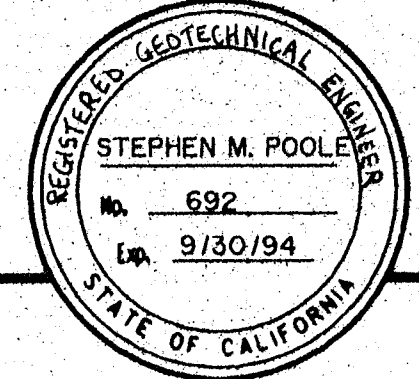  
 GEO. TECH. PROFESSIONAL  
 5/5/92  
 PLANS APPROVAL DATE  


**LEIGHTON AND ASSOCIATES, INC.**

**GEOTECHNICAL LEGEND**

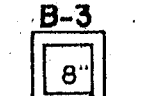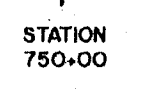-  Approximate location of exploratory boring
-  Center line of street with station number indicated
-  Denotes 2.5" California Sampler Equivalent SPT blow counts could be estimated by multiplying by 0.445

**PROFILE**

Horizontal  $\Gamma = 10'$   
 Vertical  $\Gamma = 5'$

**DATUM:**  
SEA LEVEL DATUM OF 1929%  
SUPPLEMENTAL ADJUSTMENT OF 1980

BENCHMARK	ELEVATION	DESCRIPTION
72-A-89	2951.23	Std "CAL DOT" brass disk in 2" IP stamped "BM.72-A-89" down 0.2 in AC shldr. 65.3' rt C/L Imp 714+00 NAD 1929 adj 1980
75-A-89	2934.51	Chis "+" on NW bolt PCC sign structure "Mojave Dr. Next Right" 87.5' rt C/L Imp 740+00. Bolt stamped "BM.75-A-89" NAD 1929 adj 1980

**HORIZONTAL CONTROL:**  
Standard Disk Stamped  
C/L Imp C1-53 714+20.72 POT  
N= 64342.62 E= 40751.27

**Standard Disk Stamped**  
C/L Imp C1-59 741+51.19 30'  
N= 61966.12 E= 40230.92

**LEGEND OF BORING OPERATIONS**

**2 1/4" CONE PENETRATION BORING**  
 No. of blows recorded  
 Date measured  
 Pressure measured along sleeve friction element (150 psi) and pressure measured on tip element (10,000 psi)  
 Friction Ratio (%)  
 Cone Penetration Test  
 Core Penetration dimensions and testing procedures are in accordance with ASTM standard D 3441-79 or its rework

**ROTARY BORING (WET)**  
 Description of material  
 Unit weight (pcf)  
 Consolidation test  
 Date measured  
 Consolidation material change  
 Uncolformable material change  
 Boring Date  
 Boring No.

**SAMPLE BORING (DRY)**  
 Blow per foot (Using 28 lb hammer with a 1.7" new fall)  
 Date measured  
 Description of material  
 Sample No.  
 Boring Date  
 Boring No.

**TEST PIT**  
 Shear strength  
 vane shear  
 Boring Date  
 Boring No.

**TEST PIT**  
 Blow per foot (Using 28 lb hammer with a 1.7" new fall)  
 Date measured  
 Description of material  
 Sample No.  
 Boring Date  
 Boring No.

**LEGEND OF EARTH MATERIALS**

GRAVEL  
 SAND  
 SILT  
 CLAY  
 SANDY CLAY or CLAYEY SAND  
 SILTY SAND  
 SILTY CLAY


CLAYEY SILT  
 PEAT (moist)  
 ORGANIC MATERIAL  
 FILL MATERIAL  
 IGNEOUS ROCK  
 SEDIMENTARY ROCK  
 METAMORPHIC ROCK  
 AGGREGATE BASE

**CONSISTENCY CLASSIFICATION FOR SOILS**

According to the Standard Penetration Test

Penetration (Blows/Ft)	Cohesive	
	Very soft	Soft
0-4	Very loose	Loose
5-19	Slightly compact	Medium dense
20-34	Compact	Dense
35-69	Very hard	Very dense
>70		

NOTE: Classification of earth material as shown on this sheet is based upon field inspection and is not to be construed to imply mechanical analysis

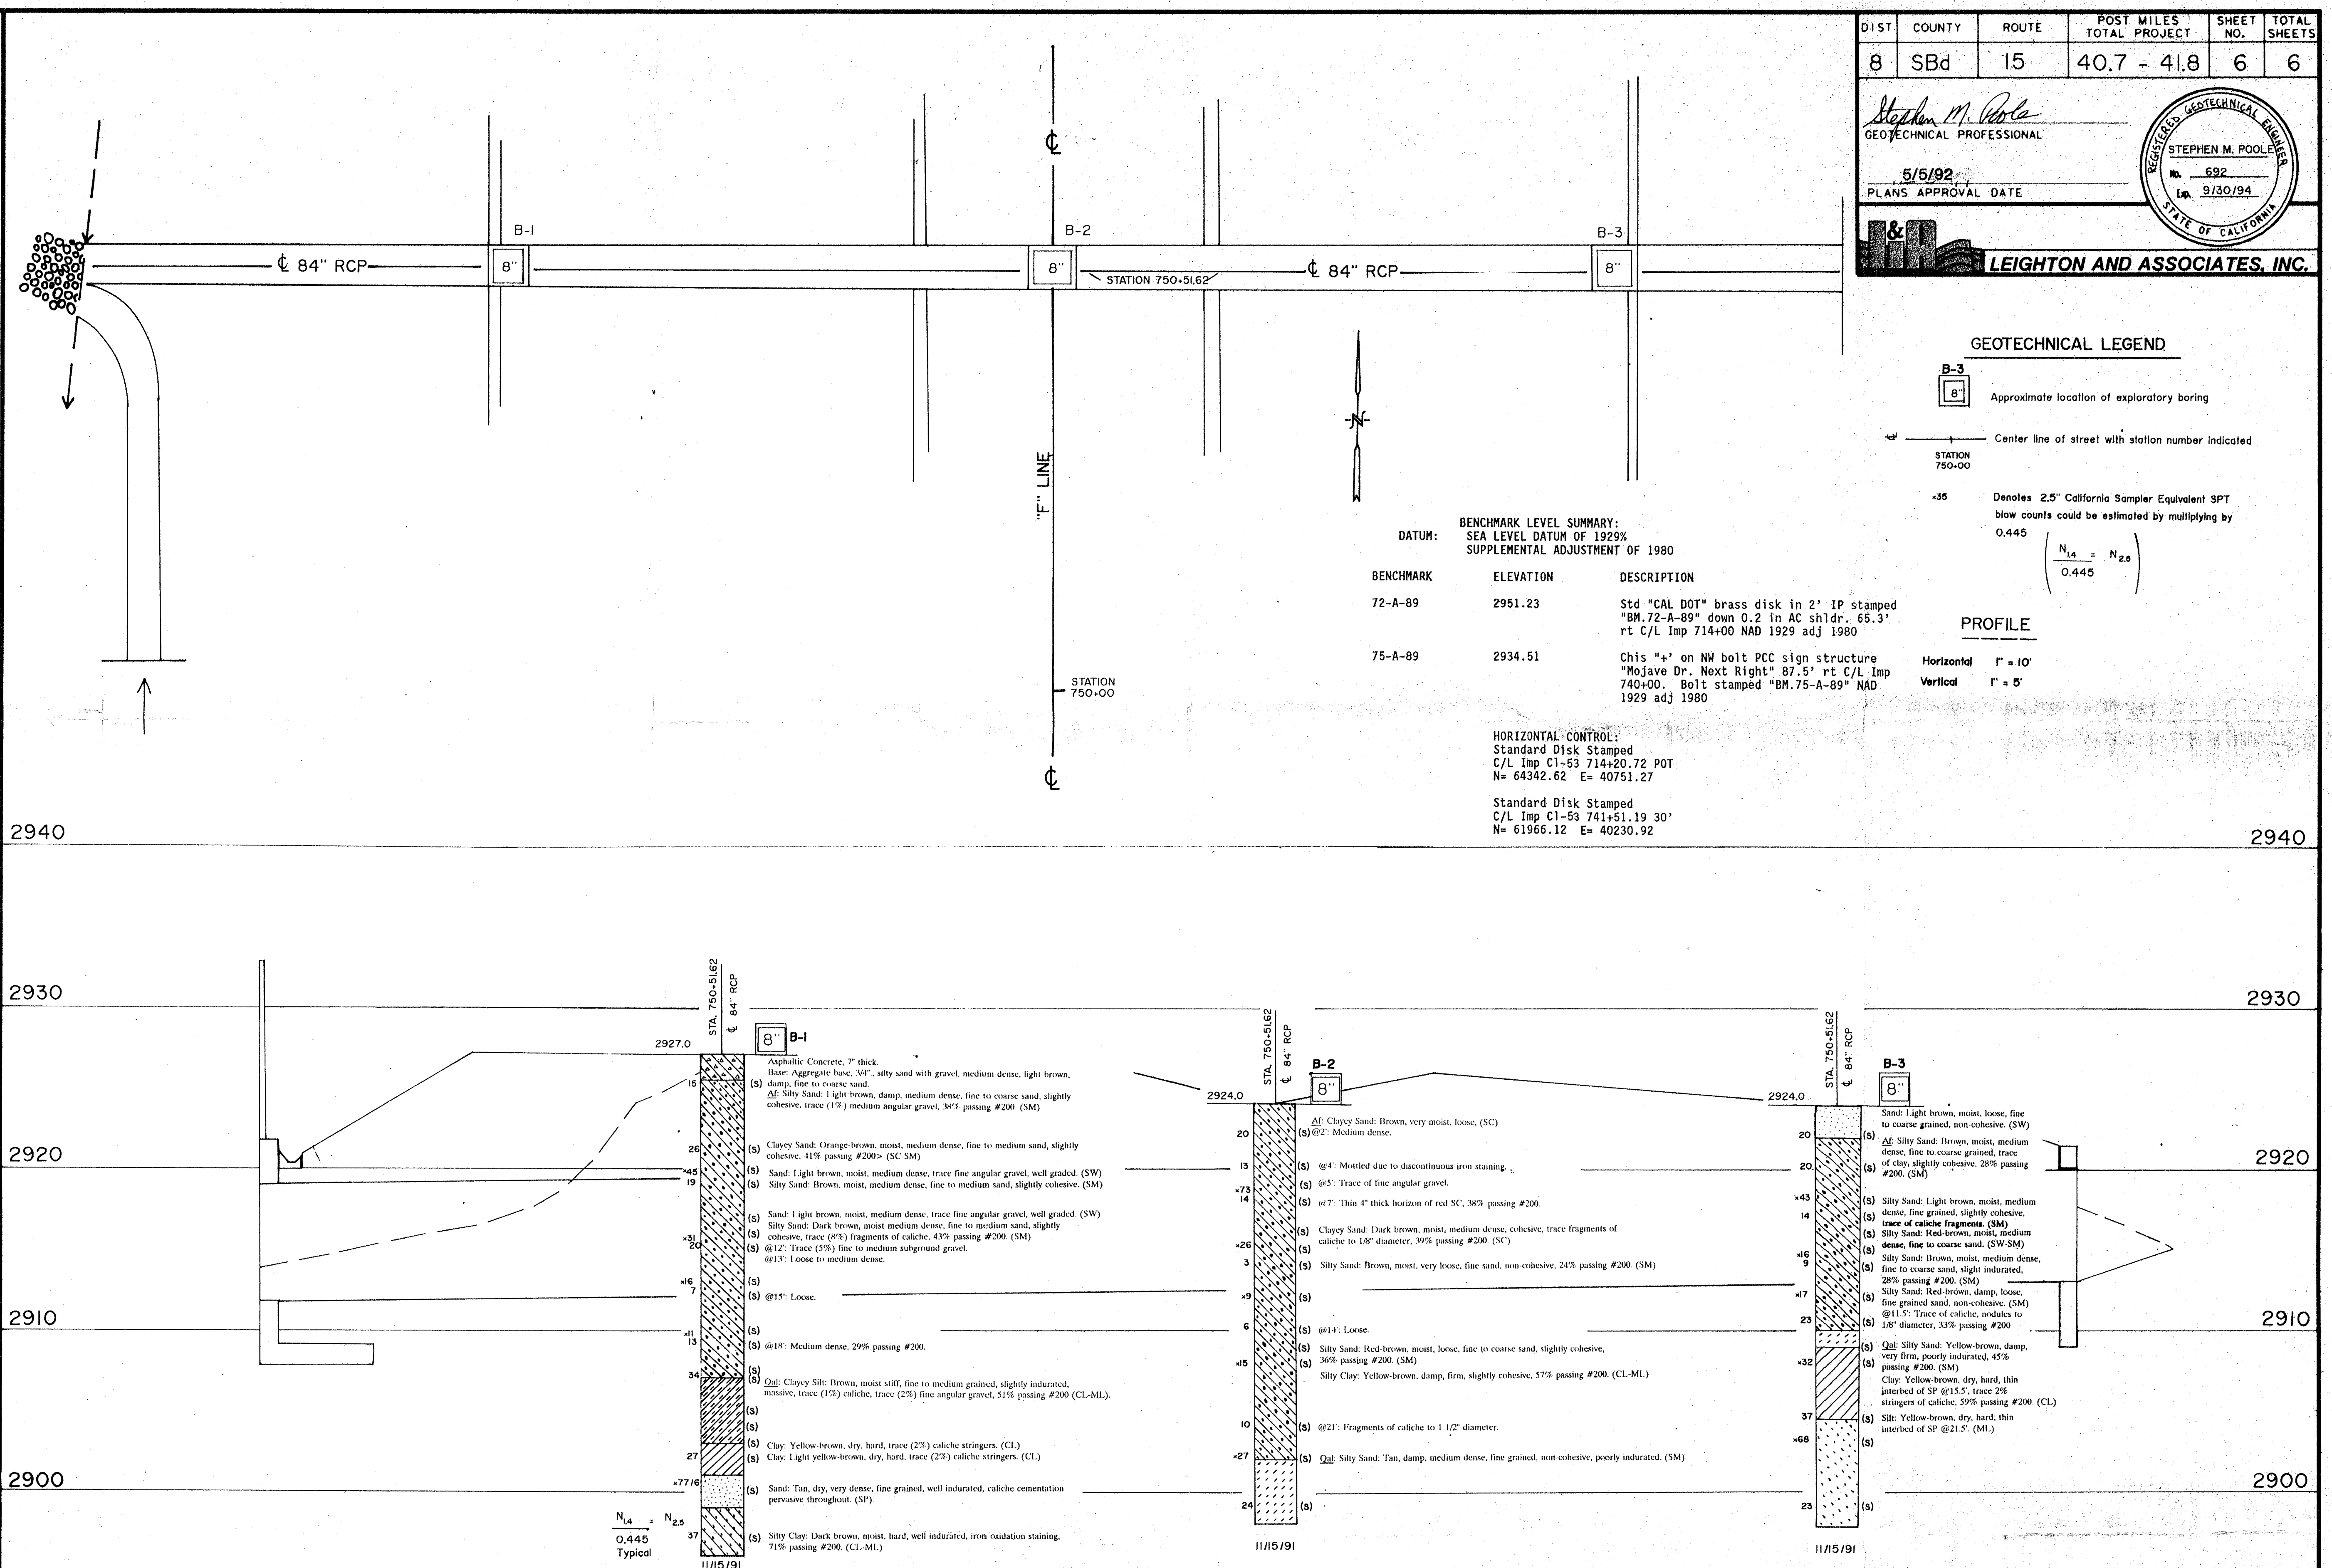

DRAWN BY: WENDY S. WEESSIES 12/5/91  
 CHECKED BY: STEPHEN M. POOLE 12/5/91  
 GREG UECKER/FRED WINKLER  
 FIELD INVESTIGATOR  
 DATE: 11/5/91

PREPARED FOR THE  
**STATE OF CALIFORNIA**  
 DEPARTMENT OF TRANSPORTATION  
 LEIGHTON & ASSOCIATES, INC.  
 PROJECT ENGINEER

BRIDGE NO. 54-1118  
 POST MILE 84" RCP  
**LOG OF TEST BORINGS**

ORIGINAL SCALE IN INCHES FOR REDUCED PLANS 0 1 2 3

CU 08103  
EA 251904

DISREGARD PRINTS BEARING EARLIER REVISION DATES


## Mojave Drive WB






DIST.	COUNTY	ROUTE	SECTION	SHEET NO.	TOTAL SHEETS
VIII	SBd	31	C	13	13

*W. Beeson*  
 CIVIL ENGINEER  
 DATE APPROVED: July 25, 1961

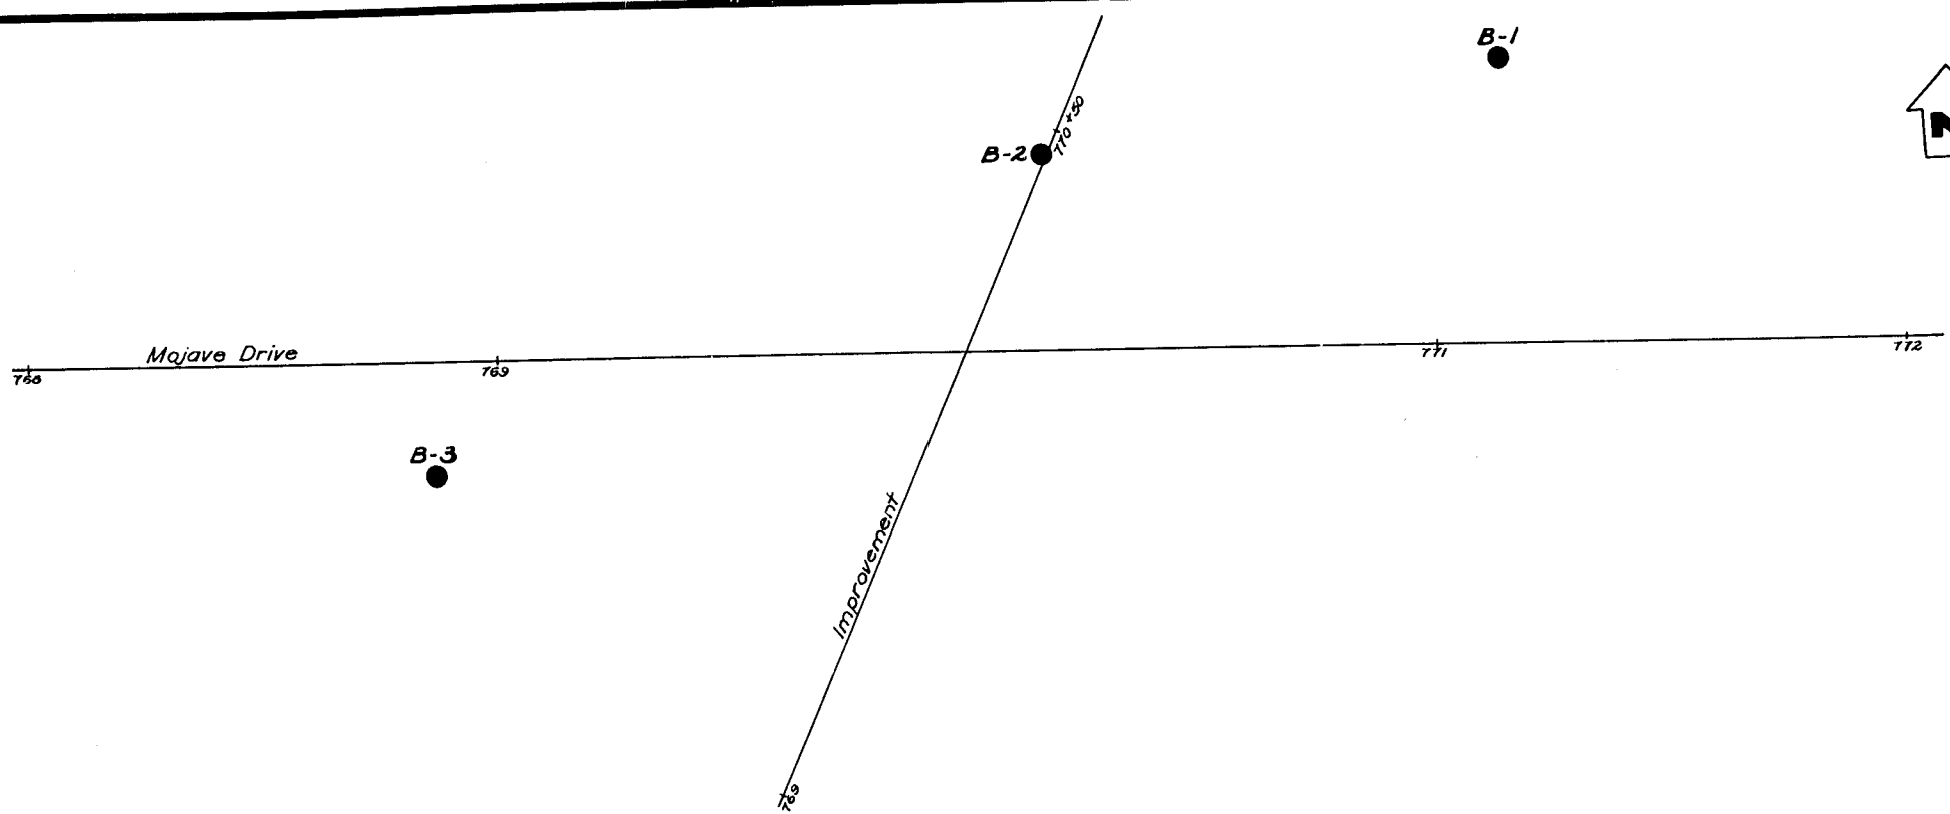


B.M. 77-A-53 Elev. 2914.26  
 2"x2" Hub & Nail buried 1.2' 226'  
 Lt. Sta. 766 +94 & Improvement.

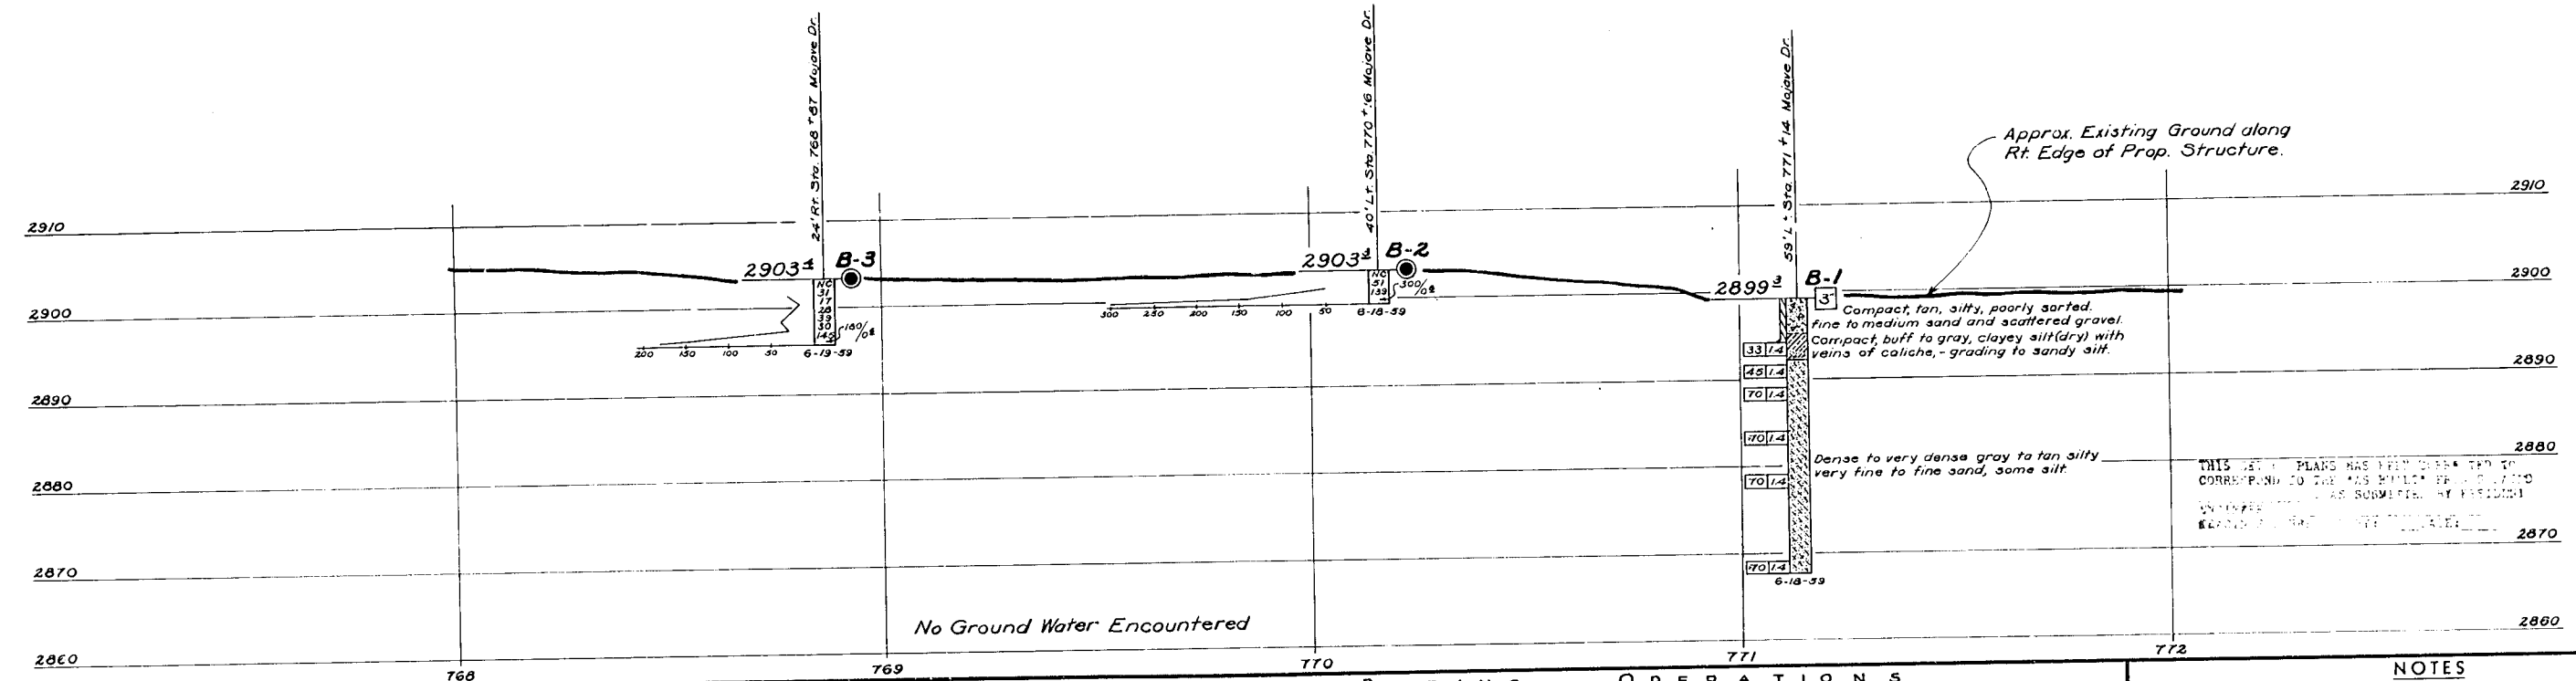

THIS SET OF PLANS HAS BEEN CHECKED TO CORRESPOND TO THE AS BUILT FIELD LOGS AND REPORTS AS SUBMITTED BY CONTRACTOR.

BRIDGE DEPARTMENT

FIELD STUDY - Remmeltkamp 6-18-60  
 DRAWN - [Signature]  
 CHECKED - [Signature]  
 APPROVED - [Signature]

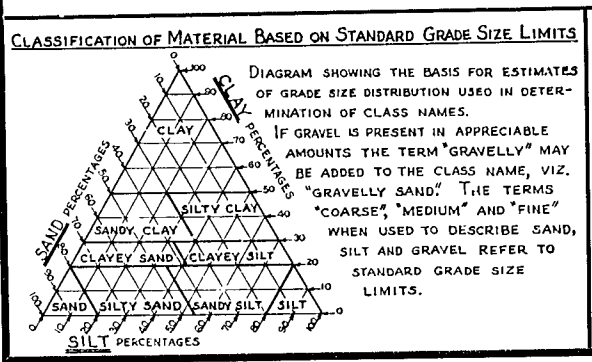

**LEGEND OF EARTH MATERIALS**

GRAVEL	SILTY CLAY OR CLAYEY SILT
SAND	PEAT AND/OR ORGANIC MATTER
SILT	FILL MATERIAL
CLAY	IGNEOUS ROCK
SANDY CLAY OR CLAYEY SAND	SEDIMENTARY ROCK
SANDY SILT OR SILTY SAND	METAMORPHIC ROCK

**LEGEND OF BORING OPERATIONS**

- PLAN OF ANY BORING
- ⊙ PENETROMETER
- ⊙ 2 1/2" CONE PENETROMETER
- ⊞ SAMPLER BORING (DRY)
- ⊞ ROTARY BORING (WET)
- ⊞ AUGER BORING (DRY)
- ⊞ JET BORING
- ⊞ CORE BORING
- ⊞ TEST PIT

**1" SOIL TUBE**

**ROTARY BORING**

**PENETRATION BORING**

**NOTES**

The contractor's attention is directed to Section 2, Article (c) of the Standard Specifications and to the Special Provisions accompanying this set of plans. Classification of earth material as shown on this sheet is based upon field inspection and is not to be construed to imply mechanical analysis.

STATE OF CALIFORNIA  
 DEPARTMENT OF PUBLIC WORKS  
 DIVISION OF HIGHWAYS

MOJAVE DRIVE O.C.

LOG OF TEST BORINGS

Hor. 1" = 20'  
 SCALE Ver. 1" = 10'

BRIDGE 54-626	FILE	DRAWING
---------------	------	---------



## Victorville Separation OH




FED. ROAD DIV. NO.	STATE	PROJ. NO.	FISCAL YEAR	SHEET NO.	TOTAL SHEETS
7	CAL.				

DIST.	COUNTY	ROUTE	SECTION	SHEET NO.	TOTAL SHEETS
Will	SBd	31	D		


BRIDGE ENGINEER CIVIL AND STRUCTURAL ENGINEER - LICENSE 5563

DATE APPROVED:

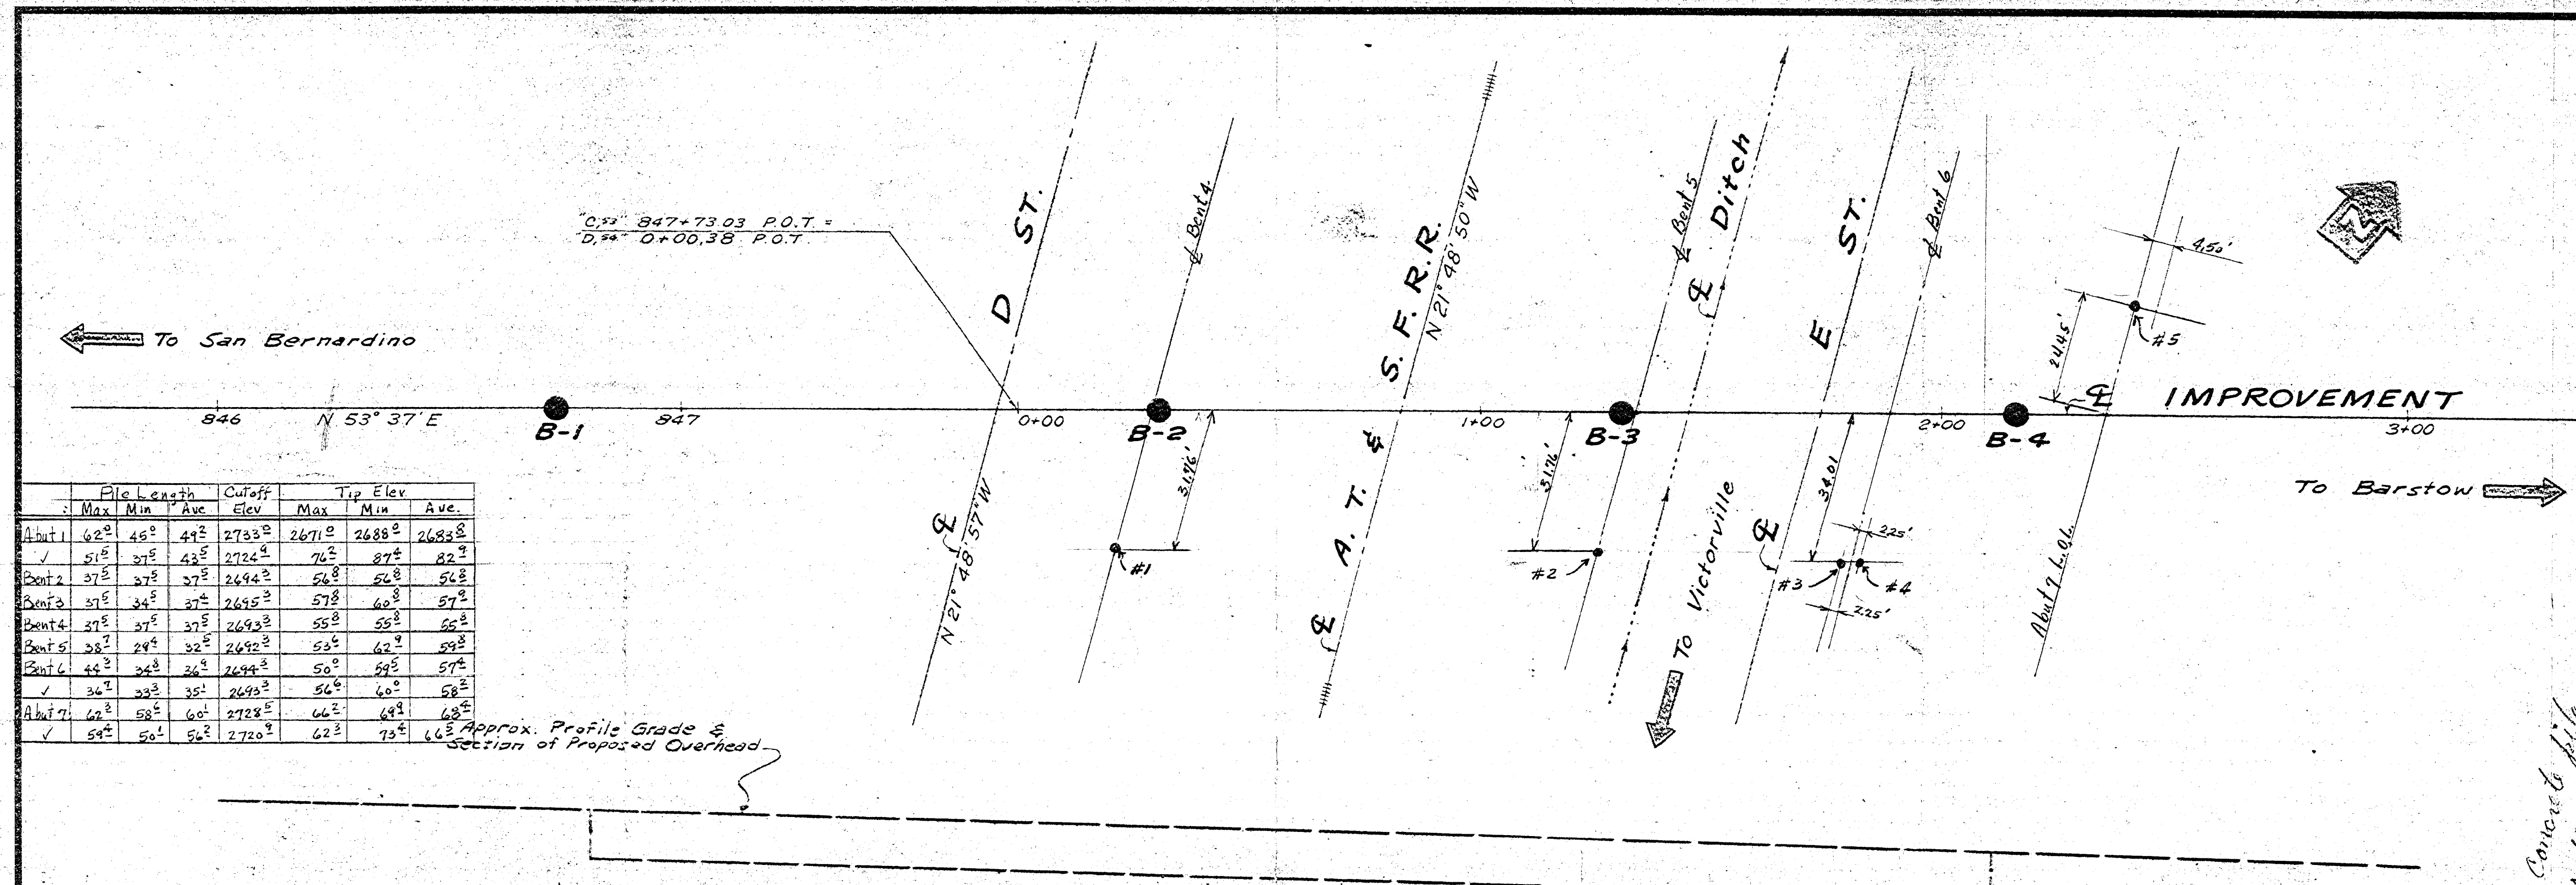


	Pile Length			Cutoff Elev.	Tip Elev.		
	Max	Min	Ave		Max	Min	Ave
Abut 1	42'	45'	44'	2783'	2671'	2688'	2683'
Bent 2	37'	37'	37'	2694'	56'	56'	54'
Bent 3	37'	34'	37'	2695'	57'	60'	57'
Bent 4	37'	37'	37'	2693'	55'	55'	55'
Bent 5	38'	29'	32'	2692'	53'	62'	59'
Bent 6	44'	34'	36'	2694'	50'	59'	57'
Abut 7	34'	33'	35'	2693'	56'	60'	58'
Abut 7	47'	58'	60'	2728'	66'	69'	68'
Abut 7	54'	56'	56'	2720'	62'	73'	66'

Approx. Profile Grade & Section of Proposed Overhead

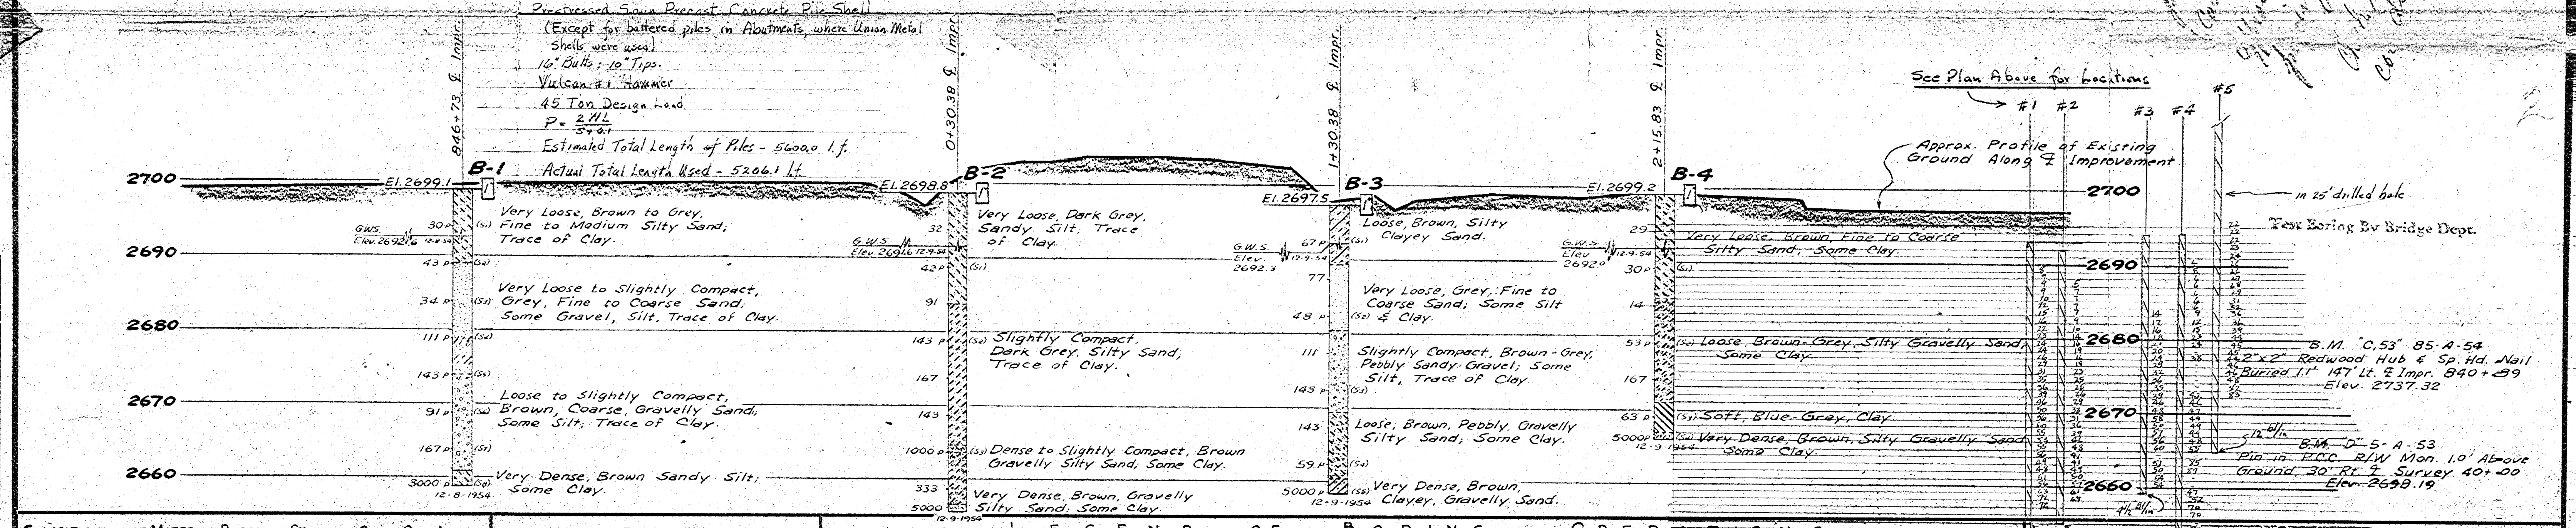


*Concrete piles are recommended for foundation support. Estimated pile length for 45' span about 2500'. That is drilled to 10' below grade. Ground piles should be in place 30 days before any superstructure is placed. Co. to investigate to make sure.*

BRIDGE DEPARTMENT  
 FIELD STUDY  
 DRAWN BY J. Mansky 10-20-1954  
 CHECKED BY F. A. Kesting 11/1/54  
 Approved Recommended by: \_\_\_\_\_  
 Approved by: \_\_\_\_\_

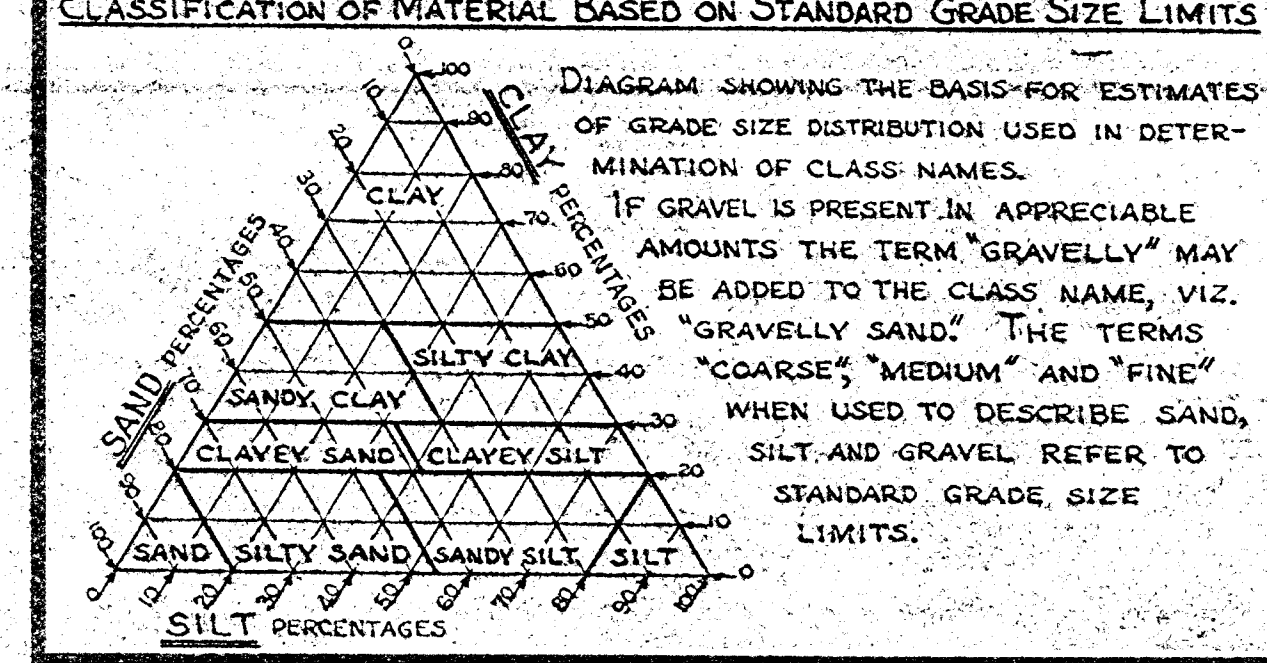

LEGEND OF EARTH MATERIALS

GRAVEL	SILTY CLAY OR CLAYEY SILT
SAND	PEAT AND/OR ORGANIC MATTER
SILT	FILL MATERIAL
CLAY	IGNEOUS ROCK
SANDY CLAY OR CLAYEY SAND	SEDIMENTARY ROCK
SANDY SILT OR SILTY SAND	METAMORPHIC ROCK

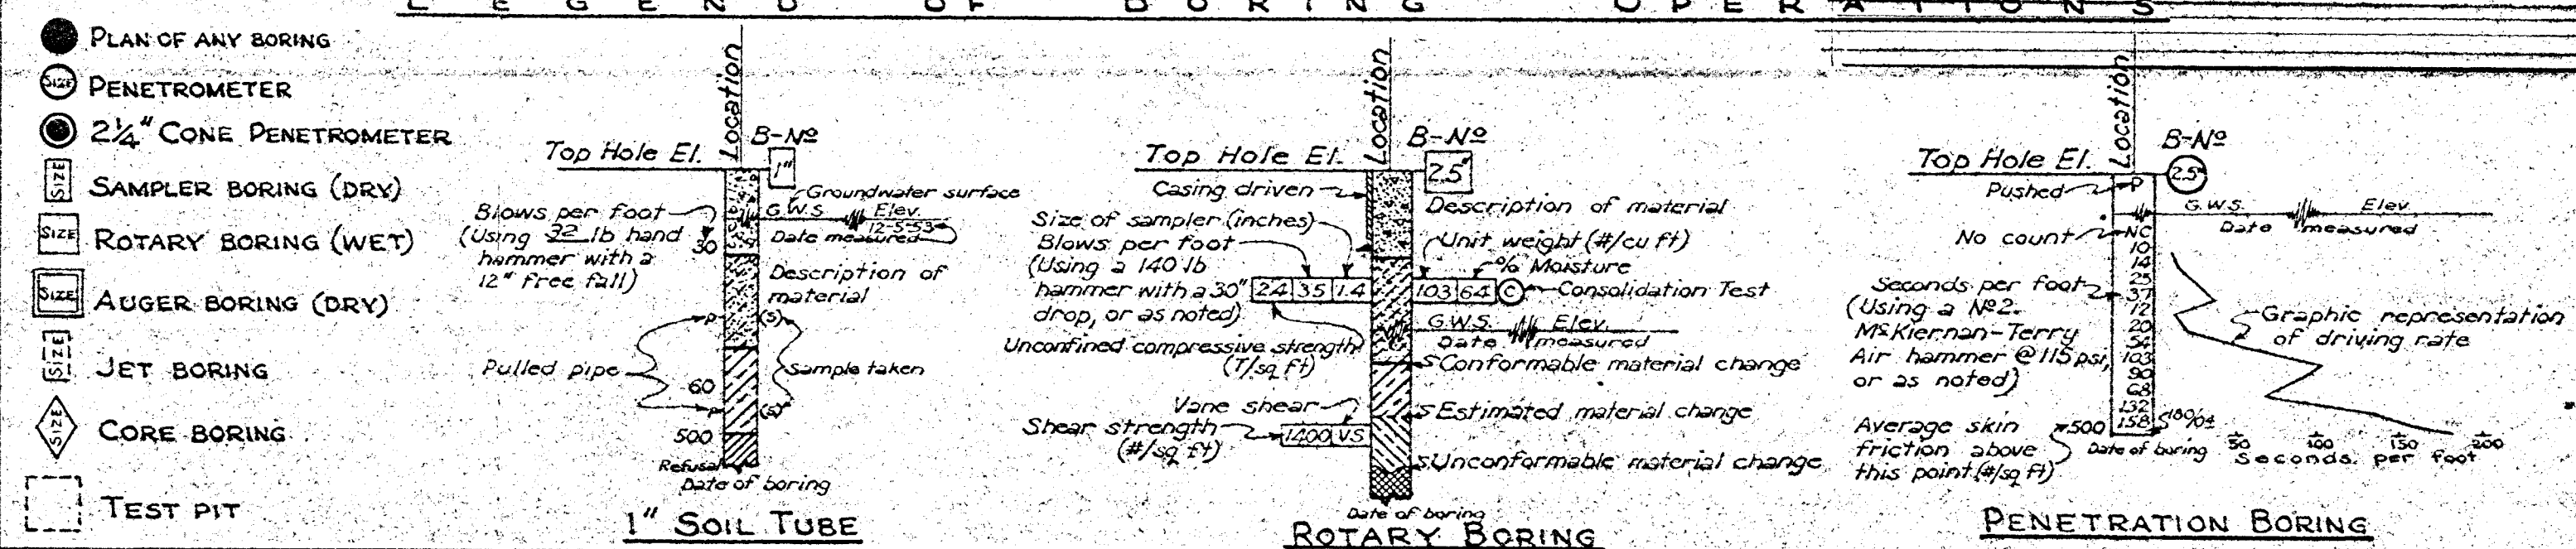

NOTES

The contractor's attention is directed to Section 2, Article (c) of the Standard Specifications and to the special provisions accompanying this set of plans. Classification of earth material as shown on this sheet is based upon field inspections and is not to be construed to imply mechanical analysis.

STATE OF CALIFORNIA  
 DEPARTMENT OF PUBLIC WORKS  
 DIVISION OF HIGHWAYS

## VICTORVILLE OVERHEAD


### LOG OF TEST BORINGS

Scale: Horiz. 1" = 20', Vert. 1" = 10'

BRIDGE 54-484 FILE DRAWING



39

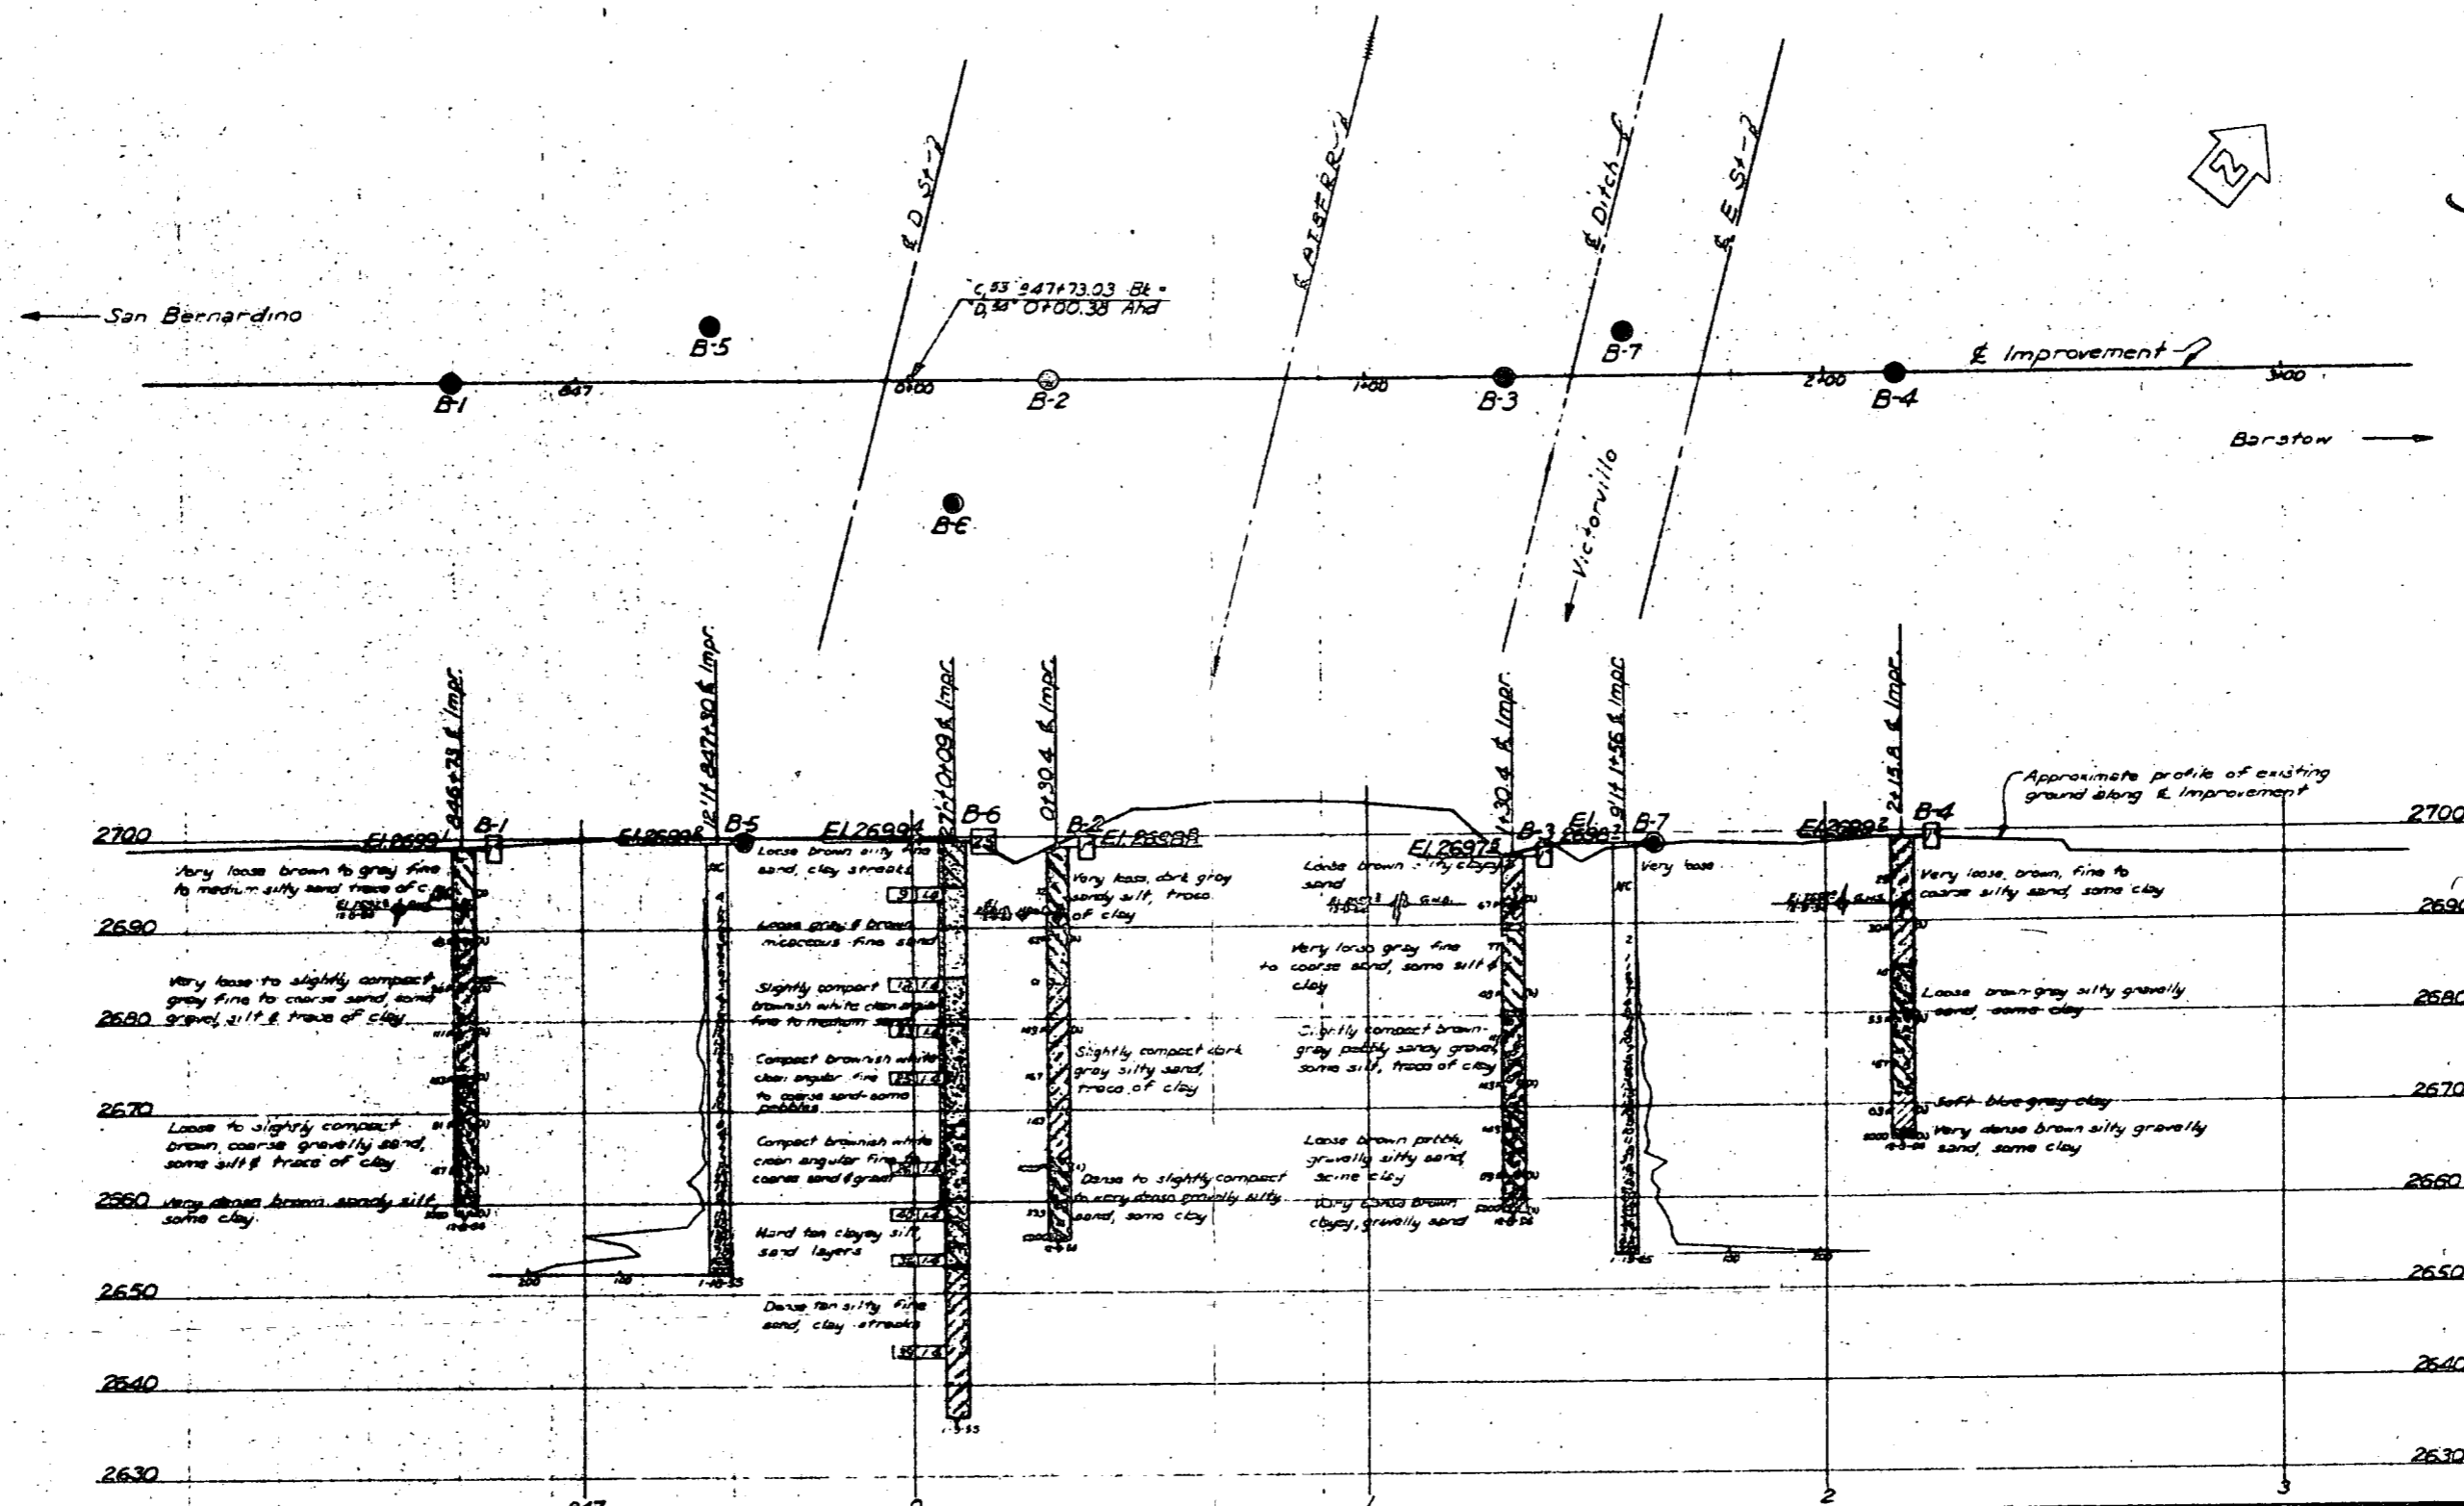

BRIDGE DEPARTMENT

FIELD CHECKED	DATE
BY	
CHECKED	
BY	

Test Borings by Bridge Dept.

B.M. 'C-53' 85-A-54  
2" x 2" Redwood Hub & Sp. No. 1611  
Bored 11' 147" H & Invar. Sta 840+09  
Elev. 2737.32

B.M. 'D' 5-A-53  
Dr. in PCC R/W Monument 2' above  
ground 30' H & Invar. Sta 840+00  
Elev. 2638.19

AS BUILT 6,750 OR REP

NOTES

The contractor's attention is directed to Section 2, Article (4) of the Standard Specifications and to the Special Provisions accompanying this set of plans. Classification of earth recorded as shown on this sheet is based upon field inspection and is not to be construed to imply mechanical analysis.


STATE OF CALIFORNIA  
DEPARTMENT OF PUBLIC WORKS  
DIVISION OF HIGHWAYS

VICTORVILLE OVERHEAD  
Rt. 31/43 Sep & AH.  
LOG OF TEST BORINGS

SCALE 1" = 20' BRIDGE 54-484 FILE DRAWING C-4269-13

FREL DRAWING NO. P. 4269 3

CLASSIFICATION OF MATERIAL BASED ON STANDARD GRADE SIZE LIMITS


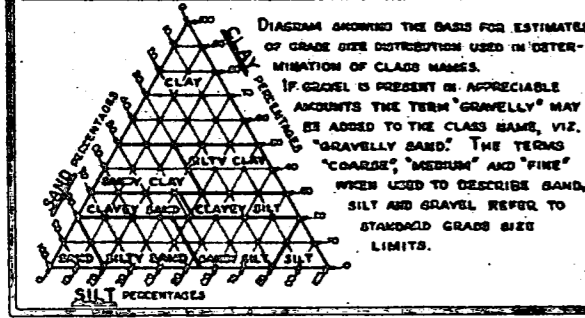


LEGEND OF EARTH MATERIALS

- |                           |                            |
|---------------------------|----------------------------|
| GRAVEL                    | SILTY CLAY OR CLAYEY SILT  |
| SAND                      | PEAT AND/OR ORGANIC MATTER |
| SILT                      | FILL MATERIAL              |
| CLAY                      | IGNEOUS ROCK               |
| SANDY CLAY OR CLAYEY SAND | SEDIMENTARY ROCK           |
| SANDY SILT OR SILTY SAND  | METAMORPHIC ROCK           |

- PLAN OF ANY BORING
- PENETROMETER
- 2 1/2" CONE PENETROMETER
- SAMPLER BORING (DRY)
- ROTARY BORING (WET)
- AUGER BORING (DRY)
- JET BORING
- CORE BORING
- TEST PIT


LEGEND OF BORING OPERATIONS

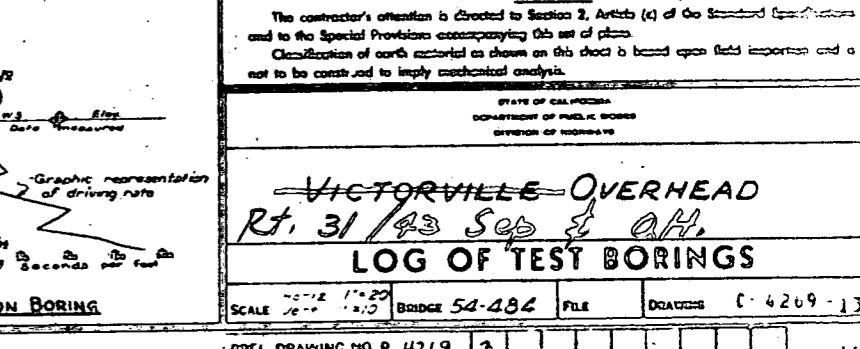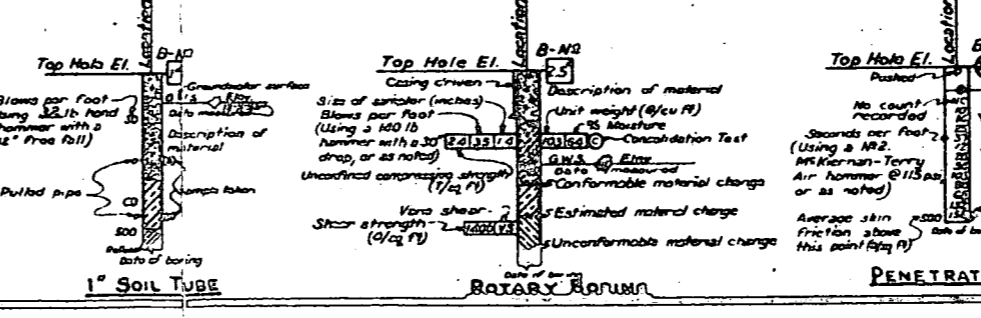

35

## Mojave River Bridge

DIST	COUNTY	ROUTE	POST MILES TOTAL PROJECT	SHEET No.	TOTAL SHEETS
08	SBd	15			

  
 REGISTERED CIVIL ENGINEER 8-14-13 DATE  
 HASSAN IBRAHIM  
 No. C59016  
 Exp. 6-30-15  
 CIVIL  
 STATE OF CALIFORNIA

PLANS APPROVAL DATE

*The State of California or its officers or agents shall not be responsible for the accuracy or completeness of electronic copies of this plan sheet.*

This LOTB sheet was prepared in accordance with the Caltrans Soil & Rock Logging, Classification, & Presentation Manual (2010 Edition).  
 See 2010 Standard Plans A10F and A10G for Soil Legend, and A10H for Rock Legend.  
**NOTE: LOTB sheets from 3 of 11 to 10 of 11, are based on the Soil & Rock Logging Classification Manual (Field Guide) August 1996.**


**BENCH MARK**

These well monument elevations are based off of BM 43.7-92, Elevation= 2697.606 ft. 2 inches brass disk stamped "State of California Division of Highways BM 43.70-92". 45.9 Ft. right of Station 178.5 @ Interstate I-5 NGVD 1929.

To San Bernardino

R-10-001

R-10-002

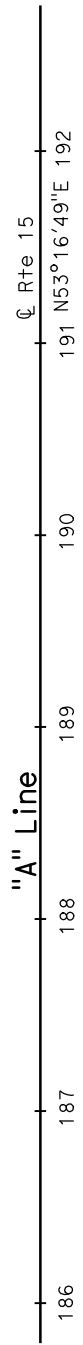

PLAN  
1" = 50'

Station	Soil Description	Elevation
2720	3" 6" Asphalt concrete pavement of road surface over well-graded SAND (SW); brown; dry.	2720
2710	Well-graded SAND with SILT (SW-SM); dense; light brown; moist; few fines; (FILL). Well-graded SAND (SW); very dense; brown; moist; few fine GRAVEL.	2710
2700	Well-graded SAND (SW); very dense; brown; moist; few fine GRAVEL.	2700
2690	Poorly-graded SAND with CLAY (SP-SC); dense; greenish brown; moist; mostly fine and medium; few coarse; trace fine GRAVEL; (NATIVE). -medium dense; grayish brown; wet.	2690
2680	GWS Elev. 2681.1' Well-graded SAND (SW); medium dense; grayish brown; wet; little fines; trace fine GRAVEL. 5-18-10 Poorly-graded SAND with CLAY (SP-SC); medium dense; grayish brown; wet; mostly fine and medium; few coarse; trace fine GRAVEL. Well-graded SAND with CLAY and GRAVEL (SW-SC); dense; grayish brown; wet; little well-graded GRAVEL; few fines.	2680
2670	Well-graded GRAVEL with SILT and SAND (GW-GM); dense; grayish brown; wet; some well-graded SAND; few fines. Well-graded SAND with SILT and GRAVEL (SW-SM); dense; grayish brown; wet; little well-graded GRAVEL; few fines.	2670
2660	SILTY SAND (SM); dense; grayish brown; wet; well-graded SAND; little fines; few fine GRAVEL. -very dense; mostly fine; trace GRAVEL.	2660
2650	-mostly fine and medium.	2650
2640	Well-graded SAND with CLAY and GRAVEL (SW-SC); dense; grayish brown; wet; few fines; trace fine GRAVEL. -very dense; little fines; few GRAVEL.	2640
2630	SILTY SAND (SM); dense; grayish brown; wet; medium to fine SAND; little fines; trace GRAVEL. -very dense; well-graded SAND; few fine GRAVEL. -dense; brown; trace fine GRAVEL. -very dense; few fine GRAVEL.	2630
2620	-medium and fine SAND. -trace fine GRAVEL. -few fine GRAVEL.	2620
2610	-some fines.	2610
2600	-few fine GRAVEL.	2600
2590	-few fine GRAVEL.	2590
2580	-few fine GRAVEL.	2580
2570	-few fine GRAVEL.	2570
2560	-few fine GRAVEL.	2560
2550	-few fine GRAVEL.	2550
2540	Terminated at Elev 2545.8' ERI = 68%	2540

PROFILE  
Horiz: 1" = 10'  
Vert: 1" = 10'

187+00

186+00

<b>ENGINEERING SERVICES</b>		<b>MATERIALS AND GEOTECHNICAL SERVICES</b>		<b>STATE OF CALIFORNIA DEPARTMENT OF TRANSPORTATION</b>		<b>DIVISION OF ENGINEERING SERVICES STRUCTURE DESIGN DESIGN BRANCH X</b>		<b>MOJAVE RIVER BRIDGE (WIDEN) LOG OF TEST BORINGS 1 OF 11</b>	
FUNCTIONAL SUPERVISOR NAME: A. Perez-Cobo	DRAWN BY: F. Nguyen CHECKED BY: S. Logeswaran	FIELD INVESTIGATION BY: H. Ibrahim		BRIDGE NO. 54-0483 POST MILE 43.93		CONTRACT NO.: 08-355561		DISREGARD PRINTS BEARING EARLIER REVISION DATES	
065 CIVIL LOG OF TEST BORINGS SHEET				ORIGINAL SCALE IN INCHES FOR REDUCED PLANS		UNIT: 3643 PROJECT NUMBER & PHASE: 08000006211		REVISION DATES 01-26-13 02-12-13 03-01-13	
				FILE => mojave-v01.dgn				SHEET OF X X	



DIST	COUNTY	ROUTE	POST MILES TOTAL PROJECT	SHEET No.	TOTAL SHEETS
08	SBD	15			


8-14-13  
 REGISTERED CIVIL ENGINEER DATE  
 Asef Wardak  
 No. C61960  
 Exp. 9-30-13  
 CIVIL  
 STATE OF CALIFORNIA

PLANS APPROVAL DATE

*The State of California or its officers or agents shall not be responsible for the accuracy or completeness of electronic copies of this plan sheet.*

This LOTB sheet was prepared in accordance with the Caltrans Soil & Rock Logging, Classification, & Presentation Manual (2010 Edition).  
 See 2010 Standard Plans A10F and A10G for Soil Legend, and A10H for Rock Legend.

FOR PLAN VIEW, SEE  
 "LOG OF TEST BORINGS 1 OF 11"

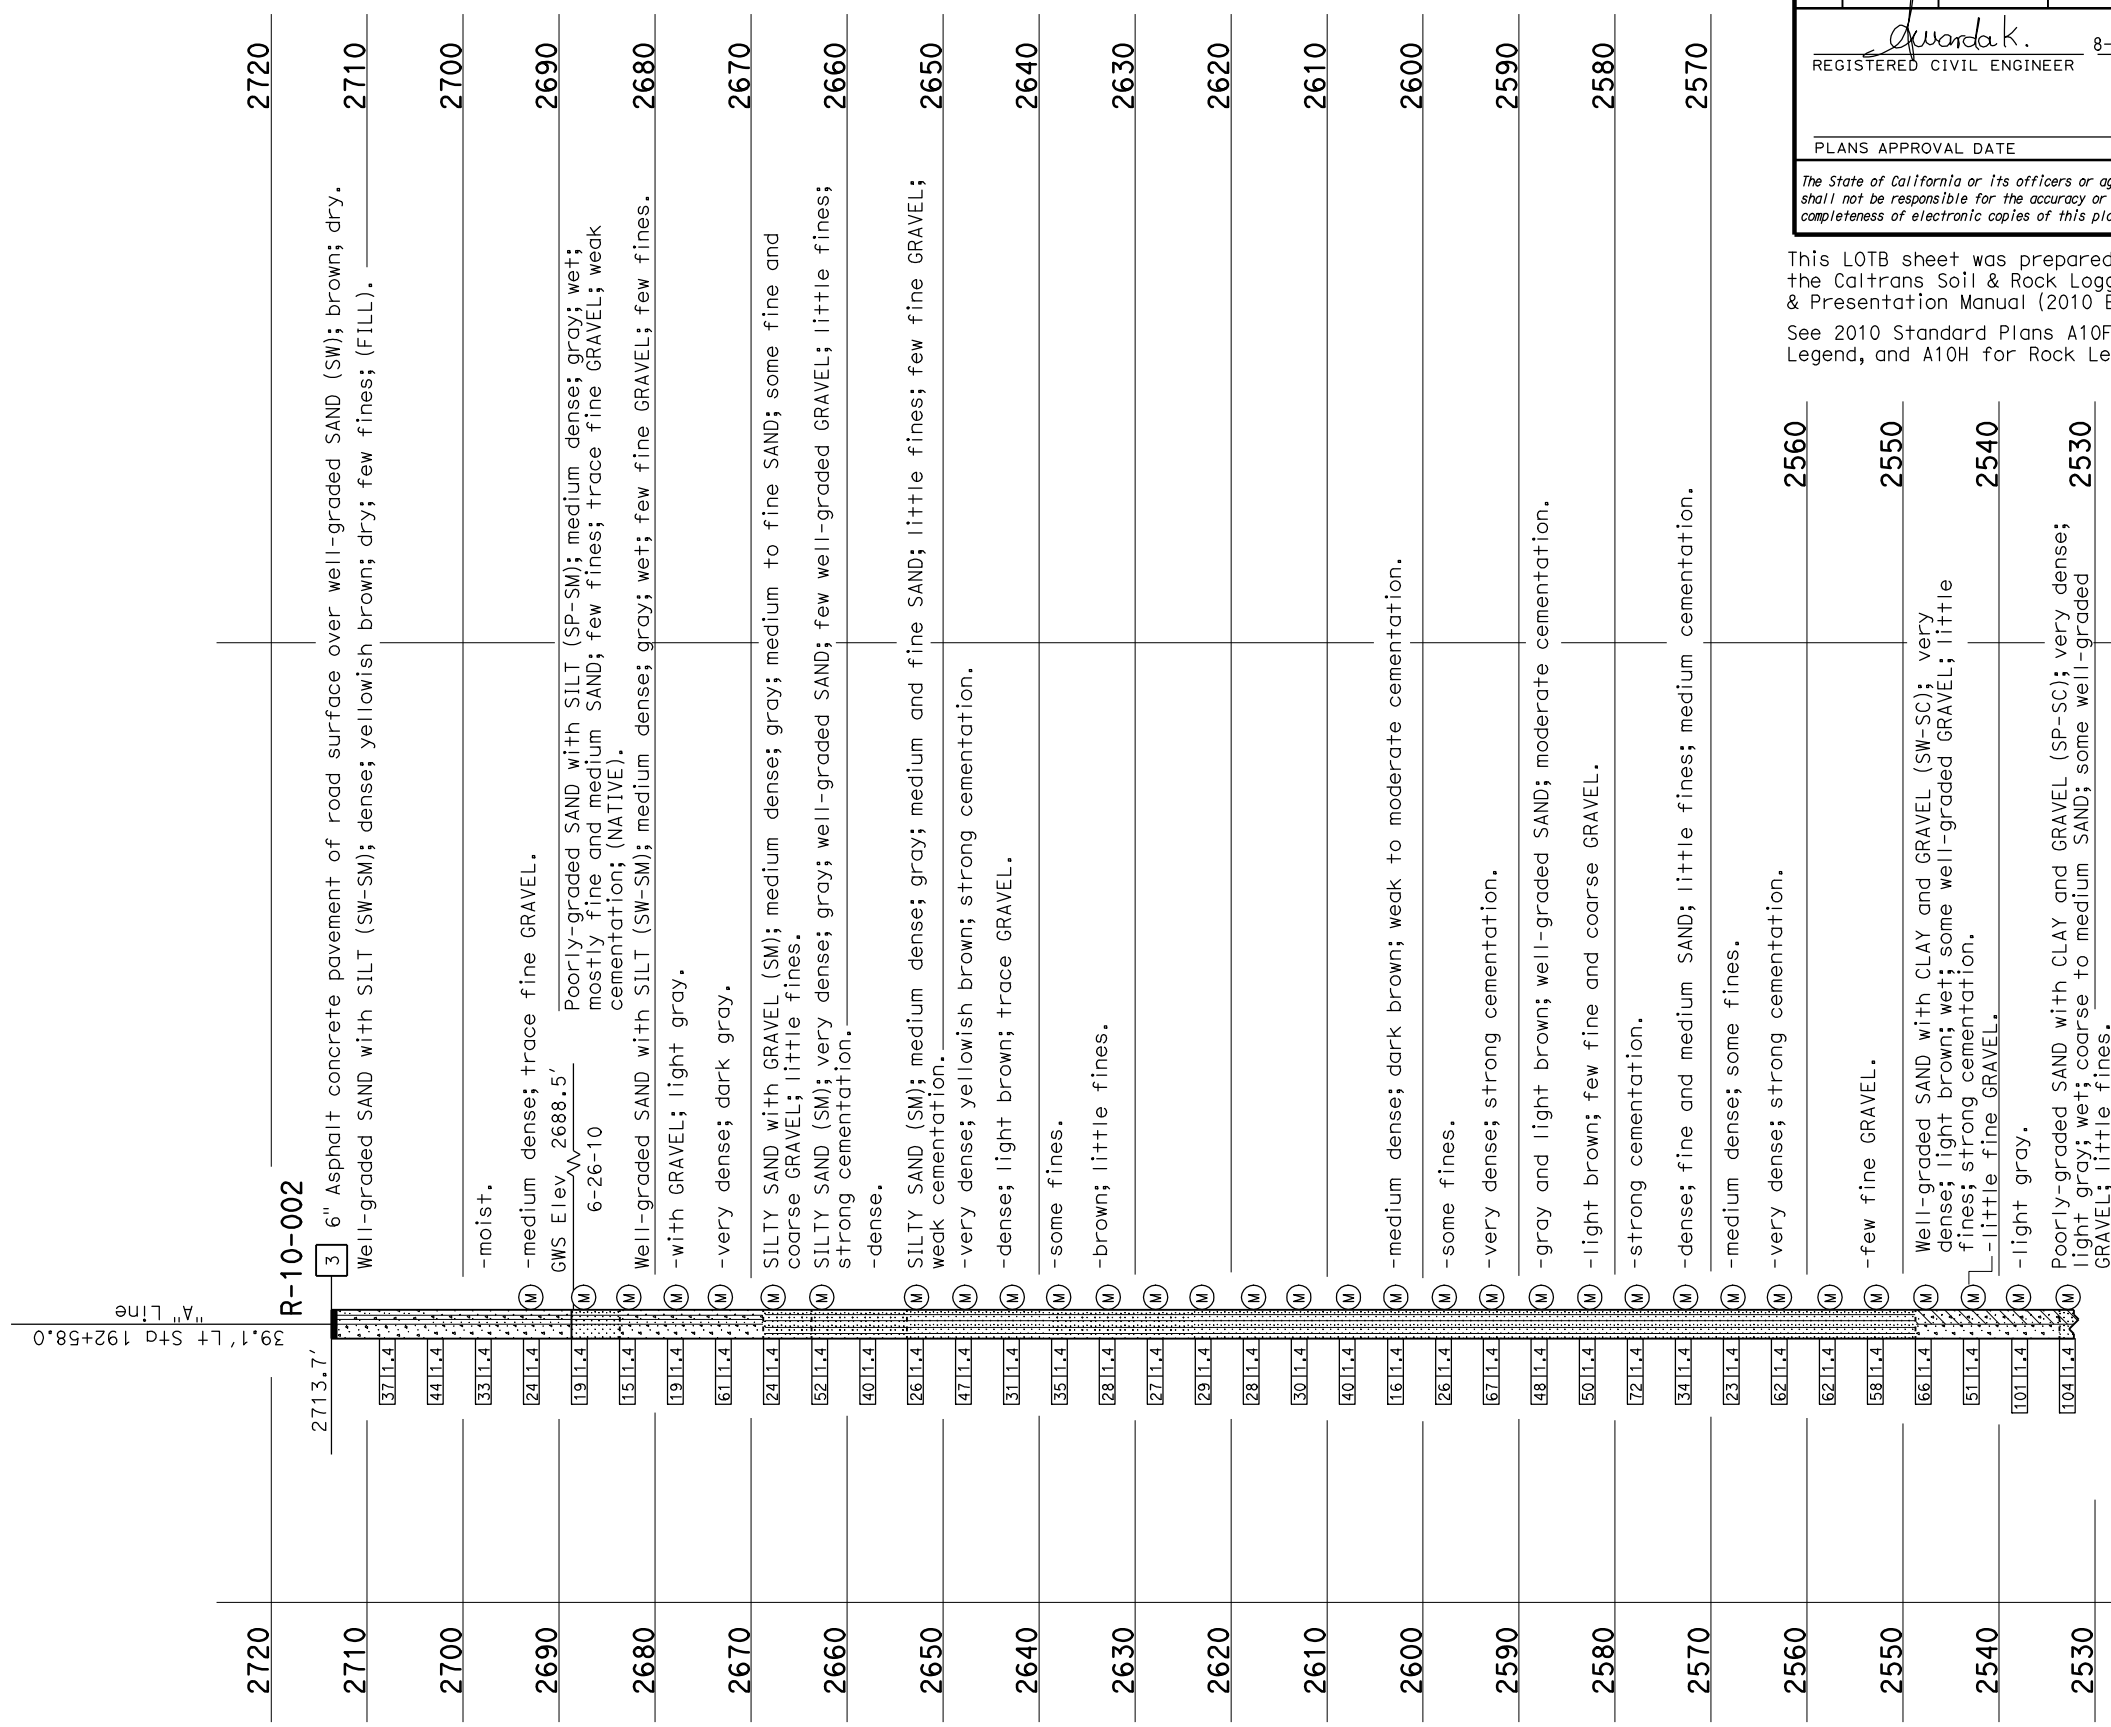

PROFILE  
 Horiz: 1" = 20'  
 Vert: 1" = 10'

192+00

194+00

<b>ENGINEERING SERVICES</b>		<b>MATERIALS AND GEOTECHNICAL SERVICES</b>		<b>STATE OF CALIFORNIA</b>		<b>DIVISION OF ENGINEERING SERVICES</b>		<b>BRIDGE NO.</b>		<b>MOJAVE RIVER BRIDGE (WIDEN)</b>	
FUNCTIONAL SUPERVISOR		DRAWN BY: F. Nguyen		DEPARTMENT OF TRANSPORTATION		STRUCTURE DESIGN		54-0483		LOG OF TEST BORINGS 2 OF 11	
NAME: A. Perez-Cobo		CHECKED BY: S. Logeswaran		FIELD INVESTIGATION BY: A. Wardak		DESIGN BRANCH X		POST MILE			
								43.93			
065 CIVIL LOG OF TEST BORINGS SHEET		ORIGINAL SCALE IN INCHES FOR REDUCED PLANS		UNIT: 3643		PROJECT NUMBER & PHASE: 08000006211		CONTRACT NO.: 08-355561		DISREGARD PRINTS BEARING EARLIER REVISION DATES	
						FILE => mojave-v02.dgn		REVISION DATES		SHEET OF	
								01-26-13 02-12-13 03-01-13		X X	

DIST	COUNTY	ROUTE	POST MILES TOTAL PROJECT	SHEET No.	TOTAL SHEETS
08	SBd	15			

REGISTERED CIVIL ENGINEER  
 Hassan Ibrahim  
 No. C59016  
 Exp. 6-30-15  
 CIVIL  
 STATE OF CALIFORNIA

8-14-13 DATE

PLANS APPROVAL DATE


The State of California or its officers or agents shall not be responsible for the accuracy or completeness of electronic copies of this plan sheet.

**BENCH MARK**

BM Elev 2718.889'  
 N 616469.644 E 2064601.085  
 Caltrans aerial target #1-8, nail in asphalt on right shoulder of northbound I-15



TO SAN BERNARDINO

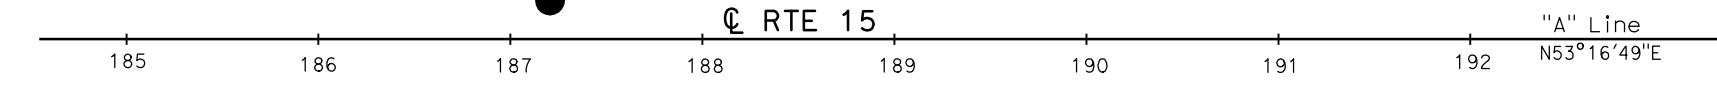

TO BARSTOW

**PLAN**  
 1" = 50'

**GPS SURVEY NOTES**

Test Boring collar position and elevation data has acquired by Differential Global Positioning System methods utilizing a Trimble 12-Channel Pro XRGPS with Minimum Shift Key (MSK) beacon receiver with applied real time differential correction. Horizontal datum : U.S. State Plane 1983 High Precision Geodetic Network (HPGN)

Projection	Zone	
California State Plane Coordinate System	5	
Boring Number	(N) Coordinate	(E) Coordinate
B-1-01	616692.685	2064795.885
B-2-01	616532.026	2064706.510
B-3-01	616496.053	2064671.152
B-4-01	616560.871	2064743.180
B-5-01	616605.484	2064729.150
B-6-01	616617.208	2064727.563
B-7-01	616574.136	2064688.918
B-8-01	616604.509	2064687.583
B-9-01	616595.539	2064665.938
B-10-01	616645.364	2064755.149
B-11-01	616643.181	2064783.874
B-12-01	616606.170	2064800.878
B-13-01	616585.486	2064774.194
B-14-01	616564.448	2064749.462
B-15-01	616613.711	2064740.071
B-16-01	616553.001	2064732.427
B-17-01	616539.325	2064713.315
B-18-01	616526.572	2064696.005
B-19-01	616567.237	2064674.049
B-20-01	616595.558	2064678.743

**NOTES:**

- The descriptions and classifications of rock and/or soil, including consistency and relative density descriptors, used by the field and/or office personnel for the exploration boreholes shown on this sheet are based on the "Soil and Rock Logging Classification Manual (Field Guide)," Engineering Service Center, Office of Structural Foundations, August 1996.
- Soil colors were determined by using Munsel Soil Color Charts (1994, Revised Edition). Rock colors were determined using Geological Society of America rock color charts (1995, 8th Printing).
- Ground water was measured in borings B-4-01, B-5-01, and B-6-01. Please refer to those borings for ground water measurements. No attempt was made to measure ground water in borings B-7-01 through B-20-01. Those borings were backfilled immediately after completion of drilling.
- The ground water levels indicated in the Log of Test Borings (LOBT) sheets reflect the measured ground water levels measurement in the boreholes on the specified dates. Ground water surface elevations are subject to seasonal fluctuations and will be encountered at higher or lower elevations depending on conditions at time of constructions.
- Test boring B-1-01 utilized a safety hammer to advance the sampler using a 140 lb hammer with a 30" drop. Penetration index values shown are the actual blow counts recorded in the field. Soil descriptions shown on the LOBT sheets for those borings are based on these index values.
- Test boring B-2-01 and B-4-01 through B-13-01 utilized a Dietrich auto hammer to advance the sampler using a 140 lb hammer with a 30" drop. Penetration index values shown are the actual blow counts recorded in the field. Soil consistency classifications for those borings are based on a conversion factor of 1.5 times the blow count.
- The boring B-3-01 utilized a safety hammer from the top of the down to Elev 2666.3' and a Dietrich auto hammer from Elev 2666.3' to the bottom of the boring, to advance the sampler using a 140 lb hammer with a 30" drop. Penetration index values shown are the actual blow counts recorded in the field. Soil consistency classifications shown on the LOBT sheet for boring B-3-01, from the top of the boring down to Elev 2666.3', are based on the actual blow counts recorded on the field, and from Elev 2666.3' to bottom of the boring are based on a conversion factors of 1.5 times the field blow count.
- E = Blow count for 1' penetration extrapolated from blow count for less than 1' (due to change in material or hard driving).
- Borings B-14-01 through B-20-01 were 2.24" diameter cone penetration borings, advanced using a Mobile 3000 hydraulic operated hoe ram. Due to the variability of the energy output of the Mobile 3000 rig, the rig was only used to estimate the depth to very dense earth material.

**LEGEND OF BORING OPERATIONS**

**LEGEND OF EARTH MATERIALS**

**CONSISTENCY CLASSIFICATION FOR SOILS**

According to the Standard Penetration Test	
SPT N-value (Blows/foot)	Consistency
0-4	Very Loose
5-10	Loose
11-30	Medium Dense
31-50	Dense
51-70	Very Dense
71-90	Very Dense
91-110	Very Stiff
111-130	Stiff
131-150	Very Stiff
151-170	Very Stiff
171-190	Very Stiff
5991-6010	Very Stiff
6011-6	

DIST	COUNTY	ROUTE	POST MILES TOTAL PROJECT	SHEET No.	TOTAL SHEETS
08	SBd	15			

REGISTERED CIVIL ENGINEER *Hassan Ibrahim* DATE 8-14-13  
 PLANS APPROVAL DATE \_\_\_\_\_  
 No. C59016 Exp. 6-30-15  
 CIVIL ENGINEER  
 STATE OF CALIFORNIA

*The State of California or its officers or agents shall not be responsible for the accuracy or completeness of electronic copies of this plan sheet.*

FOR PLAN VIEW, SEE  
"LOG OF TEST BORINGS 3 OF 11"

**LEGEND OF BORING OPERATIONS**


**2 1/4" CONE PENETROMETER**  
 SAMPLE BORING (DRY)  
 ROTARY SAMPLE BORING (WET)  
 AUGER BORING (DRY)  
 TEST PIT  
 DIAMOND CORE BORING  
 JET BORING  
 ELECTRONIC CONE PENETROMETER

**LEGEND OF EARTH MATERIALS**  
 GRAVEL  
 SAND  
 SILT  
 CLAY  
 SANDY CLAY or CLAYEY SAND  
 SILTY SAND or SANDY SILT  
 SILTY CLAY  
 CLAYEY SILT  
 REAL and/or GRANULIC MAYER  
 COBBLES and/or BOULDERS  
 LENTICULAR ROCK  
 SEDIMENTARY ROCK  
 METAMORPHIC ROCK

**CONSISTENCY CLASSIFICATION FOR SOILS**  
 According to the Standard Penetration Test

SPt No./Blow/ft	Consistency
0-4	Very Loose
5-10	Loose
11-30	Medium Dense
31-50	Dense
51-70	Very Dense
71-90	Very Hard
91-110	Very Stiff
111-130	Stiff
131-150	Medium Stiff
151-170	Very Stiff
171-190	Hard
191-210	Very Hard
211-230	Very Hard
231-250	Very Hard
4991-5010	Very Hard

NOTE: Classification of earth material as shown on this sheet is based upon field inspection and is not to be construed to imply mechanical analysis.

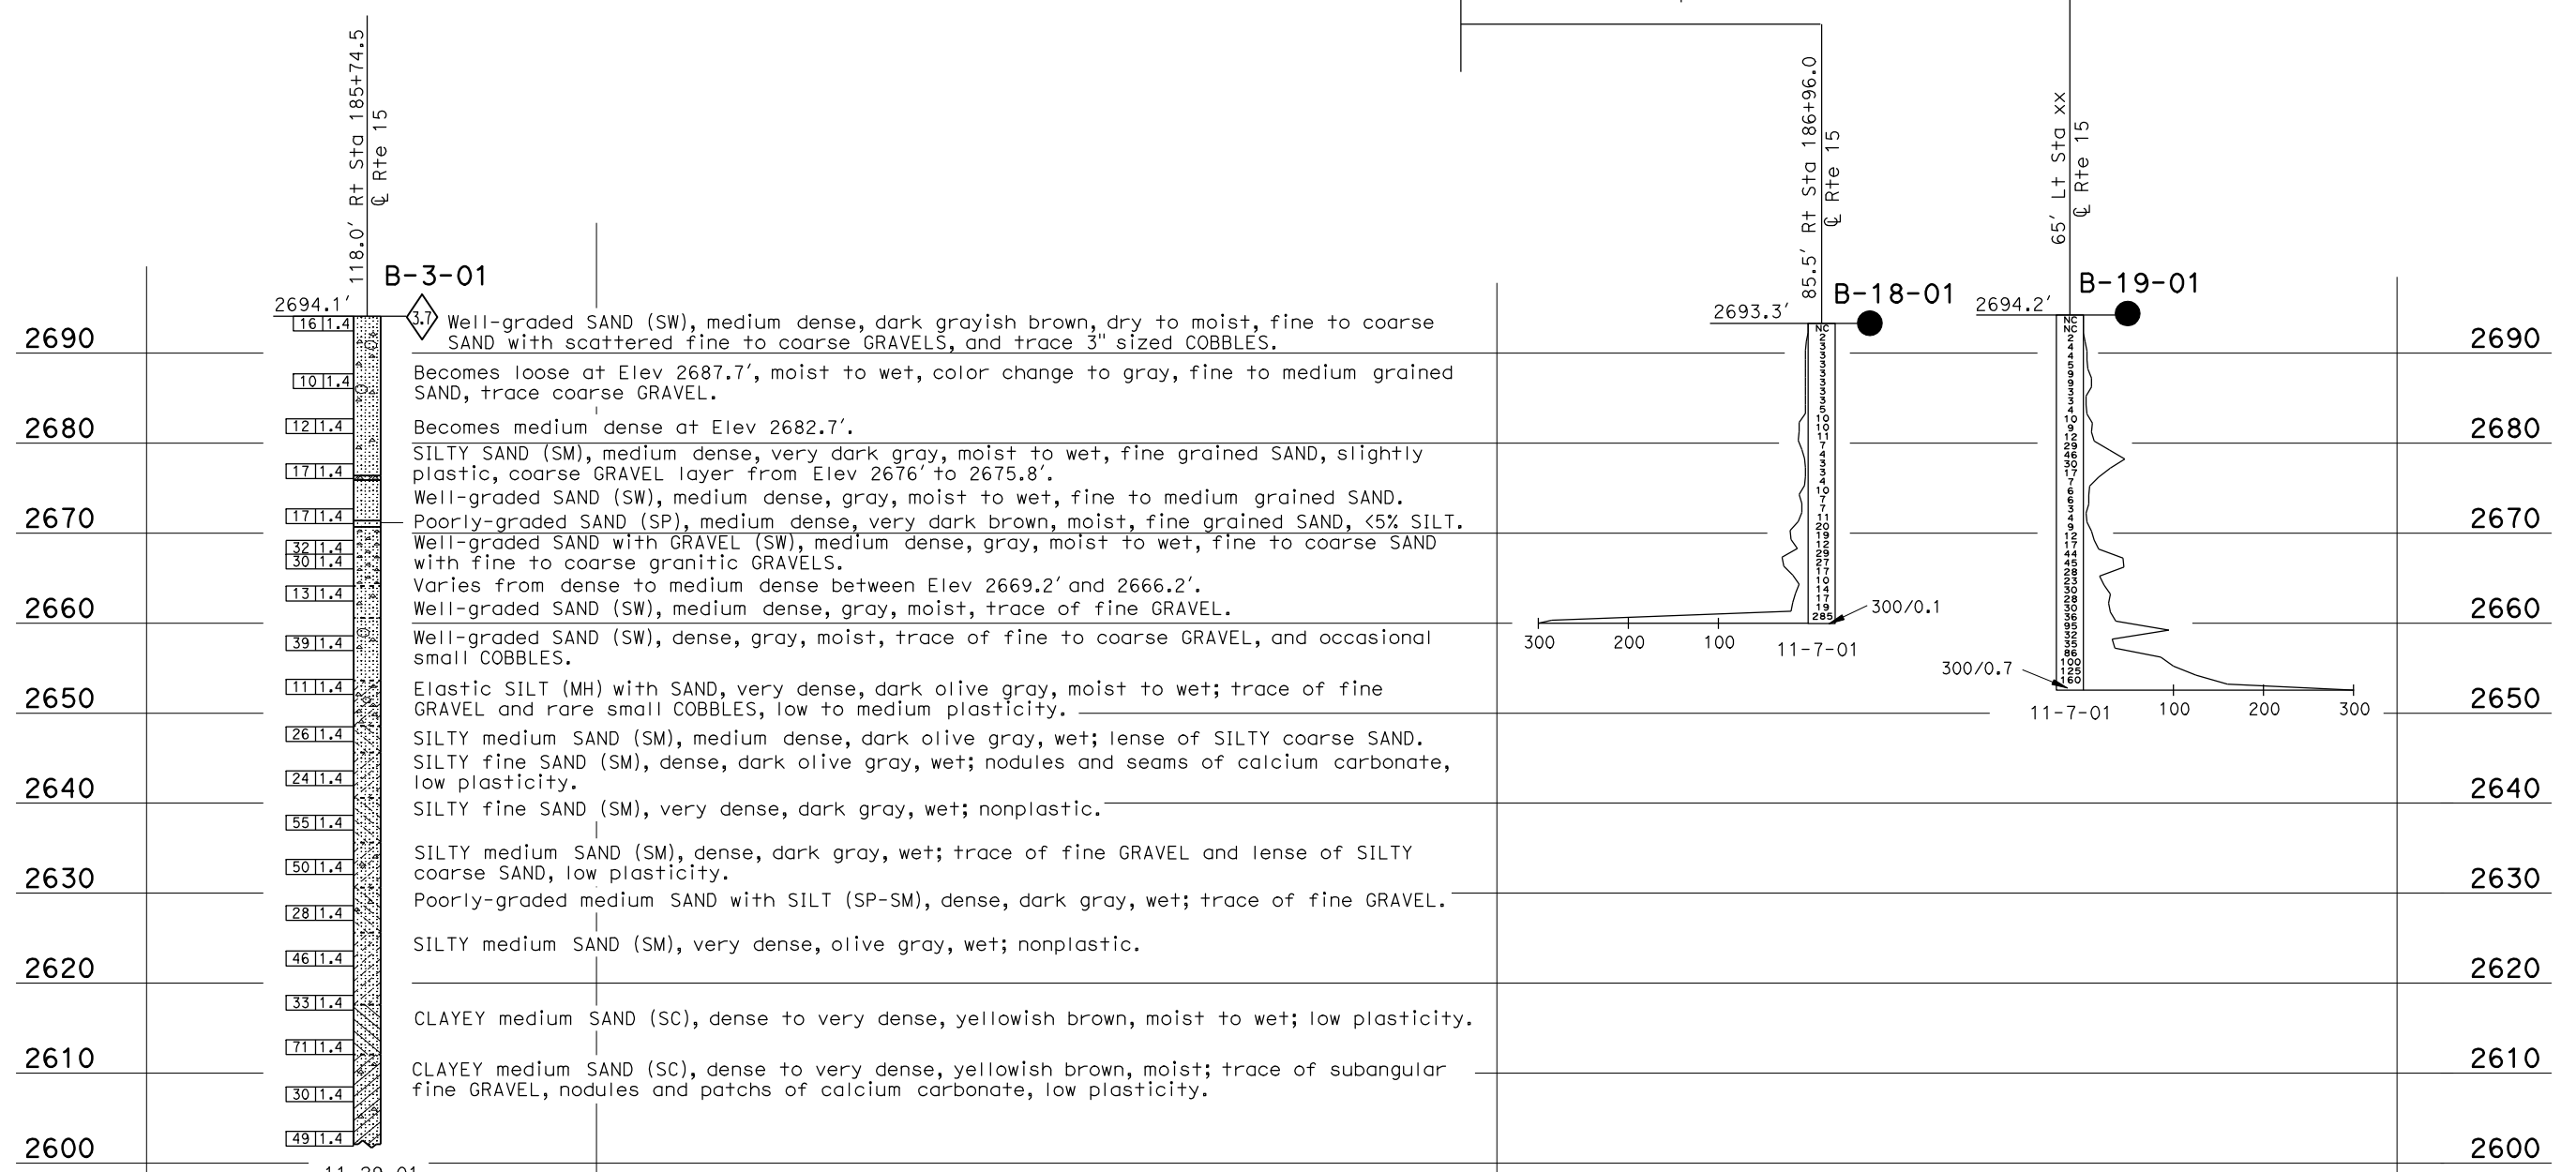

185+50	186+00	187+00	188+00
--------	--------	--------	--------

**PROFILE**  
 Horiz: 1" = 10'  
 Vert: 1" = 10'

<b>ENGINEERING SERVICES</b>	<b>MATERIALS &amp; GEOTECHNICAL SVCS</b>	FIELD INVESTIGATION BY: E. Neupert	<b>STATE OF CALIFORNIA</b> DEPARTMENT OF TRANSPORTATION	<b>DIVISION OF ENGINEERING SERVICES</b> STRUCTURE DESIGN <b>DESIGN BRANCH X</b>	BRIDGE NO. 57-1226 POST MILE 0.90	<b>MOJAVE RIVER BRIDGE (WIDEN)</b> <b>LOG OF TEST BORINGS 4 OF 11</b>
DRAWN BY I. G. Remmen	CHECKED BY A. Wardak					REVISION DATES 08-07-13



DIST	COUNTY	ROUTE	POST MILES TOTAL PROJECT	SHEET No.	TOTAL SHEETS
08	SBd	15			

REGISTERED CIVIL ENGINEER *Hassan Ibrahim* 8-14-13  
 DATE  
 PLANS APPROVAL DATE  
 REGISTERED PROFESSIONAL ENGINEER  
 No. C59016  
 Exp. 6-30-15  
 CIVIL  
 STATE OF CALIFORNIA  
 The State of California or its officers or agents shall not be responsible for the accuracy or completeness of electronic copies of this plan sheet.

FOR PLAN VIEW, SEE  
 "LOG OF TEST BORINGS 3 OF 11"

**LEGEND OF BORING OPERATIONS**

**2 1/4" CONE PENETROMETER**

**ROTORARY BORING (DRY)**

**ROTORARY BORING (WET)**

**WATER BORING**

**TEST PIT**

**STANDARD CORE BORING**

**JET BORING**

**ELECTRONIC CONE PENETROMETER**


**LEGEND OF EARTH MATERIALS**

**CONSISTENCY CLASSIFICATION FOR SOILS**

According to the Standard Penetration Test

NOTE: Classification of earth material as shown on this sheet is based upon field inspection and is not to be construed to imply mechanical analysis.

2690	Well-graded SAND (SW), loose, very pale brown, dry to moist, fine to coarse grained.
2680	Becomes medium dense, color changes to grayish brown, fine to medium grained, wet.
2670	Well-graded SAND with GRAVEL (SW), medium dense, light bluish gray, wet, contains coarse GRAVELS up to 3" in size, fine to coarse grained SAND.
2660	Becomes dense and color changes to bluish gray at Elev 2661.6', increase in subangular coarse GRAVEL to COBBLES sized ROCK clasts.
2650	Poorly-graded SAND (SP), ≤5% SILT, medium dense, dark greenish gray, moist, fine grained SAND, with trace fine grained GRAVEL.
2640	Becomes very dense at Elev 2646.6'.
2630	Well-graded SAND (SW), dense, dark greenish gray, moist to wet, fine to medium grained SAND, trace fine GRAVELS. Becomes very dense, color changes to greenish gray at Elev 2636.1' Color changes to yellowish brown at Elev 2634.8'.
2620	Becomes dense at Elev 2621.6'.
2610	Color change to dark yellowish brown at Elev 2619.4', scattered Zones of weak to moderate cementation, becomes very dense. No zones of cementation.
2600	Color change to yellowish brown at Elev 2611.1'. Strongly cemented between Elev 2609.4' to 2609.1'.

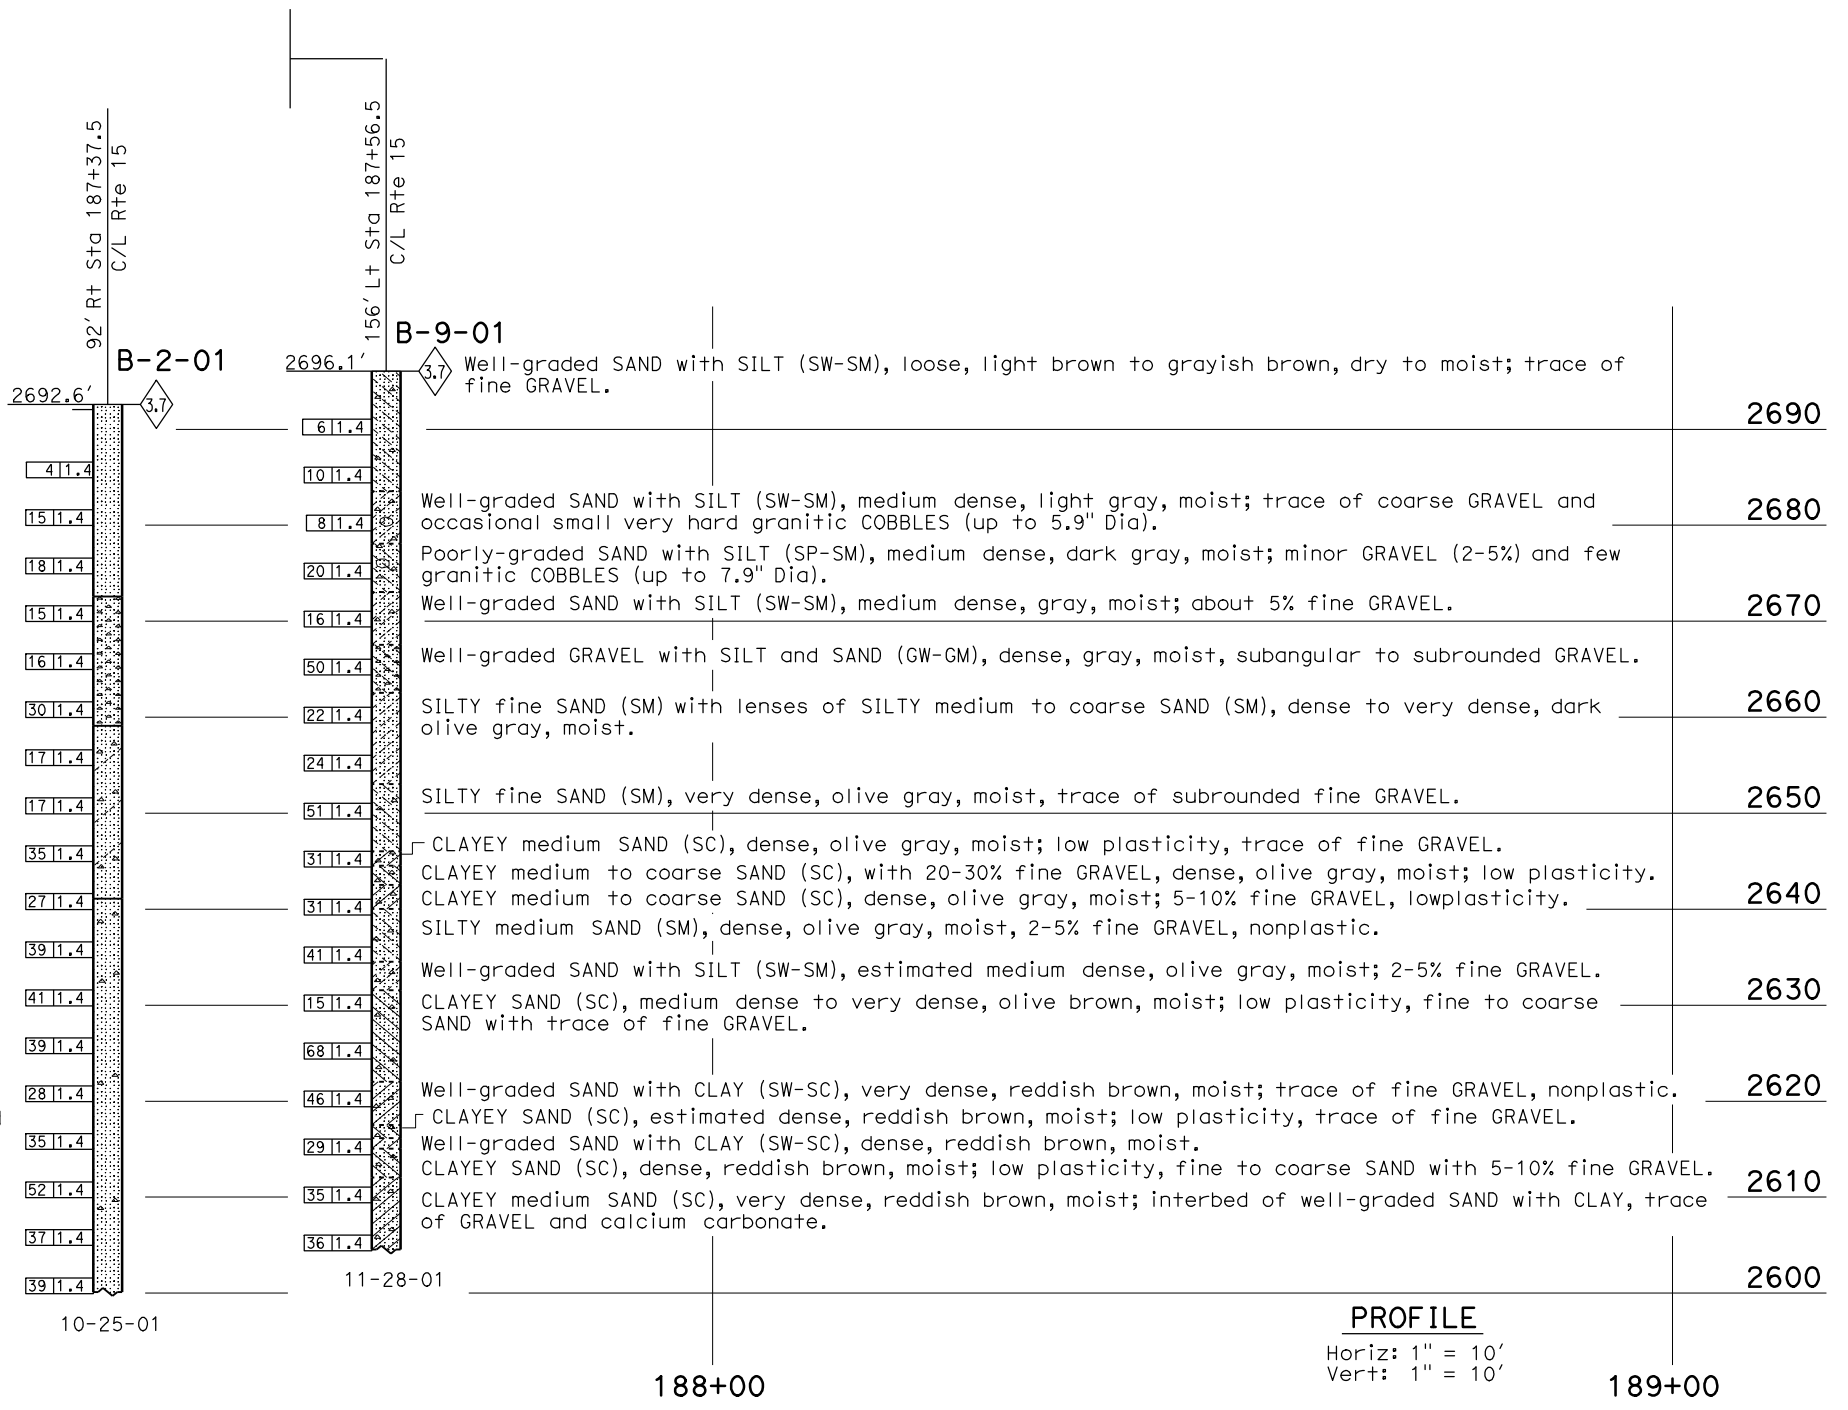

**PROFILE**  
 Horiz: 1" = 10'  
 Vert: 1" = 10'

<b>ENGINEERING SERVICES</b>	<b>MATERIALS &amp; GEOTECHNICAL SVCS</b>	FIELD INVESTIGATION BY: E. Neupert, F. Gerami	<b>STATE OF CALIFORNIA</b> DEPARTMENT OF TRANSPORTATION	<b>DIVISION OF ENGINEERING SERVICES</b> STRUCTURE DESIGN DESIGN BRANCH X	BRIDGE NO. 54-0483 POST MILE 43.8	<b>MOJAVE RIVER BRIDGE (WIDEN)</b> <b>LOG OF TEST BORINGS 5 OF 11</b>
DRAWN BY I. G. Remmen	CHECKED BY A. Wardak					

DIST	COUNTY	ROUTE	POST MILES TOTAL PROJECT	SHEET No.	TOTAL SHEETS
08	SBd	15			

8-14-13  
DATE

REGISTERED CIVIL ENGINEER

Hassan Ibrahim  
No. C59016  
Exp. 6-30-15  
CIVIL  
STATE OF CALIFORNIA

PLANS APPROVAL DATE

The State of California or its officers or agents shall not be responsible for the accuracy or completeness of electronic copies of this plan sheet.

FOR PLAN VIEW, SEE  
"LOG OF TEST BORINGS 3 OF 11"

**LEGEND OF BORING OPERATIONS**

**2 1/4" CONE PENETROMETER**  
 CONE PENETROMETER TEST  
 Pressure measured along sleeve friction element (150 sq. in.) divided by pressure on tip element (10 sq. in.)

**ROTARY SAMPLE BORING (WET)**  
 ROTARY SAMPLE BORING (WET)  
 No count recorded  
 Pushed  
 Driving rate in seconds per foot (using a No. 2 air hammer) (ft/min or as noted)  
 Friction Ratio (fs) Tip Bearing (TSB)

**ROTARY SAMPLE BORING (DRY)**  
 ROTARY SAMPLE BORING (DRY)  
 Blows per foot (15 and 30" free fall)  
 Pulled Pipe  
 Description of materials  
 Ground water surface Elev.  
 Date  
 Sample taken

**TEST PIT**  
 TEST PIT  
 Unconfined strength (lb/sq. ft)  
 Shear strength (lb/sq. ft)  
 Vane Shear

**DIAMOND CORE BORING**  
 DIAMOND CORE BORING  
 Description of material  
 Unit weight (lb/cu ft)  
 Moisture %  
 Consolidation test  
 Compressible material change  
 Unrecoverable material change

**ELECTRONIC CONE PENETROMETER**  
 ELECTRONIC CONE PENETROMETER

**LEGEND OF EARTH MATERIALS**


GRAVEL  
 SAND  
 SILT  
 CLAY  
 SANDY CLAY or CLAYEY SAND  
 CLAYEY SILT or SILTY SAND  
 SILTY CLAY

CLAYEY SILT  
 GRANULIC MAYER  
 COBBLES and/or BOULDERS  
 LIMONITE ROCK  
 SEDIMENTARY ROCK  
 METAMORPHIC

**CONSISTENCY CLASSIFICATION FOR SOILS**

According to the Standard Penetration Test

SPT N <sub>60</sub> (Blows/foot)	Consistency
0-4	Very Loose
5-10	Loose
11-30	Medium Dense
31-50	Dense
51-70	Very Dense
71-100	Very Hard

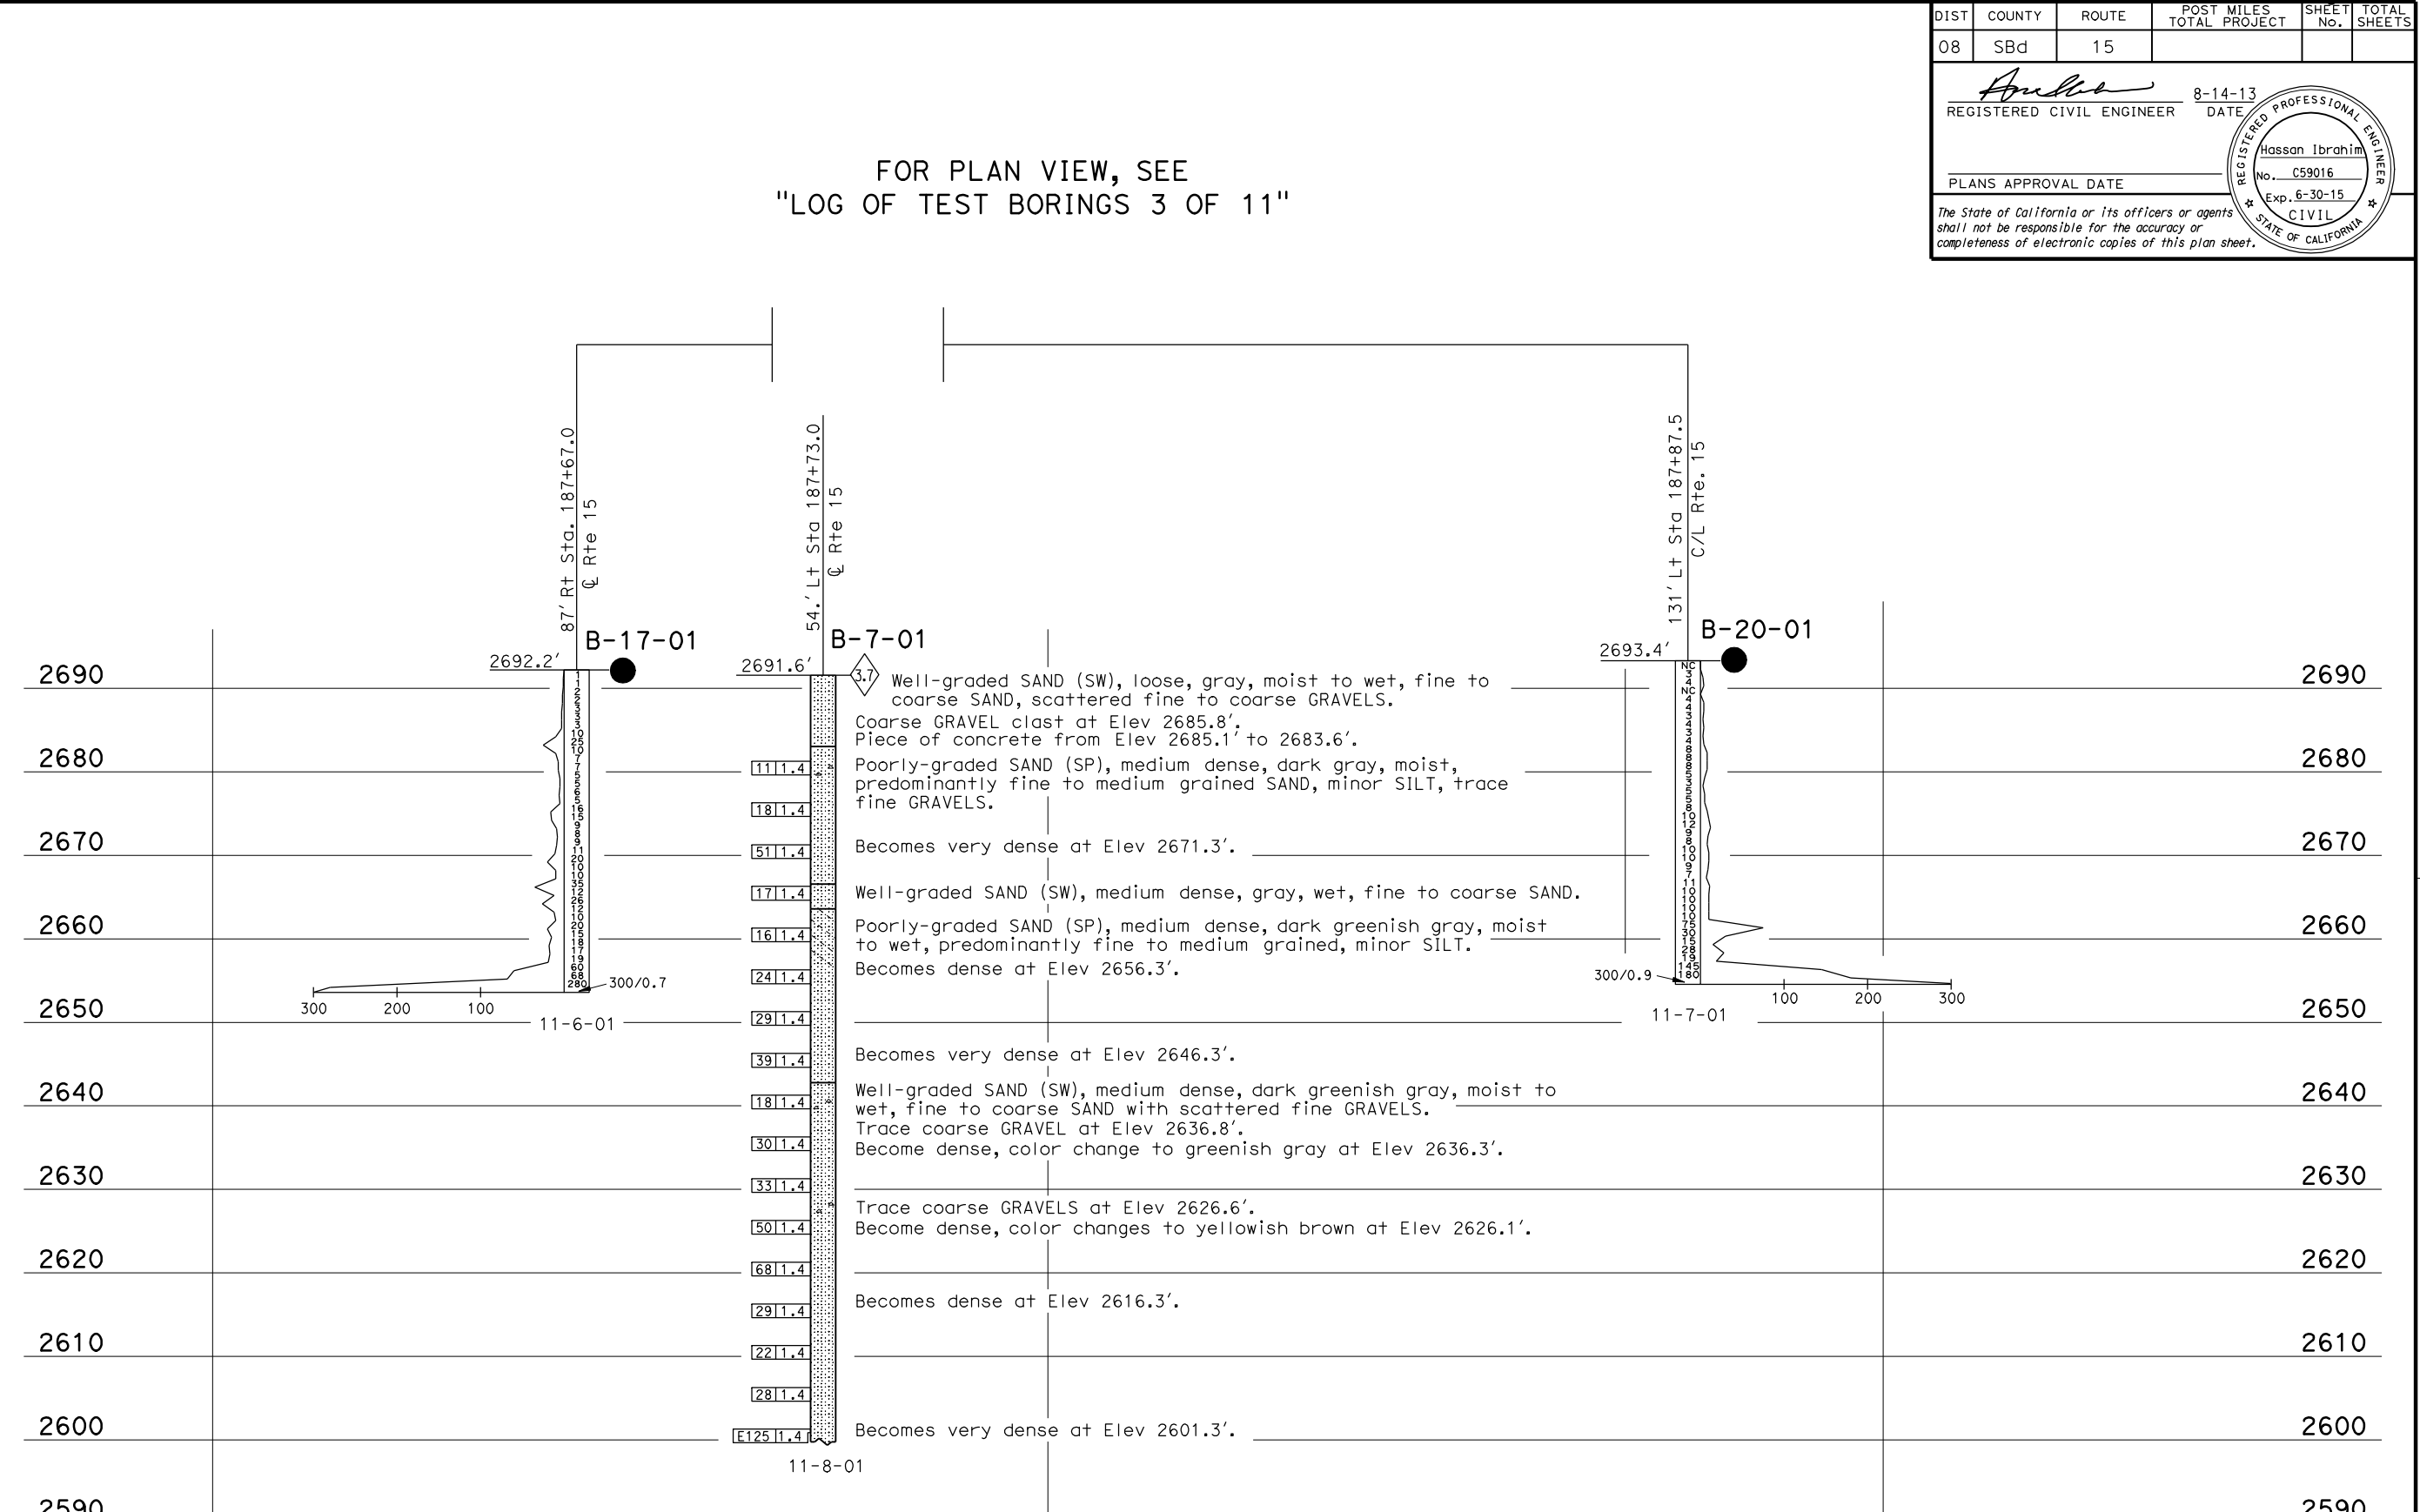

187+00	188+00	189+00	<b>PROFILE</b> Horiz: 1" = 10' Vert: 1" = 10'
--------	--------	--------	---

<b>ENGINEERING SERVICES</b>	<b>MATERIALS &amp; GEOTECHNICAL SVCS</b>	FIELD INVESTIGATION BY: E. Neupert, F. Gerami	<b>STATE OF CALIFORNIA</b> DEPARTMENT OF TRANSPORTATION	<b>DIVISION OF ENGINEERING SERVICES</b> STRUCTURE DESIGN <b>DESIGN BRANCH X</b>	BRIDGE NO. 54-0483 POST MILE 43.8	<b>MOJAVE RIVER BRIDGE (WIDEN)</b> <b>LOG OF TEST BORINGS 6 OF 11</b>
DRAWN BY I. G. Remmen	CHECKED BY A. Wardak					REVISION DATES 08-07-13

DIST	COUNTY	ROUTE	POST MILES TOTAL PROJECT	SHEET No.	TOTAL SHEETS
08	SBd	15			

REGISTERED CIVIL ENGINEER *Hassan Ibrahim* DATE 8-14-13  
 No. C59016 Exp. 6-30-15  
 CIVIL ENGINEER STATE OF CALIFORNIA

PLANS APPROVAL DATE \_\_\_\_\_

*The State of California or its officers or agents shall not be responsible for the accuracy or completeness of electronic copies of this plan sheet.*

FOR PLAN VIEW, SEE  
"LOG OF TEST BORINGS 3 OF 11"

**LEGEND OF BORING OPERATIONS**

**2 1/4" CONE PENETROMETER SAMPLE BORING (DRY)**

**ROTARY SAMPLE BORING (WET)**

**WAGER BORING (DRY)**

**TEST PIT**

**DIAMOND CORE BORING**

**JET BORING**

**ELECTRONIC CONE PENETROMETER**

**LEGEND OF EARTH MATERIALS**


**CONSISTENCY CLASSIFICATION FOR SOILS**

According to the Standard Penetration Test

SPN No. (Blows/foot)	Consistency
0-4	Very Loose
5-10	Loose
11-30	Medium Dense
31-50	Dense
51-70	Very Dense
71-90	Very Hard
91-110	Extremely Hard

NOTE: Classification of earth material as shown on this sheet is based upon field inspection and is not to be construed to imply mechanical analysis.

2690	Well-graded SAND (SW), loose, gray, moist to wet, fine to coarse SAND.
2680	Poorly-graded SAND (SP), loose, dark gray, moist to wet, predominantly fine grained with some medium grained SAND. Well-graded SAND (SW), medium dense, gray, moist to wet, fine to coarse SAND with trace fine to coarse GRAVELS.
2670	Becomes dense at Elev 2665.6'.
2660	Poorly-graded SAND (SP), medium dense, dark greenish gray, wet, predominantly fine to medium grained with trace coarse SAND.
2650	Minor amount of SILT content at Elev 2655.6'.
2640	Becomes very dense at Elev 2645.6', trace coarse GRAVEL.
2630	Becomes dense at Elev 2640.6'.
2620	Color changes to dark yellowish brown at Elev 2629.6'. Becomes very dense at Elev 2625.6'.
2610	Well-graded SAND (SW), dense, yellowish brown, moist to wet, fine to coarse SAND, trace fine GRAVELS.
2600	Poorly-graded SAND (SP), medium dense, yellowish brown, moist to wet, predominantly fine to medium grained. Becomes dense at Elev 2610.6'.
2590	Trace fine GRAVELS at Elev 2604.1'.

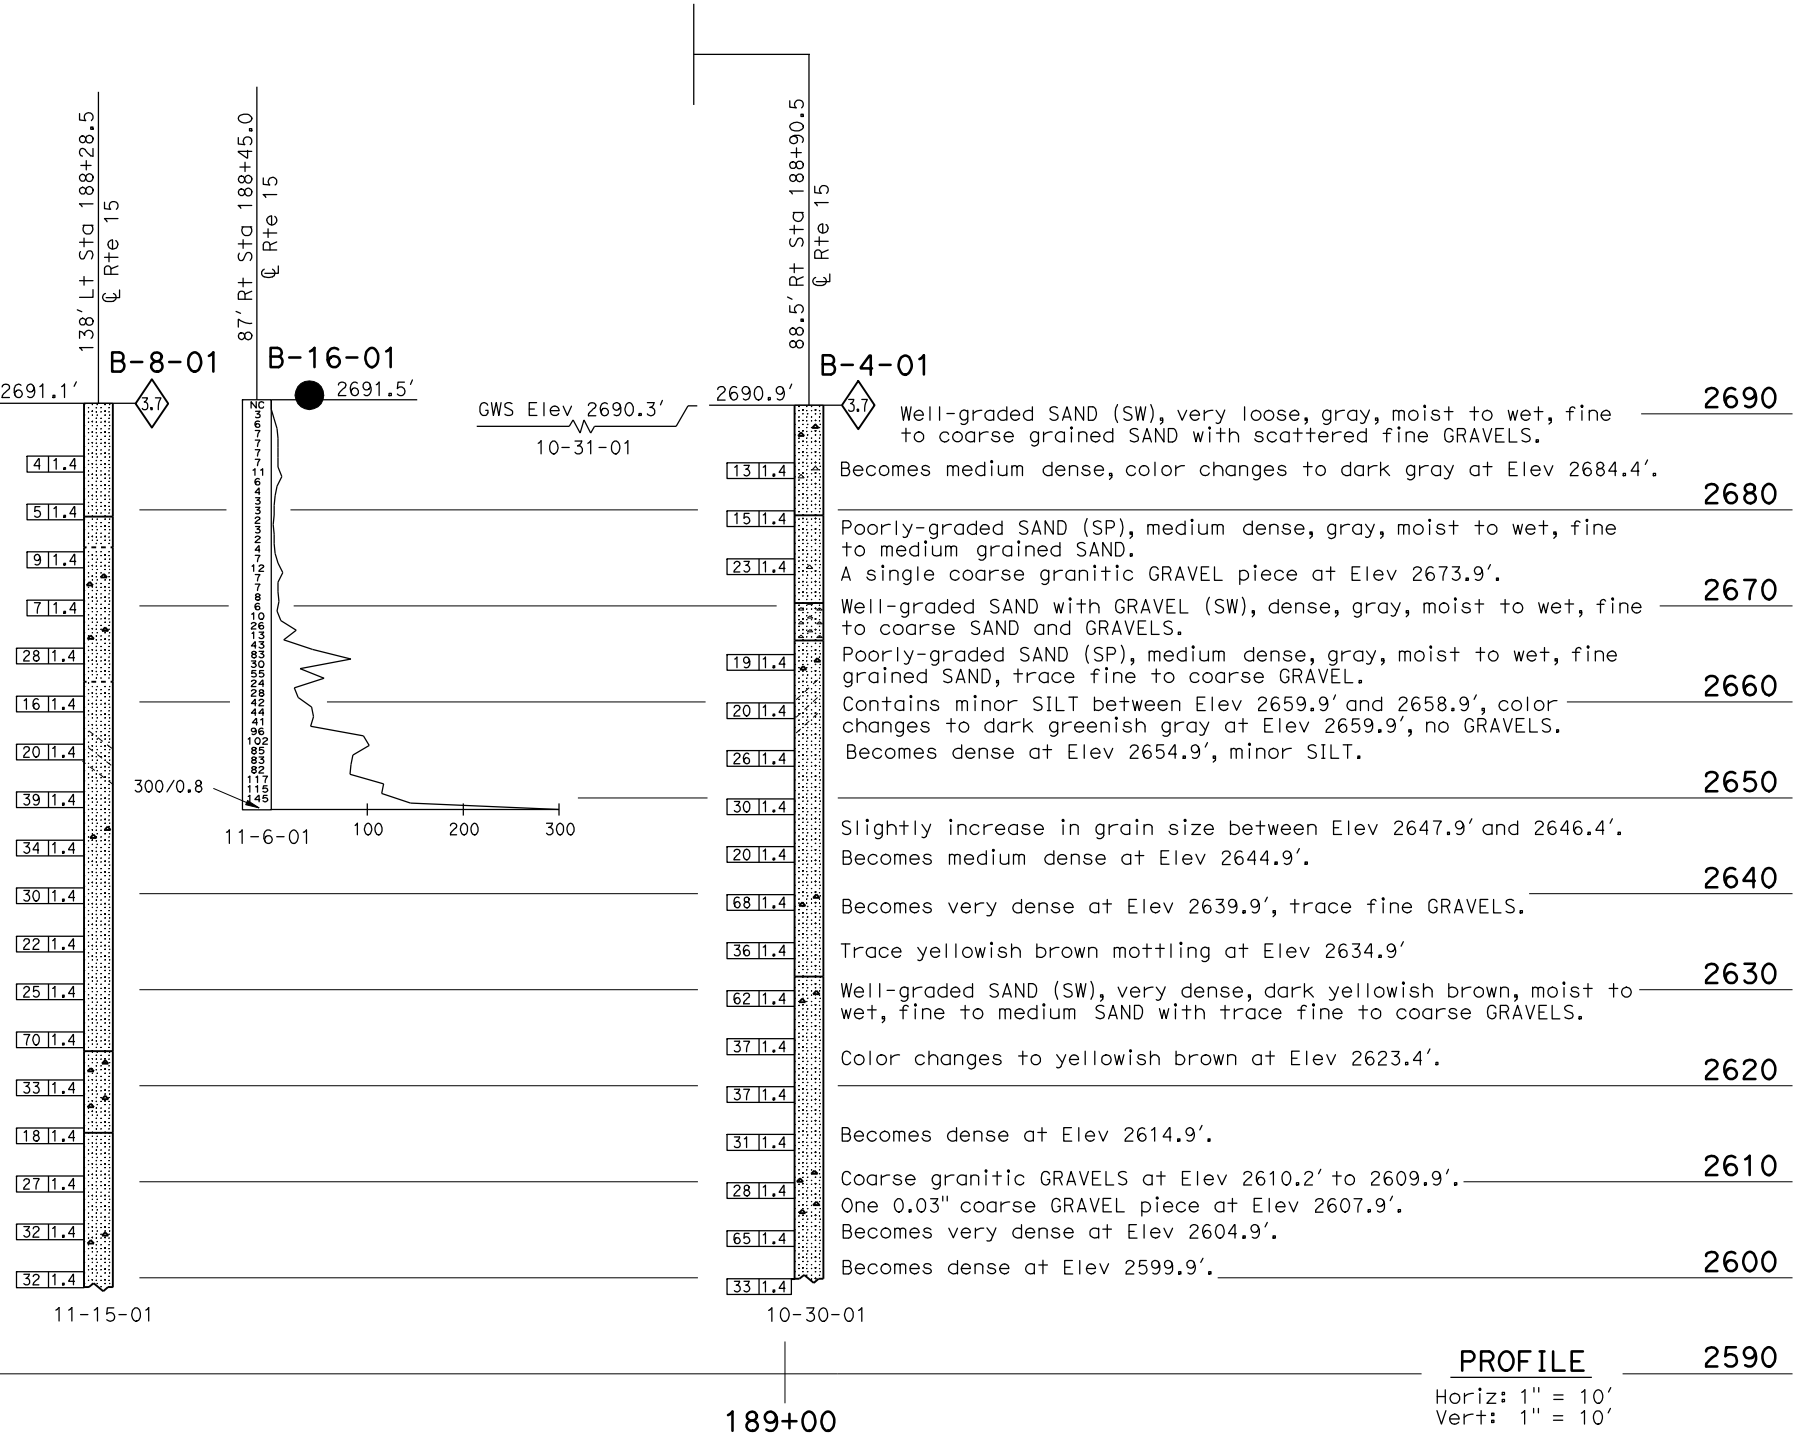

<b>ENGINEERING SERVICES</b>	<b>MATERIALS &amp; GEOTECHNICAL SVCS</b>	FIELD INVESTIGATION BY: E. Neupert, F. Gerami	<b>STATE OF CALIFORNIA</b> DEPARTMENT OF TRANSPORTATION	<b>DIVISION OF ENGINEERING SERVICES</b> STRUCTURE DESIGN <b>DESIGN BRANCH X</b>	BRIDGE NO. 54-0483 POST MILE 43.8	<b>MOJAVE RIVER BRIDGE (WIDEN)</b> <b>LOG OF TEST BORINGS 7 OF 11</b>
DRAWN BY I. G. Remmen	CHECKED BY A. Wardak					REVISION DATES 08-07-13



DIST	COUNTY	ROUTE	POST MILES TOTAL PROJECT	SHEET No.	TOTAL SHEETS
08	SBD	15			

REGISTERED CIVIL ENGINEER *Hassan Ibrahim* DATE 8-14-13  
 PLANS APPROVAL DATE \_\_\_\_\_  
 No. C59016 Exp. 6-30-15  
 CIVIL ENGINEER STATE OF CALIFORNIA  
 The State of California or its officers or agents shall not be responsible for the accuracy or completeness of electronic copies of this plan sheet.

FOR PLAN VIEW, SEE "LOG OF TEST BORINGS 3 OF 11"

**LEGEND OF BORING OPERATIONS**

**2 1/4" CONE PENETROMETER**


**LEGEND OF EARTH MATERIALS**

**CONSISTENCY CLASSIFICATION FOR SOILS**

According to the Standard Penetration Test

SPN No. (Blows/foot)	Consistency
0-4	Very Loose
5-10	Loose
11-30	Medium Dense
31-50	Dense
51-70	Very Dense
71-90	Very Dense
91-110	Very Dense
2571-2590	Very Dense

NOTE: Classification of earth material as shown on this sheet is based upon field inspection and is not to be construed to imply mechanical analysis.

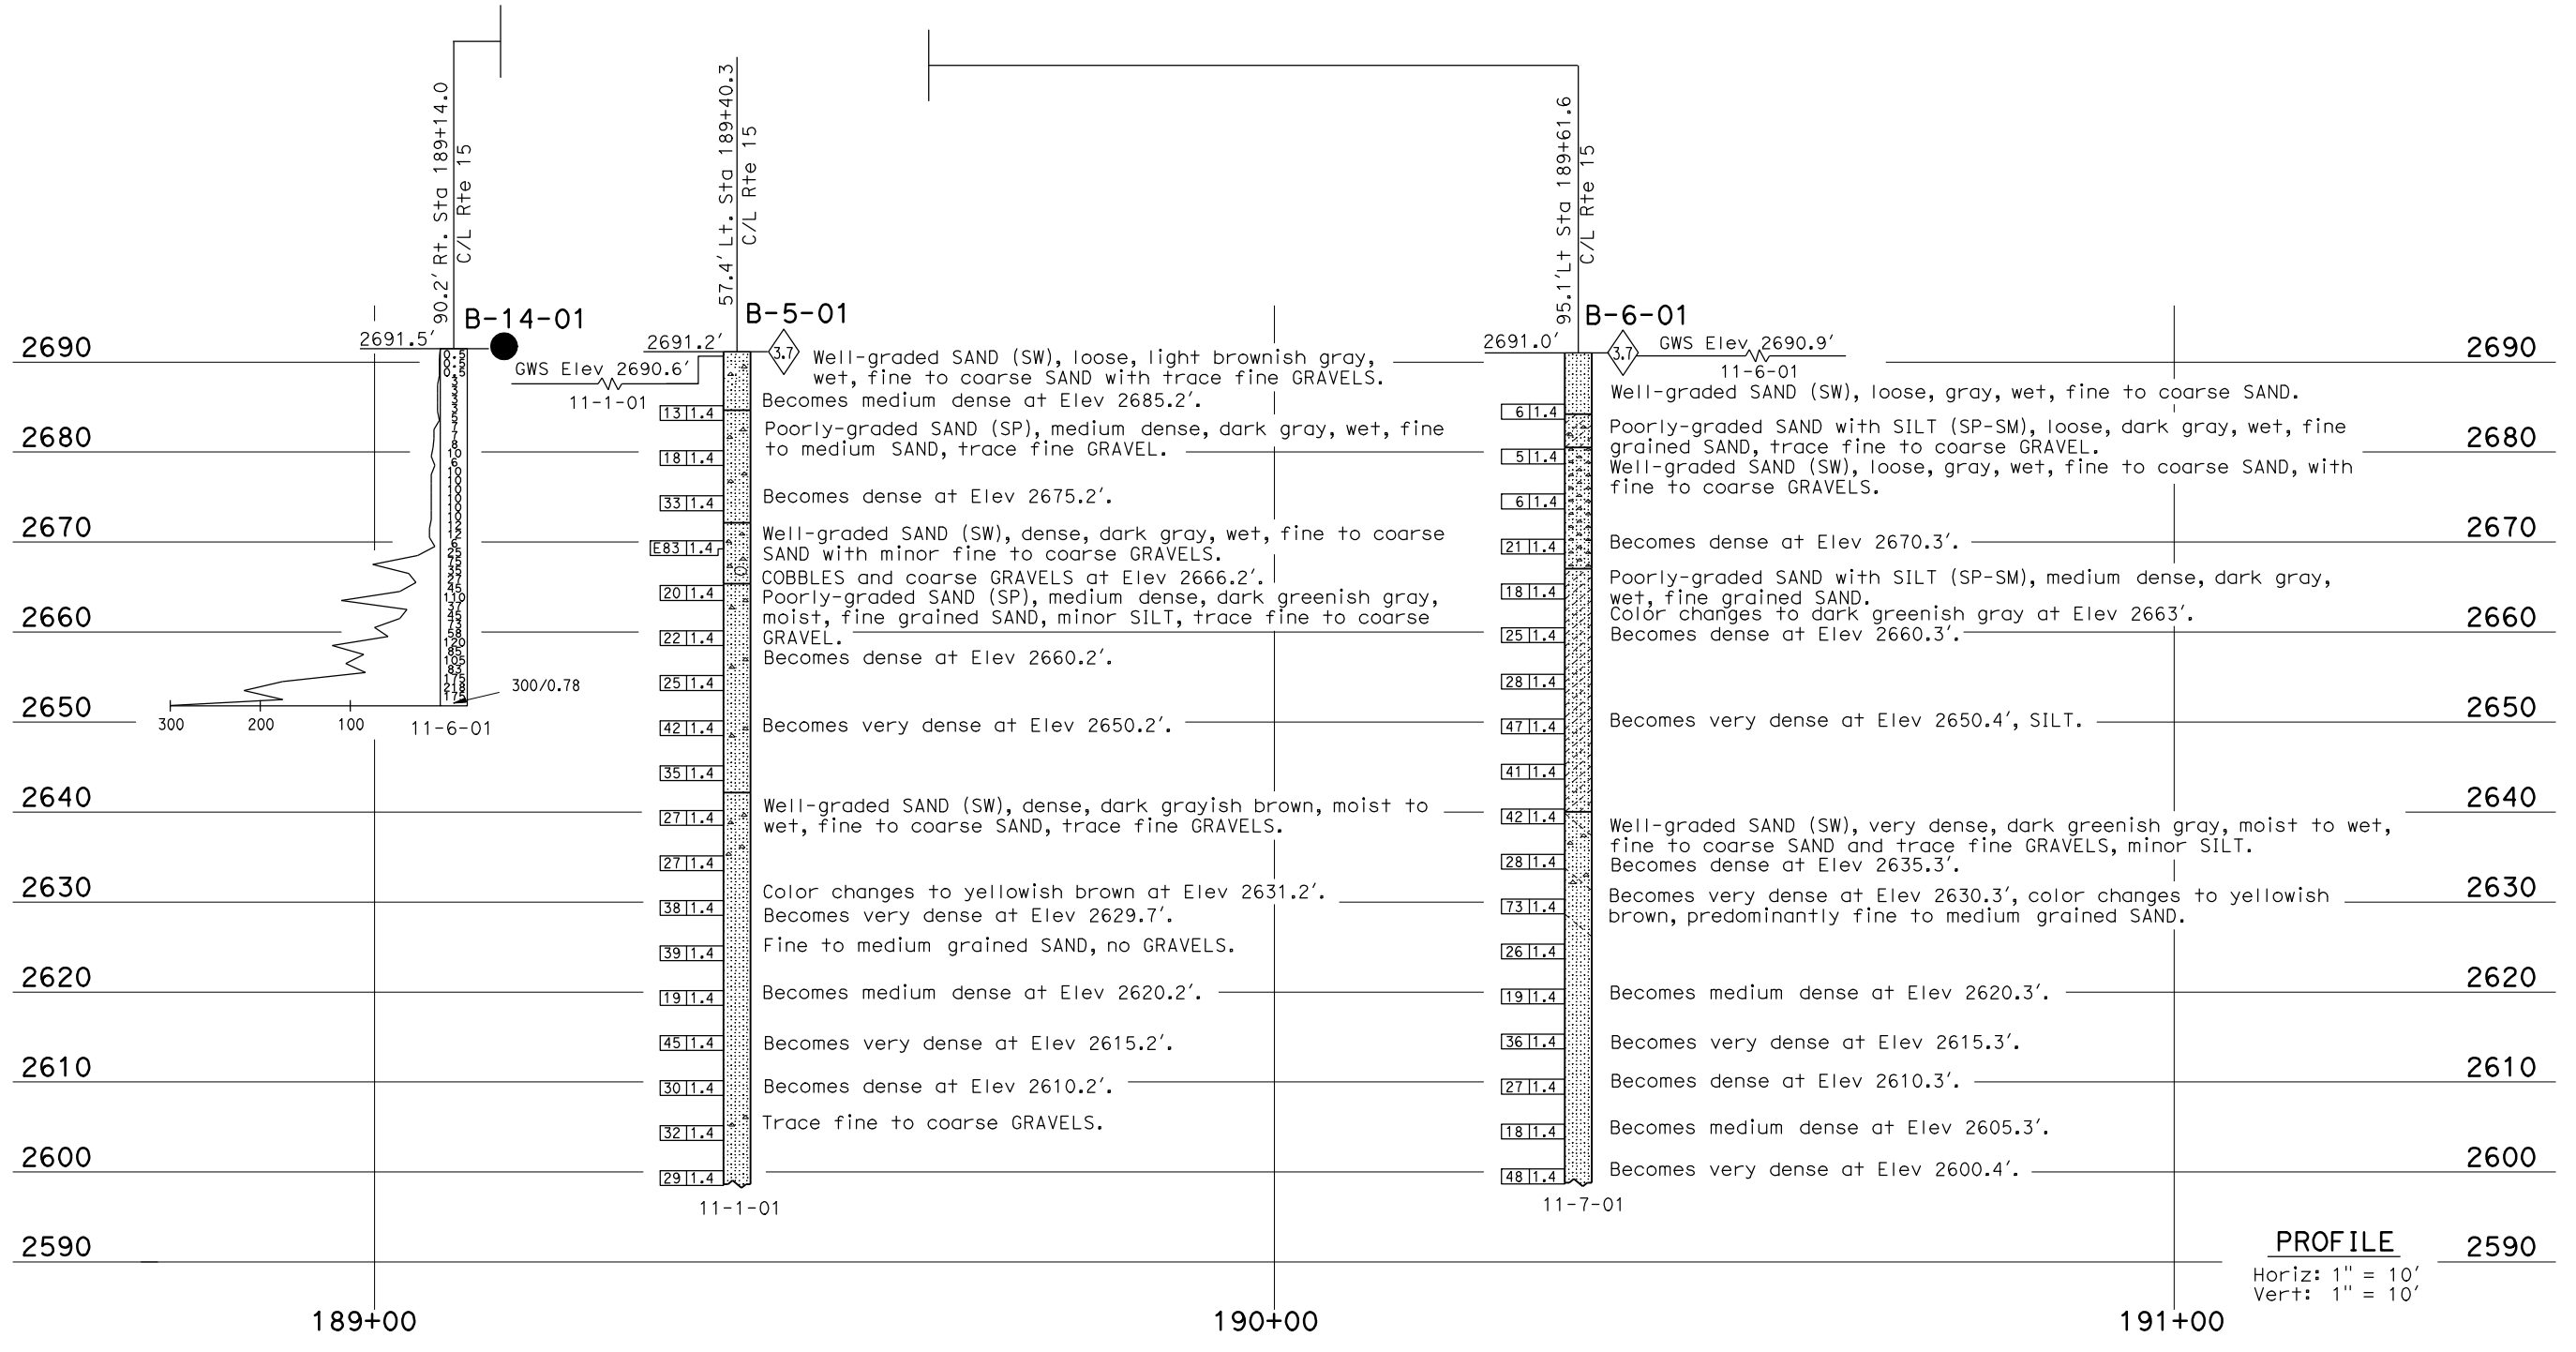

<b>ENGINEERING SERVICES</b>	<b>MATERIALS &amp; GEOTECHNICAL SVCS</b>	FIELD INVESTIGATION BY: E. Neupert, F. Gerami	<b>STATE OF CALIFORNIA</b> DEPARTMENT OF TRANSPORTATION	<b>DIVISION OF ENGINEERING SERVICES</b> STRUCTURE DESIGN <b>DESIGN BRANCH X</b>	BRIDGE NO. 54-0483 POST MILE 43.8	<b>MOJAVE RIVER BRIDGE (WIDEN)</b> <b>LOG OF TEST BORINGS 8 OF 11</b>
DRAWN BY I. G. Remmen	CHECKED BY A. Wardak					

DIST	COUNTY	ROUTE	POST MILES TOTAL PROJECT	SHEET No.	TOTAL SHEETS
08	SBd	15			

REGISTERED CIVIL ENGINEER *Hassan Ibrahim* 8-14-13 DATE  
 PLANS APPROVAL DATE  
 No. C59016  
 Exp. 6-30-15  
 CIVIL  
 STATE OF CALIFORNIA  
 The State of California or its officers or agents shall not be responsible for the accuracy or completeness of electronic copies of this plan sheet.

FOR PLAN VIEW, SEE  
"LOG OF TEST BORINGS 3 OF 11"

**LEGEND OF BORING OPERATIONS**

**2 1/4" CONE PENETROMETER**

**3/8" SAMPLE BORING (DRY)**

**1 1/2" AUGER BORING (DRY)**

**TEST PIT**

**DIAMOND CORE BORING**

**JET BORING**

**ELECTRONIC CONE PENETROMETER**


**LEGEND OF EARTH MATERIALS**

**CONSISTENCY CLASSIFICATION FOR SOILS**

According to the Standard Penetration Test

SPN No. (Blows/foot)	Consistency
0-4	Very Loose
5-10	Loose
11-30	Medium Dense
31-50	Dense
51-70	Very Dense

NOTE: Classification of earth material as shown on this sheet is based upon field inspection and is not to be construed to imply mechanical analysis.

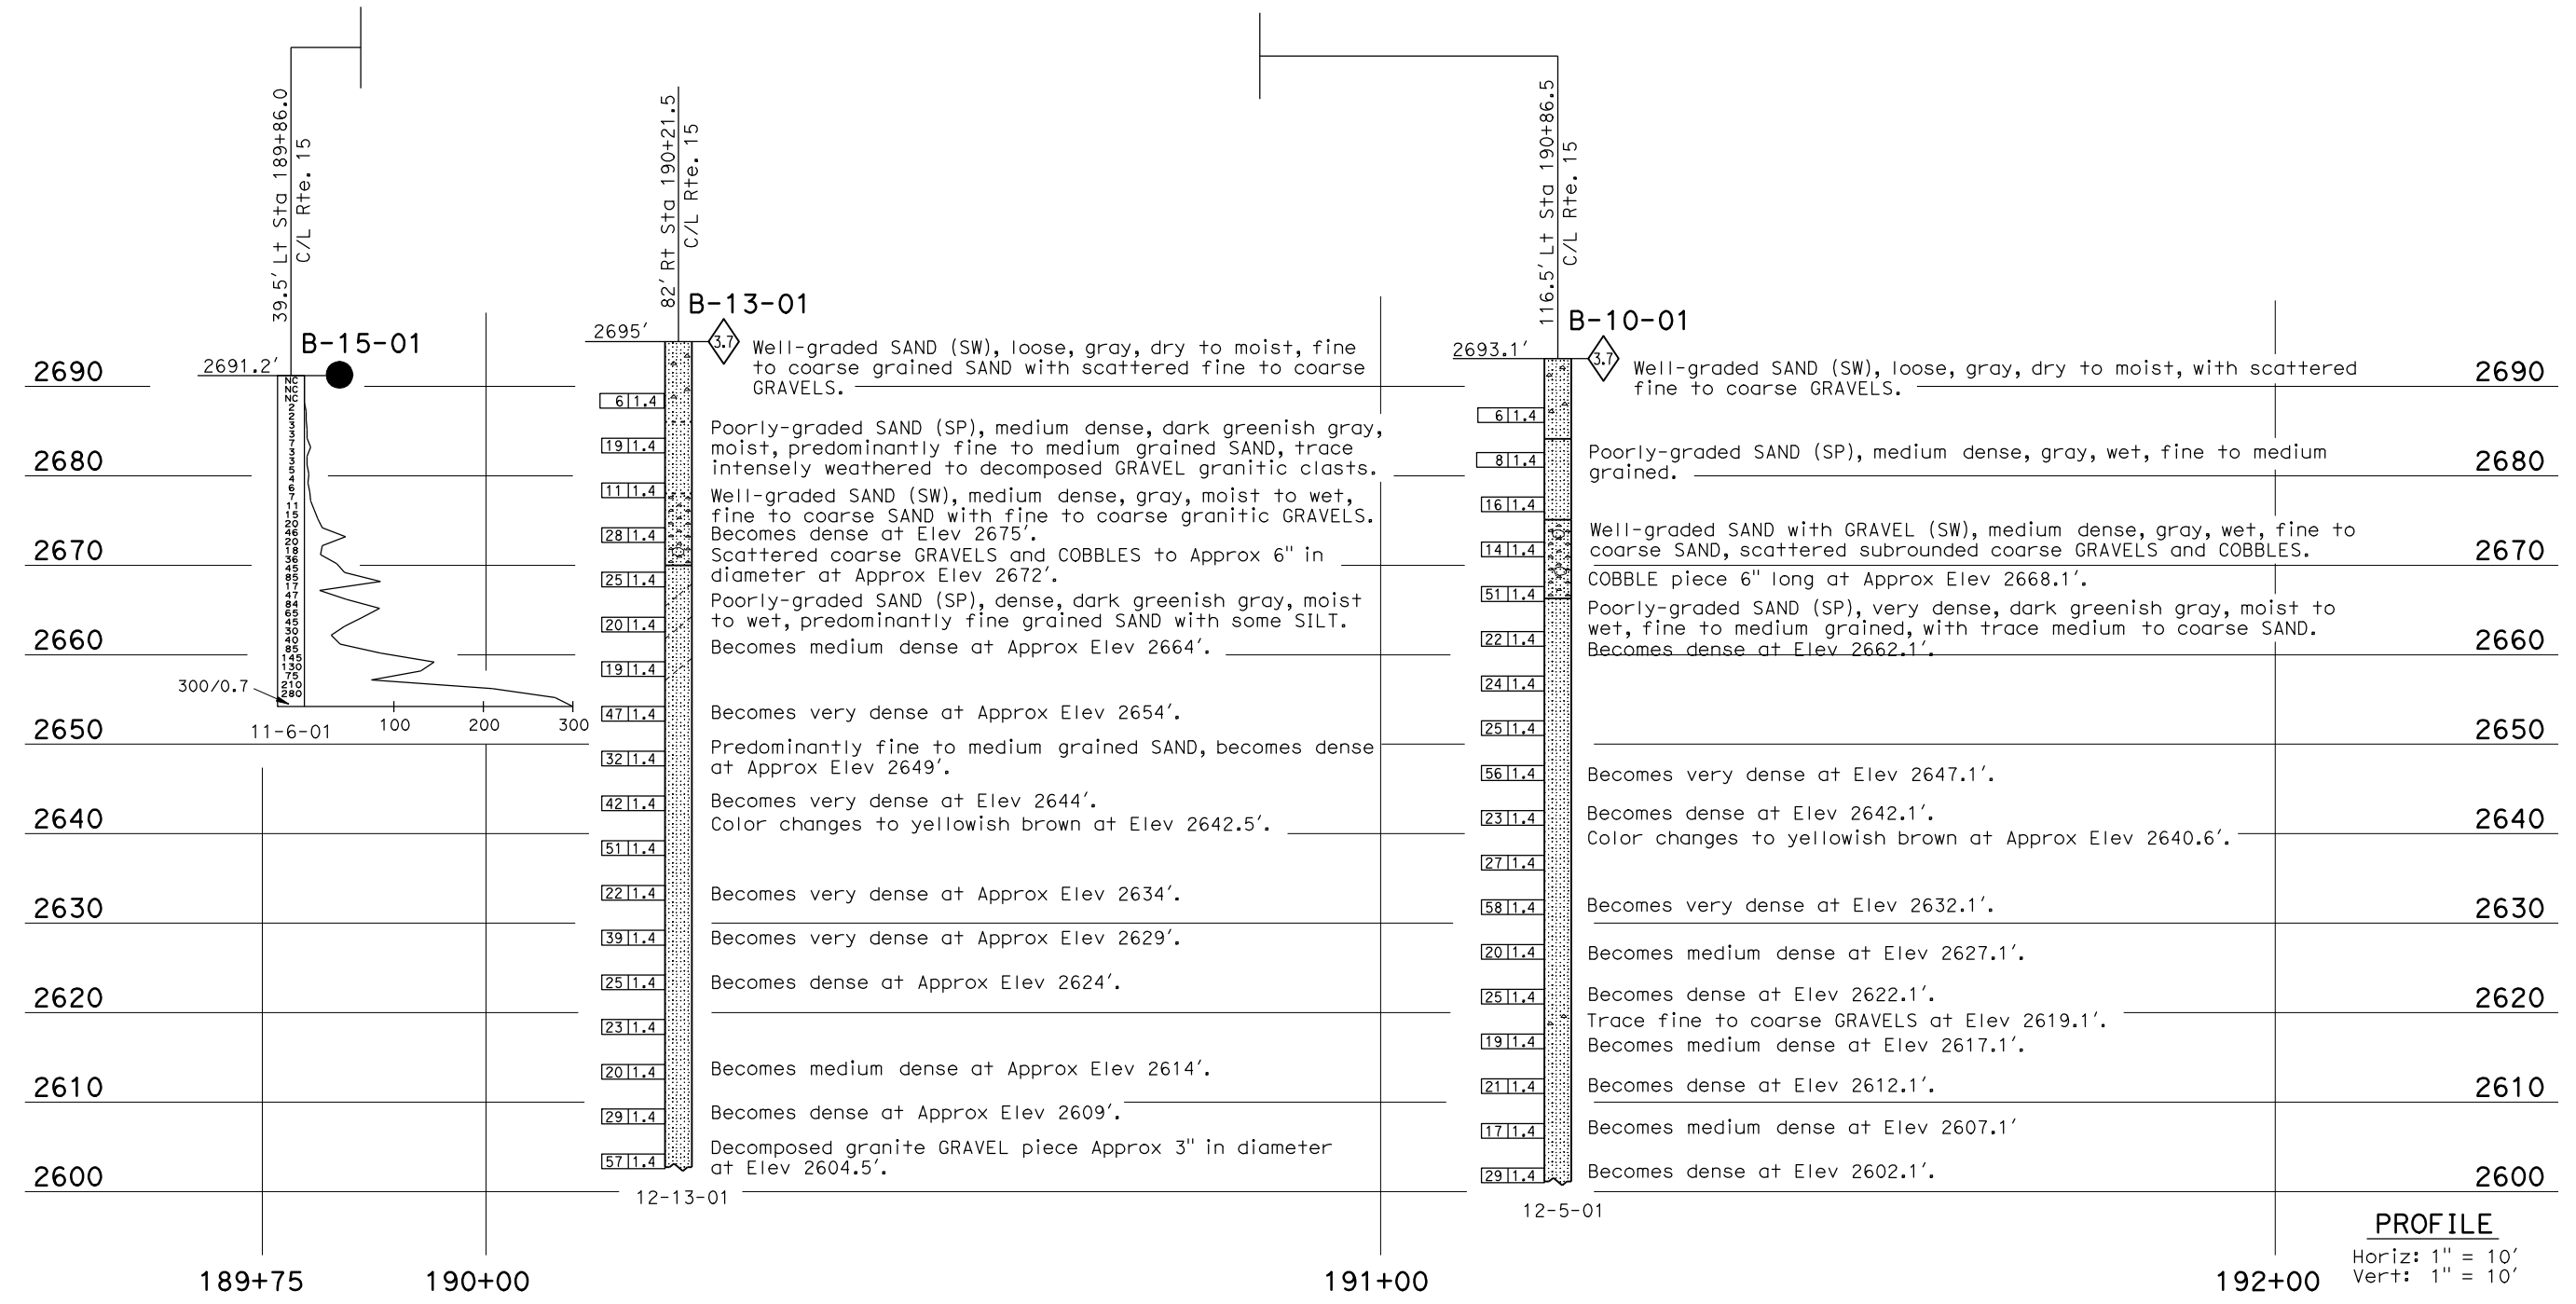

<b>ENGINEERING SERVICES</b>	<b>MATERIALS &amp; GEOTECHNICAL SVCS</b>	FIELD INVESTIGATION BY: E. Neupert, F. Gerami	<b>STATE OF CALIFORNIA</b> DEPARTMENT OF TRANSPORTATION	<b>DIVISION OF ENGINEERING SERVICES</b> STRUCTURE DESIGN <b>DESIGN BRANCH X</b>	BRIDGE NO. 54-0483 POST MILE 43.8	<b>MOJAVE RIVER BRIDGE (WIDEN)</b> <b>LOG OF TEST BORINGS 9 OF 11</b>
DRAWN BY I. G. Remmen	CHECKED BY A. Wardak					

DIST	COUNTY	ROUTE	POST MILES TOTAL PROJECT	SHEET No.	TOTAL SHEETS
08	SBd	15			

REGISTERED CIVIL ENGINEER *Hassan Ibrahim* DATE 8-14-13  
 PLANS APPROVAL DATE \_\_\_\_\_  
 No. C59016 Exp. 6-30-15  
 CIVIL ENGINEER  
 STATE OF CALIFORNIA

*The State of California or its officers or agents shall not be responsible for the accuracy or completeness of electronic copies of this plan sheet.*

FOR PLAN VIEW, SEE "LOG OF TEST BORINGS 3 OF 11"

**LEGEND OF BORING OPERATIONS**

**LEGEND OF EARTH MATERIALS**


**CONSISTENCY CLASSIFICATION FOR SOILS**

**LEGEND OF BORING OPERATIONS**

**LEGEND OF EARTH MATERIALS**

**CONSISTENCY CLASSIFICATION FOR SOILS**

NOTE: Classification of earth material as shown on this sheet is based upon field inspection and is not to be construed to imply mechanical analysis.

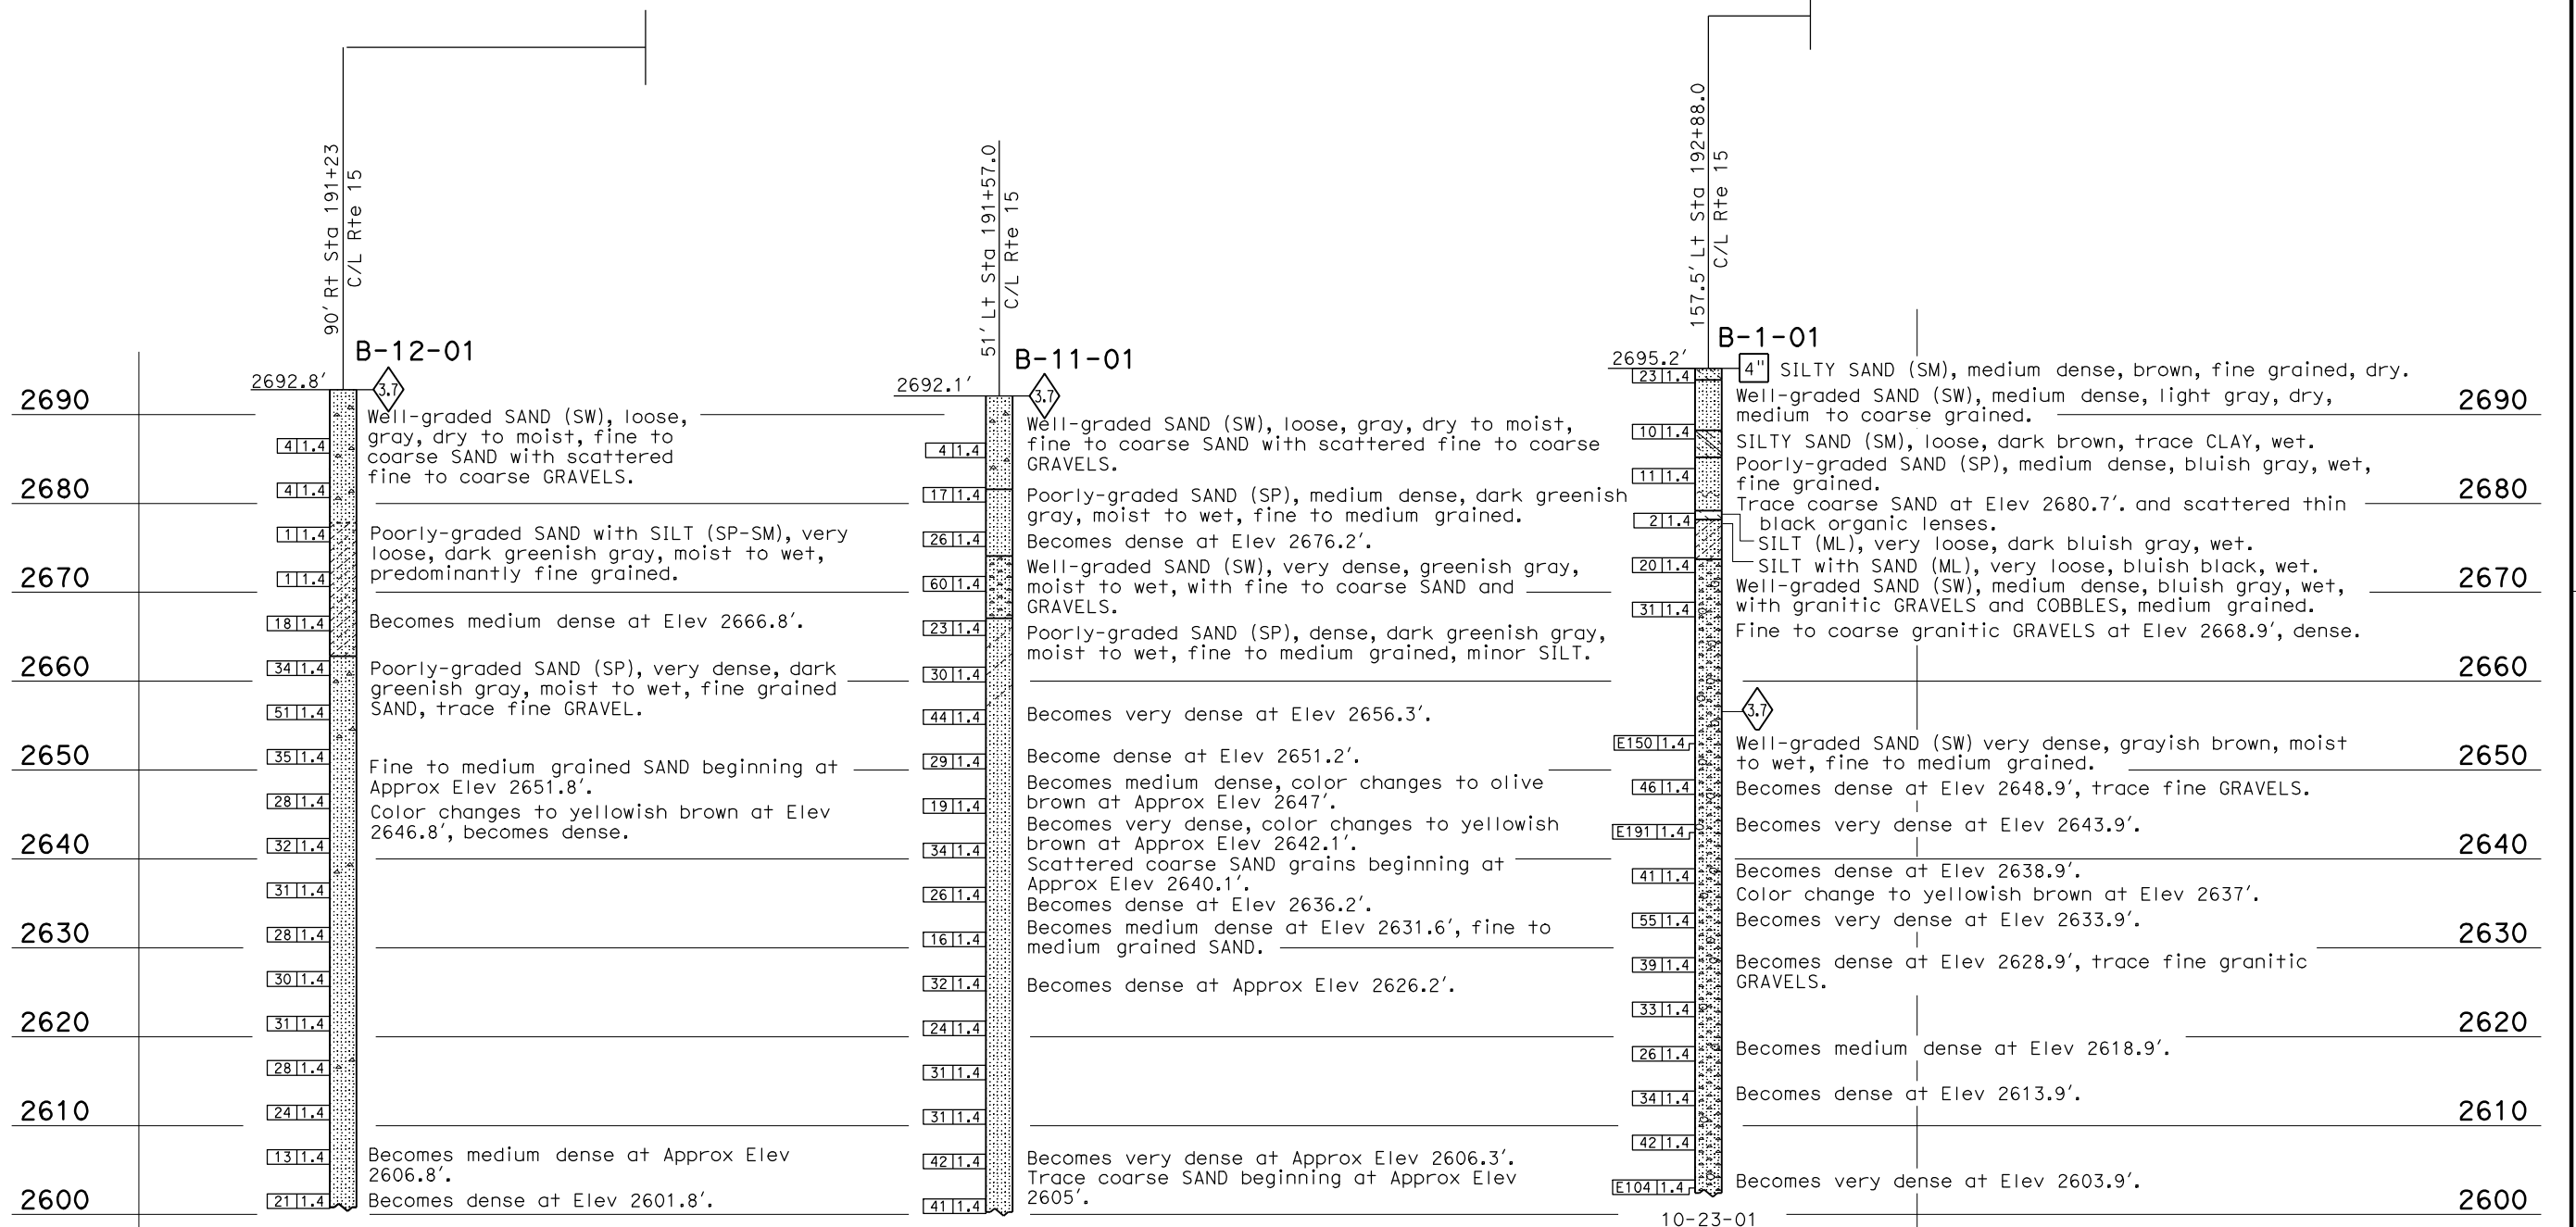

191+00	192+00	193+00
12-12-01	12-6-01	10-23-01

**PROFILE**  
 Horiz: 1" = 10'  
 Vert: 1" = 10'

<b>ENGINEERING SERVICES</b>	<b>MATERIALS &amp; GEOTECHNICAL SVCS</b>	FIELD INVESTIGATION BY: E. Neupert, F. Gerami	<b>STATE OF CALIFORNIA</b> DEPARTMENT OF TRANSPORTATION	<b>DIVISION OF ENGINEERING SERVICES</b> STRUCTURE DESIGN <b>DESIGN BRANCH X</b>	BRIDGE NO. 54-0483 POST MILE 43.8	<b>MOJAVE RIVER BRIDGE (WIDEN)</b> <b>LOG OF TEST BORINGS 10 OF 11</b>
DRAWN BY I. G. Remmen	CHECKED BY A. Wardak					





## Stoddard Wells Road


NO TEST PILE SPECIFIED  
 LOCATION - BENT #3 - RIGHT FOOTING - PILE NO. 21 - SEE FIELD BOOK NO. 2  
 TYPE - CAST-IN-PLACE CONCRETE PILE ALTERNATIVE "W"  
 HAMMER - VULCAN NO. 1  
 DIAM. - 10" TIP & 16" BUTT  
 ELEV. - CUT-OFF 2703.25 TIP 2690.2  
 LOADS - DESIGN 45 TONS E.M.R. LOAD 82+ TONS

LENGTH -	MAX.	MIN.	AVE.
ABUT #1	28.2	26.8	27.5
BENT #2L	14.7	12.4	13.1
2R	13.3	12.8	13.0
BENT #3L	12.8	12.7	12.7
3R	13.4	11.5	12.9
BENT #4L	13.6	12.9	13.1
4R	12.6	11.6	12.3
ABUT #5	35.0	31.7	32.7

TOTAL - 691.9 L.F.  
 ESTIMATE - 1350 L.F.

ATTEMPT WAS MADE TO DRIVE PILES THROUGH SOFTER AREA (B-2 & B-4) AT ELEV. 2690 ±, BUT PILES REACHED E.M.R. BEARING WELL BEFORE MIN. PENETRATION.


PENETR	BLOWS/FT
1	3
2	9
3	16
4	23
5	28
6	30
7	32
8	38
9	47
10	54
11	85
12	109
13	111

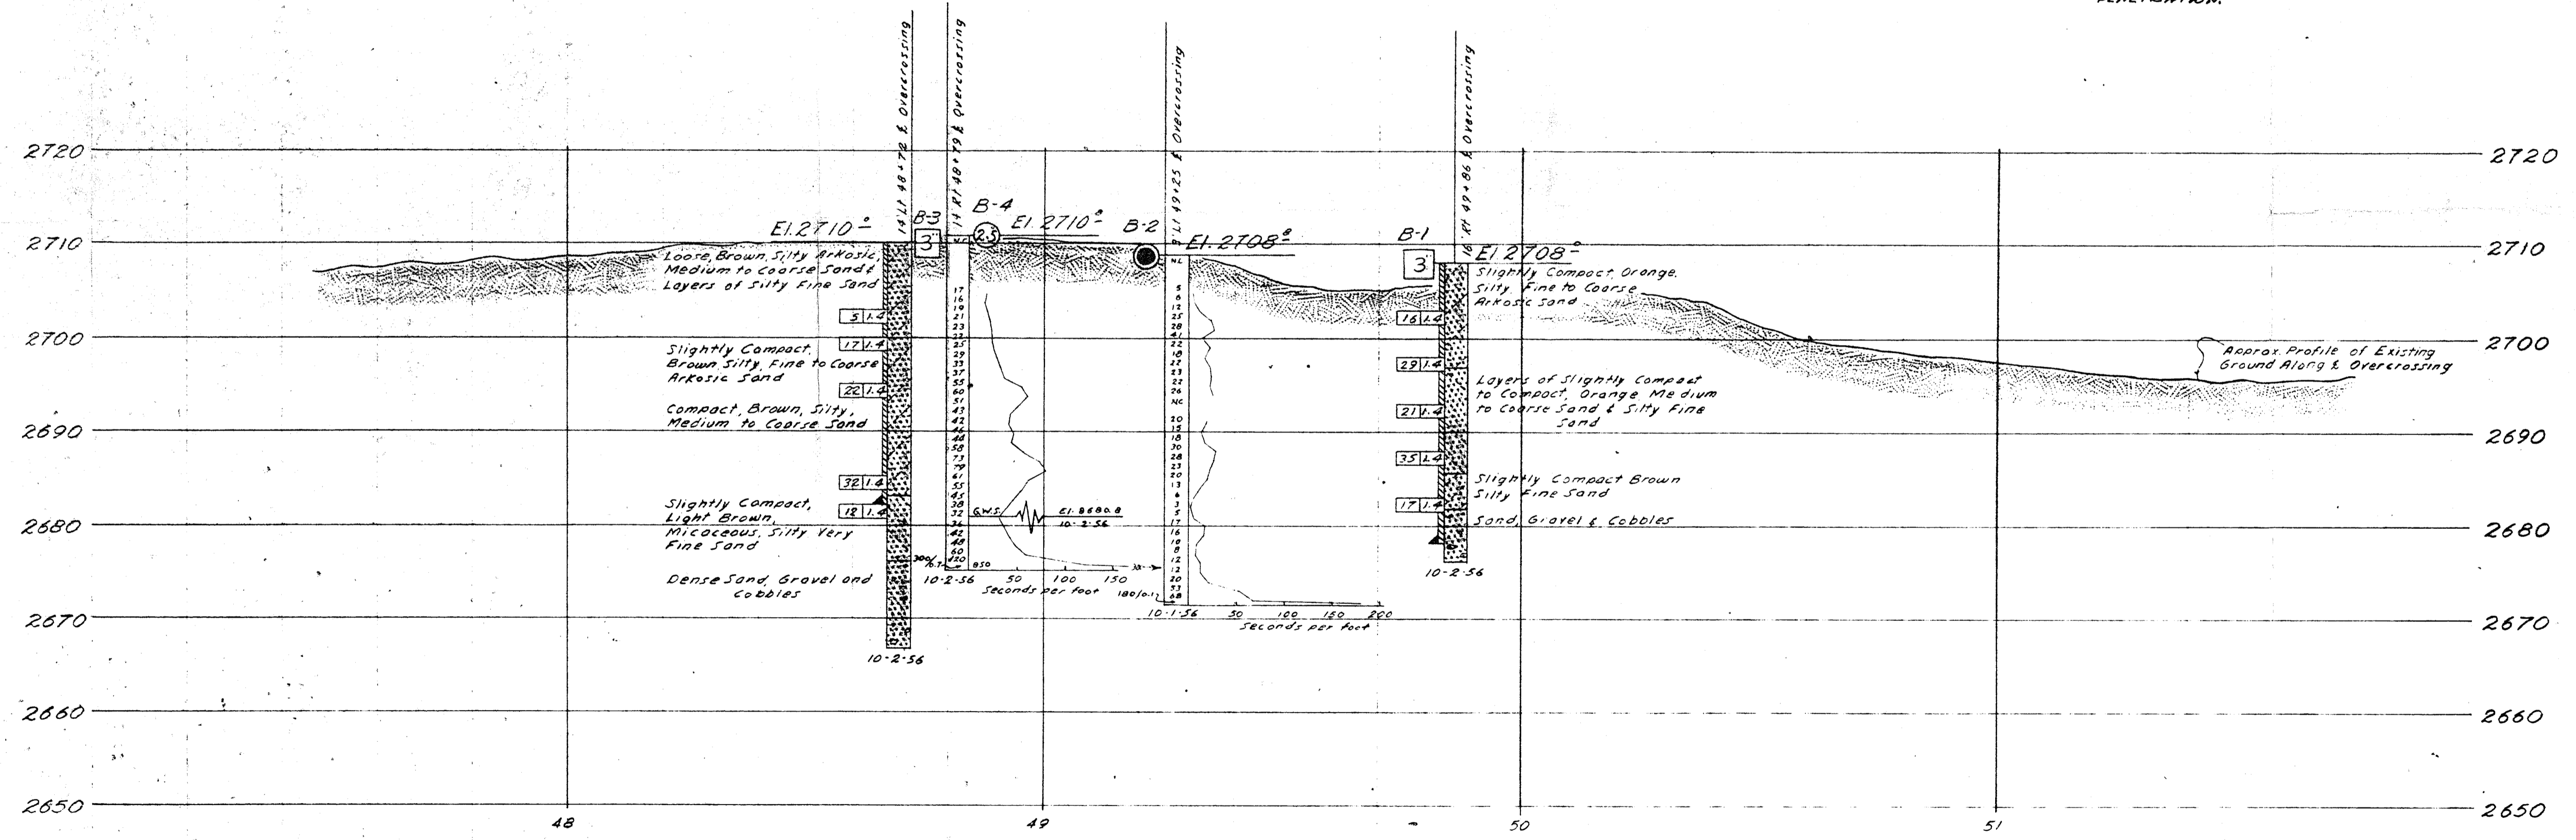

B.M. #5A-54  
 Set 2" x 2" Rwd. Hub & Sc. Hd.  
 on Bur. 1:279 E. Imp. 44+00  
 Elev. 2691.66

BRIDGE DEPARTMENT

FIELD STUDY  
 DRAWN BY: *[Signature]*  
 CHECKED BY: *[Signature]*  
 APPROVED BY: *[Signature]*

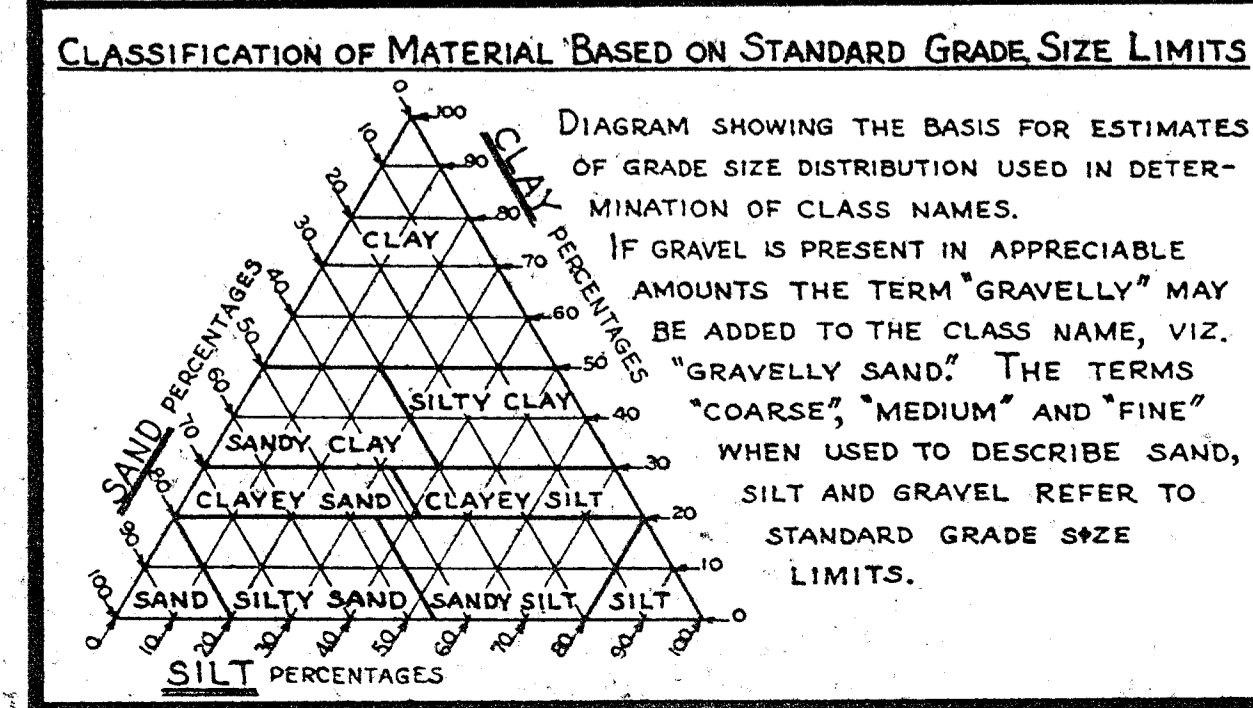

**LEGEND OF EARTH MATERIALS**

GRAVEL	SILTY CLAY OR CLAYEY SILT
SAND	PEAT AND/OR ORGANIC MATTER
SILT	FILL MATERIAL
CLAY	IGNEOUS ROCK
SANDY CLAY OR CLAYEY SAND	SEDIMENTARY ROCK
SANDY SILT OR SILTY SAND	METAMORPHIC ROCK

**LEGEND OF BORING OPERATIONS**

- PLAN OF ANY BORING
- PENETROMETER
- 2 1/2" CONE PENETROMETER
- SAMPLER BORING (DRY)
- ROTARY BORING (WET)
- AUGER BORING (DRY)
- JET BORING
- CORE BORING
- TEST PIT

**1" SOIL TUBE**

**ROTARY BORING**

**PENETRATION BORING**

**NOTES**

The contractor's attention is directed to Section 2, Article (c) of the Standard Specifications and to the Special Provisions accompanying this set of plans. Classification of earth material as shown on this sheet is based upon field inspection and is not to be construed to imply mechanical analysis.

STATE OF CALIFORNIA  
 DEPARTMENT OF PUBLIC WORKS  
 DIVISION OF HIGHWAYS

**STODDARD WELLS RD. OVERCROSSING**


**LOG OF TEST BORINGS**

HORIZ 1" = 20'  
 SCALE VERT 1" = 10'

BRIDGE 54-535 FILE 59 DRAWING C-5224-11



## Cement Company Road UC

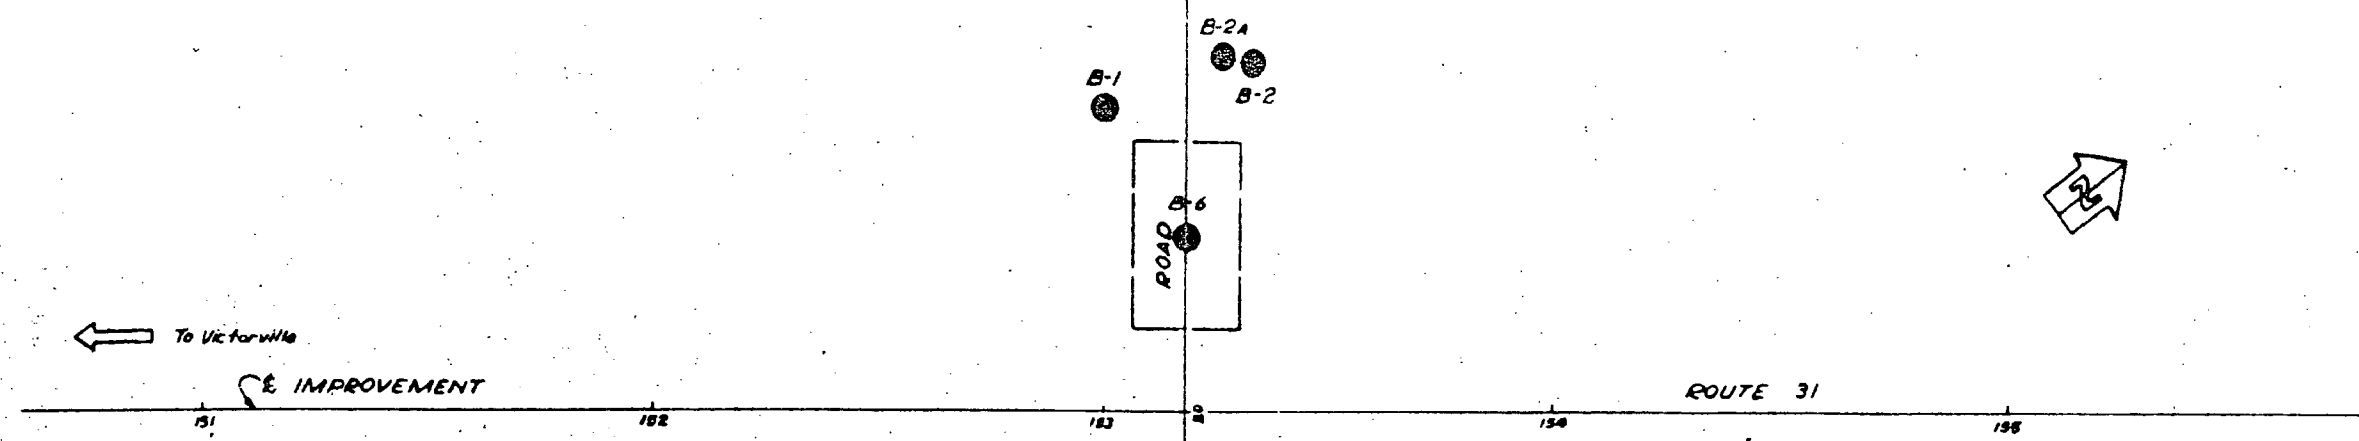

DIVISION OF ENGINEERING SERVICES - GEOTECHNICAL SERVICES

As-Built Log of Test Borings sheet is considered an informational document only. As such, the State of California registration seal with signature, license number and registration certificate expiration date confirm that this is a true and accurate copy of the original document. It does not attest to the accuracy or validity of the information contained in the original document. This drawing is available and presented only for the convenience of any bidder, contractor or other interested party.

DIST.	COUNTY	ROUTE	KILOMETER POST - TOTAL PROJECT	Sheet No.	Total Sheets
08	SBD	31			


REGISTERED ENGINEER - CIVIL

**CEMENT CO. UC (WIDEN)**  
**LOG OF TEST BORINGS 2 OF 2**

NOTE: A COPY OF THIS LOG OF TEST BORINGS IS AVAILABLE AT OFFICE OF STRUCTURE MAINTENANCE AND INVESTIGATIONS, SACRAMENTO, CALIFORNIA

CU: 08  
 EA: 355521


BRIDGE No. 54 0517

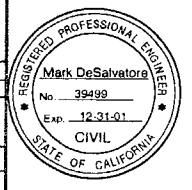


Revisions made to this Log of Test Borings from the original 1956 Log of Test Borings are the addition of the following table and notes:

Boring	Station	Offset from "C/L Route 15"
B-3	97+54.251	18.290 m Right
B-1	97+54.251	19.810 m Left
B-5	97+59.738	11.580 m Right
B-6	97+59.738	11.580 m Left
B-2A	97+62.176	22.860 m Left
B-4	97+62.786	7.320 m Right
B-2	97+64.310	22.560 m Left


- Notes:
- See the General Plan and/or Foundation Plan for Metric Stations.
  - The Division of Structure Design produced the data presented in the table above. The data are the metric locations for the As-Built Test Borings referenced to the proposed new structure location. This table is presented on the As-Built Log of Test Boring sheet for the convenience of any bidder, contractor or other interested party.
  - In the table above, the Metric Boring Locations are based on NAD 83 horizontal datum.

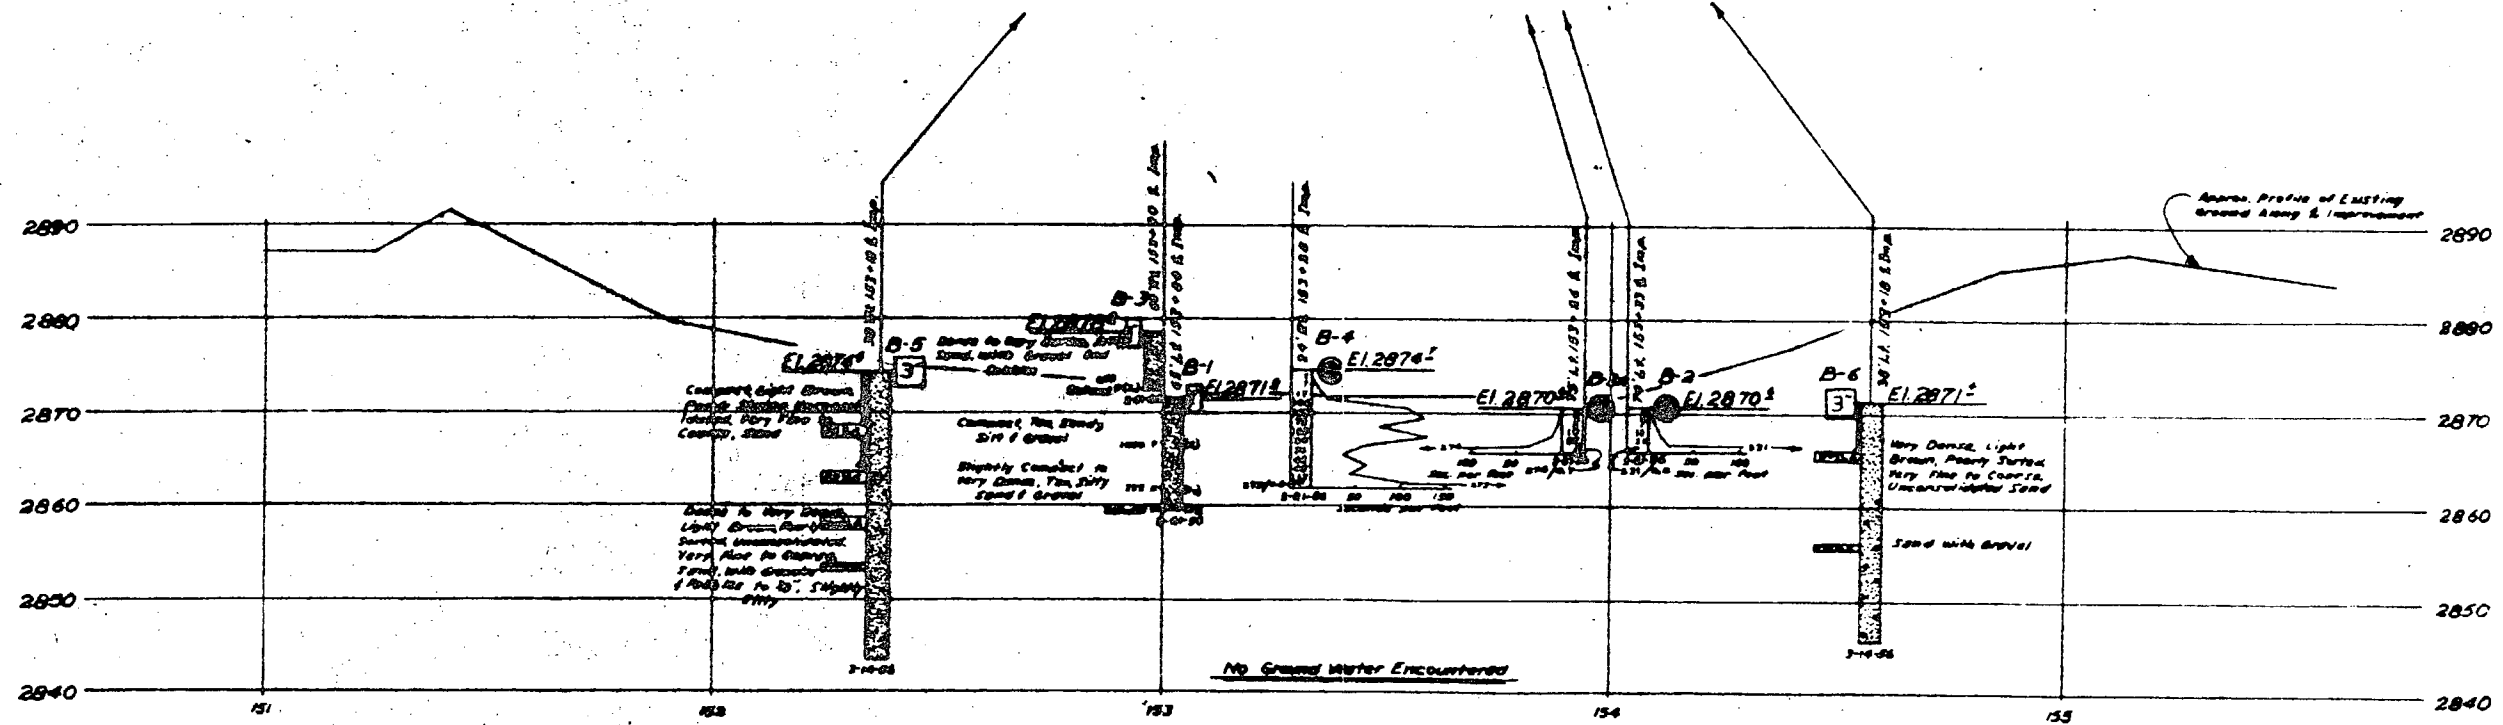

B.M. = 64.54  
 2' x 2' Road N of Sta. 97+11.00 D.P. 15  
 2' x 2' Road S of Sta. 97+11.00 D.P. 15  
 Sta. 97+47.6 & 97+48.0 El. 2891.06

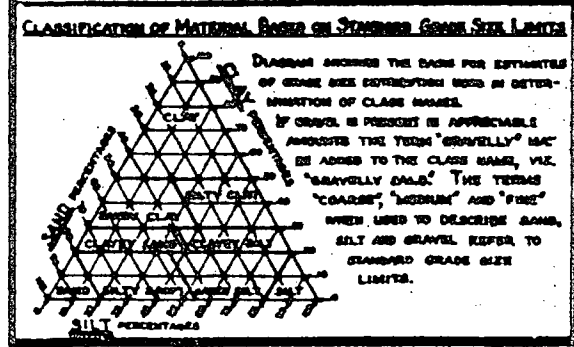

- LEGEND OF EARTH MATERIALS**
- GRAVEL
  - SAND
  - SILT
  - CLAY
  - SANDY CLAY OR CLAYEY SAND
  - SANDY SILT OR SILTY SAND
  - SILTY CLAY OR CLAYEY SILT
  - PEAT AND/OR ORGANIC MATTER
  - FILL MATERIAL
  - IGNEOUS ROCK
  - SEDIMENTARY ROCK
  - METAMORPHIC ROCK

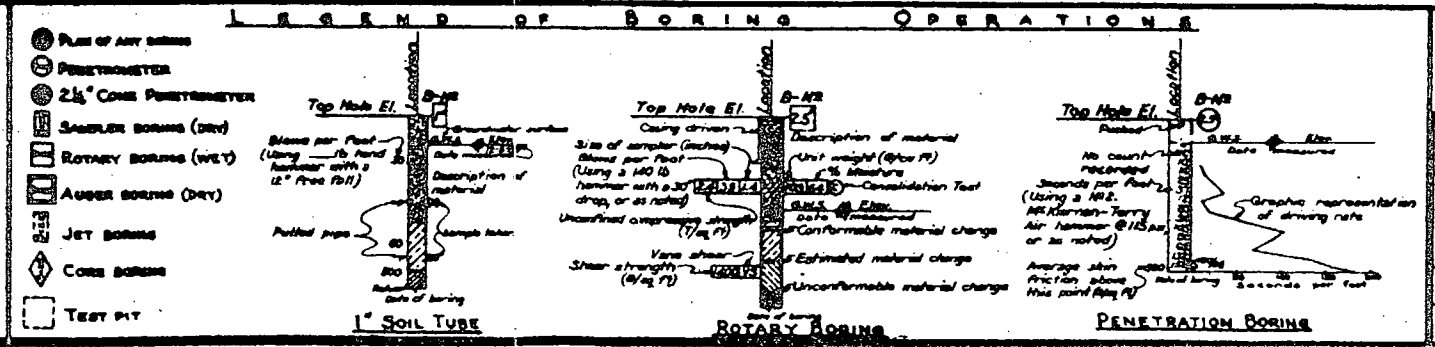

**NOTES**

The contractor's attention is directed to Section 2, Article (c) of the Standard Specifications and to the Special Provisions accompanying this set of plans.

Classification of earth material as shown on this sheet is based upon field inspection and is not to be construed to imply mechanical analysis.

STATE OF CALIFORNIA  
 DEPARTMENT OF PUBLIC WORKS  
 DIVISION OF HIGHWAYS

58-BVCA-FI

**CEMENT CO. UNDERCROSSING**

**LOG OF TEST BORINGS**

SCALE: HORIZ. 1" = 20'  
 VERT. 1" = 10'

BRIDGE 54-517 FILE 5-C DRAWING 2-4353-2


PREL. DRAWING NO. P. 45505




DIST	COUNTY	ROUTE	KILOMETER POST TOTAL PROJECT	SHEET NO	TOTAL SHEETS
08	SBd	15			

10-24-01  
 REGISTERED CIVIL ENGINEER  
 Mark DeSajvatore  
 No. 39499  
 Exp. 12-31-01  
 CIVIL  
 STATE OF CALIFORNIA

PLANS APPROVAL DATE  
 The State of California or its officers or agents shall not be responsible for the accuracy or completeness of electronic copies of this plan sheet.

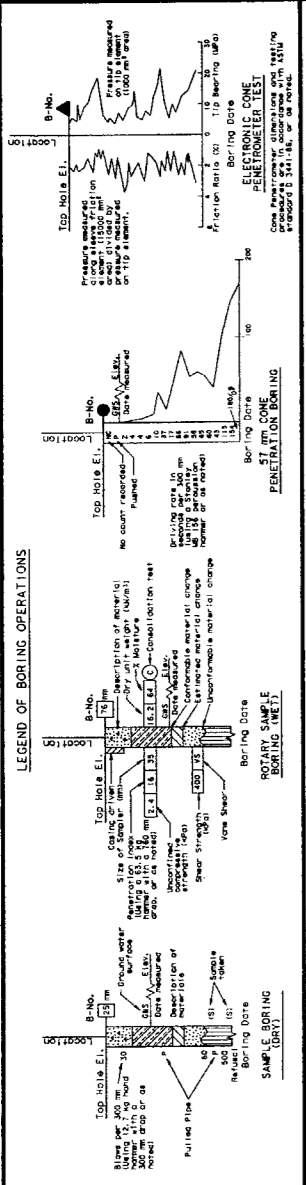


**BENCH MARK**  
 BM #46.52-92 Elev. 879.372  
 Fd. 51 mm with std. br. dish in conc. 4.219 m West of NBnd  
 R/W fence, down 152mm (NGVD 29)

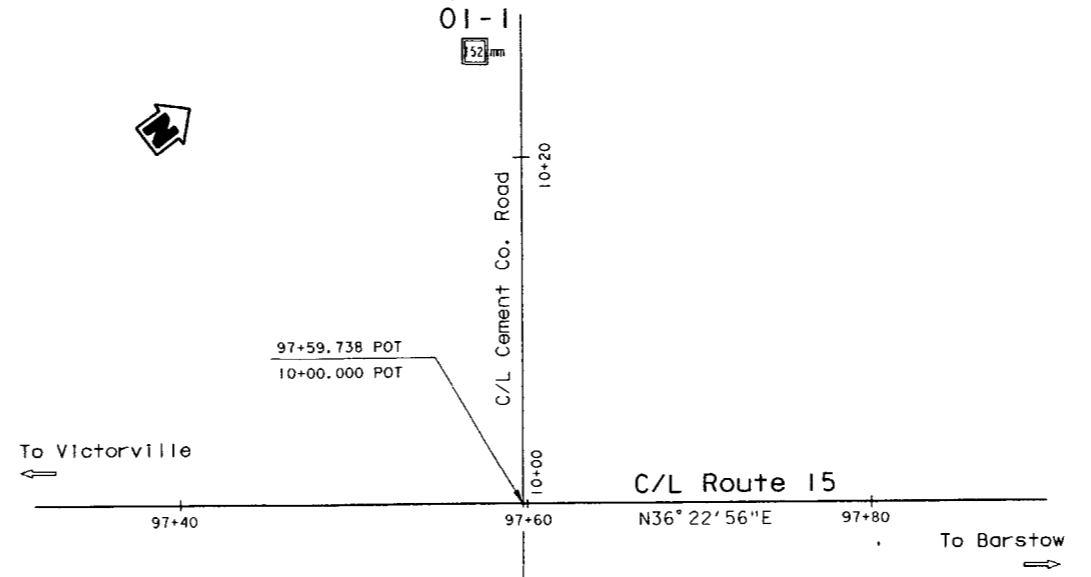

**PLAN**  
 1:200

- Notes:
1. Ground Water was not encountered during field investigation.
  2. The descriptions and classifications of rock and/or soil, including consistency and relative density descriptors, used by the field and/or office personnel for the exploration boreholes shown on this sheet are based on the "Soil and Rock Logging Classification Manual (Field Guide)", Engineering Service Center, Office of Structural Foundations, August 1996.
  3. Soil colors were determined by using Munsell Soil Color Charts (1994, Revised Edition). Rock colors were determined using USGS rock color charts (1995, revised text).
  4. Test boring 01-1, 01-2 utilized a safety hammer to advance the sampler using 63.5 kg hammer with a 760 mm drop. Penetration index values shown are the actual blow counts recorded in the field.
  5. E= Blow count for 0.3 m penetration extrapolated from blow count for less than 0.3 m penetration (due to change in material or hard driving).

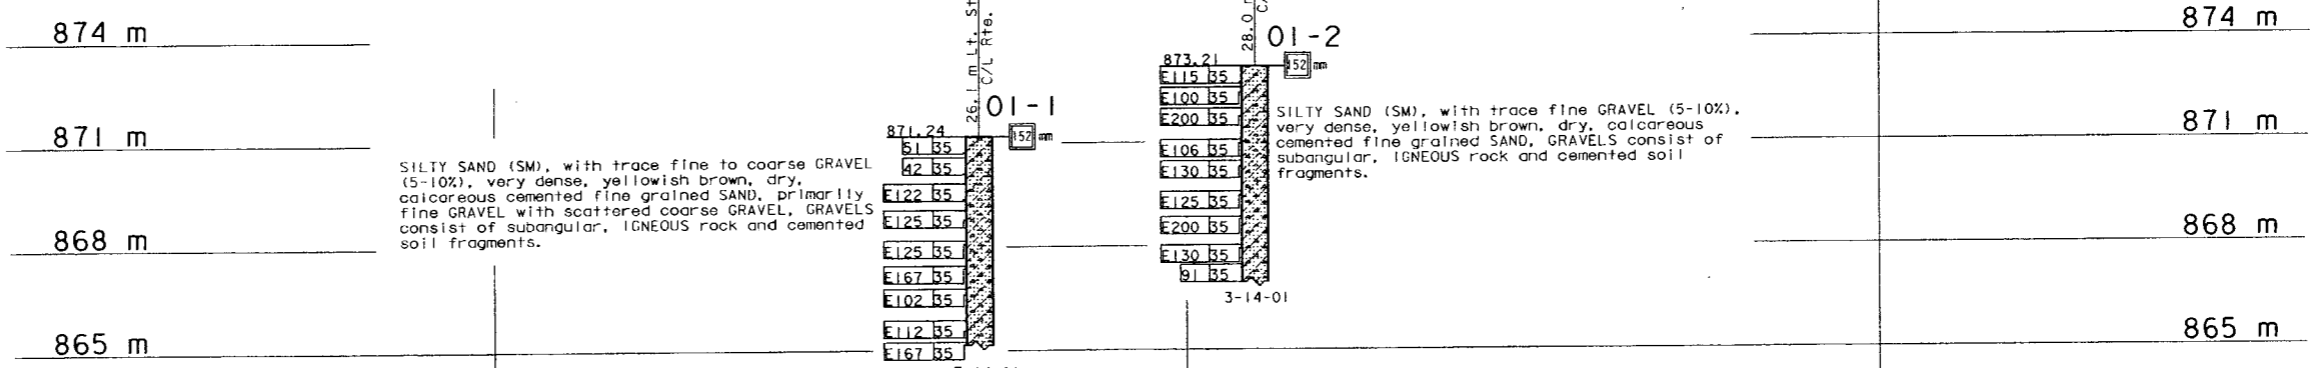

**PROFILE**  
 HOR. 1:50  
 VER. 1:100

ALL DIMENSIONS ARE IN METERS UNLESS OTHERWISE SHOWN

**LEGEND OF EARTH MATERIALS**

GRAVEL	CLAYEY SILT
SAND	CLAYEY SAND
SILT	CLAY
CLAY	CLAYEY CLAY
CLAYEY SAND	CLAYEY SILT
CLAYEY SILT	SANDY SILT
SANDY SILT	SANDY CLAY
SANDY CLAY	SANDY SILTY SAND
SANDY SILTY SAND	SANDY SILTY CLAY
SANDY SILTY CLAY	SANDY SILTY CLAY

**CONSISTENCY CLASSIFICATION FOR SOILS**

SPT (blows/30 cm)	Consistency
0-4	Very Loose
5-10	Loose
11-20	Medium Dense
21-30	Dense
31-50	Very Dense
>50	Hard

NOTE: Classification of earth material as shown on this sheet is based upon field inspection and is not to be construed to imply mechanical analysis.

<b>ENGINEERING SERVICES</b>	<b>GEOTECHNICAL SERVICES</b>
DRAWN BY Lily Wang 09/01	CHECKED BY M. Spohn

FIELD INVESTIGATION BY:  
 H. Valencia

**STATE OF CALIFORNIA**  
 DEPARTMENT OF TRANSPORTATION

**DIVISION OF STRUCTURES**  
 STRUCTURE DESIGN

BRIDGE NO.  
54-0517

KILOMETER POST  
74.7

CU 08  
EA 355521

<b>CEMENT CO. UC (WIDEN)</b>	
<b>LOG OF TEST BORINGS 1 OF 2</b>	
DISREGARD PRINTS BEARING EARLIER REVISION DATES	REVISION DATES (PRELIMINARY STAGE ONLY)
10-25-01	
SHEET	OF

DATE PLOTTED => 28 OCT 2001 TIME PLOTTED => 09:22:08 USERNAME => TSDDP



## Bell Mountain Wash



DIST	COUNTY	ROUTE	KILOMETER POST TOTAL PROJECT	SHEET No	TOTAL SHEETS
08	SBd	15			

10-29-01  
 REGISTERED CIVIL ENGINEER  
 Mark DeSalvatore  
 No. 39499  
 Exp. 12-31-01  
 CIVIL  
 STATE OF CALIFORNIA

PLANS APPROVAL DATE

The State of California or its officers or agents shall not be responsible for the accuracy or completeness of electronic copies of this plan sheet.

**LEGEND OF BORING OPERATIONS**


**7.5 m CONE PENETRATION TEST**  
 Pressure measured at 150 mm penetration  
 Friction ratio (s) = 1/10 bearing ratio

**ROTTARY SAMPLE BORING (REBT)**  
 Description of material  
 Size of sample of soil  
 No. of samples  
 No. of blow counts  
 No. of blow counts per 300 mm  
 No. of blow counts per 600 mm  
 No. of blow counts per 900 mm  
 No. of blow counts per 15000 mm

**7.5 m CONE PENETRATION TEST**  
 Description of material  
 Size of sample of soil  
 No. of samples  
 No. of blow counts  
 No. of blow counts per 300 mm  
 No. of blow counts per 600 mm  
 No. of blow counts per 900 mm  
 No. of blow counts per 15000 mm

**DIAMOND CORE BORING**  
 Description of material  
 Size of sample of soil  
 No. of samples  
 No. of blow counts  
 No. of blow counts per 300 mm  
 No. of blow counts per 600 mm  
 No. of blow counts per 900 mm  
 No. of blow counts per 15000 mm


**SET BORING**  
 Description of material  
 Size of sample of soil  
 No. of samples  
 No. of blow counts  
 No. of blow counts per 300 mm  
 No. of blow counts per 600 mm  
 No. of blow counts per 900 mm  
 No. of blow counts per 15000 mm

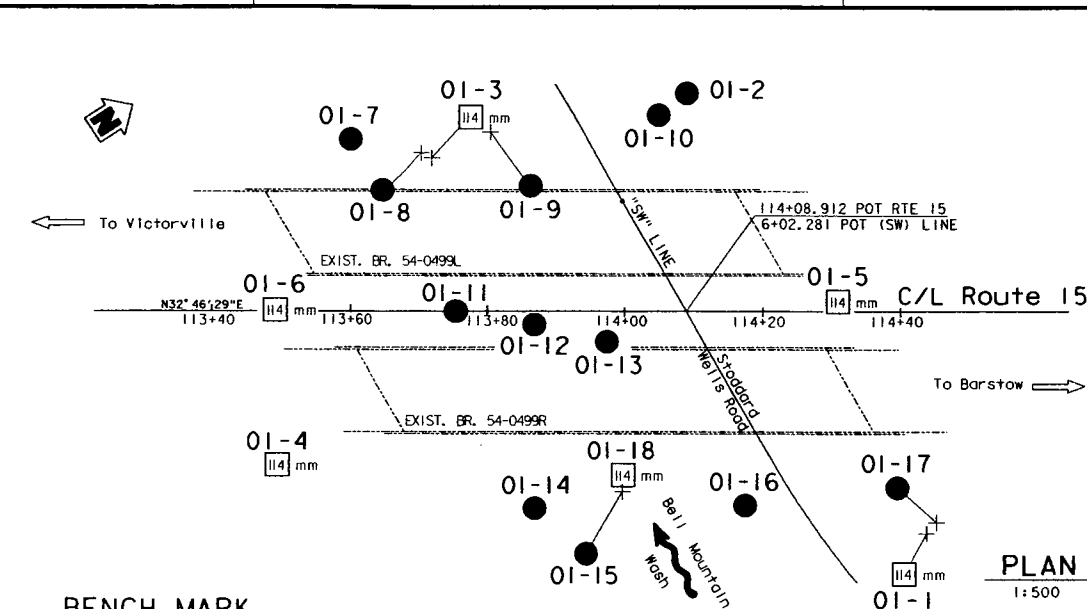

- Notes:**
- No attempt was made to measure ground water in any borings except for boring 01-3 during the 2001 field investigation.
  - Ground water was not encountered in borings 01-3 during the 2001 field investigation.
  - The descriptions and classifications of rock and/or soil, including consistency and relative density descriptors, used by the field and/or office personnel for the explanation boreholes shown on this sheet are based on the "Soil and Rock Logging Classification Manual (Field Guide)", Engineering ServiceCenter, Office of Structural Foundations, August 1996.
  - Soil colors were determined by using Munsell Soil Color Charts (1994, Revised Edition). Rock colors were determined using USGS rock color charts (1995, revised text).
  - Test boring B-1-00 was advanced using a combination of tungsten-carbide drill bits and wireline diamond coring methods.
  - Test borings 01-2, 01-4, 01-5, 01-18 utilized a safety hammer to advance the sampler using a 63.5 kg hammer with a 760 mm drop. Penetration Index values shown are the actual blow counts recorded in the field.
  - Test borings 01-1, 01-3, 01-6 utilized a Deldrich automatic hammer to advance the sampler. Penetration Index values shown on the LOTB sheets were the actual blow counts recorded in the field.
  - Soil consistency classifications for test borings 01-1, 01-3, 01-6 are based on a conversion factor of 1.5 times the uncorrected blow count.
  - E=Blow count for 0.3 m penetration extrapolated from blow count for less than 0.3 m penetration (due to change in material or hard driving).
  - Penetration Index value designated "Ref" means sampler refusal.
  - Refusal in earth material is defined as severely limited or halted penetration (less than 60 mm penetration in 50 blow counts) of the Standard Penetration Test (SPT) sampler due to the presence of GRAVEL, COBBLES, BOULDERS or ROCK formation materials.

**BENCH MARK**

BM PT #186 Elev. 878.901 m  
 Fd. PK nail & tin in AC gore, approx. 24.94 m  
 NW'ly of the SBnd edge of deck bridge  
 N621227.045 E2067844.939

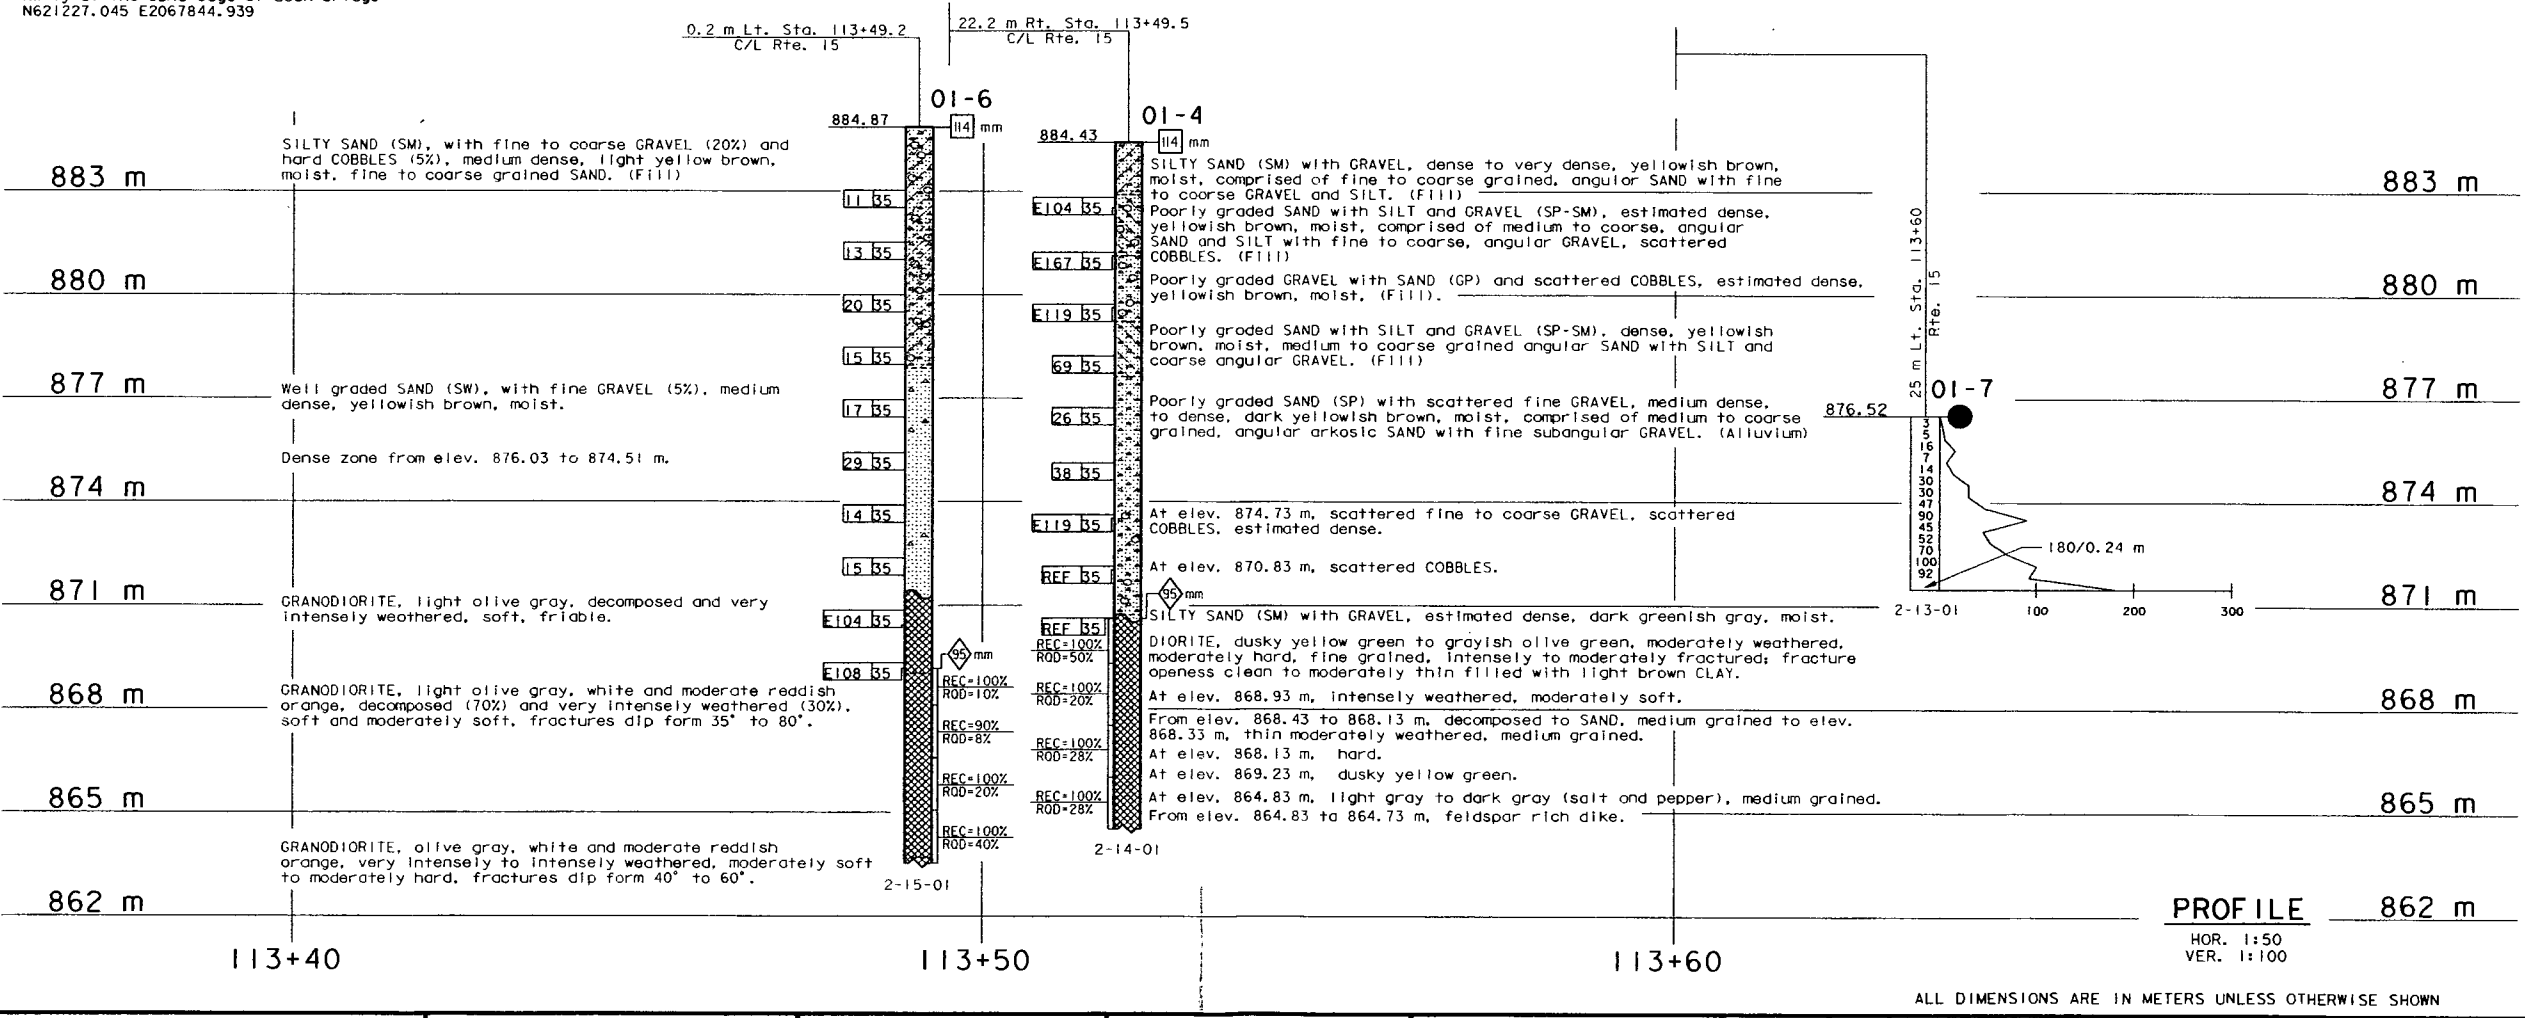

**LEGEND OF EARTH MATERIALS**

GRAVEL  
 SAND  
 SILT  
 CLAY  
 CLAYEY SILT  
 SILTY CLAY  
 SILTY SAND  
 SILTY SILT  
 CLAYEY SAND  
 CLAYEY SILT  
 SILTY CLAY

**CONSISTENCY CLASSIFICATION FOR SOILS**

According to the Standard Penetration Test

SPN Value (blows/300 mm)	Consistency
0-4	Very Loose
5-10	Loose
11-20	Medium Dense
21-30	Dense
31-50	Very Dense
>50	Hard

NOTE: Classification of earth material as shown on this sheet is based upon field inspection and is not to be construed to imply mechanical analysis.

<b>ENGINEERING SERVICES</b>	<b>GEOTECHNICAL SERVICES</b>	FIELD INVESTIGATION BY: R. Fuentes M. Pagenkopp H. Valencia	<b>STATE OF CALIFORNIA</b> DEPARTMENT OF TRANSPORTATION	<b>DIVISION OF STRUCTURES</b> STRUCTURE DESIGN	BRIDGE NO. 54-0499 KILOMETER POST 76.3	<b>BELL MOUNTAIN WASH BRIDGE (WIDEN)</b>
DRAWN BY Irma G-Remmen 9/01	CHECKED BY H. Valencia 10/01		CU 08 EA 355521	DISREGARD PRINTS BEARING EARLIER REVISION DATES	REVISION DATES (PRELIMINARY STAGE ONLY)	SHEET 1 OF 7

FILE -> /user/dms/local/trans/lab/08-355520/bel/lnf1.dgn

DATE PLOTTED -> 30 OCT 2001 USERNAME -> TSDPPP



DIST	COUNTY	ROUTE	KILOMETER POST TOTAL PROJECT	SHEET No	TOTAL SHEETS
08	SBd	15			

10-30-01  
 REGISTERED CIVIL ENGINEER  
 Mark DeSalvatore  
 No. 39499  
 Exp. 12-31-01  
 CIVIL  
 STATE OF CALIFORNIA

PLANS APPROVAL DATE  
 The State of California or its officers or agents shall not be responsible for the accuracy or completeness of electronic copies of this plan sheet.

FOR PLAN VIEW, SEE  
 "LOG OF TEST BORINGS" 1 OF 7

**LEGEND OF BORING OPERATIONS**

**75 mm CONE PENETRATION**  
 75 mm CONE PENETRATION TEST  
 Friction ratio (kN/m<sup>2</sup>) vs. Penetration (mm) graph showing test results.

**ROTARY SAMPLE BORING (WELL)**  
 Description of material, Sample No., Depth (m), etc.

**DIAMOND CORE BORING**  
 Description of material, Sample No., Depth (m), etc.

**75 mm CONE PENETRATION**  
 75 mm CONE PENETRATION TEST  
 Friction ratio (kN/m<sup>2</sup>) vs. Penetration (mm) graph showing test results.

**ROTARY SAMPLE BORING (WELL)**  
 Description of material, Sample No., Depth (m), etc.

**DIAMOND CORE BORING**  
 Description of material, Sample No., Depth (m), etc.

**LEGEND OF EARTH MATERIALS**


GRAVEL, SAND, SILT, CLAY, etc. symbols and descriptions.

**CONSISTENCY CLASSIFICATION FOR SOILS**

According to the Standard Penetration Test

SPT N-value (blows/30cm)	Consistency
0-4	Very Loose
5-10	Loose
11-20	Medium Dense
21-30	Dense
31-50	Very Dense
>50	Hard

NOTE: Classification of earth material as shown on this sheet is based upon field inspection and is not to be construed to imply mechanical analysis.

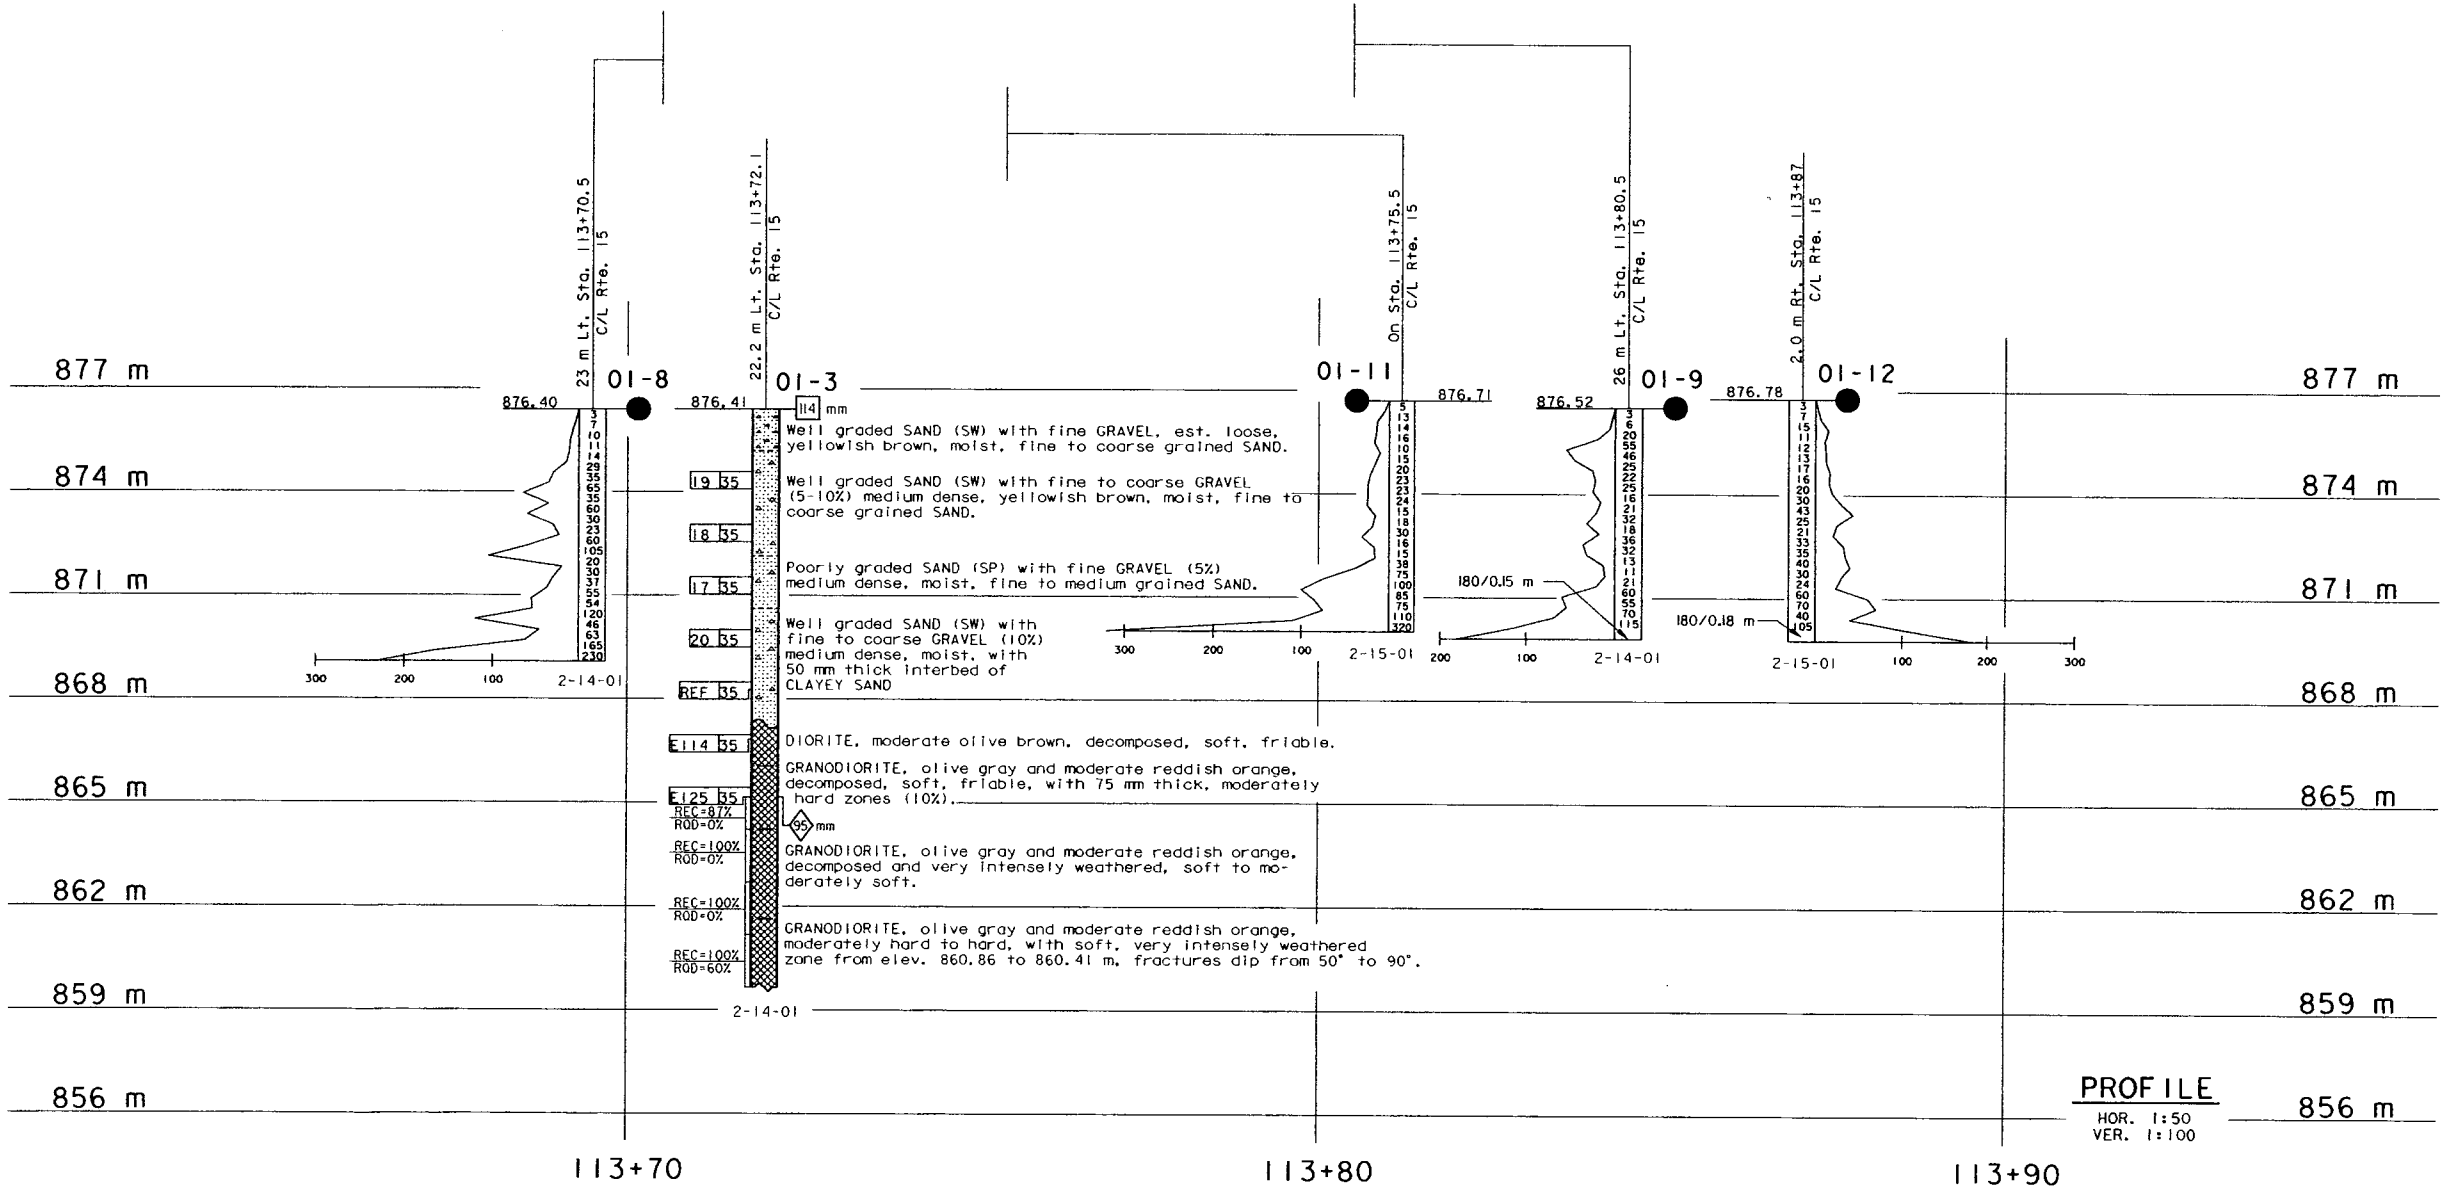

<b>ENGINEERING SERVICES</b>		<b>GEOTECHNICAL SERVICES</b>		FIELD INVESTIGATION BY: R. Fuentes M. Pagenkopp H. Valencia	BRIDGE NO. 54-0499	<b>BELL MOUNTAIN WASH BRIDGE (WIDEN)</b>	
DRAWN BY Irma G-Reitman 9/01	CHECKED BY N. Sandoval 10/01	STATE OF CALIFORNIA DEPARTMENT OF TRANSPORTATION			KILOMETER POST 76.3	<b>LOG OF TEST BORINGS 2 OF 7</b>	
O&G CIVIL LOG OF TEST BORINGS SHEET (METRIC) (REV. 328/01)				CU 08 EA 355521	DISREGARD PRINTS BEARING EARLIER REVISION DATES		



DATE PLOTTED => 30 OCT 2001 TIME PLOTTED => 15:22:03 USERNAME => tsdbdd






DIST	COUNTY	ROUTE	KILOMETER POST TOTAL PROJECT	SHEET No	TOTAL SHEETS
08	Sbd	15			

REGISTERED CIVIL ENGINEER  
 10-30-01  
 Mark Desalvatore  
 No. 39499  
 Exp. 12-31-01  
 CIVIL  
 STATE OF CALIFORNIA

PLANS APPROVAL DATE  
 The State of California or its officers or agents shall not be responsible for the accuracy or completeness of electronic copies of this plan sheet.

FOR PLAN VIEW, SEE  
"LOG OF TEST BORINGS" 1 OF 7

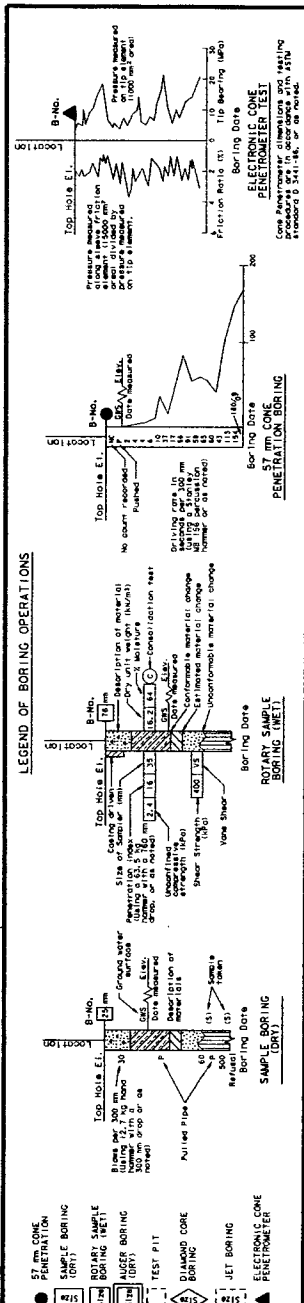


**LEGEND OF EARTH MATERIALS**

GRAVEL	CLAYEY SILT
SAND	PEAT AND/OR ORGANIC MATTER
COBBLES AND/OR BOLDERS	SILT
LONGEVUS ROCK	CLAY
SEDIMENTARY ROCK	CLAYEY SAND
IGNEOUS ROCK	SANDY SILT or SILTY SAND
DIAMOND CORE	SILT CLAY
DIAMOND CORE	METAMORPHIC

**CONSISTENCY CLASSIFICATION FOR SOILS**

SP	Very Loose	0-4
SM	Loose	5-10
MS	Medium Dense	11-30
MD	Dense	31-50
HS	Very Dense	51-100
HC	Hard	101-300

NOTE: Classification of earth material as shown on this sheet is based upon field inspection and is not to be construed to imply mechanical analysis.

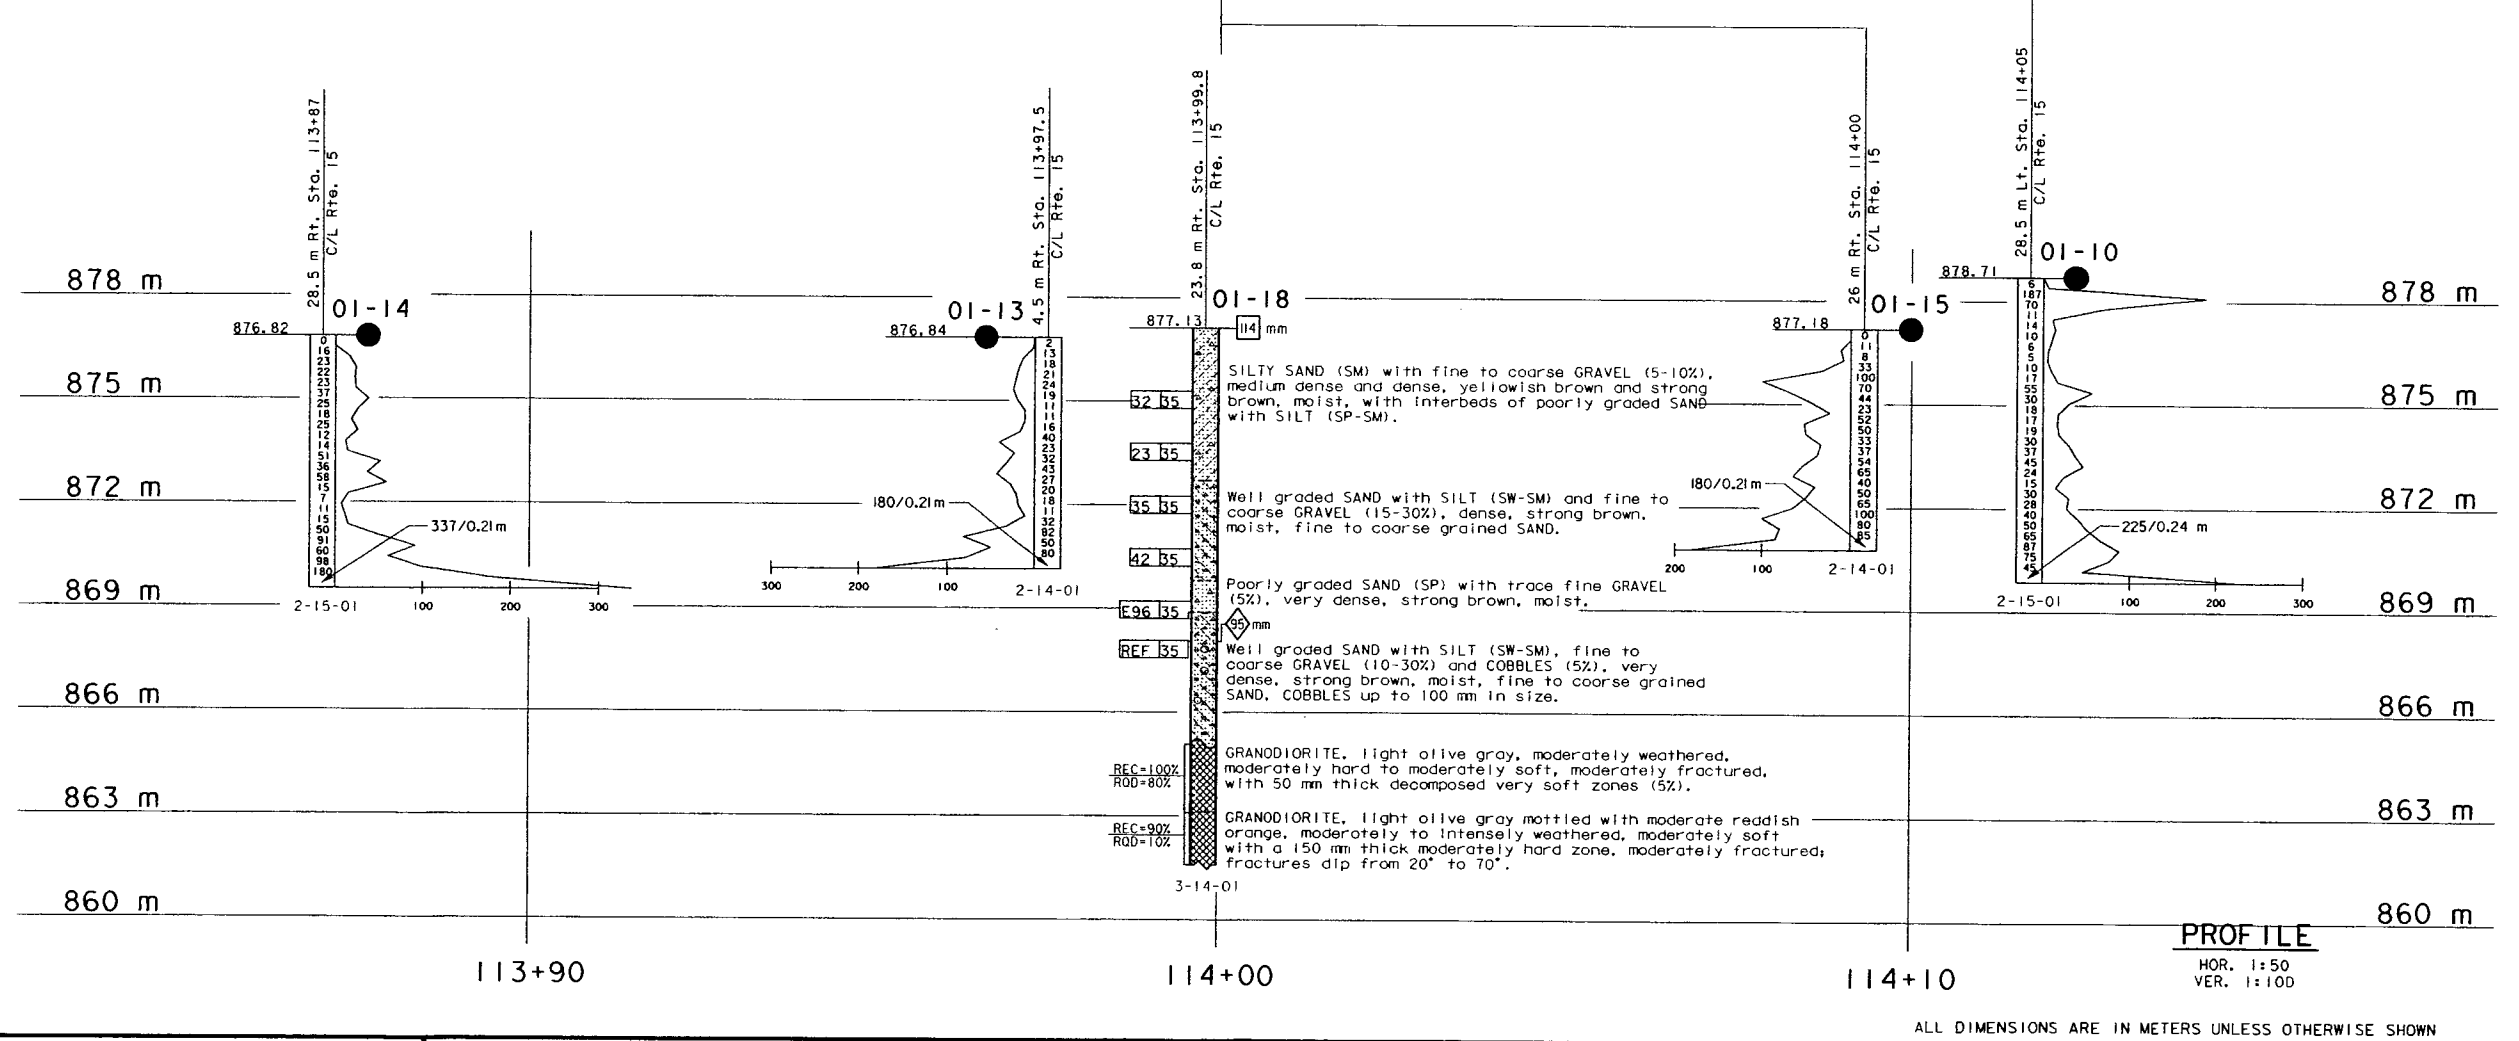

<b>ENGINEERING SERVICES</b> DRAWN BY: Irma G-Remmen 9/01 CHECKED BY: N. Sandoval 10/01		<b>GEOTECHNICAL SERVICES</b>		FIELD INVESTIGATION BY: R. Fuentes M. Pagenkopp H. Valencia		<b>STATE OF CALIFORNIA</b> DEPARTMENT OF TRANSPORTATION		<b>DIVISION OF STRUCTURES</b> STRUCTURE DESIGN		BRIDGE NO. 54-0499 KILOMETER POST 76.3		<b>BELL MOUNTAIN WASH BRIDGE (WIDEN)</b> <b>LOG OF TEST BORINGS 3 OF 7</b>	
ORIGINAL SCALE IN MILLIMETERS FOR REDUCED PLANS: 0 10 20 30 40 50 60 70 80 90 100						CU 08 EA 355521		DISREGARD PRINTS BEARING EARLIER REVISION DATES		REVISION DATES (PRELIMINARY STAGE ONLY)		SHEET OF	

08S CIVIL LOG OF TEST BORINGS SHEET (METRIC) (REV. 328/01)

DATE PLOTTED => 30 OCT 2001

USERNAME => TSBDD

FILE => /user/dms/local/translab/08-355520/bel1lmt3.dgn






DIST	COUNTY	ROUTE	KILOMETER POST TOTAL PROJECT	SHEET No	TOTAL SHEETS
08	SBd	15			

10-30-01  
 REGISTERED CIVIL ENGINEER  
 Mark Desjardins  
 No. 39499  
 Exp. 12-31-01  
 CIVIL ENGINEER  
 STATE OF CALIFORNIA

PLANS APPROVAL DATE

The State of California or its officers or agents shall not be responsible for the accuracy or completeness of electronic copies of this plan sheet.

FOR PLAN VIEW, SEE  
 "LOG OF TEST BORINGS" 1 OF 7

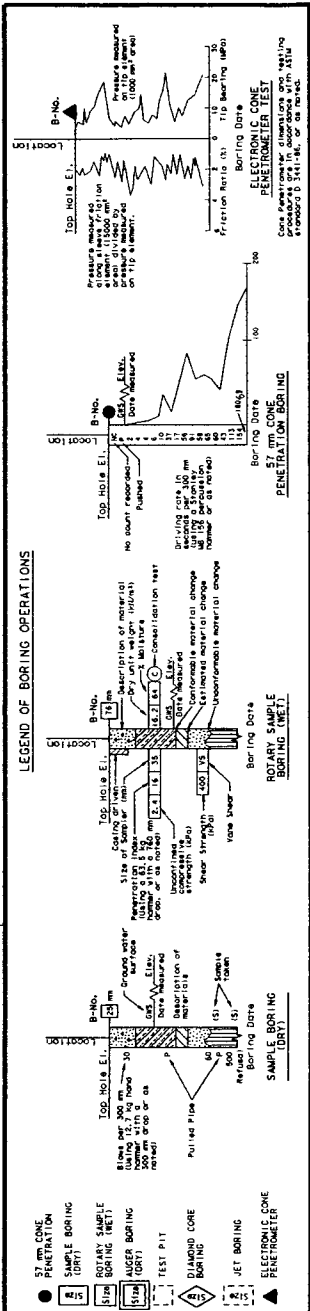



**LEGEND OF EARTH MATERIALS**

GRAVEL	CLAYEY SILT
SAND	CLAY
SILT	SEDIMENTARY ROCK
CLAY	IGNEOUS ROCK
SANDY CLAY or CLAYEY SAND	SEDIMENTARY ROCK
SANDY SILT or SILTY SAND	SEDIMENTARY ROCK
SILT	SEDIMENTARY ROCK
SILT	SEDIMENTARY ROCK
SILT	SEDIMENTARY ROCK

**CONSISTENCY CLASSIFICATION FOR SOILS**

SP (Very Loose)	1-2
ML (Loose)	3-4
MC (Medium Dense)	5-6
MH (Dense)	7-8
SH (Very Dense)	9-10
OH (Very Dense)	11-12
US (Very Dense)	13-14
US (Very Dense)	15-16
US (Very Dense)	17-18
US (Very Dense)	19-20
US (Very Dense)	21-22
US (Very Dense)	23-24
US (Very Dense)	25-26
US (Very Dense)	27-28
US (Very Dense)	29-30
US (Very Dense)	31-32
US (Very Dense)	33-34
US (Very Dense)	35-36
US (Very Dense)	37-38
US (Very Dense)	39-40
US (Very Dense)	41-42
US (Very Dense)	43-44
US (Very Dense)	45-46
US (Very Dense)	47-48
US (Very Dense)	49-50

NOTE: Classification of earth material as shown on this sheet is based upon field inspection and is not to be construed to imply mechanical analysis.

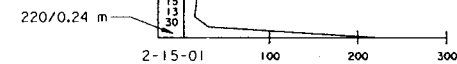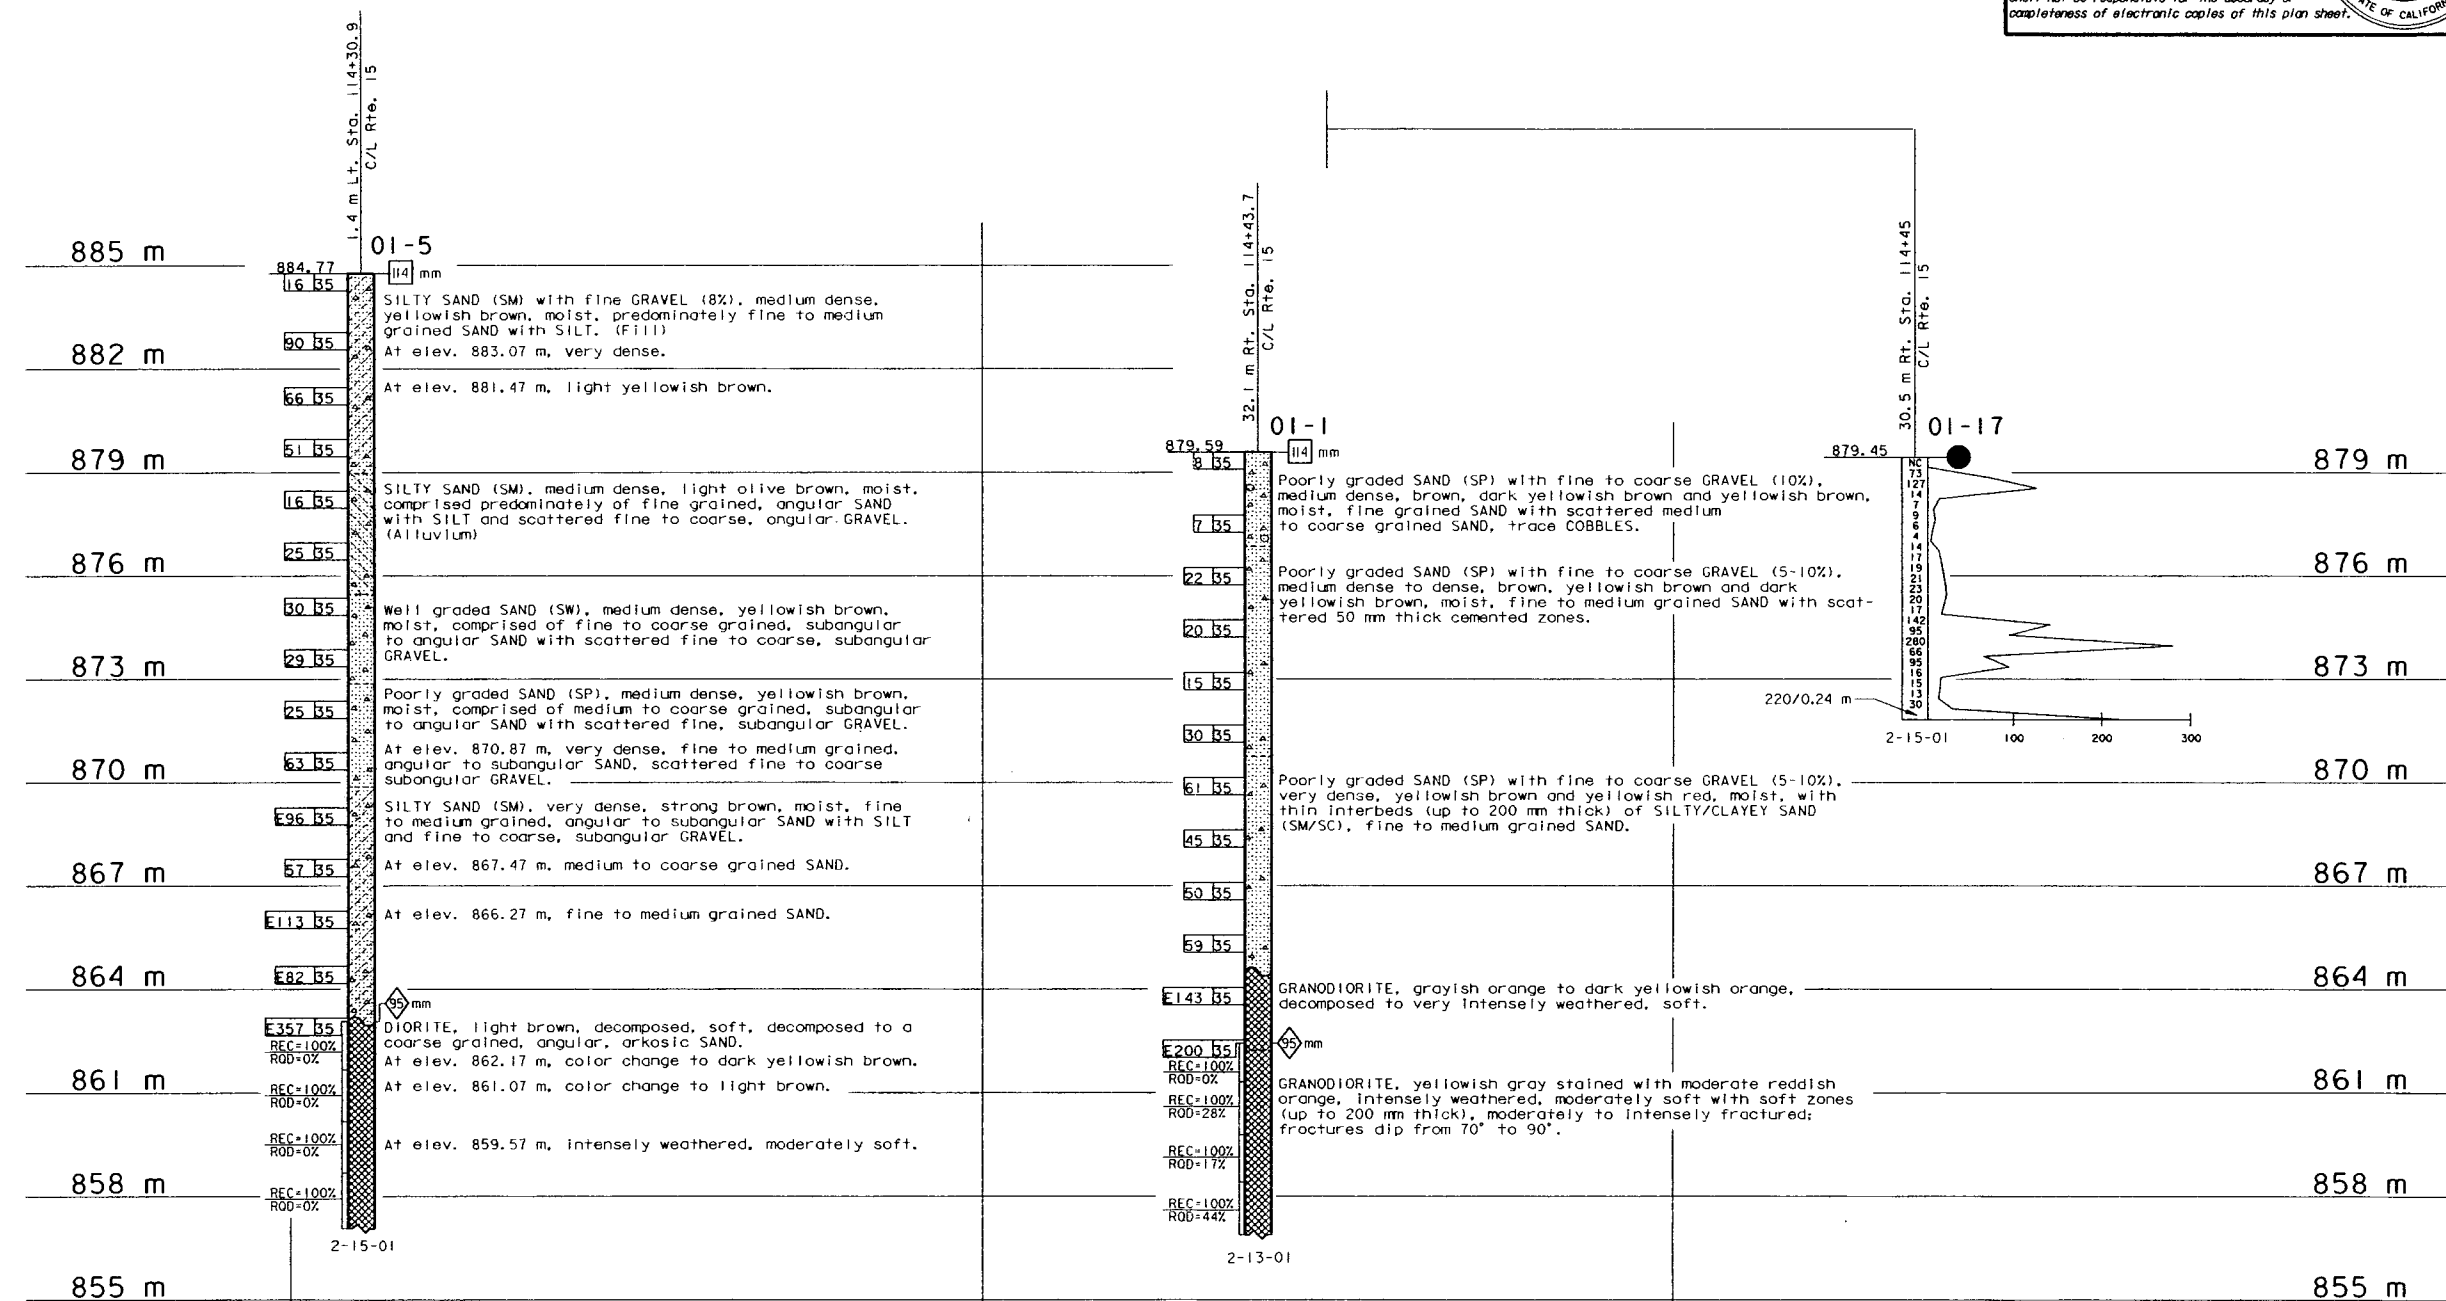

**PROFILE**  
 HOR. 1:50  
 VER. 1:100

ALL DIMENSIONS ARE IN METERS UNLESS OTHERWISE SHOWN

<b>ENGINEERING SERVICES</b>	<b>GEOTECHNICAL SERVICES</b>	FIELD INVESTIGATION BY: R. Fuentes M. Pagenkopp H. Valencia	<b>STATE OF CALIFORNIA</b> DEPARTMENT OF TRANSPORTATION	<b>DIVISION OF STRUCTURES</b> STRUCTURE DESIGN	BRIDGE NO. 54-0499 KILOMETER POST 76.3	<b>BELL MOUNTAIN WASH BRIDGE (WIDEN)</b>
DRAWN BY Irma G-Remmen 9/01	CHECKED BY H. Valencia 10/01		CU 08 EA 355521			<b>LOG OF TEST BORINGS 5 OF 7</b>






DIST	COUNTY	ROUTE	KILOMETER TOTAL PROJECT	POST TOTAL	SHEET No	TOTAL SHEETS
08	SBd	15				

10-30-01  
 REGISTERED CIVIL ENGINEER  
 Mark Desalvatore  
 No. 39499  
 Exp. 12-31-01  
 CIVIL  
 STATE OF CALIFORNIA

PLANS APPROVAL DATE \_\_\_\_\_  
 The State of California or its officers or agents shall not be responsible for the accuracy or completeness of electronic copies of this plan sheet.

WEATHERING DESCRIPTORS							Modified from United States Bureau of Reclamation, Engineering Geology Field Manual.
Descriptors		Diagnostic features				General characteristics (strength, excavation, etc.) <sup>5</sup>	
Alphanumeric descriptor	Descriptive term	Chemical weathering-Discoloration and/or oxidation		Mechanical weathering- Grain boundary conditions (disaggregation) primarily for granitics and some coarse-grained sediments	Texture and solutioning		
		Body of rock	Fracture surfaces <sup>†</sup>		Texture	Solutioning	
W1	Fresh	No discoloration, not oxidized.	No discoloration or oxidation.	No separation, intact (tight).	No change.	No solutioning.	Hammer rings when crystalline rocks are struck. Almost always rock excavation except for naturally weak or weakly cemented rocks such as siltstones or shales.
W2	Slightly weathered to fresh <sup>°</sup>						
W3	Slightly weathered	Discoloration or oxidation is limited to surface of, or short distance from, fractures; some feldspar crystals are dull.	Minor to complete discoloration or oxidation of most surfaces.	No visible separation, intact (tight).	Preserved.	Minor leaching of some soluble minerals may be noted.	Hammer rings when crystalline rocks are struck. Body of rock not weakened. With few exceptions, such as siltstones or shales, classified as rock excavation.
W4	Moderately to slightly weathered <sup>°</sup>						
W5	Moderately weathered	Discoloration or oxidation extends from fractures usually throughout; Fe-Mg minerals are "rusty," feldspar crystals are "cloudy."	All fracture surfaces are discolored or oxidized.	Partial separation of boundaries visible.	Generally preserved.	Soluble minerals may be mostly leached.	Hammer does not ring when rock is struck. Body of rock is slightly weakened. Depending on fracturing, usually is rock excavation except in naturally weak rocks such as siltstones or shales.
W6	Intensely to moderately weathered <sup>°</sup>						
W7	Intensely weathered	Discoloration or oxidation throughout; all feldspars and Fe-Mg minerals are altered to clay to some extent; or chemical alteration produces in-situ disaggregation, see grain boundary conditions.	All fracture surfaces are discolored or oxidized, surfaces friable.	Partial separation, rock is friable; in some conditions granitics are disaggregated.	Texture altered by chemical weathering (hydration, argillation).	Leaching of soluble minerals may be complete.	Dull sound when struck with hammer, usually can be broken with moderate to heavy manual pressure or by light hammer blow without reference to planes of weakness such as incipient or hairline fractures, or veinlets. Rock is significantly weakened. Usually common excavation.
W8	Very intensely weathered						
W9	Decomposed	Discolored or oxidized throughout, but resistant minerals such as quartz may be unaltered; all feldspars and Fe-Mg minerals are completely altered to clay.		Complete separation of grain boundaries (disaggregated).	Resembles a soil, partial or complete remnant rock structure may be preserved; leaching of soluble minerals usually complete.		Can be granulated by hand. Always common excavation. Resistant minerals such as quartz may be present as "stringers" or "dikes."

Notes: This chart and its horizontal categories are more readily applied to rocks with feldspars and mafic minerals. Weathering in various sedimentary rocks, particularly limestones and poorly indurated sediments, will not always fit the categories established. This chart and weathering categories may have to be modified for particular site conditions or alteration such as hydrothermal effects; however, the basic framework and similar descriptors are to be used.  
<sup>°</sup> Combination descriptors are permissible where equal distribution of both weathering characteristics are present over significant intervals or where characteristics present are "in between" the diagnostic feature. However, dual descriptors should not be used where significant, identifiable zones can be delineated. When given as a range only two adjacent terms may be combined. "Decomposed to slightly weathered," or "moderately weathered to fresh" are not acceptable.  
<sup>†</sup> Does not include directional weathering along shears or faults and their associated features. For example, a shear zone that carried weathering to great depths into a fresh rock mass would not require the rock mass to be classified as weathered.  
<sup>5</sup> These are generalizations and should not be used as diagnostic features for weathering or excavation classification. These characteristics vary to a large extent based on naturally weak materials or cementation and type of excavation.

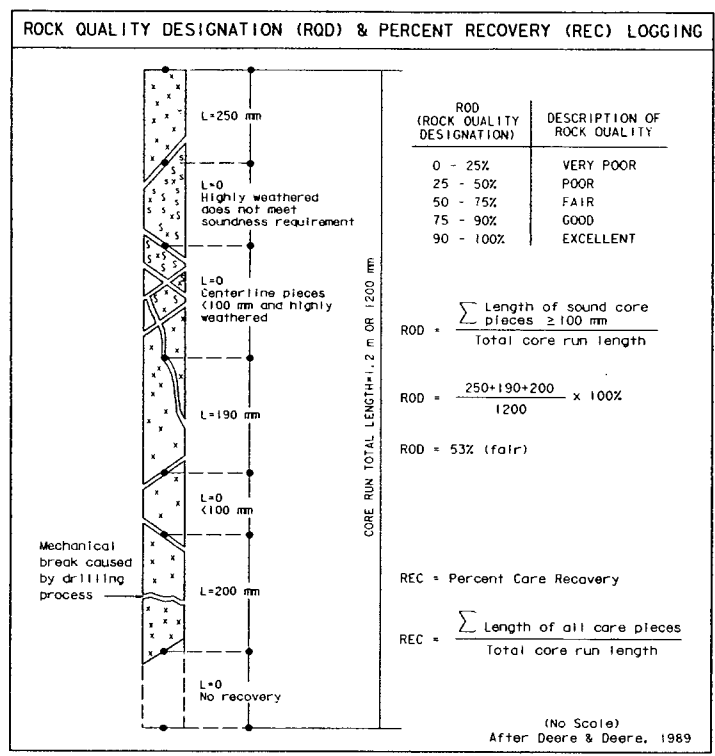

### FRACTURE DENSITY

Modified from United States Bureau of Reclamation, Engineering Geology Field Manual.

**FRACTURE DENSITY**- Based on the spacing of all natural fractures in an exposure or core recovery lengths in boreholes; excludes mechanical breaks, shears, and shear zones; however, shear-disrupted zones (fracturing outside the shear) are included. Descriptors for fracture density apply to all rock exposures such as tunnel walls, dazer trenches, outcrops, or foundation cut slopes and inverts, as well as boreholes. Descriptive criteria presented below are based on borehole cores where lengths are measured along the core axis, for other exposures the criteria is distance measured between fractures (size of blocks).

**UNFRACTURED (FD0):** No fractures.

**VERY SLIGHTLY FRACTURED (FD1):** Core recovered mostly in lengths greater than 1 m.

**SLIGHTLY TO VERY SLIGHTLY FRACTURED (FD2)\***

**SLIGHTLY FRACTURED (FD3):** Core recovered mostly in lengths from 300 to 1000 mm, with few scattered lengths less than 300 mm or greater than 1000 mm.

**MODERATELY TO SLIGHTLY FRACTURED (FD4)\***

**MODERATELY FRACTURED (FD5):** Core recovered mostly in 100 to 300 mm lengths with most lengths about 200 mm.

**INTENSELY TO MODERATELY FRACTURED (FD6)\***

**INTENSELY FRACTURED (FD7):** Lengths average from 30 to 100 mm with scattered fragmented intervals. Core recovered mostly in lengths less than 100 mm.

**VERY INTENSELY TO INTENSELY FRACTURED (FD8)\***

**VERY INTENSELY FRACTURED (FD9):** Core recovered mostly as chips and fragments with a few scattered short core lengths.

\* Combinations of fracture densities (e.g. very intensely to intensely fractured, or moderately to slightly fractured) are used where equal distribution of both fracture density characteristics are present over a significant interval or exposure, or where characteristics are "in between" the descriptor definitions.

### ROCK HARDNESS DESCRIPTORS

Alphanumeric Descriptor	Descriptor	Criteria
H1	Extremely hard	Core, fragment, or exposure cannot be scratched with knife or sharp pick; can only be chipped with repeated heavy hammer blows.
H2	Very hard	Cannot be scratched with knife or sharp pick. Core or fragment breaks with repeated heavy hammer blows.
H3	Hard	Can be scratched with knife or sharp pick with difficulty (heavy pressure). Heavy hammer blow required to break specimen.
H4	Moderately hard	Can be scratched with knife or sharp pick with light or moderate pressure. Core or fragment breaks with moderate hammer blow.
H5	Moderately soft	Can be grooved 2 mm deep by knife or sharp pick with moderate or heavy pressure. Core or fragment breaks with light hammer blow or heavy manual pressure.
H6	Soft	Can be grooved or gouged easily by knife or sharp pick with light pressure, can be scratched with fingernail. Breaks with light to moderate manual pressure.
H7	Very soft	Can be readily indented, grooved or gouged with fingernail, or carved with a knife. Breaks with light manual pressure.

Any bedrock unit softer than H7, very soft, is to be described using ASTM D-2488 consistency descriptors.

Note: Although "sharp pick" is included in these definitions, descriptions of ability to be scratched, grooved or gouged by a knife is the preferred criteria.

Modified from United States Bureau of Reclamation, Engineering Geology Field Manual.

### BEDDING, FOLIATION, OR FLOW TEXTURE DESCRIPTORS

Descriptors	Thickness / Spacing
Massive	Greater than 3 m
Very thickly bedded, foliated, or banded	1 to 3 m
Thickly	300 mm to 1 m
Moderately	100 to 300 mm
Thinly	30 to 100 mm
Very thinly	10 to 30 mm
Laminated (intensely foliated or banded)	Less than 10 mm

Modified from United States Bureau of Reclamation, Engineering Geology Field Manual.

<b>ENGINEERING SERVICE CENTER</b>		<b>STRUCTURE FOUNDATIONS</b>		FIELD INVESTIGATION BY: R. Fuentes M. Pagenkopp H. Valencia		<b>STATE OF CALIFORNIA</b> DEPARTMENT OF TRANSPORTATION		BRIDGE NO. 54-0499 KILOMETER POST 76.3		<b>BELL MOUNTAIN WASH BRIDGE (WIDEN)</b>	
DRAWN BY Irma G-Rennen 9/01		CHECKED BY H. Valencia 10/01				<b>DIVISION OF STRUCTURES</b> <b>STRUCTURE DESIGN</b>				<b>LOG OF TEST BORINGS 6 OF 7</b>	
DSF GEOLOGIST LOG OF TEST BORINGS SHEET (METRIC) (REV. 10/5/2000)		ORIGINAL SCALE IN MILLIMETERS FOR REDUCED PLANS		CU 08 EA 355521		DISREGARD PRINTS BEARING EARLIER REVISION DATES		REVISION DATES (PRELIMINARY STAGE ONLY)		SHEET 6 OF 7	

FILE -> /user/dms/local/translab/08-355520/bellmtn6.dgn

DATE PLOTTED -> 30 OCT 2001 TIME PLOTTED -> 15:43:39 USERNAME -> t8ddp

10/11/57  
 10/11/57  
 10/11/57

DIVISION OF ENGINEERING SERVICES - OFFICE OF GEOTECHNICAL SERVICES


As-Built Log of Test Borings sheet is considered an informational document only. As such, certificate expiration date confirm that this is a true and accurate copy of the original document. It does not attest to the accuracy or validity of the information contained in the any bidder, contractor or other interested party.

DIST.	COUNTY	ROUTE	KILOMETER POST - TOTAL PROJECT	Sheet No.	Total Sheets
08	Sbd	15		7	7

REGISTERED ENGINEER - CIVIL  
 Mark DeSalvatore  
 No. 38499  
 Exp. 12-31-01  
 CIVIL  
 STATE OF CALIFORNIA

**BELL MOUNTAIN WASH BRIDGE (WIDEN)**  
**LOG OF TEST BORINGS 7 OF 7**

NOTE: A COPY OF THIS LOG OF TEST BORINGS IS AVAILABLE AT OFFICE OF STRUCTURE MAINTENANCE AND INVESTIGATIONS, SACRAMENTO, CALIFORNIA  
 CU: 08  
 EA: 355521  
 BRIDGE No. 54-0499

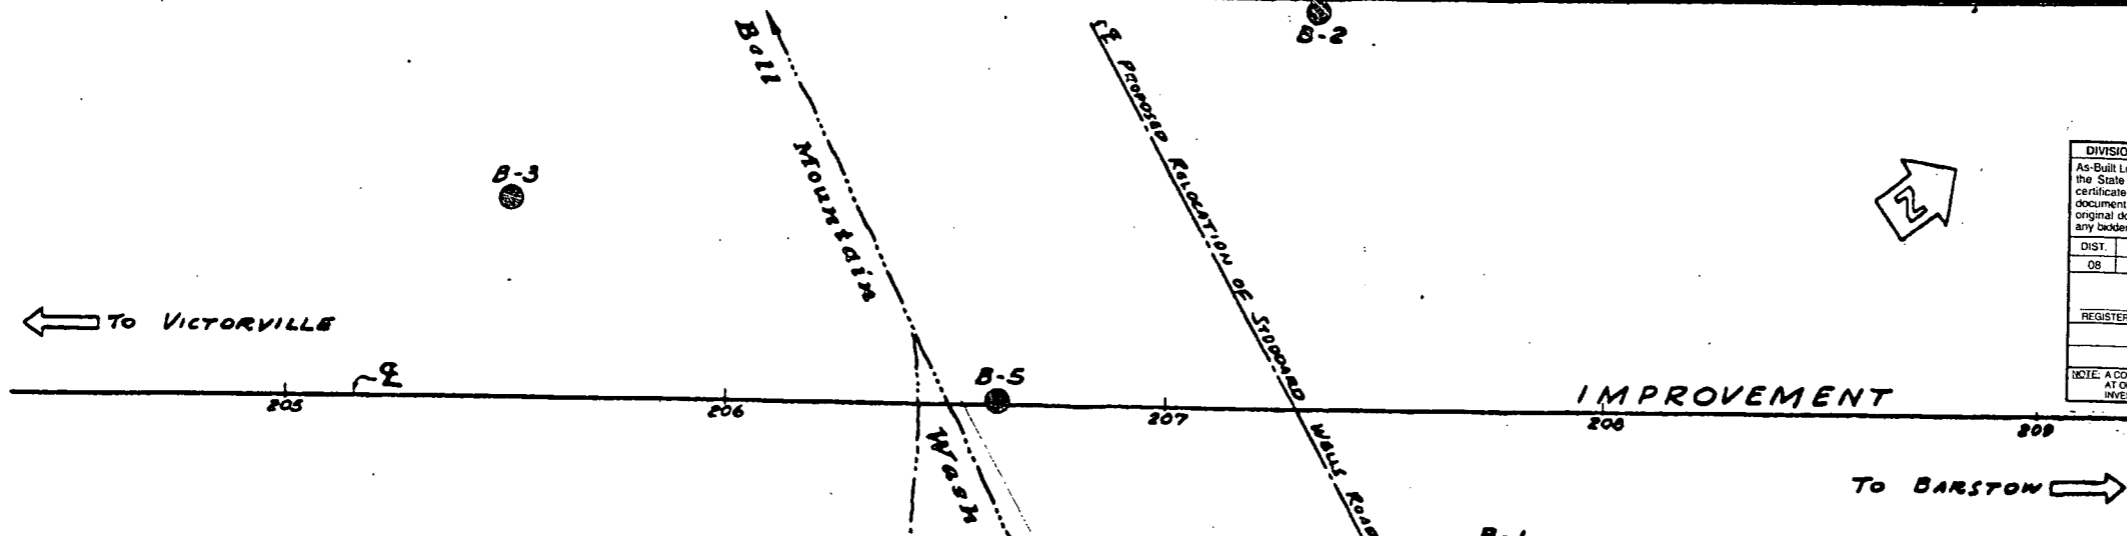

Pile #74  
 Pile # Blows/ft.


1	1
2	2
3	3
4	6
5	8
6	7
7	7
8	7
9	8
10	6
11	5
12	5
13	7
14	13
15	11
16	13
17	13
18	25
19	50

**DESIGN PILE LOADING: 45T**  
**PILE TYPE: RH-40 STEEL**  
**TOTAL NUMBER PILES: 22**  
**LINEAL FT PILES, PLAN: 600**  
**LINEAL FT PILES, 'AS BUILT' 633.5**  
**HAMMER: VULCAN No. 1**

Revisions made to this Log of Test Borings from the original 1955 Log of Test Borings are the addition of the following table and notes:


Boring	Station	Offset from 'CL Route 15'
B-3	113+54.135	13.110 m Left
B-4	113+67.546	12.800 m Right
B-5	113+87.968	0.305 m Left
B-2	114+10.219	26.210 m Left
B-1	114+22.716	9.450 m Right

Notes:  
 1. See the General Plan and/or Foundation Plan for Metric Stationing.  
 2. The Division of Structure Design produced the data presented in the table above. The data are the metric locations for the As-Built Test Borings referenced to the centerline of Route 15 as shown on the General Plan (dated 9-7-00). This table is presented on the As-Built Log of Test Boring sheet for the convenience of any bidder, contractor or other interested party.  
 3. In the table above, the Metric Boring Locations are based on NAD 83 horizontal datum.

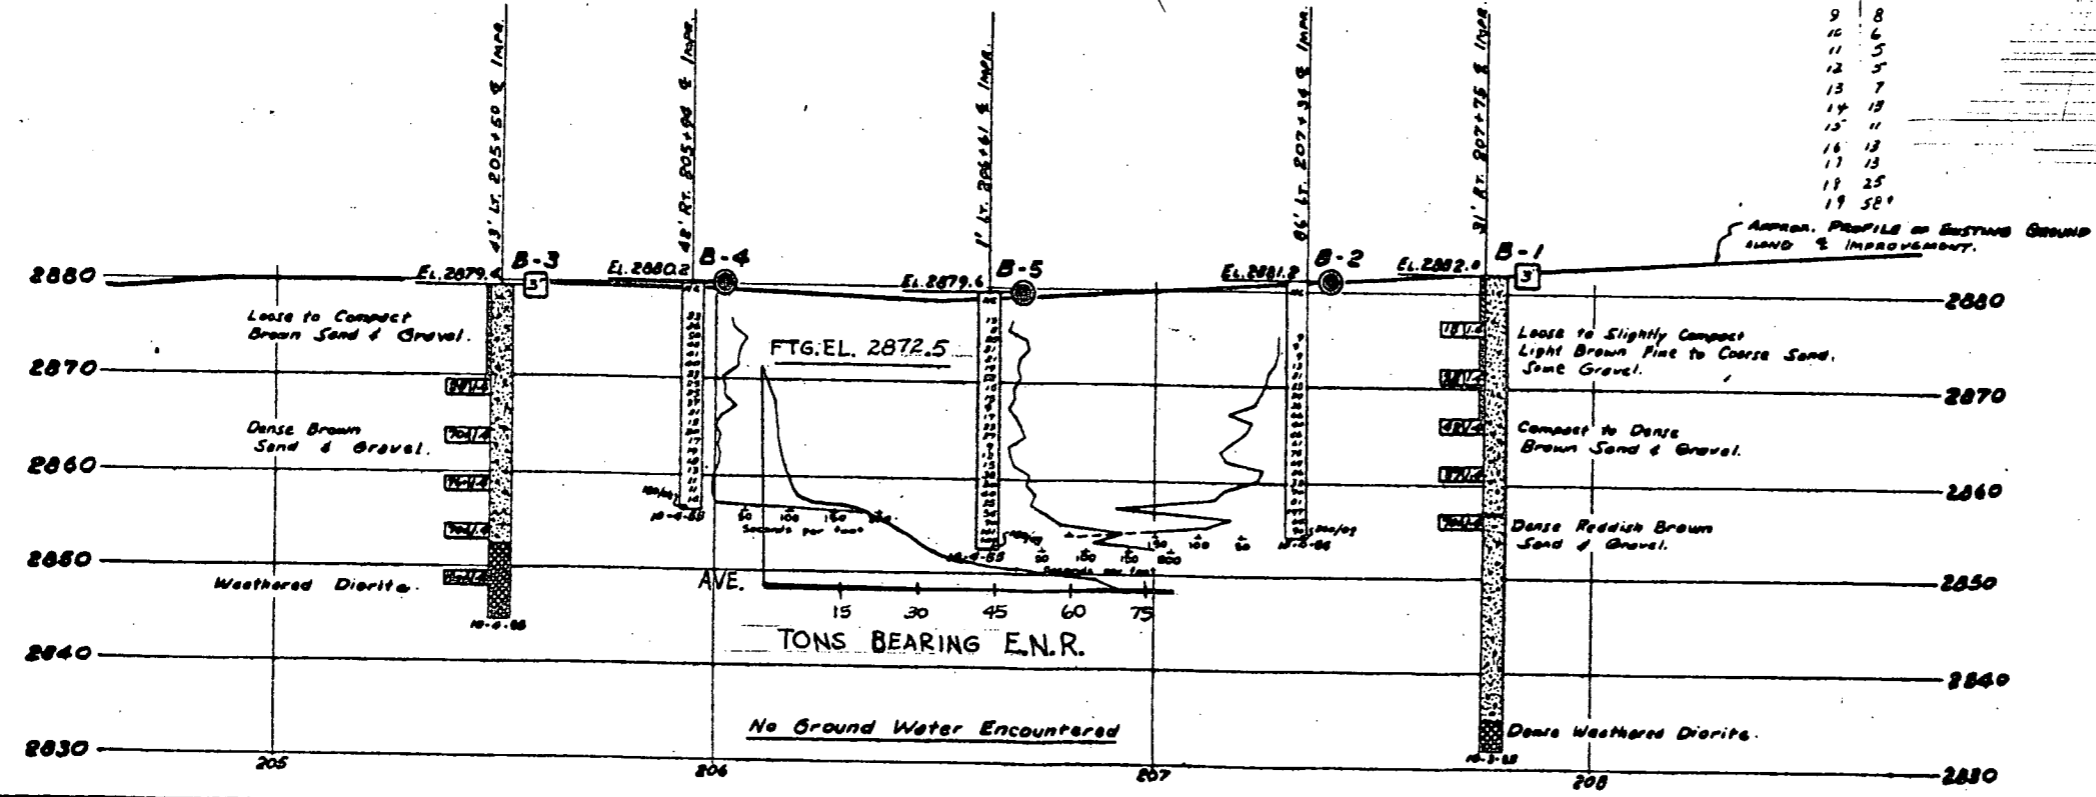


**AS BUILT**  
 CORRECTIONS BY A. KECCHIVAL  
 CONTRACT NO. 08-119A04  
 DATE 7-25-69

B.M. "Q" 21-A-54  
 RWD 2 x 2 1/2" Deep, 69" Rt. Sta.  
 207+781 & EAST RDB.  
 Elev. 2850.15

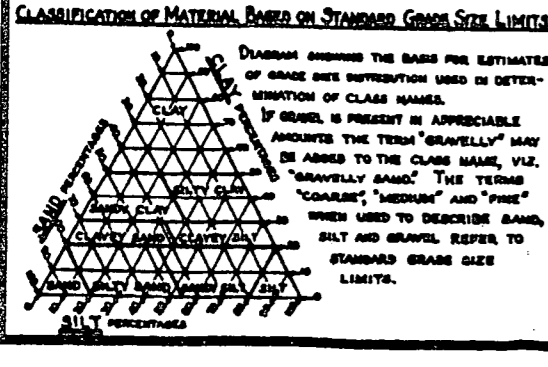

**LEGEND OF EARTH MATERIALS**

GRAVEL	SILTY CLAY OR CLAYEY SILT
SAND	PEAT AND/OR ORGANIC MATTER
SILT	FILL MATERIAL
CLAY	IGNEOUS ROCK
SANDY CLAY OR CLAYEY SAND	SEDIMENTARY ROCK
SANDY SILT OR SILTY SAND	METAMORPHIC ROCK

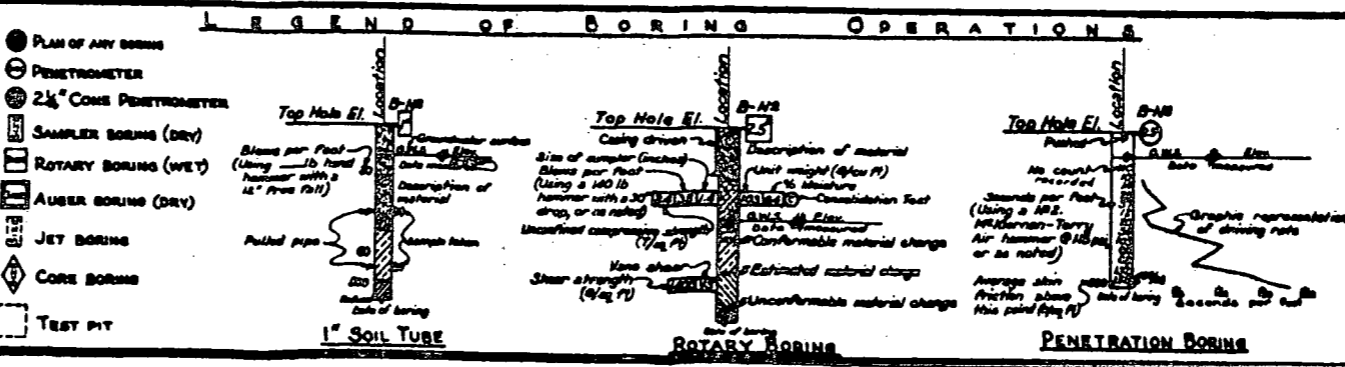

**NOTES**

The contractor's attention is directed to Section 2, Article (c) of the Standard Specifications and to the Special Provisions accompanying this set of plans. Classification of earth material as shown on this sheet is based upon field inspection and is not to be construed to imply mechanical analysis.

58-8VC4-F7

**BELL MOUNTAIN WASH BRIDGE**

**LOG OF TEST BORINGS**


Scale: Horiz. 1" = 50', Vert. 1" = 10'  
 SHEET 54-499  
 DRAWING C-4691-11

BRIDGE DEPARTMENT

North Victorville UP



BRIDGE DEPARTMENT

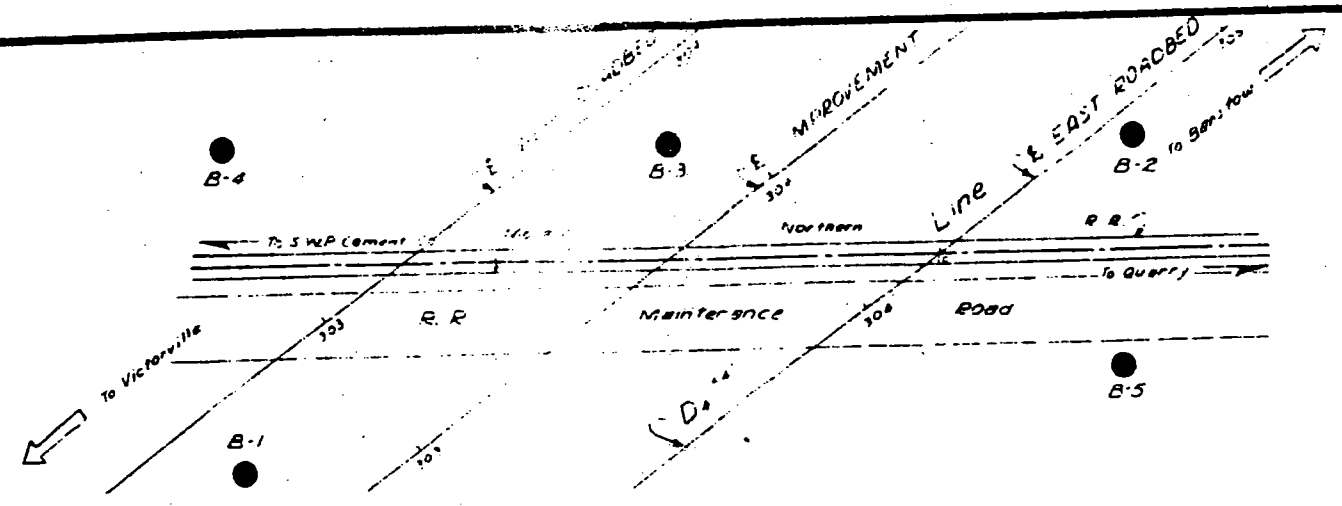

**DIVISION OF ENGINEERING SERVICES - OFFICE OF GEOTECHNICAL SERVICES**  
 As-Built Log of Test Borings sheet is considered an informational document only. As such, the State of California registration seal with signature, license number and registration certificate expiration date confirm that this is a true and accurate copy of the original document. It does not attest to the accuracy or validity of the information contained in the original document. This drawing is available and presented only for the convenience of any bidder, contractor or other interested party.

DIST.	COUNTY	ROUTE	KILOMETER POST - TOTAL PROJECT	Sheet No.	Total Sheets
08	Sbd	15			

REGISTERED ENGINEER: CIVIL  
 Mark DeSalvatore  
 No. 39499  
 Exp. 12-31-01  
 CIVIL  
 STATE OF CALIFORNIA



**NORTH VICTORVILLE UP (REPLACE)**  
**LOG OF TEST BORINGS 2 OF 2**

NOTE: A COPY OF THIS LOG OF TEST BORINGS IS AVAILABLE AT OFFICE OF STRUCTURE MAINTENANCE AND INVESTIGATIONS, SACRAMENTO, CALIFORNIA. CU: 08 EA: 356571 BRIDGE No. 54-1211

Revisions made to this Log of Test Borings from the original 1956 Log of Test Borings are the addition of the following table and notes:


Boring	Station	Offset from C/L Route 15
B-1	143+14.629	5.853 m Left
B-4	143+26.159	23.821 m Left
B-3	143+51.687	6.591 m Left
B-5	143+67.727	24.096 m Right
B-2	143+77.251	12.163 m Right

- Notes:
- See the General Plan and/or Foundation Plan for Metric Stationing.
  - The Division of Structure Design produced the data presented in the table above. The data are the metric locations for the As-Built Test Borings referenced to the centerline of Route 15 as shown on the General Plan (dated 9-14-00). This table is presented on the As-Built Log of Test Boring sheet for the convenience of any bidder, contractor or other interested party.
  - In the table above, the Metric Boring Locations are based on NAD 83 horizontal datum.

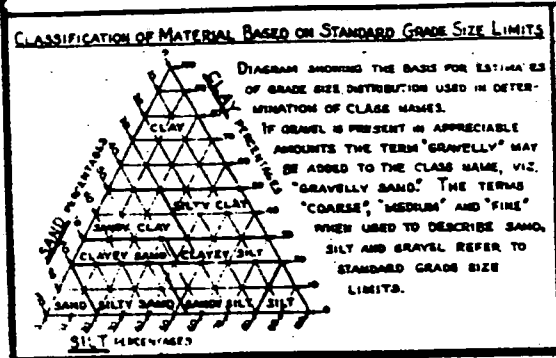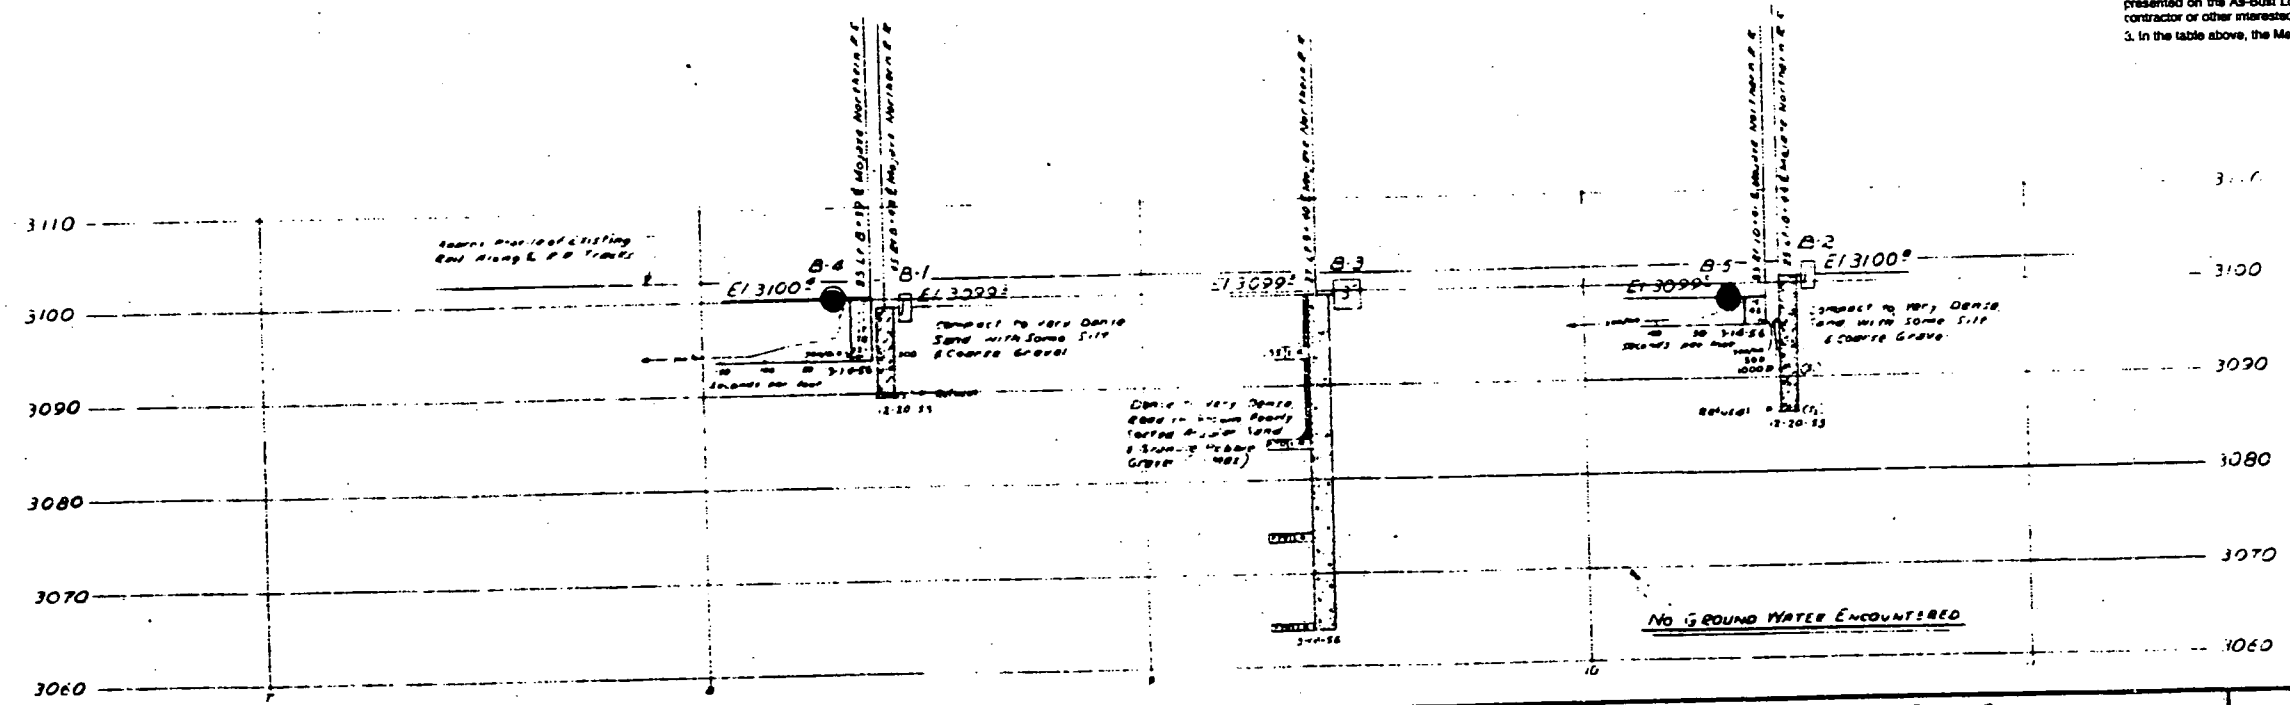

**LEGEND OF EARTH MATERIALS**

GRAVEL	SILTY CLAY OR CLAYEY SILT
SAND	PEAT AND/OR ORGANIC MATTER
SILT	FILL MATERIAL
CLAY	IGNEOUS ROCK
SANDY CLAY OR CLAYEY SAND	SEDIMENTARY ROCK
SANDY SILT OR SILTY SAND	METAMORPHIC ROCK

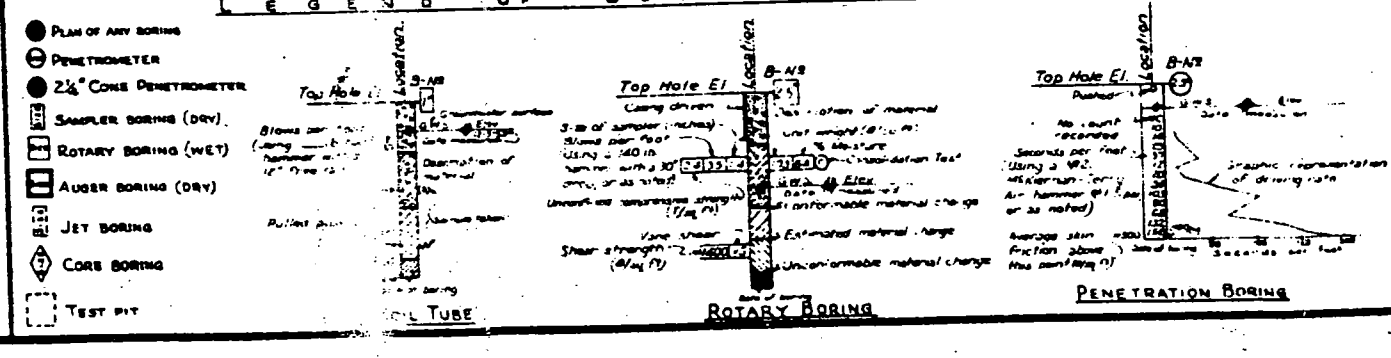

**NOTES**

The contractor's attention is directed to Section 2, Article 11 of the Standard Specifications and to the Special Provisions accompanying the set of plans. Classification of earth material as shown on this sheet is based upon field inspection and is not to be construed to imply mechanical analysis.

50-BVC1-E1

**NORTH VICTORVILLE U.P.**  
**LOG OF TEST BORINGS**

SCALE: HORIZ. 1" = 40' VERT. 1" = 10' BRIDGE 54-514 FILE DRAWING






DIST	COUNTY	ROUTE	KILOMETER POST TOTAL PROJECT	SHEET No	TOTAL SHEETS
08	SBd	15			

10-30-01  
 REGISTERED CIVIL ENGINEER  
 Mark DeSalvatore  
 No. 39499  
 Exp. 12-31-01  
 CIVIL  
 STATE OF CALIFORNIA

PLANS APPROVAL DATE

The State of California or its officers or agents shall not be responsible for the accuracy or completeness of electronic copies of this plan sheet.

**BENCH MARK**  
 BM #CP-110 Elev. 937.082  
 Fd. 2X2 H&T in dirt median  
 Rte. 15, approx. Sta. 142.51  
 N 623609.920  
 E 2069428.081  
 NGVD1929

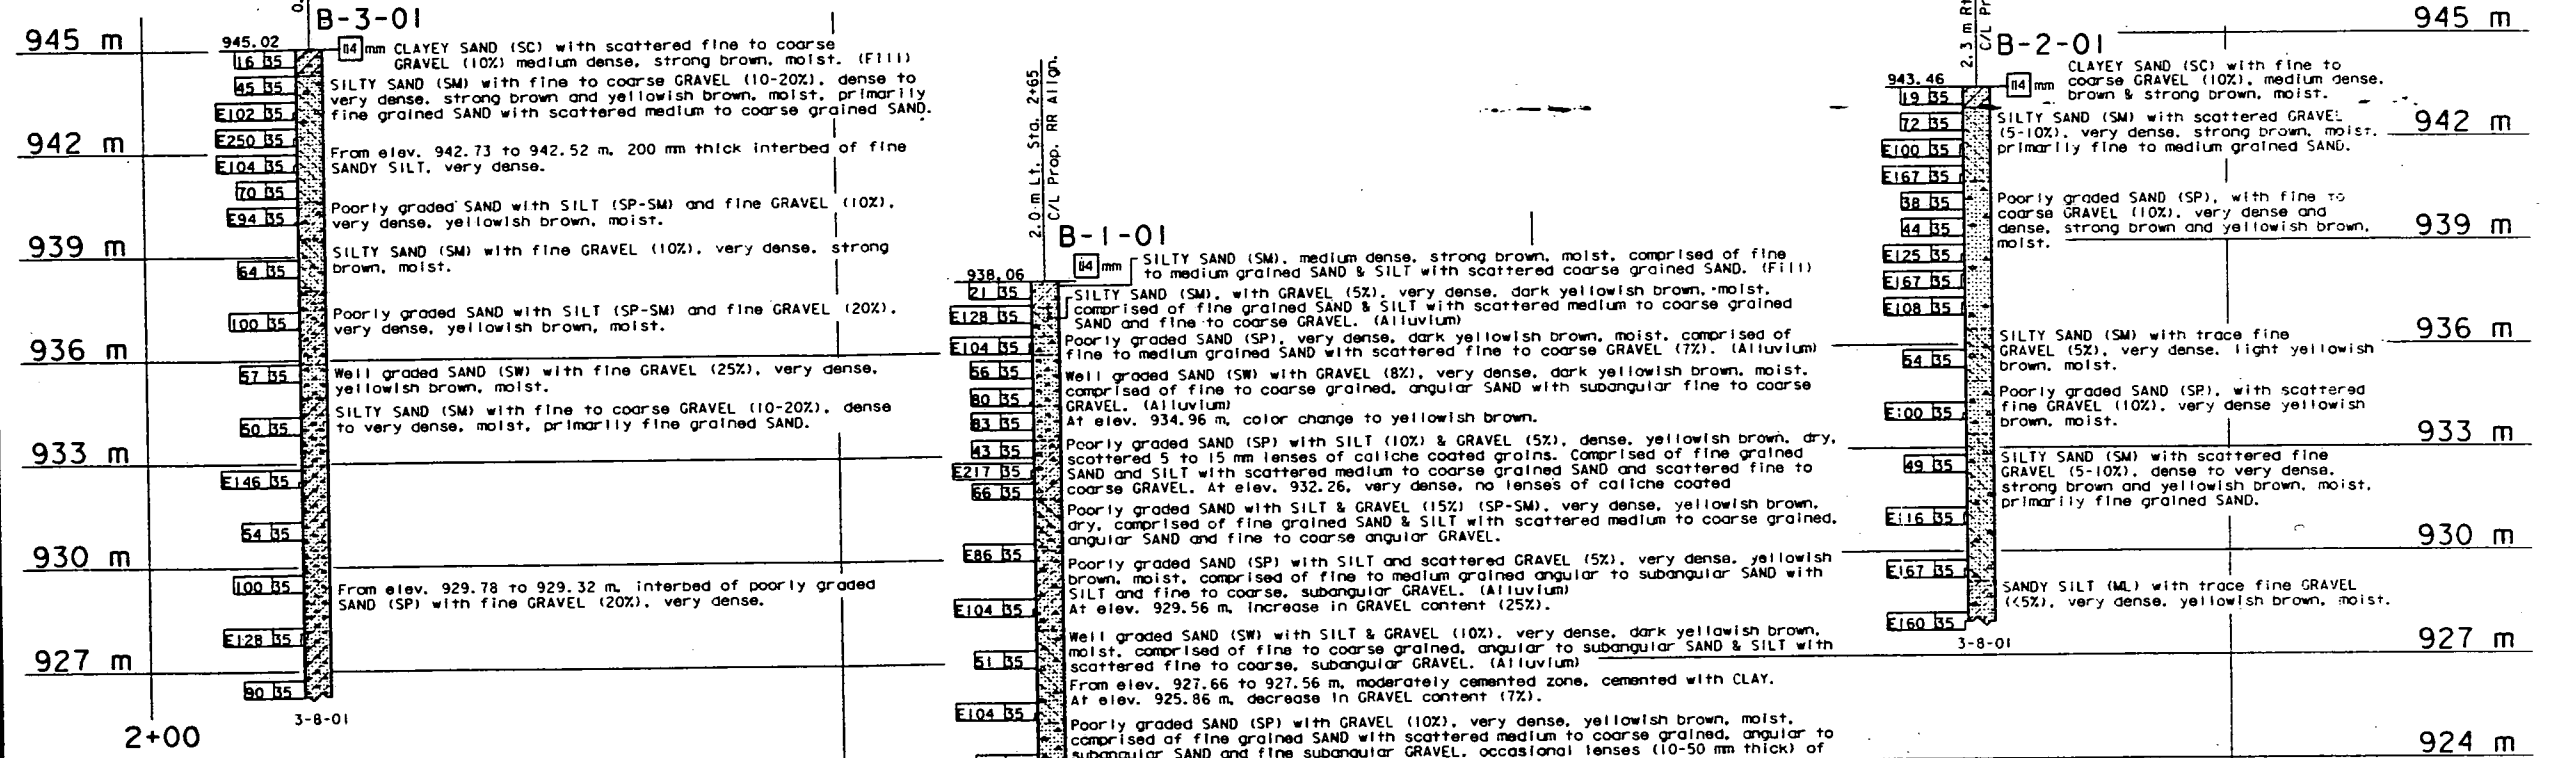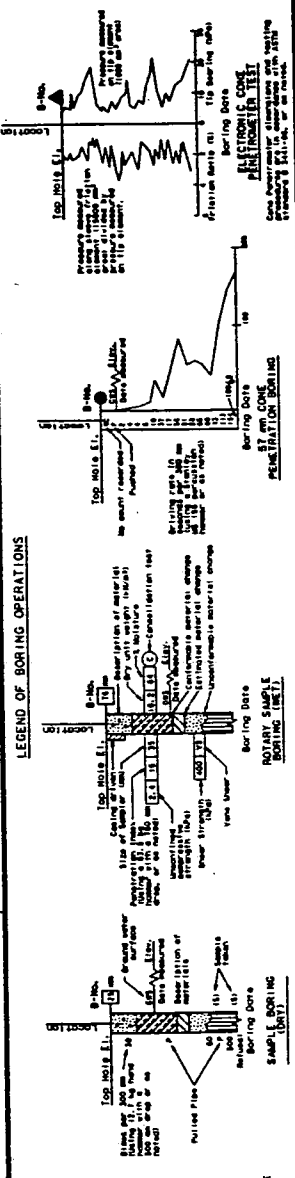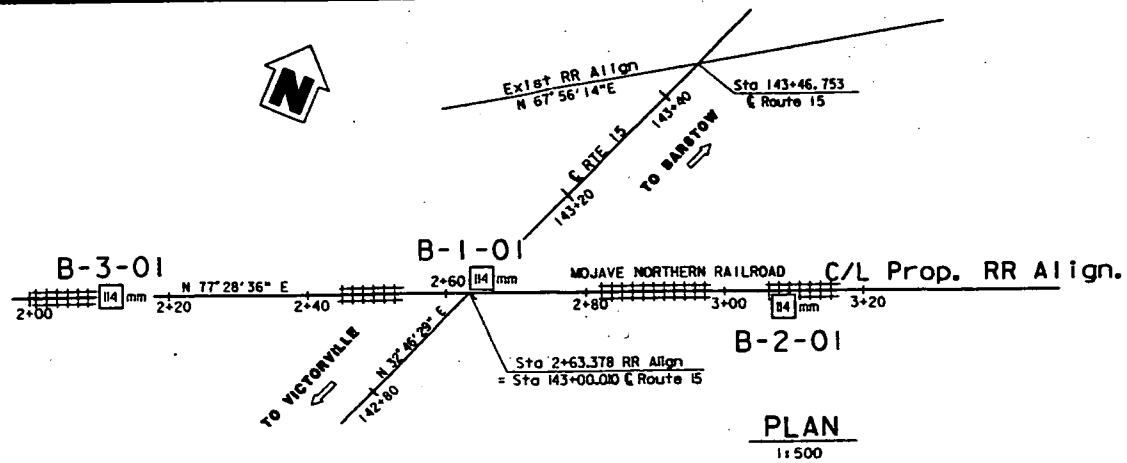

- NOTES:**
- Ground water was not measured in Borings B-1-01 and B-2-01.
  - Ground water was not encountered in Boring B-3-01.
  - The descriptions and classifications of rock and/or soil, including consistency and relative density descriptors, used by the field and/or office personnel for the exploration borings shown on this sheet are based on the "Soil and Rock Logging Classification Manual (Field Guide)," Engineering Service Center, Office of Structural Foundations, August 1996.
  - Soil colors were determined by using Munsell Soil Color Charts (1994, Revised Edition). Rock colors were determined using USGS rock color charts (1995, revised text).
  - Test borings B-1-01, B-2-01, and B-3-01, utilized a safety hammer to advance the sampler using a 63.5 kg hammer with a 760 mm drop. Penetration Index values shown are the actual blow counts recorded in the field.
  - E = Blow count for 0.3 m penetration extrapolated from blow count for less than 0.3 m penetration (due to change in material or hard driving).

**LEGEND OF EARTH MATERIALS**

CLAYEY SILT	CLAYEY SAND	CLAYEY SILT	CLAYEY SAND
CLAYEY SILT	CLAYEY SAND	CLAYEY SILT	CLAYEY SAND
CLAYEY SILT	CLAYEY SAND	CLAYEY SILT	CLAYEY SAND
CLAYEY SILT	CLAYEY SAND	CLAYEY SILT	CLAYEY SAND


**CONSISTENCY CLASSIFICATION FOR SOILS**

Very Loose	Loose	Medium Dense	Dense	Very Dense
Very Soft	Soft	Firm	Stiff	Hard

<b>ENGINEERING SERVICES</b>	<b>GEOTECHNICAL SERVICES</b>	FIELD INVESTIGATION BY:	<b>STATE OF CALIFORNIA</b>	<b>DIVISION OF STRUCTURES</b>	BRIDGE NO.	<b>NORTH VICTORVILLE UP (REPLACE)</b>
DRAWN BY: Irma G-Ramirez 9/01		H. Valencio, M. Pagenkopp	DEPARTMENT OF TRANSPORTATION	STRUCTURE DESIGN	54-1211	<b>LOG OF TEST BORINGS 1 OF 2</b>
CHECKED BY: M. Spahn 10/01					KILOMETER POST: 79.2	


**APPENDIX B**  
**LOCATIONS OF PROPOSED STRUCTURES**



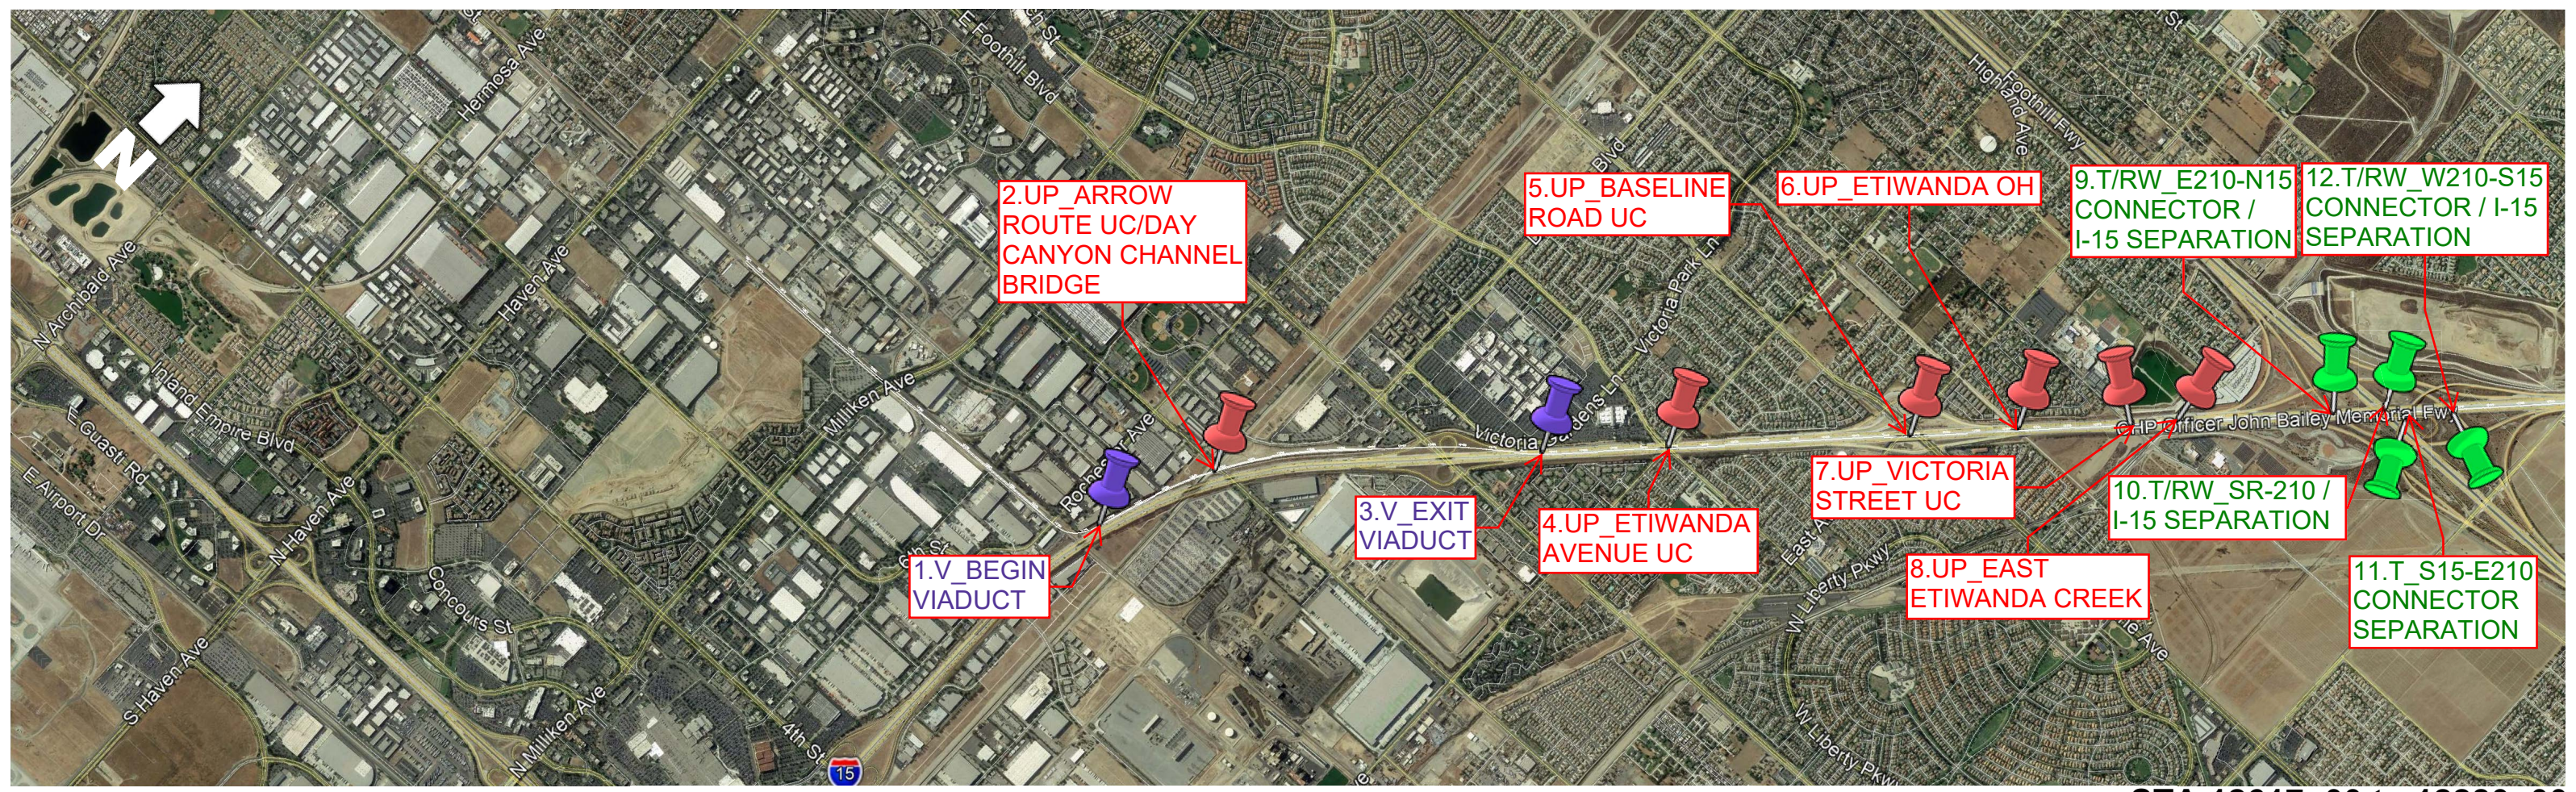

--- Viaduct (V)    --- Underpass (UP)    --- Trench (T)    --- Siderunning Trench (T/SR)

**STA 12617+00 to 12280+00**

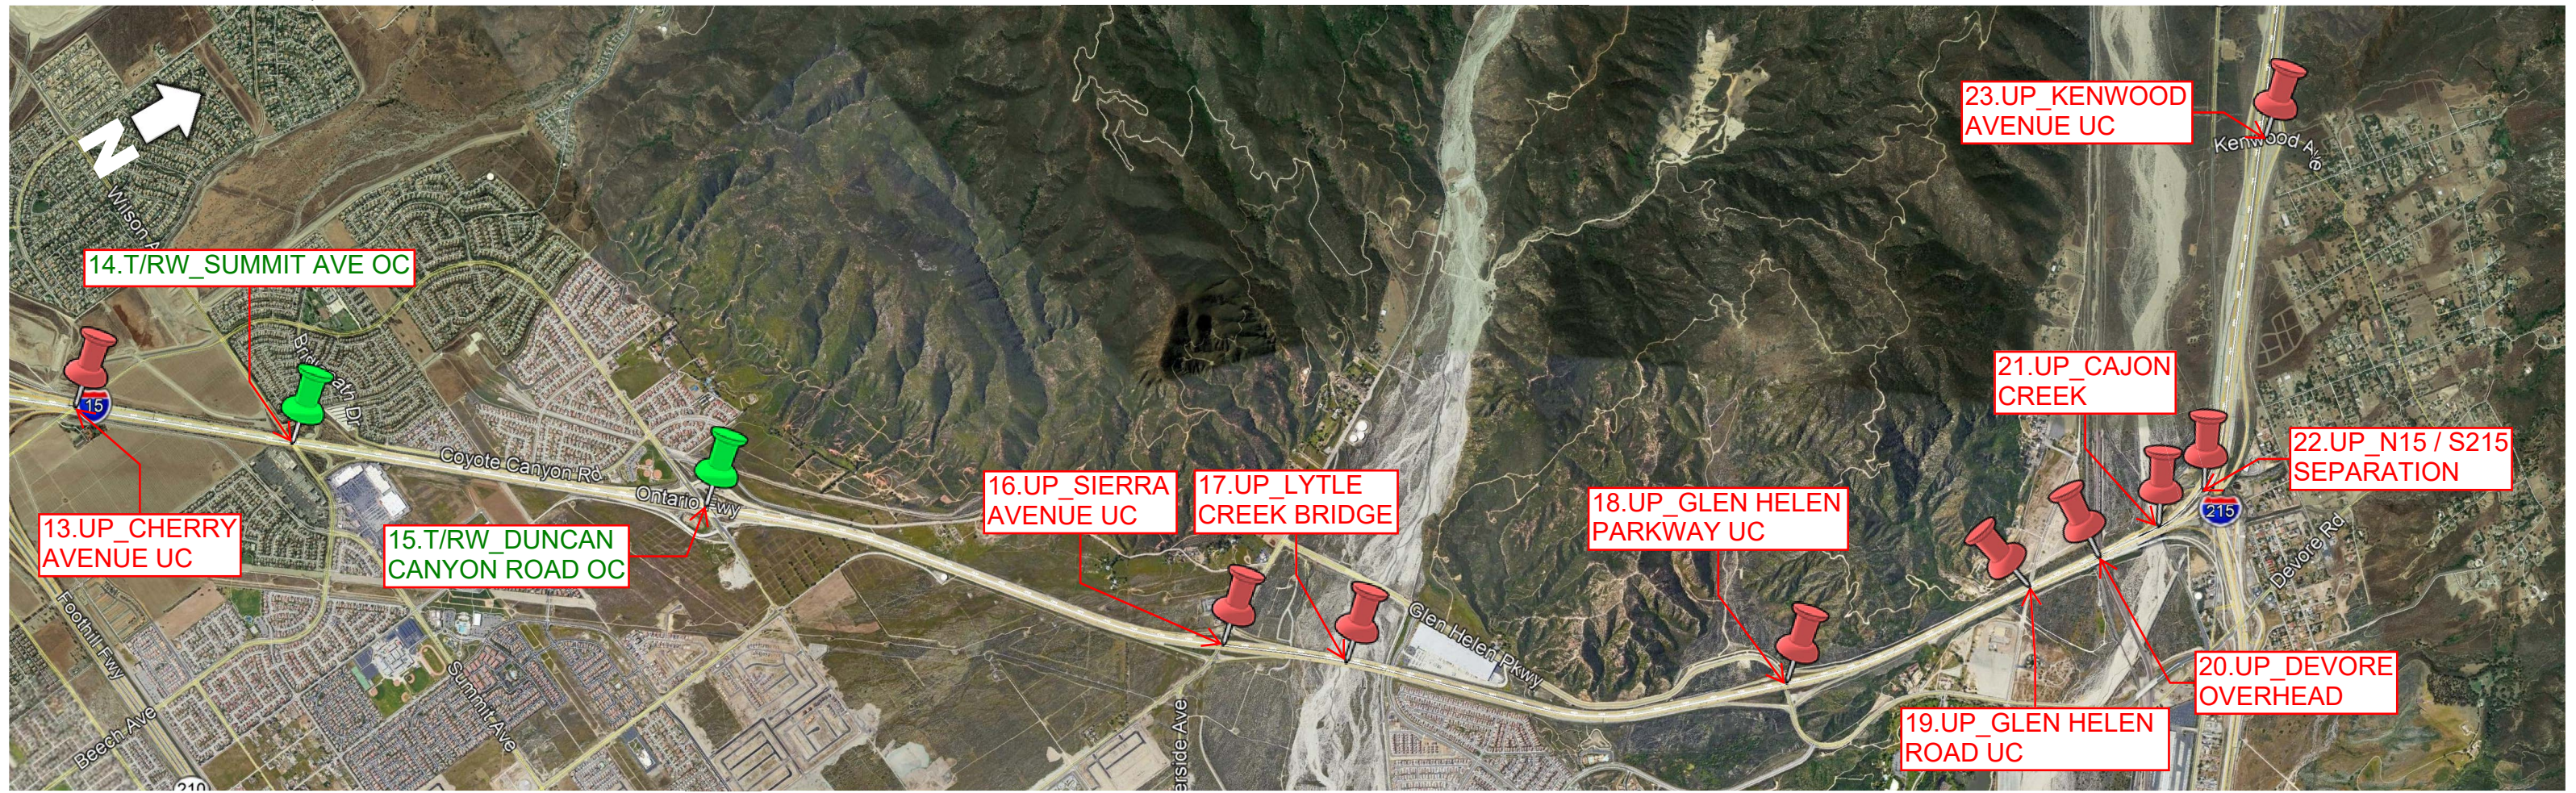


**STA 12280+00 to 11800+00**





**STA 11800+00 to 11310+00**

--- Viaduct (V)   
 --- Underpass (UP)   
 --- Trench (T)   
 --- Siderunning Trench (T/SR)

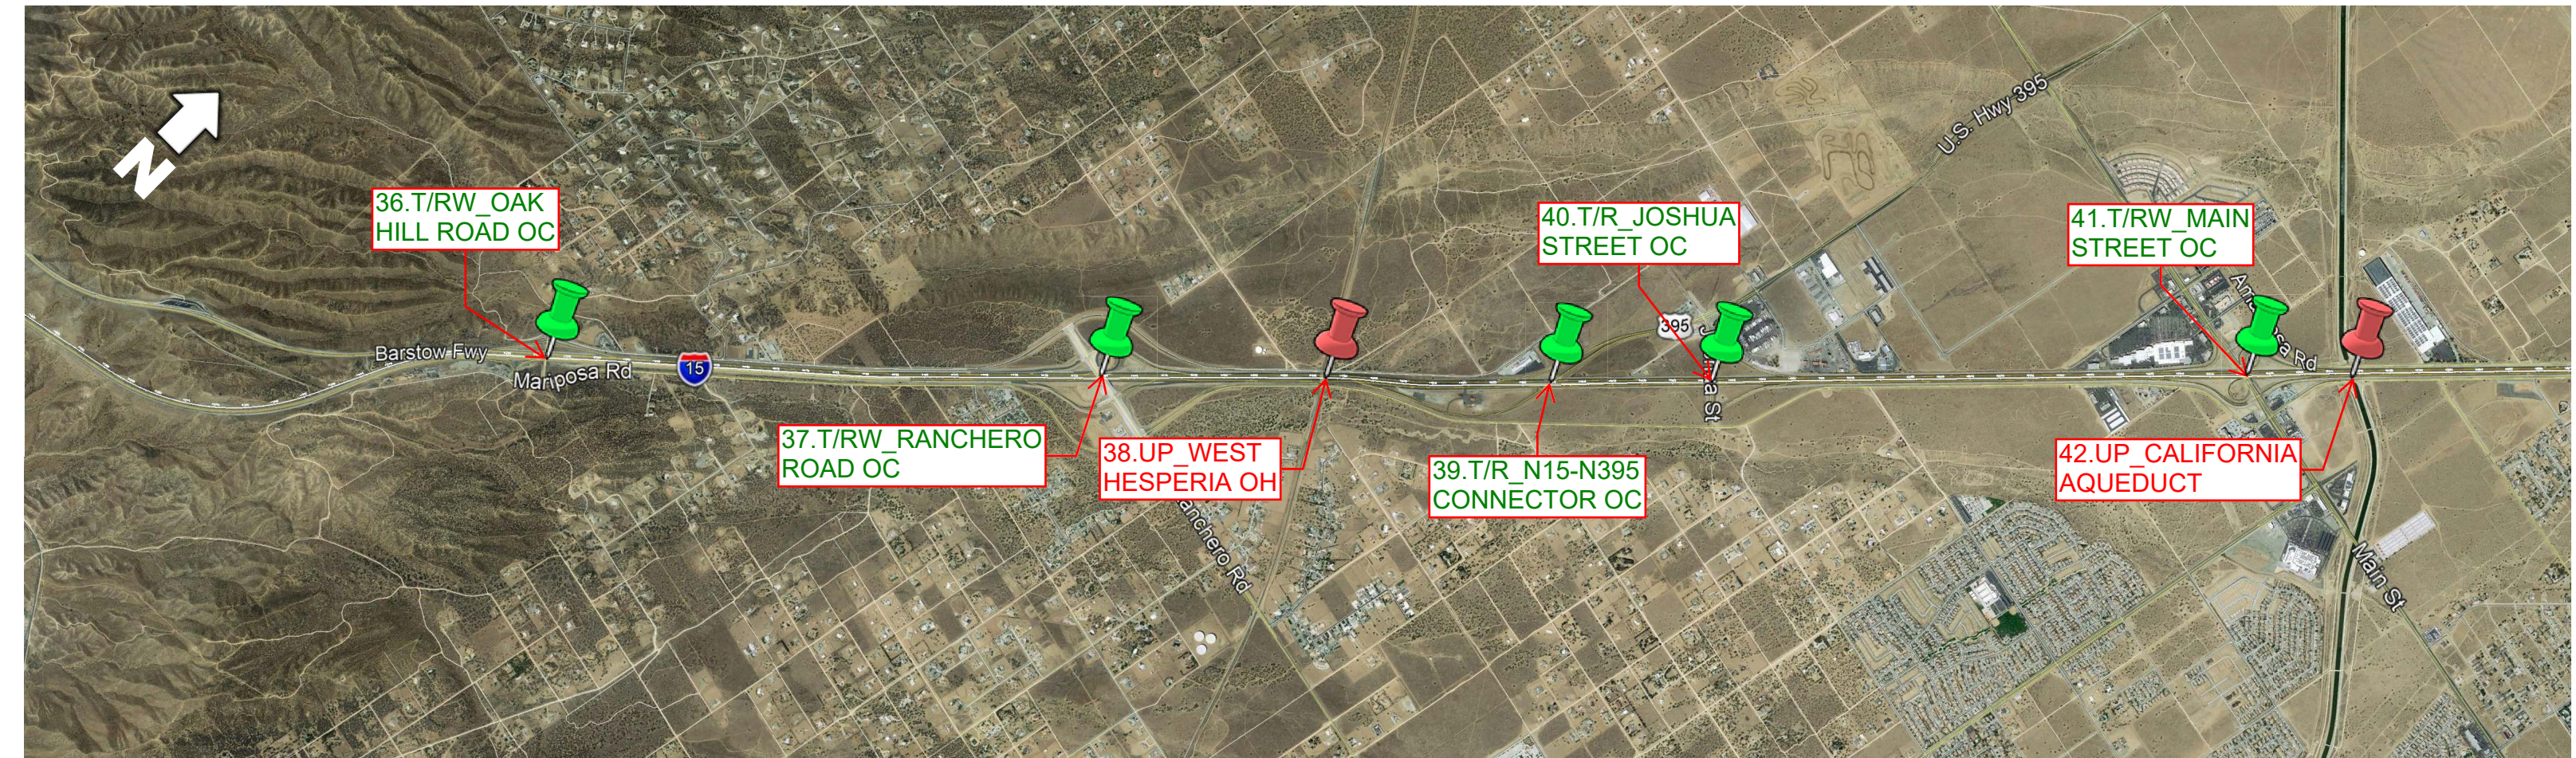

**STA 11310+00 to 10870+00**





📌 --- Viaduct (V)   
 📌 --- Underpass (UP)   
 📌 --- Trench (T)   
 📌 --- Siderunning Trench (T/SR)

**STA 10870+00 to 10430+00**



**STA 10430+00 to 10017+00**