


Attachment D
Revised Line Maps
Metro San Fernando Valley
Service Changes effective
December 17, 2006 or later

Metro Connections Line 91 (Branch Route of Line 90)

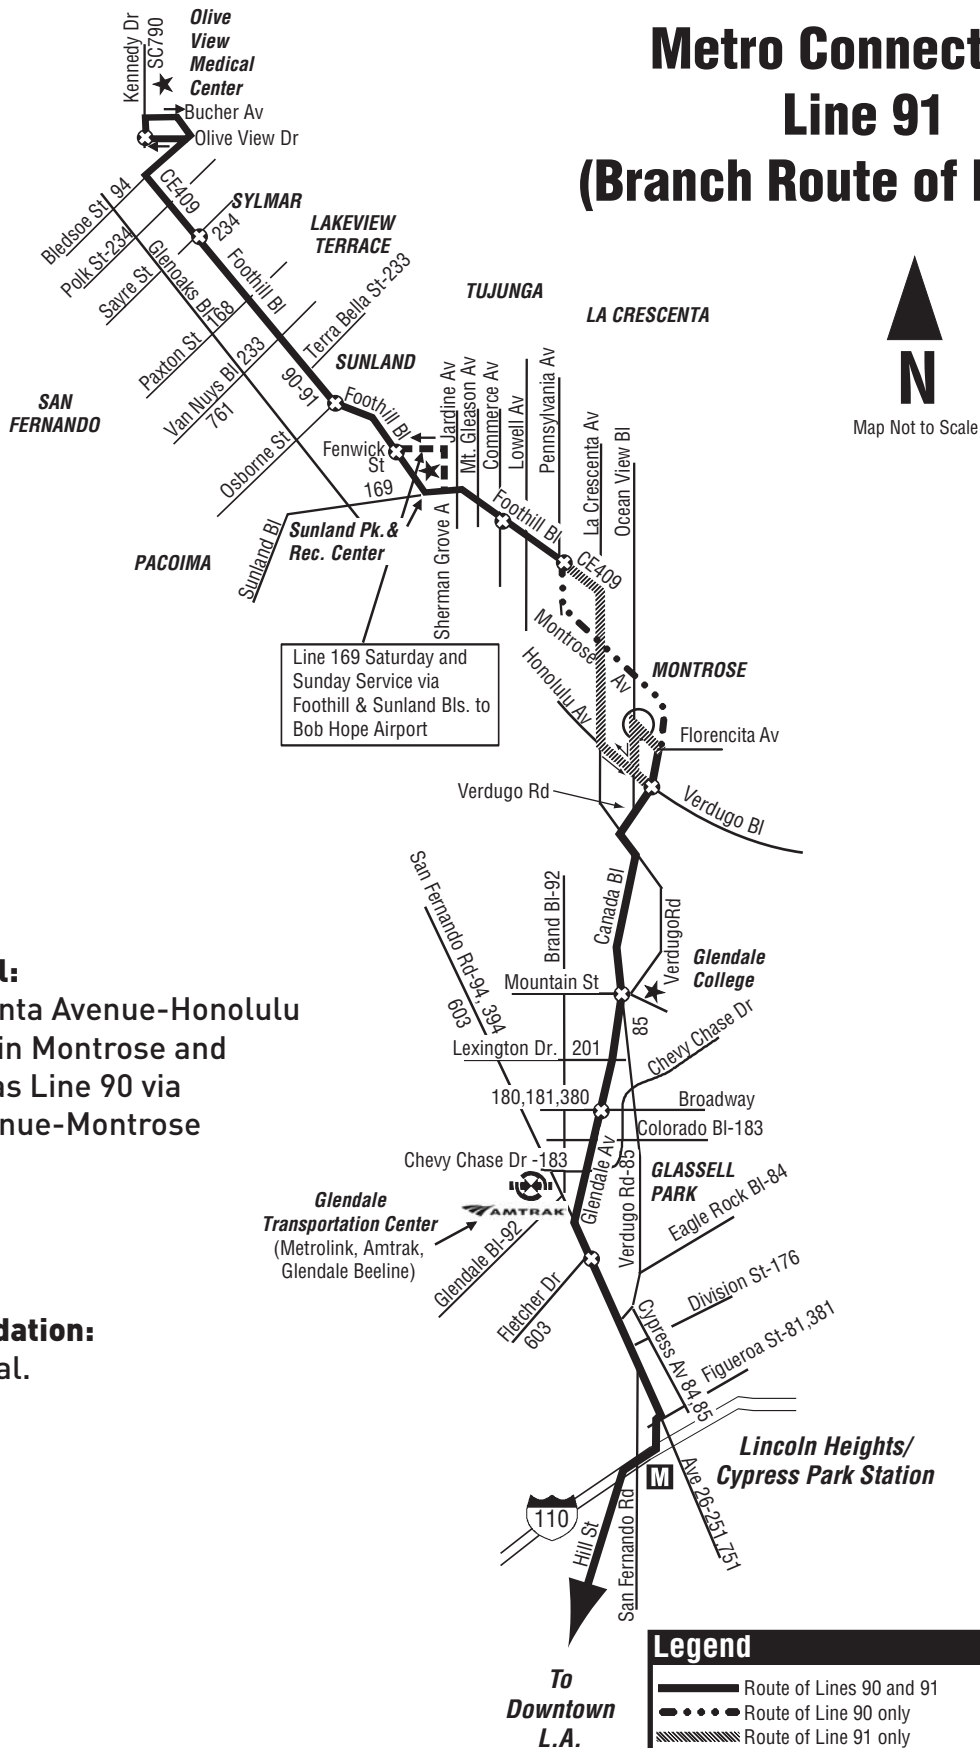

Original Proposal:

Cancel La Crescenta Avenue-Honolulu Avenue segment in Montrose and operate all trips as Line 90 via Pennsylvania Avenue-Montrose Avenue.

Staff Recommendation:

Withdraw proposal.

Legend	
	Route of Lines 90 and 91
	Route of Line 90 only
	Route of Line 91 only
	Shortline turnaround loop and route of Lines 90-91 continuing via Line 169 on weekends.
	Timepoints used on Timetable
	Santa Clarita Transit
	Metrolink Station
	Metro Station Entrance


Metro Connections

LINES 94 & 224

Line 224
*Olive View Hosp.
 To Universal City
 Red Line Station*

Original Proposal:

Operate as two separate lines: Line 94A via regular route from Olive View Medical Center to Sun Valley, then via Lankershim Boulevard to North Hollywood Station (see Line 166) and Line 94B via regular route from Sun Valley and to Downtown Los Angeles.

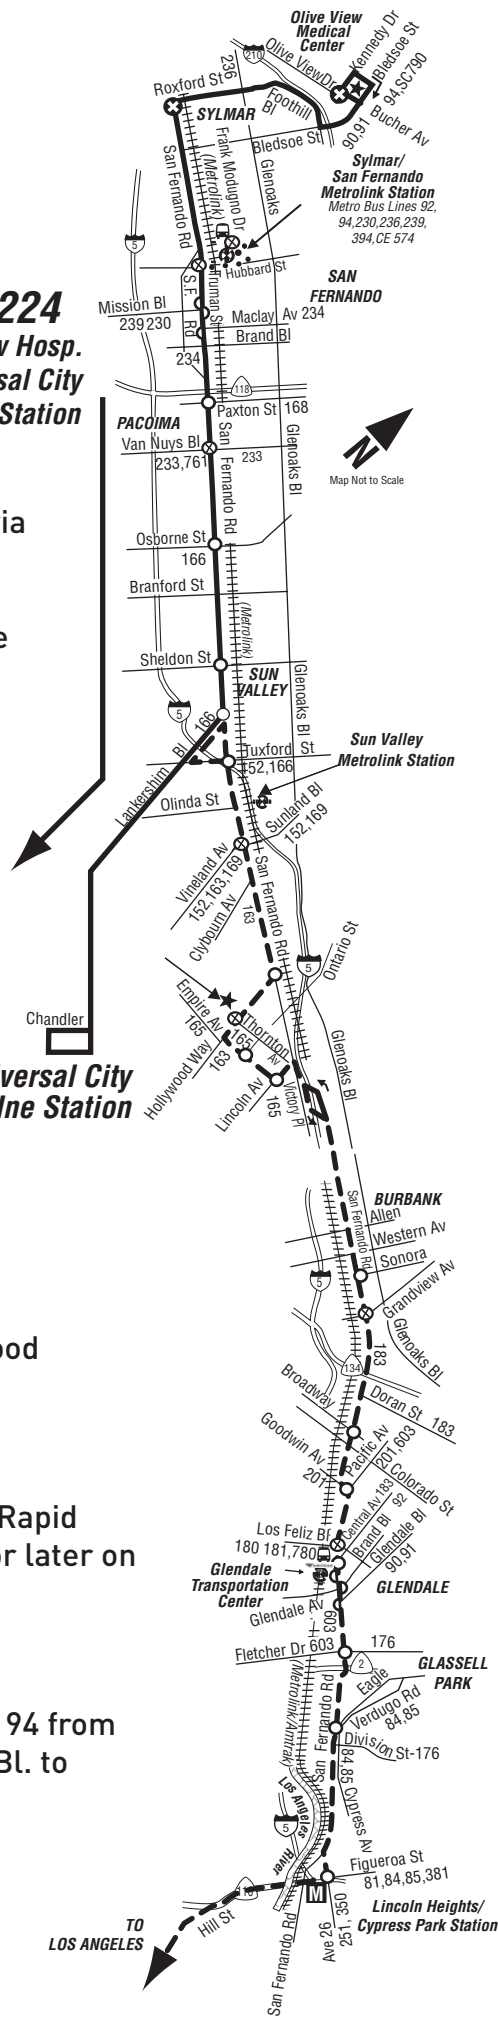

Line 94

Staff Recommendations:


Line 94A

- Route extended from North Hollywood Station to Universal City Station.
- Renumber to Line 224.
- Reallocate resources to new Metro Rapid Line 724 (see Line 766) in June-07 or later on weekdays only.

Line 94B

- Adopt proposal and operate as Line 94 from San Fernando Rd. and Lankershim Bl. to downtown Los Angeles.

Metro Connections Line 152 & Branch Rte. 153 Via San Fernando Rd.

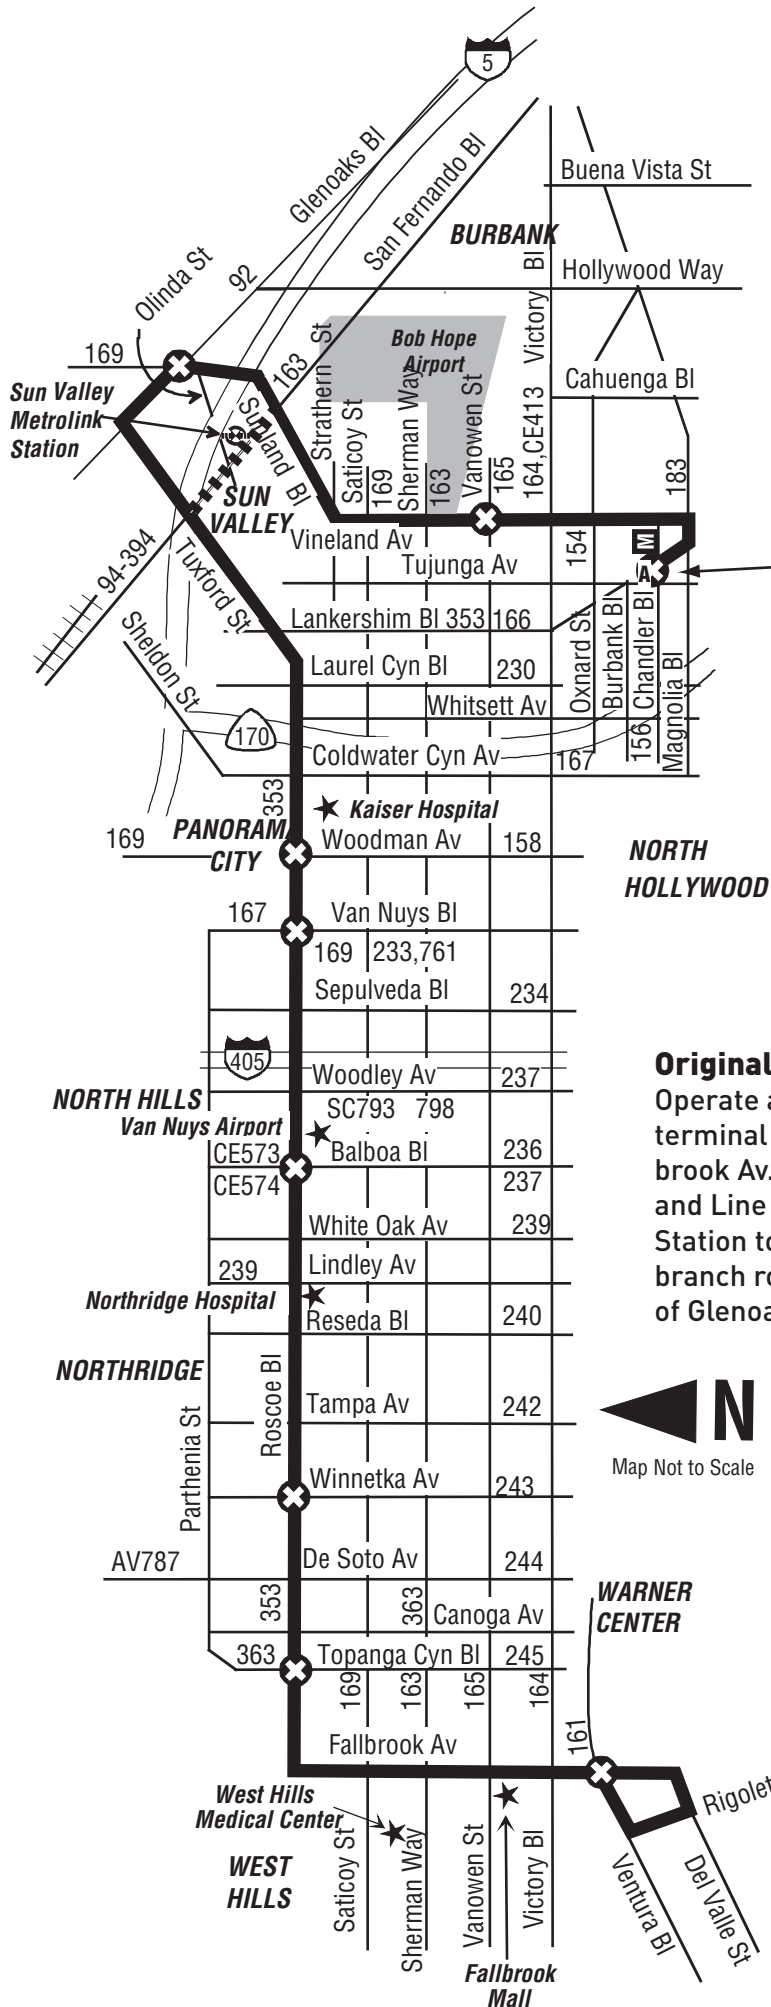

Legend

- Timepoints used on Timetable
- Route 153
- Metro Red Line Station
- Metro Orange Line Station
- Metrolink Station
- CE - LADOT Commuter Express
- SC - Santa Clarita Transit
- AV - Antelope Valley Transit

Metro Bus Lines Shown at Transfer Locations
Subject to Change Without Notice

Original Proposals:


Operate as two separate lines; Line 152A from new terminal at Warner Center then via Victory Bl. to Fallbrook Av. and regular route to North Hollywood Station and Line 152B via regular route from North Hollywood Station to downtown Burbank. Operate new Line 153 as branch route of Line 152A via San Fernando Rd. instead of Glenoaks Bl. between Tuxford St. and Sunland Bl.

Staff Recommendations:

- Retain existing route to along Fallbrook Av. to Ventura Bl. and implement remainder of route as proposed.
- Operate as Line 152.



Metro Connections Line 155

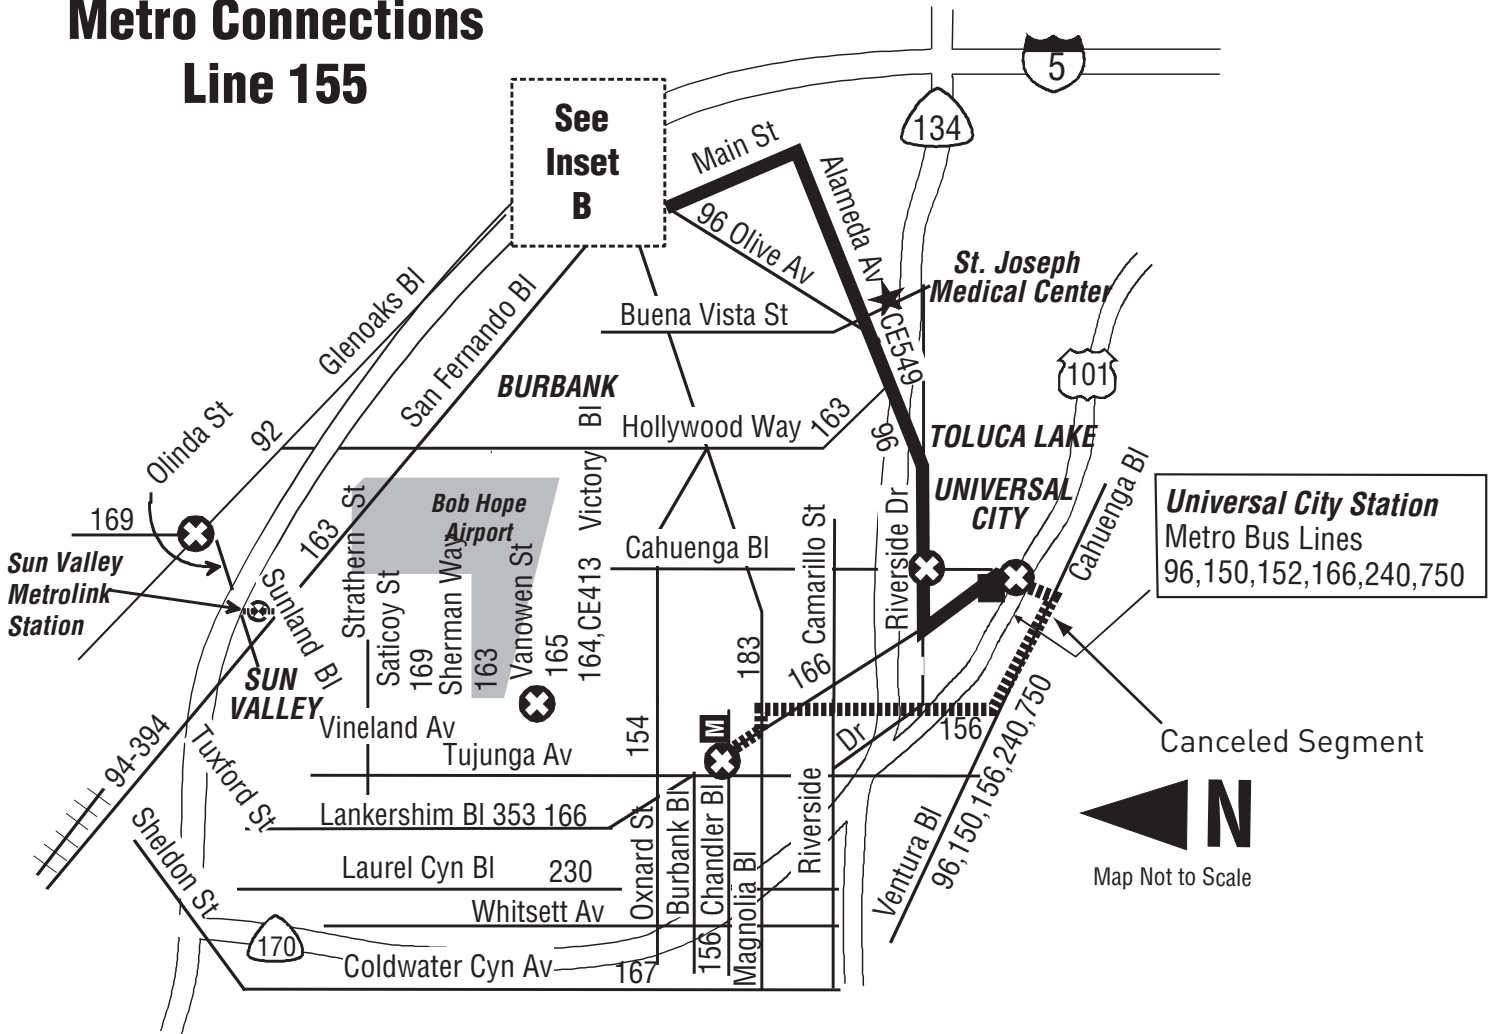

Original Proposal:


Operate Line 152B as a shuttle route between Downtown Burbank Station and North Hollywood Station.

Staff Recommendations:

- Modify proposed route to operate between Universal City Station and downtown Burbank.
- Renumber to new Line 155.

Legend	
	Timepoints used on Timetable
	Metro Red Line Station
	Metro Orange Line Station
	Metrolink Station
CE	LADOT Commuter Express
SC	Santa Clarita Transit
AV	Antelope Valley Transit

Metro Bus Lines Shown at Transfer Locations
Subject to Change Without Notice

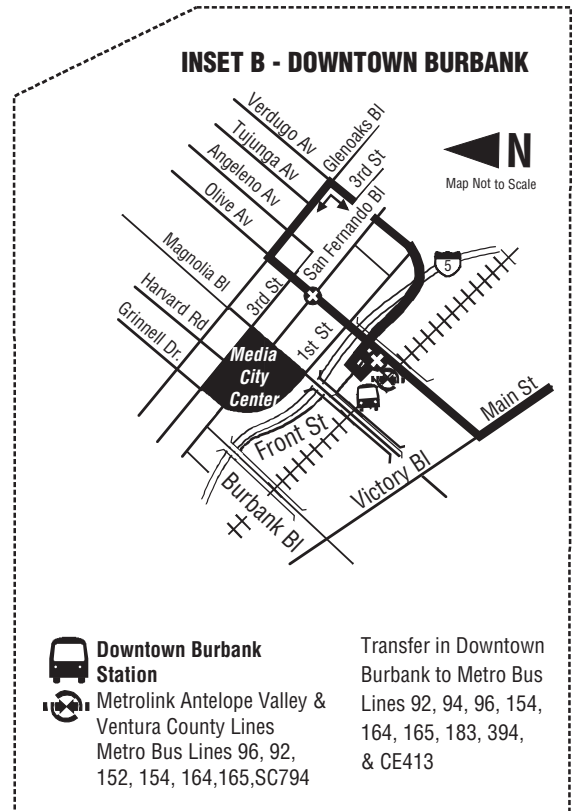


- | | | |
|--|--|--|
| | Downtown Burbank Station | Transfer in Downtown Burbank to Metro Bus Lines 92, 94, 96, 154, 164, 165, 183, 394, & CE413 |
| | Metrolink Antelope Valley & Ventura County Lines | Metro Bus Lines 96, 92, 152, 154, 164, 165, SC794 |

Metro Connections


Line 156 Late Night Metro Red Line Replacement Service

Renumber to Line 356

Minor Reroute to Lankershim Bl.

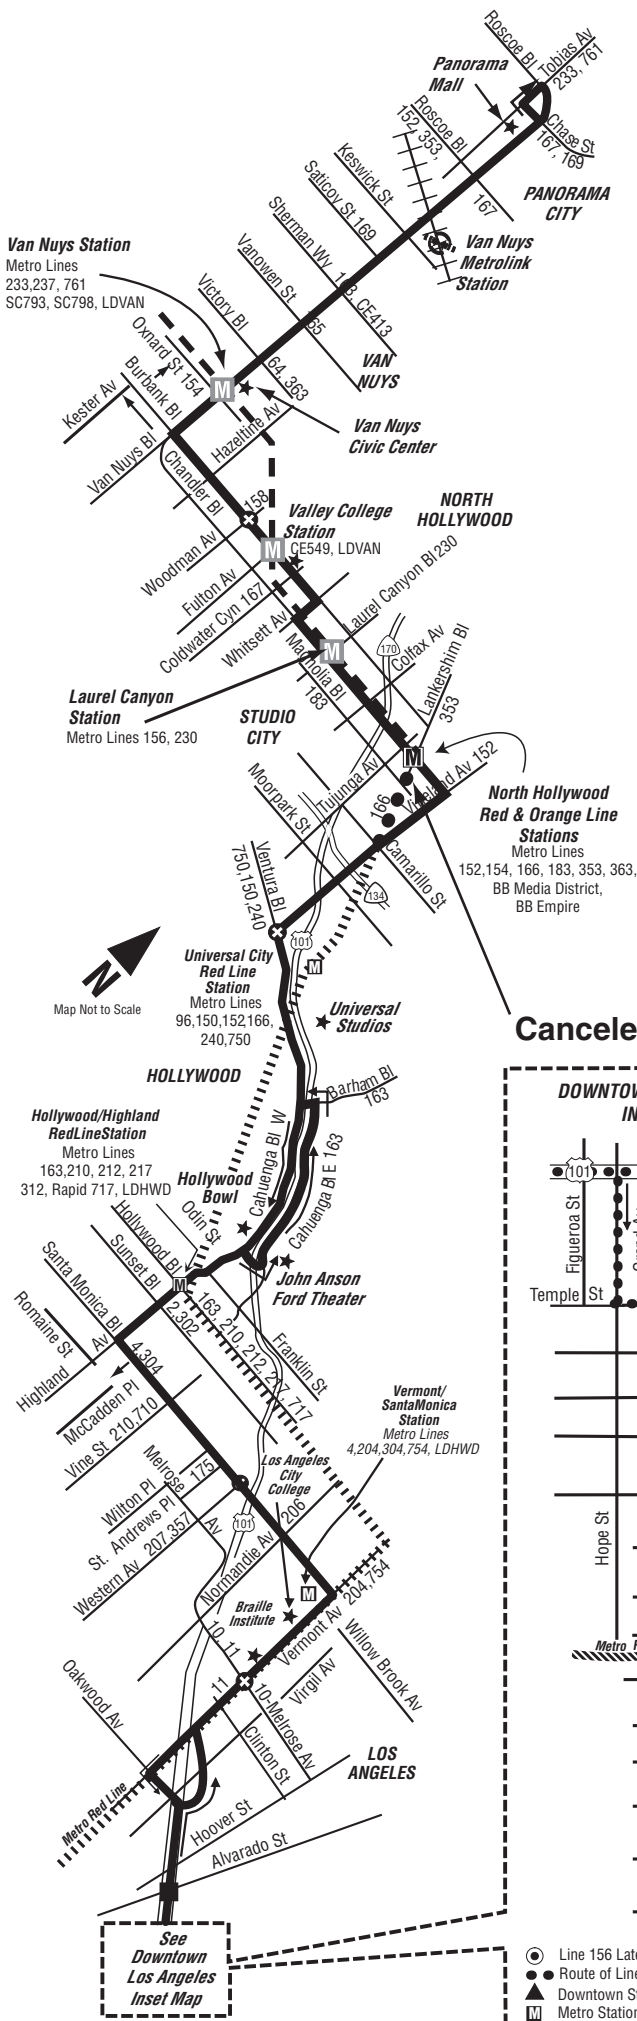

Canceled Segment

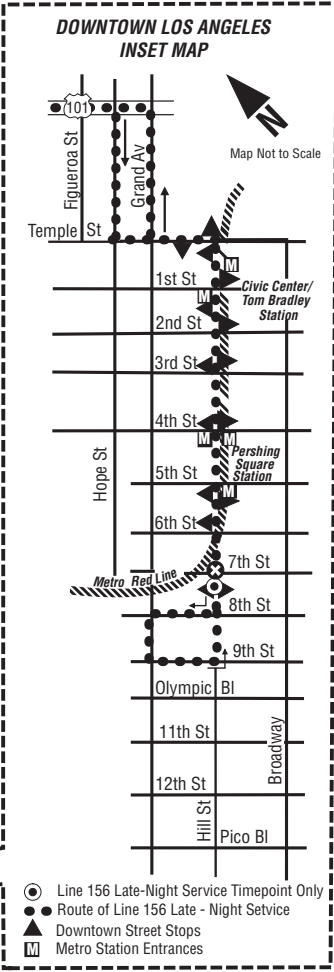

Original Proposals:
 Reroute segment between Vineland Av. and Cahuenga Bl. to Lankershim Bl., replacing Line 166 segment;
 Operate Line 156 Owl Service as a separate line and renumber as Line 356. (See Line 166.)

Staff Recommendations:

Line 156


- Retain existing route, except for a minor reroute of a one-half mile segment from Lankershim Bl. to Vineland Av.

Line 156 Owl

- Adopt proposal.

Legend	
	Route of Line 156
	Route of Line 156 Late-Night Service from Panorama City into Downtown Los Angeles (10:30pm-5:00am)
	Metro Rail Station
	Metro Rail Station & Timepoint
	Metro Orange Line Station
	Route of Orange Line
	156 Freeway Stop
	Timepoints used on Timetable
SC	Santa Clarita Transit
CE	LADOT Commuter Express
LD	LADOT Dash
BB	Burbank Bus

Metro Bus Lines Shown at Transfer Locations
 Subject to Change Without Notice

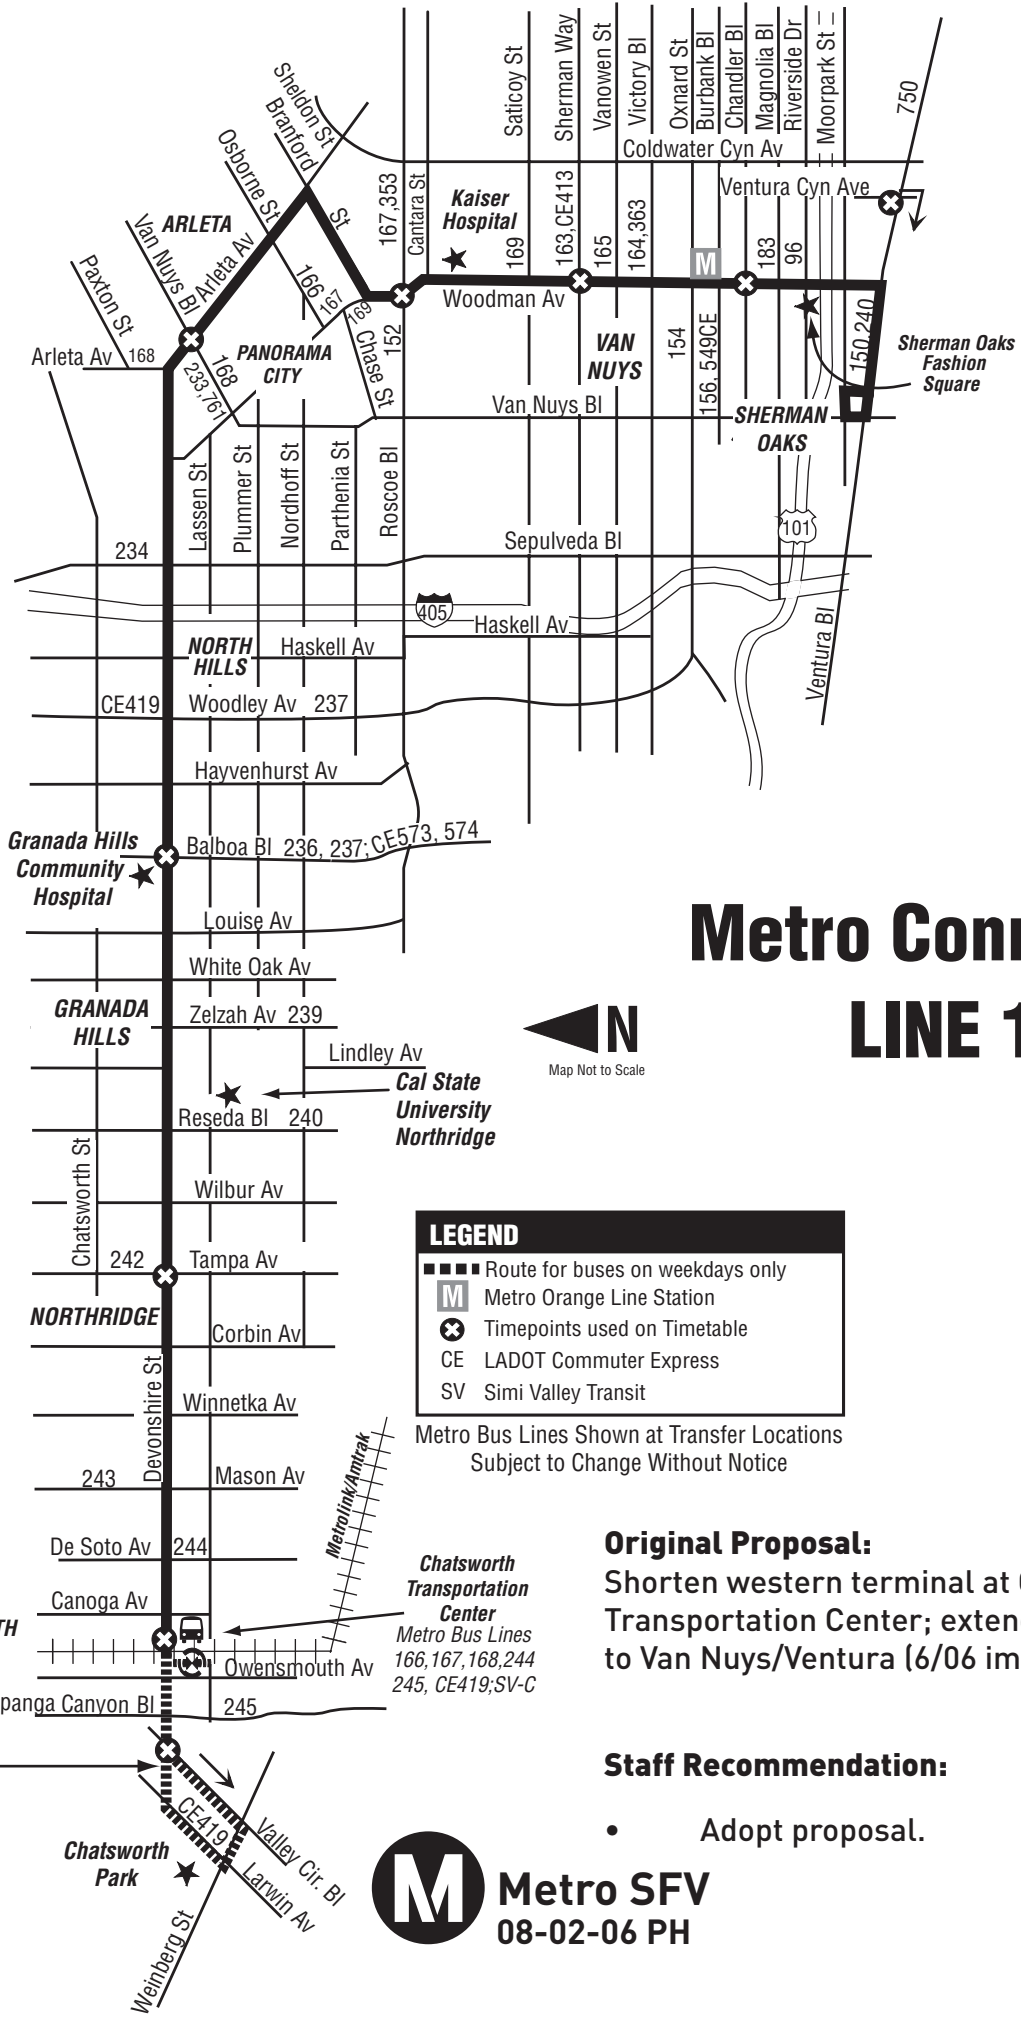

Metro Connections LINE 158



LEGEND	
	Route for buses on weekdays only
	Metro Orange Line Station
	Timepoints used on Timetable
CE	LADOT Commuter Express
SV	Simi Valley Transit

Metro Bus Lines Shown at Transfer Locations
Subject to Change Without Notice

Original Proposal:
Shorten western terminal at Chatsworth Transportation Center; extend eastern terminal to Van Nuys/Ventura (6/06 implementation).

Staff Recommendation:

- Adopt proposal.


Canceled Segment



Metro Connections

Line 166 & 364

Limited Stop

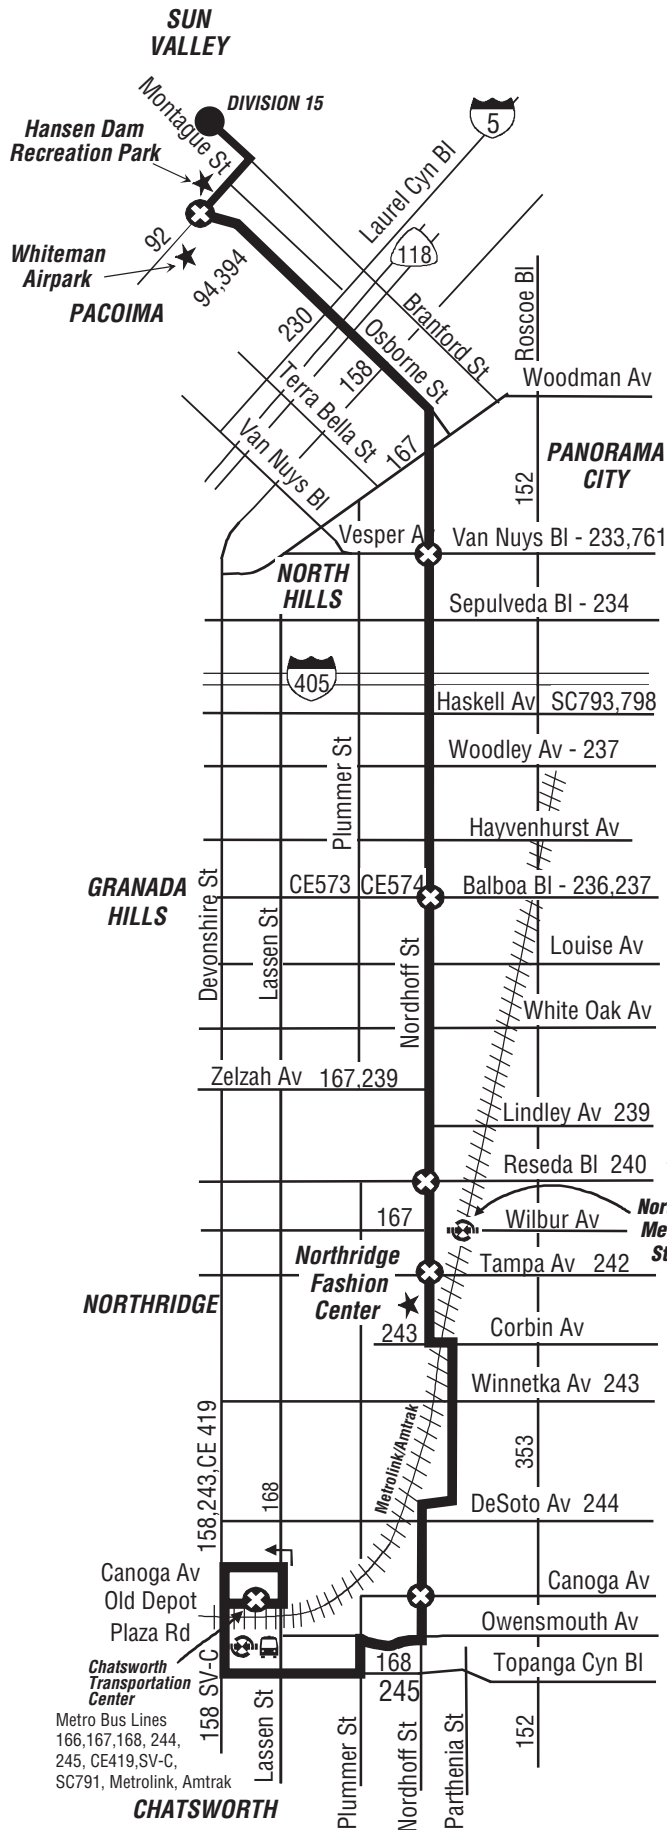

Original Proposals:

Shorten line in Sun Valley at Glenoaks Bl. and Branford St. and convert selected trips to provide proposed new Line 364 limited stop service along same alignment; Cancel Sun Valley to Universal City Station segment and replace Lankershim Bl. segment with (Option 1) proposed Line 94A and new Line 766 between Sylmar and North Hollywood Station; or (Option 2) alternate proposal for new Line 394 and rerouted segment of Line 156.

Staff Recommendations:

Line 166

- Adopt proposal.

Line 364

- Adopt proposal.



Map Not to Scale

Legend

- ⊗ - Timepoints used on Timetable
- CE - LADOT Commuter Express
- SV - Simi Valley Transit
- SC - Santa Clarita Transit
- //// - Supplemental school route. Phone Metro Information Center for exact days of operation.
- - Shortline Turnaround Loop
- M - Metro Rail Entrance and Timepoint
- M - Metro Orange Line Station

Metro Bus Lines Shown at Transfer Locations
 Subject to Change Without Notice

METRO CONNECTIONS

LINE 240



MAP NOT TO SCALE

Legend

- Timepoints used on Timetable
- Metro Red Line Station
- Metro Orange Line Station
- Metrolink Station
- SC Santa Clarita Transit
- AV Antelope Valley Transit Authority
- CE LADOT Commuter Express
- LD LADOT Dash


Metro Bus Lines Shown at Transfer Locations
Subject to Change Without Notice

Original Proposals:

Shorten route to end at Reseda Bl. and Ventura Bl.; Convert selected weekday trips to proposed new Line 741 Metro Rapid service along Reseda Bl. between Northridge and Tarzana. (See Line 741.)

Staff Recommendations:


- Retain existing route on Ventura Bl. to Universal City Station.
- Reallocate resources to new Metro Rapid Line 741 on weekdays only.

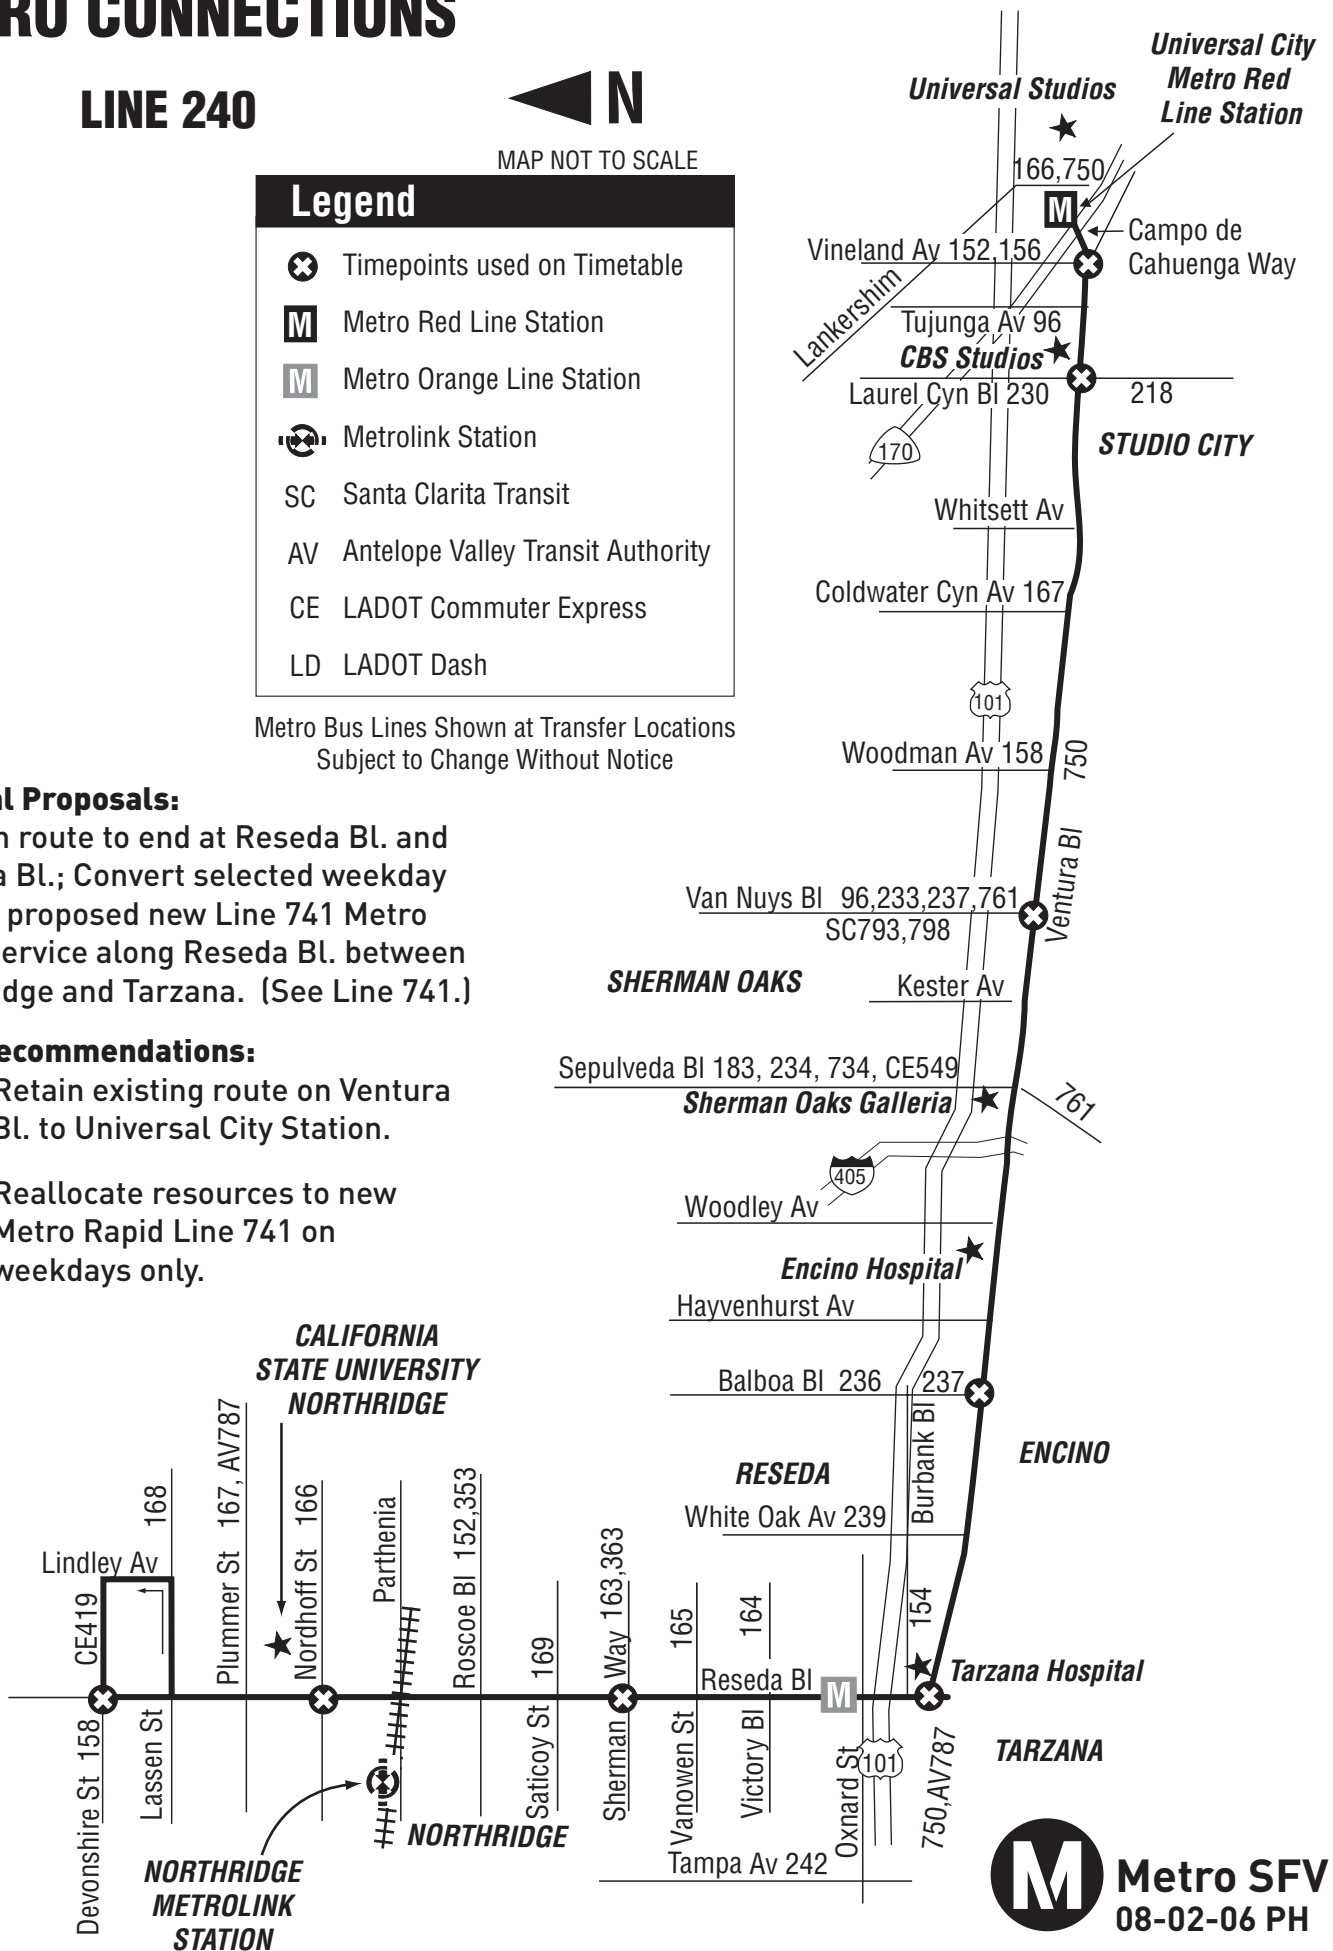

Metro Connections

Line 363

(Branch route of Line 353)

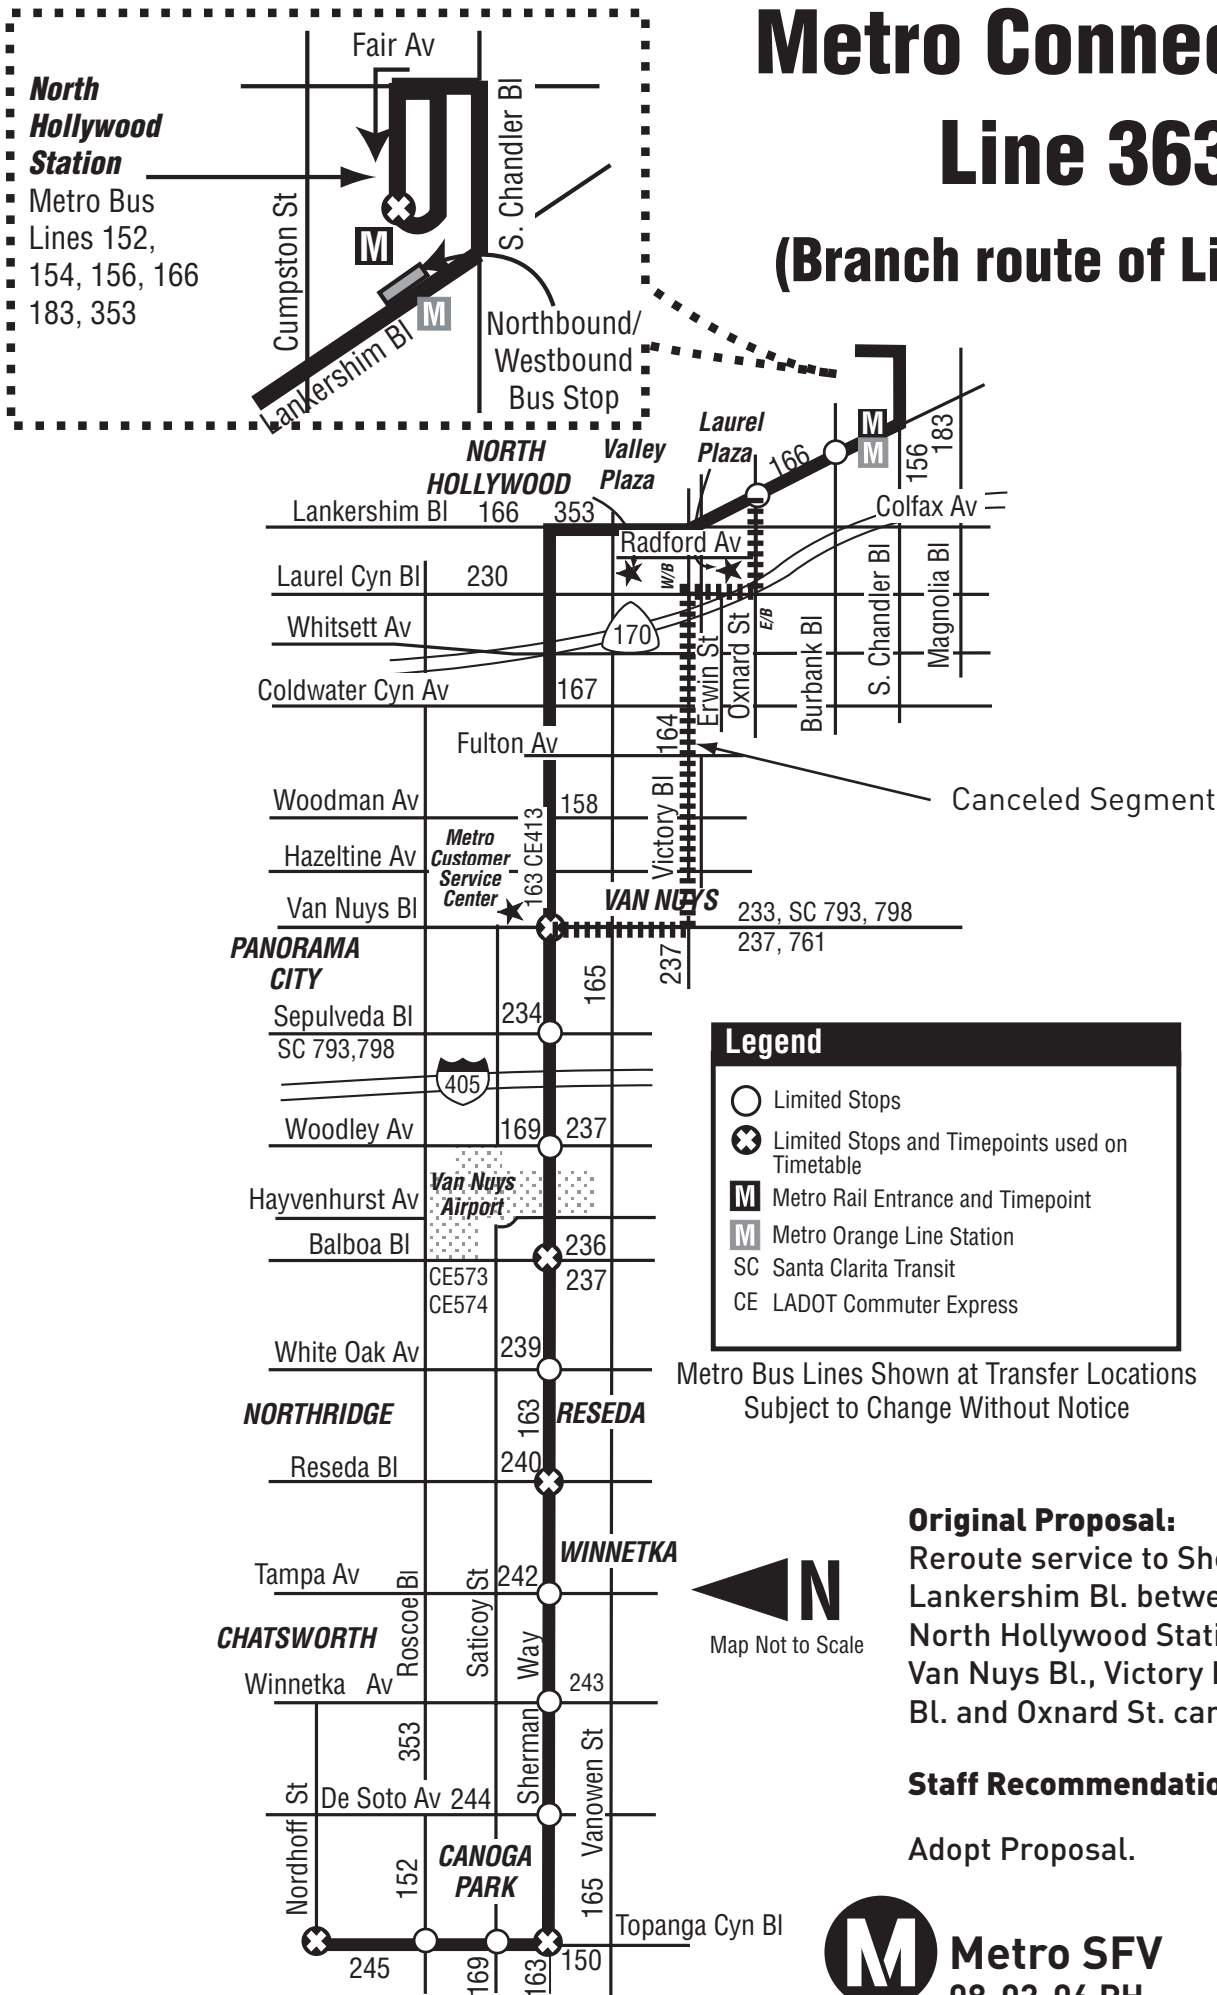


Metro Connections Line 741

Original Proposal:

Operate new Metro Rapid service along Reseda Boulevard between Northridge and Tarzana on weekdays only. (See Line 240)

Staff Recommendation:

Adopt Proposal

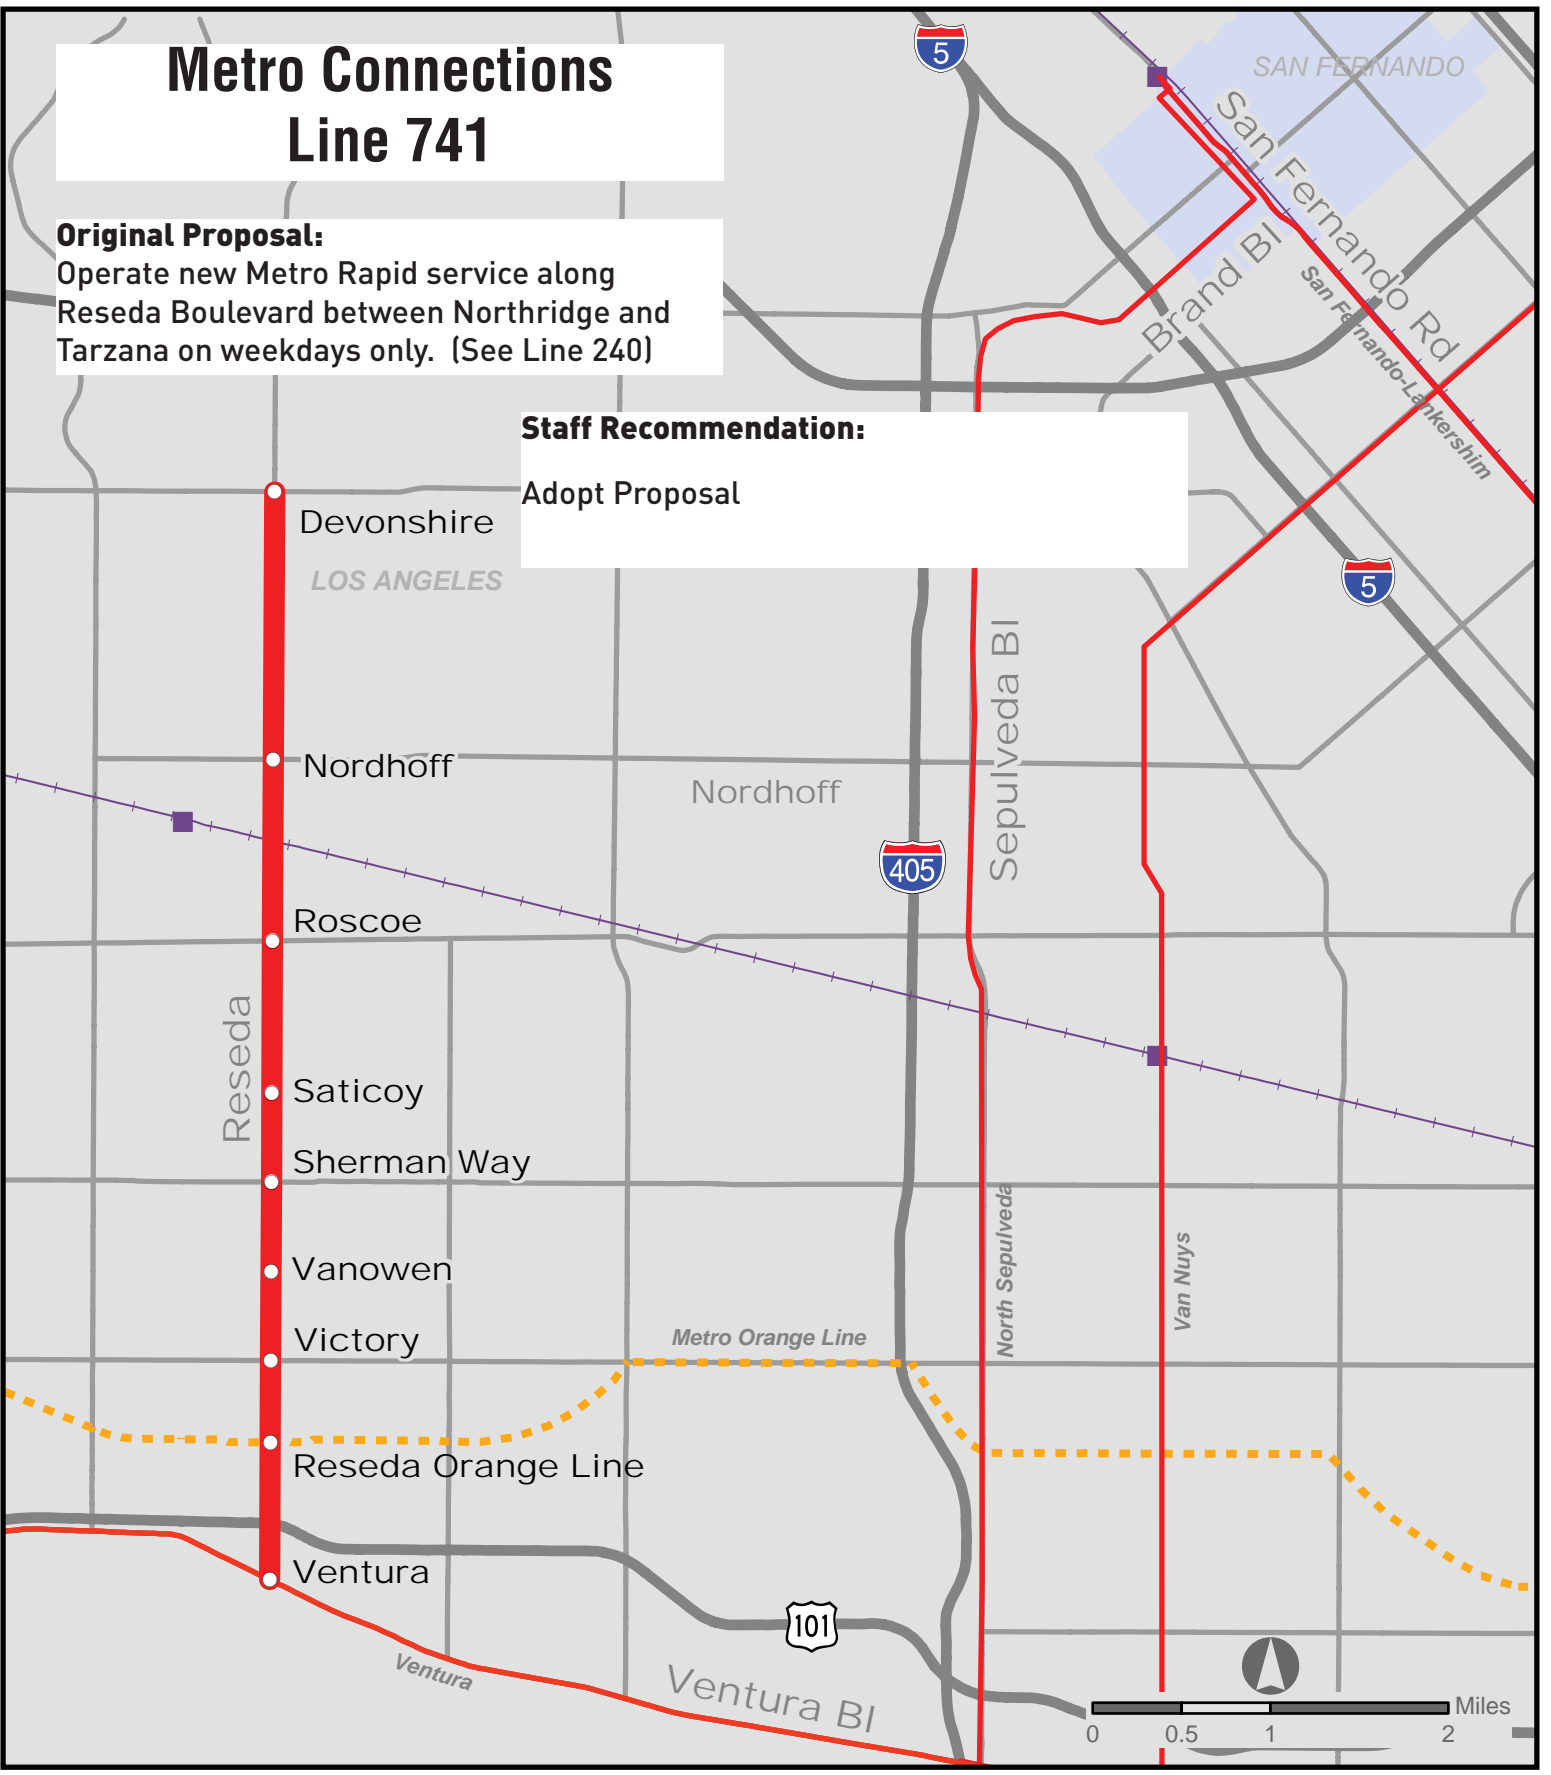

Reseda Metro Rapid Effective December 2006

-  Reseda Metro Rapid and Stops
-  Other Rapid Lines



Phase II-C

Countywide Planning and Development
January 2006

Metro Connections

NEW LINE 724

Metro Bus Lines Shown at Transfer Locations
Subject to Change Without Notice

Legend	
	Route of Line 94 & 394
	Route of Line 394 and midday weekday scheduled trips on Line 94 to Sylmar/San Fernando Metrolink Station only
	Route of Line 94 only
	Timepoints used on Timetable
	Limited Stops
	Limited Stops and Timepoints used on Timetable
	Metrolink Stations
CE	LADOT Commuter Express
SC	Santa Clarita Transit


724 Sylmar Station To N. Hollywood Red Line Station

Original Proposal:

Operate new Metro Rapid service along San Fernando Road and Lankershim Boulevard between Sylmar/San Fernando Transportation Center and North Hollywood Station on weekdays only. (See Lines 94A and 166)

Staff Recommendation:

- Adopt proposal; Defer implementation to June-07 or later.
- Renumber to Line 724.

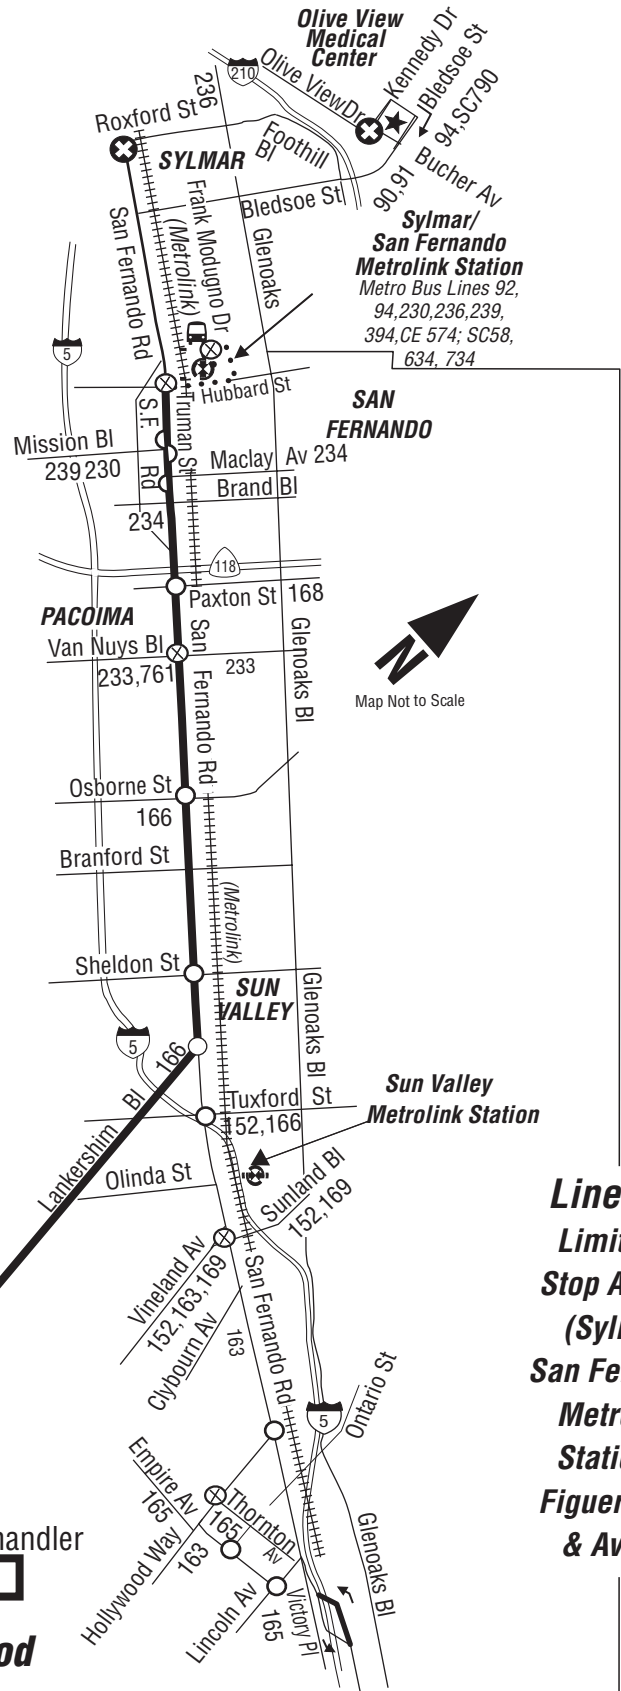

**Line 394
Limited
Stop Area
(Sylmar/
San Fernando
Metrolink
Station to
Figueroa St.
& Ave 26)**

