

REPORT NO. UMTA-WA-06-0009-79-1

VEHICLE DATA ACQUISITION SYSTEM

OCTOBER 1979



AUTOMATED GUIDEWAY TRANSIT TECHNOLOGY PROGRAM

**U.S. DEPARTMENT OF TRANSPORTATION
Urban Mass Transportation Administration
Office of Technology Development and Deployment
Washington, D.C. 20590**

TA
1207

.H38 document is available to the U.S. public through
C-2 National Technical Information Service,
Springfield, Virginia 22161

NOTICE

This document is disseminated under the sponsorship of the Department of Transportation in the interest of information exchange. The United States Government assumes no liability for its contents or use thereof.

The United States Government does not endorse products or manufacturers. Trade or manufacturers' names appear herein solely because they are considered essential to the object of this report.

| | | | | | |
|---|--|------------------------------------------------------|---|-------------------------------------------------------|-----------|
| 1. Report No. WA-06-0009-79-1 | | 2. Government Accession No. | | 3. Recipient's Catalog No. | |
| 4. Title and Subtitle Vehicle Data Acquisition System | | | | 5. Report Date October 1979 | |
| | | | | 6. Performing Organization Code 272 | |
| 7. Author(s) Andrew Haug | | | | 8. Performing Organization Report No. | |
| 9. Performing Organization Name and Address Port of Seattle P. O. Box 1209 Seattle, Washington 98111 | | | | 10. Work Unit No. (TRAIS) | |
| | | | | 11. Contract or Grant No. WA-06-0009 | |
| 12. Sponsoring Agency Name and Address U. S. Department of Transportation Urban Mass Transportation Administration Office of Technology Development and Deployment Washington, D.C. 20590 | | | | 13. Type of Report and Period Covered Final Report | |
| | | | | 14. Sponsoring Agency Code UTD-42 | |
| 15. Supplementary Notes | | | | | |
| 16. Abstract A Vehicle Data Acquisition System (VDAS) has been developed by the Port of Seattle which collects and continuously records 20 minutes of data from 34 test points in a specially instrumented Sea-Tac Satellite Transit System vehicle. The recorded data is useful to maintenance personnel to rapidly diagnose intermittent and total vehicle failures, thus reducing vehicle downtime and maintenance costs. This system uses an onboard microprocessor system based on the Intel 8080 and a semiconductor memory to record data which can then be dumped to a microprocessor terminal in the maintenance area for analysis. A six-month in-service test on one vehicle demonstrated that the VDAS can speed up corrective maintenance as well as identify marginal conditions and incipient failures. | | | | | |
| 17. Key Words Automated Guideway Transit Data Acquisition System Vehicle Maintenance | | | 18. Distribution Statement This document is available to the public through the National Technical Information Service, Springfield, Virginia 22161 | | |
| 19. Security Classif. (of this report) UNCLASSIFIED | | 20. Security Classif. (of this page) UNCLASSIFIED | | 21. No. of Pages | 22. Price |

03978

TA
1207
.H38
c.2

I. BACKGROUND

A. General

In October, 1976, the Port of Seattle requested Department of Transportation (DOT) funding for a Vehicle Data Acquisition System (VDAS) which was to be used on the Satellite Transit System (STS) at Sea-Tac International Airport. That request was granted in July, 1977 and this document constitutes the final report for the project.

The motivating factor behind the VDAS concerned the amount of time and energy involved in maintaining the operational readiness of the STS vehicles (12 cars of the SLT class). At the time the grant request was made, 75% of maintenance labor was being expended on troubleshooting and only 25% on actual repair. The maintenance group realized that as the passenger volume increased at Sea-Tac, the need for more vehicles would make the system more complex and the system integrity would begin to disintegrate. Normally, during the off peak periods of the year, half the twelve car fleet is required to provide service. Thus, if a car had a known intermittent problem, the luxury exists of keeping that vehicle out of service until the problem is finally isolated. Due to the aforementioned anticipated increase in passenger volume, the Port has already purchased twelve new vehicles for future delivery and is presently running at full capacity. Obviously, the proposed data acquisition system has come at a most convenient time.

B. History

Since 1973, the Sea-Tac International Airport has been operating a subway system providing transportation between the main terminal and the two satellite terminals through two independent underground loops (see Figure 1). A separate shuttle section interconnects the two loops in the main airport terminal.

During the six years of service the maintenance on the transit vehicles has been continually updated and improved. Most mechanical equipment failures could be found and corrected through periodic maintenance procedures. Electronic control malfunctions on the vehicles have always been hard to find due to their dynamic nature. The vehicles are unmanned in normal service and it would be a tedious task to manually monitor a vehicle while it is in that mode. The idea was born to develop a system that monitors the vehicle control logic in the same manner in which a flight recorder assembles data on commercial airliners. The ability to look at the sequence of events occurring prior to the perceived fault would allow technicians to spend more time improving the transit system rather than tracking down intermittent repetitious fault conditions.

C. Project Theory

We began the project with two distinct goals in mind:

1. To significantly reduce the maintenance costs of the STS through decreasing the number of failures and maintaining a high level of availability.
2. To determine if sufficient long-term maintenance cost improvement could be realized by increasing the number of VDAS units in the vehicle fleet.

The VDAS would primarily be used in identifying elusive, intermittent problems by "capturing" critical performance parameters during the most recent twenty minutes of operation. This data would be analyzed, and a picture of the operating system before, during and after failure would be developed.

II. DESIGN CONSIDERATIONS

The STS vehicles are automatically controlled by hardwired wayside controls. A computer system supervises the train operation in the loop, but it does not have to be running for loop control.

The vehicles receive speed and stop commands from the wayside through antennas underneath the vehicle, stopping in alignment with the station door and all interlocking switching for multiple car trains. All of the ATO equipment is located in the vehicles' control consoles at the front and rear (see Figures 2 and 3).

The VDAS ties into these different control circuits at strategic monitor points. These points were carefully selected such that examination of their status at any given time should yield accurate system information directly related to sub-system function, thereby isolating problems to specific sub-systems. The maintenance crew keeps two spare electronic sub-system units on hand at all times. Thus, when the VDAS indicates a faulty unit, it can quickly be replaced resulting in significant reduction in downtime.

Based upon past failure history the Maintenance personnel selected 34 test points for the VDAS (See Appendix A). They consist of four major types of signals:

1. Static relay voltages. All relays feed off the +36 VDC vehicle battery.
2. Static signals between control units. These are digital in nature, alternating between OVDC and either +6VDC or +15 VDC.

3. Analog signals within a feedback loop. Threshold levels are indicative of different modes of operation.
4. Pulse integrations. Peak detectors and control circuitry for interrupt enabling.

A breakdown of the number of test points located within specific sub-systems may be found in Table 1.

Early in the system development, we decided to use as many off-the-shelf products as possible. The Port is not set up for developmental work and, in addition, Port labor costs are too high for that type of activity.

We chose a microprocessor for the VDAS controller and initially wanted to use a cassette tape for transferring the accumulated data. The cassette idea was later scrapped in favor of a microdiskette system for its better reliability and ease of usage. The diskette is not a dedicated unit. When a failure occurs, the maintenance personnel connect the diskette drive to the vehicle VDAS and dump the contents of memory onto the diskette for data reduction and analysis.

A Prolog microprocessor system was chosen primarily for its convenient 19 in. rack mounting which is the vehicle format. (See Figure 2.) Height limitations within the vehicle eliminate most of the existing single board computers. It might be emphasized that any of the commercially available microprocessing systems are capable of performing the tasks necessary were it not for the aforementioned size limitation. If this had been known in advance, the vehicles could probably have been designed to accommodate other systems.

For program development and data formatting, a SOL computer was purchased along with a North Star Disk and accompanying Disk Operating System (DOS) (see Figure 4). 8080 assembly coding and Basic program generation capabilities are part of the SOL software configuration. The 8080 assembly code is used for the actual data acquisition on the vehicle and a Basic language program is resident in the SOL computer for data reduction and formatting.

We chose to consider the acquired data as a single contiguous file which would simplify our data handling procedures. The system was designed such that acquired data would be stored in consecutive memory locations until the top of RAM was reached (see Figure 5 for memory mapping). At that point, the address counter would "roll-over," allowing the newest data to be stored at location 2000, writing over previously stored information. To keep track of the proper sequencing in the data stored, the relative time of occurrence accompanies the data bytes (see Figure 6 for data storage formatting).

We did consider using an Intel development system which would have reduced the software development time. The advantage with development systems is their ability to function in-circuit as the software is being written. For our purposes, this advantage did not outweigh the considerably higher cost.

To acquire the data from the vehicle itself, we designed signal-conditioning circuit cards which were compatible with the Prolog mainframe. This resulted in a reliable customized interface suitable for accurate reading of the parameters we were after. For systems requiring a greater number of monitoring points, this may become an unwieldy solution, but for the number of points we were monitoring, it was not an insurmountable task.

One of the problems we ran into interfacing with the STS vehicle concerned ensuring that the VDAS would not interfere with the normal operation of the ATO controls. This was solved through the vehicle contractor, Westinghouse Corp., and resulted in a termination board (see Figure 7) installed between the test points and the interface electronics. With the termination board installed, any type of VDAS circuit violation such as shorted output, or voltage feedback, would not affect the vehicle circuitry.

Another design problem occurred when we decided to use the diskette drive. Having already purchased the Prolog computer, we were faced with the task of interfacing the North Star Disk drive to it. The Prolog System had an inverted data bus and used differing timing signals for its strobing, for example. These problems were solved through the addition of another interface card (Figures 8) which conditioned these signals for acceptance by the disk controller.

Because the test vehicle operates off a non-standard voltage level (36 VDC), we had some difficulty locating a suitable power supply for the VDAS. We needed +5, +15, and -15 VDC. We eventually found a supply with sufficient reliability to satisfy our requirements. Previous supplies had a tendency to burn out during revenue operation, causing considerable delay in the VDAS evaluation.

We wanted to be able to interrupt the VDAS software at any time (i.e., in the event of a system failure) to allow us to dump the memory contents on disk. Also, we knew that a timing relationship was required for the data to have any meaning. To achieve these goals, we developed a hardware priority interrupt system using a Prolog priority interrupt card. In this way, a real-time clock would generate an interrupt, the interrupt card would determine its priority and branch to the appropriate service routine while holding the other interrupts in a high impedance state until the task was finished. The dump procedure is initiated by depressing a button on the VDAS front panel (see Figure 2).

One consideration that has a direct bearing on the efficacy of the system is the amount of memory required. We needed to store about 20 minutes' worth of vehicle data to allow the Maintenance personnel sufficient time to get to the test vehicle following a failure and initiate the dump procedure. We started with the assumption of 6 data words, which yields one bit for each of 34 monitored conditions plus eight bits for resolving the vehicle speed to 0.1 mph, leaving six expansion bits which are unused at this time. In addition, two words relating to the running real time are required. Referring to Figure 9, this would require 96,000 words of core memory.

This is an obvious problem as most microprocessors have the capability of addressing only 65K of memory, the 8080 included. So we decided to employ the maximum 65K less whatever the controlling software required, but only store the data whenever a change occurred in any given bit of the 6 data words. This has been a workable solution yielding 56K of usable core memory for data storage (main program and related utilities constitute 9K of total memory). This allows about 12 minutes of data storage which has proven sufficient for our needs.

III. EQUIPMENT

A. Hardware

1. SOL Terminal Computer--See Figure 10.

This equipment was purchased for software development and data analysis. It operates as a stand alone computer under control of a program contained in a personality module which allows the assembled output of developed programs to be compatible with the VDAS CPU, in this case the Intel 8080. The mainframe is designed around the S-100 bus, an industry standard geared for the hobby market. In essence, SOL combines a Central Processing Unit (CPU) with several S-100 peripheral modules--memory, keyboard interface, video interface, audio cassette interface, plus parallel/serial I/O interfaces. The system also includes a five slot backplane board for adding other I/O or memory modules that are S-100 compatible.

The SOL uses an 8080 as its CPU for control of system functions. The internal structure of the CPU employs 3 separate buses:

- i. 16 bit address bus.
- ii. 8 bit bi-directional data bus.
- iii. 28 bit Control bus.

The S-100 bus is a composite of these buses and other control signals arranged in a standardized format such that I/O modules can be developed independent of the host system yet with the certainty that they will be operational when installed in the S-100 backplane.

In addition to the S-100 bus structure, the SOL uses an eight bit keyboard input port, an eight bit parallel input port, an eight bit parallel output port and an eight bit sense switch logic input port.

A Universal Asynchronous Receiver/Transmitter (UART) is installed for processing serial data from the audio cassette I/O circuits and the serial input line. This is advantageous since the UART would otherwise have to be incorporated as a software module.

All CPU data and address lines are tri-stated to allow multiple device connection. The SOL also has video generation capability in ROM which allows a dot matrix format for video output.

As previously mentioned, we decided to use a diskette for mass storage rather than the audio cassette. We chose a North Star Micro-Disk System for its availability and S-100 bus compatibility. To allow the disk to "talk" to the SOL, we purchased a software package which contained all the I/O routines required to interface the North Star software with the SOL hardware. This package fit entirely within the 256 byte block North Star has allocated for its I/O area thus taking nothing away from the user's workspace, and without requiring any hardware interfacing.

Aside from the disk unit, one other peripheral was installed in the SOL system, a Practical Automation Printer.

This unit gives us hardcopy of our system software and the data from the VDAS. It has selectable baud rates (up to 1200 bps in serial mode) and uses a 20mA current loop or 8 bit parallel bus for data input.

2. Prolog (See Figure 11)

The basic Prolog System consists of eight printed circuit boards:

- i. Priority Interrupt (#8118-1)
- ii. I/O (#8113-1)
- iii. 32 bit input (#8114)
- iv. CPU (#8821)
- v. RAM (#8119 - 4 each)

These boards are manufactured by Prolog to fit into a 19 inch wide card rack with the S-100 bus backplane wiring. Their usage is fairly straightforward.

To provide the necessary signal conditioning to the test points prior to inputting them to the Prolog System, the Port built four prototype custom PCB's:

- i. 9001 - 36 vdc input card inputs relay logic to system via opto-isolators.
- ii. 9002 - CMOS input card. Provides high input impedance and also contains hardware tachometer scaling for determining vehicle speed.
- iii. 9003 - OP AMP Analog input card.
- iv. 9004 - Control Card.

These cards were wire-wrapped on a standard Prolog utility dip card (#P561) having a 56 pin card edge connector consistent with their off-the-shelf system boards. Details of these custom PCB's are shown in Appendix B.

To allow transferral of acquired data, we purchased a controller from North Star and adapted it for use with the Prolog System (see Figure 8). The controller was configured such that when the vehicle experienced a failure, a technician would connect the disk unit to the Prolog System and press the "DUMP" button (see Figure 2) generating a hardware interrupt, halting the CPU and branching to the memory dump routine. We ran into some initial problems in locating the software properly because the I/O routine required certain locations for its use and we had previously used those same locations. This is definitely something which should be researched before purchasing a similar system.

B. Software

There are two major programs developed for the system:

1. VDAS Data Handler
2. Data Analysis Routine

The SOL computing system, in conjunction with the North Star DOS, was used for program development.

This section will address just the routines developed for the VDAS itself rather than delve into all the necessary bookkeeping procedures peculiar to our particular system. The rationale behind this is that the important information is the manner in which the data was gathered, and how that data was assembled into a form usable by our maintenance group. This information would be valuable to future users, whereas the manner of implementation would not necessarily be of value to a user with a different system, which would probably be the case.

1. VDAS Data Handler

This is an assembly language program written for the Intel 8080 microprocessor. Data from the Westinghouse vehicle is input to the processor every 100 msec. If any data has changed from the last sample, all data is stored in random access memory along with a time reference. If no data has altered, no storage will take place.

A memory wrap-around is provided when the top of memory (FFFF hex - see Figure 5) is reached. The program revitalizes the memory pointer to the beginning of storage (2000 hex) such that "new" data will write over "old" data. In this manner it is possible to get at least twelve (12) minutes worth of data at any given time.

The program is interrupt driven such that when not executing one of the interrupt routines, the CPU is in a halt state with interrupts enabled (the processor automatically disables interrupts upon initiation of an interrupt subroutine). When

an interrupt is received

a "RST" (restart)
instruction vectors the software to the start address of the routine which handles the particular interrupt. The only exception is the "Power-On" Routine which takes advantage of the fact that the processor automatically vectors to address zero when power comes on. Thus, the hardware interrupt procedure provided by the Prolog System is not needed and address zero contains logic appropriate for handling the power-on situation.

The remaining logic is arranged as a continuous assembly of the following interrupt modules:

- i. Monitor
- ii. Disable
- iii. Memory Dump
- iv. Reinitialize

The monitor routine (see Appendix C for flow diagrams) stores data from the vehicle into memory. It contains logic to determine whether data has been altered since the last time data was stored. If that is true, the data is stored. A memory limit check is also provided incorporating the memory wraparound feature when memory overflow occurs. It is driven with a clock which provides an interrupt every 100 msec.

The Disable routine captures one last frame of data including the time reference--and then disables the real time clock interrupt to "freeze the memory." It also readies the system for dumping the contents of memory by initializing the appropriate handshaking flags. The time reference is not correlated to Greenwich time. It has meaning only within the VDAS frame of reference.

The memory dump routine outputs the contents of memory from 2000-FFFF hex onto a microdiskette with the oldest data placed at the beginning of the diskette. If the overflow flag has been set, then the current memory pointer points to the oldest data. If overflow has not occurred, then the dump takes place from 2000 hex to the current value of the memory pointer.

The reinitialize routine clears flags, turns off indicators and clears memory of old test data. The real-time clock is re-enabled and the system is once again ready for a new set of data.

There are separate subroutines called by the interrupt routines which accomplish straightforward tasks such as memory limit checking, writing to disk and inputing data from the test vehicle.

All of the interrupt routines are designed to be completed within the interrupt disable timeout which is automatically generated as part of the hardware interrupting procedure. Following completion of their tasks, the routines return to the idle mode with all interrupts fully enabled.

2. Data Analysis

The Data Analysis program is a Basic language program which is used for gathering maintenance information. It is run only on the SOL computer and uses the data dumped out from the VDAS as input. The principle features of this program are:

- i. Test point data from the Westinghouse vehicle is displayed in binary format on a CRT or a line printer depending on user selection. The data is identified with appropriate heading and a legend is included at the end of each display for further explanation (see Figure 12 for a representative example).
- ii. Three levels of resolution are provided to enable focusing on an area of interest within a considerable amount of data. The lowest level of resolution encompasses the entire data with a scan of 48 frames, which is approximately 1 out of every 150 data points or frames. The medium level of resolution involves a scan between any two points within the low resolution scan. There are 10 frames which is about 1 out of 15 data points. The high resolution scan encompasses every frame within a specified range.

The program is structured such that the operator may go from one level of resolution to another with relative ease. The scan at each resolution may be truncated to add even further flexibility in usage. Also, it is possible to effect a pause in the program by keyboard entry. This enables the user to examine data on the CRT more easily.

- iii. The user may choose between a total scan or time-specified scan at the lowest resolution upon entry to the program. The time-specified scan can be used effectively if the user knows approximately the time between when a fault occurred and the "stop monitor" button is depressed. Entering this time will allow the user to truncate the display to the area of interest more quickly.

IV. TEST PERIOD RESULTS

The VDAS data test points were chosen by the maintenance group based upon their previous experience in diagnosing vehicle failures. For instance, there is a point which determines direction (forward or reverse), this point, in conjunction with another point which determines speed (brake, acceleration, maintain speed) can indicate the dynamic performance of the vehicle at any time. If the data indicated that the control logic was in an accelerating reverse mode when it should have been in forward braking, you can immediately narrow your choices to the appropriate areas.

Figure 12 shows a sample Data Analysis Output. The time is referenced to the vehicle data itself, having no relationship to the actual time of occurrence. The time reference does, however, indicate a timing relationship between the actual test points themselves. It is very important to plot the dynamic performance of each test point versus the time of occurrence. It must be remembered that data is stored only when one of the data points alters state. With a sampling rate of 100 ms there often are periods of time upwards of one to three seconds where data is not stored. By plotting events according to their true time of occurrence, one may develop an accurate assessment of how the control logic was behaving during the time a failure occurred.

Appendix A contains the vehicle control schematics showing where each of the test points are located. As can be seen, they tend to follow a certain line of logic from inception to completion. In this manner, the technicians can isolate failures to a given sub-system. If the data shows that a start command was received (test point 3) but that the motors weren't energized (test point 4), then a fault is indicated in the motor control logic.

Appendix D contains data analyses for three separate failures recorded by the VDAS.

The first failure occurred during an "add train" operation where the test vehicle was being placed in revenue operation. The data shows a loss of "code load" 1.8 seconds after the wayside transmitters came on, and only .3 second after the wayside transmitters started sending the D.O.C. word.

The second failure occurred at the main terminal in the South loop. The test vehicle was operating in a two-car configuration and the vehicles were given a command to reverse their direction following a scheduled stop at the main terminal.

In both cases, it appears that the interference from the wayside Info transmission prevented speed commands from being decoded. This is evidenced by the intermittent nature of code loaded after the A relay was reset. This is due to jamming of the speed code signal by the wayside information signal.

The third failure occurred during normal operation as the vehicle was attempting to accelerate from 15 to 20 mph. The lack of an overspeed failure (test points 31 and 32) and presence of a balance failure (test point 33) and an A-relay dropout 1 second later suggests a ramp failure or tach failure. Specifically, "+ ramp" is suspect because of a speed decrease (test point 20) and is one of the two servo inputs, the other being "Tach 1." The 20 mph crystal oscillator which generates the "+ ramp" signal probably didn't start oscillating. The stability of code loaded (test point 34) from the speed decoder does not suggest a failure in the decode circuitry.

In addition to these examples, we found many other faults through a combination of VDAS and troubleshooting techniques. For example, the vehicle stopped on a reset from the wayside controller. Upon examination of the VDAS data we discovered that Tach 2 (test point 21) had dropped out for no apparent reason. (Tach 1 & 2 are identical circuits backing each other up. We determine speed from Tach 1 and simply detect the absence or presence of Tach 2.) The technicians immediately examined the Tach 2 signal and found that the waveform was rounded showing 5MHZ noise on the edges. The Tach 2 circuitry was replaced and the car re-entered revenue operation after being out of service a mere three minutes.

Another advantage we have found in using the VDAS concerns the isolation of recurring trouble spots. Quite often, a failure is caused by noise on the vehicle send and receive circuitry. VDAS will pinpoint this problem and document it in such a fashion as to convince management that it is worthwhile to re-design the antennas or associated circuitry causing the problem. In this manner, the VDAS is used as a tool to reduce the amount of time spent on troubleshooting and increase the man-hours expended on improving system efficiency.

V. CONCLUSION AND RECOMMENDATIONS

The maintenance group is thoroughly convinced of the efficacy of the VDAS. They only wish they had more test units available. This would be the prime recommendation arising from the project. We configured one test vehicle to determine if the system had value and wanted to ascertain whether installation of the VDAS on all vehicles would be cost effective. Both goals have been met. The VDAS pinpoints vehicle problems, and is the only way we know of which will provide maintenance with dynamic system information. We have seen problems on the test vehicle reflected in other vehicles, but have no way of knowing if the other vehicle is exhibiting identical symptoms. Yet, even from information gleaned from the single test vehicle, we can narrow the guesses to a manageable few in the instances where similar problems appear in other vehicles.

The VDAS should be viewed as a tool, not a panacea to all system problems. While it is possible to monitor a great many testpoints through expansion, it is felt that this approach would only serve to confuse the issue which is to significantly reduce vehicle downtime. This end result is better served by carefully selecting testpoints according to their own inherent value within the system. This, in conjunction with highly trained personnel, can reduce that downtime through failure analyses conducted with a systematic approach provided by using the VDAS as a diagnostic tool. The results from the data analysis must be viewed from the systems viewpoint.

It is important that personnel performing the analysis know exactly what should be happening at any given time. The VDAS can indicate something is awry, but it takes the skill of a trained technician to interpret that clue properly.

We are presently forging ahead with the task of incorporating VDAS into all of our vehicles. It is not necessary to have a computer in each vehicle. We feel that by configuring each vehicle such that a computing unit can easily be installed and removed as an individual vehicle exhibits an intermittent problem we can reduce the total system cost while maintaining a high level of system integrity. Our plans call for three or four computing units for a total fleet of 24 vehicles.

It is also important to keep accurate records of system problems such that an empirical database may be constructed. This is especially true in the case of those problems which are intermittent. They may occur only once every week or less, but with proper record keeping, enough information will be gathered such that the solution will eventually come to light. These records can also be very helpful in training new personnel and keeping present personnel up-to-date on the vehicle electronics.

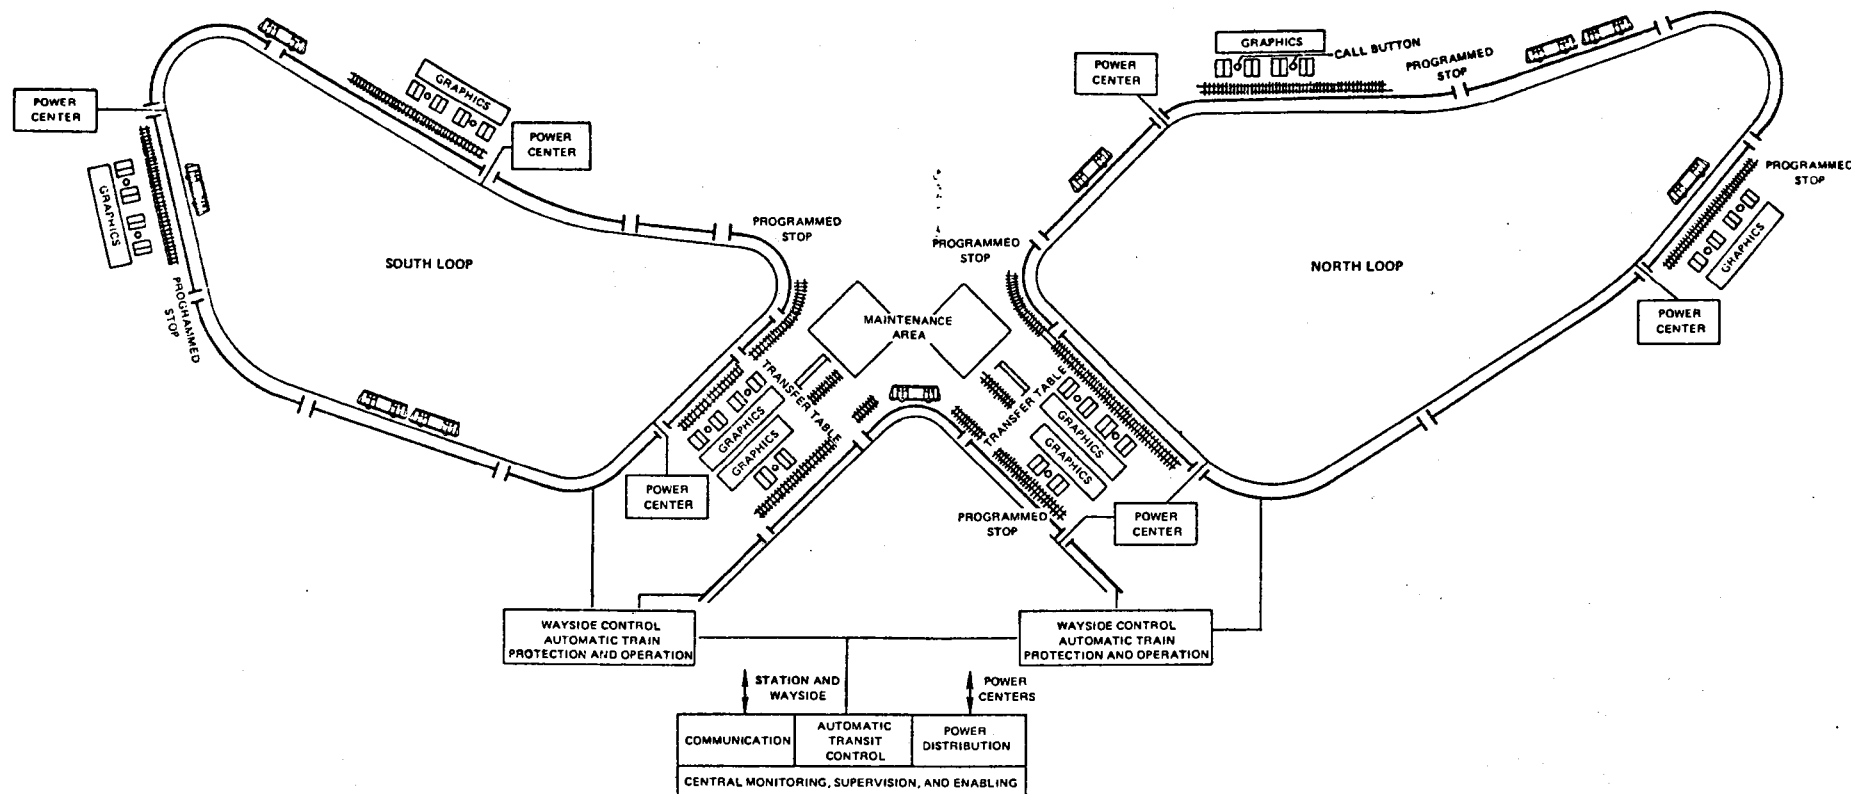


FIGURE 1
SEA-TAC INTERNATIONAL AIRPORT
SATELLITE TRANSIT SYSTEM

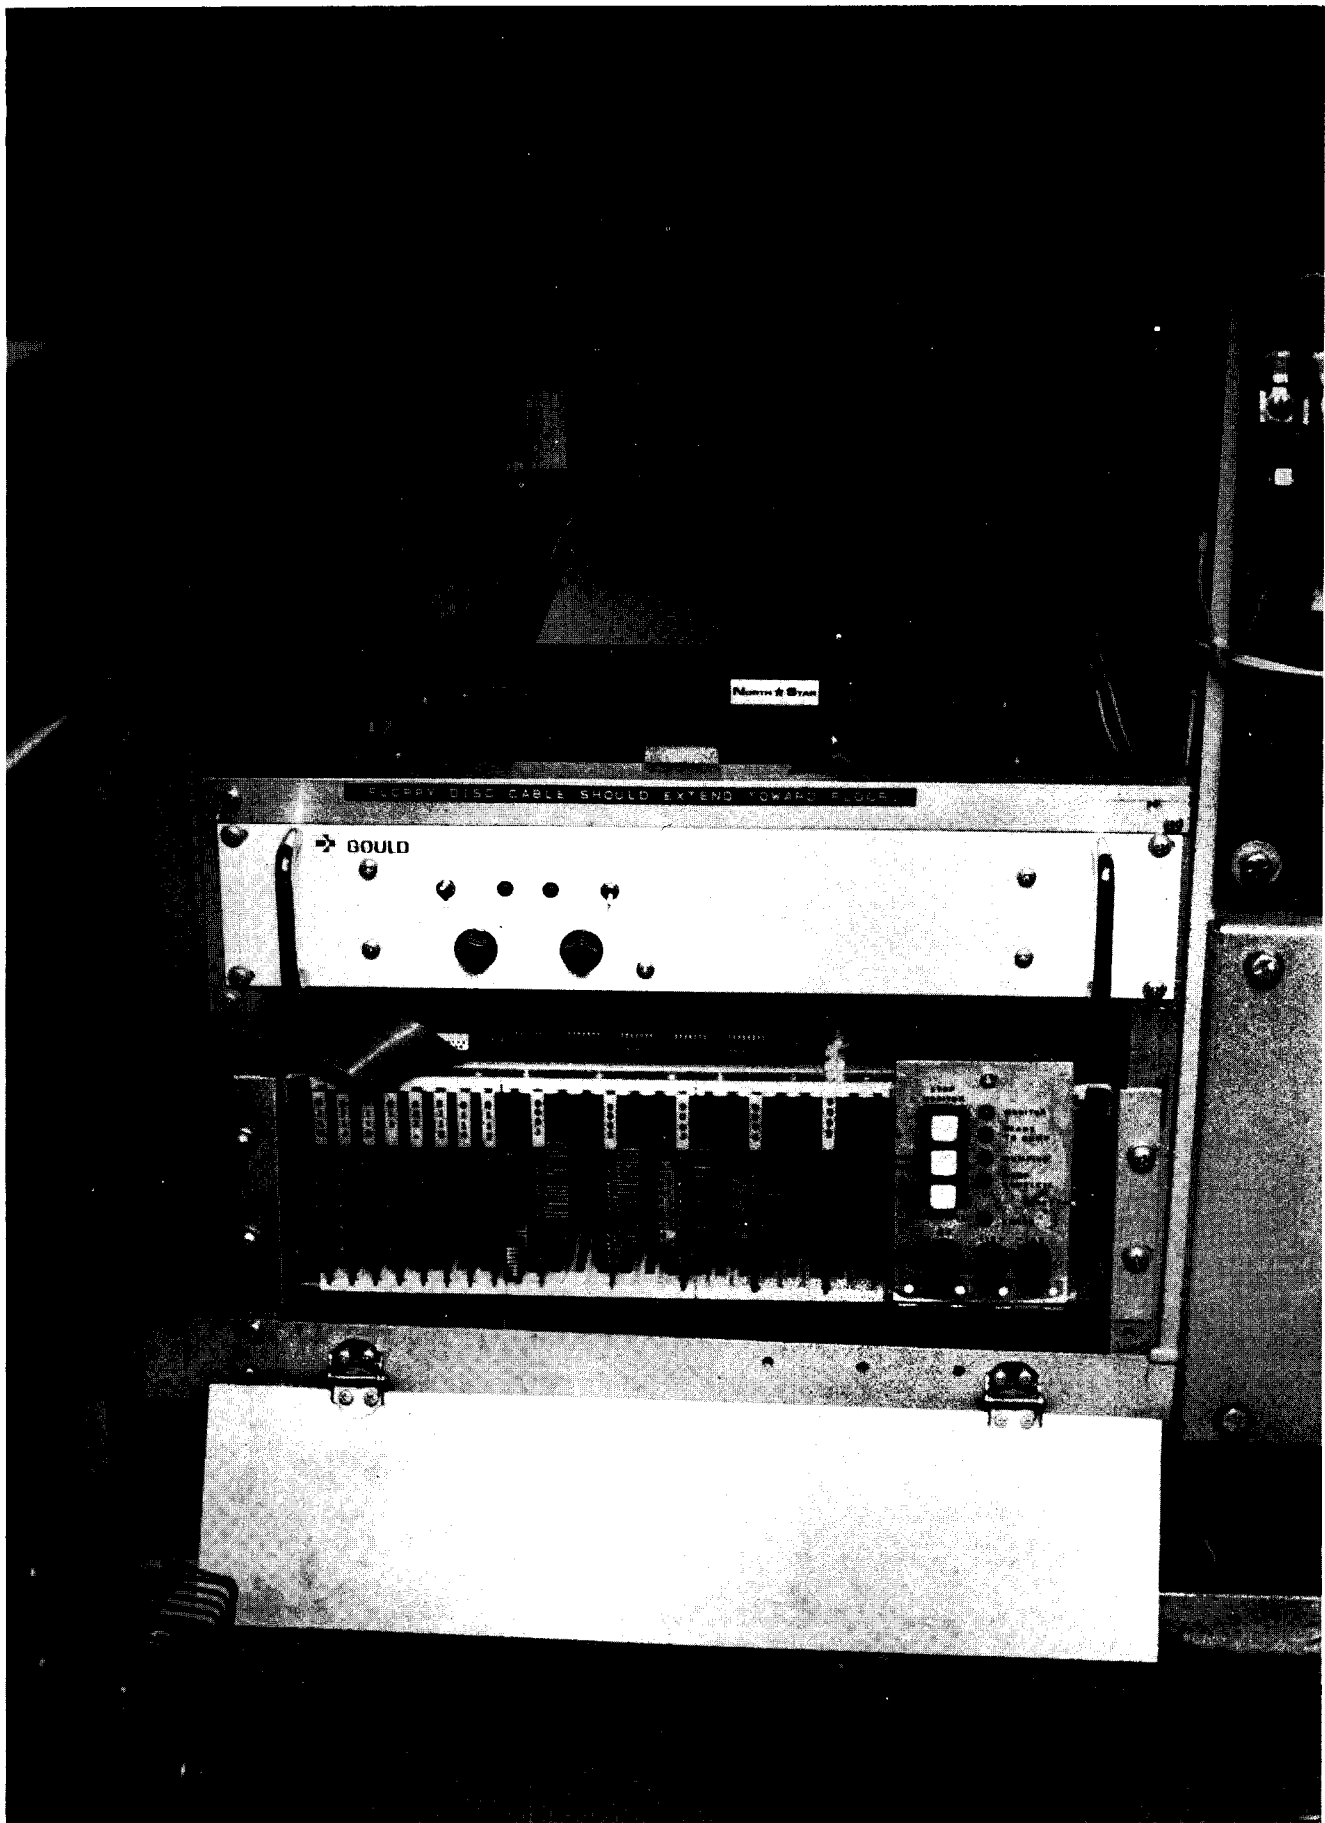


FIGURE 2
Picture of V DAS Control Circuitry




FIGURE 3

Picture of VDAS Termination Board



FIGURE 4

Picture of SOL Computer with North Star Disk

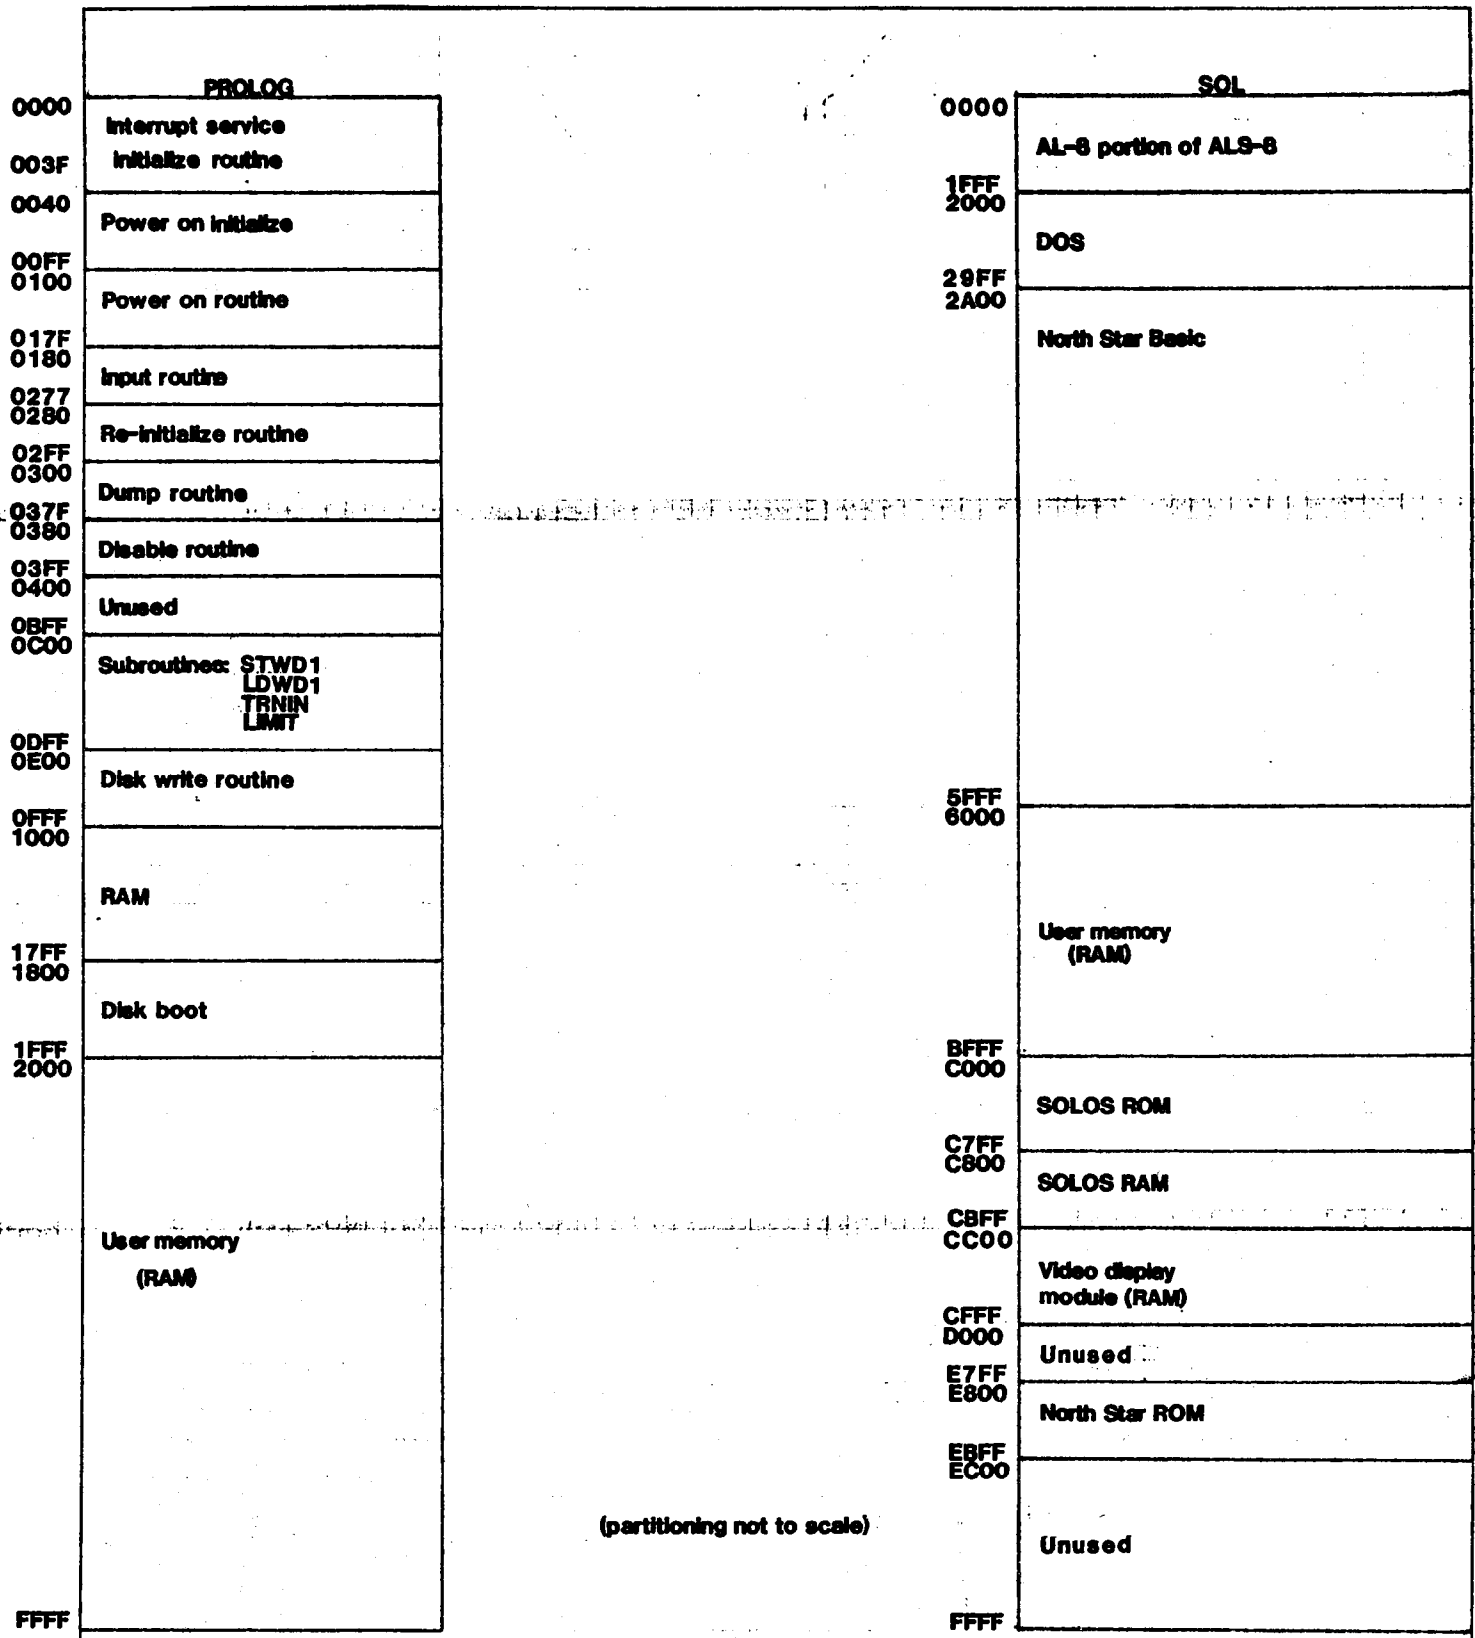

| | | |
|---------------------------------------------------|------------|----------------|
| PORT OF SEATTLE COMMISSION | | DESIGN NO. |
| PROJECT <u>STS-VDAS</u> | | DRAWING NO. |
| TITLE <u>MEMORY MAP: PROLOG & SOL SYSTEMS</u> | | |
| DRAWN BY <u>A. HAUG</u> | DATE _____ | APPROVED _____ |

POS 120-9

FIGURE 5

30 TESTPOINTS

DEVICE ADDRESS

BIT ASSIGNMENT #

(MSB)
8

7

6

5

4

3

2

(LSB)
1

| | | | | | | | | |
|------------|------------------|------------------------------|---------------------------------------|--------------------------------------|------------------------|------------------------------|--------------------------|------------------------------|
| IN '00 | TP-7H BR — | TP-7L DOC | TP-6 DTX | TP-5 MDL | TP-4 MC2 | TP-3 FP4 | TP-2 PR | TP-1 LS |
| IN '01 | TP-17H — BV — | TP-17L | TP-16H — CR — | TP-16L | TP-11 REL | TP-10 ZS | TP-9 LBC | TP-8 FLIN |
| IN '02 | TP-24 B/P | TP-23 UPD | TP-22 A REL | TP-21 TACH 2 | TP-19H — AP — | TP-19L X0 ≡ B X1 ≡ P | TP-18H — XP — | TP-18L O1 ≡ P I0 ≡ B |
| IN '03 | TP-32 OSI | TP-31 OSJ | TP-30 P SIG | TP-29 DCMD | TP-28 DSEN | TP-27 CB | TP-26 CA | TP-25 PCS |
| IN '04 | | | | | | | TP-34 COLD | TP-33 BAL |
| IN '05 | TP-20 BUSY | TP-20 BIT 8 (128) | TP-20 BIT 7 (64) TACH #1 | TP-20 BIT 6 (32) (NX.1) MPH | TP-20 BIT 5 (16) | TP-20 BIT 4 (8) | TP-20 BIT 3 (4) | TP-20 BIT 2 (2) |
| OUT '06 | NOT USED | DISABLE TIME INTERRUPT | (#4) DUMP COMPLETE INDICATOR | (#5) ERROR INDICATOR | NOT USED | (#3) DUMPING INDICATOR | (#2) READY TO DUMP | (#1) MONITOR INDICATOR |

PORT OF SEATTLE COMMISSION


DESIGN NO.

PROJECT STS - VDAS

TITLE BIT ASSIGNMENT IN PROLOG SYSTEM

DRAWING NO.

DRAWN BY P. STUTZ DATE 2/24/78 APPROVED _____

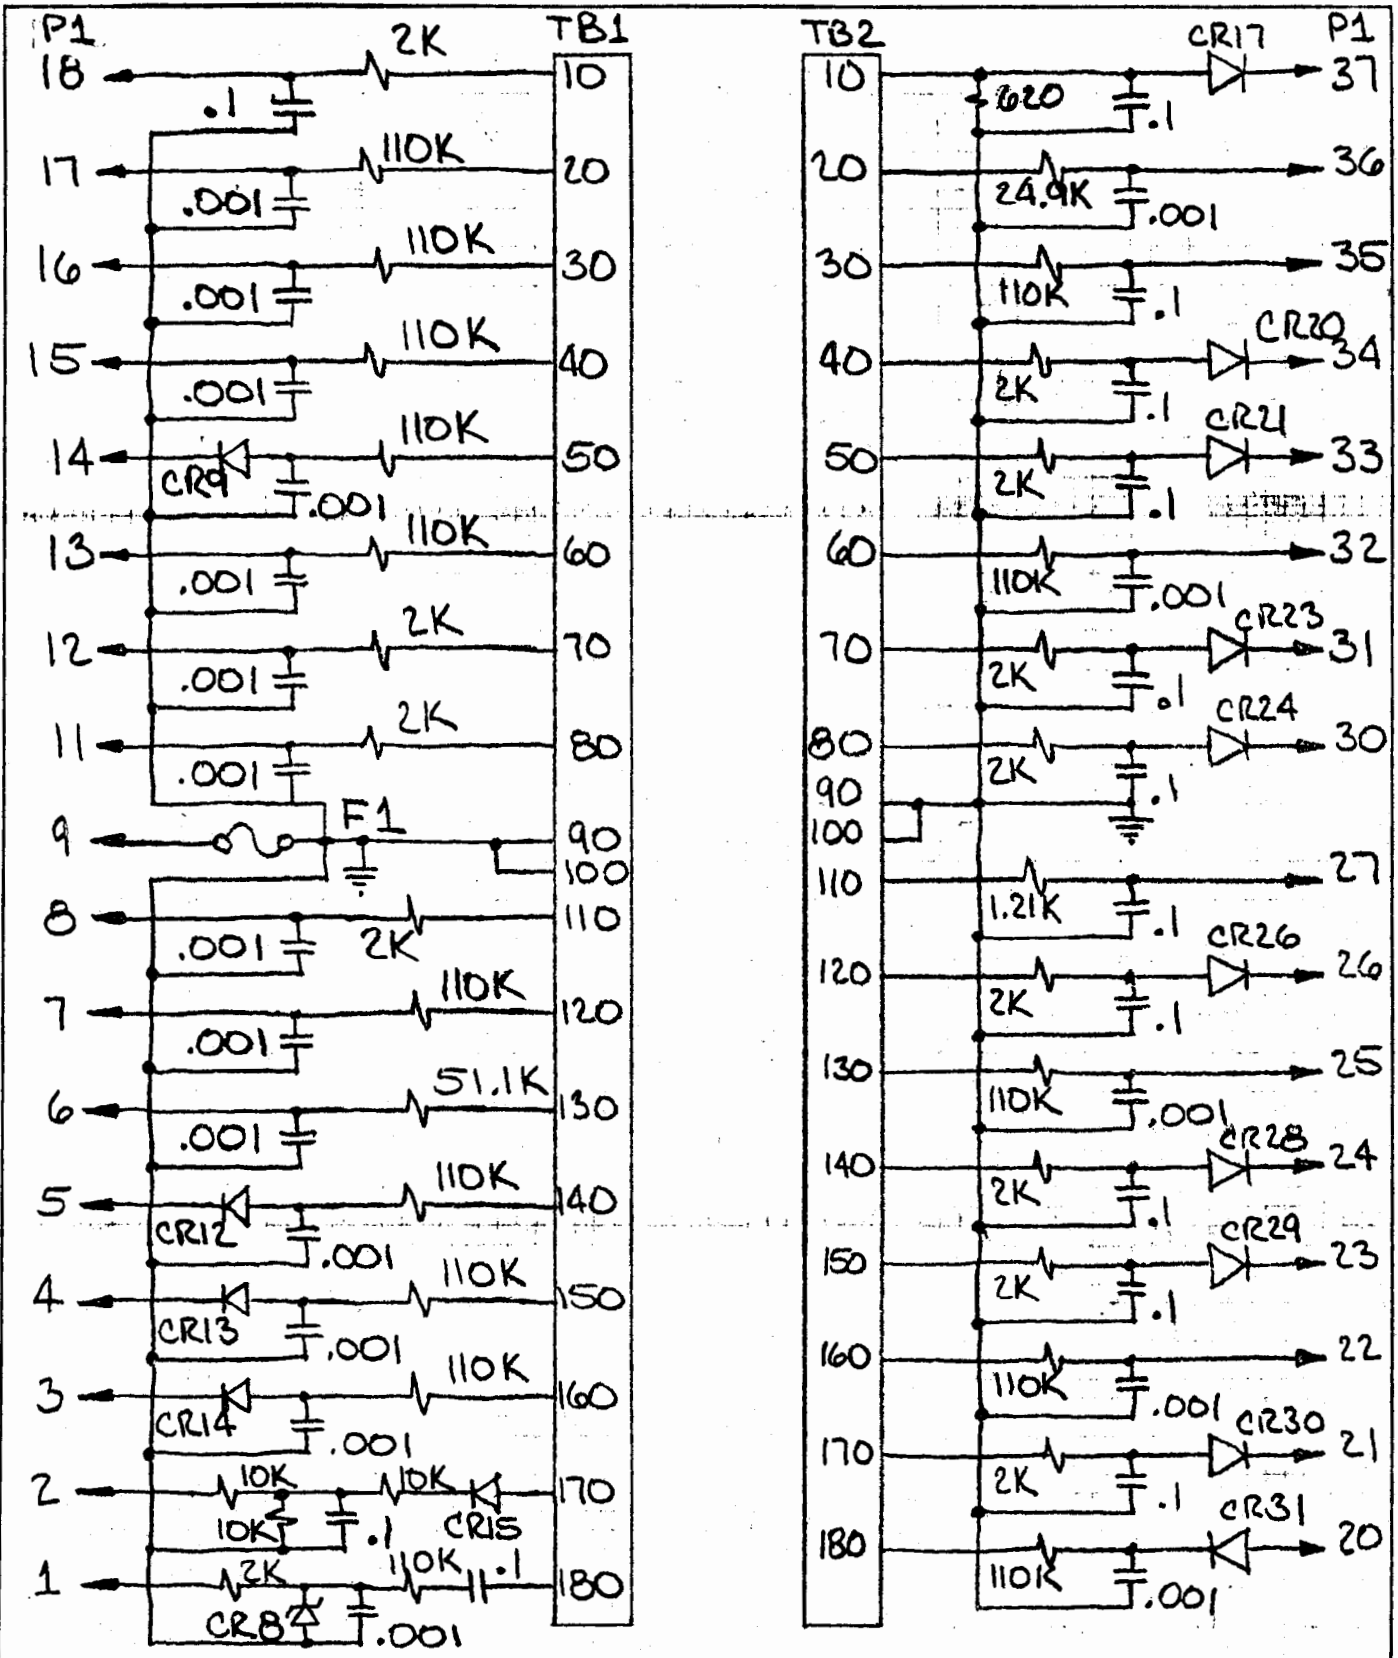


| | | |
|-------------------------------------|-----------------------------------|-------------|
| PORT OF SEATTLE COMMISSION | | DESIGN NO. |
| PROJECT <u>STS-VDAS</u> | | DRAWING NO. |
| TITLE <u>VDAS Termination Board</u> | | |
| DRAWN BY <u>A. HAUG</u> | DATE <u>9/7/79</u> APPROVED _____ | |

POS 120-9

FIGURE 7







TO DISK

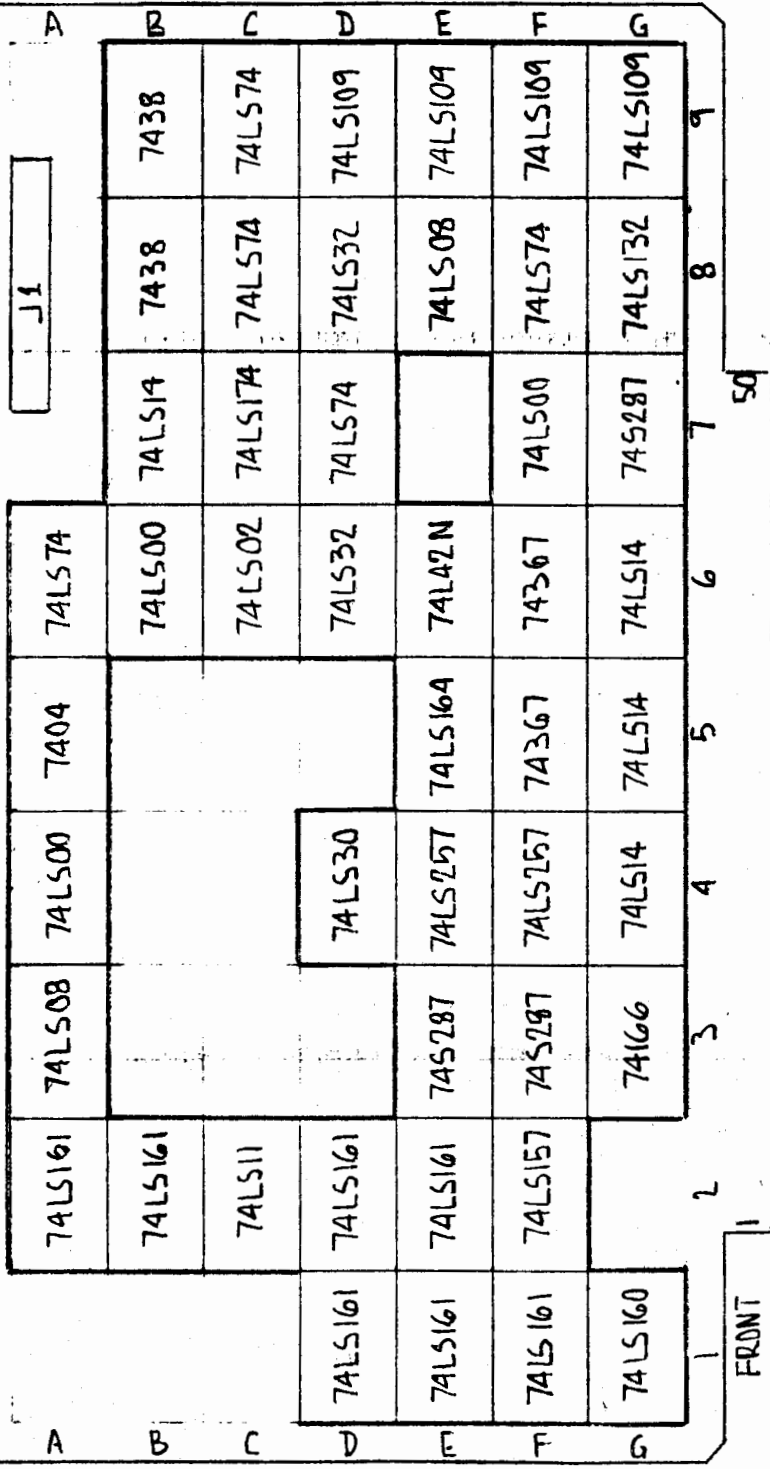

TO S-100 BUS

| | | | |
|----------------------------|----------------------------------|------|-------------|
| PORT OF SEATTLE COMMISSION | | | DESIGN NO. |
| PROJECT | STS- VDAS | | DRAWING NO. |
| TITLE | NORTHSTAR DISK I/O-CARD ASSEMBLY | | |
| DRAWN BY | P. STUTZ | DATE | 3/6/78 |
| APPROVED | | | |

FIGURE 8 a

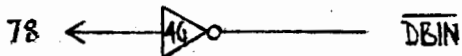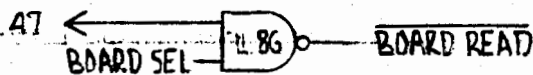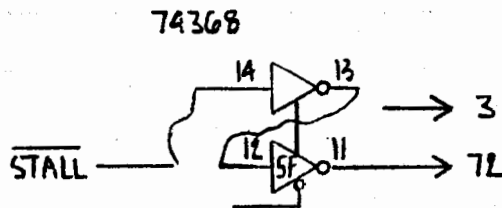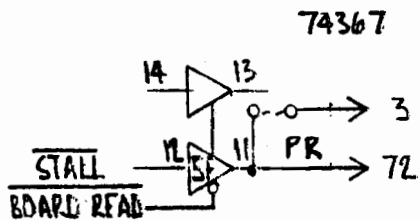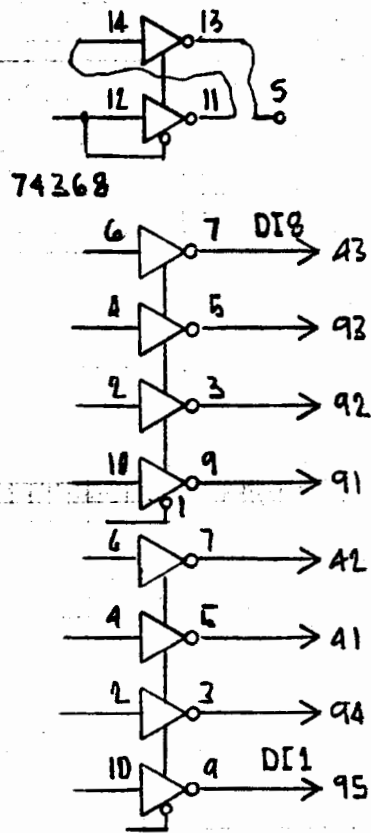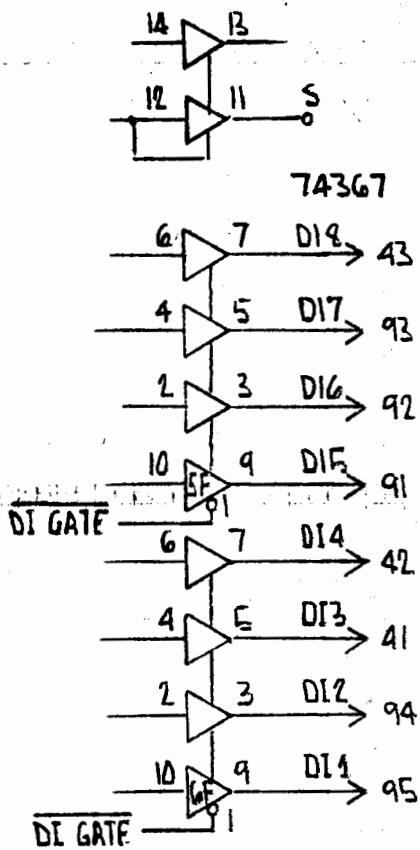

STANDARD
INTERFACE

ADAPTED FOR PROLOG

| | | |
|----------------------------|------------------------------------|-------------|
| PORT OF SEATTLE COMMISSION | | DESIGN NO. |
| PROJECT | STS - VDA6 | |
| TITLE | ADAPT NORTHSTAR-DISK-I/O TO PROLOG | |
| DRAWN BY | PETEZ STUTZ | DATE 3/6/78 |
| | APPROVED | |
| | | DRAWING NO. |

FIGURE 8b

M: Memory Amount (# of 8 bit words)

S: Sample rate(sec)

T: Length of time which may be stored using M & S above (min)

B: Word length (bits)

The following equation may be used to determine core memory size:

$$M = \frac{BT \times 60 \text{ sec}}{S \times 1 \text{ min}} = \frac{60BT}{S}$$

In our system, the following are given:


$$M = 56K = 57,344 \quad (1K = 1024)$$

$$S = .1 \text{ sec}$$

$$B = 8 \text{ bits}$$

$$T = \frac{MS}{60B} = \frac{(57344)(.1)}{60(8)} \quad 11.95 \text{ min}$$

FIGURE 9
Core Memory Size Calculation

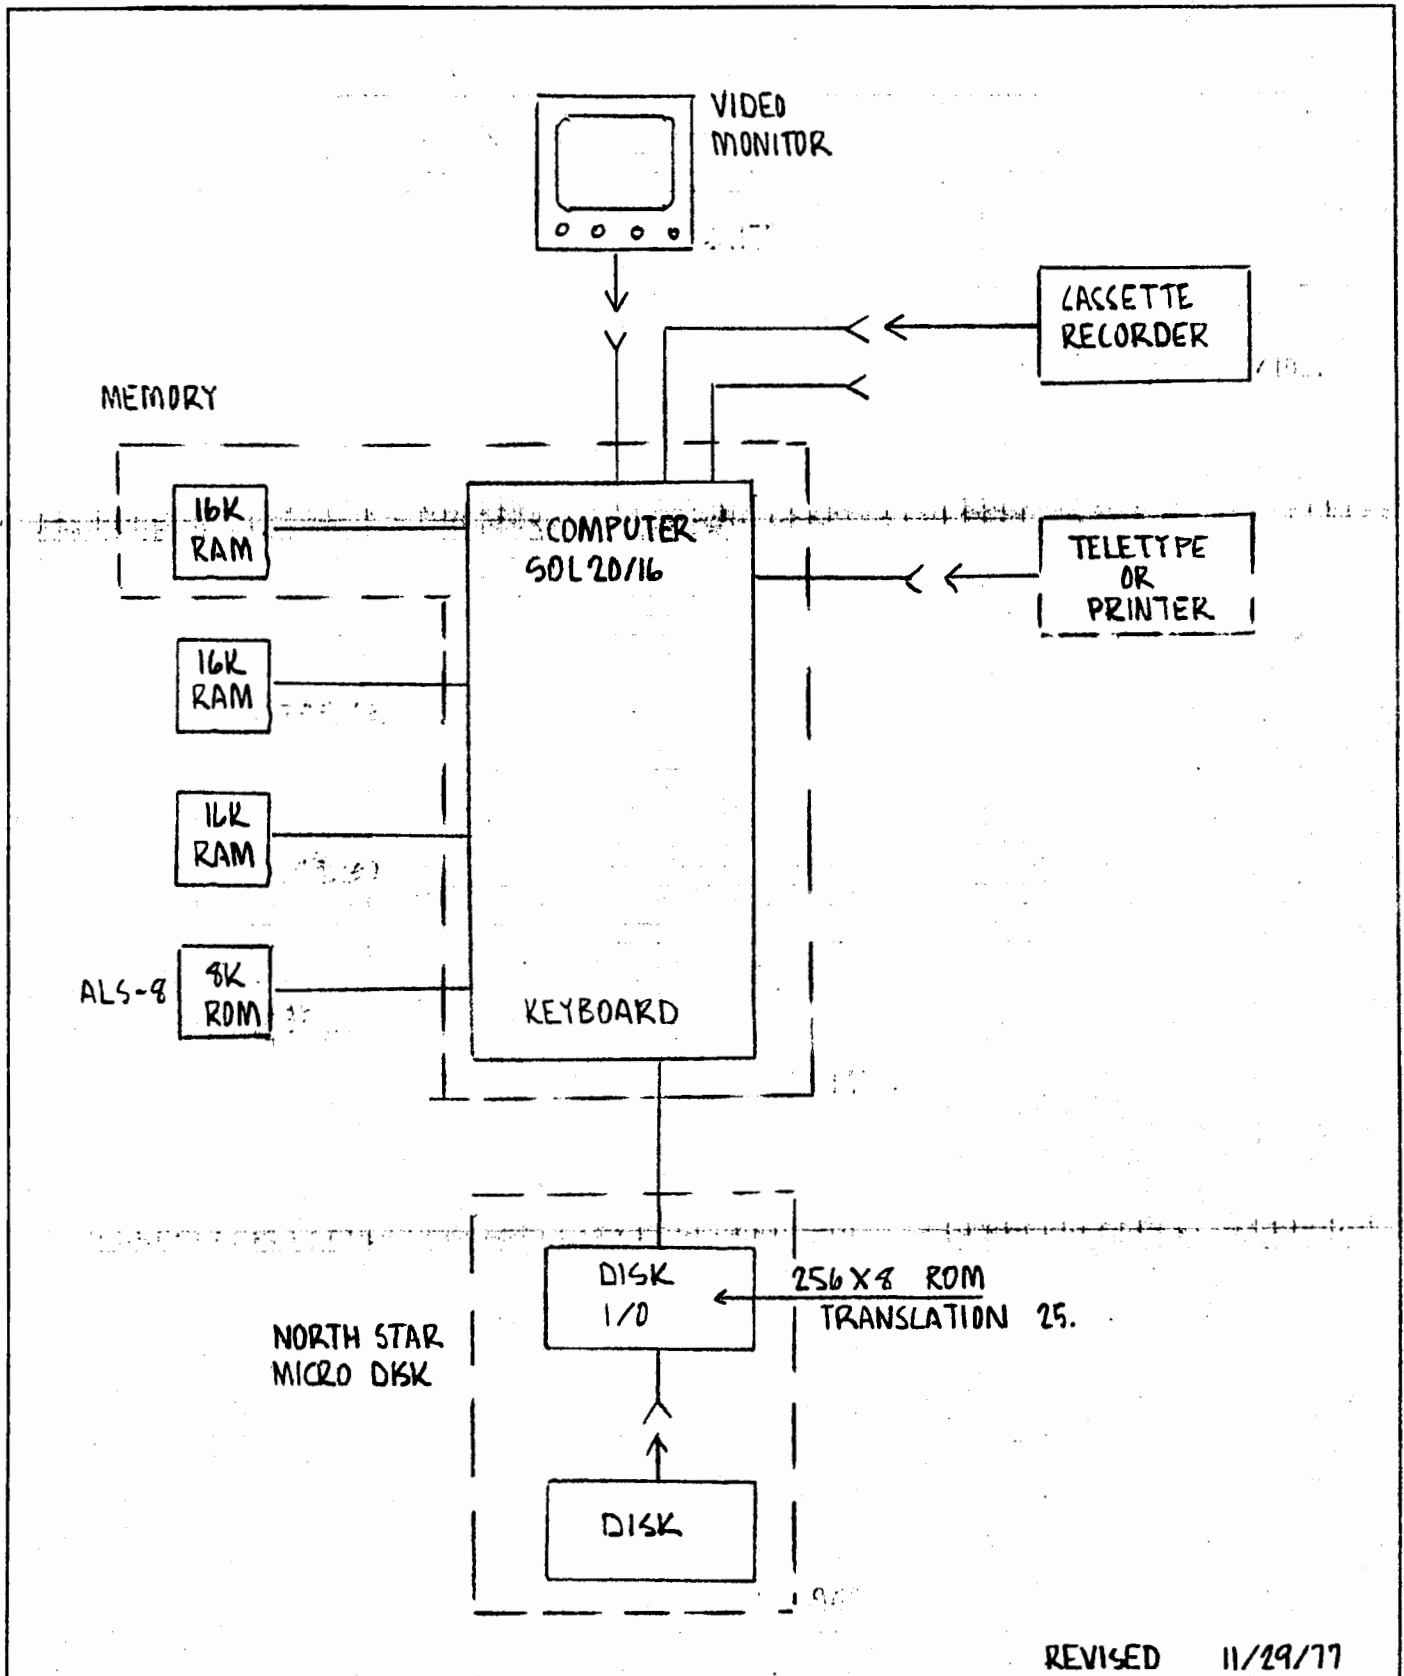


REVISED 11/29/77

| | | |
|-----------------------------------|----------------------------------------|-------------|
| PORT OF SEATTLE COMMISSION | | DESIGN NO. |
| PROJECT | STS - VDA6 | DRAWING NO. |
| TITLE | IN HOUSE DEVELOPMENT & PLOTTING SYSTEM | |
| DRAWN BY | P. STUTZ | |
| DATE | 11-22-77 | APPROVED |

POS 120-9

FIGURE 10

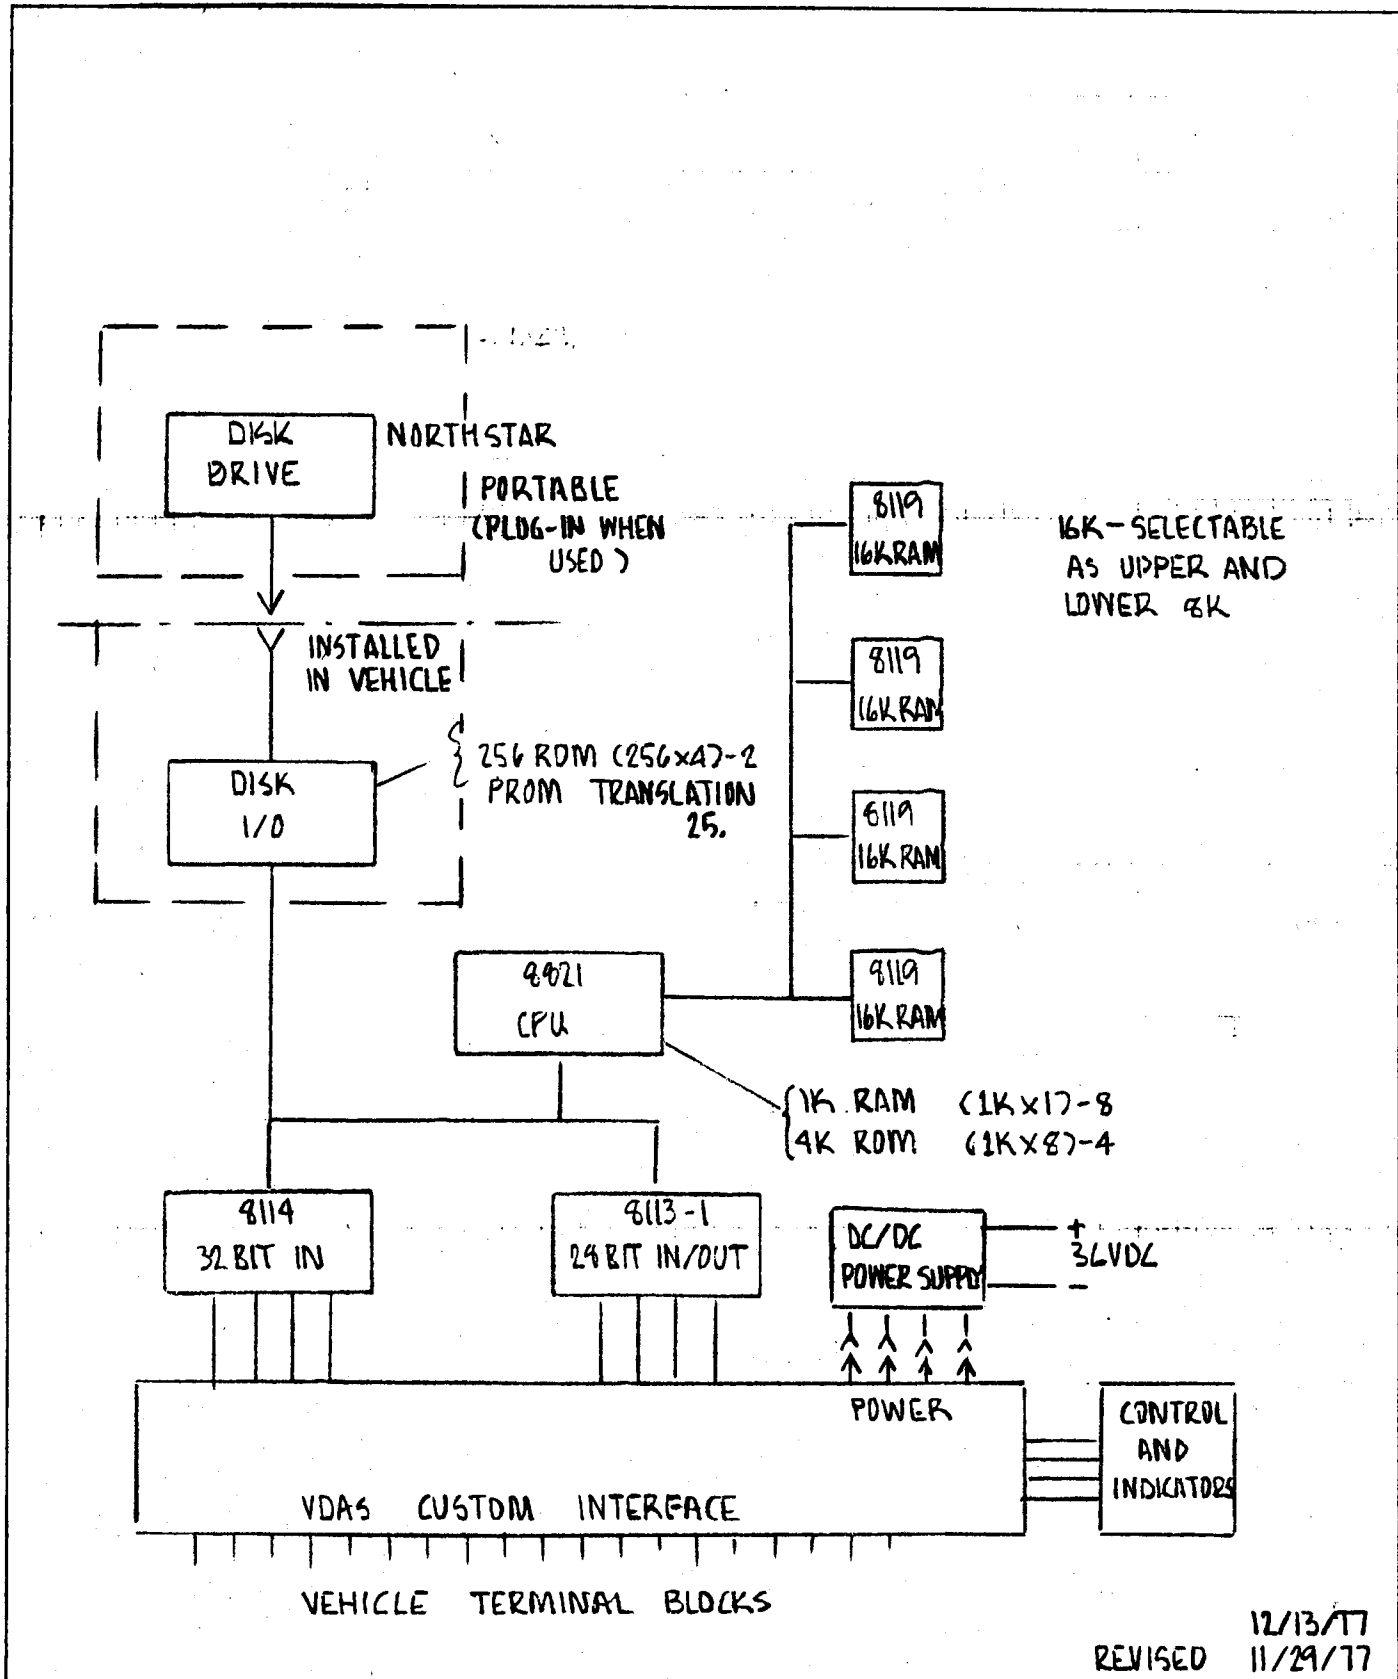

| | | |
|--------------------------------------------------------------|-------------|------------|
| PORT OF SEATTLE COMMISSION | | DESIGN NO. |
| PROJECT <u>STS - VDA5</u> | | |
| TITLE <u>VEHICLE COMPUTER HARDWARE (PROLOG)</u> | | |
| DRAWN BY <u>P. STUTZ</u> DATE <u>11-22-77</u> APPROVED _____ | DRAWING NO. | |

POB 120-9

FIGURE 11

| DATA | TIME | |
|------|------|--------------------------|
| | 1 | LINE SW CLOSED |
| | 2 | PR RELAY CLOSED |
| | 3 | FP RELAY CLOSED |
| | 4 | MAIN CONTACTOR CLOSED |
| | 5 | MOTOR OVERLOAD |
| | 6 | DOC TX TO WAYSIDE |
| | 7L | ANY DOC-VEH. OR INFO. RX |
| | 7H | BIT RATE + DOC |
| | 8 | FLIN + REL |
| | 9 | LOW BRAKE CLAMP |
| | 10 | ZERO SPEED |
| | 11 | REL FROM INFO RX |
| | 16L | PROP |
| | 16H | HARD PROP |
| | 17L | PROGRAM STOP BRAKING |
| | 17H | MAX. CONTROL BRAKING |
| | 18L | PROP. (XP SIG.) |
| | 18H | BRAKING (XP SIG.) |
| | 19L | PROP. (AP SIG.) |
| | 19H | " |
| | 20 | TACH 1 SPEED |
| | 21 | TACH 2 > 2.5 VOLTS |
| | 22 | A RELAY PULLED IN |
| | 23 | UPDATE RECEIVED |
| | 24 | PROP. |
| | 25 | PCS TX ON |
| | 26 | COUP. #1 END |
| | 27 | COUP. #2 END |
| | 28 | FWD SENSE FROM REVERSER |
| | 29 | FWD + CAR AHEAD |
| | 30 | P SIG. INTERLOCK |
| | 31 | TACH 1 FAULT |
| | 32 | TACH 2 FAULT |
| | 33 | BALANCE FAULT |
| | 34 | CODE LOAD |

FIGURE 12a

Data Analysis Overlay Showing Bit Placement

TEST DATA

(IP 1 THRU 34)

| WTR TIME | 1 1 1 1 1 1 2 2 2 2 2 2 2 2 2 3 3 3 3 3 | | | | | | | | | | | | | | | | | | | | | | | | | | | | | | | | | |
|-------------|-----------------------------------------|---|---|---|---|---|----|---|---|---|---|----|----|----|----|-----|---|---|---|---|---|---|---|---|---|---|---|---|---|---|--|--|--|--|
| INT (SEC) | 1 | 2 | 3 | 4 | 5 | 6 | 7 | 8 | 9 | 0 | 1 | 6 | 7 | 8 | 9 | 0 | 1 | 2 | 3 | 4 | 5 | 6 | 7 | 8 | 9 | 0 | 1 | 2 | 3 | 4 | | | | |
| 3582 6354.3 | 1 | 0 | 0 | 1 | 1 | 1 | 11 | 1 | 1 | 1 | 0 | 11 | 00 | 01 | 01 | 5.5 | 1 | 1 | 1 | 1 | 1 | 1 | 1 | 0 | 1 | 1 | 0 | 0 | 1 | 1 | | | | |
| 3583 6456.7 | 1 | 0 | 1 | 1 | 1 | 1 | 11 | 1 | 1 | 1 | 0 | 11 | 00 | 01 | 11 | 5.5 | 1 | 1 | 1 | 1 | 1 | 1 | 1 | 0 | 1 | 1 | 0 | 0 | 1 | 1 | | | | |

STOP IN LINE 9135LEGEND

1-FRUIT

0-UR

0-BRIKE

0-PROPULSION

0-UR 30-UNDEFINED

TEST POINT 20 GIVEN IN MPH


FIGURE 12b

Sample Test Data Analysis Output

| <u>Sub-system</u> | <u># TP's</u> |
|----------------------|---------------|
| Car Logic | 1 |
| Traction Controller | 3 |
| Brake/Propulsion | 4 |
| Speed Maintaining | 7 |
| Speed Decoder | 1 |
| Information Receiver | 3 |
| Vehicle Transmitter | 1 |
| Train Line Wire | 5 |
| AC Power Controls | 5 |
| | <hr/> |
| | 30 |


Four test points not shown deal with the vehicle doors. These points were later determined to be so obvious as to not require system monitoring (ie. doors are either open or closed).

TABLE 1

 

APPENDIX A

Test Point Drawings

 

VDAS

BASIC GUIDELINES FOR INTERCONNECTION

- ALL 36VDC SIGNAL THRU OPTICAL ISOLATORS

~~- NO PHYSICAL CONNECTION BETWEEN BATTERY
GROUND AND SYSTEM GROUND~~

EXCLUDE

12/13/77 P. STUTZ


- ALL INTERCONNECTIONS ON TERMINAL BLOCKS,
EITHER ALREADY EXISTING, SPARE TERMINALS
OR TB-3 (~~TOTALLY UNUSED SO FAR~~);

TB3-55/56/57/58 USED
FOR RECENT MODIFICATION

- USE SPARE CIRCUITRY ON BOARDS WHERE
AVAILABLE (UNUSED BUFFERS ETC.)

- NO CHANGE TO EXISTING CIRCUIT BOARDS UNLESS
ABSOLUTELY NO OTHER CHOICE,


- VDAS CRADLE, 104-PIN CONNECTOR NUMBERS ARE DESIGNATED
WITH "#" AND PIN NUMBER.

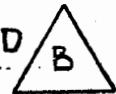

REVC 7/20/78
REV B 4/3/78
REV A 12/13/77

| | | |
|----------------------------|---------------------------------|-------------|
| PORT OF SEATTLE COMMISSION | | DESIGN NO. |
| PROJECT | STS - VDAS TESTPOINT DEFINITION | |
| TITLE | GUIDELINES FOR INTERCONNECT | DRAWING NO. |
| DRAWN BY | P. STUTZ | LCD P-330 |
| DATE | 11-4-77 | APPROVED |

CPARE CONTACT
(N.C.)

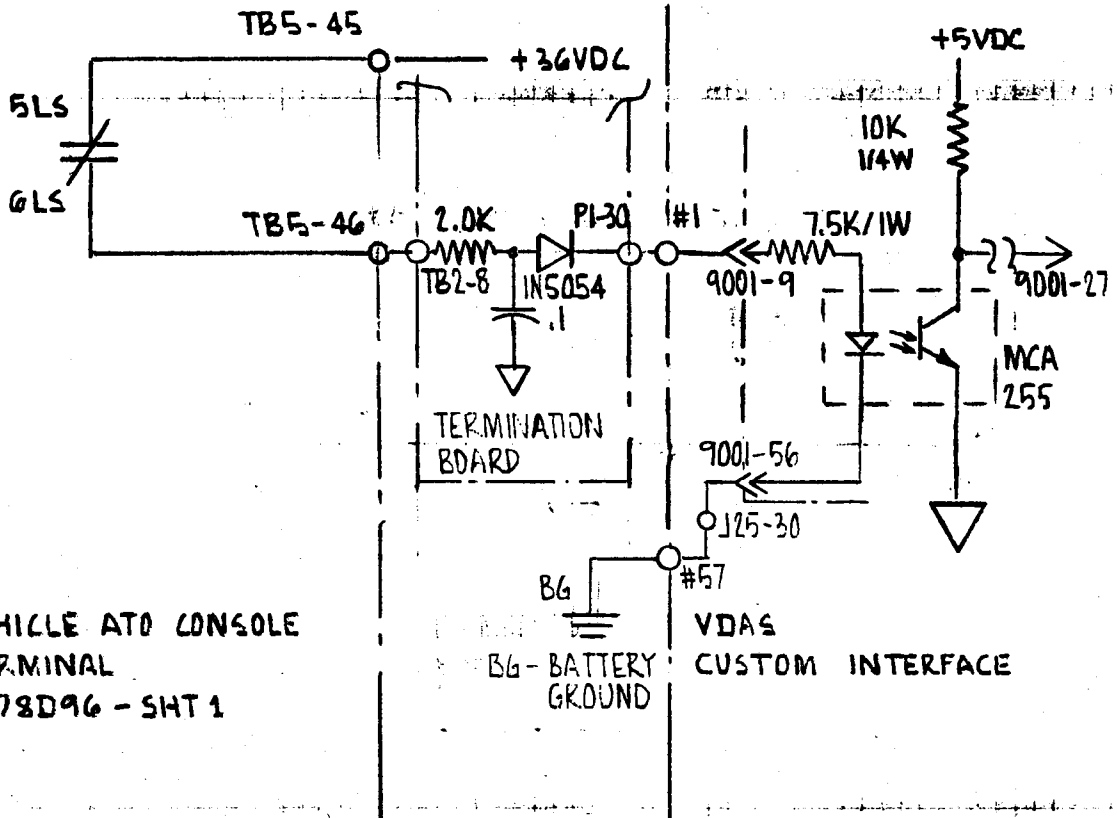


REF VEHICLE ATO CONSOLE
TERMINAL
7078D96 - SHT 1

(W)

REV C 7/20/78
REV B 4/3/78
REV A 12/9/77

| | | |
|---|--|---------------------------------------------------|
| PROJECT <u>STS - VDAS TESTPOINT DEFINITION</u> TITLE <u>TESTPOINT #1 - LINE SWITCH</u> DRAWN BY <u>P. STUTZ</u> DATE <u>10-31-77</u> APPROVED _____ | | DESIGN NO. DRAWING NO. <u>LCO P-330</u> |
|---|--|---------------------------------------------------|

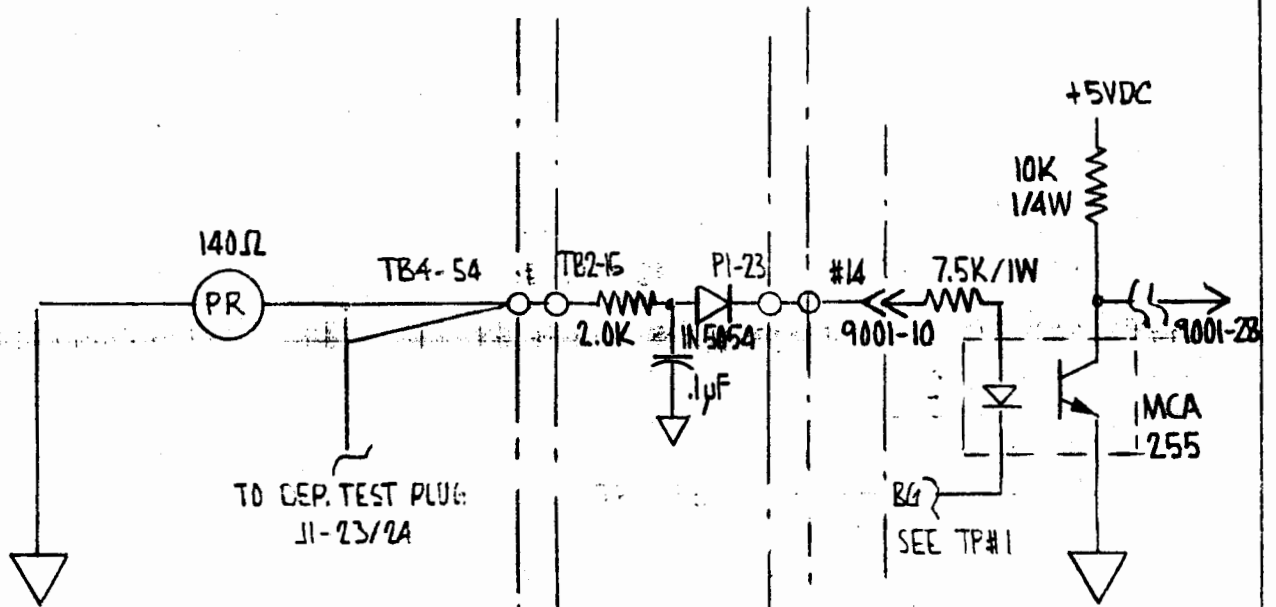

REF (W) VEHICLE INTER CRADLE WIRING
7304D29 - SHT 68

(W) VEHICLE SCHEMATIC
3907C11 - SHT 11

TERMINATION BOARD

VDA'S CUSTOM INTERFACE


REV C 7/20/76
REV B 4/3/78

PROJECT STS - VDA'S TESTPOINT DEFINITION
TITLE TESTPOINT #2 - POWER RELAY
DRAWN BY P. STUTZ DATE 10-31-77 APPROVED _____

DESIGN NO.

DRAWING NO.

LCO P-330

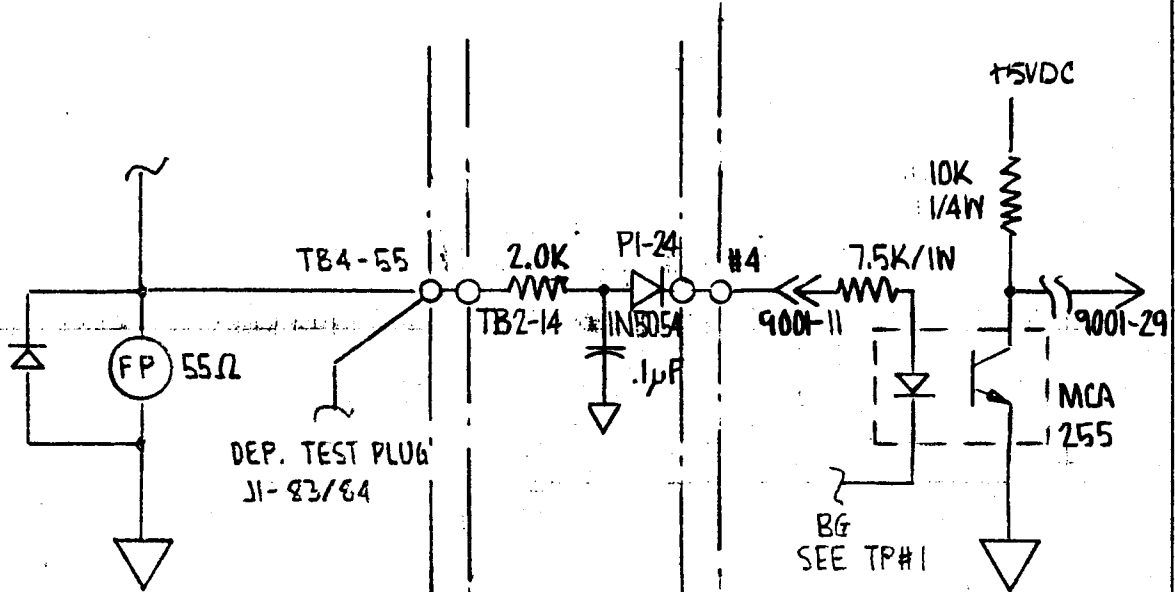

REF. VEHICLE SCHEMATIC
 (W) 3907C11 - SHT 11

(W) VEH. ATD CONSOLE
 7078D96 - SHT 1


(W) INTER-CRADLE WIRING
 7304D39 - SHT 69

TERMINATION BOARD

VDA'S CUSTOM INTERFACE


REV C 7/20/78
 REV B 4/3/78

| | | |
|-------------------------------------------------|----------------------|------------------|
| PORT OF SEATTLE COMMISSION | | DESIGN NO. |
| PROJECT <u>STS - VDA'S TESTPOINT DEFINITION</u> | | DRAWING NO. |
| TITLE <u>TESTPOINT #3 - GATING RELAY (CFP4)</u> | | <u>LCO P-330</u> |
| DRAWN BY <u>P. STUTZ</u> | DATE <u>10-31-77</u> | APPROVED _____ |

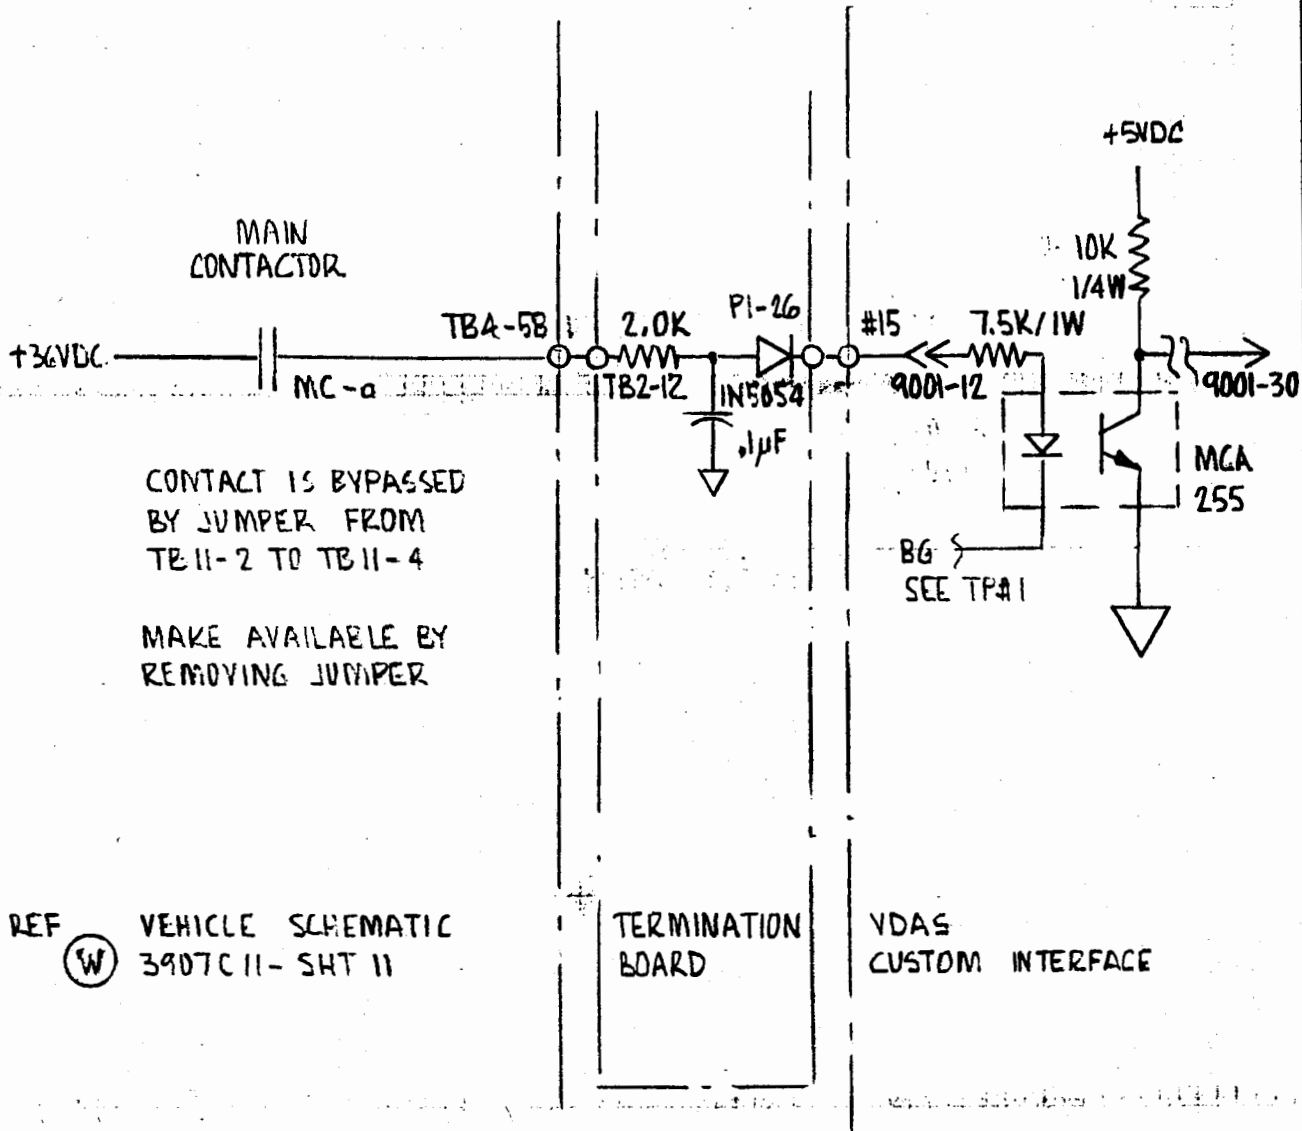

REV C 7/20/78
 REV B 4/3/78

| | | |
|------------------------------------------------|----------------------|----------------|
| PROJECT <u>STS - VDAS TESTPOINT DEFINITION</u> | | DESIGN NO. |
| TITLE <u>TESTPOINT #4 - MAIN CONTACTOR</u> | | DRAWING NO. |
| DRAWN BY <u>P. STUTZ</u> | DATE <u>10-31-77</u> | APPROVED _____ |
| PORT OF SEATTLE COMMISSION | | LCD P-330 |

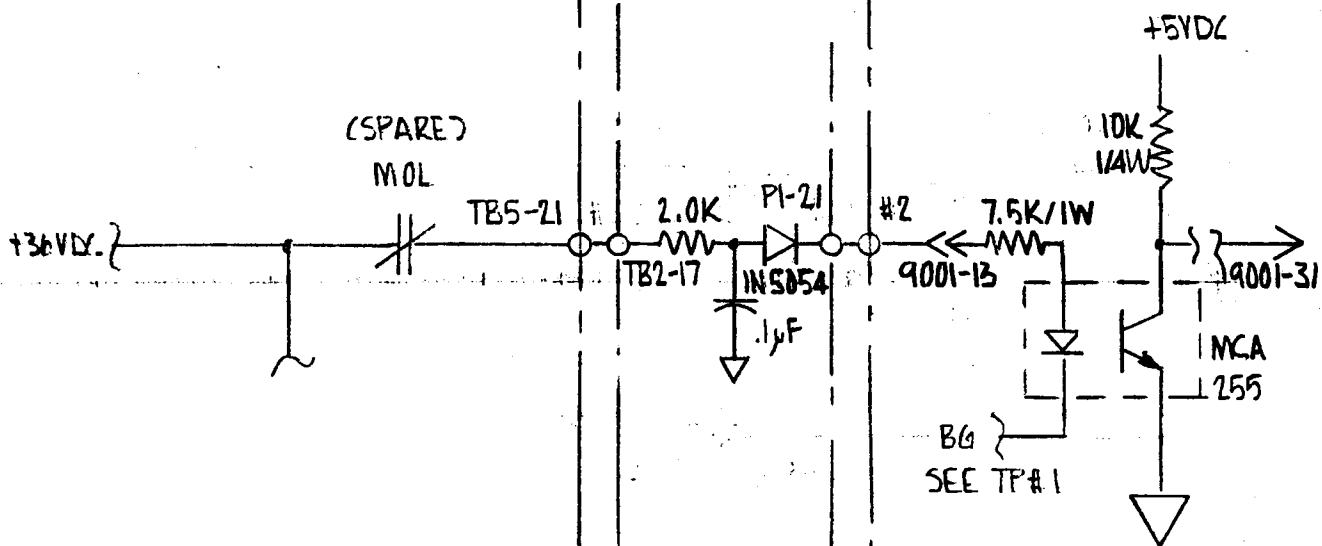

- REF (W) VEHICLE SCHEMATIC
3907C11 - SHT 12
- (W) ATO CONSOLE TERM. BD.
7078D96 - SHT 1

TERMINATION BOARD

VDAS CUSTOM INTERFACE

REV C 7/20/78
REV B 4/3/78


PROJECT STS - VDAS TESTPOINT DEFINITION

TITLE TESTPOINT #5 - MOTOR OVERLOAD

DRAWN BY P. STUTZ DATE 10-31-77 APPROVED _____




DESIGN NO. _____

DRAWING NO. LCO P-330

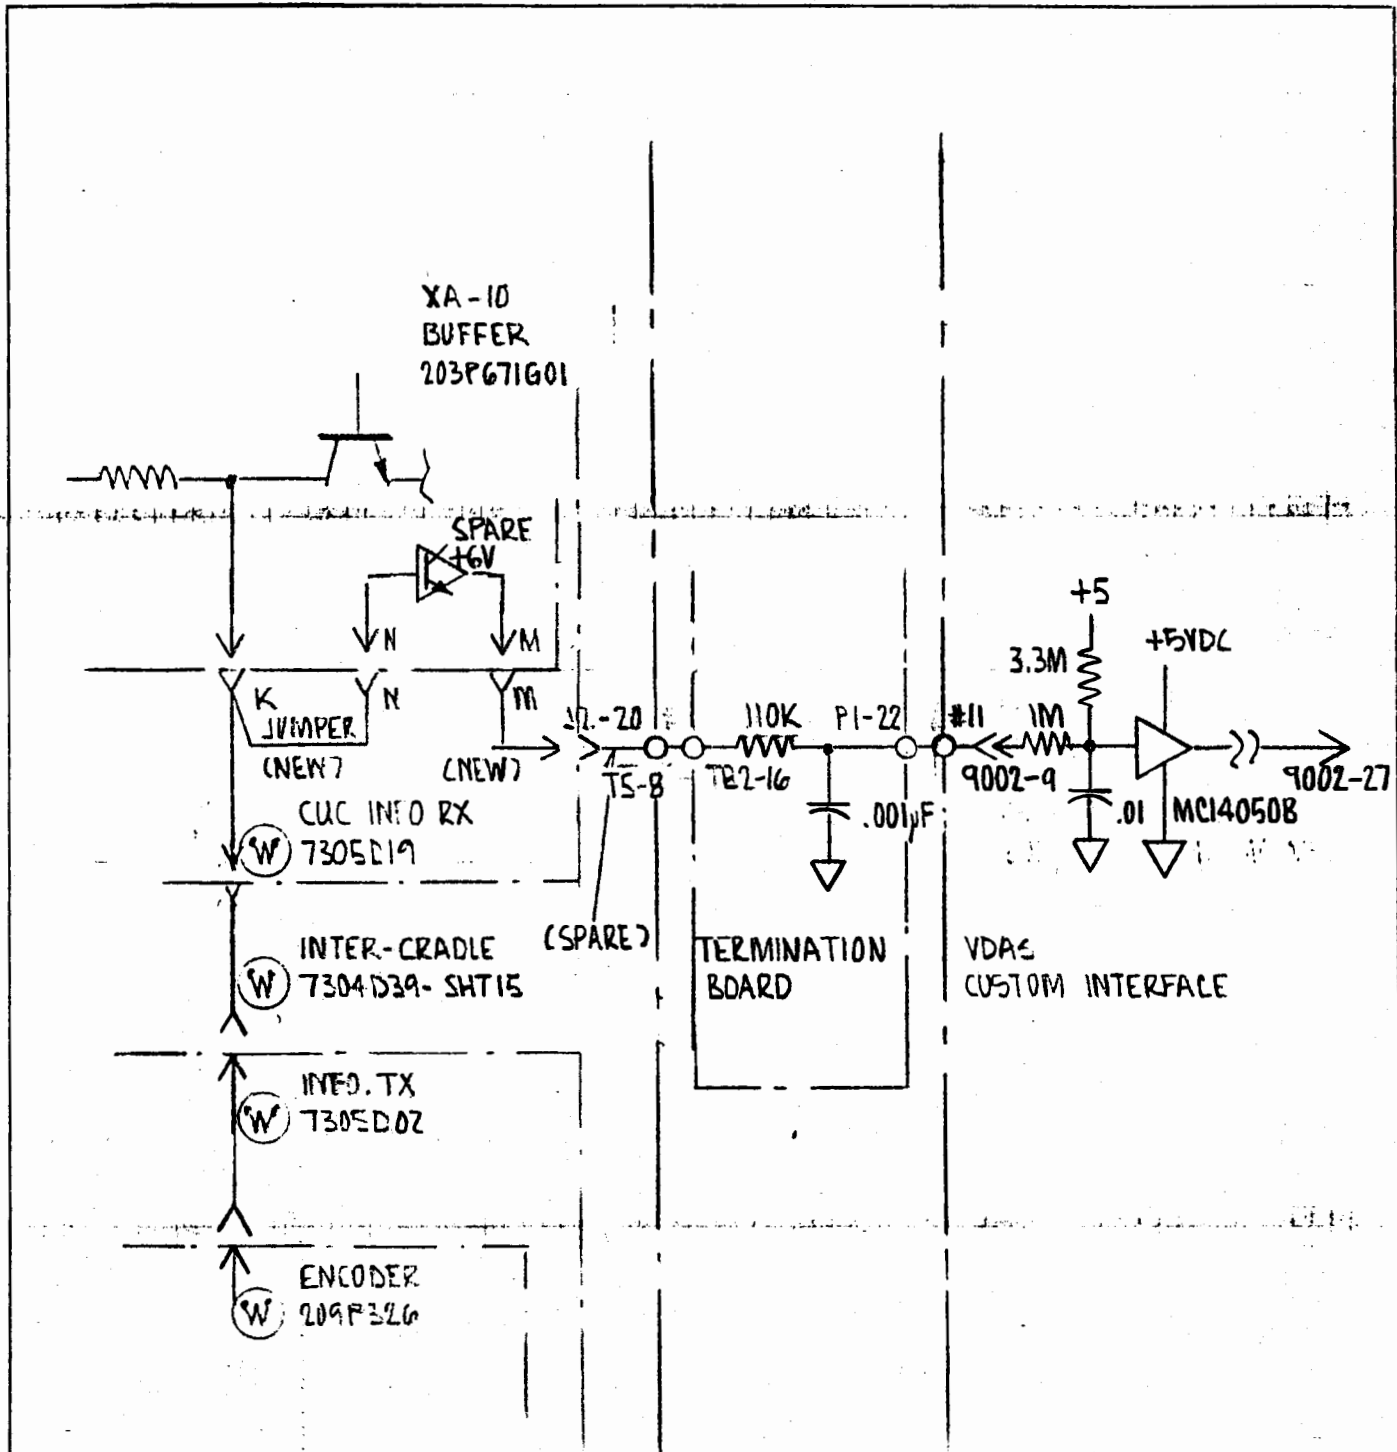

REV C 7/20/78
 REV B 4/3/78
 REV A 12/9/77


| | | |
|-----------------------------------------------------------------|-------------------------------------|--------------------------|
| PORT OF SEATTLE COMMISSION | | DESIGN NO. |
| PROJECT <u>STS- VDA6 TESTPOINT DEFINITION</u> | | |
| TITLE <u>TESTPOINT #6 - DOOR OPEN COMMAND TX (FROM VEHICLE)</u> | | DRAWING NO. LCO P-330 |
| DRAWN BY <u>P. STUTZ</u> | DATE <u>10-31-77</u> APPROVED _____ | |

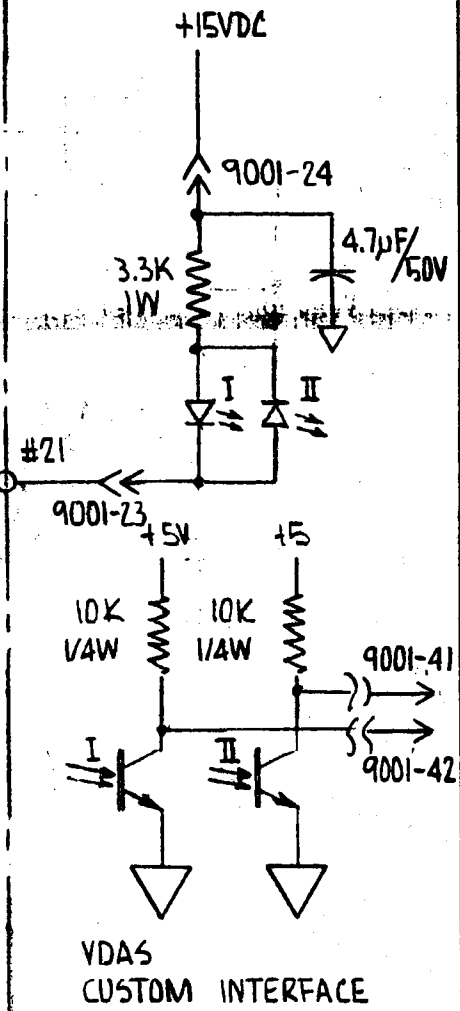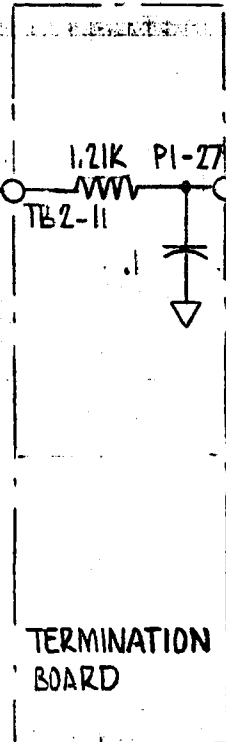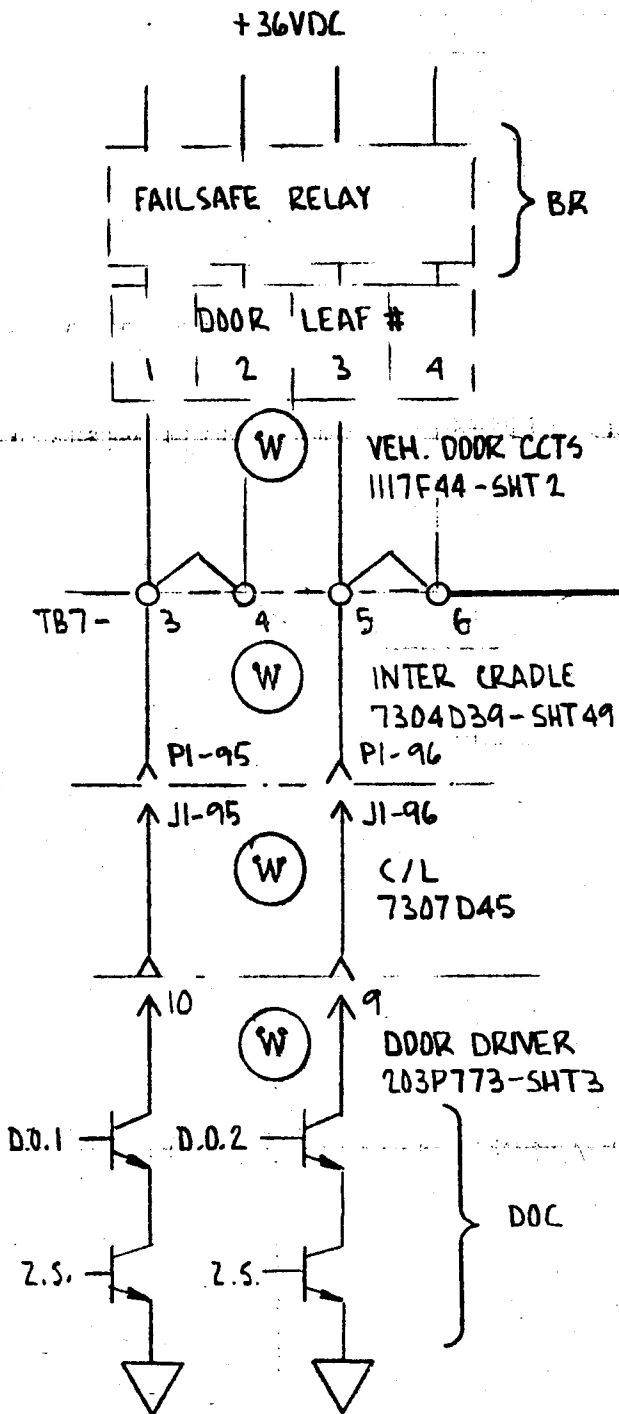

| | A | B | $\emptyset \hat{=} 0V$ |
|------------------------------------|-------------|-------------|------------------------|
| BR · DOC | \emptyset | I | I $\hat{=} +5V$ |
| \overline{BR} · DOC | \emptyset | I | |
| BR · \overline{DOC} | I | \emptyset | |
| \overline{BR} · \overline{DOC} | I | I | |

REV C 7/20/78
 REV B 4/3/78
 REV A 12/9/77

| | | |
|--------------------------------------------------|--------------|--------------------------|
| PORT OF SEATTLE COMMISSION | | DESIGN NO. |
| PROJECT STS- VDCS TESTPOINT DEFINITION | | DRAWING NO. LCO P-330 |
| TITLE TESTPOINT #7 - DOOR OPEN COMMAND (RECEIVE) | | |
| DRAWN BY P. STUTZ | DATE 11-1-77 | APPROVED |

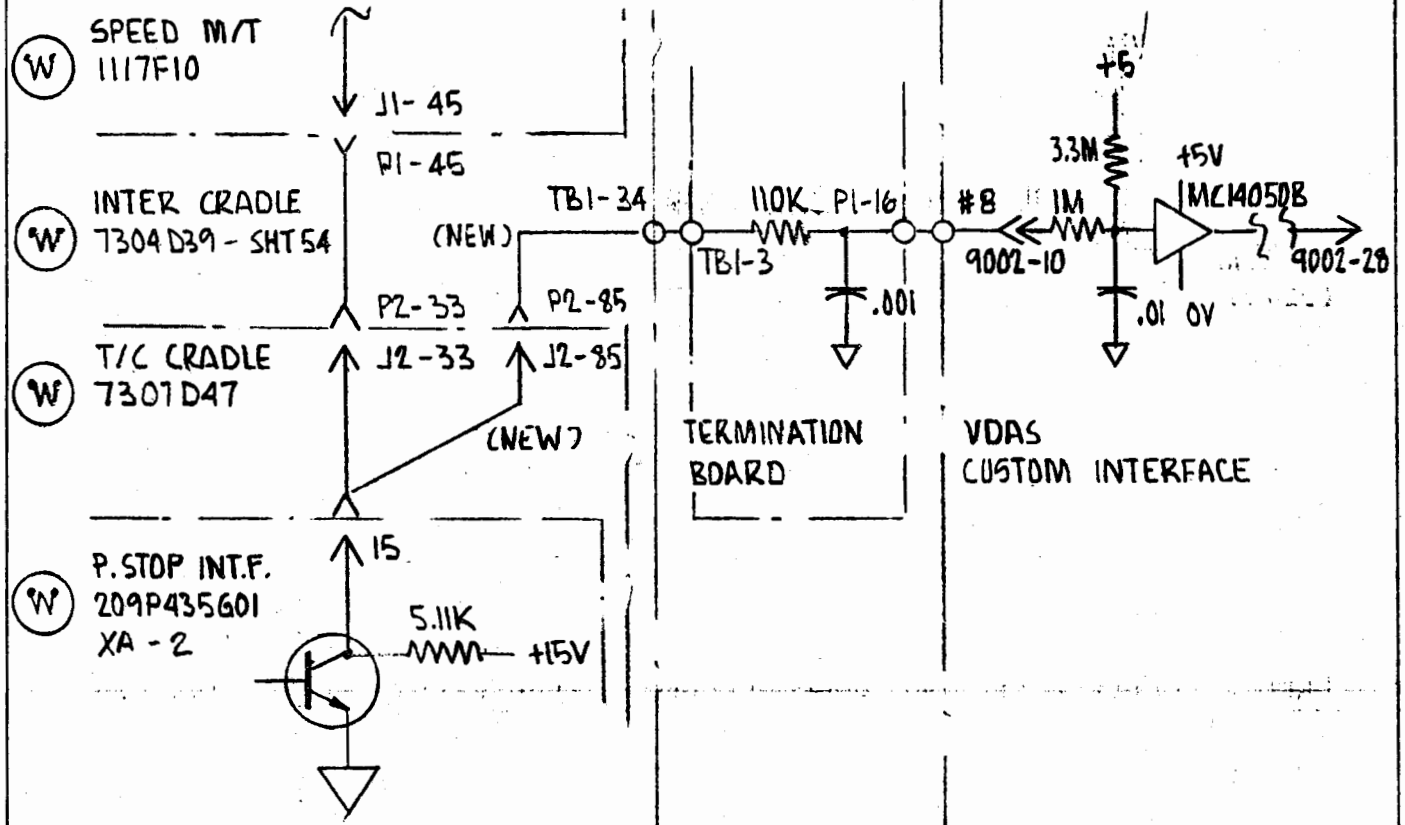


TERMINATION BOARD

VDAS CUSTOM INTERFACE

REV C 7/20/78
 REV B 4/3/78
 REV A 12/9/77

| | | |
|------------------------------------------------------------------------------|---------------------|------------------|
| PORT OF SEATTLE COMMISSION PROJECT <u>STS - VDAS TESTPOINT DEFINITION</u> | | DESIGN NO. |
| TITLE <u>TESTPOINT #4 - FLIN-REL</u> | | DRAWING NO. |
| DRAWN BY <u>P. STUTZ</u> | DATE <u>11-1-77</u> | <u>LCO P-330</u> |

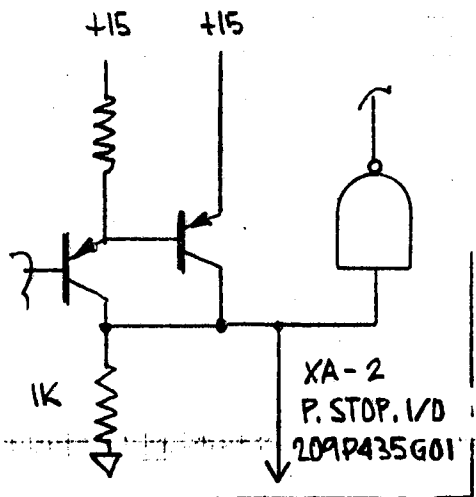

$$HI - F \cdot REF = \frac{LBC}{LBC}$$

$$LO - F \cdot REF = \frac{LBC}{LBC}$$

TRACTION CONT.
7307D47

J2-86
LBC (NEW)

P.I.C 8J/L
209P437G01


U

B

TB3-2

110K
PI-15

TERMINATION BOARD

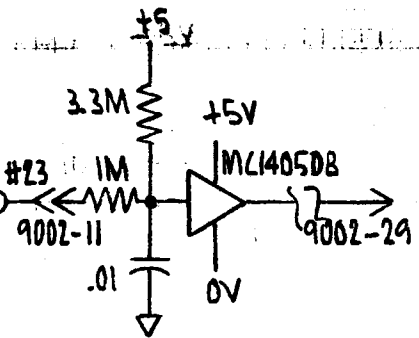


VDA5
CUSTOM INTERFACE

REVC 7/20/78
REVB 4/3/78

| | | |
|----------------------------|-------------------------------|-------------|
| PORT OF SEATTLE COMMISSION | | DESIGN NO. |
| PROJECT | STS-VDA5 TESTPOINT DEFINITION | |
| TITLE | TESTPOINT # 9 - LBC | |
| DRAWN BY | P. STUTZ | DRAWING NO. |
| DATE | 11-1-77 | LCO P-330 |
| APPROVED | | |

ZERO SPEED LINE

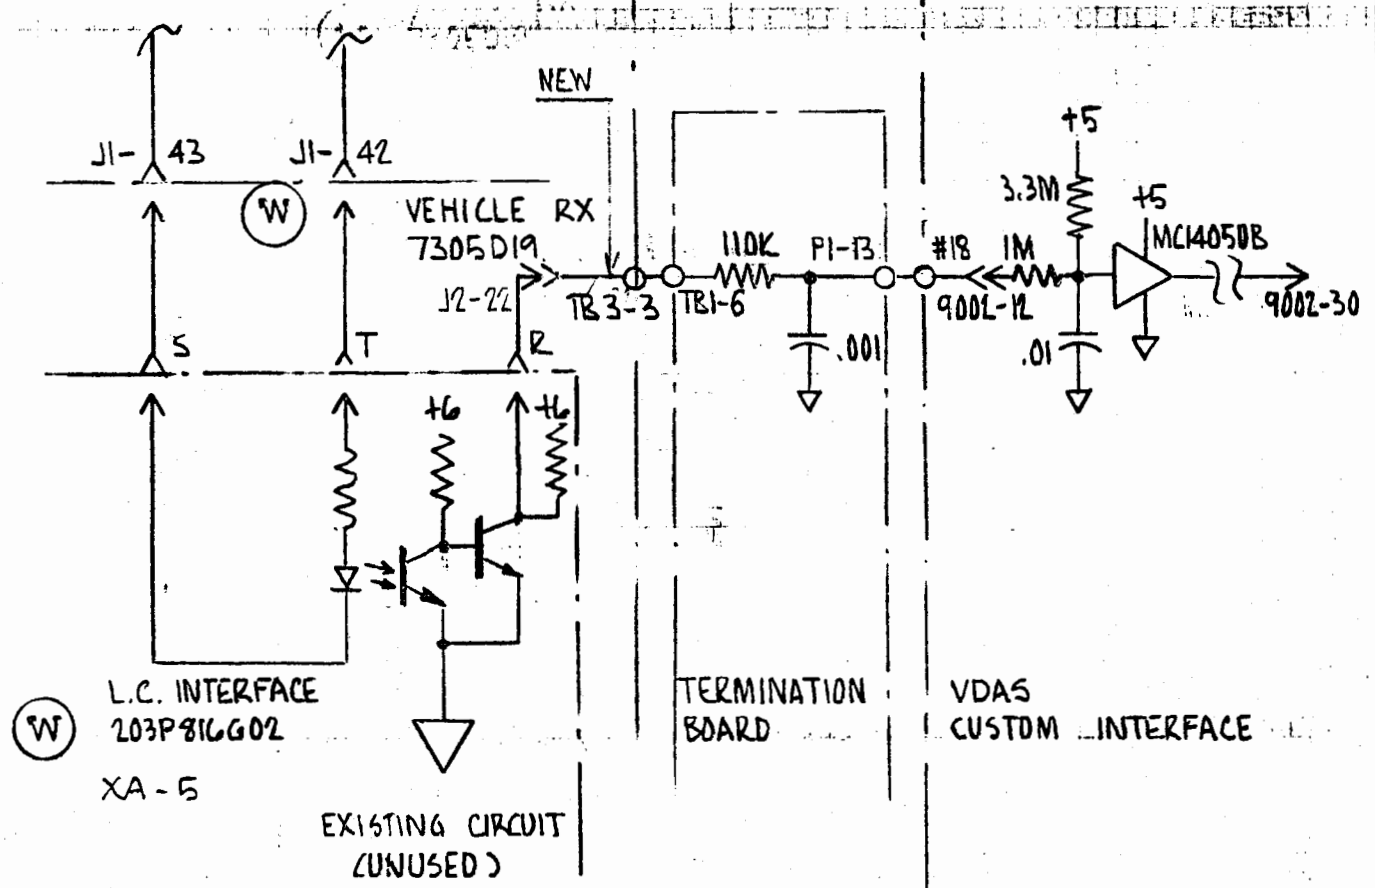


(W) L.C. INTERFACE
203P816G02
XA-5

TERMINATION BOARD

VDAS CUSTOM INTERFACE

REV C 7/20/78
REV B 4/3/78
REV A 12/9/77

| | | |
|----------------------------|-------------------------------|-------------|
| PORT OF SEATTLE COMMISSION | | DESIGN NO. |
| PROJECT | STS VDAS TESTPOINT DEFINITION | |
| TITLE | TESTPOINT #10 - ZERO SPEED | DRAWING NO. |
| DRAWN BY | P. STUTZ | LCO P-330 |
| DATE | 11-1-77 | |
| APPROVED | | |

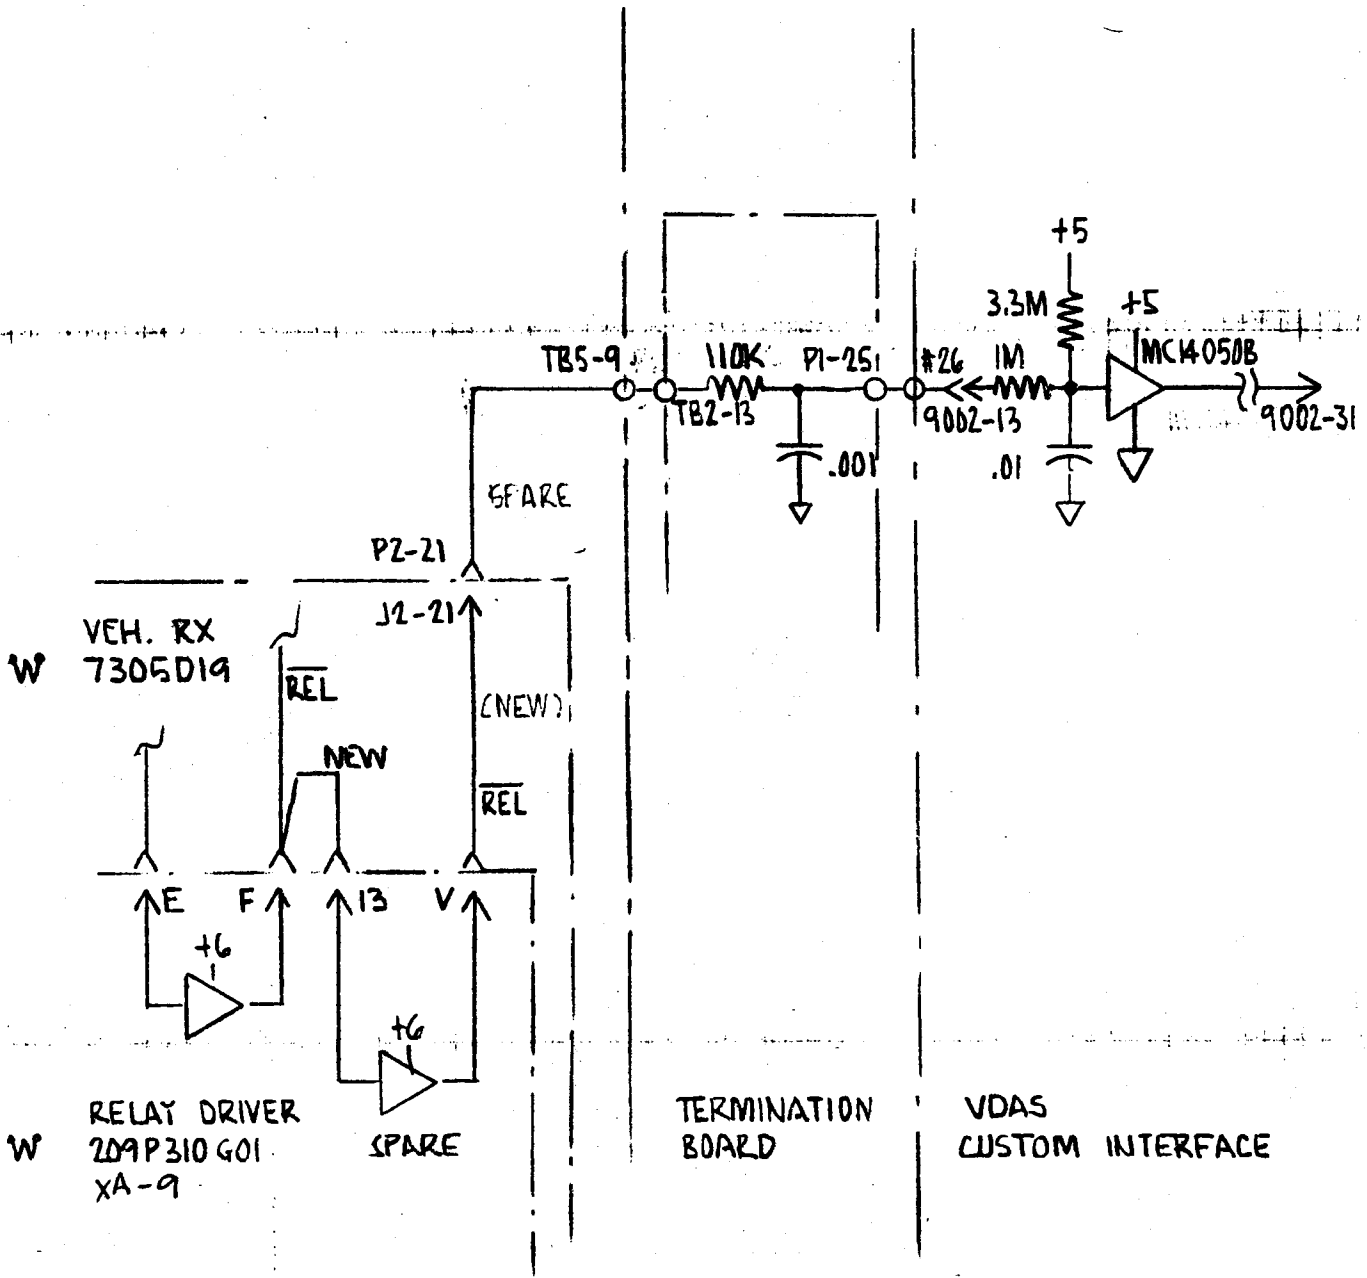

REV C 7/20/78
 REV B 4/3/78
 REV A 12/9/77

PORT OF SEATTLE COMMISSION
 PROJECT STS - VDAS TESTPOINT DEFINITION
 TITLE TESTPOINT # 11 - REL
 DRAWN BY P. STUTZ DATE 11-1-77 APPROVED _____

DESIGN NO. _____
 DRAWING NO. LCO P-330


USE TB3-3 DOOR LEAF #1
TB3-4 DOOR LEAF #2
TB3-5 DOOR LEAF #3
TB3-6 DOOR LEAF #4

REV C 7/20/74
REV B 4/3/76

WILL NOT BE USED
IN VDAS PER
MIKE KISMAN

REV A 12/9/77





| | | |
|----------------------------|------------------------------------------------------|-------------|
| PORT OF SEATTLE COMMISSION | | DESIGN NO. |
| PROJECT | STS - VDAS TESTPOINT DEFINITION | |
| TITLE | TESTPOINTS 12/13/14/15 - DOOR LEAF OPEN LIMIT SWITCH | DRAWING NO. |
| DRAWN BY | P. STUTZ | LCD P-330 |
| DATE | 11/8/77 | |
| APPROVED | | |

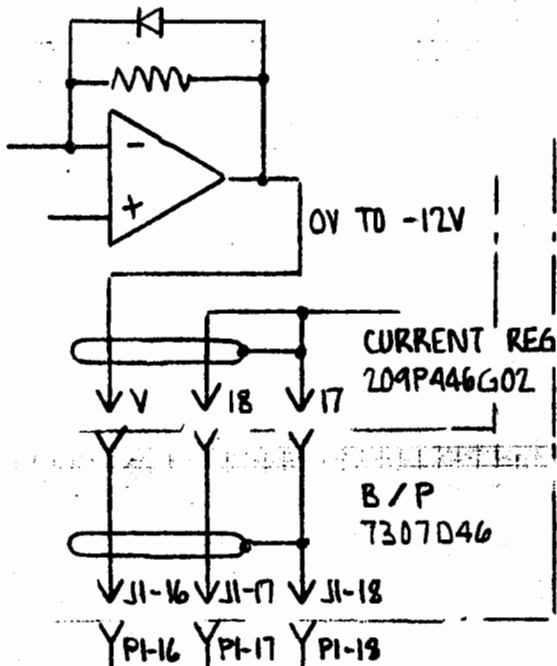


INTER CRADLE
7304D39-SHT29

TERMINATION BOARD

VDAS CUSTOM INTERFACE

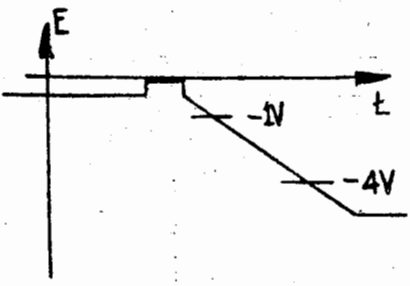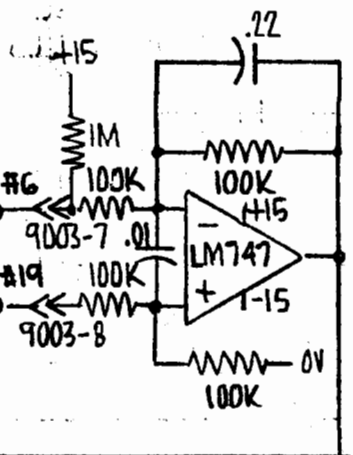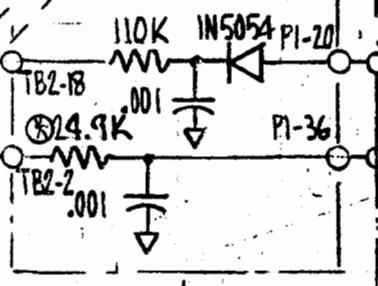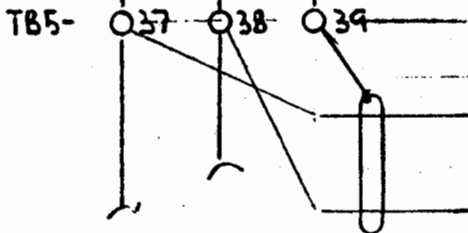


⊕ 4 CIRCUITS
USING THIS
GROUND RETURN

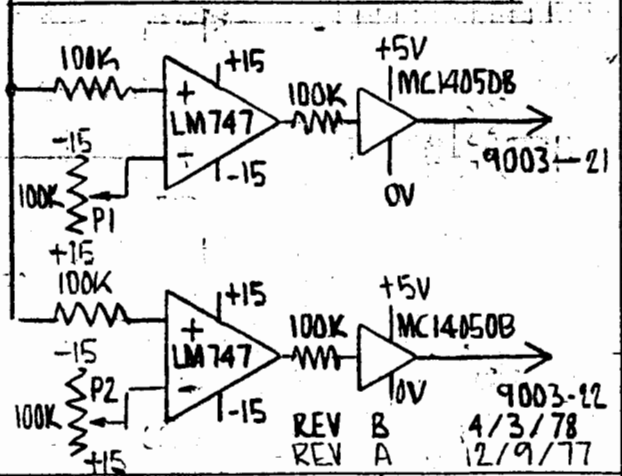


PORT OF SEATTLE COMMISSION
PROJECT STS - VDAS TESTPOINT DEFINITION
TITLE TESTPOINT #16 - CR (FIRING PULSE)
DRAWN BY P. STUTZ DATE 11-1-77 APPROVED

REV C 7/20/78
DESIGN NO.
DRAWING NO.
LCO P-330

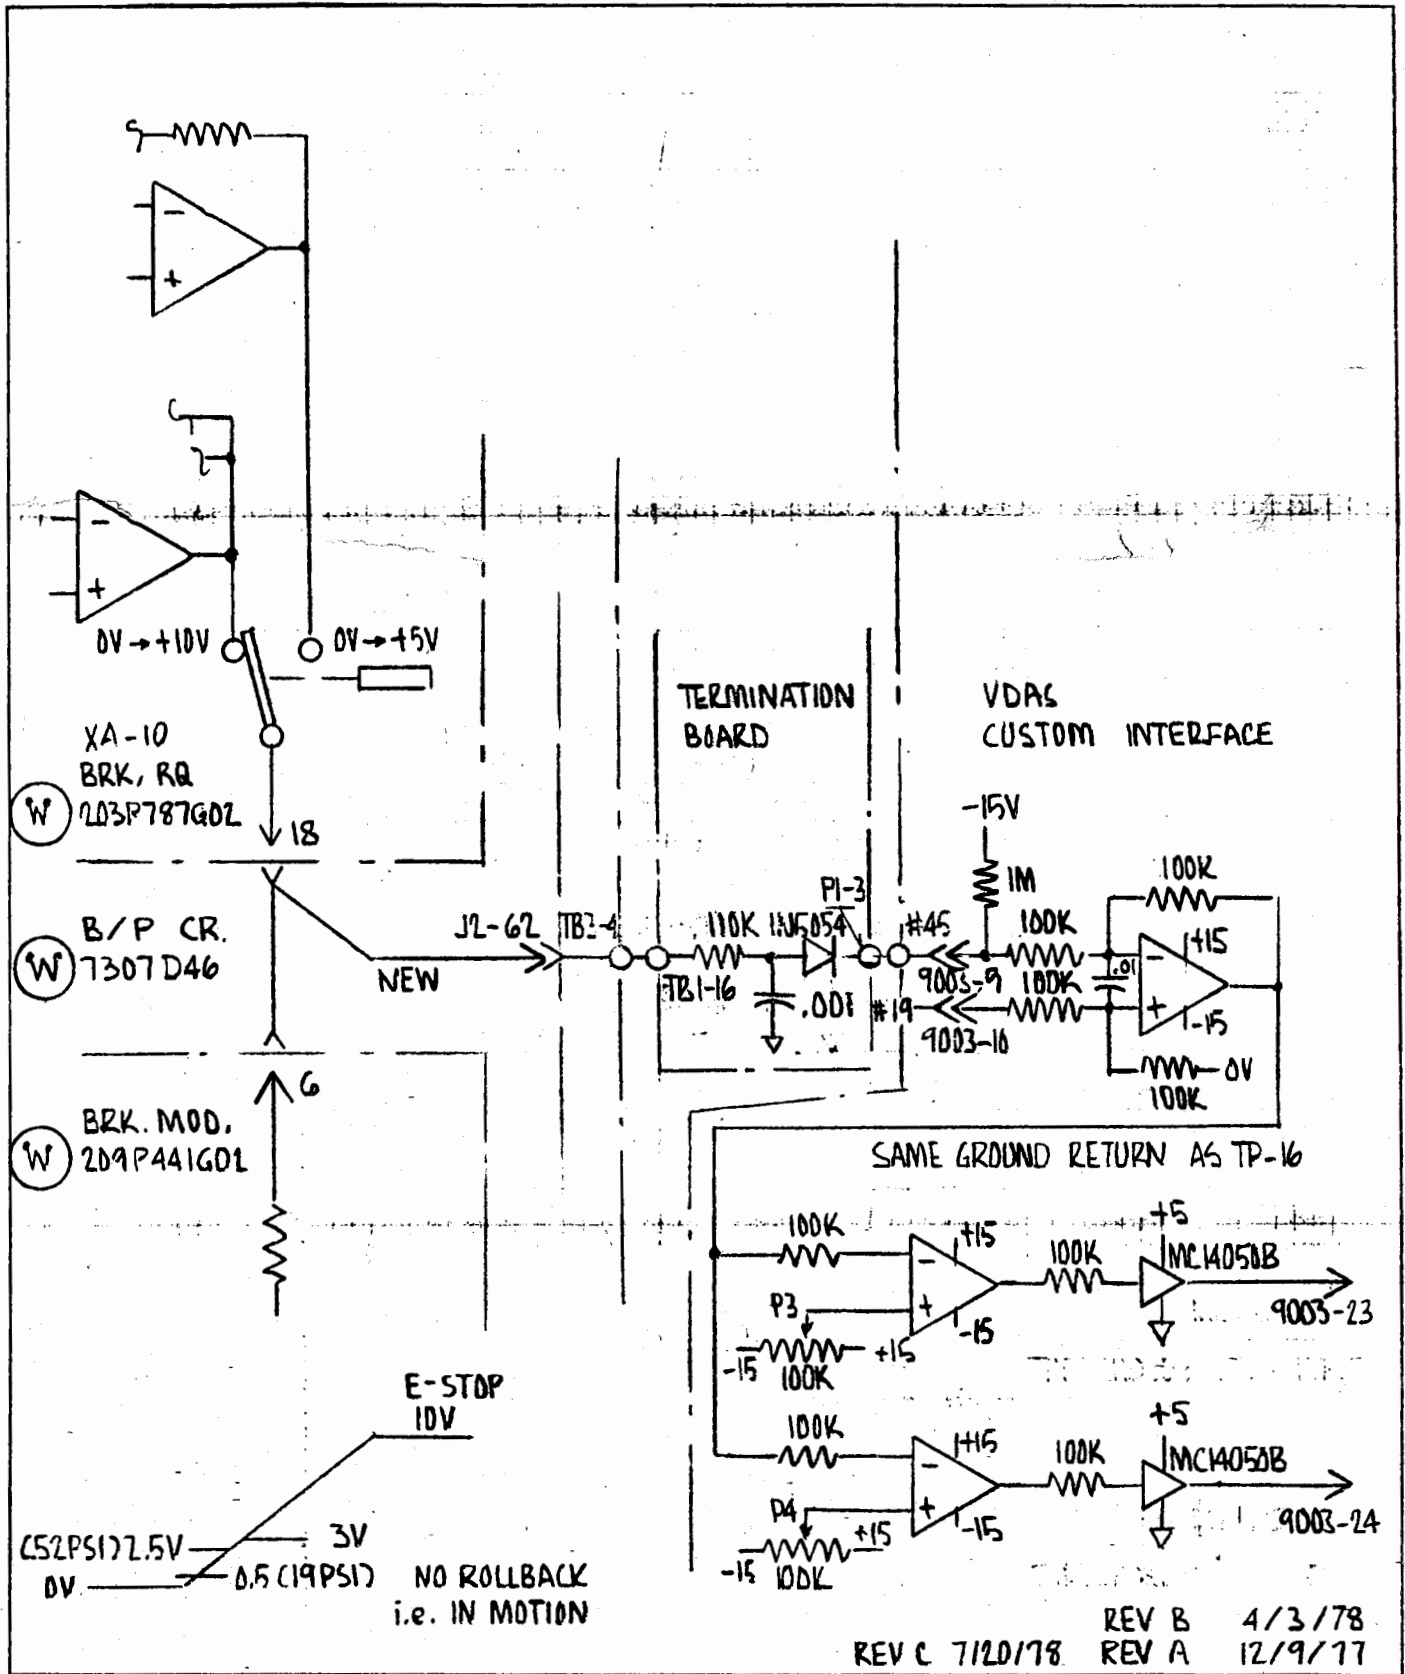


| | | |
|-----------------------------------|---------------------------------|-------------|
| PORT OF SEATTLE COMMISSION | | DESIGN NO. |
| PROJECT | STS - VDA6 TESTPOINT DEFINITION | |
| TITLE | TESTPOINT #17 - BV | DRAWING NO. |
| DRAWN BY | P. STUTZ | LCO P-330 |
| DATE | 11-1-77 | |
| APPROVED | | |


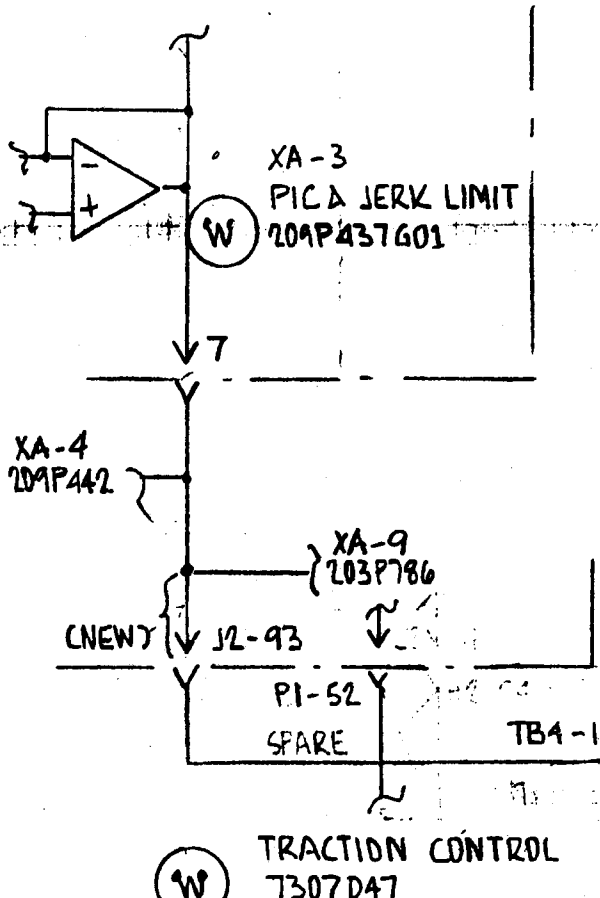


TERMINATION BOARD


VDA'S CUSTOM INTERFACE

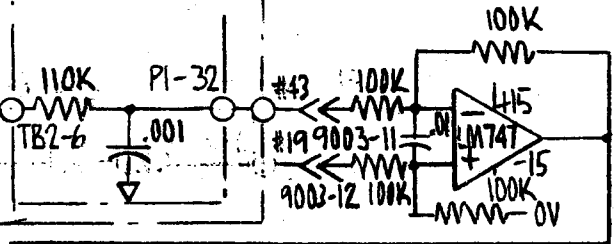


TRACTION CONTROL
T307D47

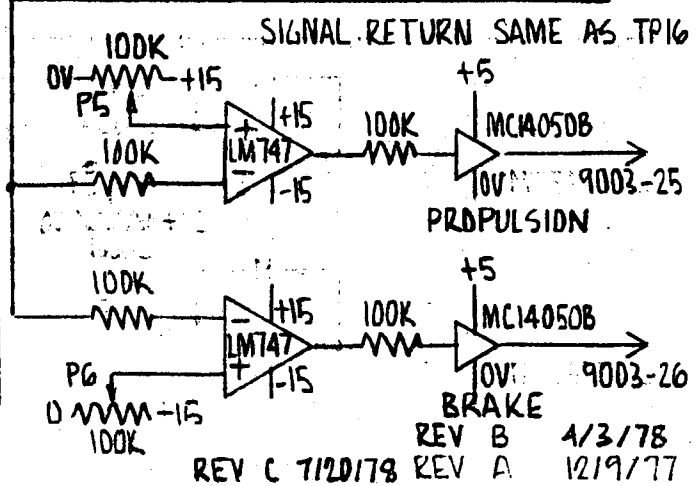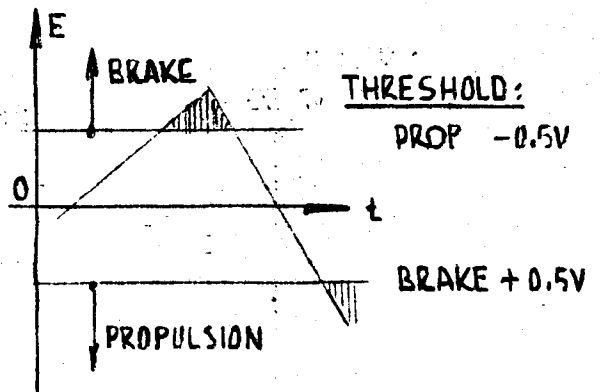

| | | |
|----------------------------|---------------------------------|-------------|
| PORT OF SEATTLE COMMISSION | | DESIGN NO. |
| PROJECT | STS - VDAS TESTPOINT DEFINITION | |
| TITLE | TESTPOINT #18 - X-P SIGNAL | DRAWING NO. |
| DRAWN BY | P. STUTZ | LCO P-330 |
| DATE | 11-1-77 | |
| APPROVED | | |

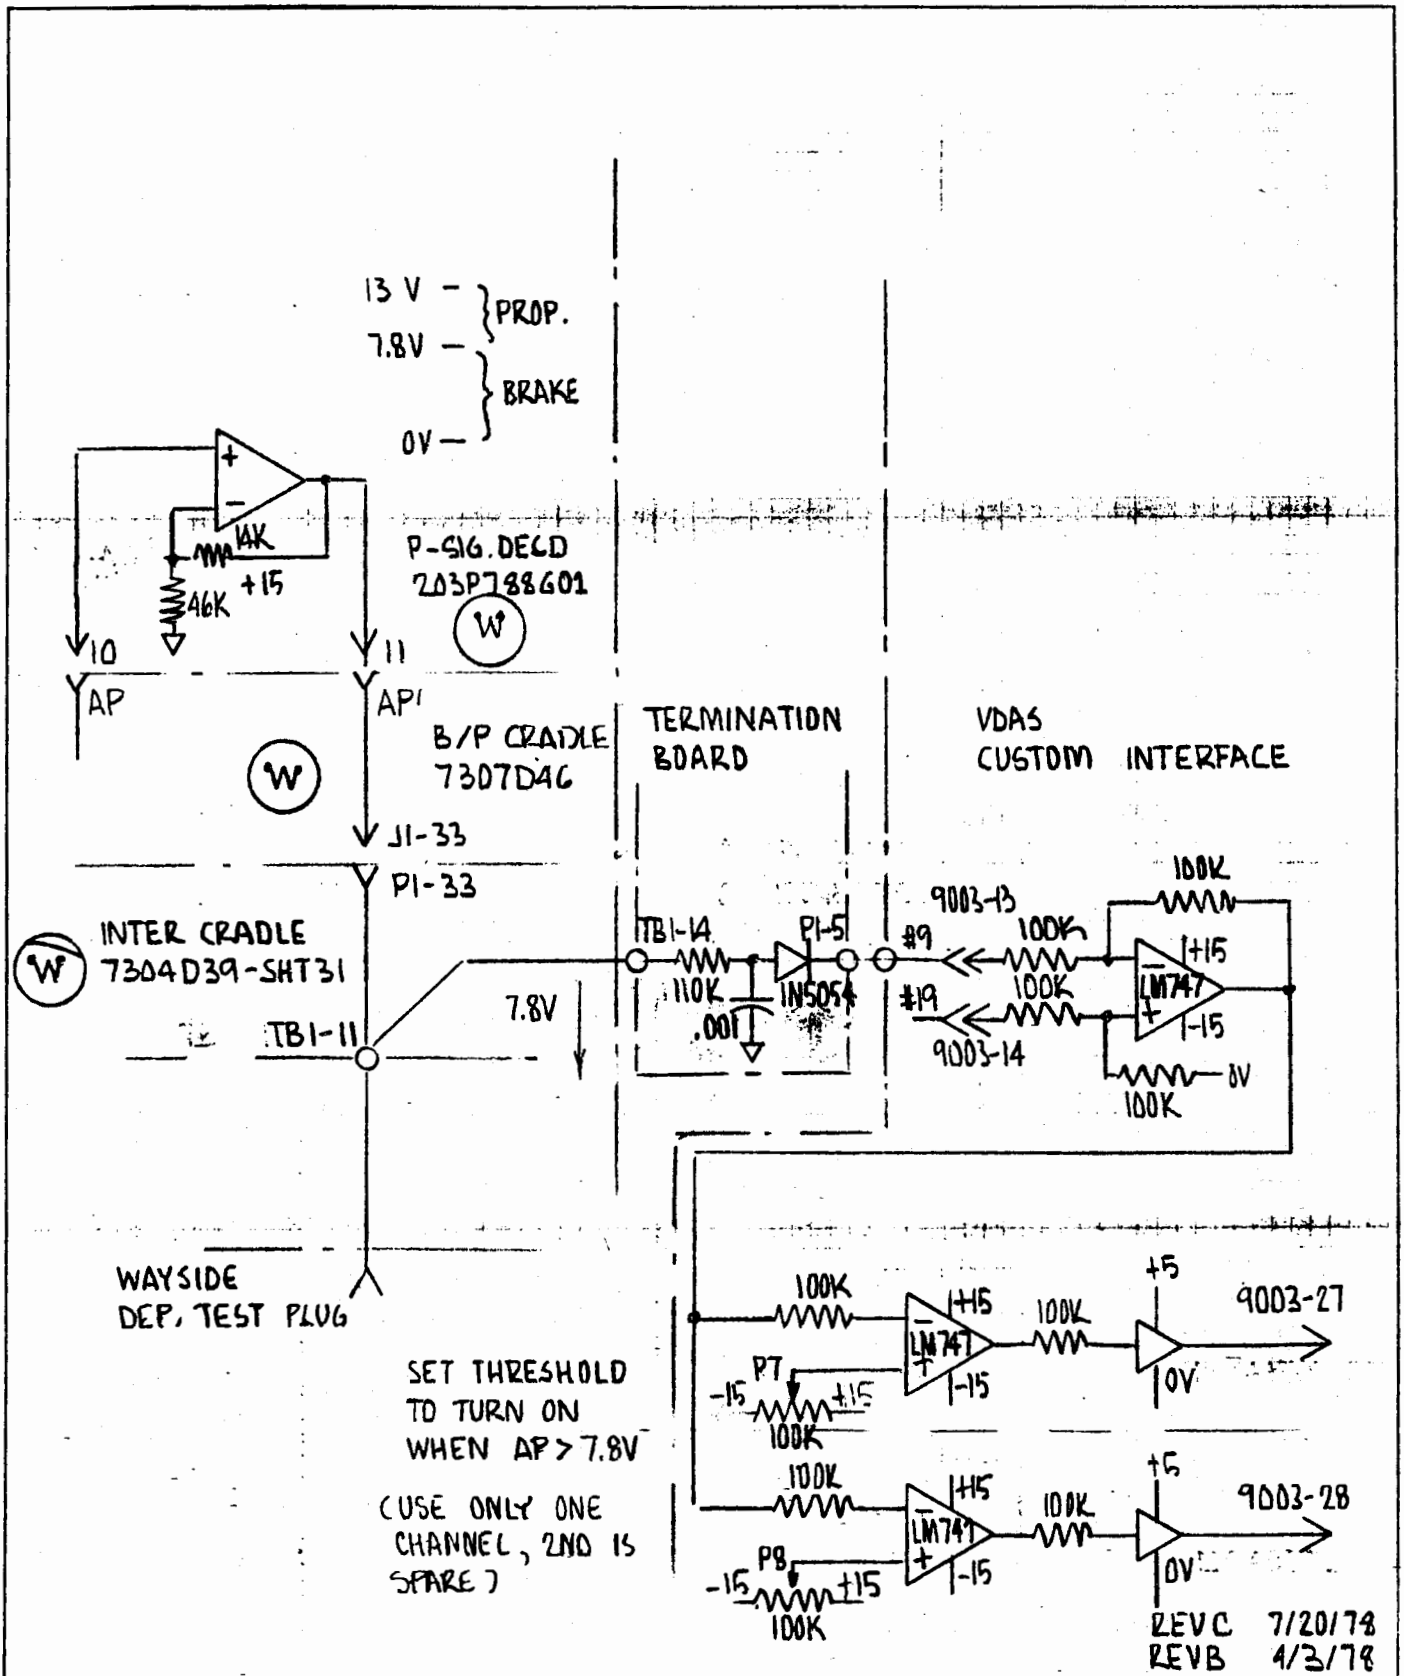

| | | |
|---|--|----------------------------------------------------|
| PORT OF SEATTLE COMMISSION PROJECT <u>STS - VDas TESTPOINT DEFINITION</u> TITLE <u>TESTPOINT #19 - AP SIGNAL</u> DRAWN BY <u>P. STUTZ</u> DATE <u>11-2-77</u> APPROVED _____ | | DESIGN NO. DRAWING NO. <u>LC0 - P330</u> |
|---|--|----------------------------------------------------|

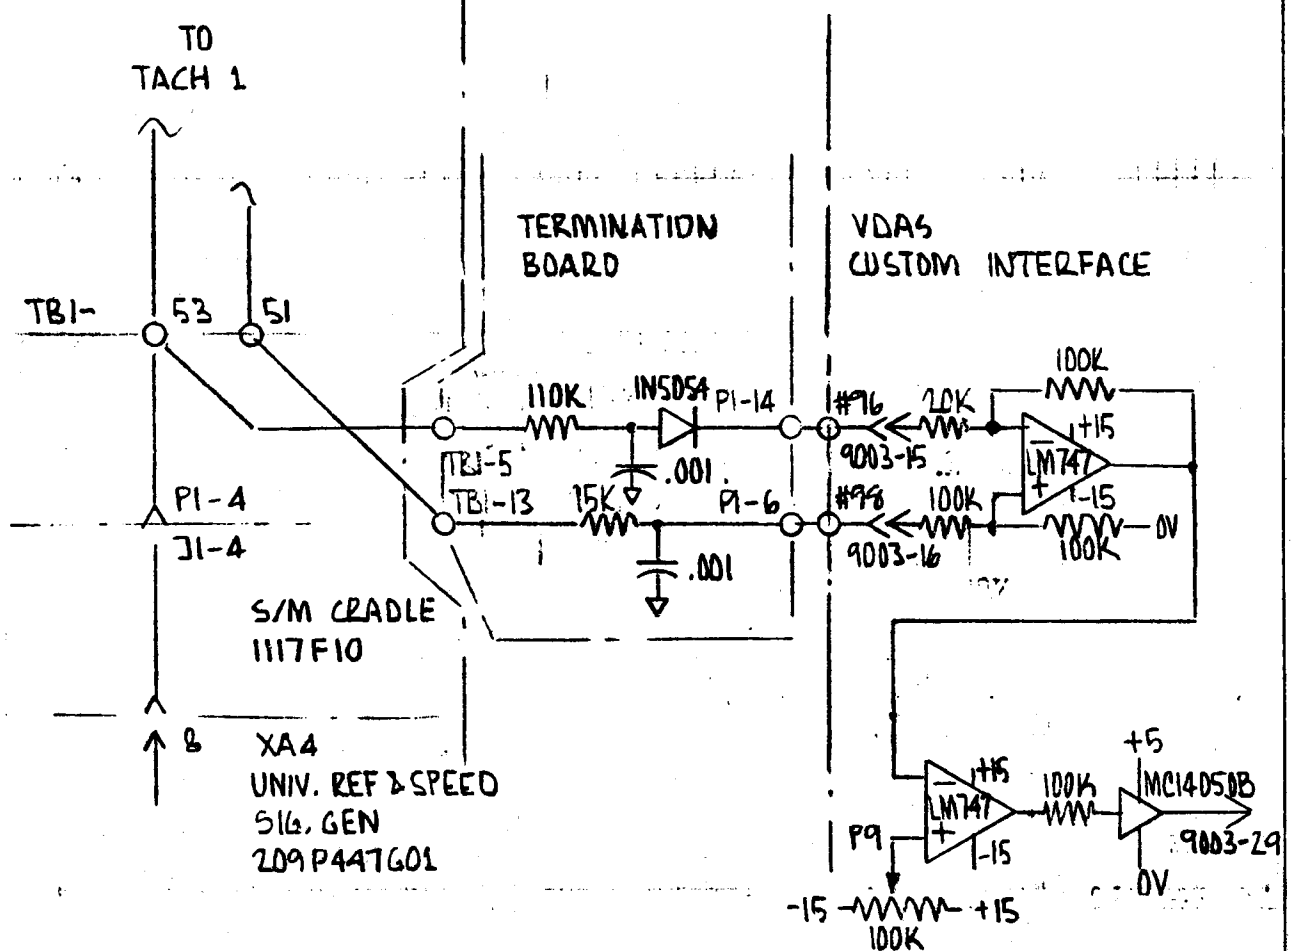


INFO ONLY
 ATO TACH DETECTOR
 THRESHOLD 2.1V

102 HZ / MPH
 THRESHOLD SET
 AT 2.5V PEAK
 AT TBI-53

GATE COUNTER AND
 ENTER COUNT AS
 8-BIT NUMBER INTO
 COMPUTER
 ONE-SHOT CIRCUIT FOR
 SIGNAL CONDITIONING


REV C 7/20/78
 REV B 4/3/78
 REV A 12/9/77

| | | |
|-----------------------------------------|--|-------------|
| PORT OF SEATTLE COMMISSION | | DESIGN NO. |
| PROJECT STS - VDA6 TESTPOINT DEFINITION | | |
| TITLE TESTPOINT #20 - TACH #1 | | DRAWING NO. |
| DRAWN BY P. STUTZ DATE 11-2-73 APPROVED | | LCD P-330 |

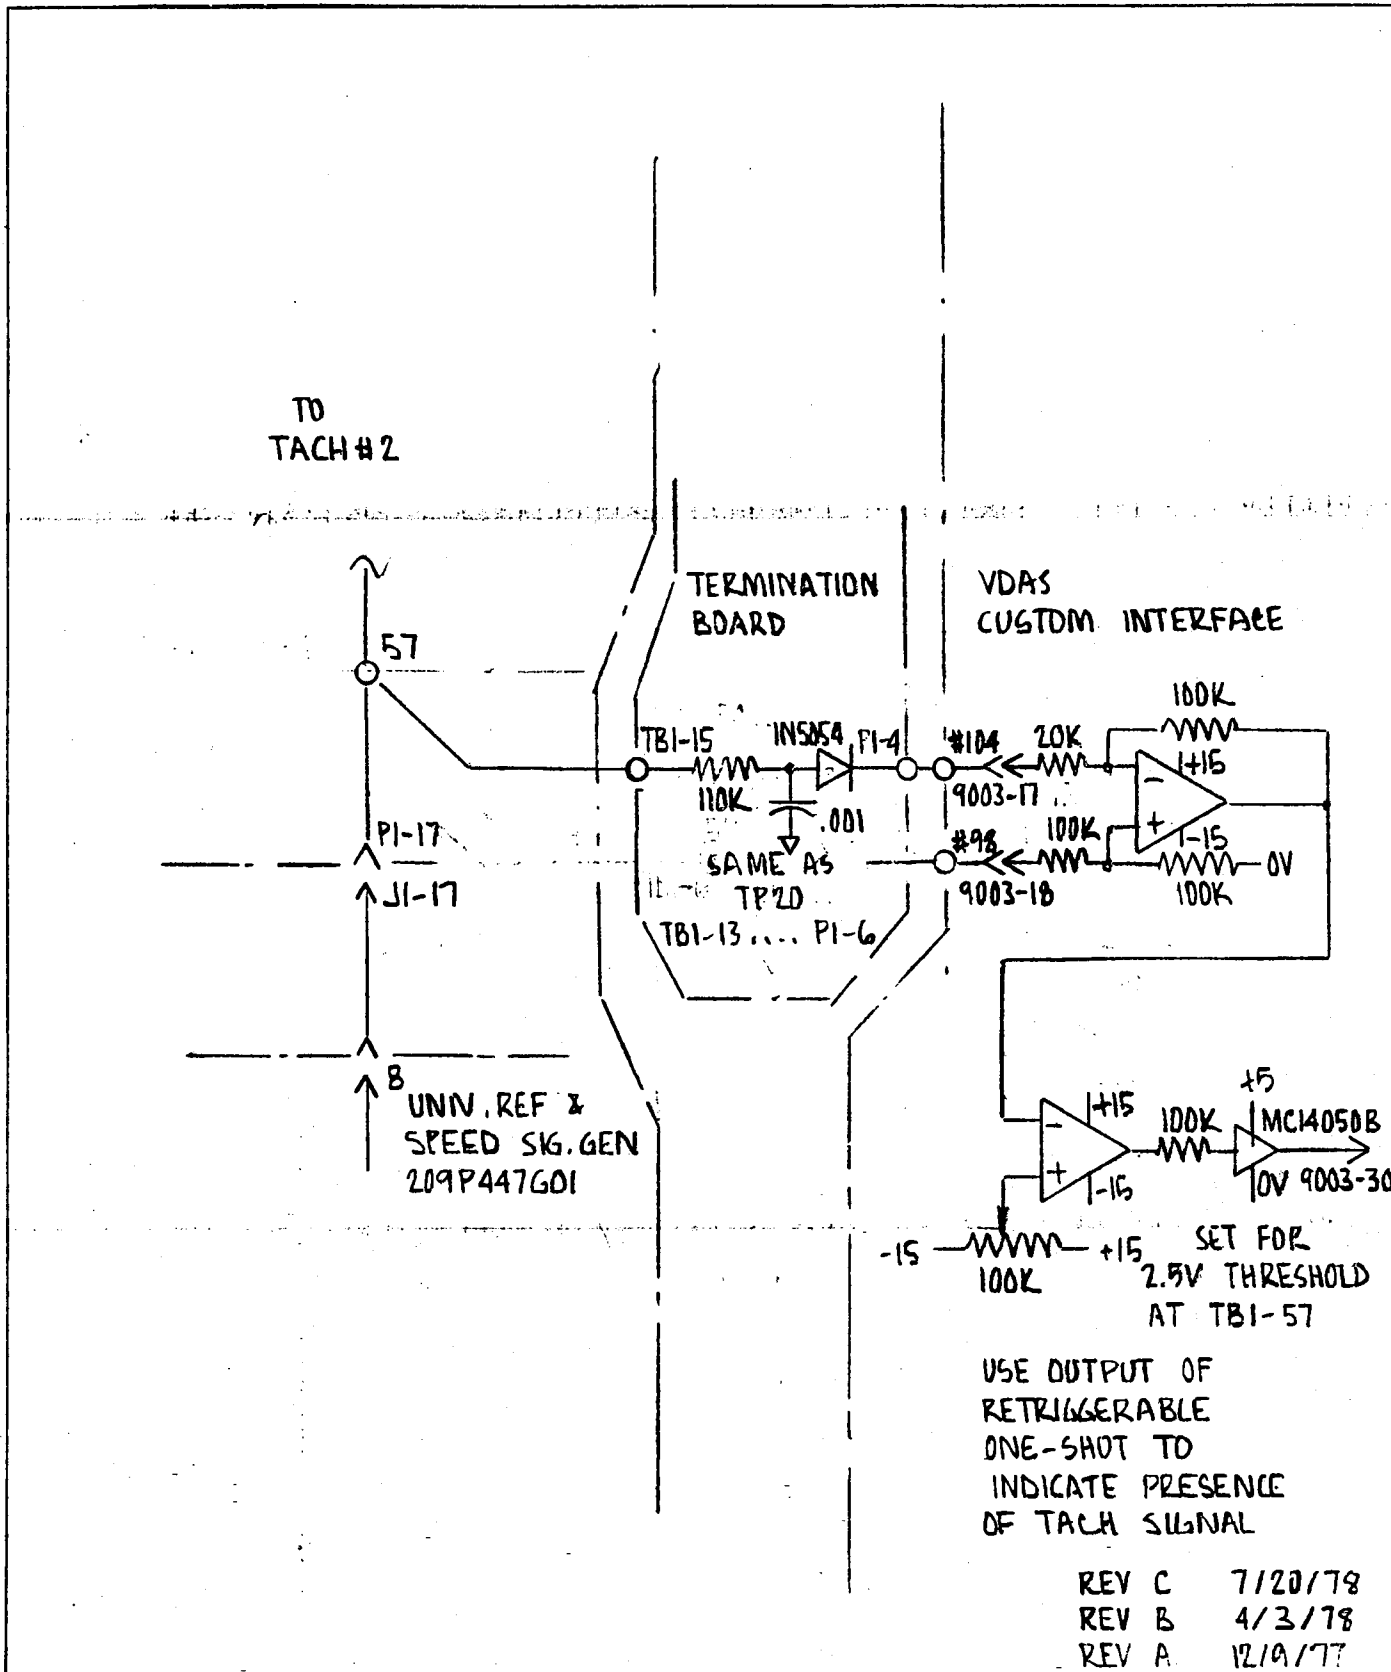

REV C 7/20/78
 REV B 4/3/78
 REV A 12/9/77

| | | |
|---|--|--------------------------------------------------|
| PROJECT <u>STS - VDAS TESTPOINT DEFINITION</u> TITLE <u>TESTPOINT #21 - TACH #2</u> DRAWN BY <u>P. STUTZ</u> DATE <u>11-2-77</u> APPROVED _____ | | DESIGN NO. _____ DRAWING NO. <u>LCO P-330</u> |
|---|--|--------------------------------------------------|

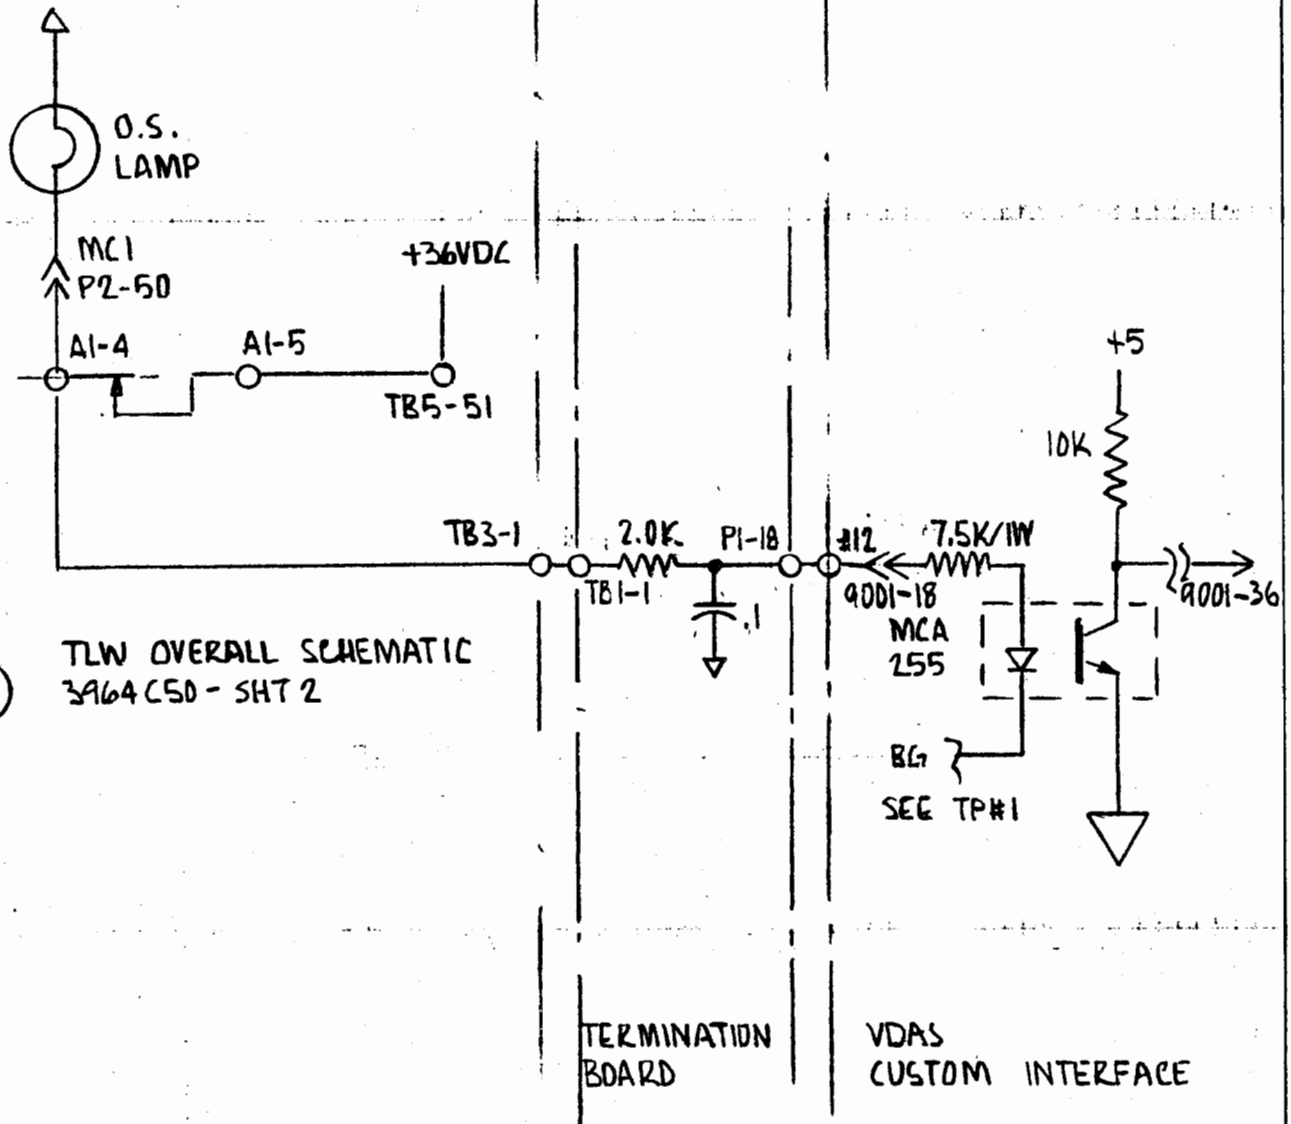



(W) TLW OVERALL SCHEMATIC
3964C50-SHT 2

TERMINATION BOARD

VDA6 CUSTOM INTERFACE


REV C 7/20/78
REV B 4/3/78

| | | |
|----------------------------|---------------------------------|-------------|
| PORT OF SEATTLE COMMISSION | | DESIGN NO. |
| PROJECT | STS - VDA6 TESTPOINT DEFINITION | |
| TITLE | TESTPOINT #22 - "A" RELAY | |
| DRAWN BY | P. STUTZ | DRAWING NO. |
| DATE | 11-2-77 | LCO P-330 |
| APPROVED | | |

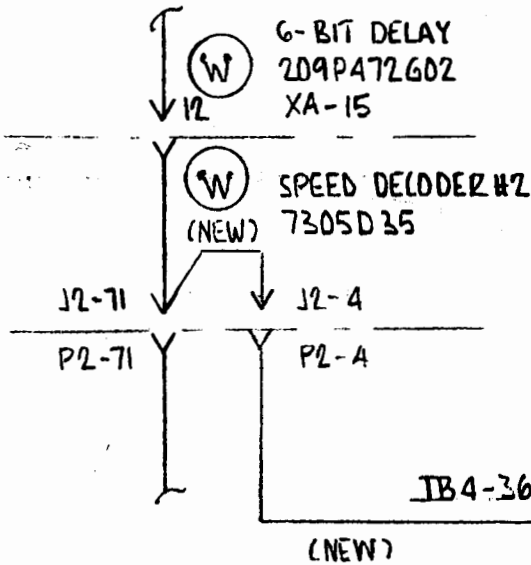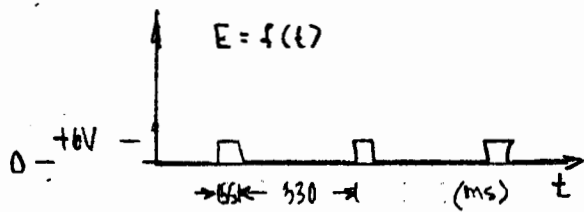

TERMINATION BOARD

VDAS CUSTOM INTERFACE

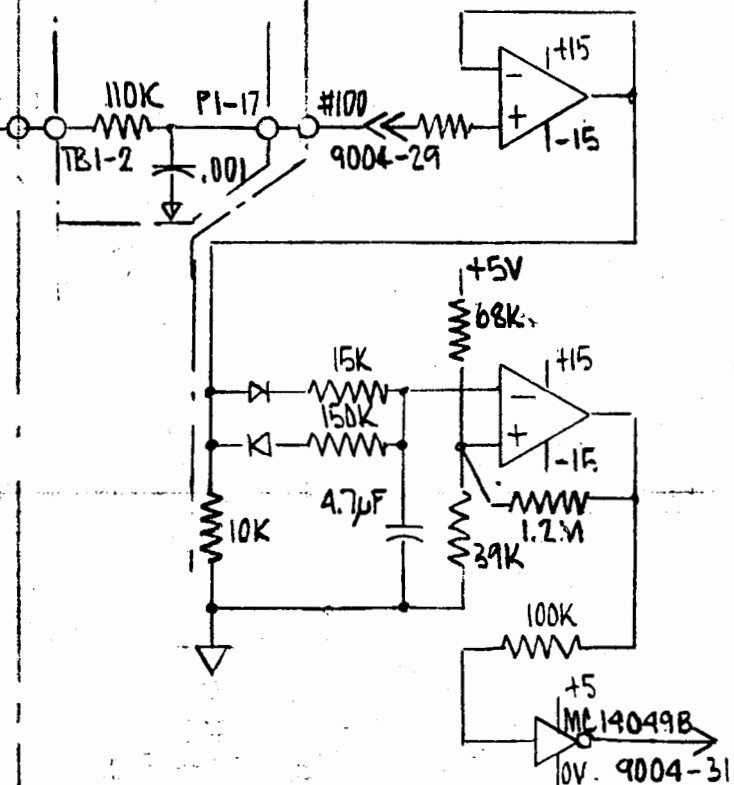

REV C 7/20/78
REV B 4/3/78

PORT OF SEATTLE COMMISSION

PROJECT STS - VDAS TESTPOINT DEFINITION


TITLE TESTPOINT #23 - UPDATE

DRAWN BY P. STUTZ DATE 11-7-77 APPROVED

DESIGN NO.


DRAWING NO.

LCO - P-330

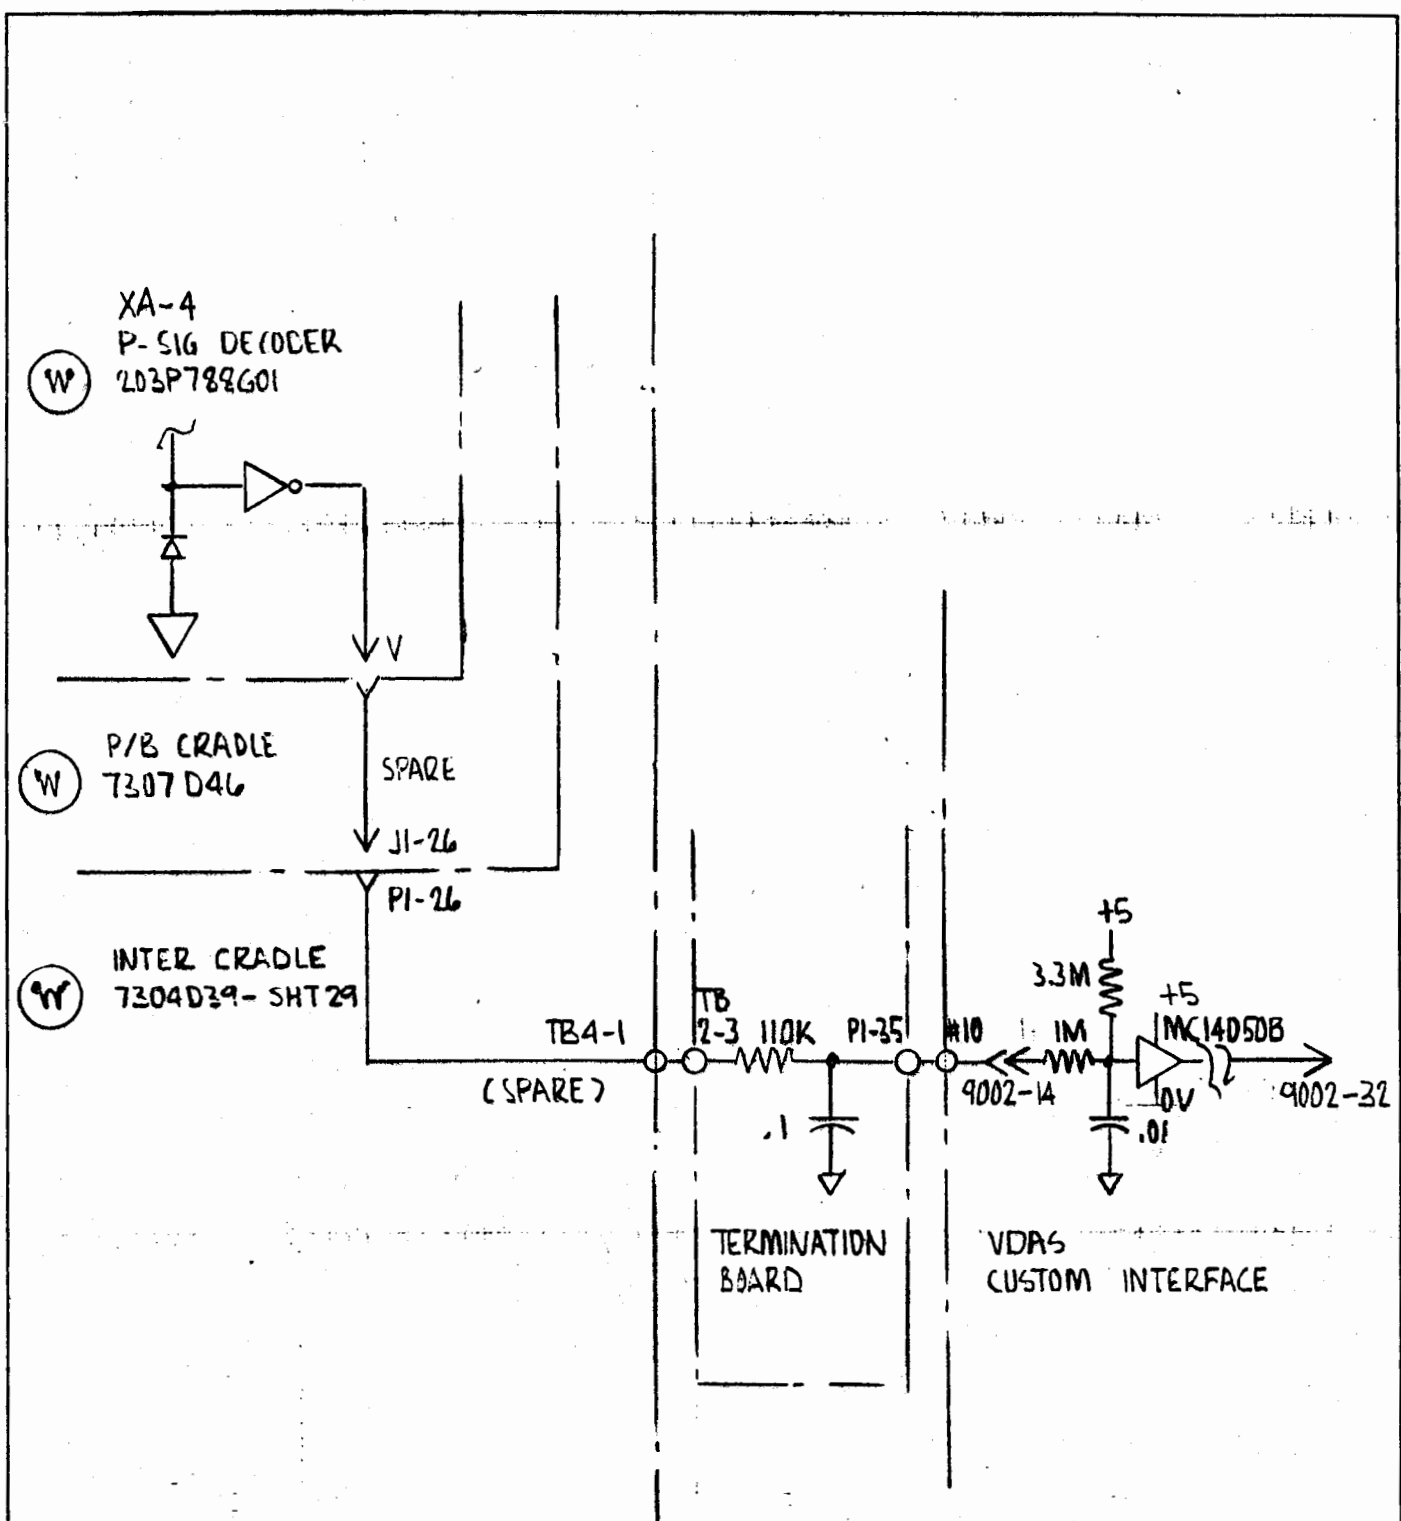

REV C 7/20/78
 REV B 4/3/78


| | | |
|-----------------------------------|----------------------------------------|--------------------------|
| PORT OF SEATTLE COMMISSION | | DESIGN NO. |
| PROJECT | STS - VDA5 TESTPOINT DEFINITION | DRAWING NO. LCO P-330 |
| TITLE | TESTPOINT #24 - B/P (BRAKE/PROPULSION) | |
| DRAWN BY | P. STUTZ | |
| DATE | 11-7-77 | |
| APPROVED | | |

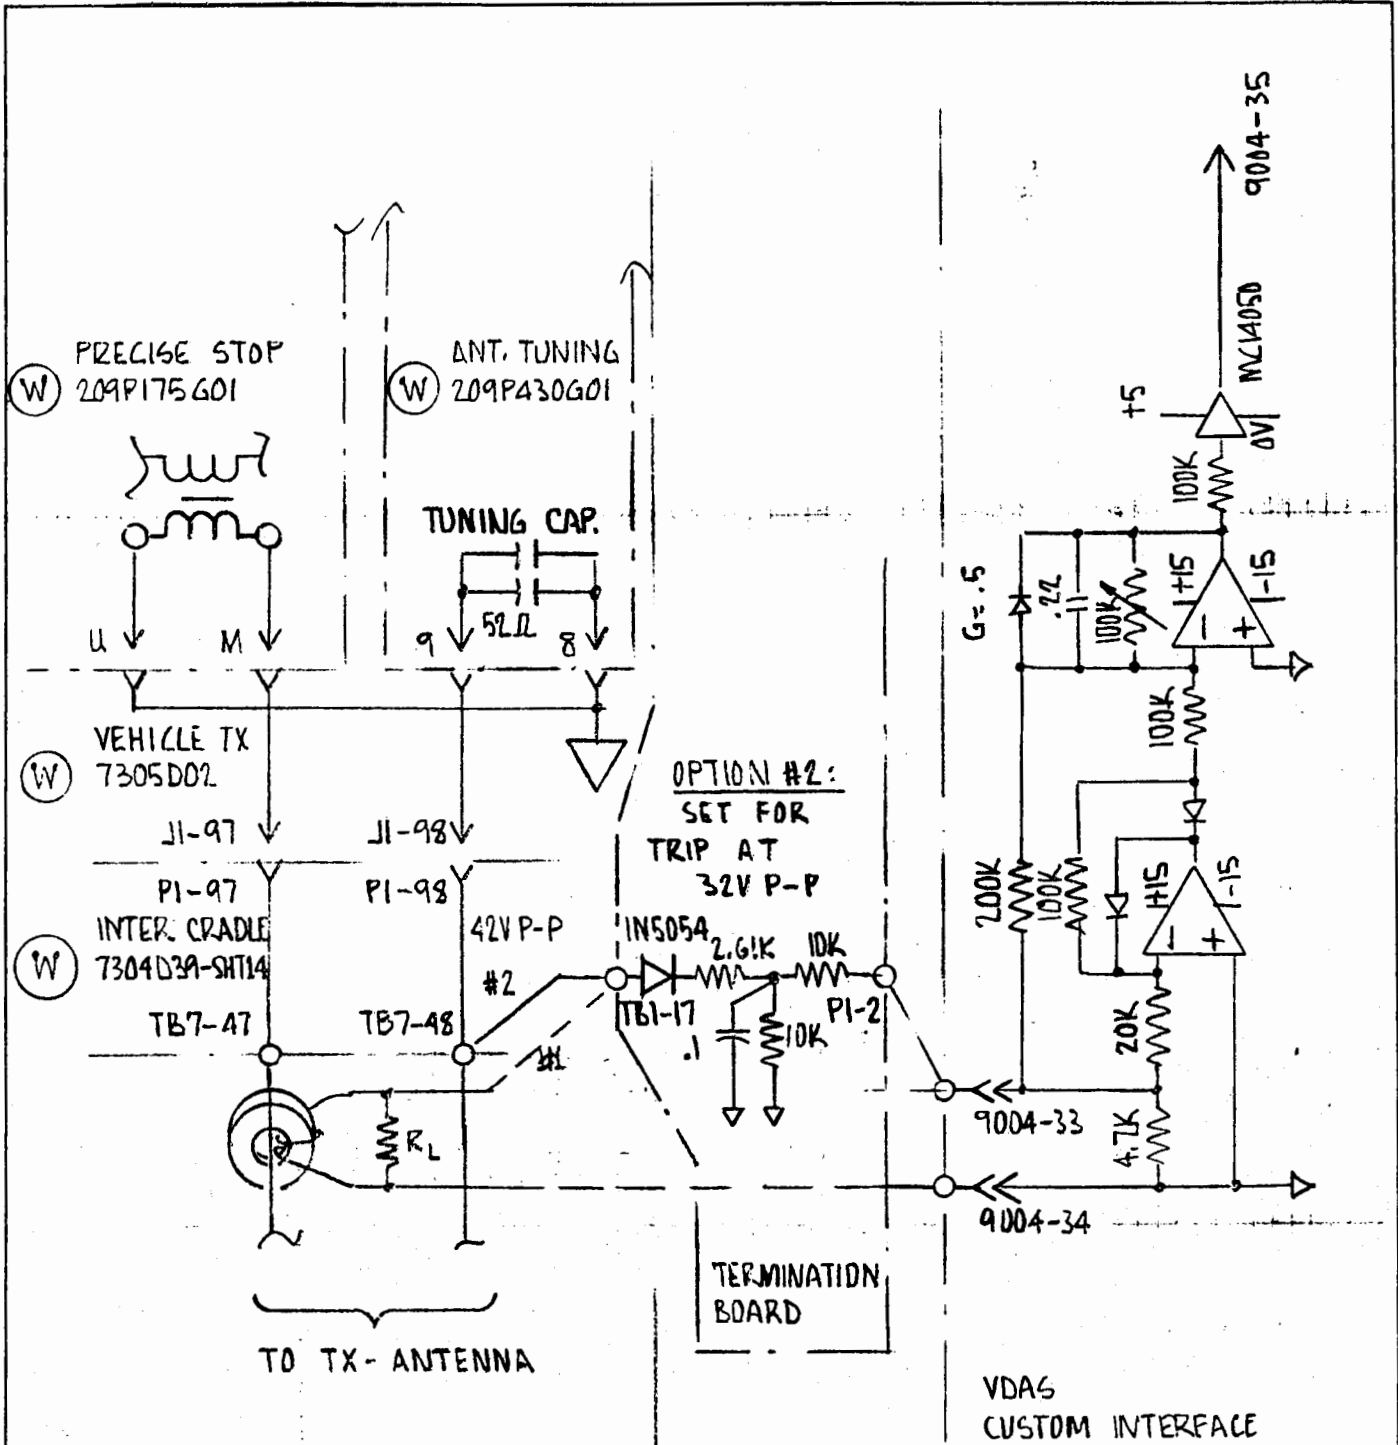

- OPTION :
1. CURRENT TRANSFORMER
 2. TUNING CAPACITOR - IN USE


REV C 7/20/78
REV B 4/3/78

| | | |
|-----------------------------------|-----------------------------------------|-------------|
| PORT OF SEATTLE COMMISSION | | DESIGN NO. |
| PROJECT | STS - VDAS TESTPOINT DEFINITION | |
| TITLE | TESTPOINT # 25 - VEHICLE TX, TX CURRENT | |
| DRAWN BY | P. STUTZ | DRAWING NO. |
| DATE | 11-7-77 | LCO P-330 |
| APPROVED | | |

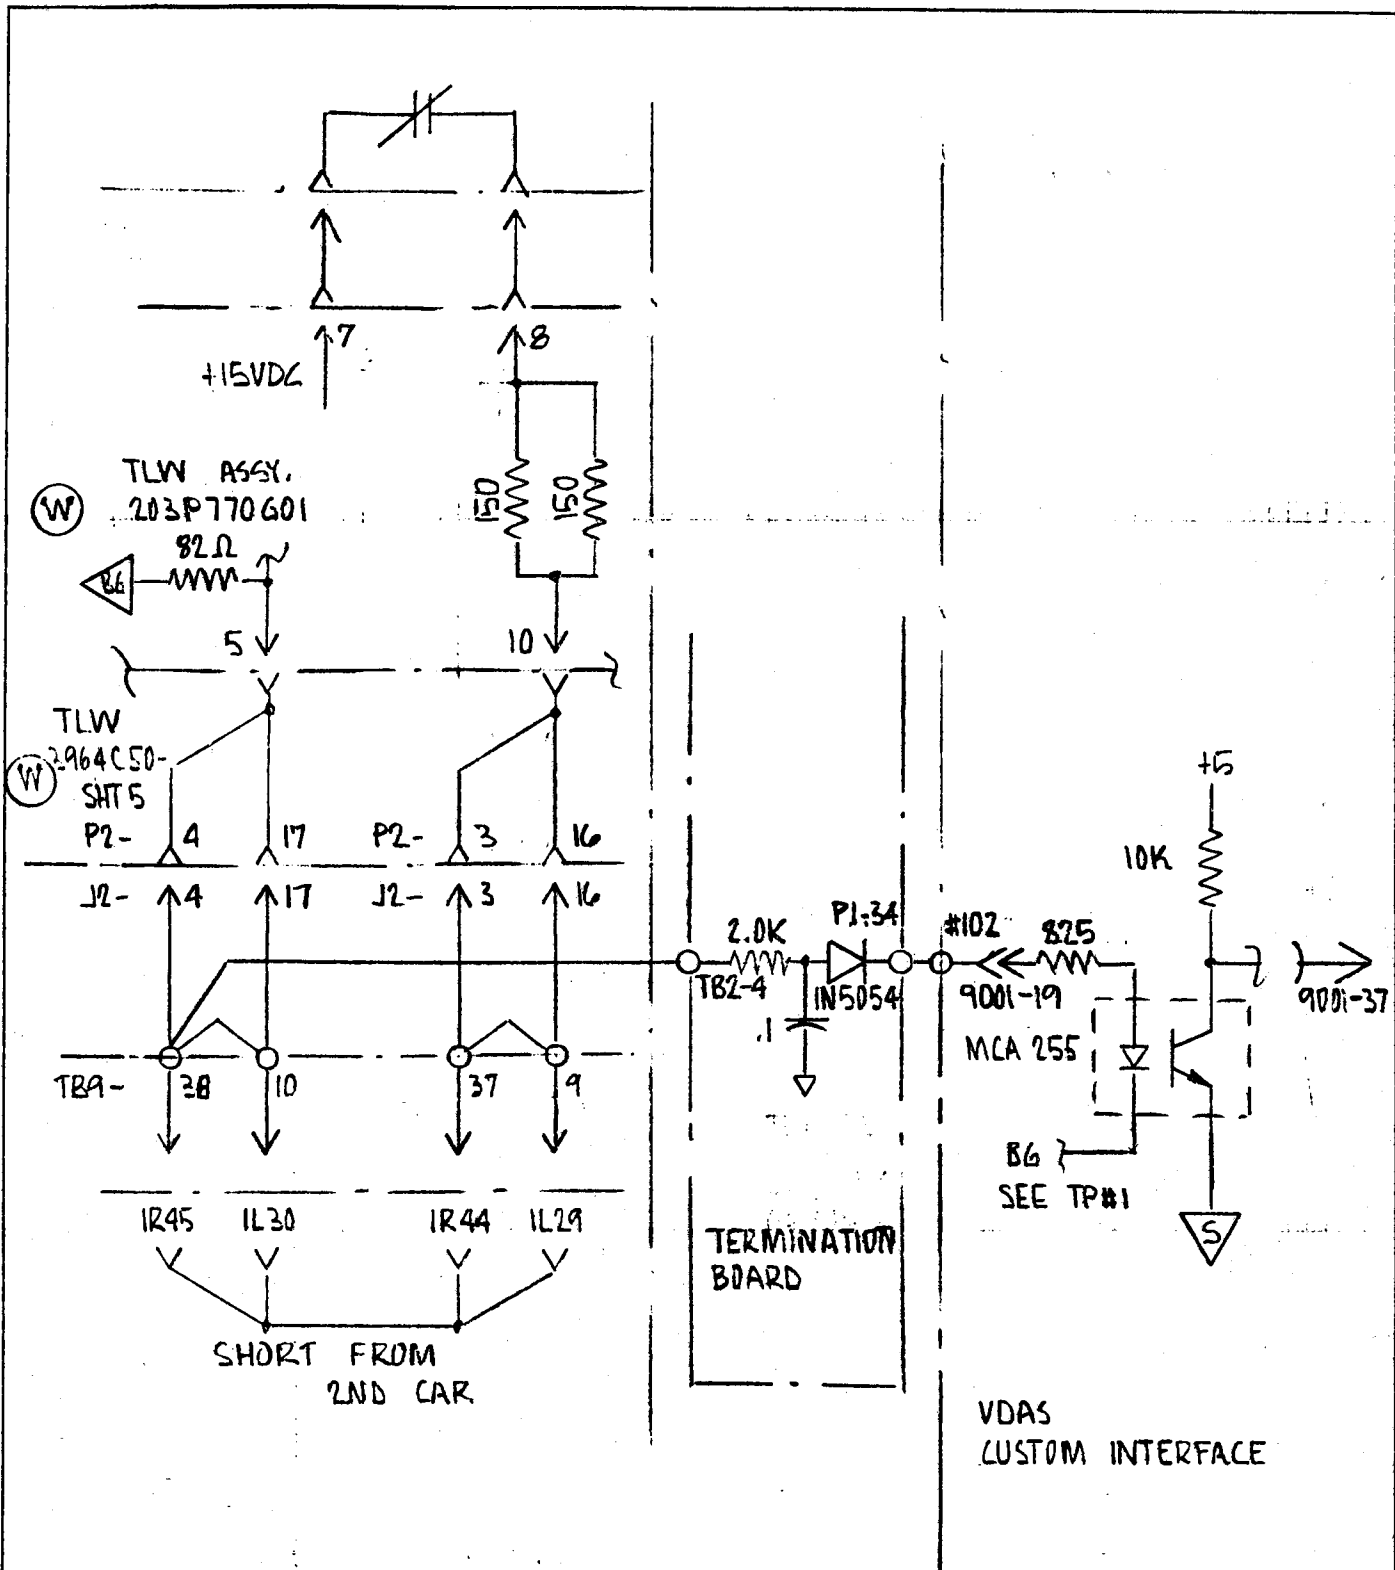


REV C 7/20/78
 REV B 4/3/78

| | | |
|-----------------------------------|---------------------------------|-------------|
| PORT OF SEATTLE COMMISSION | | DESIGN NO. |
| PROJECT | STS - VDAS TESTPOINT DEFINITION | |
| TITLE | TESTPOINT # 26 - CAR AHEAD | |
| DRAWN BY | P. STUTZ | DRAWING NO. |
| DATE | 11-7-77 | LCD P-330 |
| APPROVED | | |

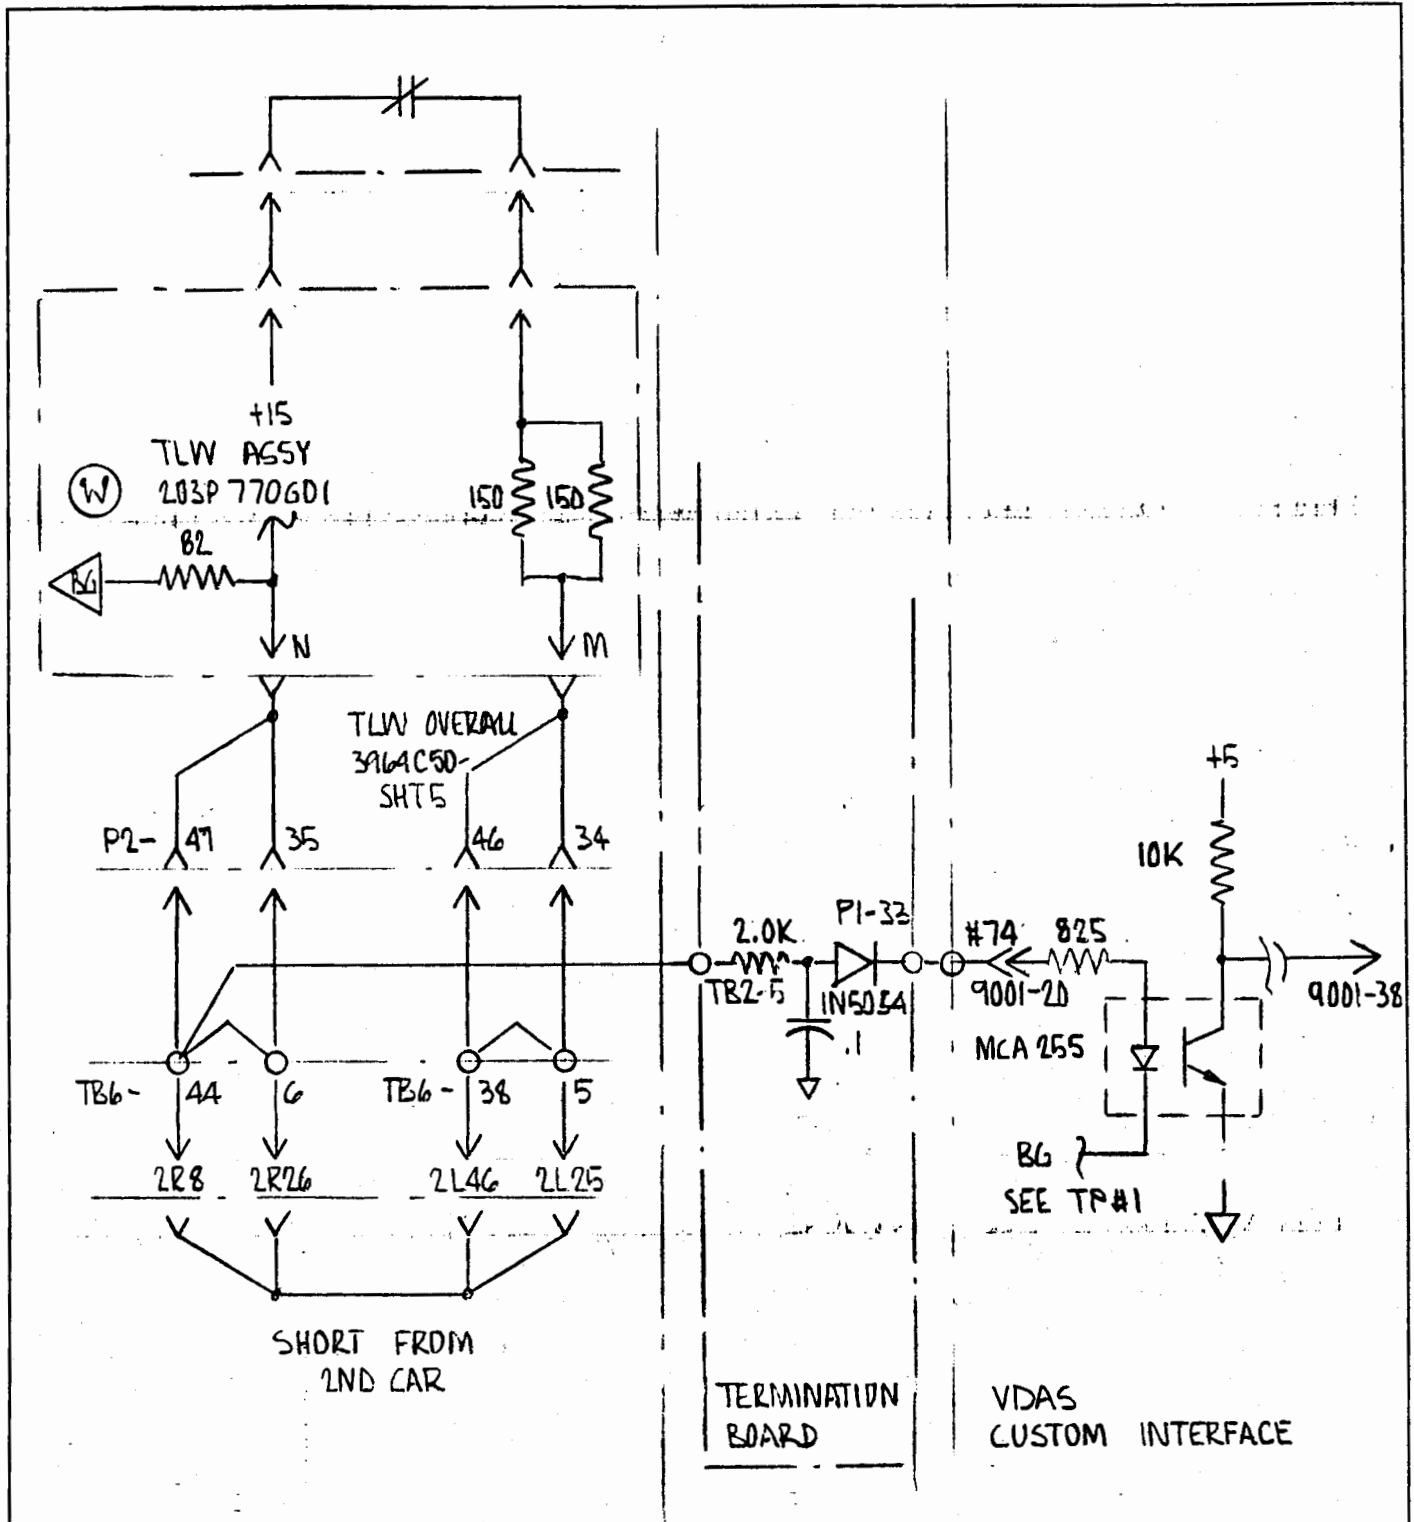

REV C 7/20/76
 REV B 4/3/78

| | | |
|-----------------------------------|---------------------------------|-------------|
| PORT OF SEATTLE COMMISSION | | DESIGN NO. |
| PROJECT | STS - VDAS TESTPOINT DEFINITION | |
| TITLE | TESTPOINT # 27 - CAR BEHIND | |
| DRAWN BY | P. STUTZ | DRAWING NO. |
| DATE | 11-7-77 | LCB P-330 |
| APPROVED | | |

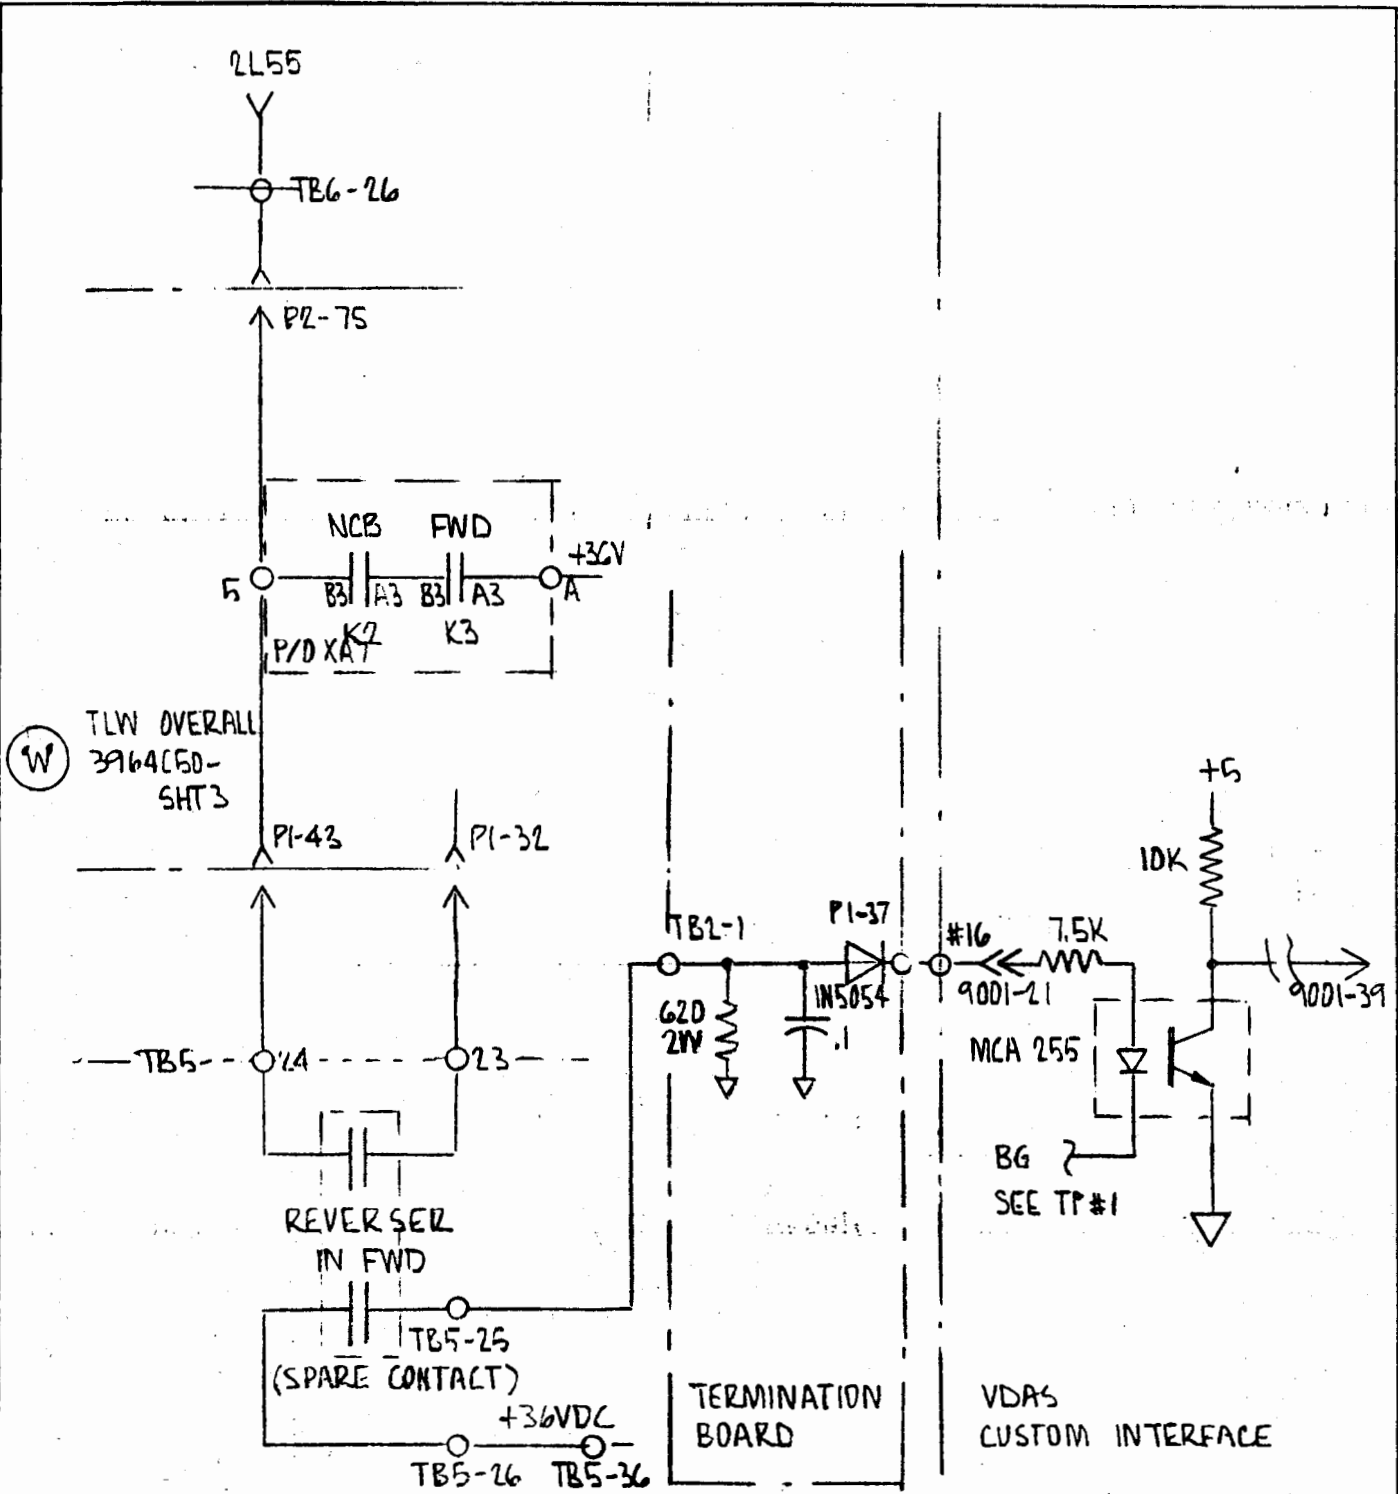

REV B 4/3/78

PORT OF SEATTLE COMMISSION


PROJECT STS - TESTPOINT DEFINITION

TITLE TESTPOINT #24 - DIRECTION SENSE (FWD)

DRAWN BY P. STUTZ DATE 11-7-77 APPROVED

DESIGN NO.


DRAWING NO.
LCD P-330

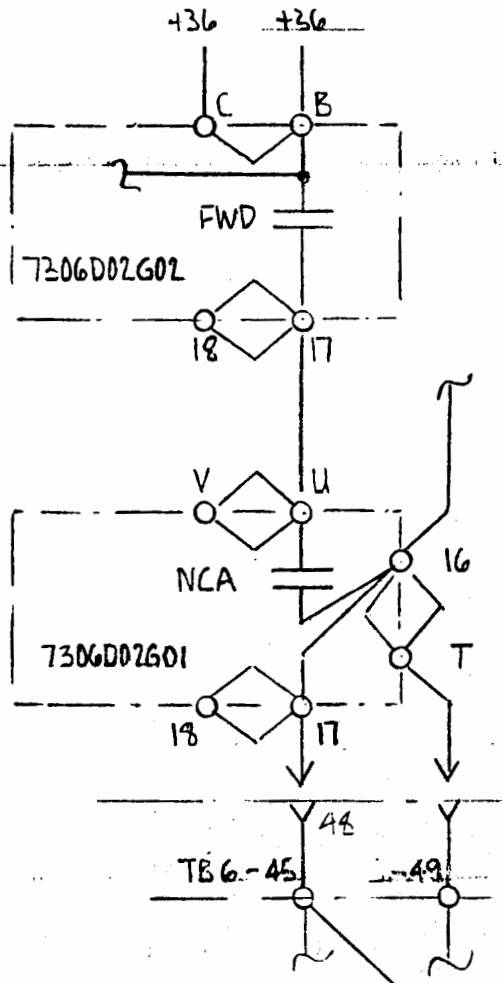

(W)


TLW OVERALL
396AC50-SHT3

VDA6
CUSTOM INTERFACE

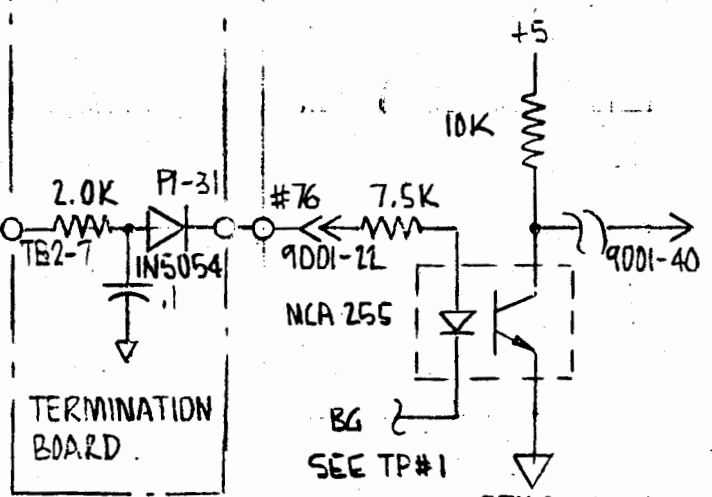

REV C 7/20/78
REV B 4/3/78

| | | |
|-----------------------------------|-----------------------------------------|--------------------------|
| PORT OF SEATTLE COMMISSION | | DESIGN NO. |
| PROJECT | STS- VDA6 TESTPOINT DEFINITION | |
| TITLE | TESTPOINT #29 - DIRECTION COMMAND (FWD) | DRAWING NO. LCO P-330 |
| DRAWN BY | P. STUTZ | |
| DATE | 11-7-77 | |
| APPROVED | | |

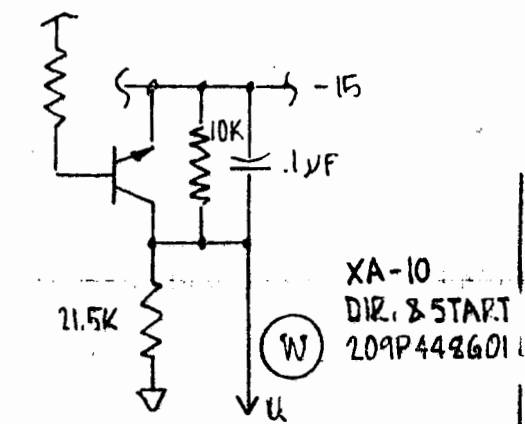

XA-10
DIR. & START
209P448601



SPEED/MAINT
1117F10
NEW

J2-60 J2-45


P2-60 P2-45
NEW

TB3-8


INTER CRADLE
7304D39-SHT41

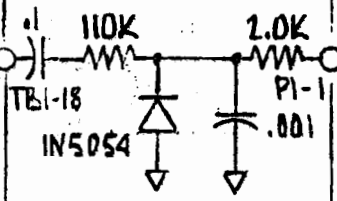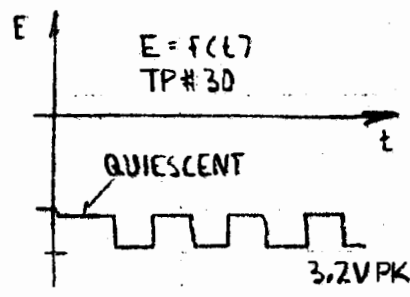

TERMINATION BOARD

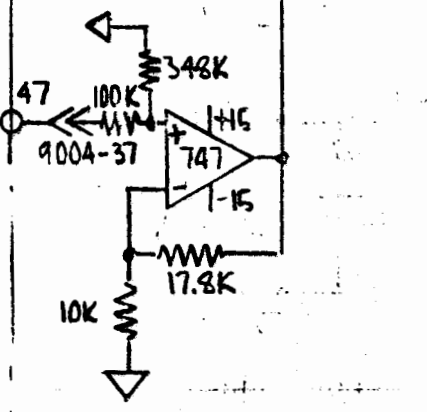

VDAS
CUSTOM INTERFACE

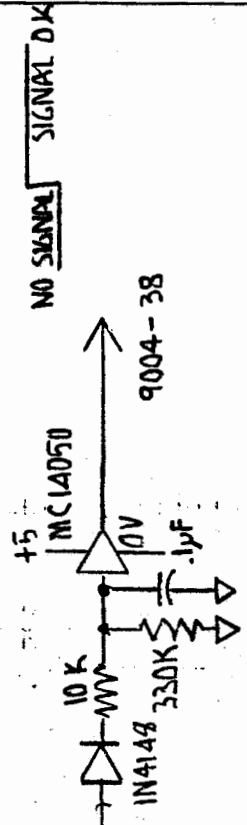


REV C 7/20/78
REV B 4/3/78

PORT OF SEATTLE COMMISSION
PROJECT STS - VDAS TESTPOINT DEFINITION
TITLE TESTPOINT #30 - P SIGNAL INTERLOCK
DRAWN BY P. STUTZ DATE 11-7-77 APPROVED _____

DESIGN NO.
DRAWING NO.
LCD P-330


EUT EXISTING CIRCUIT BOARD LAND, ADD PIGGYBACK BOARD FOR OETD-ISOLATOR

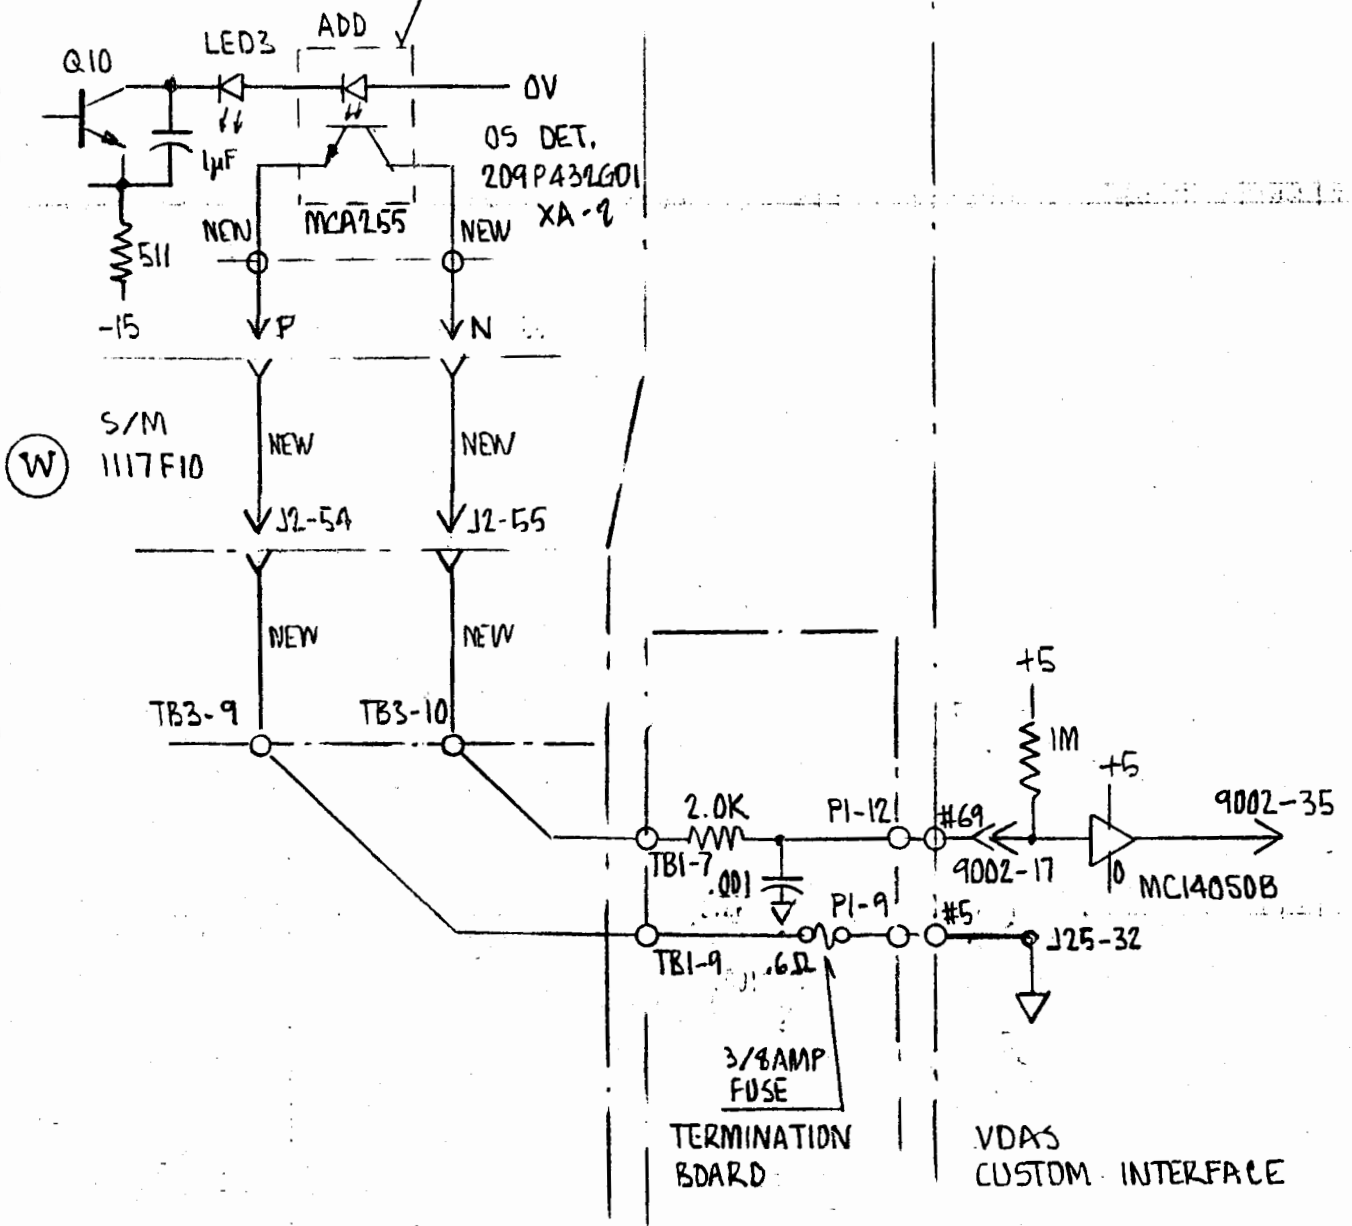

REV C 7/20/78
REV B 4/3/78

| | | |
|---|--|--------------------------------------------|
| PORT OF SEATTLE COMMISSION PROJECT STS-VDAS TESTPOINT DEFINITION TITLE TESTPOINT #31 OS II / OVERSPEED TACH I DRAWN BY P. STUTZ DATE 11-8-77 APPROVED _____ | | DESIGN NO. DRAWING NO. LCO P-330 |
|---|--|--------------------------------------------|

CUT EXISTING CIRCUIT BOARD LAND, ADD PIGGYBACK BOARD FOR OPTO-ISOLATOR

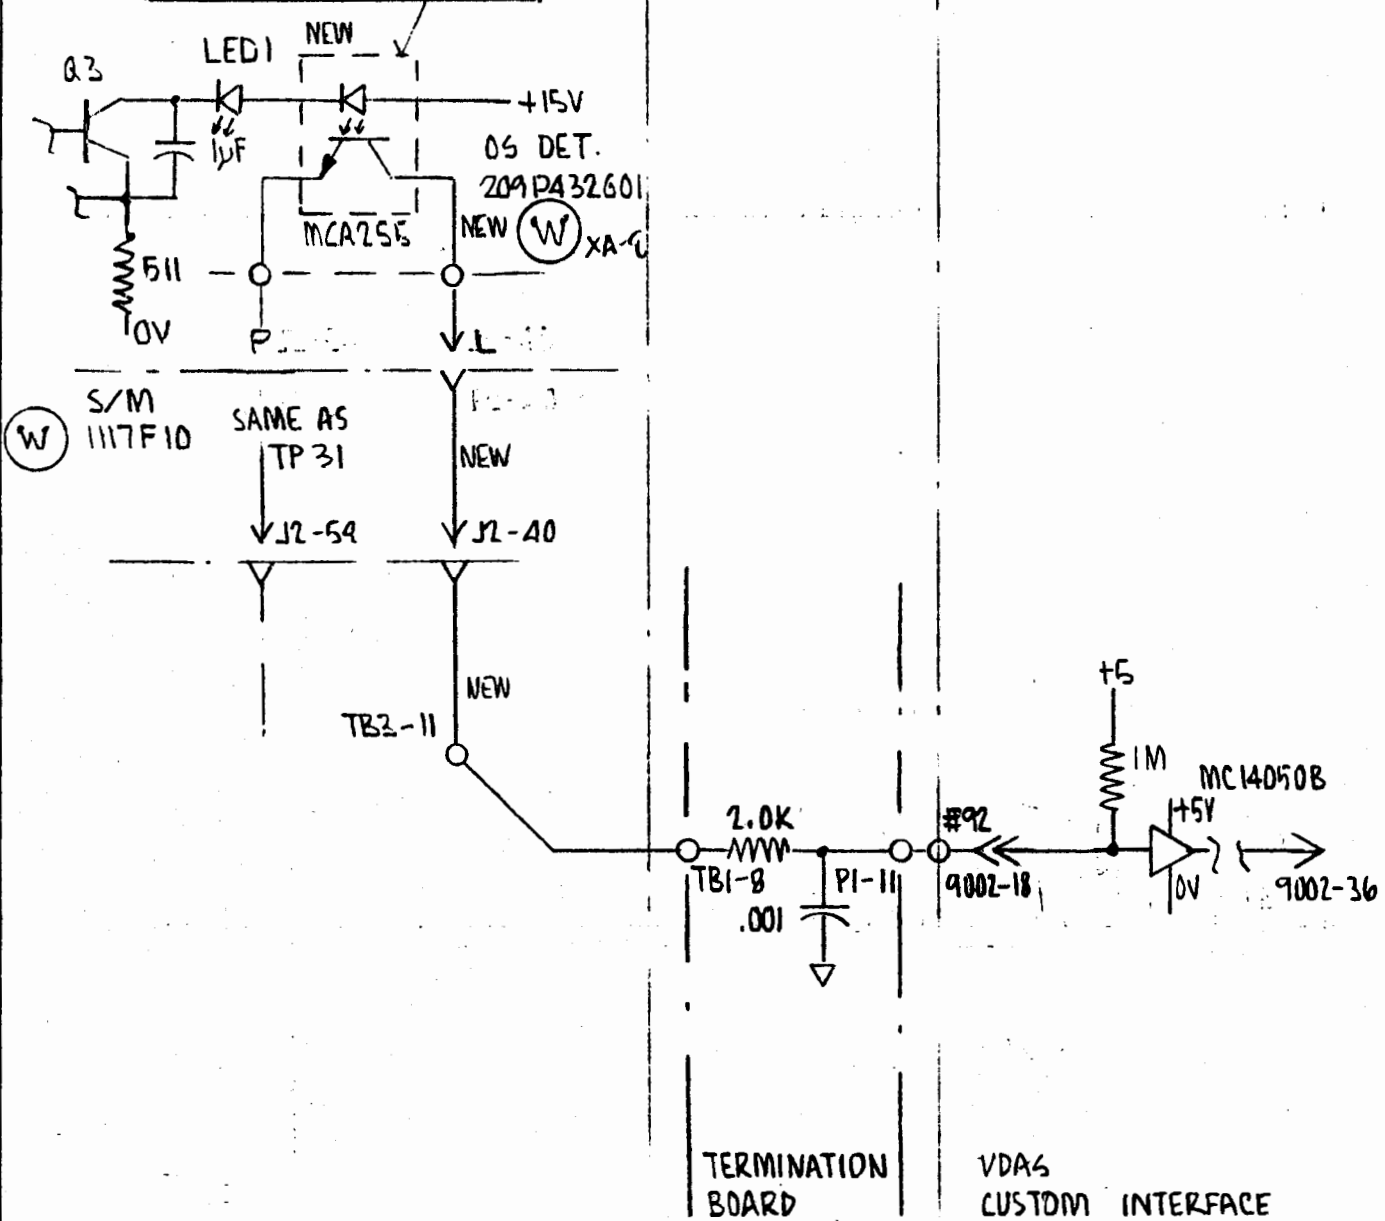

REV C 7/20/78
REV B 4/3/76


PORT OF SEATTLE COMMISSION

PROJECT STS - VDAS TESTPOINT DEFINITION
TITLE TESTPOINT #32 OSI OVERSPEED TACH 2
DRAWN BY P. STUTZ DATE 11-8 77 APPROVED

DESIGN NO.


DRAWING NO.
LCD P-330

CUT EXISTING CIRCUIT BOARD LAND, ADD PIGGY-BACK BOARD FOR OPTO-ISOLATOR

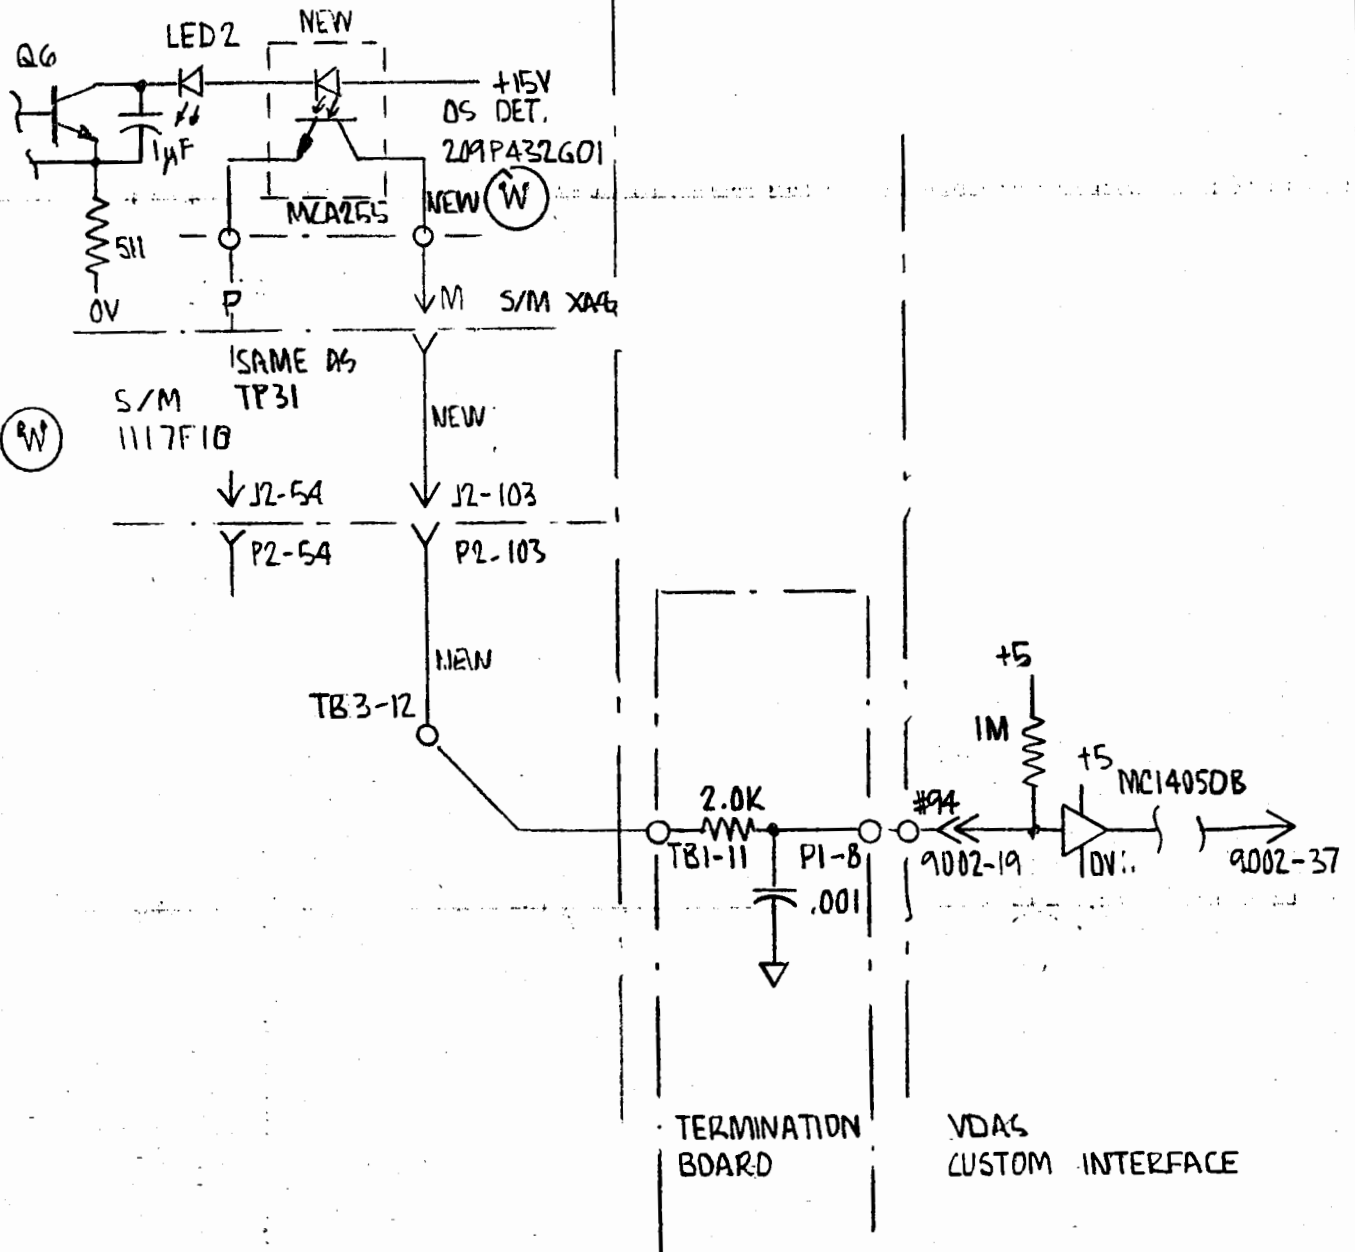

REV C 7/20/78
REV B 4/3/78

| | | |
|-----------------------------------|-----------------------------------------------|-------------|
| PORT OF SEATTLE COMMISSION | | DESIGN NO. |
| PROJECT | STS - VDAS TESTPOINT DEFINITION | |
| TITLE | TESTPOINT #33 - BAL / BALANCE TACH1 VS. TACH2 | DRAWING NO. |
| DRAWN BY | P. STUTZ | LCO P-330 |
| DATE | 11-8-77 | |
| APPROVED | | |

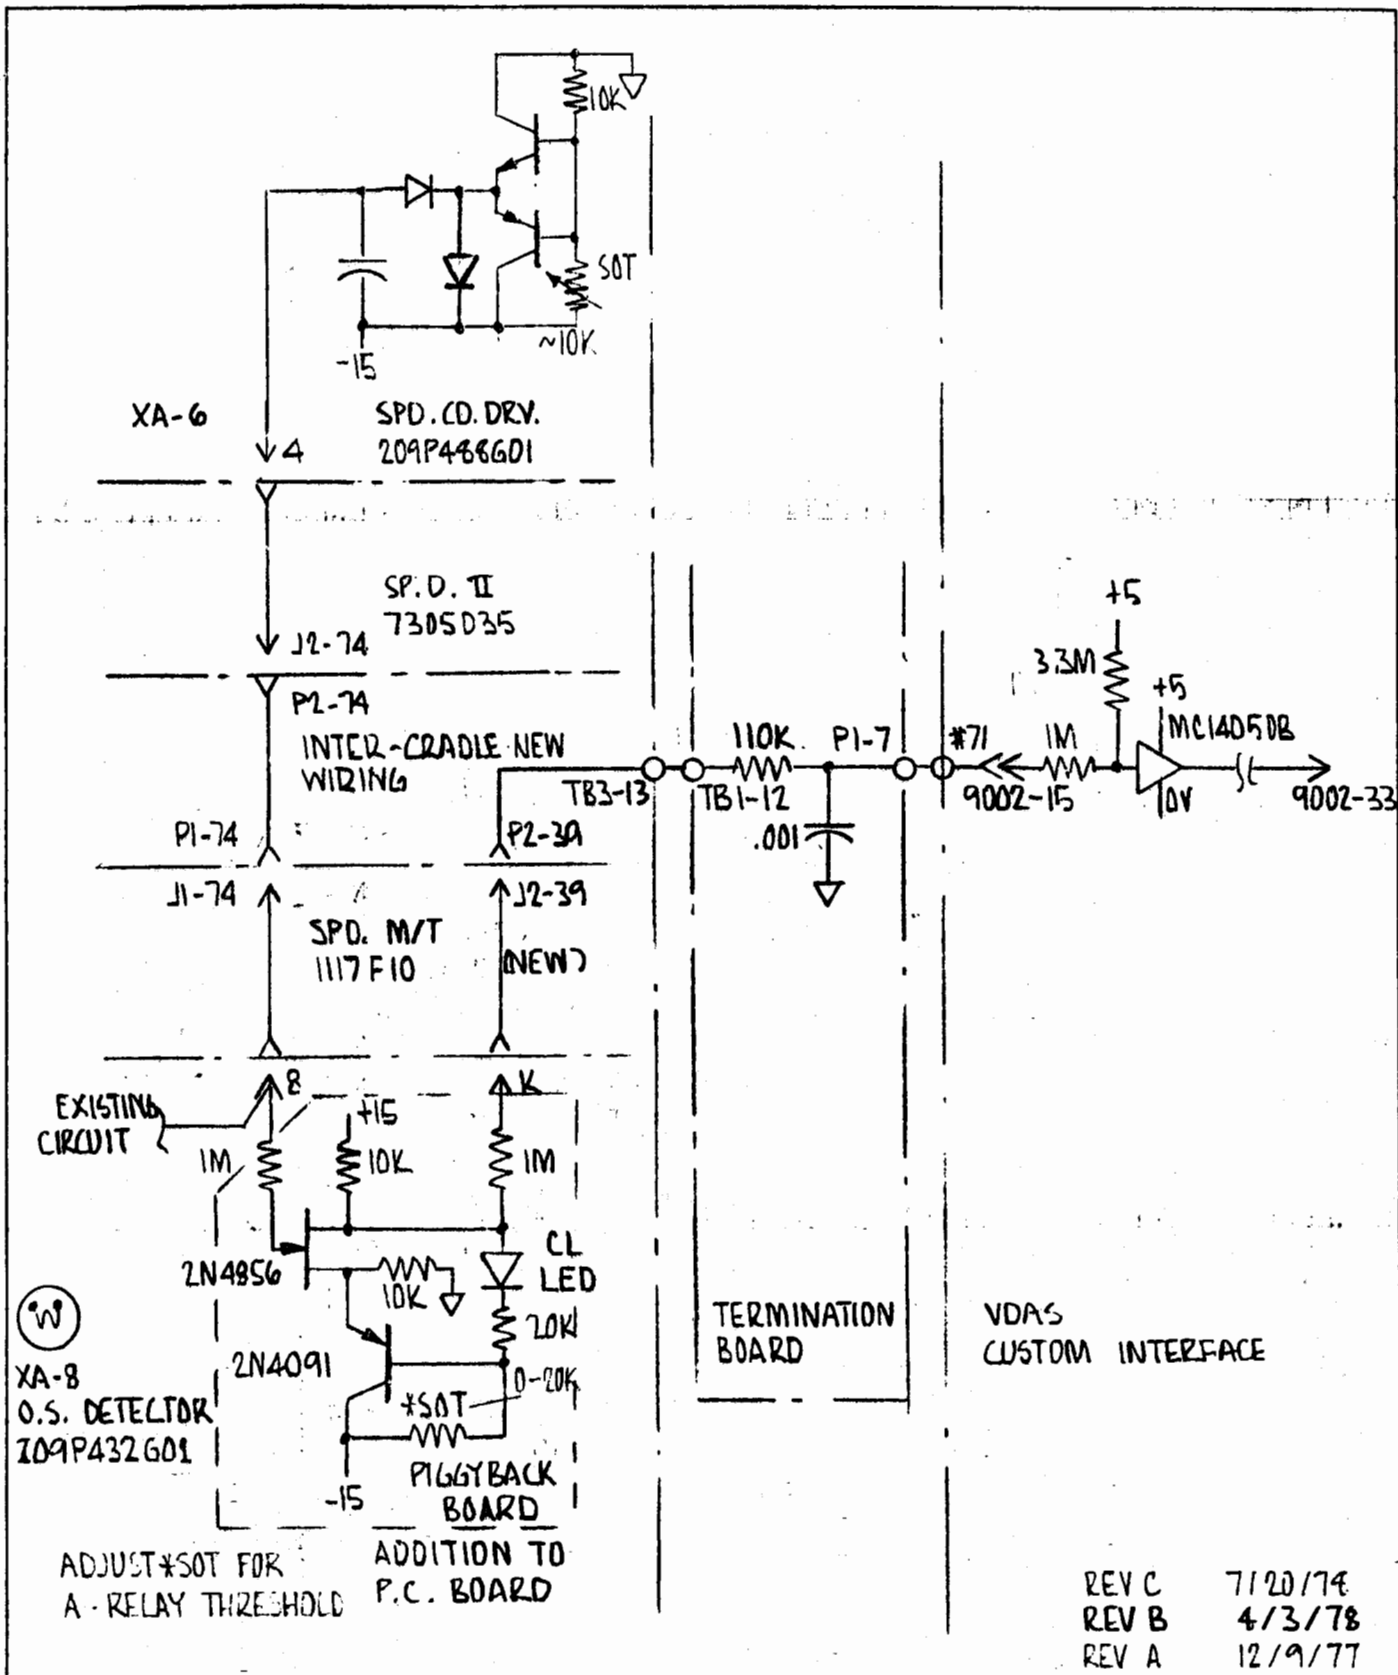

Ⓜ
 XA-8
 O.S. DETECTOR
 109P432601

ADJUST *SOT FOR
 A-RELAY THRESHOLD

ADDITION TO
 P.C. BOARD

TERMINATION
 BOARD


VDA'S
 CUSTOM INTERFACE


REV C 7/20/78
 REV B 4/3/78
 REV A 12/9/77

| | | |
|-----------------------------------|----------------------------------|-------------|
| PORT OF SEATTLE COMMISSION | | DESIGN NO. |
| PROJECT | STS - VDA'S TESTPOINT DEFINITION | |
| TITLE | TESTPOINT # 34 - CODE LOAD | DRAWING NO. |
| DRAWN BY | P. STUTZ | LCO P-330 |
| DATE | 11-8-77 | |
| APPROVED | | |

APPENDIX B



Prolog System Information

 

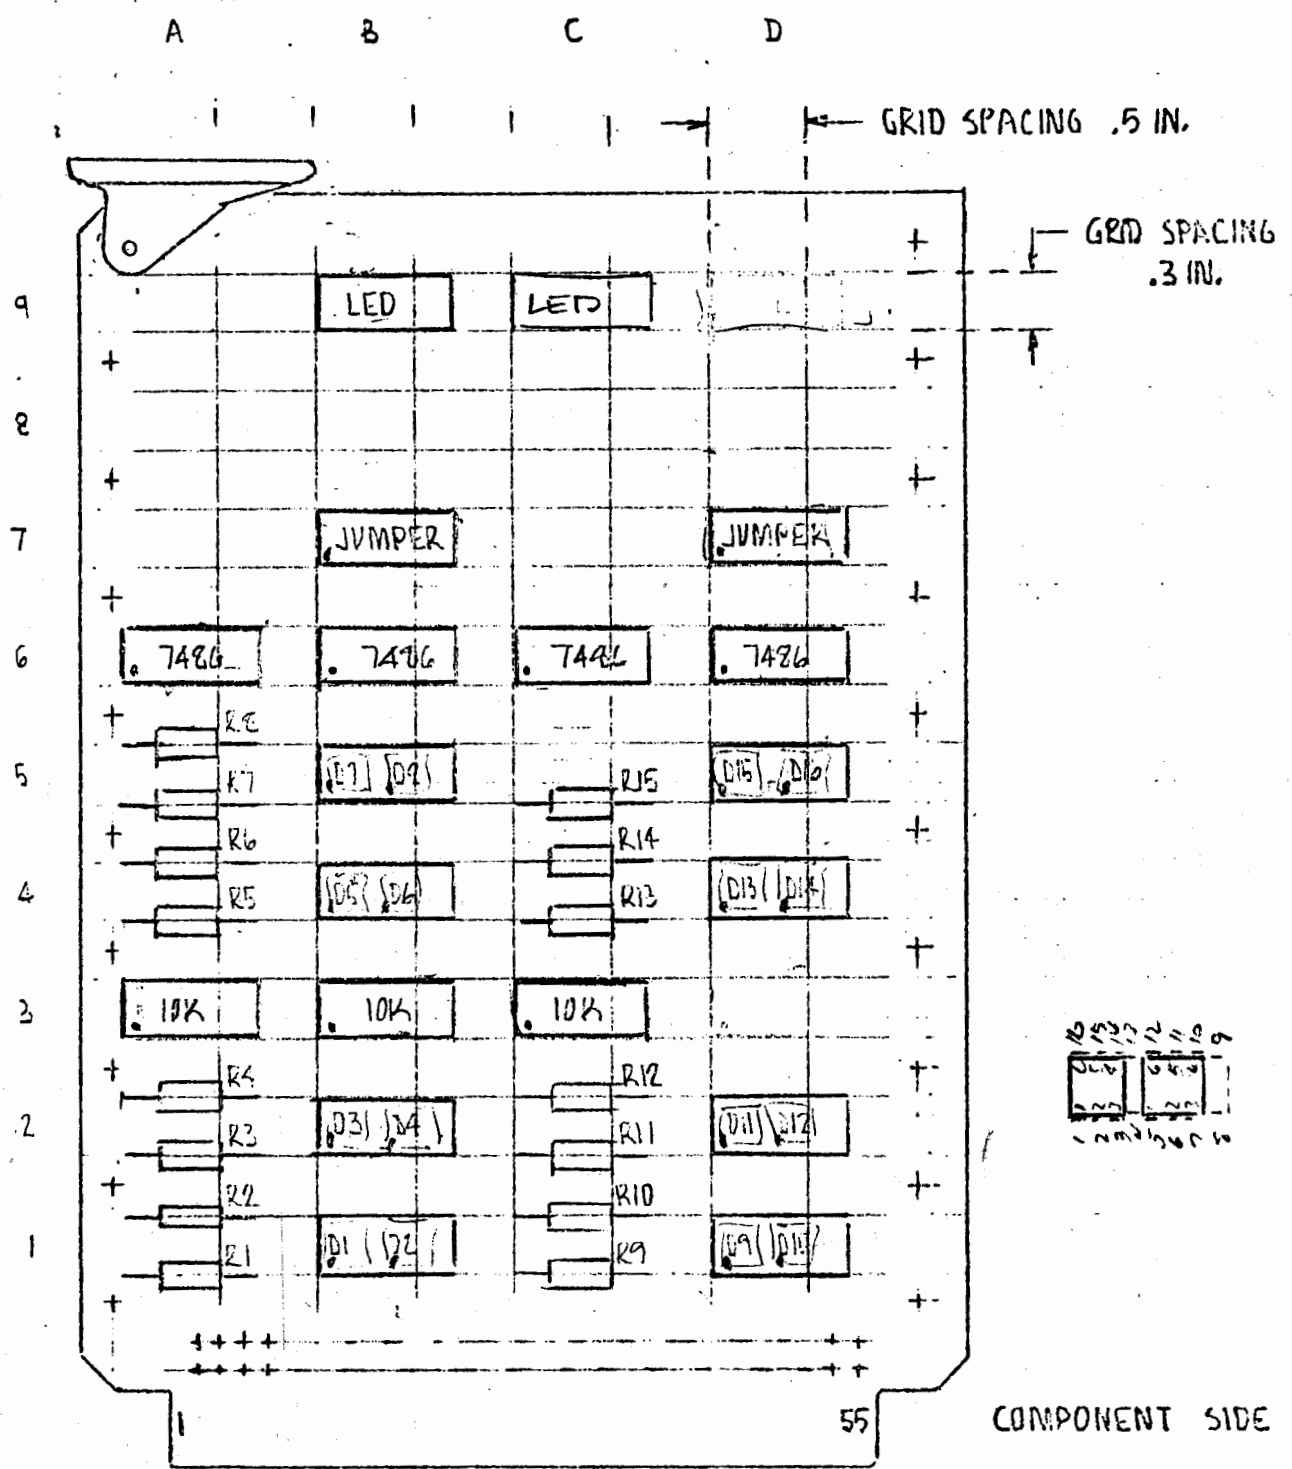



PROLOG PART NUMBER #P561

| | | |
|---------------------------------|---------------------------|-------------|
| PORT OF SEATTLE COMMISSION | | DESIGN NO. |
| PROJECT PROLOG UTILITY DIP CARD | | DRAWING NO. |
| TITLE _____ | | |
| DRAWN BY P. STUTZ | DATE _____ APPROVED _____ | |

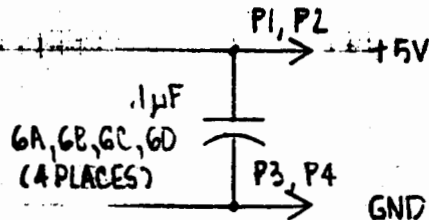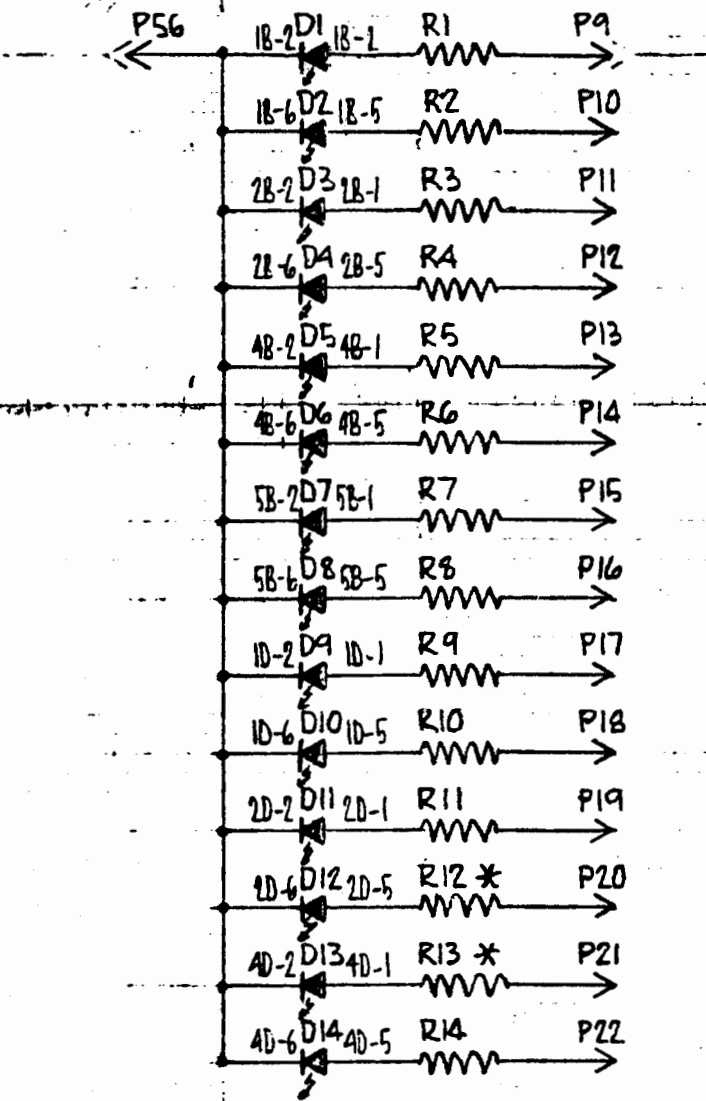


NOTE
 * R12, R13 3.3K/1W
 ALL OTHERS 7.5K/1W

D1 TO D16 ARE THE
 INPUT PORTIONS OF 16
 OPTICAL COUPLERS

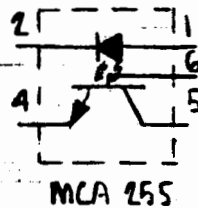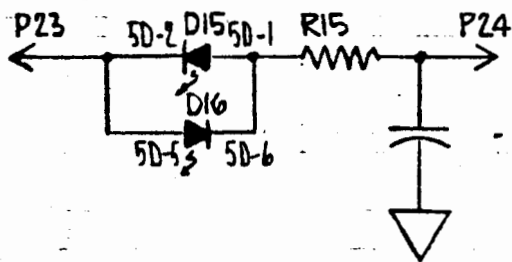

9001

| | | |
|-----------------------------------|-----------------------------------------|-------------|
| PORT OF SEATTLE COMMISSION | | DESIGN NO. |
| PROJECT | STS-VDAC | DRAWING NO. |
| TITLE | ISOLATED INPUT CARD (36VDC - TTL LEVEL) | |
| DRAWN BY | P. STUTZ | |
| DATE | 12/19/77 | APPROVED |

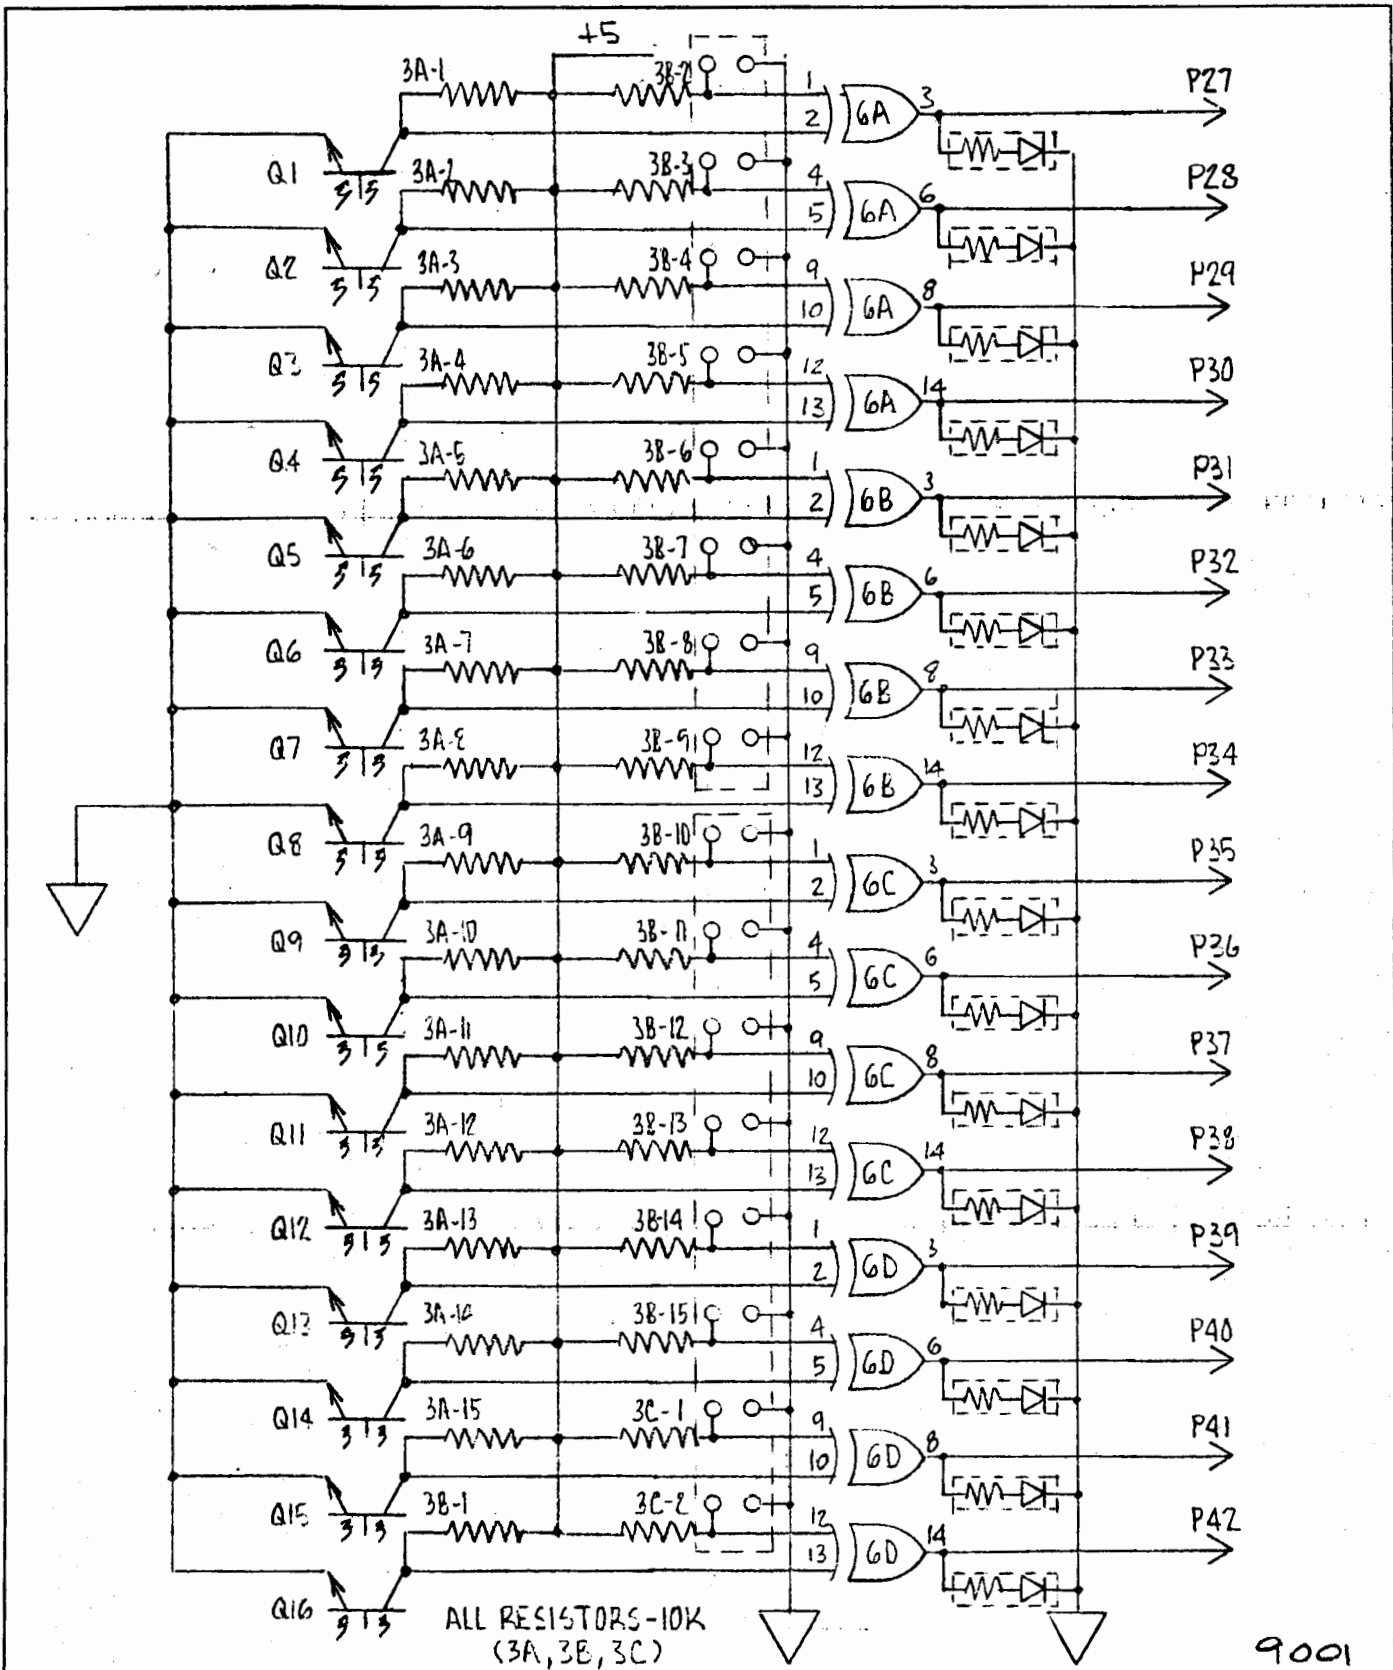


9001

| | | |
|-----------------------------------|-----------------------------------------|-------------|
| PORT OF SEATTLE COMMISSION | | DESIGN NO. |
| PROJECT | STS - VDAC | |
| TITLE | ISOLATED INPUT CARD (±6VDC - TTL LEVEL) | |
| DRAWN BY | P. STUTZ | DRAWING NO. |
| DATE | 12/19/77 | |
| APPROVED | | |


DATA INDICATORS
(16 BITS)

SPEED DISPLAY
(8 BITS)

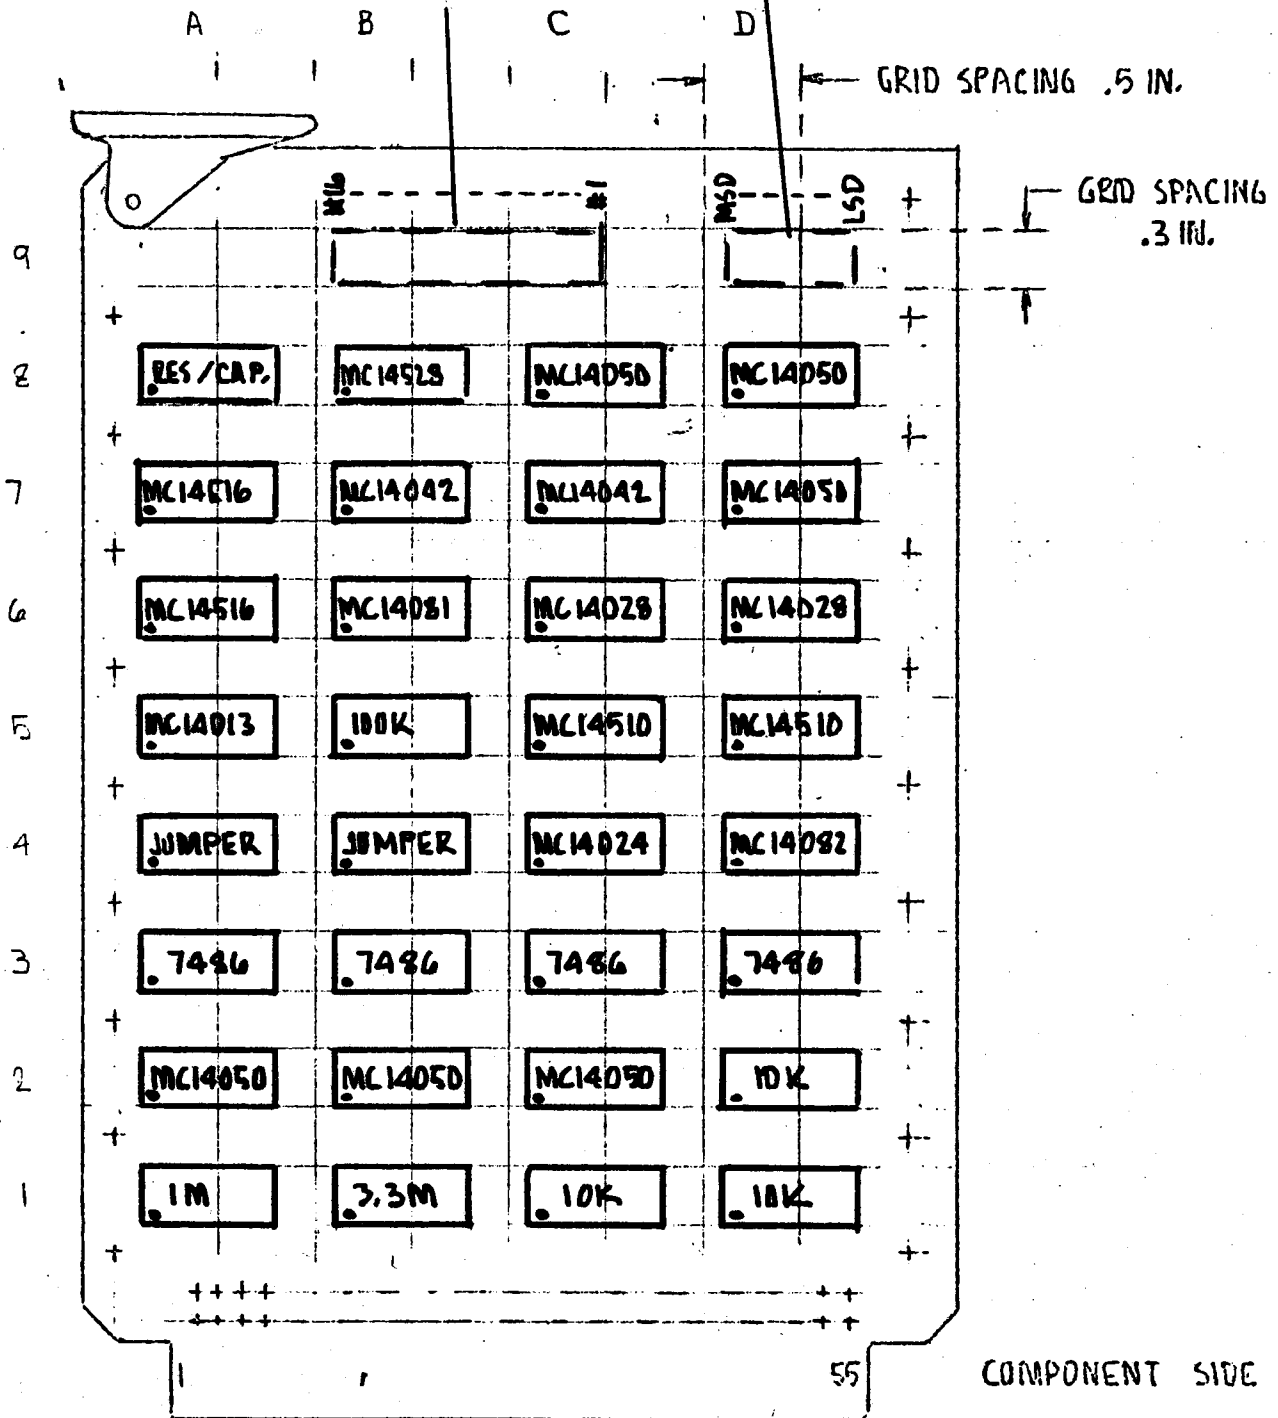

PROLOG PART NUMBER #P561

| | | |
|---------------------------------------------------------------|------------|----------------|
| PORT OF SEATTLE COMMISSION PROJECT PROLOG UTILITY DIP CARD | | DESIGN NO. |
| TITLE HI-Z INPUT, SPEED INDICATOR | | DRAWING NO. |
| DRAWN BY P. STUTZ | DATE _____ | APPROVED _____ |

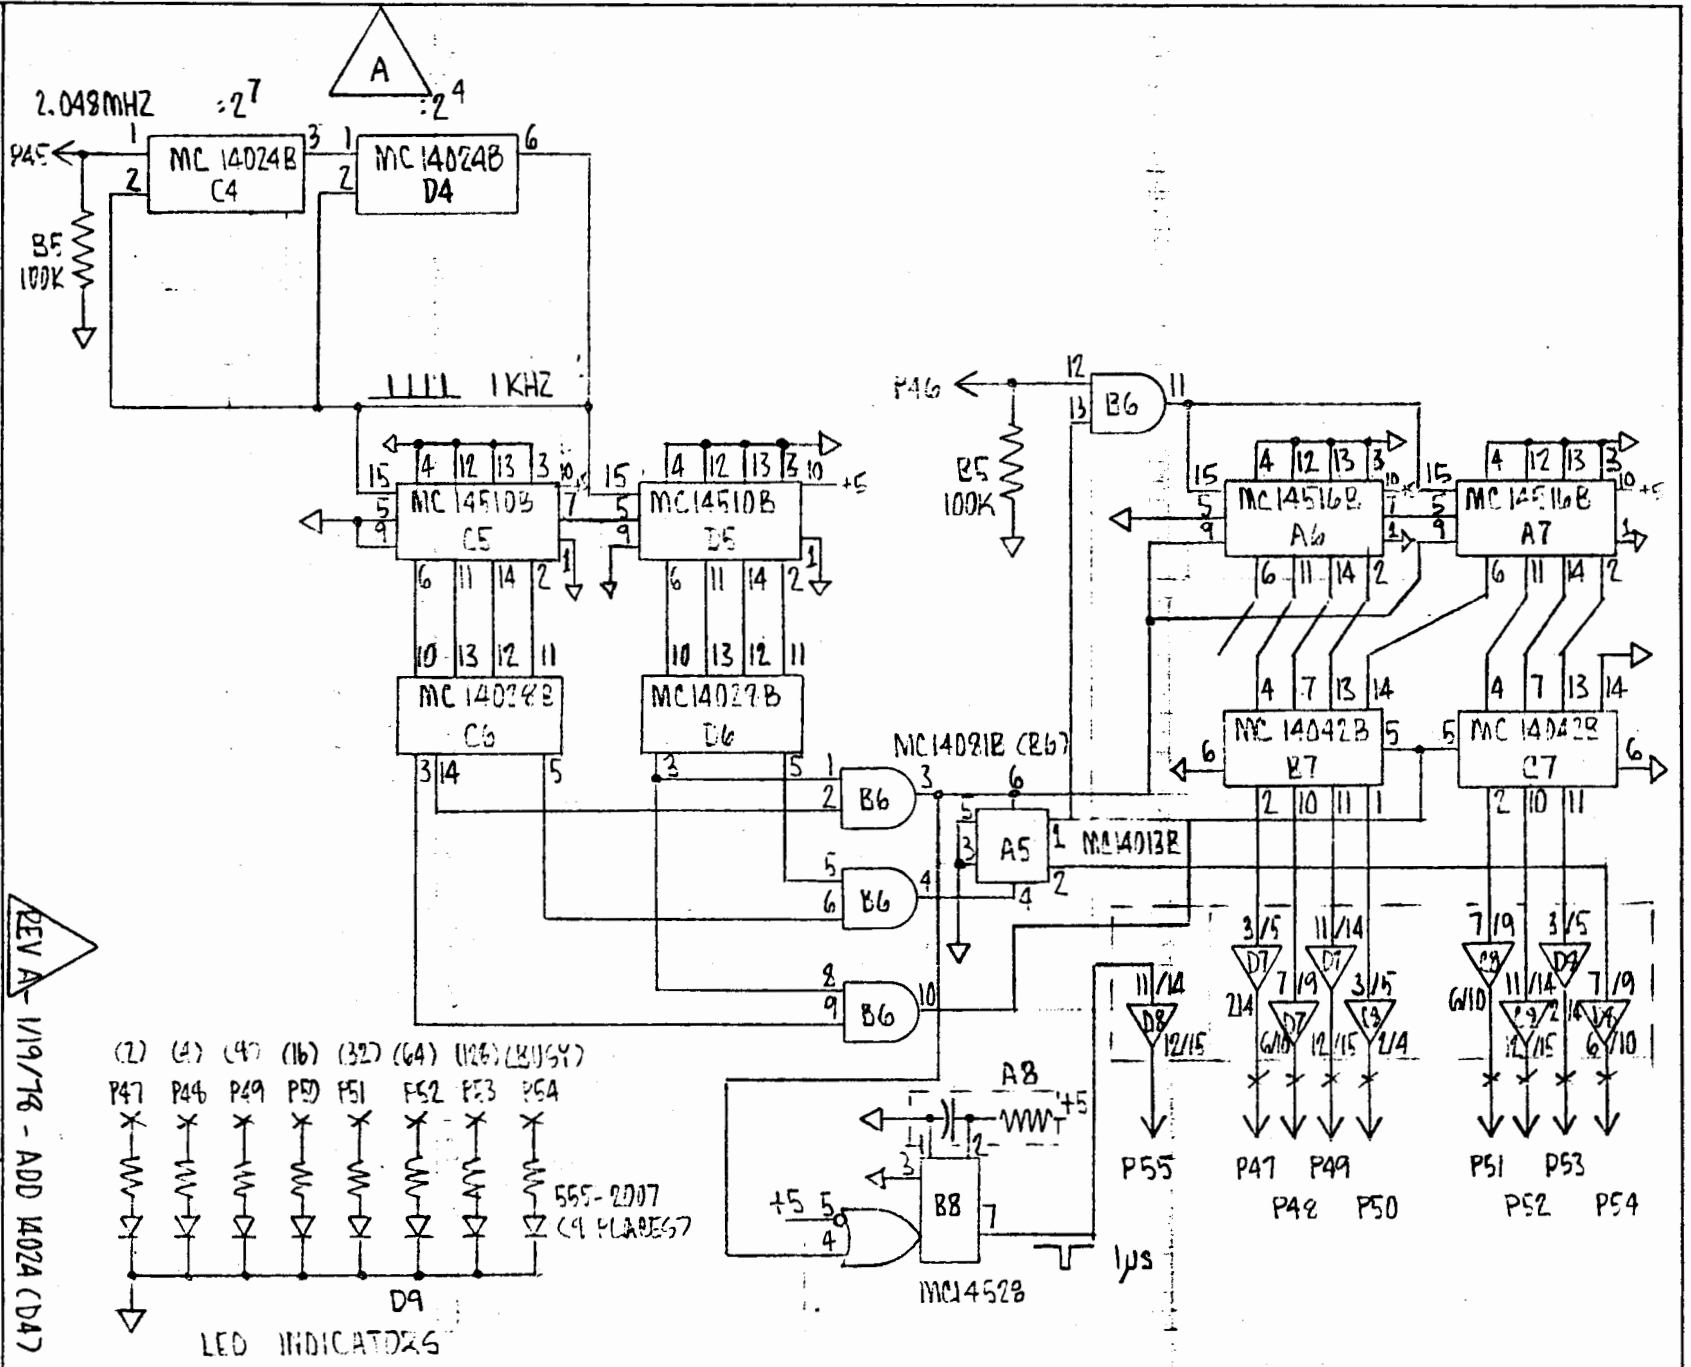

PORT OF SEATTLE COMMISSION

PROJECT STS - VDAQ

TITLE TACH SIGNAL SCALER

DRAWN BY P. STUTZ DATE 12-27-77

APPROVED

REV A - 1/19/78 - ADD 14024 (D4)


- (2) P47
 - (4) P48
 - (4) P49
 - (16) P50
 - (32) F51
 - (64) F52
 - (128) F53
 - (256) F54
- 555-2207 (4 PLACES)
- D9 LED INDICATORS

POS 1209

9002

DRAWING NO.

DESIGN NO.




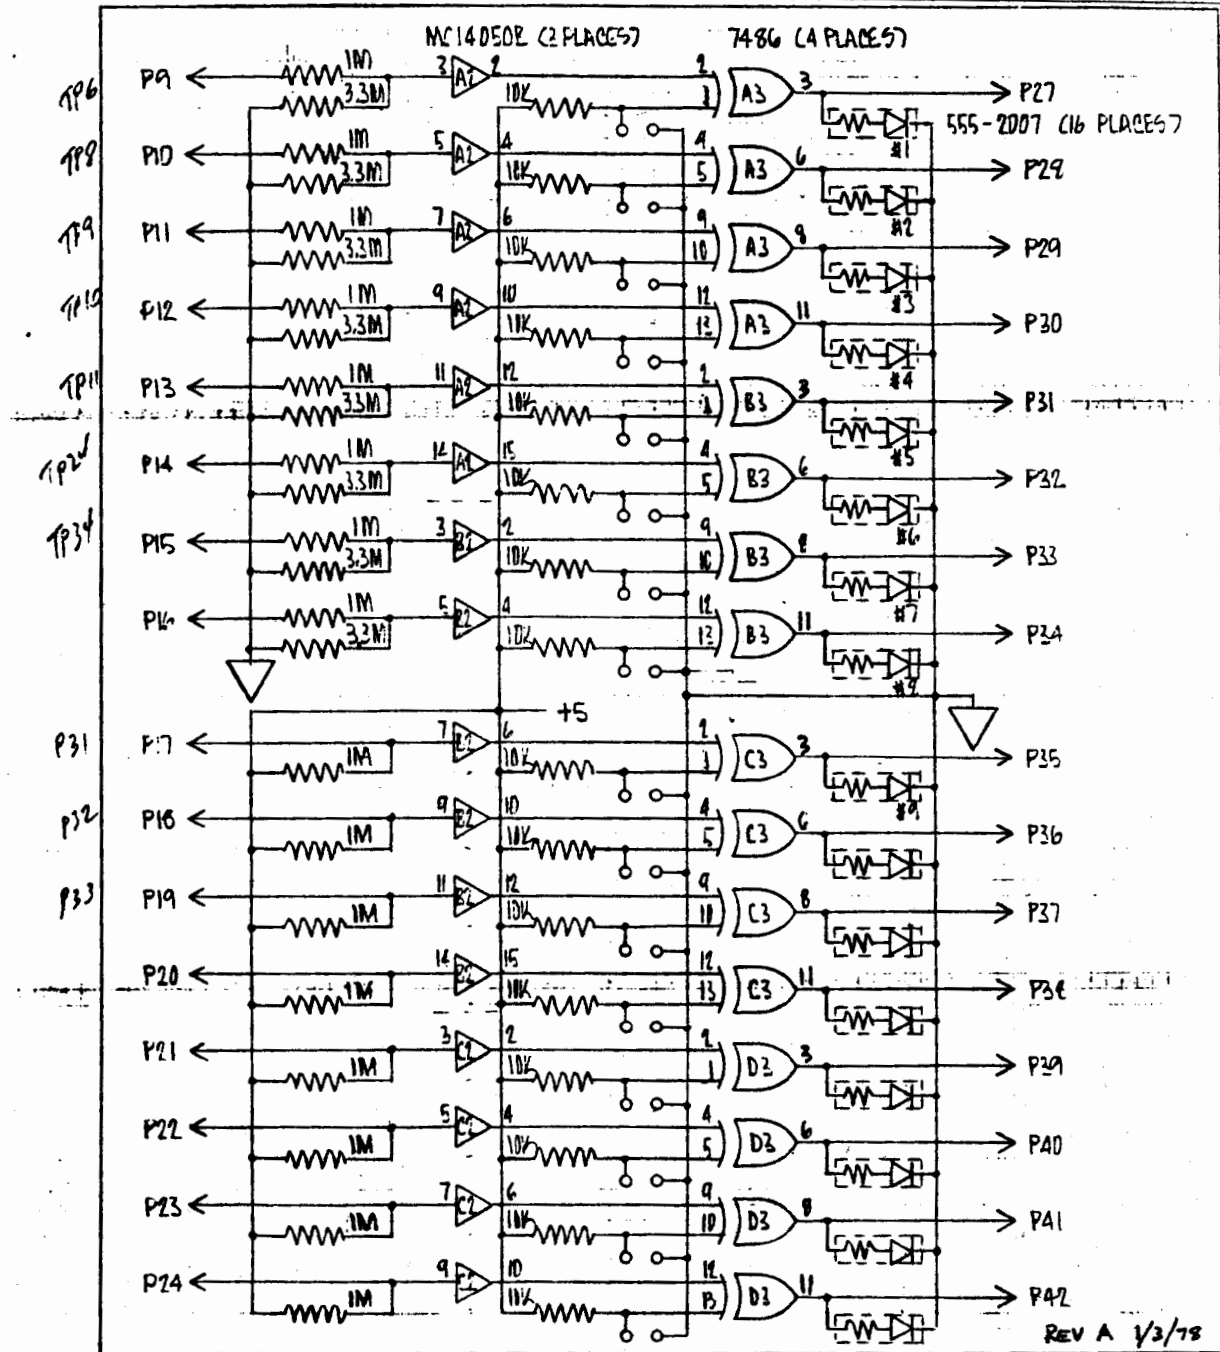






REV A 1/3/78


| | | |
|-----------------------------------|-----------------------------------|-------------|
| PORT OF SEATTLE COMMISSION | | DESIGN NO. |
| PROJECT | STS - VDAS | |
| TITLE | CMOS INPUT CARD (+6V, +15V LEVEL) | DRAWING NO. |
| DRAWN BY | P. STUTZ | |
| DATE | 12/23/77 | APPROVED |

PCB 120-2


9002

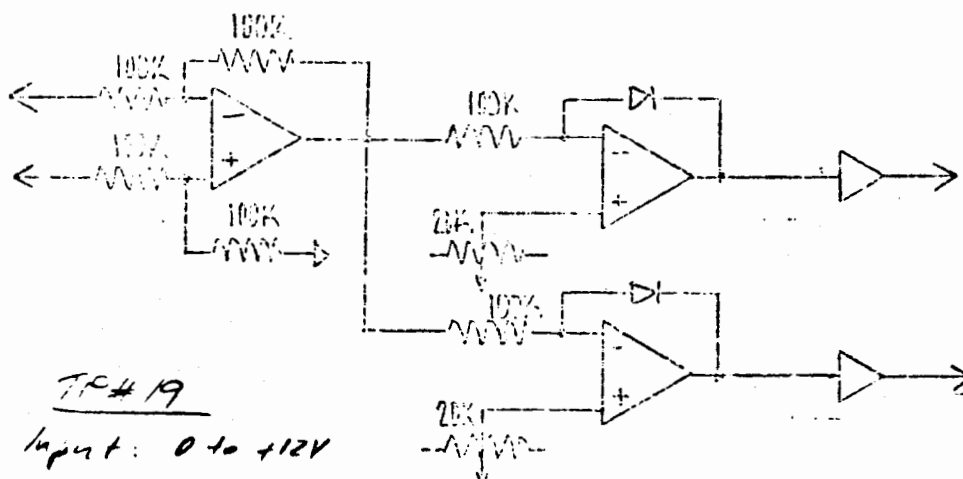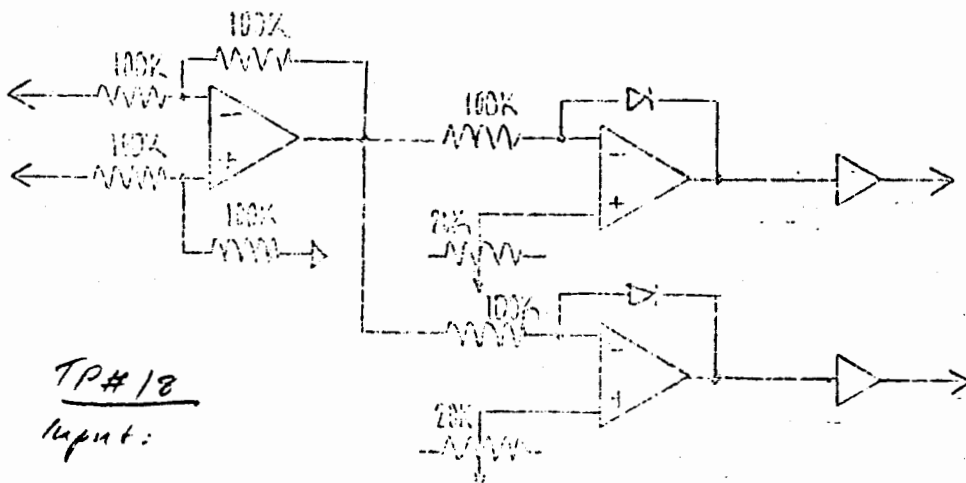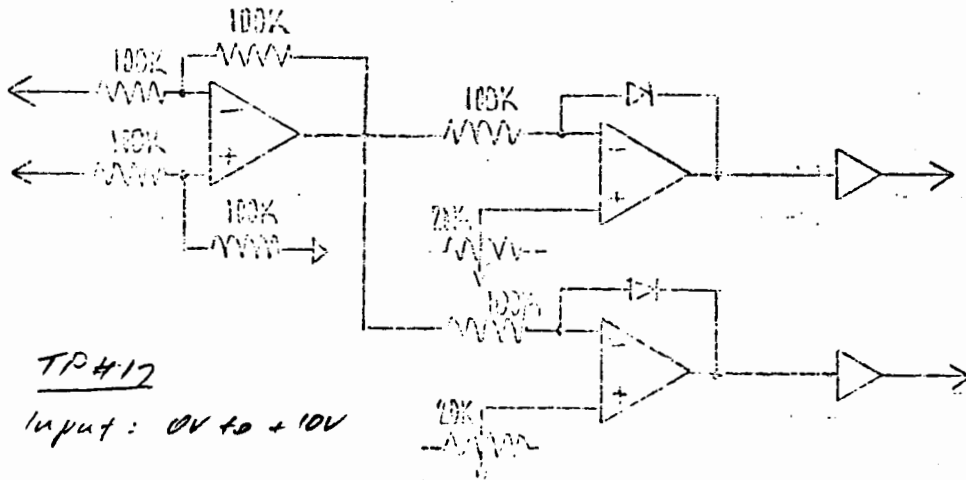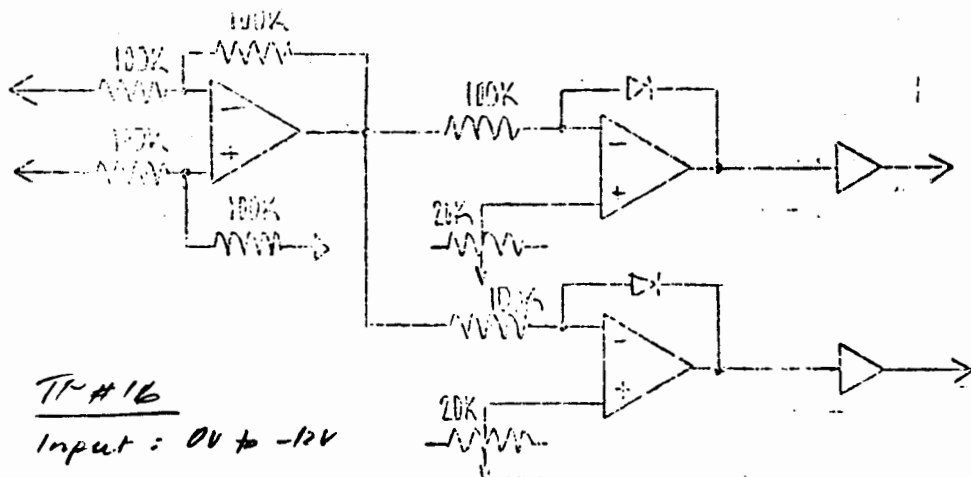

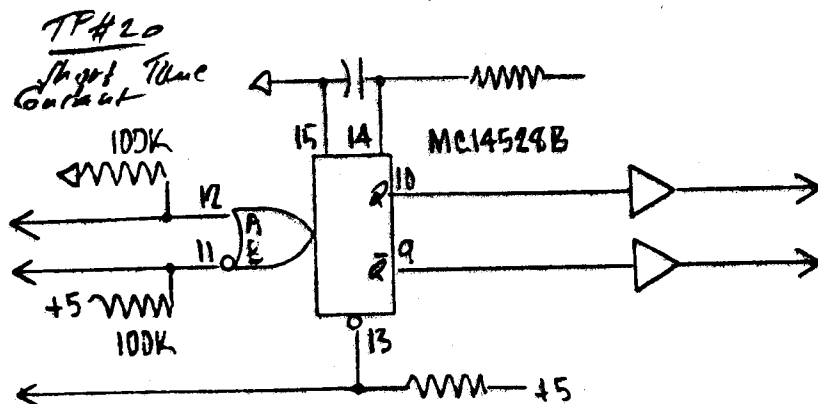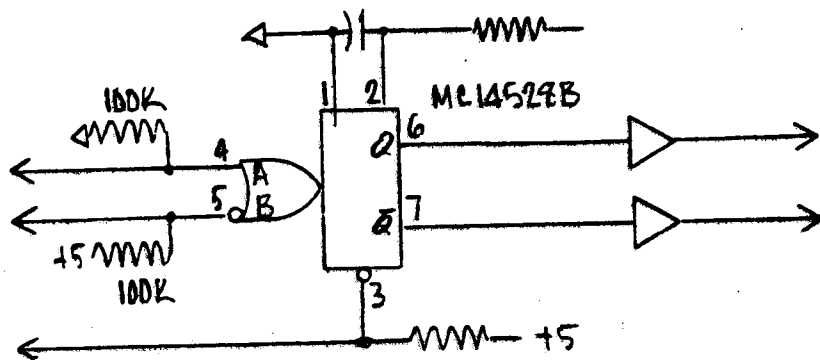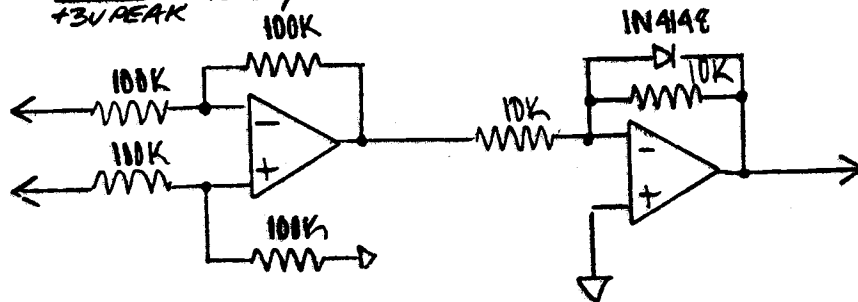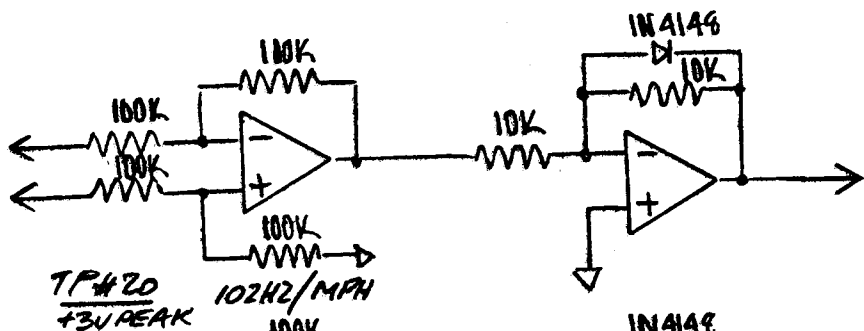


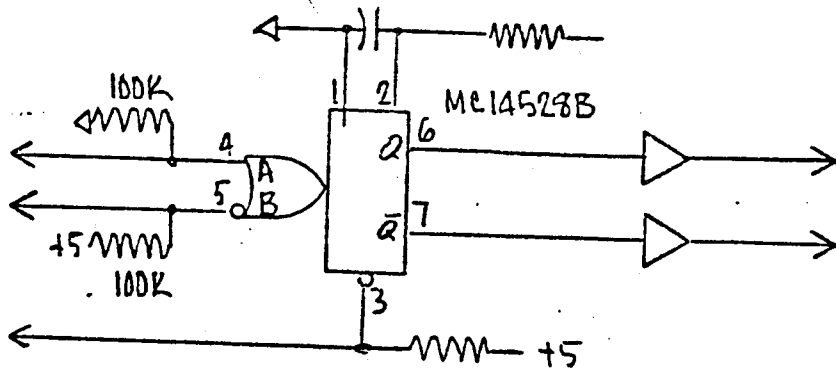


TP#20
Short Time
Output

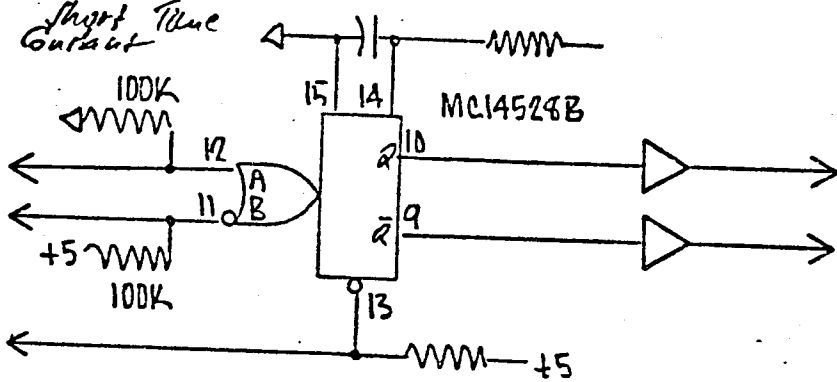


TP#21
Time Constant long enough to
maintain Q

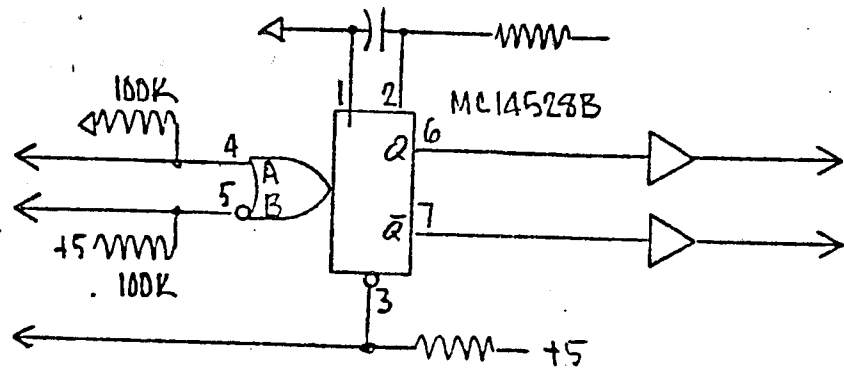


TP#20
Short Time
Output

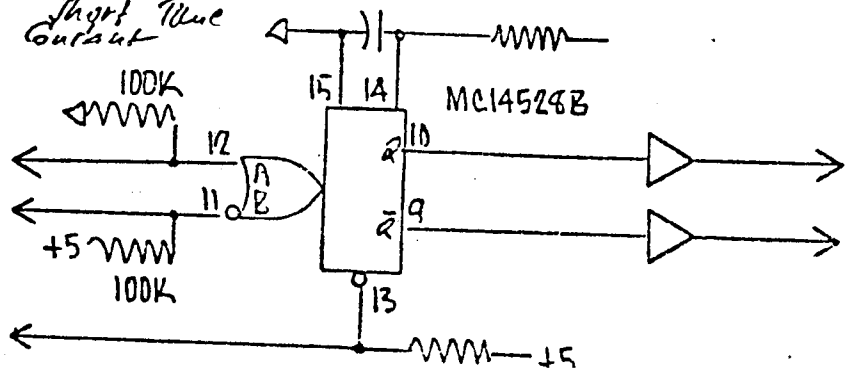

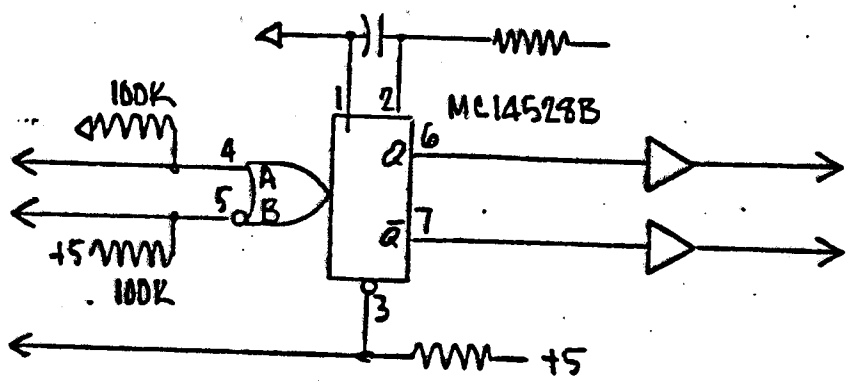



TP#20

Short Time Constant


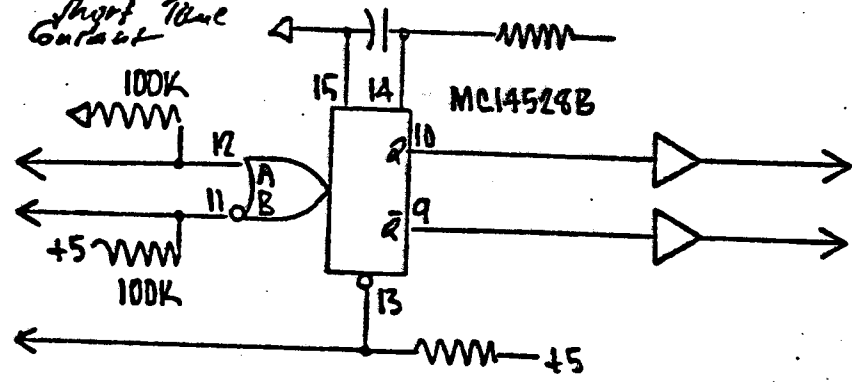




TP#21

Time Constant long enough to maintain Q

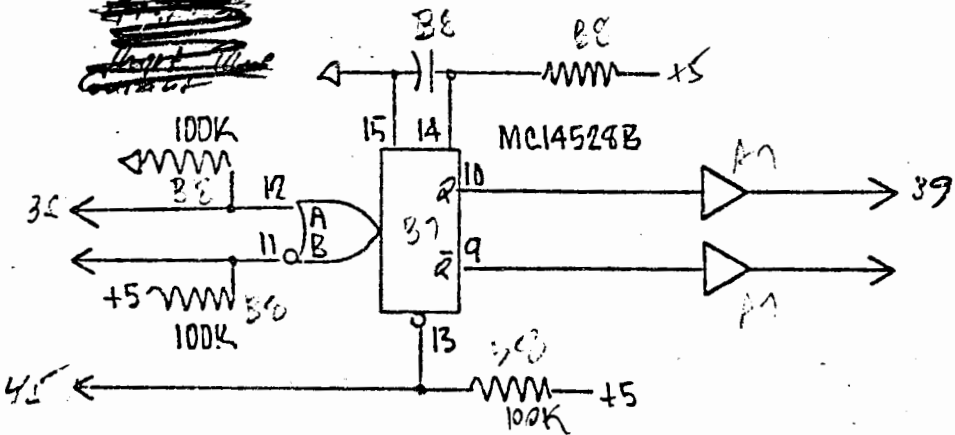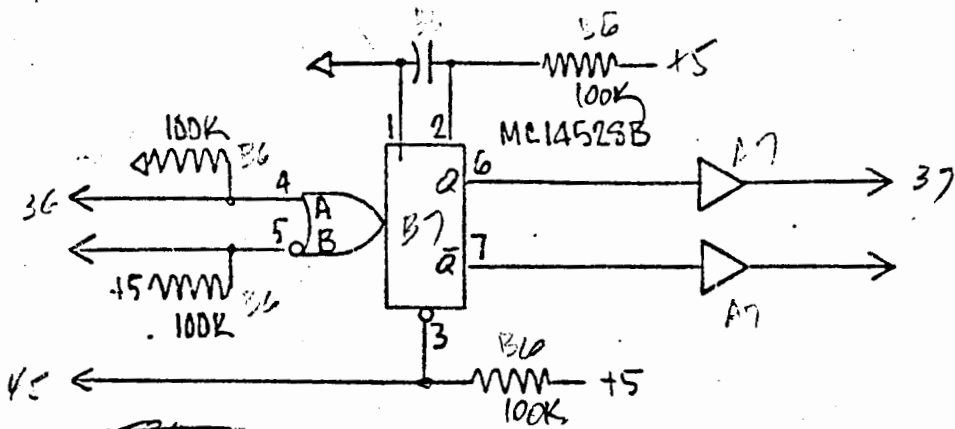


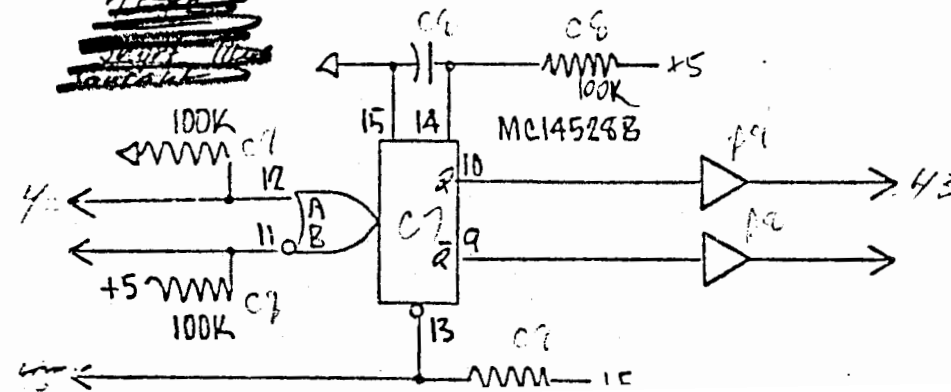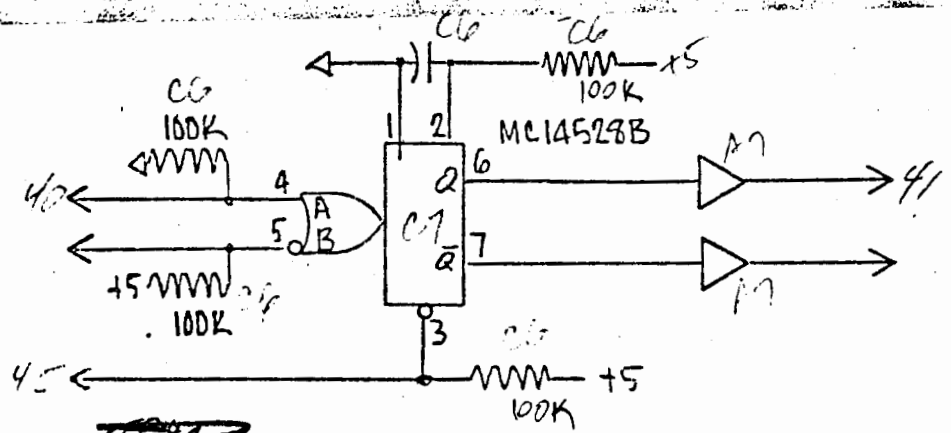


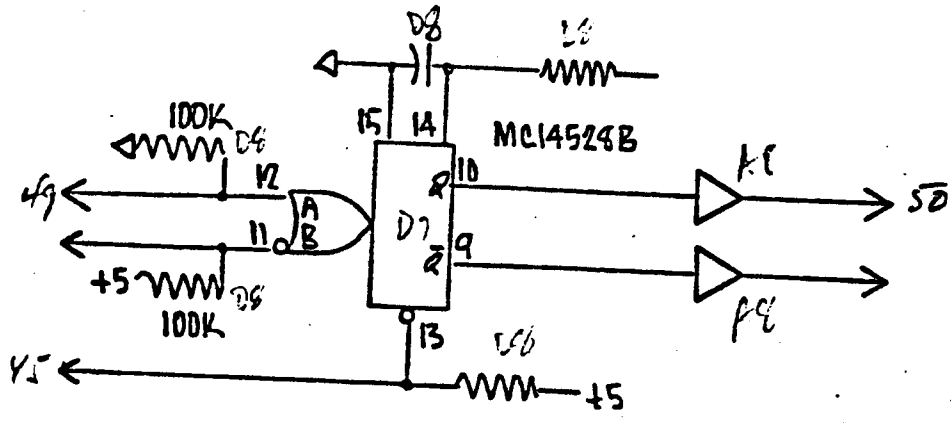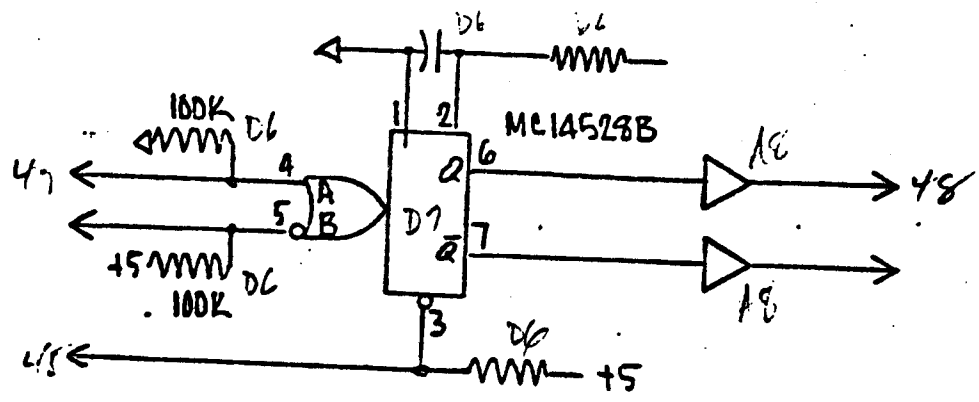

- 1, 2 +5VDC
- 3, 4 GND
- 5, 6 -5VDC (NOT USED)
- 53, 54 -12VDC
- 55, 56 +12VDC

A B C D



9
8
7
6
5
4
3
2
1

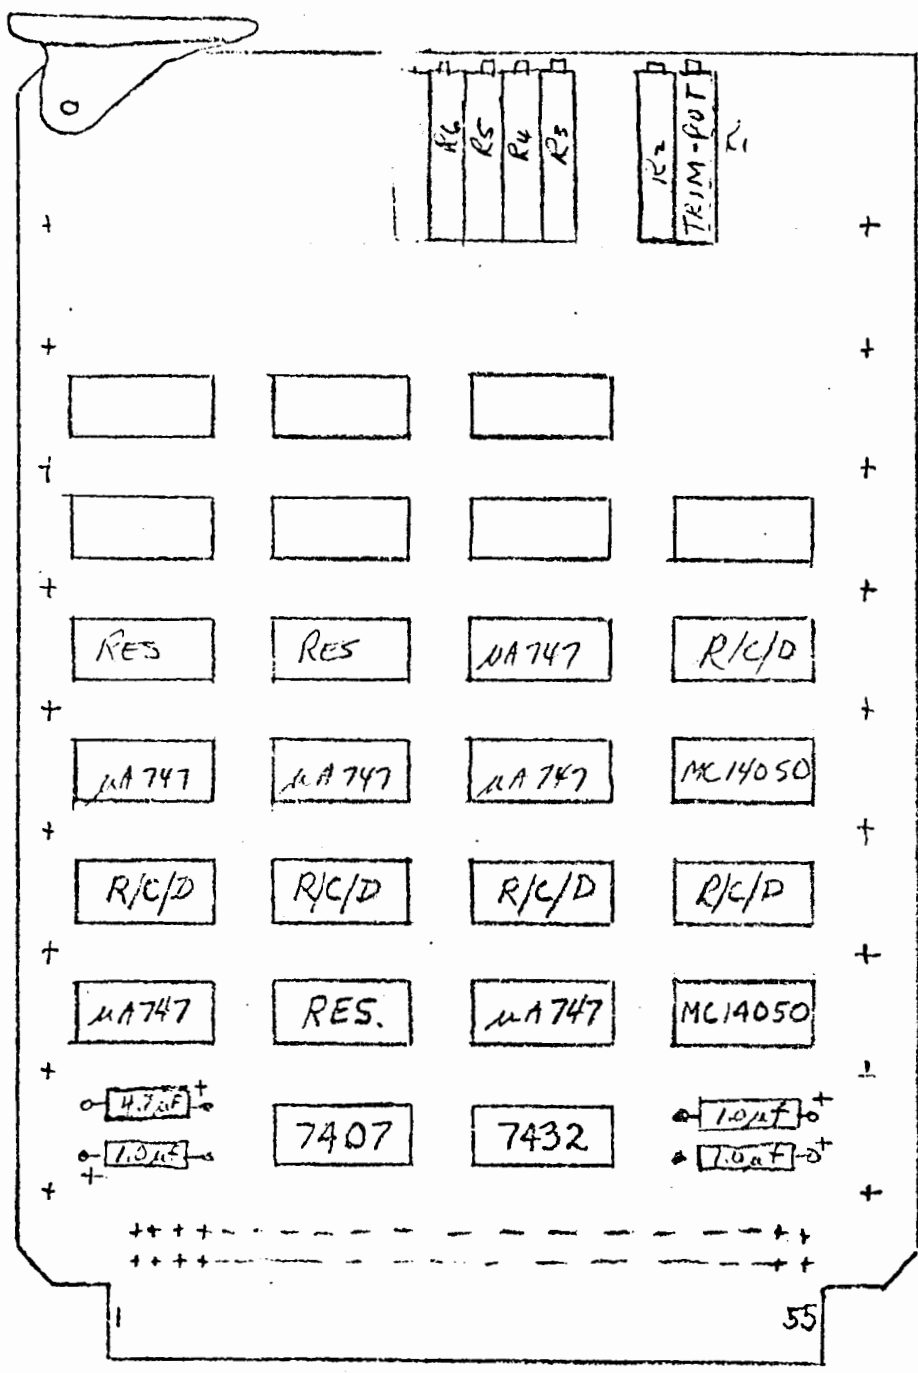

Control Card


TITLE MISC

LIGHT

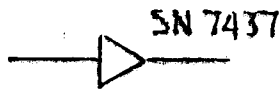
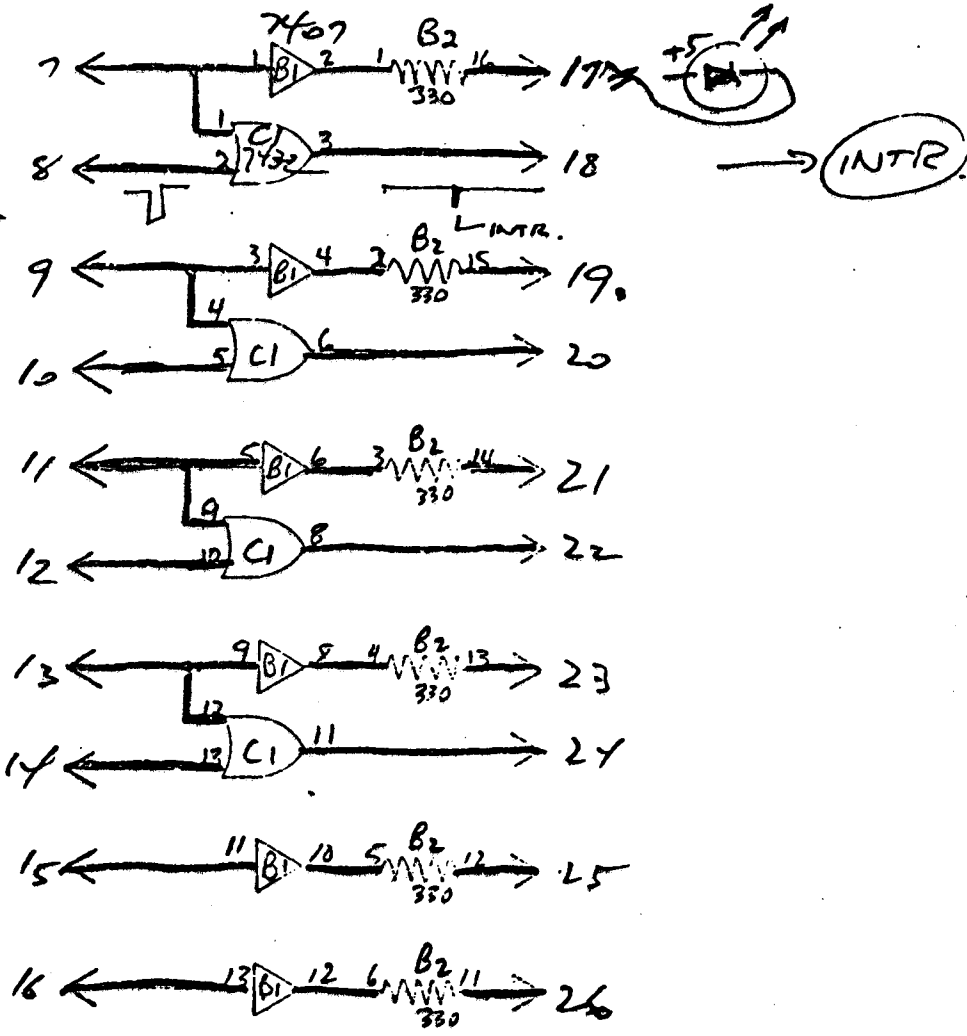


INTERRUPT GATING


1/16/63

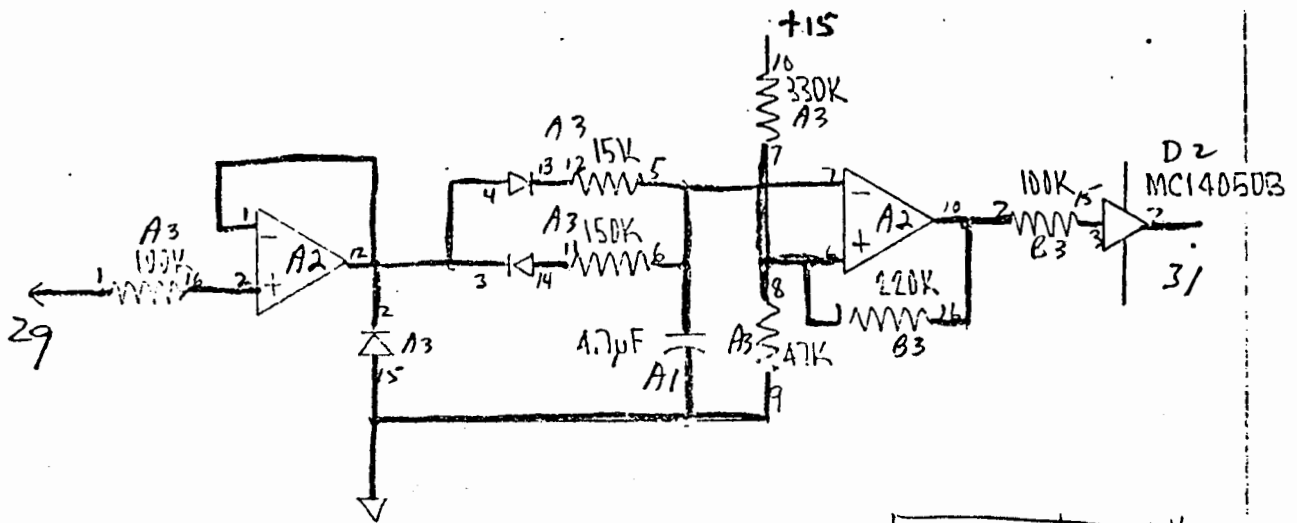

TP# 22

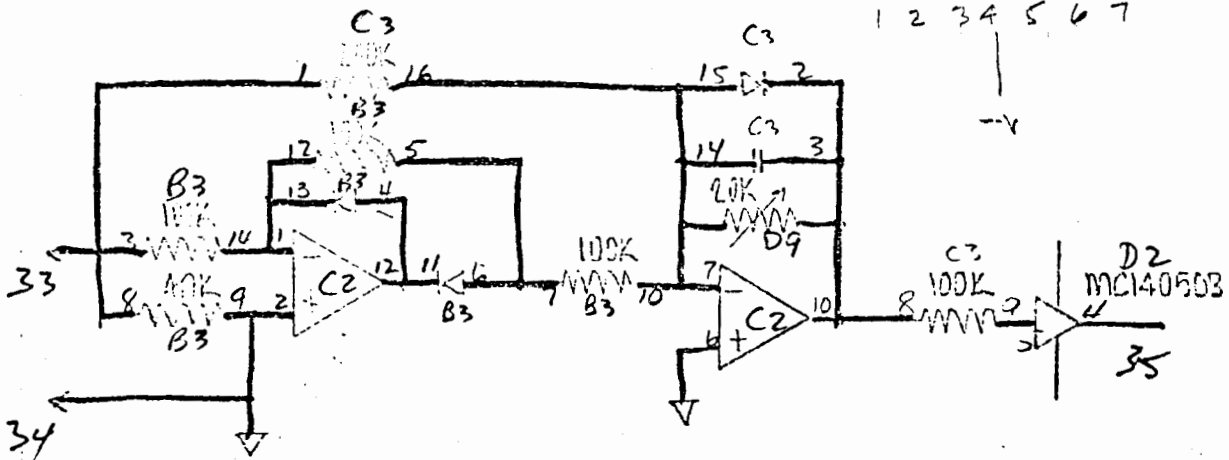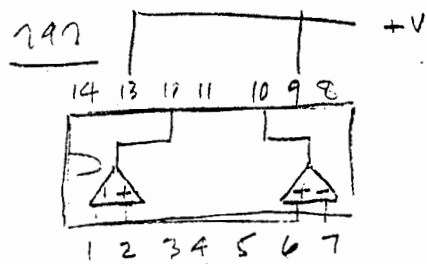

TP# 25

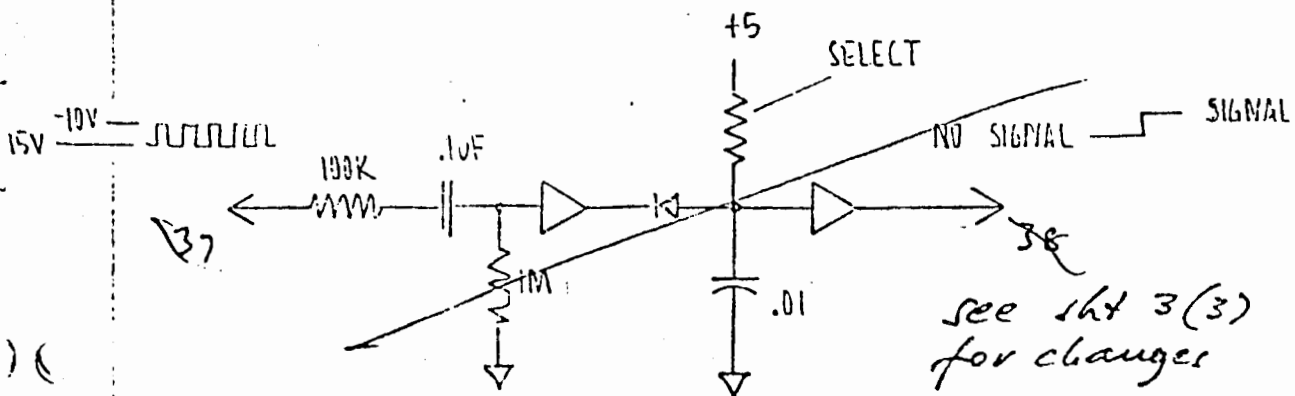


TP# 30

see sh 3(3)
for changes


MC 14050B

TP # 30

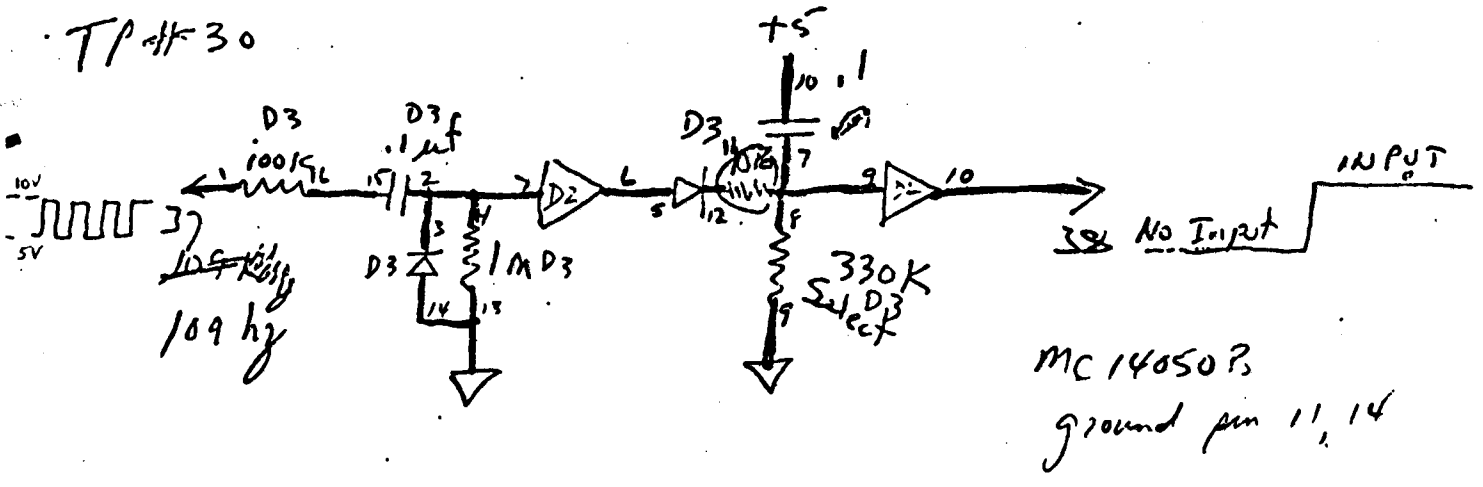


MC 14050B
ground pin 11, 14

+5
+15
-15
COM.

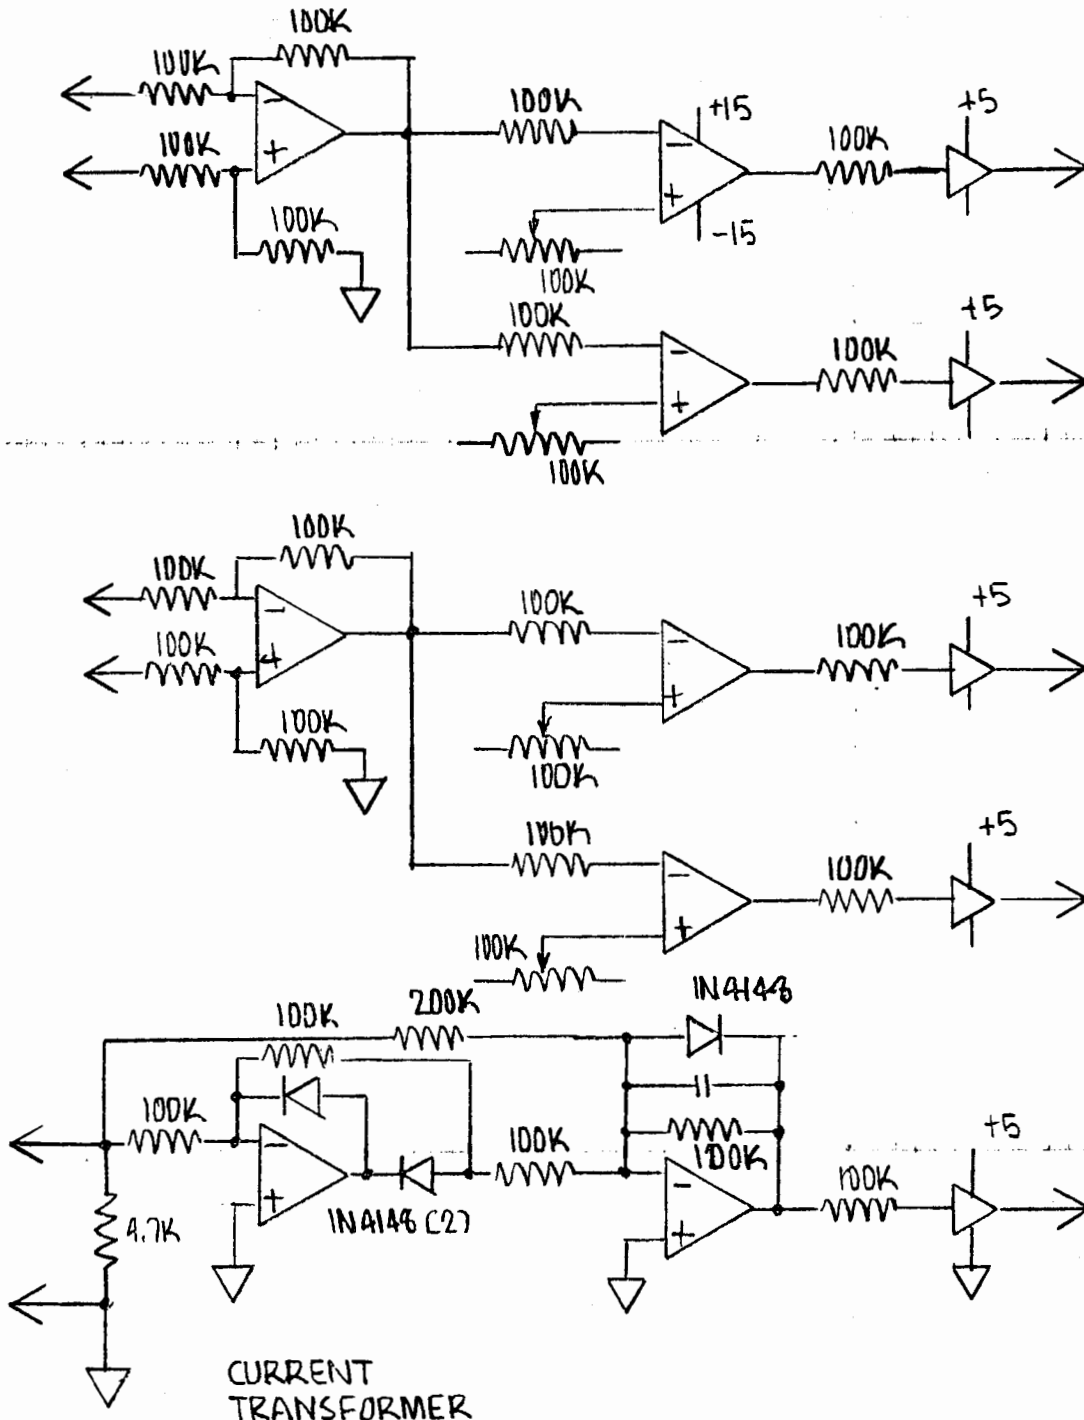

NOTE:
 ALL RESISTORS - 1/4W
 OP. AMPS 747
 BUFFERS MC14050B

| | | |
|----------------------------|-------------------------------|-------------|
| PORT OF SEATTLE COMMISSION | | DESIGN NO. |
| PROJECT | STS - VDAS | DRAWING NO. |
| TITLE | SPARE CHANNELS (CONTROL CARD) | |
| DRAWN BY | P. STUTZ | |
| DATE | 2/16/78 | APPROVED |

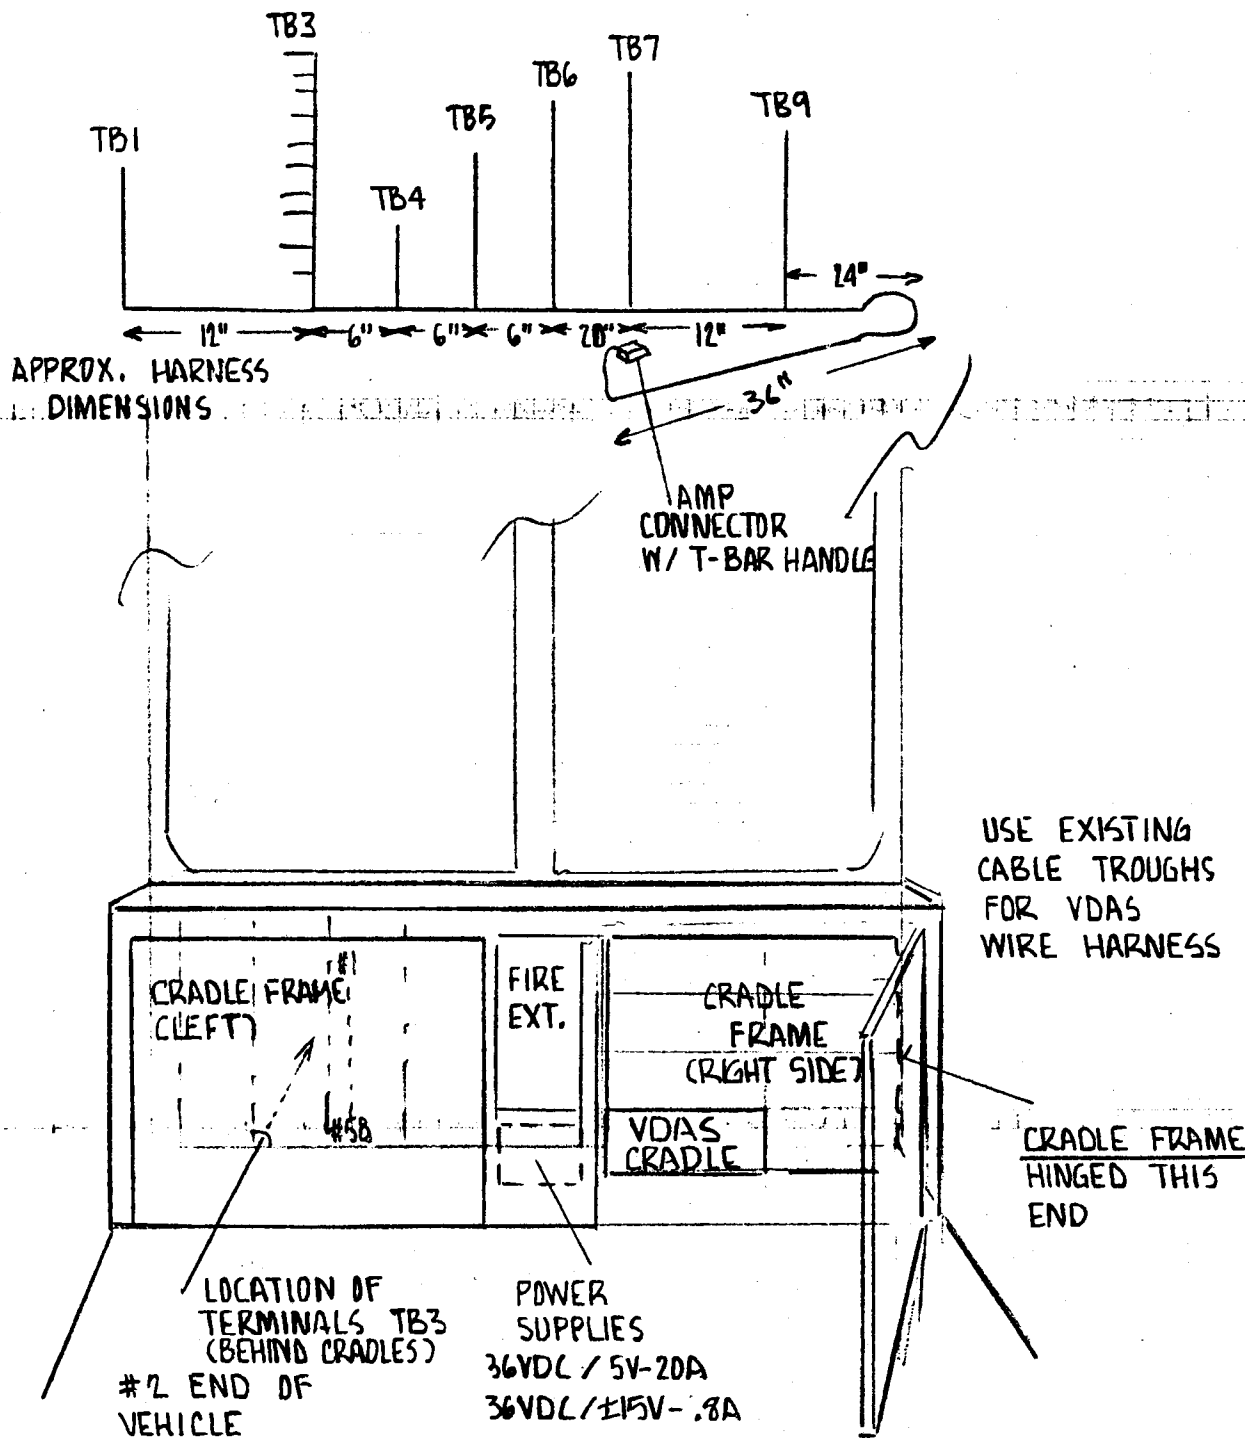

| | | |
|-----------------------------------|--------------------------------------|------------------------------|
| PORT OF SEATTLE COMMISSION | | DESIGN NO. |
| PROJECT | STS - VDAS | DRAWING NO. SK 711-1 (67) |
| TITLE | LOCATION OF VDAS IN VEHICLE (#2 END) | |
| DRAWN BY | P. STUTZ | DATE |
| | | 11-29-77 |
| | | APPROVED |

| TESTPOINT # | TERMINAL # | CRADLE CONN. | |
|-------------|------------|--------------|-------------|
| 1 | TB5-46 | J1-1 | |
| 2 | TB4-54 | J1-2 | |
| 3 | TB4-55 | J1-3 | |
| 4 | TB3-1 | J1-4 | |
| 5 | TB5-21 | J1-5 | |
| 6 | TB5-8 | J1-34 | |
| 7 | TB7-3 | J1-6 | |
| 8 | TB1-34 | J1-30 | |
| 9 | TB3-12 | J1-31 | |
| 10 | TB3-14 | J1-35 | |
| 11 | TB5-19 | J1-36 | |
| 12 | TB3-3 | J1-7 | |
| 13 | TB3-4 | J1-8 | |
| 14 | TB3-5 | J1-9 | |
| 15 | TB3-6 | J1-10 | |
| 16 | TB5-37 | J1-68 | } * |
| (B/P COM) | TB5-38 | J1-69 | |
| 17 | TB3-15 | J1-70 | } * |
| (B/P COM) | TB5-38 | J1-71 | |
| 18 | TB4-11 | J1-73 | } * |
| (T/C COM) | TB4-12 | J1-74 | |
| 19 | TB1-11 | J1-75 | } * |
| | TB5-38 | J1-76 | |
| 20 | TB1-53 | J1-42 | } * |
| | TB1-51 | J1-43 | |
| 21 | TB1-55 | J1-44 | } * |
| | TB1-57 | J1-45 | |
| 22 | TB3-8 | J1-11 | |
| 23 | TB3-16 | J1-57 | |
| 24 | TB4-7 | J1-32 | |
| 25 | TB3-18 | J1-47 | } * |
| 26 | TB3-19 | J1-48 | |
| 27 | TB9-39 | J1-12 | |
| 28 | TB6-44 | J1-13 | |
| 29 | TB5-24 | J1-14 | |
| 30 | TB6-45 | J1-15 | |
| 31 | TB3-21 | J1-58 | |
| 32 | TB3-24 | J1-61 | } COM J1-64 |
| 33 | TB3-25 | J1-62 | |
| 34 | TB3-26 | J1-63 | |
| | TB3-28 | J1-60 | |


* SHIELDED PAIR
SHIELD ONLY
TERMINATED
AT TB3

| | | |
|----------------------------|--------------------------------------|-------------|
| PORT OF SEATTLE COMMISSION | | DESIGN NO. |
| PROJECT | STS - VDAS - CAR WIRING | |
| TITLE | TERMINAL TO VDAS WIRING - TESTPOINTS | DRAWING NO. |
| DRAWN BY | P. STUTZ | SK 7711-26 |
| DATE | 11-29-77 | |
| APPROVED | | |

DESIGNATION
GND

TERMINAL
TB3-54

CRADLE CONN.

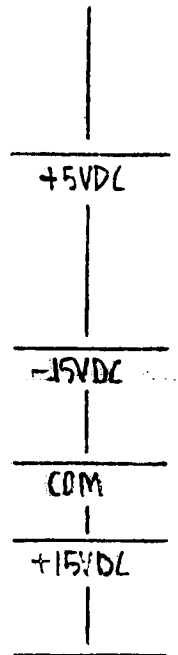

-55
-56
-57
-58
-46
-47
-48
-49
-50
-45
-44
-43
-42
-41
-40
-39
TB3-38

J1-39
J1-40
J1-52
J1-54
J1-55
J1-50
J1-51
J1-53
J1-66
J1-67
J1-95
J1-96
J1-97
J1-98
J1-99
J1-100
J1-101
J1-102

PORT OF SEATTLE COMMISSION

PROJECT STS - VDAS - CAR WIRING

TITLE TERMINAL TO VDAS WIRING - POWER

DRAWN BY P. STUTZ DATE 11-28-77 APPROVED _____

DESIGN NO. _____

DRAWING NO. SK 7711-3(6)

TERMINAL
TB3-

CRADLE CONNECTOR
J1-

| | |
|----|----|
| 2 | 19 |
| 7 | 20 |
| 9 | 21 |
| 10 | 22 |
| 11 | 23 |
| 13 | 25 |
| 15 | 26 |
| 17 | 27 |
| 20 | 30 |
| 22 | 31 |
| 27 | 32 |
| 28 | 33 |
| 29 | 34 |
| 30 | 35 |
| 31 | 36 |
| 32 | 37 |
| 33 | 38 |
| 34 | 39 |
| 35 | 40 |
| 36 | |
| 37 | |
| 38 | |
| 39 | |
| 40 | |

| | |
|----|----|
| 56 | 41 |
| 57 | 28 |
| 58 | 29 |

} GND

| | |
|----|----|
| 46 | 37 |
| 47 | 38 |
| 48 | 49 |

} +5VDC

PORT OF SEATTLE COMMISSION

PROJECT STS - VDAS - CAB WIRING

TITLE TERMINAL TO VDAS WIRING - SPARES, ETC.

DRAWN BY P. STUTZ DATE 11-24-77 APPROVED _____

DESIGN NO. _____

DRAWING NO. SK 7711-466

VEHICLE TERMINAL
BLOCK ASSIGNMENT

-#1 END -
TB 3

TESTPOINT
DESIGNATION

NOTE: "S" - SPARE

| | | | | | |
|--------|--------|----|----------|-----|---------------|
| J1-4 | | | 4 | "S" | SPARE |
| J1-7 | J1-19 | | 12 | -13 | |
| J1-9 | J1-8 | | 14 | 15 | |
| J1-20 | J1-10 | | "S" | 22 | SPARE |
| J1-21 | J1-11 | | "S" | "S" | SPARE |
| J1-23 | J1-22 | 10 | "S" | "S" | "S" |
| J1-25 | J1-31 | | "S" | 9 | |
| J1-26 | J1-35 | | "S" | 10 | |
| J1-27 | J1-57 | | "S" | 23 | |
| J1-48 | J1-47 | | 25 | 25 | (COM) SPARE |
| J1-58 | J1-80 | 20 | 30 | "S" | (COM) SPARE |
| J1-64 | J1-81 | | 31/32/33 | "S" | (COM) SPARE |
| J1-62 | J1-61 | | 32 | 31 | |
| J1-82 | J1-63 | | "S" | 33 | SPARE |
| J1-83 | J1-60 | | | 34 | |
| J1-85 | J1-84 | 30 | | | |
| J1-87 | J1-86 | | | | SPARES |
| J1-89 | J1-88 | | | | |
| J1-91 | J1-90 | | | | |
| J1-101 | J1-102 | | | | |
| J1-99 | J1-100 | 40 | | | +15VDC |
| J1-97 | J1-98 | | | | COM |
| J1-95 | J1-96 | | | | -15VDC |
| J1-51 | J1-50 | | | | |
| J1-66 | J1-53 | | | | +5VDC |
| N.C. | J1-67 | 50 | | | |
| N.C. | N.C. | | | | NOT CONNECTED |
| J1-AD | J1-39 | | | | |
| J1-54 | J1-52 | | | | |
| | J1-55 | 58 | | | GND |

PORT OF SEATTLE COMMISSION

PROJECT STS-VDAS -


DESIGN NO.

TITLE VEHICLE TERMINAL BLOCK ASSIGNMENT

DRAWING NO.

DRAWN BY P. STUTZ DATE 11-28-77 APPROVED

SK 7711-5 (67)

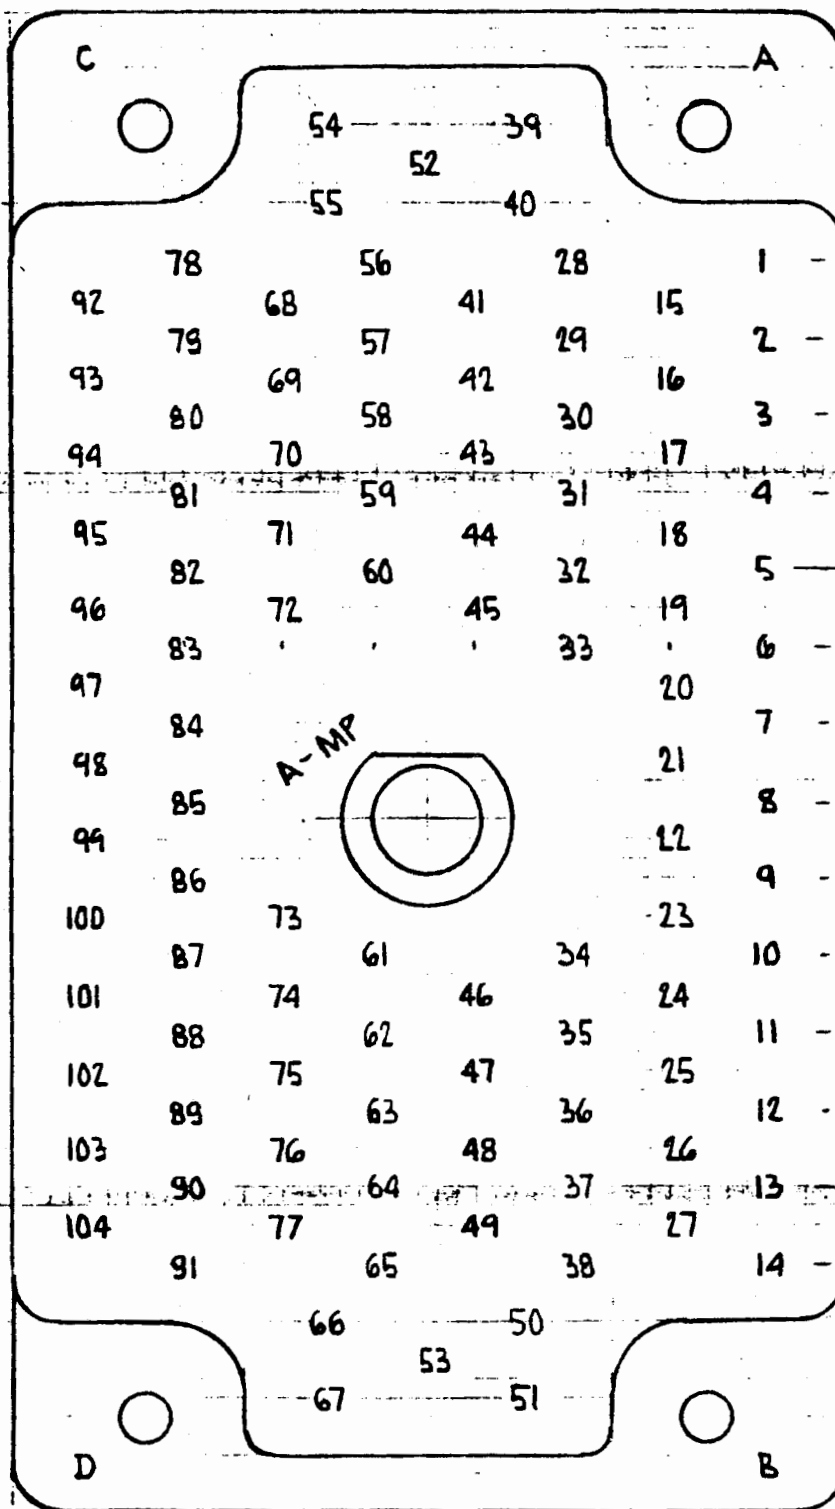

VIEW TOWARDS
CRADLE CONNECTOR
PINS.

CRADLE WIRING
TO BE AT REAR,
WIRE WRAP

| | | |
|-------------------------------------------------------|-------------------------------------|-------------|
| PORT OF SEATTLE COMMISSION | | DESIGN NO. |
| PROJECT <u>STS - VDA'S - CRADLE CHASSIS CONNECTOR</u> | | |
| TITLE <u>PIN NUMBERS</u> | | DRAWING NO. |
| DRAWN BY <u>P. STUTZ</u> | DATE <u>11-22-77</u> APPROVED _____ | |

REGULATOR +12VDC
 REGULATOR -5VDC
 RESET BUTTON

VDAS CUSTOM
 INTERFACE

| | | |
|--------|----------------------|----|
| | AMP CONN. 104 PIN | 32 |
| | | 31 |
| | | 30 |
| | | 29 |
| | | 28 |
| | FRONT PANEL I/O | 27 |
| | | 26 |
| | INTERCONNECT | 25 |
| | | 24 |
| | | 23 |
| 9005 | SPARE | 22 |
| | | 21 |
| | | 20 |
| 9004 | CONTROL | 19 |
| | | 18 |
| | | 17 |
| 9003 | OP. AMP | 16 |
| | | 15 |
| | | 14 |
| 9002 | CMOS INPUT | 13 |
| | | 12 |
| | | 11 |
| 9001 | 36V INPUT | 10 |
| | | 9 |
| 8113-1 | 28 BIT INPUT/OUTPUT | 8 |
| 8114 | 32 BIT INPUT | 7 |
| 8118-1 | PRIORITY INTERRUPT | 6 |
| 8821 | CPU 8080 | 5 |
| 8119 | 16K MEMORY | 4 |
| 8119 | 16K MEMORY | 3 |
| 8119 | 16K MEMORY | 2 |
| 8119 | 16K MEMORY | 1 |

AMP CONNECTOR
 CTD WESTINGHOUSE
 TERMINAL BLOCKS
 CONNECTOR FACES TO
REAR!

FRONT VIEW

TOP LEFT


BOTTOM LEFT

PORT OF SEATTLE COMMISSION
 PROJECT STS - VDAS - VEHICLE CARD CAGE
 TITLE ASSEMBLY DETAILS FRONT VIEW
 DRAWN BY P. STUTZ DATE 11-16-77 APPROVED

DESIGN NO.
 DRAWING NO.

| | | |
|----|--------|---------------------|
| 1 | 8119 | 16K MEMORY |
| 2 | 8119 | 16K MEMORY |
| 3 | 8119 | 16K MEMORY |
| 4 | 8119 | 16K MEMORY |
| 5 | 8821 | 8080 CPU |
| 6 | 8118 | PRIORITY INTERRUPT |
| 7 | 8114 | 32 BIT INPUT |
| 8 | 8113-1 | 24 BIT INPUT/OUTPUT |
| 9 | | |
| 10 | 9001 | 36V INPUT |
| 11 | | |
| 12 | | |
| 13 | 9002 | CMOS INPUT |
| 14 | | |
| 15 | | |
| 16 | 9003 | OP. AMP |
| 17 | | |
| 18 | | |
| 19 | 9004 | CONTROL |
| 20 | | |
| 21 | | |
| 22 | 9005 | SPARE |
| 23 | | |
| 24 | | |
| 25 | | INTERCONNECT |
| 26 | | |
| 27 | | FRONT PANEL I/O |
| 28 | | FRONT PANEL |
| 29 | | FUSES |
| 30 | | INDICATOR LIGHTS |
| 31 | | PUSH BUTTONS |
| 32 | | |


AMP CONN.

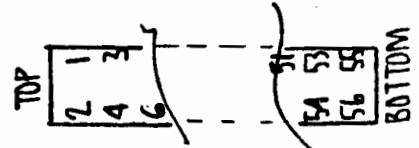

SOCKET PIN
NUMBER
ASSIGNMENT
REAR VIEW
(TYPICAL)

REAR VIEW
WIRE WRAP PLANE

| | | |
|---|--|---------------------------------------|
| PROJECT <u>STS - VDRS - VEHICLE CARD CAGE</u> TITLE <u>ASSEMBLY DETAILS - REAR VIEW</u> DRAWN BY <u>P. STUTZ</u> DATE <u>11-16-77</u> APPROVED _____ | | DESIGN NO. _____ DRAWING NO. _____ |
|---|--|---------------------------------------|

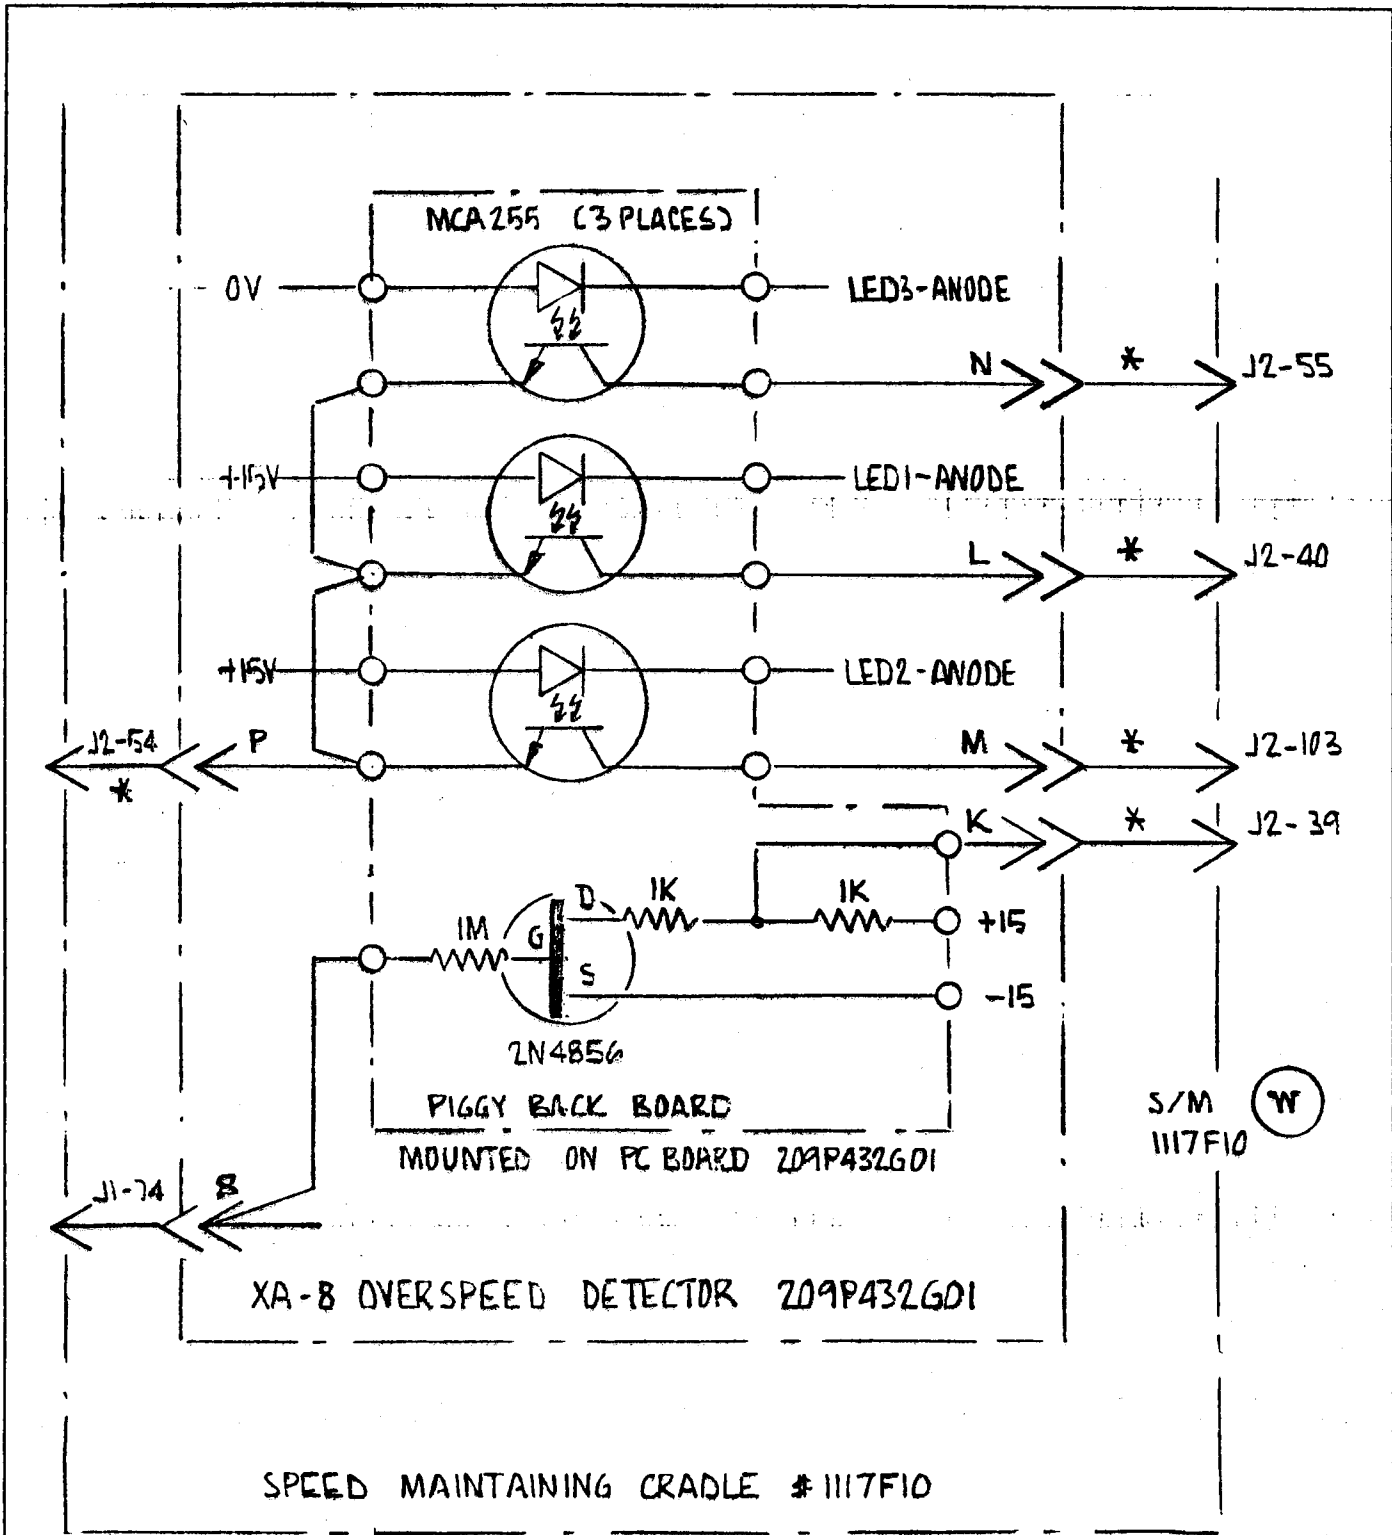

NOTE:
* - ADD TO CRADLE WIRING

REF: TESTPOINT DEFINITIONS-REVA -12/9/77

PORT OF SEATTLE COMMISSION

PROJECT STS-VDAS

TITLE PIGGY BACK BOARD TO OVERSPD. DET # 209P432G01


DRAWN BY P. STUTZ DATE 2/7/78 APPROVED _____


DESIGN NO. _____


DRAWING NO. _____



APPENDIX C


VDAS Data Handler & Data Analysis Software Listings

 

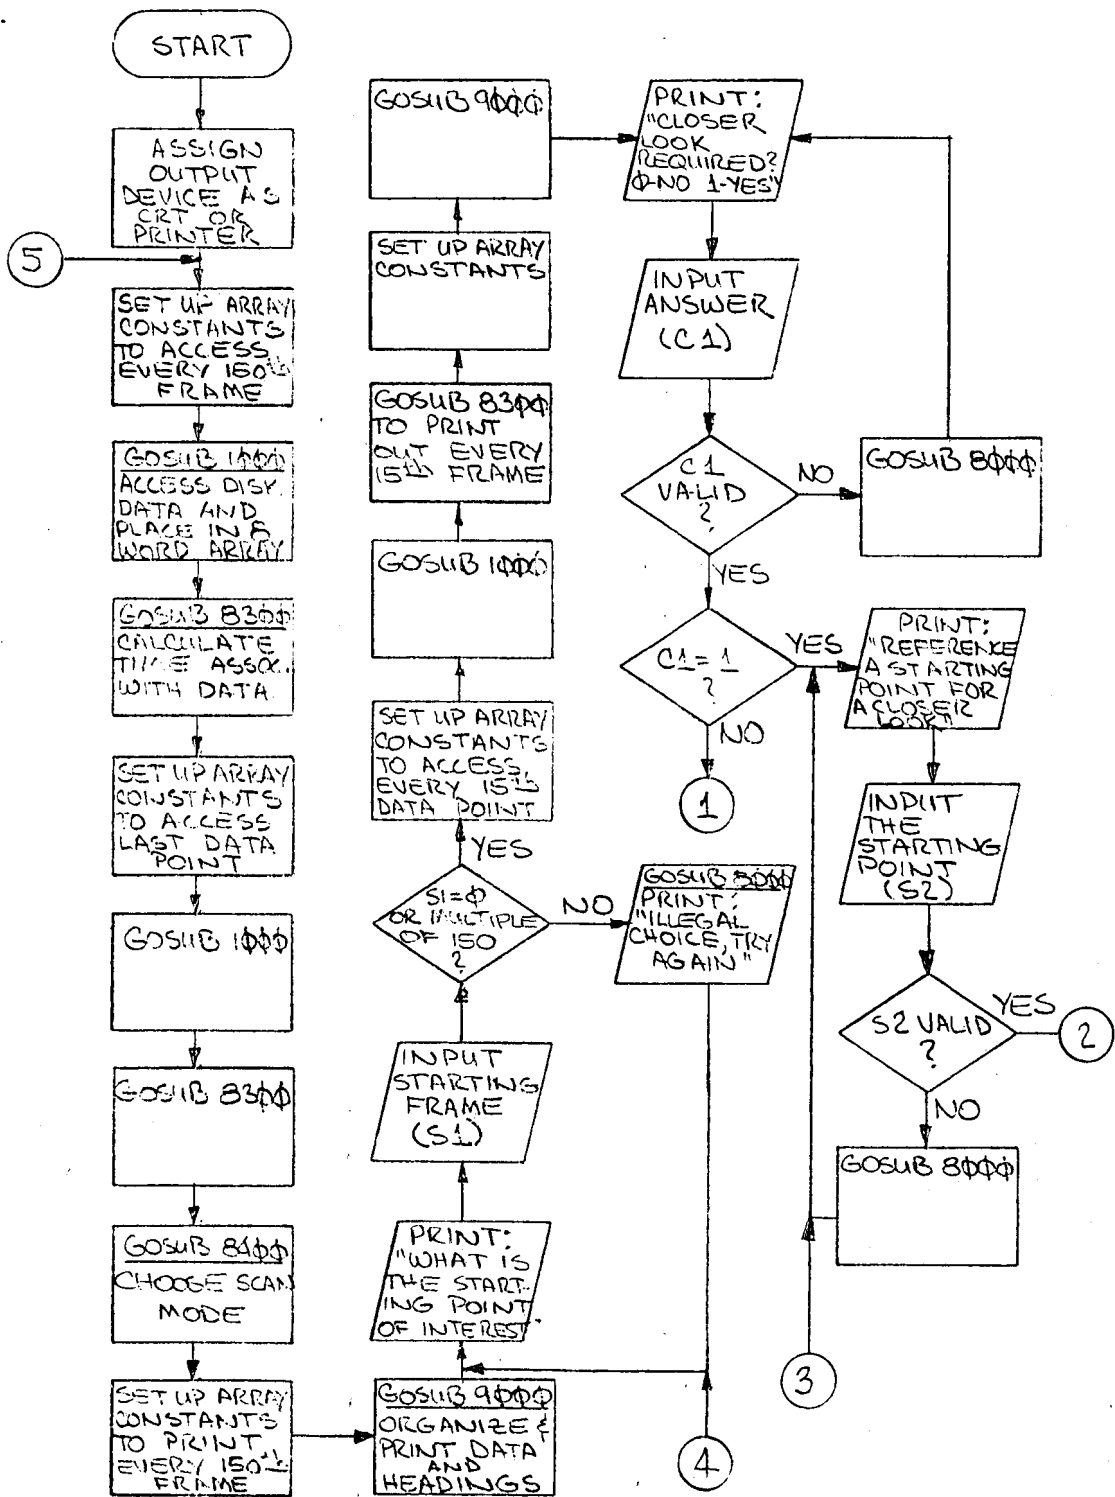

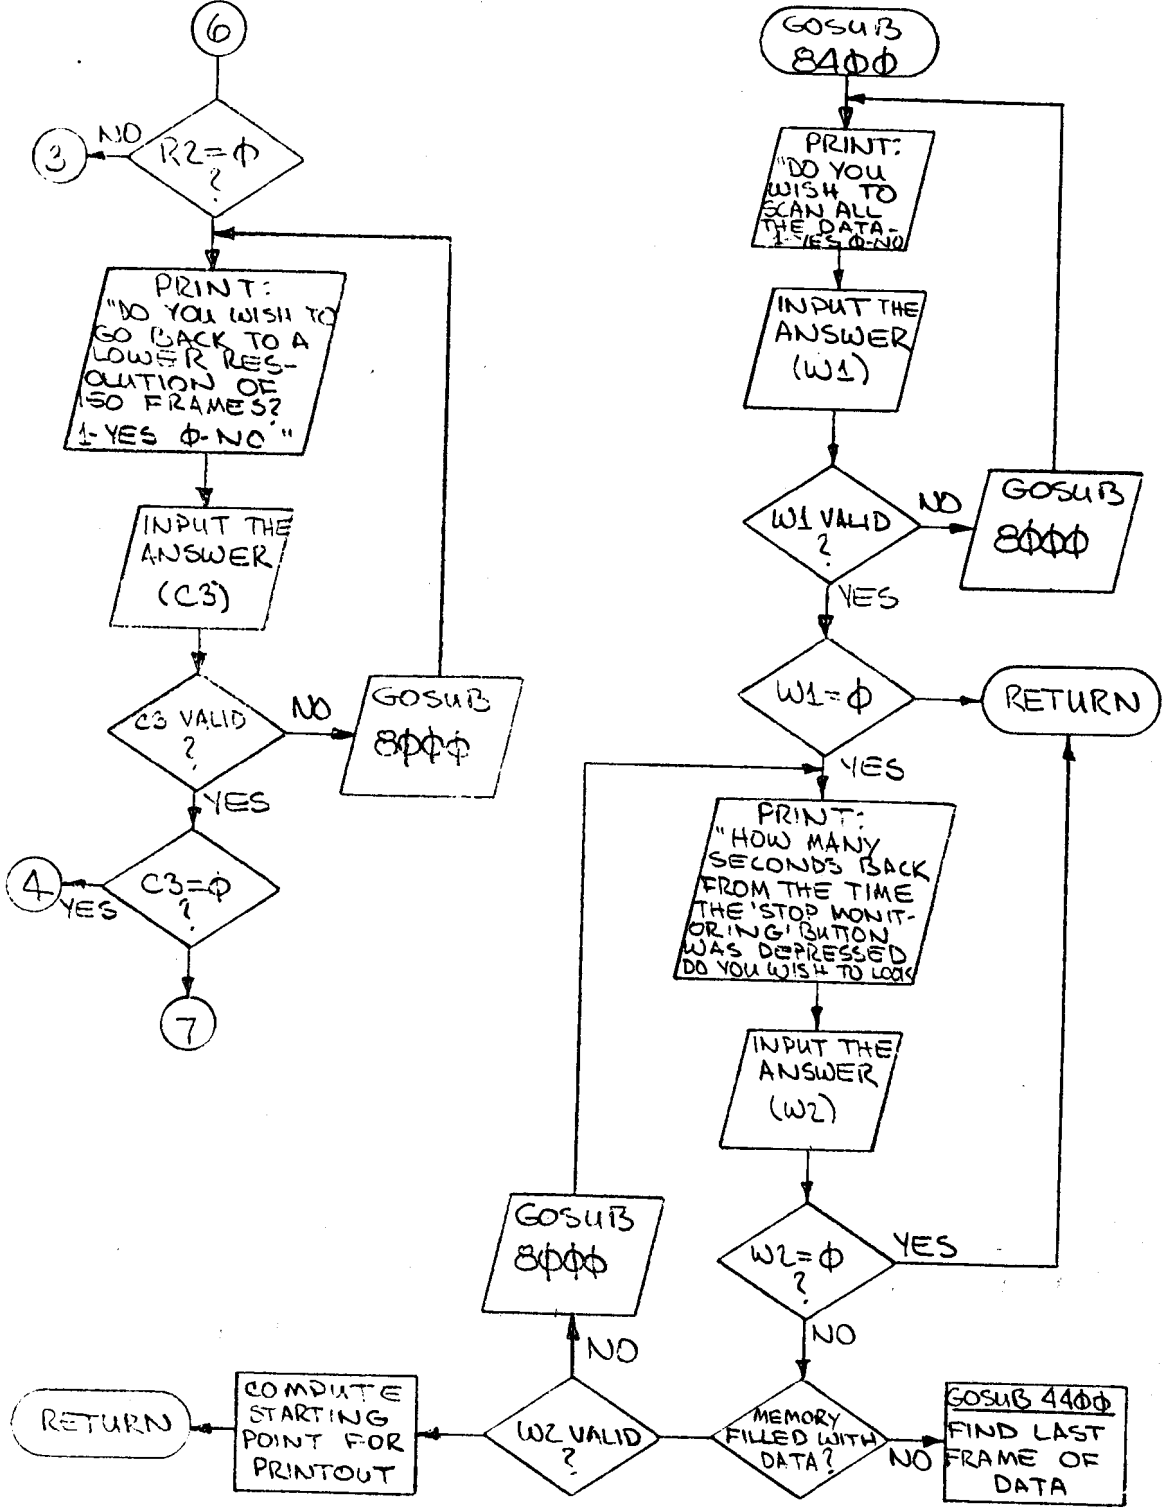

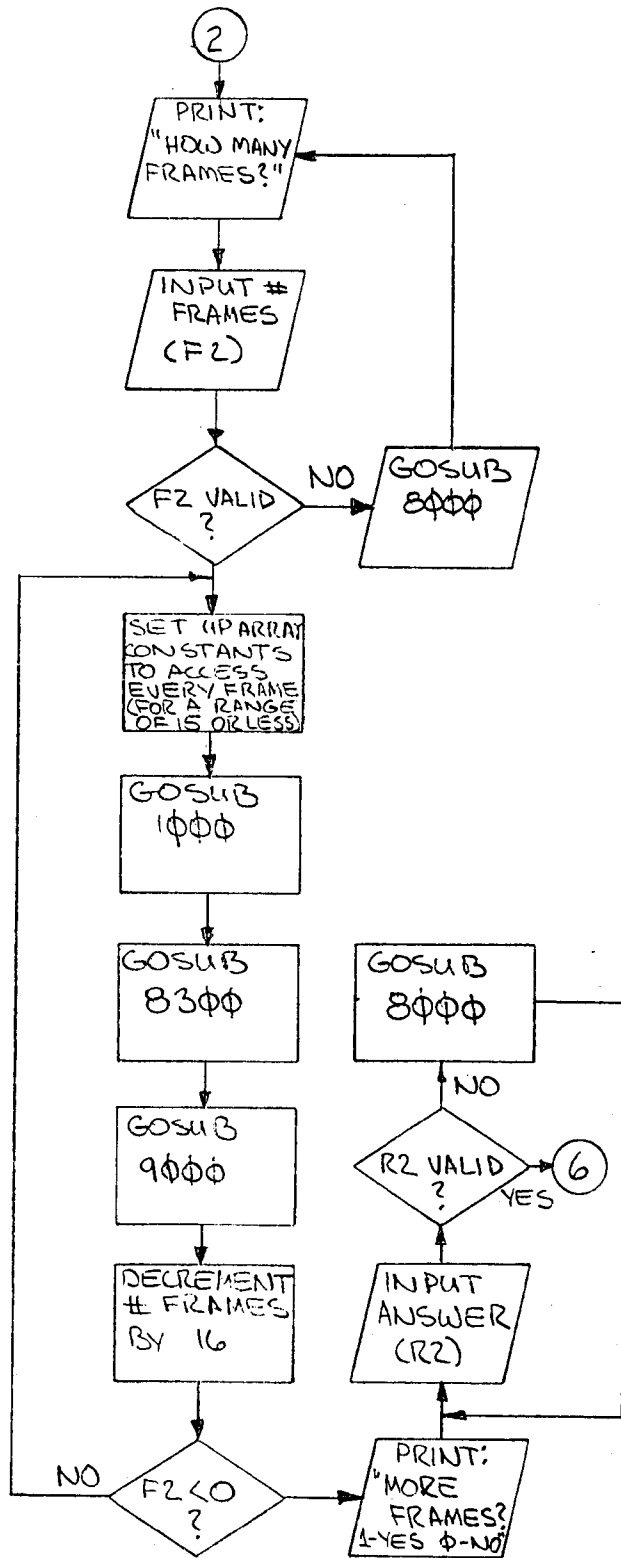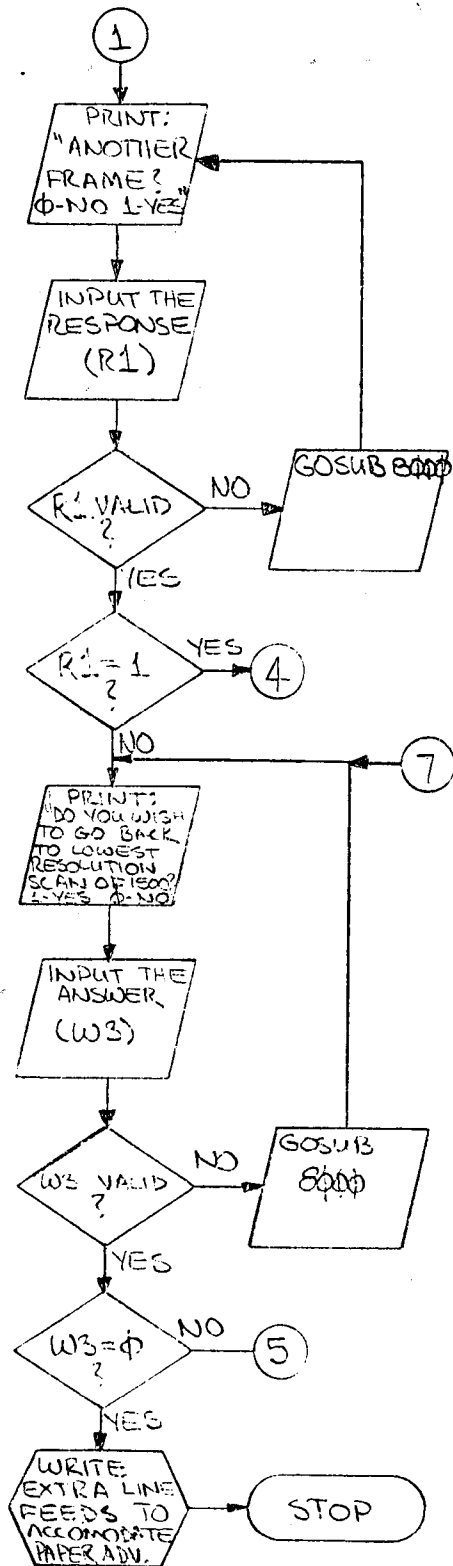

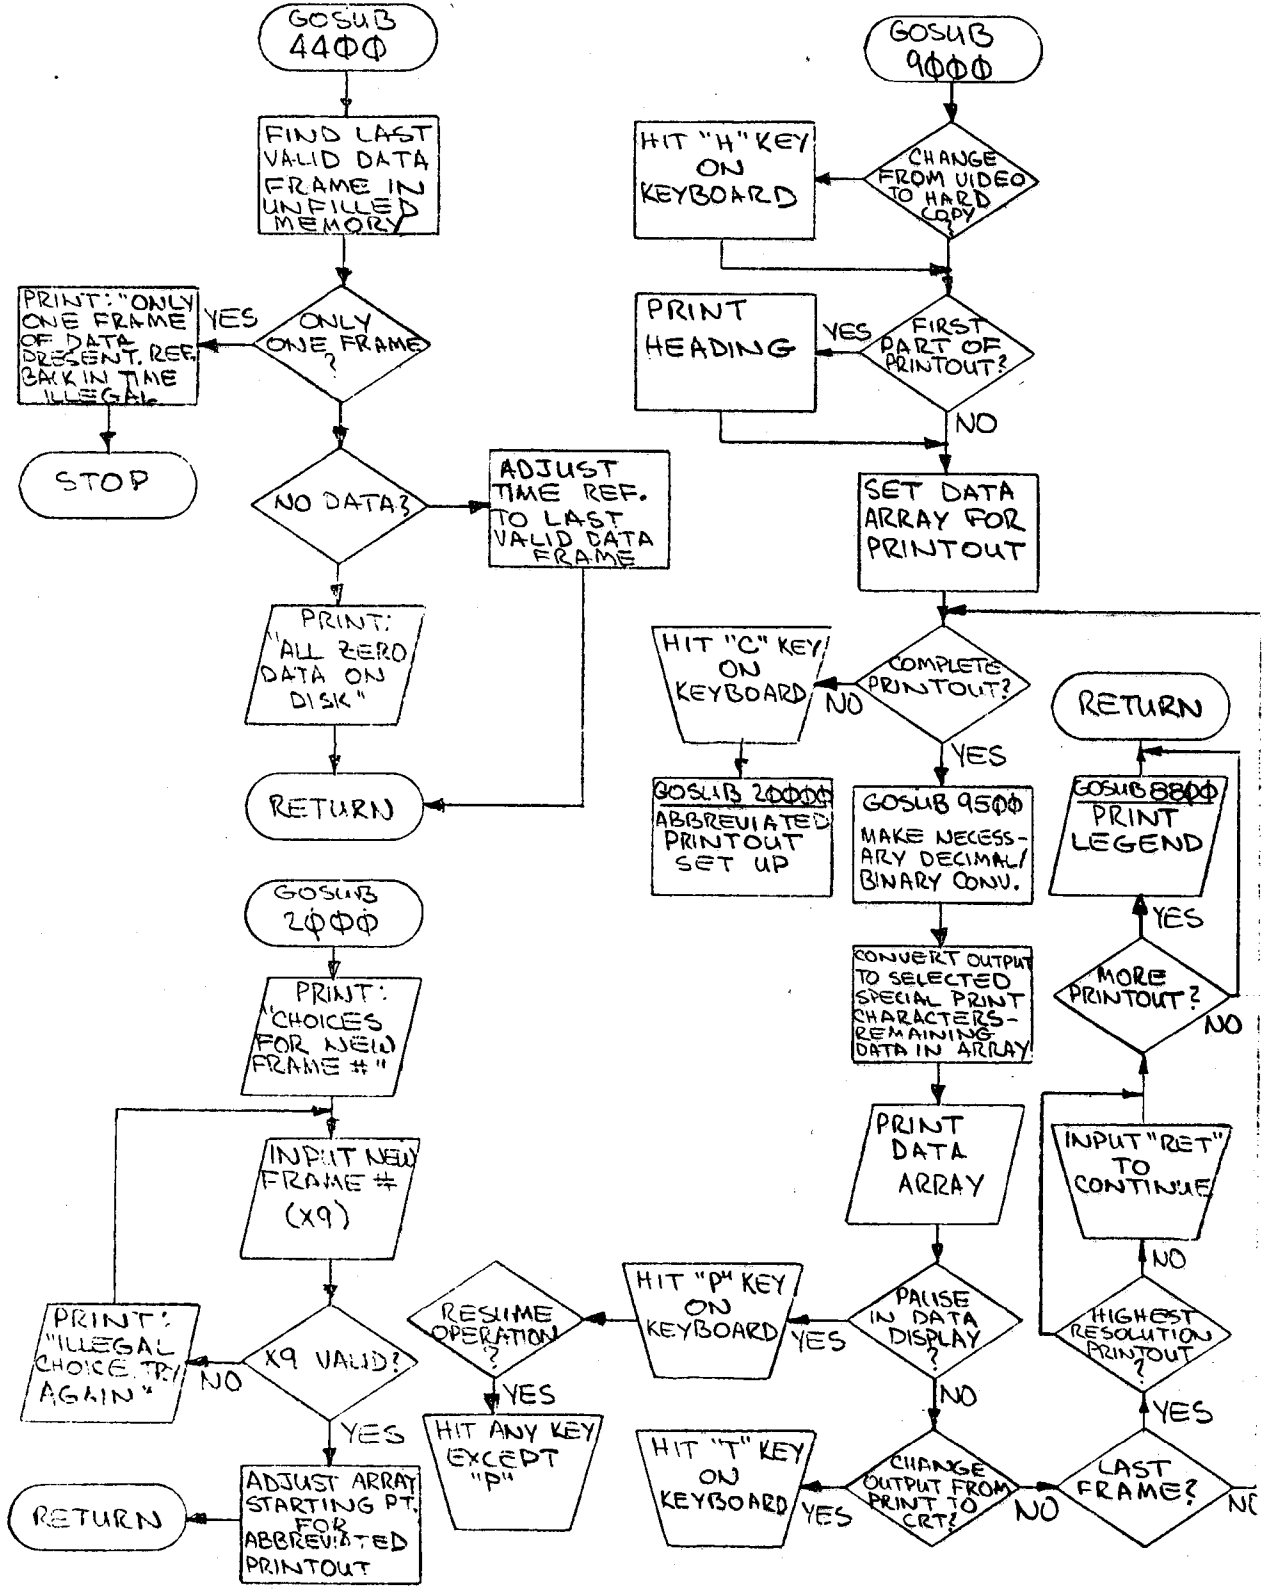

```

1 REM... THIS PROGRAM PUTS TRAIN DATA INTO
2 REM... A MEANINGFUL FORMAT FOR ANALYSIS
3 REM... 1 JUNE 78
5 REM... D1 IS THE DATA DISPLAY VARIABLE
6 INPUT "TYPE 1 FOR HARD COPY 0 FOR CRT? ",D1
7 REM... IF ANSWER ILLEGAL, SAY SO, GO BACK & GET VALID ANSWER
8 IF D1<0 OR D1>1 THEN GOSUB 8000\IF D1<0 OR D1>1 THEN 6
9 LINE #0,80 \ LINE #1,80
10 REM... INITIALIZE ARRAY STARTING POINTER
11 K1=0
15 DIM D(50,8),O(50),P*(20),P(40),N(50),T(50)
16 REM... D2 IS THE PROGRAMMING DECISION DISPLAY VARIABLE
19 D2=0
20 REM... ASSIGN DISPLAY VARIABLE VALUES AS FOLLOWS ,
21 REM... 0-CRT,1-SERIAL OUTPUT,2-PARALLEL OUTPUT,
22 REM... 3-CUSTOM OUTPUT
23 REM*****INPUT EVERY 150TH FRAME OF DATA FROM DISK*****
24 OPEN #0,"TDATA"
25 X1=1200
27 REM... SET ABBREVIATED DISPLAY VARIABLE FOR LOWEST RESOLUTION
28 S7=1
30 FOR I1=0 TO 56400 STEP X1
40 J=I1/X1
45 N(J)=I1/8
46 GOSUB 1000
48 REM... CALCULATE TIMES
49 GOSUB 8300
50 NEXT I1
53 I1=57336
55 J=48
56 N(J)=I1/8
62 GOSUB 1000
63 REM... CALCULATE TIMES
65 CLOSE #0
67 GOSUB 8300
68 REM REM... CHOOSE SCAN MODE
69 GOSUB 8400
70 L1=48
72 L2=1
73 REM... IF FULL SCAN IS DESIRED, SET ARRAY ACCORDINGLY
74 IF K1=0 THEN B1=0
75 REM***PRINT OUT TEST POINT DATA AT EVERY 150TH FRAME***
80 GOSUB 9000
90 REM... NOW TAKE A CLOSER LOOK AT THE DATA
100 REM... FIRST PICK A STARTING POINT
110 ! #D2,"WHAT IS THE STARTING POINT OF INTEREST?"
120 ! #D2,"... PICK A DATA POINT NUMBER OFF PRINTOUT"
121 ! #D2,"VALID CHOICES ARE:0,150,300,450,600,750,900,1050,"
122 ! #D2,"1200,1350,1500,1650,1800,1950,2100,2250,2400,2550,"
123 ! #D2,"2700,2850,3000,3150,3300,3450,3600,3750,3900,4050,"
124 ! #D2,"4200,4350,4500,4650,4800,4950,5100,5250,5400,5550,"
125 ! #D2,"5700,5850,6000,6150,6300,6450,6600,6750,6900,&7050"
126 ! #D2,
130 INPUT S1
135 U1=S1
136 REM... CHECK FRAME NUMBER FOR VALIDITY
138 IF U1=0 THEN 160
139 REM... IF TOO LARGE, SAY SO, GO BACK & GET A NEW NUMBER
140 IF U1>7050 THEN GOSUB 8000
141 IF U1>7050 THEN 100
142 U1=U1-150
144 IF U1=0 THEN 160
145 REM... IF NO MULTIPLE OF 150, SAY SO, GO BACK & GET ONE THAT IS
146 IF U1<0 THEN GOSUB 8000
148 IF U1<0 THEN 100

```

```

149 GOTO 142
150 GOSUB 8000
155 GOTO 100
160 REM***** NOW, INPUT EVERY 15TH FRAME OF DATA FROM DISK****
170 OPEN #0, "TDATA"
175 S0=S1*8
177 REM... SET ABBREVIATED PRINT VARIABLE FOR MEDIUM RESOLUTION
178 S7=2
180 IF S0>=56400 THEN X4=935
190 IF S0<56400 THEN X4=1200
195 X2=120
200 FOR I1=S0 TO S0+X4 STEP X2
205 J=(I1-S0)/X2
210 N(J)=I1/8
220 GOSUB 1000
221 REM... CALCULATE TIMES
222 GOSUB 8300
223 NEXT I1
226 CLOSE #0
227 IF X4>1100 THEN X5=10
230 IF X4<1100 THEN X5=7
335 L1=X5
338 L2=1
340 B1=0
355 REM***PRINT OUT TEST POINT DATA FOR EVERY 15TH DATA POINT***
360 GOSUB 9000
370 ! #D2,
400 ! #D2, "CLOSER LOOK REQUIRED?"
410 ! #D2, "0-NO,1-YES"
420 INPUT C1
425 IF C1=0 OR C1=1 THEN 440
428 REM... IF ANSWER ILLEGAL, SAY SO, GO BACK & GET VALID ANSWER
430 GOSUB 8000
435 GOTO 400
438 REM... IF CLOSER LOOK NOT WANTED, CONSIDER MORE PRINTOUT...
439 REM..... AT THIS RESOLUTION.
440 IF C1=0 THEN PRINT #D2, "ANOTHER FRAME?"
450 IF C1=0 THEN PRINT #D2, "0-NO,1-YES"
452 REM... IF CLOSER LOOK WANTED, CONTINUE ON.....
455 IF C1=1 THEN 500
465 INPUT R1
470 IF R1=1 OR R1=0 THEN 480
472 REM... IF ANSWER ILLEGAL, SAY SO, GO BACK & GET VALID ANSWER
474 GOSUB 8000
477 GOTO 440
478 REM... IF MORE PRINTOUT NOT WANTED AT THIS RESOLUTION...
479 REM..... CONSIDER A LOWER RESOLUTION PRINTOUT
480 IF R1=0 THEN 730
482 REM... IF MORE PRINTOUT WANTED AT THIS RESOLUTION....
483 REM..... GO BACK AND GET IT.
490 IF R1=1 THEN 100
500 IF X4<1100 THEN X8=(X4+1)/8
502 IF X4>1100 THEN X8=X4/8
504 REM... INITIALIZE HEADING & LEGEND PRINT VARIABLE
505 K4=1
509 ! #D2, "REFERENCE A STARTING POINT FOR A CLOSER LOOK"
512 INPUT S2
514 IF S2<7153 THEN L3=15
515 IF S2>=7153 THEN L3=7167-S2
523 S4=S2*8
525 IF S2<0 OR S2>7167 THEN 540
528 IF K4>1 THEN 552
530 ! #D2, "HOW MANY FRAMES?"
531 ! #D2, "(IF STARTING FRAME)=7152, NUMBER OF FRAMES"
532 ! #D2, "WILL BE PREDETERMINED AND RUN THRU LAST FRAME."

```

```

533 IF S2<7167 THEN 532
534 INPUT F2
535 IF S2+F2>7167 THEN ! #D2,"TOO MANY FRAMES FOR SELECTED"
536 IF S2+F2>7167 THEN ! #D2,"STARTING POINT."
537 IF S2+F2<=7167 THEN 552
538 REM... IF TOO MANY FRAMES OR ILLEGAL STARTING POINT SELECTED.
539 REM..... SAY SO, GO BACK AND GET VALID INFORMATION
540 GOSUB 8000
550 GOTO 500
551 REM... SET ARRAY LENGTH AND SAMPLE RATE
552 IF S4<57224 THEN X7=120
553 IF S4>=57224 THEN X7=57336-S4
554 IF S4=57216 THEN F2=15
556 IF S4>=57224 THEN F2=(57336-S4)/8
557 K4=K4+1
558 X3=8
559 B1=0
560 REM... IF LESS THAN 15 FRAMES REMAIN, SET ARRAY ACCORDINGLY.
561 L1=L3\IF F2<15 THEN L1=F2
562 L2=1
563 REM*****INPUT EACH FRAME OF DATA FROM DISK*****
564 OPEN #0,"TDATA"
565 FOR I1=54 TO S4+X7 STEP X3
567 J=(I1-54)/X3
569 N(J)=I1/8
572 GOSUB 1000
575 REM... CALCULATE TIMES
576 GOSUB 8300
580 NEXT I1
590 CLOSE #0
595 REM... SET ABBREVIATED PRINT DISPLAY FOR HIGHEST RESOLUTION
598 S7=3
599 REM*****PRINT OUT TEST POINT DATA FOR EACH FRAME*****
600 GOSUB 9000
605 REM... ADJUST NUMBER OF FRAMES AND STARTING POINT.....
606 REM..... TO PRINT OUT MORE DATA
610 F2=F2-16
611 S2=S2+16
612 REM... IF FRAMES ALL PRINTED, CONTINUE ON.....
614 IF F2=0 THEN 620
615 REM... IF NOT, GO BACK AND DO MORE
618 IF F2>0 THEN 514
620 ! #D2,"MORE FRAMES?"
630 ! #D2,"0-NO, 1-YES"
640 INPUT R2
645 IF R2=0 OR R2=1 THEN GOTO 680
648 REM... IF ANSWER ILLEGAL, SAY SO, GO BACK & GET VALID ANSWER
650 GOSUB 8000
655 GOTO 620
670 REM... IF MORE FRAMES ARE TO BE PRINTED, GO BACK AND DO IT
680 IF R2=1 THEN 500
685 REM... IF NOT, CONSIDER LOWER RESOLUTION SCAN
690 ! #D2,"DO YOU WISH TO GO BACK TO A LOWER RESOLUTION SCAN"
695 ! #D2,"OF 15 FRAMES?"
700 ! #D2,"1-YES, 0-NO"
705 INPUT C3
707 REM... IF ANSWER ILLEGAL, SAY SO, GO BACK & GET VALID ANSWER
710 IF C3<0 OR C3>1 THEN GOSUB 8000
712 IF C3<0 OR C3>1 THEN 690
715 REM... IF LOWER RESOLUTION SCAN WANTED, GO BACK.....
720 IF C3=1 THEN 100
725 REM... IF NOT, CONSIDER LOWEST RESOLUTION SCAN
730 IF C3=0 THEN ! #D2,"DO YOU WISH TO GO BACK TO LOWEST"
735 IF C3=0 THEN ! #D2,"RESOLUTION SCAN OF 150 FRAMES."
740 IF C3=0 THEN ! #D2,"1-YES, 0-NO"

```

```

750 IF W3=0 THEN INPUT W3
752 REM... IF ANSWER ILLEGAL, SAY SO, GO BACK & GET VALID ANSWER
755 IF W3<0 OR W3>1 THEN GOSUB 8000
757 IF W3<0 OR W3>1 THEN 730
760 IF W3=1 THEN GOTO 24
995 REM... DO LINE FEEDS BEFORE EXITING PROGRAM
999 GOTO 30000
1000 REM... READ & DISPLAY INCOMING DATA
1010 READ #0 %I1, &D(J,1), &D(J,2), &D(J,3), &D(J,4)
1020 READ #0 %I1+4, &D(J,5), &D(J,6), &D(J,7), &D(J,8)
1030 ! #D2,
1040 ! #D2, D(J,1), D(J,2), D(J,3), D(J,4), D(J,5), D(J,6), D(J,7), D(J,8)
1050 RETURN
4400 REM*****NON-WRAPAROUND ROUTINE*****
4401 REM... SET NON-WRAPAROUND VARIABLE
4402 K6=1
4405 FOR J=48 TO 0 STEP -1
4410 IF D(J,1)+ D(J,2)+D(J,3)+ D(J,4)<>0 THEN 4416
4415 IF D(J,5)+ D(J,6)+ D(J,7)+ D(J,8)=0 THEN 4425
4416 IF J=0 THEN ! " CONTINUE PROGRAM BY TYPING 'CONT'"
4417 IF J=0 THEN ! "ONLY ONE FRAME OF DATA PRESENT !"
4418 IF J=0 THEN ! "REFERENCE BACK IN TIME ILLEGAL !"
4419 IF J=0 THEN K5=1
4420 IF J=0 THEN STOP
4421 IF J=0 THEN RETURN
4422 IF J=0 THEN RETURN
4423 T(48)=T(J)
4424 RETURN
4425 NEXT J
4430 ! #D2, "ALL ZERO DATA ON DISK"
4435 RETURN
8000 REM*****INVALID ENTRY ROUTINE*****
8005 ! #D2,
8010 ! #D2, "ILLEGAL CHOICE, TRY AGAIN"
8015 ! #D2,
8020 RETURN
8300 REM*****TIME CALCULATION*****
8310 T1=256*D(J,1)
8320 T(J)=(T1+D(J,2))/10
8330 RETURN
8400 REM*****SCAN MODE DECISION ROUTINE*****
8410 ! #D2, "DO YOU WISH TO SCAN ALL THE DATA?"
8420 ! #D2, "1-YES, 0-NO"
8430 INPUT W1
8435 REM... IF ANSWER ILLEGAL, SAY SO, GO BACK & GET VALID ANSWER
8440 IF W1<0 OR W1>1 THEN GOSUB 8000
8445 IF W1<0 OR W1>1 THEN 8400
8450 IF W1=0 THEN 8465
8455 REM... IF TOTAL SCAN REQUESTED, GO NO FURTHER HERE....
8460 RETURN
8462 REM... OTHERWISE, GET TIME REFERENCE.
8465 ! #D2, "HOW MANY SECONDS BACK FROM THE TIME"
8466 ! #D2, "THE 'STOP MONITOR' BUTTON WAS DEPRESSED"
8467 ! #D2, "DO YOU WISH TO LOOK?"
8468 ! #D2,
8469 K1=1, REM... SET PARTIAL SCAN VARIABLE
8470 INPUT W2
8471 IF W2=0 AND S2=2 THEN LET B1=15
8472 IF W2=0 AND S7=1 THEN LET B1=48
8473 IF W2=0 THEN 8525
8474 REM... IF NO TIME ENTRY FOUND, ENTER NON-WRAPAROUND ROUTINE
8475 IF T(48)+T(47)=0 THEN GOSUB 4400
8477 REM... IF ONLY ONE FRAME OF DATA FOUND, GO NO FURTHER.....
8478 IF K5=1 THEN RETURN
8479 REM... IF OPERATOR ATTEMPTS TO GO BACK TOO FAR(IN TIME)....

```



```

8480 REM...SAY SO,GO BACK & GET VALID TIME
8483 IF T(48)-W2<T(0) THEN GOSUB 8000
8485 IF T(48)-W2<T(0) THEN 8465
8487 REM...COMPUTE TIME ADJUSTMENT
8490 T3=T(48)-W2
8492 REM...TO FIND STARTING POINT FOR PRINTOUT.
8495 FOR J=0 TO 48
8500 IF T3<T(J) THEN 8510
8505 GOTO 8520
8508 REM...SET STARTING POINT
8510 B1=J-1
8511 REM...RESET LAST TIME ENTRY FOR NON-WRAPAROUND PRINTOUT
8512 IF K6=1 THEN T(48)=T(47)
8515 RETURN
8520 NEXT J
8525 RETURN
8800 REM...PRINT LEGEND
8810 ! #D1,TAB(10),"LEGEND"
8815 ! #D1,TAB(10),"-----"
8820 ! #D1,TAB(10),"1-TRUE "
8830 ! #D1,TAB(10),"0-FALSE"
8840 ! #D1,TAB(10),"B-BRAKE"
8850 ! #D1,TAB(10),"P-PROPULSION"
8860 ! #D1,TAB(10),"U(OR X)-UNDEFINED"
8870 ! #D1,TAB(10),"TEST POINT 20 GIVEN IN MPH"
8880 RETURN
9000 REM**PRINT HEADING(HARDCOPY AVAILABLE BY HITTING 'H' KEY)**
9001 IF INP(252)=72 THEN D1=1
9002 IF S7=3 AND K4>2 THEN 9020
9003 ! #D1,TAB(35),"TEST DATA"
9004 ! #D1,TAB(33),"(TP 1 THRU 34)"
9005 ! #D1,
9006 ! #D1,"DATA TIME",TAB(31),1,1,1,TAB(38),1,TAB(41),1,TAB(44),1,
9008 ! #D1,TAB(48),2,TAB(52),2,2,2,2,2,2,2,2,2,
9010 ! #D1,TAB(70),3,3,3,3,3,
9012 ! #D1," PNT (SEC)",TAB(12),1,2,3,4,5,6,7,
9013 ! #D1,TAB(27),8,9,
9014 ! #D1,TAB(31),0,1,6,TAB(38),7,TAB(41),8,TAB(44),9,
9016 ! #D1,TAB(48),0,TAB(52),1,2,3,4,5,6,7,8,9,
9018 ! #D1,TAB(70),0,1,2,3,4
9019 ! #D1,"-----"
9020 FOR J=B1 TO L1 STEP L2
9021 REM...IF ABBREVIATED PRINTOUT WANTED,HIT 'C' KEY
9022 IF INP(252)=67 THEN GOSUB 20000
9030 FOR K=1 TO 8
9035 REM...FIRST,MAKE NECESSARY DECIMAL-TO-BINARY CONVERSIONS
9040 IF K>2 AND K<8 THEN GOSUB 9500
9045 REM...THEN CONVERT SELECTED BINARY DATA TO LETTERS
9050 IF K=3 THEN GOSUB 9600
9060 IF K=4 THEN GOSUB 9650
9070 IF K=5 THEN GOSUB 9700
9080 IF K=6 THEN GOSUB 9750
9090 IF K=7 THEN GOSUB 9800
9100 IF K=8 THEN GOSUB 9850
9102 REM...GO TO NEXT WORD
9105 NEXT K
9110 REM*****PRINT DATA & HEADINGS*****
9120 GOSUB 9900
9124 REM...IF PAUSE IS WANTED DURING PRINTOUT,HIT 'P' KEY
9126 IF INP(252)=80 THEN 9126
9127 REM...IF SWITCH FROM PRINTER TO CRT IS NEEDED,HIT 'T' KEY
9128 IF INP(252)=84 THEN D1=0
9129 REM*****THEN,GO TO NEXT FRAME *****
9130 NEXT J
9131 REM...SKIP PROGRAMMED PAUSE IF HIGHEST RESOLUTION PRINTOUT

```

```

9132 IF S7=3 THEN 9138
9133 INPUT"HIT RETURN TO CONTINUE.....",Q$
9134 IF S7<>3 THEN 9140
9135 RESTORE
9136 REM... IF PRINTOUT NOT COMPLETE,SKIP PRINTING LEGEND
9138 IF F2>15 THEN RETURN
9140 REM***** PRINT LEGEND*****
9150 GOSUB 8800
9160 RETURN
9500 REM*****DECIMAL TO BINARY CONVERSION*****
9503 D8=128
9508 D9=0(J,K)
9515 FOR B=1 TO 8
9518 Q=((K-3)*8)+(B+2)
9524 IF D9<D8 THEN 9536
9527 O(Q)=1
9530 D9=D9-D8
9533 GOTO 9539
9536 O(Q)=0
9539 D8=D8/2
9545 NEXT B
9551 RETURN
9600 REM*****CREATE PRINT ARRAY FOR DATA WORD#0*****
9605 REM... CONVERT SELECTED BINARY DATA TO LETTERS
9608 IF O(4)*O(3)=1 THEN LET P$(1,2)="11"
9611 IF O(4)+O(3)=0 THEN LET P$(1,2)="00"
9614 IF O(4)=0 AND O(3)=1 THEN LET P$(1,2)="01"
9617 IF O(4)=1 AND O(3)=0 THEN LET P$(1,2)="10"
9620 REM... PUT REMAINING OUTPUT ARRAY VALUES IN PRINT ARRAY
9623 P(6)=O(5)
9626 P(5)=O(6)
9629 P(4)=O(7)
9632 P(3)=O(8)
9635 P(2)=O(9)
9638 P(1)=O(10)
9640 RETURN
9650 REM*****CREATE PRINT ARRAY FOR DATA WORD#01*****
9653 REM... FIRST, CONVERT SELECTED BINARY DATA TO LETTERS
9655 IF O(12)*O(11)=1 THEN LET P$(3,4)="11"
9658 IF O(12)+O(11)=0 THEN LET P$(3,4)="00"
9661 IF O(12)=0 AND O(11)=1 THEN LET P$(3,4)="01"
9664 IF O(12)=1 AND O(11)=0 THEN LET P$(3,4)="10"
9667 IF O(14)*O(13)=1 THEN LET P$(5,6)="11"
9670 IF O(14)+O(13)=0 THEN LET P$(5,6)="00"
9673 IF O(14)=0 AND O(13)=1 THEN LET P$(5,6)="01"
9676 IF O(14)=1 AND O(13)=0 THEN LET P$(5,6)="10"
9678 REM... THEN, PUT REMAINING OUTPUT IN PRINT ARRAY
9680 P(11)=O(15)
9682 P(10)=O(16)
9684 P(9)=O(17)
9686 P(8)=O(18)
9695 RETURN
9700 REM*****CREATE PRINT ARRAY FOR DATA WORD #2*****
9703 REM... FIRST, CONVERT SELECTED BINARY DATA TO LETTERS
9705 IF O(23)*O(24)=1 THEN LET P$(7,8)="11"
9708 IF O(23)+O(24)=0 THEN LET P$(7,8)="00"
9711 IF O(23)=1 AND O(24)=0 THEN LET P$(7,8)="01"
9714 IF O(23)=0 AND O(24)=1 THEN LET P$(7,8)="10"
9717 IF O(25)*O(26)=1 THEN LET P$(9,10)="11"
9720 IF O(25)+O(26)=0 THEN LET P$(9,10)="00"
9723 IF O(25)=1 AND O(26)=0 THEN LET P$(9,10)="01"
9726 IF O(25)=0 AND O(26)=1 THEN LET P$(9,10)="10"
9729 REM... THEN, PUT REMAINING OUTPUT IN PRINT ARRAY
9730 P(24)=O(19)
9733 P(23)=O(20)

```

```


9736 P(22)=0(21)
9738 P(21)=0(22)
9740 RETURN
9750 REM***** CREATE PRINT ARRAY FOR DATA WORD#03*****
9755 REM...SO,PUT ALL BINARY OUTPUT INPRINT ARRAY
9758 P(32)=0(27)
9760 P(31)=0(28)
9762 P(30)=0(29)
9764 P(29)=0(30)
9767 P(28)=0(31)
9770 P(27)=0(32)
9773 P(26)=0(33)
9776 P(25)=0(34)
9780 RETURN
9800 REM***** CREATE PRINT ARRAY FOR DATA WORD#04*****
9805 REM...ONLY TWO BINARY VALUES INVOLVED
9810 REM...PUT THEM IN PRINT ARRAY
9815 P(34)=0(41)
9820 P(33)=0(42)
9825 RETURN
9850 REM*****CREATE PRINT ARRAY FOR DATA WORD#05*****
9855 P(20)=D(J,8)/5
9860 RETURN
9900 REM*****PRINT TEST POINT DATA*****
9935 ! #D1,N(J),TAB(4),T(J),
9941 ! #D1,TAB(12),P(1),P(2),P(3),P(4),P(5),P(6),TAB(25),P$(1,2),
9942 ! #D1,TAB(27),P(8),P(9),
9943 ! #D1,TAB(31),P(10),P(11),TAB(36),P$(5,6),TAB(39),P$(3,4),
9944 ! #D1,TAB(42),P$(9,10),TAB(45),P$(7,8),
9945 ! #D1, P(20),TAB(52),P(21),P(22),P(23),P(24),
9946 ! #D1,P(25),P(26),P(27),P(28),P(29),
9947 ! #D1,TAB(70),P(30),P(31),P(32),P(33),P(34)
9975 RETURN
20000 REM*****ABBREVIATED PRINTOUT ROUTINE*****
20005 ! #D2,"CHOICES FOR NEW FRAME NUMBER ARE:"
20010 IF S7=1 THEN 20100
20020 IF S7=2 THEN 20200
20030 IF S7=3 THEN 20300
20100 REM...FOR LOW RESOLUTION SCAN
20105 ! #D2,
20110 FOR J=0 TO 10
20115 ! #D2,N(J),
20120 NEXT J
20125 ! #D2,
20130 FOR J=11 TO 20
20135 ! #D2,N(J),
20140 NEXT J
20145 ! #D2,
20150 FOR J=21 TO 30
20155 ! #D2,N(J),
20160 NEXT J
20165 ! #D2,
20170 FOR J=31 TO 40
20175 ! #D2,N(J),
20180 NEXT J
20185 ! #D2,
20188 FOR J=40 TO 47
20190 ! #D2,N(J),
20192 NEXT J
20194 ! #D2,
20195 INPUT"NEW FRAME NUMBER? ",X9
20196 J=X9/150
20197 IF X9>7050 THEN ! #D2,"ILLEGAL CHOICE, TRY AGAIN !"
20198 IF X9>7050 THEN 20000
20199 GOTO 20500


```

```
20200 REM...FOR MEDIUM RESOLUTION SCAN
20210 FOR J=0 TO 7
20215 ! #D2,N(J),
20220 NEXT J
20225 ! #D2,
20230 IF X5=7 THEN 20280
20235 FOR J=8 TO 10
20240 ! #D2,N(J),
20245 NEXT J
20250 ! #D2,
20260 INPUT"NEW FRAME NUMBER? ",X9
20265 IF X9>(50+X4)/8 THEN ! #D2,"ILLEGAL CHOICE,TRY AGAIN!"
20280 IF X9>(50+X4)/8 THEN 20000
20290 J=(X9-S1)/15
20295 GOTO 20500
20300 REM...FOR HIGH RESOLUTION SCAN
20305 IF S2>=7155 THEN 20350
20310 FOR J=0 TO 10
20315 ! #D2,N(J),
20320 NEXT J
20325 ! #D2,
20330 FOR J=11 TO X7/8
20335 ! #D2,N(J),
20340 NEXT J
20342 ! #D2,
20344 GOTO 20375
20350 FOR J=0 TO X7/8
20355 ! #D2,N(J),
20360 NEXT J
20365 ! #D2,
20375 INPUT"NEW FRAME NUMBER? ",X9
20380 IF X9>(54+X7)/8 THEN ! #D2,"ILLEGAL CHOICE,TRY AGAIN!"
20385 IF X9>(54+X7)/8 THEN 20000
20390 J=X9-S2
20500 RETURN
30000 REM*****PAPER ADVANCE*****
30010 FOR I=1 TO 19
30020 ! #1,
30030 NEXT
30040 STOP
```


VDAS DATA ACQUISITION PROGRAM

-EXEC-

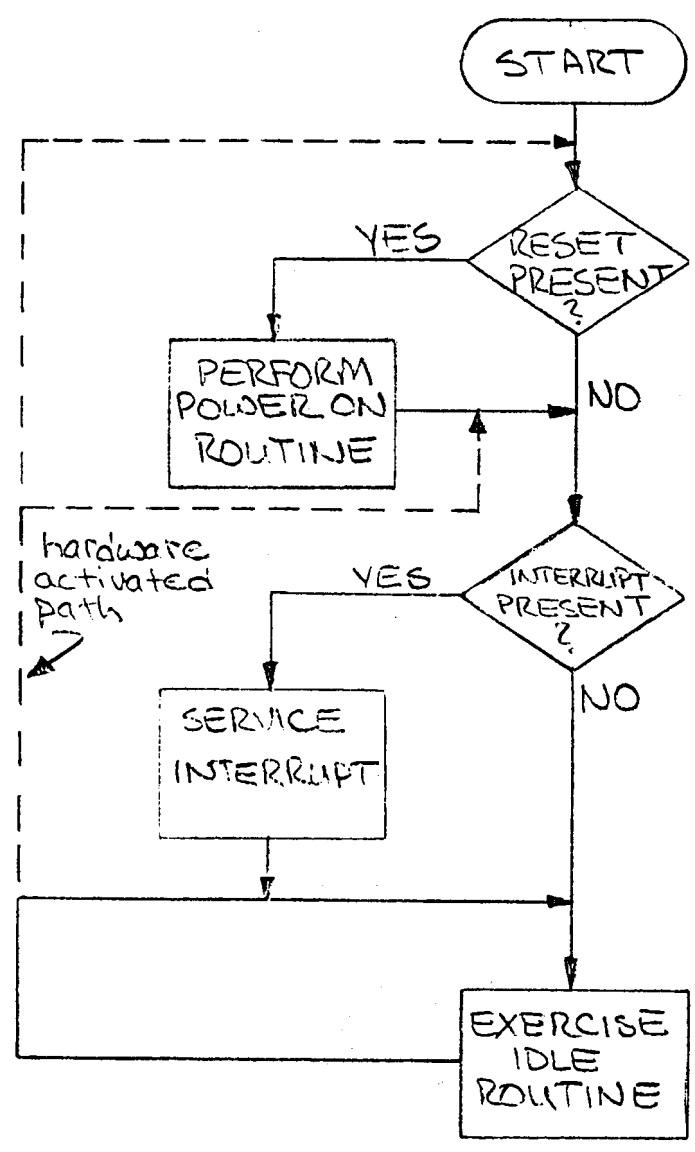


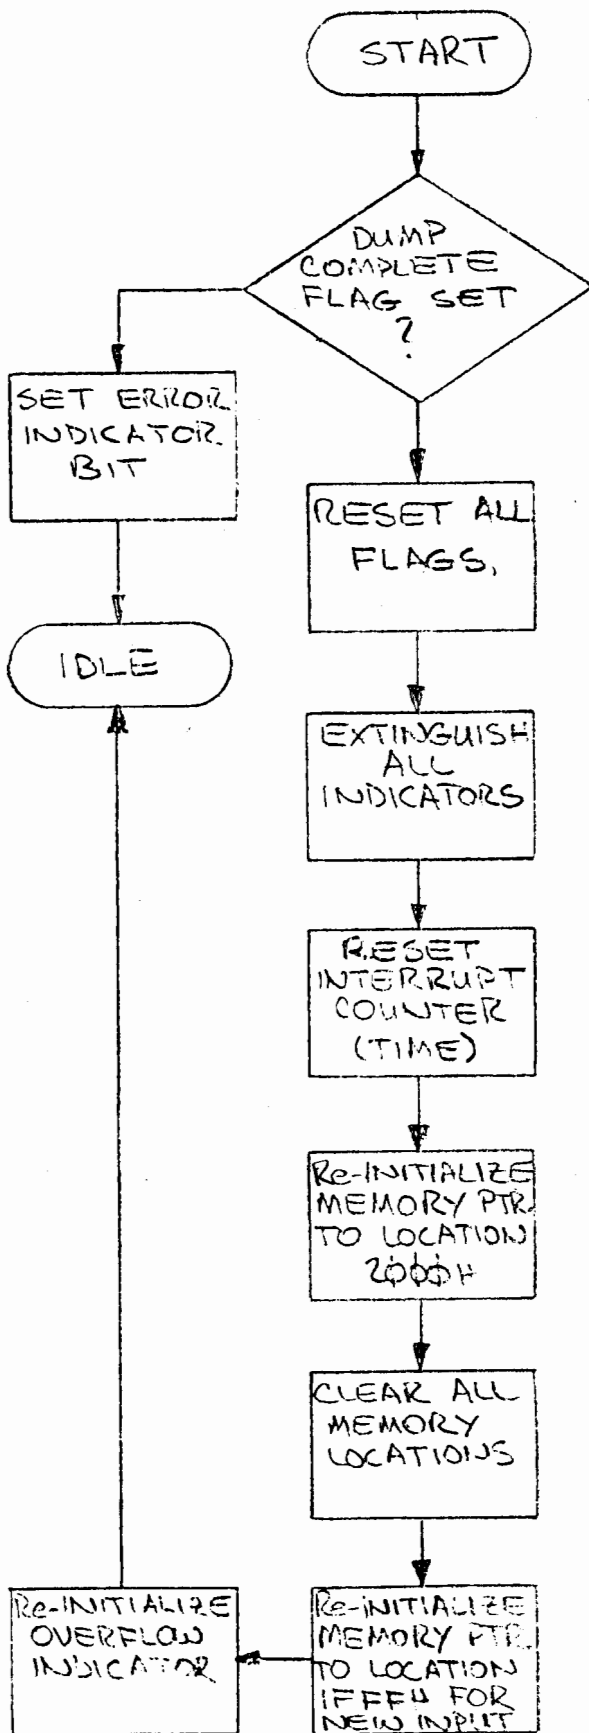


OUTPUT ROUTINE

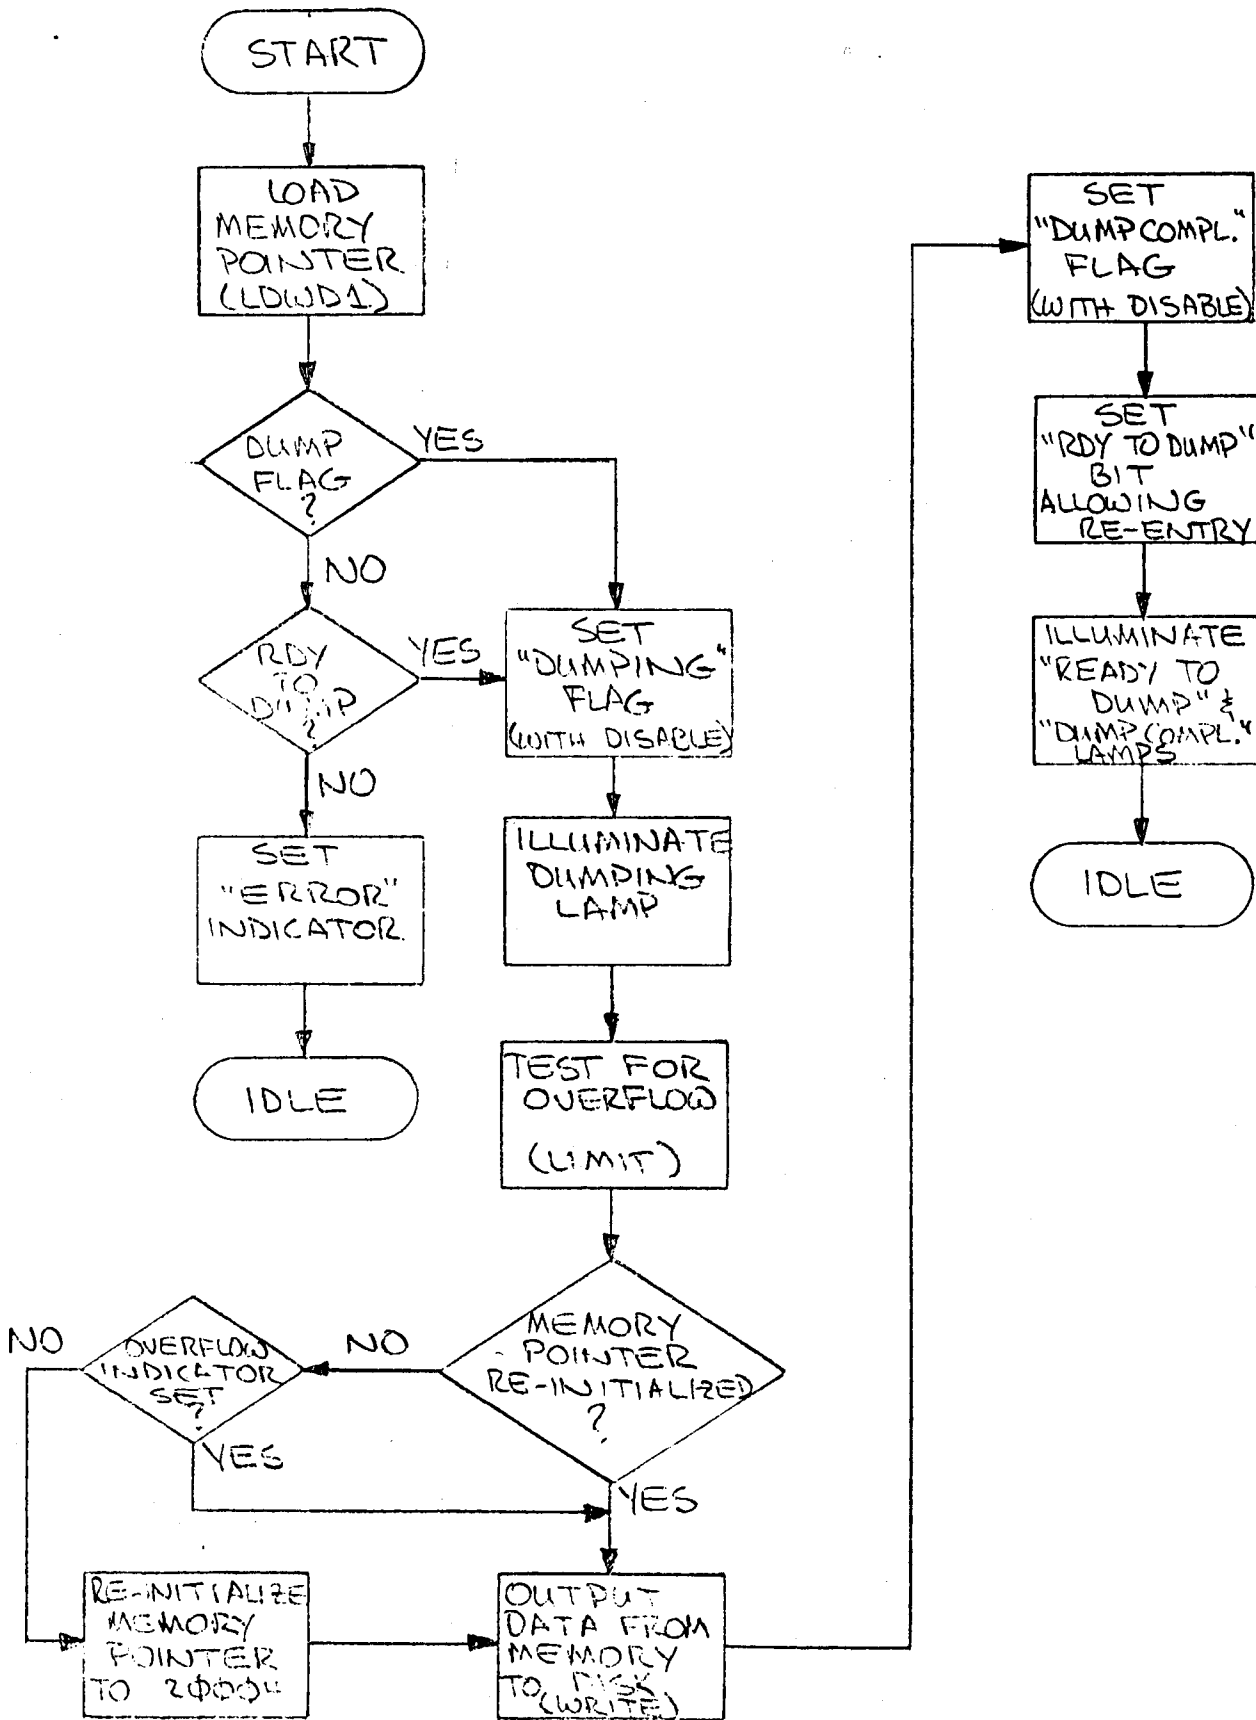


DISABLE ROUTINE


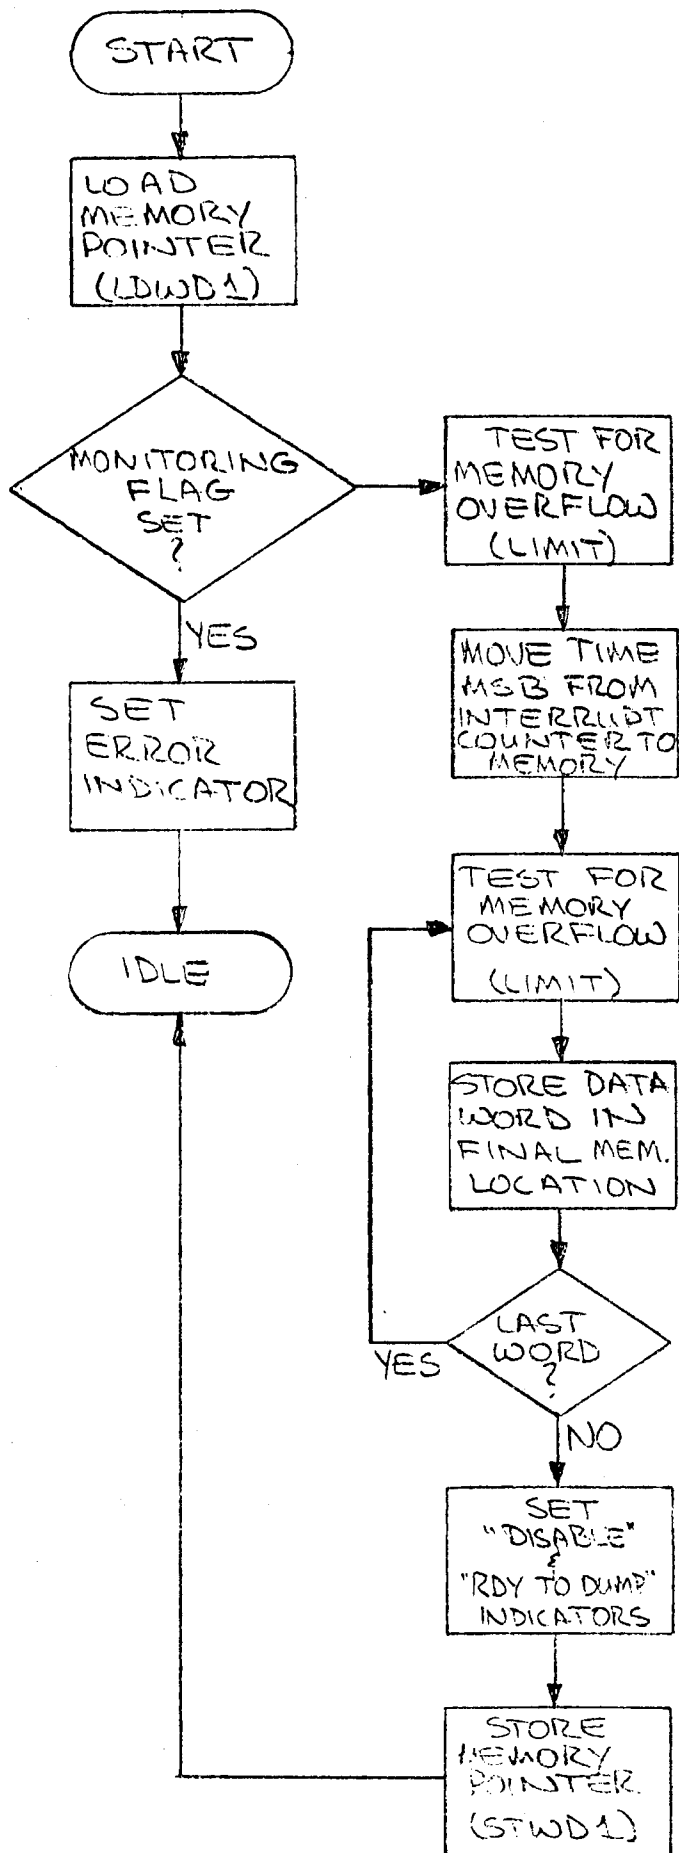


INPUT ROUTINE

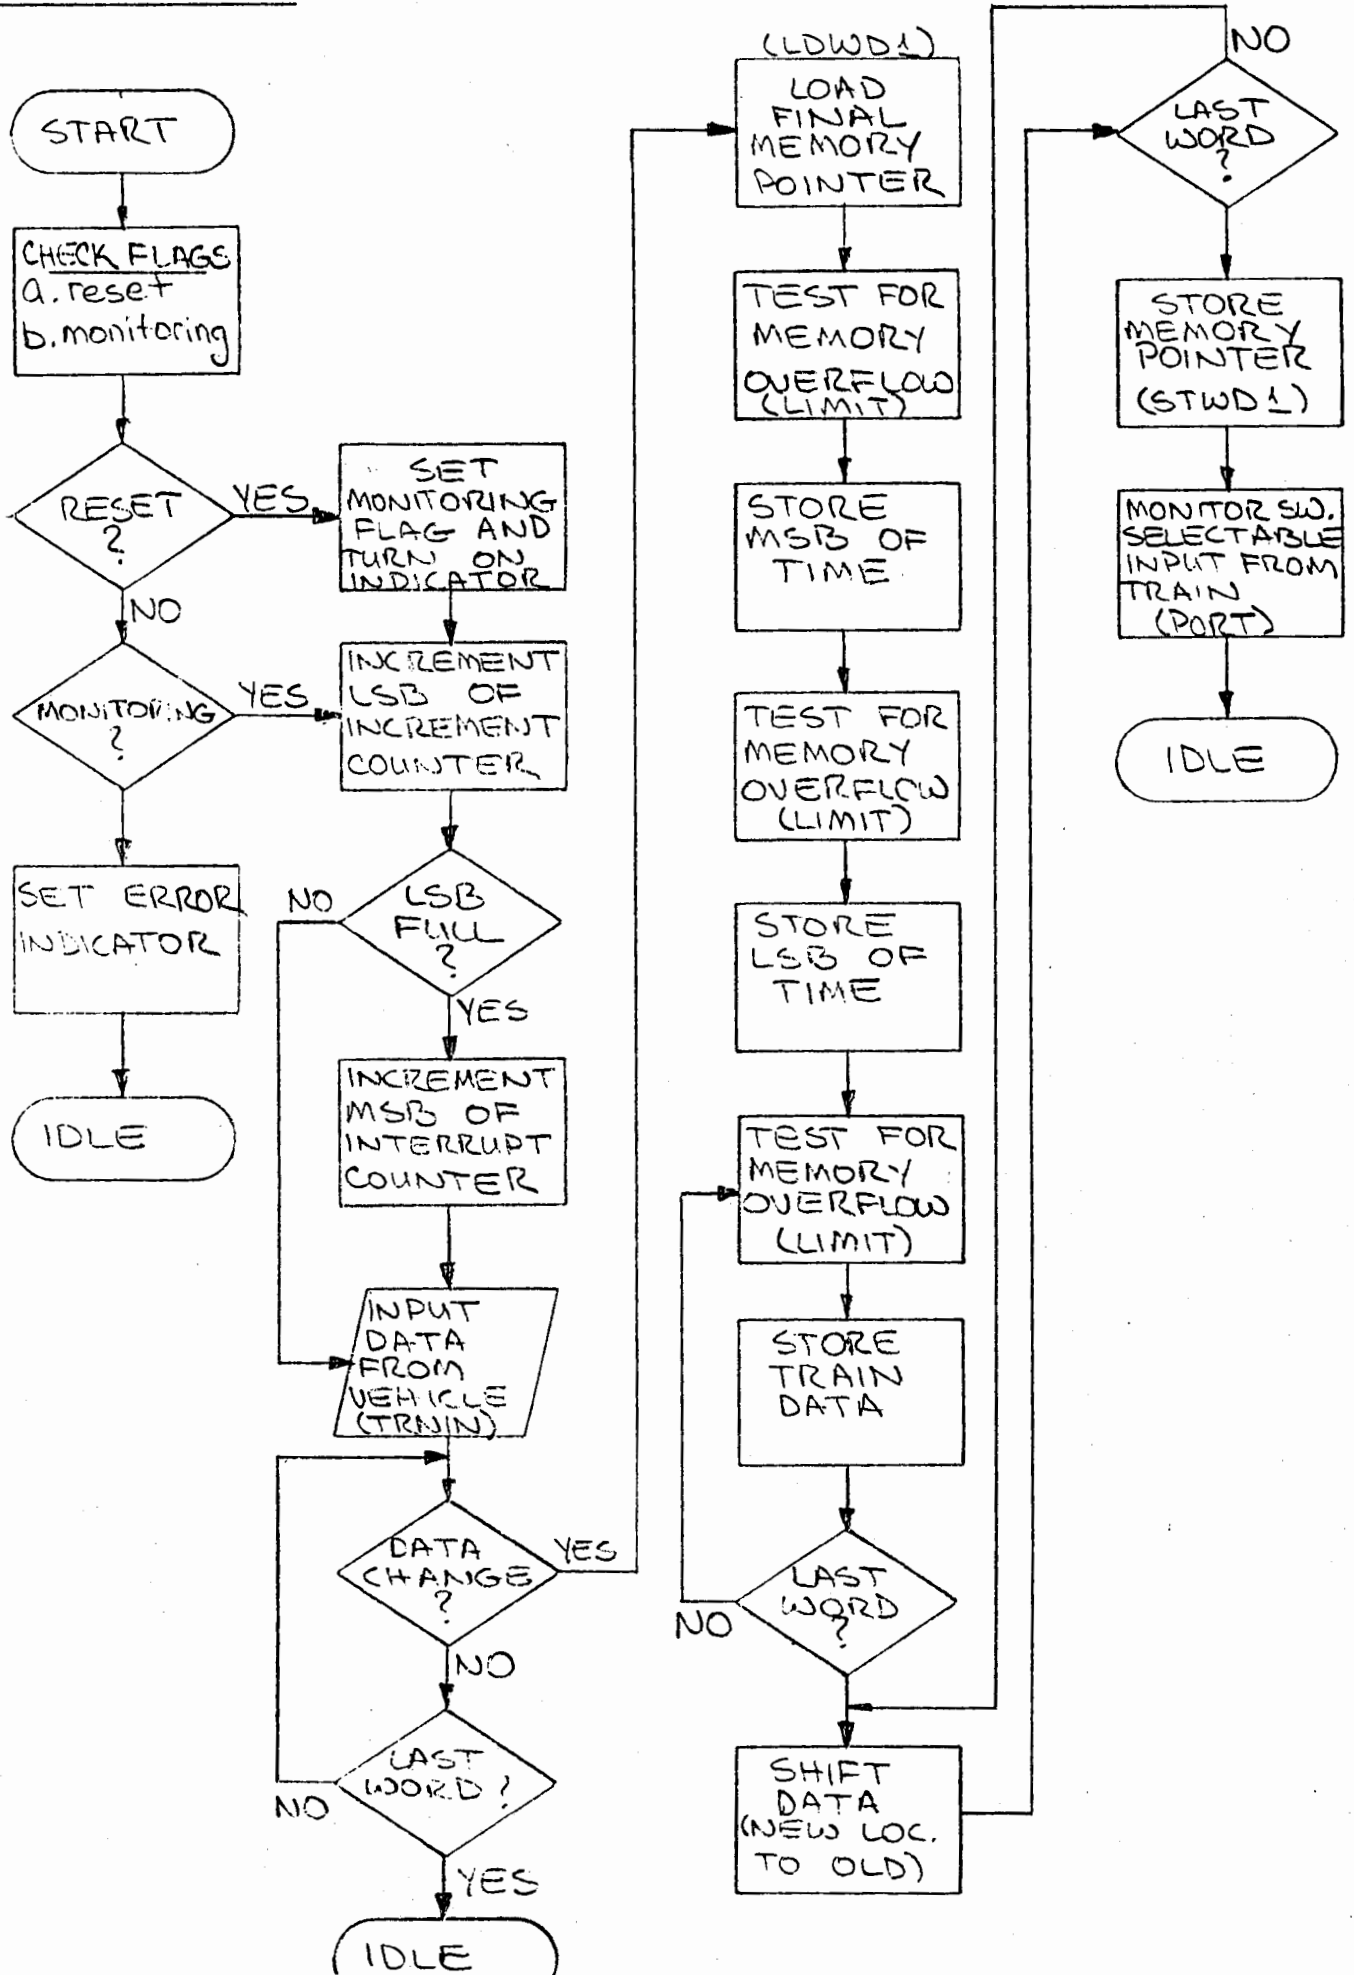

Power On Routine

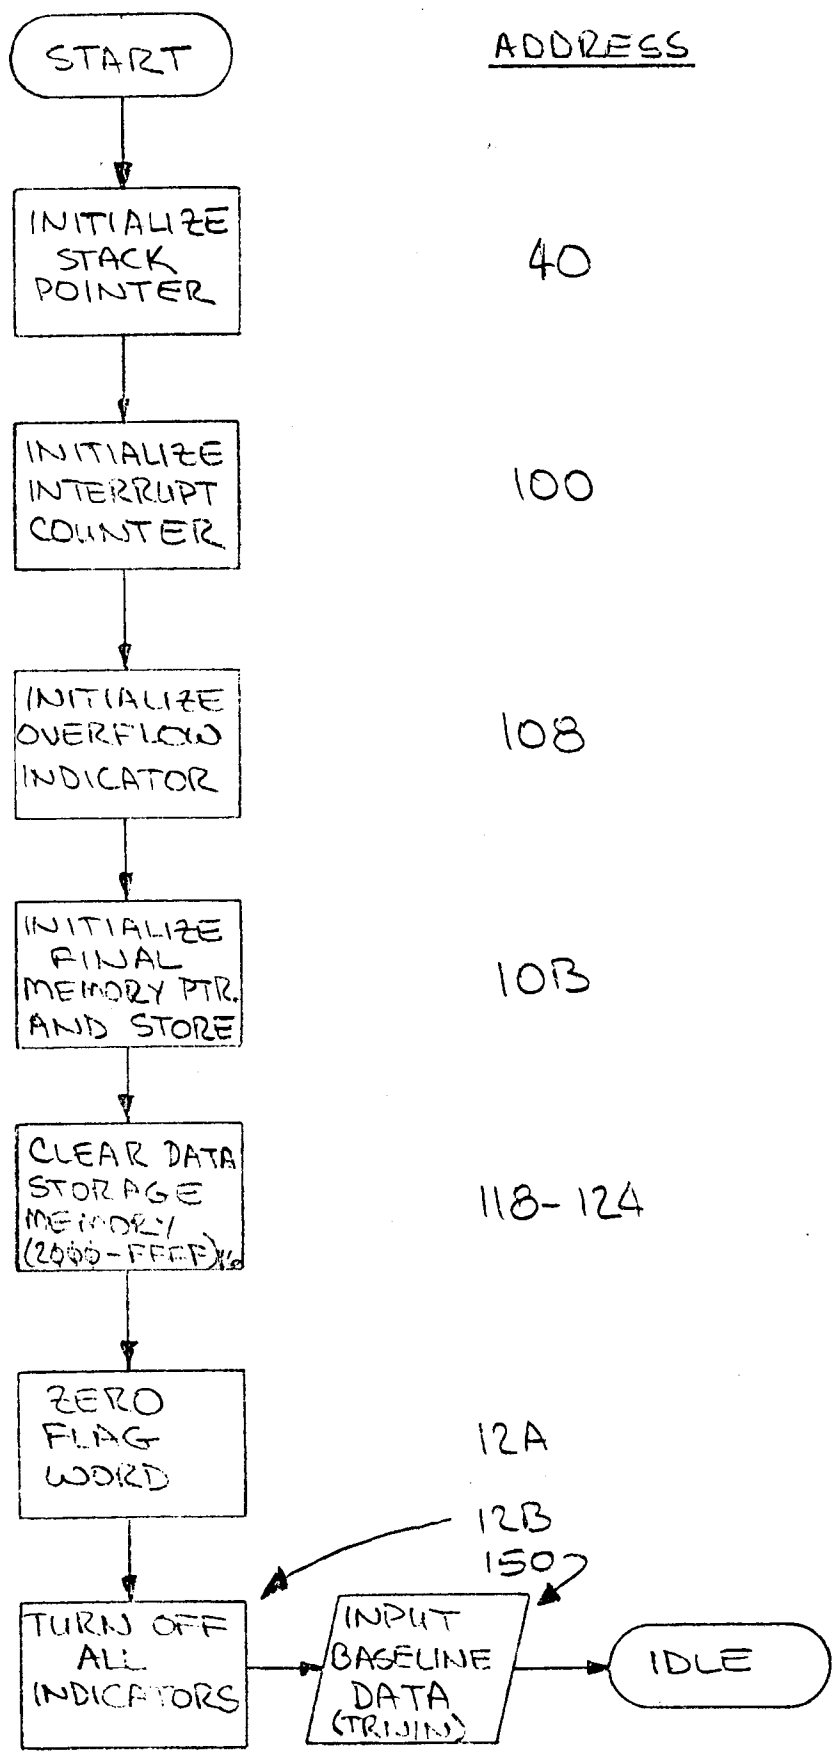

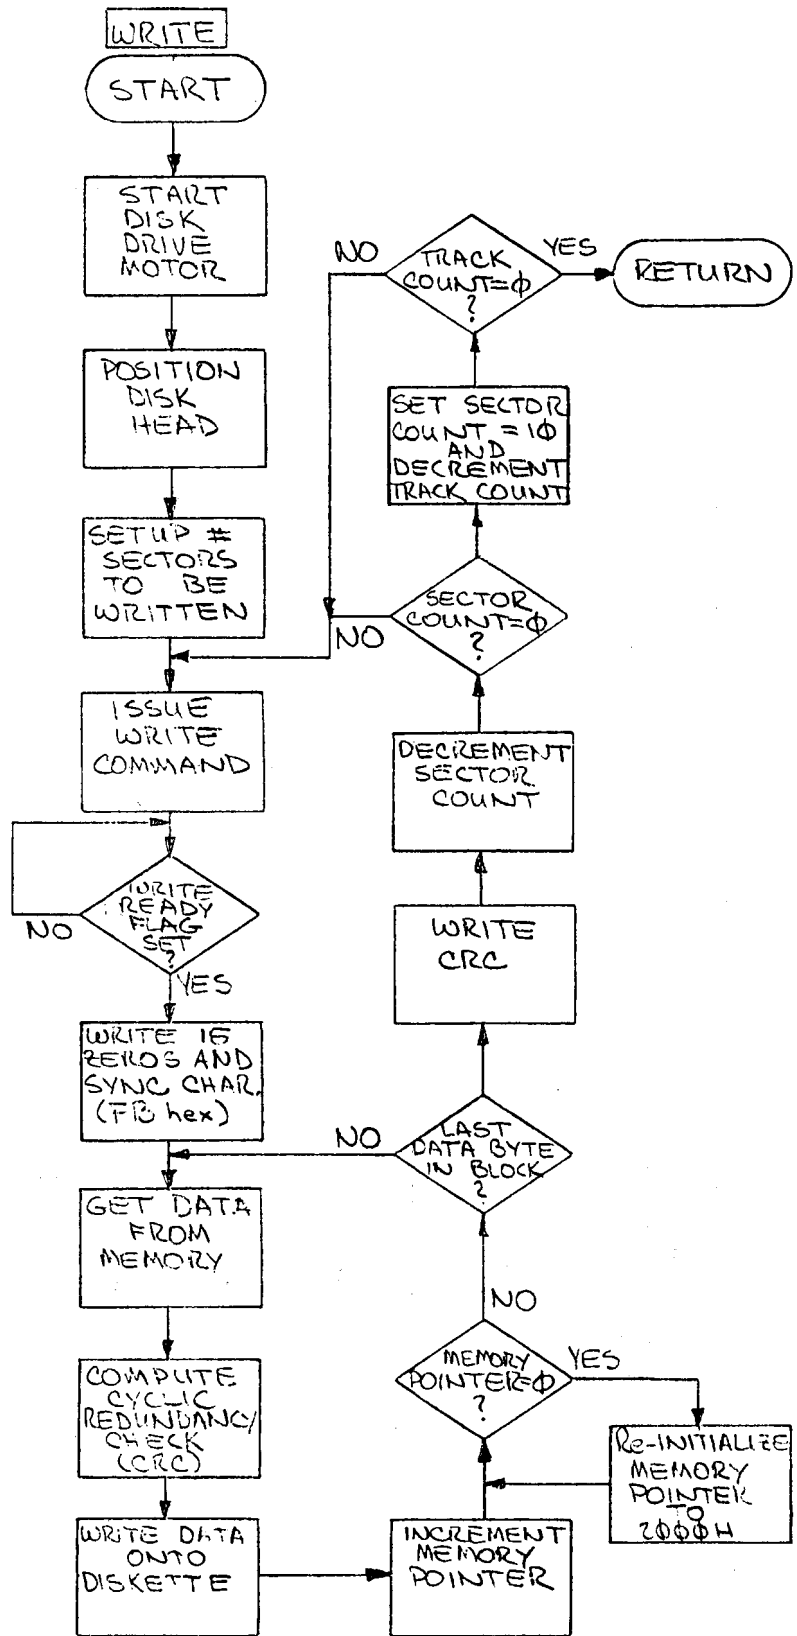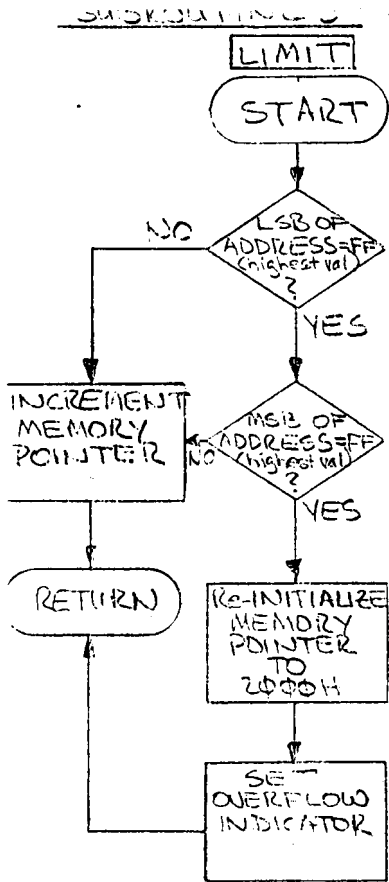

VDAS 11 - 6/28/78

PROM LABELED ASSM2 (000-3FR)

READY
ASSMX 0 8000

| | |
|---------------|---------------------------------------------------------|
| 0000 00 | 0020 START NOP |
| 0001 C3 40 00 | 0030 JMP PINIT |
| 0004 | 0040 DS START+18H-\$ |
| 0018 C3 80 01 | 0050 INT4 JMP VDASI ;SERVICE INPUT ROUTINE |
| 001B | 0060 DS START+20H-\$ |
| 0020 C3 80 02 | 0070 INT3 JMP STRTO ;SERVICE REINITIALIZE ROUTINE |
| 0023 | 0080 DS START+28H-\$ |
| 0028 C3 00 03 | 0090 INT2 JMP DUMP ;SERVICE OUTPUT ROUTINE |
| 002B | 0100 DS START+30H-\$ |
| 0030 C3 80 03 | 0110 INT1 JMP DSABL ;SERVICE DISABLE ROUTINE |
| 0033 | 0120 DS START+40H-\$ |
| 0040 31 FF | 0130 PINIT DW OFF31H ;INITIALIZE STACK POINTER |
| 0042 13 | 0140 DB 13H |
| 0043 C3 00 01 | 0150 INTO JMP PWRON ;SERVICE POWER ON ROUTINE |
| 0046 FB | 0160 IDLE EI ;ENABLE INTERRUPTS |
| 0047 76 | 0170 HLT ;WAIT |
| 0048 C3 46 00 | 0180 JMP IDLE ;SPIN HERE UNTIL ANOTHER INTERRUPT OCCURS |
| 004B | 0190 DS START+100H-\$ |
| 0100 3E 00 | 0200 PWRON MVI A,00H ;INITIALIZE INTERRUPT COUNTER |
| 0102 32 00 10 | 0210 STA 1000H |
| 0105 32 01 10 | 0220 STA 1001H |
| 0108 32 05 10 | 0225 STA 1005H ;INITIALIZE OVERFLOW INDICATOR |
| 010B 21 FF 1F | 0230 MMPNT LXI H,1FFFH ;INITIALIZE FINAL MEMORY POINTER |
| 010E 7C | 0240 MOV A,H ;AND STORE AWAY |
| 010F 32 03 10 | 0250 STA 1003H |
| 0112 7D | 0260 MOV A,L |
| 0113 32 04 10 | 0270 STA 1004H |
| 0116 3E 00 | 0275 MVI A,00H ;ZERO ACCUMULATOR |
| 0118 77 | 0280 ZMEM MOV M,A ;CLR FINAL MEMORY LOCATION |
| 0119 23 | 0290 INX H |
| 011A 7C | 0300 MOV A,H |
| 011B EE 00 | 0310 XRI 00H ;TEST FOR LIMIT ADDRESS |
| 011D CA 25 01 | 0320 JZ FLGWD |
| 0120 3E 00 | 0330 MVI A,00H ;IF NOT LIMITING,CONTINUE CLEARING |
| 0122 C3 18 01 | 0340 JMP ZMEM. |
| 0125 11 02 10 | 0350 FLGWD LXI D,1002H ;SET FLAG POINTER |
| 0128 3E 00 | 0360 FLG1 MVI A,00H ;ZERO ACCUMULATOR |
| 012A 12 | 0370 STAX D |
| 012B D3 06 | 0380 OUT 06H ;AND TURN OFF ALL DISPLAYS |
| 012D 11 10 10 | 0390 BSLIN LXI D,1010H ;SET UP BASELINE STORAGE POINTER |
| 0130 CD 50 01 | 0395 CALL TRNIN ;BRING DATA FROM TRAIN |
| 0133 C3 46 00 | 0396 JMP IDLE ;RETURN TO EXEC |
| 0136 | 0398 DS START+150H-\$ |
| 0150 DB 00 | 0400 TRNIN IN 00H ;INPUT TRAIN DATA |
| 0152 12 | 0410 STAX D ;AND STORE AWAY |
| 0153 13 | 0420 INX D ;AND MOVE TO NEXT BASELINE DATA LOCATION |
| 0154 13 | 0430 INX D |
| 0155 DB 01 | 0440 IN 01H ;ETCETERA |
| 0157 12 | 0450 STAX D |
| 0158 13 | 0460 INX D |
| 0159 13 | 0470 INX D |
| 015A DB 02 | 0480 IN 02H |
| 015C 12 | 0490 STAX D |

| | |
|---------------|---------------------------------------------------------------|
| 0150 13 | 0500 INX D |
| 015E 13 | 0510 INX D |
| 015F DB 03 | 0520 IN 03H |
| 0161 12 | 0530 STAX D |
| 0162 13 | 0540 INX D |
| 0163 13 | 0550 INX D |
| 0164 DB 04 | 0560 IN 04H |
| 0166 12 | 0570 STAX D |
| 0167 13 | 0580 INX D |
| 0168 13 | 0590 INX D |
| 0169 DB 05 | 0600 IN 05H |
| 016B 12 | 0610 STAX D |
| 016C C9 | 0620 RET ;RETURN TO MAIN PROGRAM |
| 016D | 0630 DS START+180H-\$ |
| 0180 3A 02 10 | 0650 VDASI LDA 1002H ;LOAD FLAGS |
| 0183 EE 00 | 0660 XRI 00H ;RESET? |
| 0185 CA 90 01 | 0670 JZ FLG2 ;IF SO CONTINUE |
| 0188 EE 01 | 0672 XRI 01H ;ALREADY MONITORING? |
| 018A CA 97 01 | 0674 JZ INCTM ;IF SO, INCREMENT INTR.CNTR. |
| 018D C3 E0 03 | 0690 JMP ERRIN ;IF NOT SET, OPERATION INVALID |
| 0190 3E 01 | 0700 FLG2 MVI A, 01H ;SET "MONITOR FLAG"(6 REST ERROR IND.) |
| 0192 32 02 10 | 0710 STA 1002H |
| 0195 D3 06 | 0720 OUT 06H ;AND TURN ON INDICATOR |
| 0197 11 01 10 | 0730 INCTM LXI D, 1001H ;GO TO LSB OF INTR. CNTR. |
| 019A 1A | 0740 LDAX D ;LOAD CONTENTS INTO ACCUMULATOR |
| 019B 3C | 0750 INR A ;AND INCREMENT |
| 019C 12 | 0760 STAX D ;AND STORE AWAY |
| 019D EE 00 | 0770 XRI 00H ;LSB FULL? |
| 019F C2 A6 01 | 0780 JNZ DATN1 ;IF NOT, INPUT TRAIN DATA |
| 01A2 1B | 0790 DCX D ;OTHERWISE, GO TO MSB OF INTERRUPT CNTR. |
| 01A3 1A | 0800 LDAX D ;BRINC CONTENTS INTO ACCUMULATOR |
| 01A4 3C | 0810 INR A ;AND INCREMENT |
| 01A5 12 | 0820 STAX D ;AND STORE AWAY |
| 01A6 11 11 10 | 0830 DATN1 LXI D, 1011H ;SETUP BUFFER STORAGE |
| 01A9 CD 50 01 | 0840 CALL TRNIN ;AND BRINC IN NEW TRAIN DATA |
| 01AC 11 10 10 | 0850 INCMP LXI D, 1010H ;SET UP MEM. PNTR TO EXAMINE OLD DATA |
| 01AF OE 06 | 0860 MVI C, 06H ;SET WORD SIZE COUNTER |
| 01B1 1A | 0870 WDCMP LDAX D ;MOVE OLD DATA TO ACCUMULATOR |
| 01B2 13 | 0880 INX D ;BUMP POINTER TO NEW DATA |
| 01B3 EB | 0885 XCHG ;SET UP FOR COMPARISON |
| 01B4 AE | 0890 XRA M ;COMPARE NEW DATA WITH OLD |
| 01B5 EB | 0895 XCHG ;RESTORE REGISTERS |
| 01B6 C2 C1 01 | 0900 JNZ STRWD ;IF DIFFERENT, GOTO DATA STORAGE ROUTINE |
| 01B9 0D | 0910 DCR C ;DECREMENT WORD SIZE COUNTER |
| 01BA CA F5 01 | 0920 JZ EXIT2 ;IF DONE PREPARE TO EXIT |
| 01BD 13 | 0930 INX D ;IF NOT, MOVE TO NEXT OLD DATA |
| 01BE C3 B1 01 | 0940 JMP WDCMP ;AND MAKE MORE COMPARISONS |
| 01C1 CD 60 02 | 0950 STRWD CALL LDWD1 ;LOAD FINAL MEMORY POINTER |
| 01C4 CD 40 02 | 0960 CALL LIMIT ;TEST FOR MEMORY OVERFLOW |
| 01C7 3A 00 10 | 0970 LDA 1000H ;STORE MSB OF TIME |
| 01CA 77 | 0980 MOV M, A |
| 01CB CD 40 02 | 0990 CALL LIMIT |
| 01CE 3A 01 10 | 1000 LDA 1001H ;STORE LSB OF TIME |
| 01D1 77 | 1010 MOV M, A |
| 01D2 11 11 10 | 1020 LXI D, 1011H ;GO TO FIRST DATA WORD |
| 01D5 OE 06 | 1030 MVI C, 06H ;AND SET WORD SIZE COUNTER |
| 01D7 CD 40 02 | 1040 LIM3 CALL LIMIT ;TEST FOR MEMORY OVERFLOW |
| 01DA 1A | 1050 LDAX D ;MOVE WORD INTO ACCUMULATOR |
| 01DB 77 | 1060 MOV M, A ;AND THEN STORE IN FINAL MEMORY |
| 01DC 13 | 1070 INX D ;GO TO NEXT BUFFER WORD |
| 01DD 13 | 1080 INX D |
| 01DE 0D | 1090 DCR C ;DECREMENT WORD SIZE COUNTER |
| 01DF C2 D7 01 | 1100 JNZ LIM3 ;IF NOT DONE, GO BACK AND STORE AGAIN |
| 01E2 11 1B 10 | 1200 ODTNW LXI D, 101BH ;GO TO END OF INPUT BUFFER |
| 01E5 OE 06 | 1205 MVI C, 06H ;SET WORD SIZE COUNTER |
| 01E7 1A | 1210 XFER LDAX D ;LOAD WORD INTO ACCUMULATOR |

| | |
|---------------|-----------------------------------------------------------|
| 01E8 18 | 1215 DCX D ;GO TO OLD DATA LOCATION |
| 01E9 12 | 1220 STAX D ;STORE NEW DATA INTO OLD DATA LOCATION |
| 01EA 0D | 1225 DCR C ;DECREMENT WORD SIZE COUNTER |
| 01EB CA F2 01 | 1230 JZ RSTR1 ;DONE? IF SO,PREPARE TO EXIT |
| 01EE 1B | 1235 DCX D ;IF NOT, GO TO NEXT NEW DATA LOCATION |
| 01EF C3 E7 01 | 1240 JMP XFER ;AND GO BACK AND PRANSFER MORE DATA |
| 01F2 CD 70 02 | 1245 RSTR1 CALL STWD1 ;STORE FINAL MEMORY POINTER |
| 01F5 | 1248 PORT EQU 1080H ;DEFINE INPUT INSTRUCTION AREA |
| 01F5 21 80 10 | 1250 EXIT2 LXI H,1080H ;SET MEMORY POINTER TO RAM |
| 01F8 36 DB | 1253 MVI M,0DBH ;PUT INPUT INSTRUCTION IN RAM |
| 01FA 23 | 1256 INX H ;INCREMENT MEMORY POINTER |
| 01FB DB 07 | 1259 IN 07H ;INPUT SWITCH SETTINGS |
| 01FD E6 07 | 1262 ANI 07H ;MASK OUT UNUSED SWITCHES |
| 01FF FE 07 | 1265 CPI 07H ;SWITCH SETTING SEVEN? |
| 0201 CA 0E 02 | 1271 JZ TIME ;IF SO,MONITOR CLOCK |
| 0204 77 | 1274 MOV M,A ;IF NOT,STORE SWITCH SETTINGS |
| 0205 23 | 1277 INX H ;INCREMENT MEMORY POINTER |
| 0206 36 C9 | 1280 MVI M,0C9H ;LOAD MEMORY WITH 'RETURN' INSTRUCTION |
| 0208 CD 80 10 | 1283 CALL PORT ;EXECUTE INSTRUCTIONS IN RAM |
| 020B D3 05 | 1286 OUT 05H ;DISPLAY SWITCH SETTINGS ON LEDS |
| 020D C9 | 1289 RET ;AND GO BACK TO IDLE |
| 020E 3A 01 10 | 1292 TIME LDA 1001H ;LOAD LSB OF TIME |
| 0211 D3 05 | 1295 OUT 05H ;AND OUTPUT TO LEDS |
| 0213 C9 | 1298 RET ;AND GO BACK TO IDLE |
| 0214 | 1299 DS START+240H-\$ |
| 0240 7D | 1300 LIMIT MOV A,L ;CHECK FOR MEMORY OVERFLOW |
| 0241 EE FF | 1303 XRI OFFH |
| 0243 CA 48 02 | 1306 JZ TSMSB |
| 0246 23 | 1309 BUMP INX H |
| 0247 C9 | 1312 RET ;GO BACK TO MAIN PROGRAM |
| 0248 7C | 1315 TSMSB MOV A,H |
| 0249 EE FF | 1318 XRI OFFH ;LIMIT REACHED? |
| 024B CA 51 02 | 1321 JZ REINT |
| 024E C3 46 02 | 1324 JMP BUMP |
| 0251 21 00 20 | 1327 REINT LXI H,2000H ;IF SO,REINITIALIZE MEMORY POINTER |
| 0254 3E 01 | 1330 SETOV MVI A,01H ;AND SET OVERFLOW INDICATOR |
| 0256 32 05 10 | 1333 STA 1005H |
| 0259 C9 | 1336 EXIT1 RET ;AND GO BACK TO MAIN PROGRAM |
| 025A | 1339 DS START+260H-\$ |
| 0260 3A 03 10 | 1342 LDWD1 LDA 1003H ;LOAD FINAL MEMORY INTO H&L |
| 0263 67 | 1345 MOV H,A |
| 0264 3A 04 10 | 1348 LDA 1004H |
| 0267 67 | 1351 MOV L,A |
| 0268 C9 | 1354 RET ;GO BACK TO MAIN PROGRAM |
| 0269 | 1357 DS START+270H-\$ |
| 0270 7C | 1360 STWD1 MOV A,H ;MOVE FINAL MEMORY POINTER TO BUFFER |
| 0271 32 03 10 | 1363 STA 1003H |
| 0274 7D | 1370 MOV A,L |
| 0275 32 04 10 | 1380 STA 1004H |
| 0278 C9 | 1390 RET ;GO BACK TO MAIN PROGRAM |
| 0279 | 1400 DS START+280H-\$ |
| 0280 3A 02 10 | 1410 STRTO LBA 1002H ;LOAD FLAGS |
| 0283 EE 60 | 1420 XRI 60H ;"DUMP COMPLETE SET (ALONG WITH DISABLE)? |
| 0285 C2 E0 03 | 1430 JNZ ERRIN ;IF NOT,ERROR CONDITION PRESENT |
| 0288 3E 00 | 1440 MVI A,00H ;IF SO,RESET FLAGS |
| 028A 32 02 10 | 1450 STA 1002H ;AND STORE AWAY |
| 028D D3 06 | 1455 OUT 06H ;TURN OFF INDICATORS |
| 028F 32 00 10 | 1458 STA 1000H ;RESET MSB OF TIME |
| 0292 32 01 10 | 1460 STA 1001H ;RESET LSB OF TIME |
| 0295 21 00 20 | 1462 SETUP LXI H,2000H ;INITIALIZE MEMORY POINTER |
| 0298 AF | 1464 BCCL2 XRA A ;ZERO ACCUMULATOR |
| 0299 77 | 1466 CLMH3 MOV H,A ;AND XFER TO MEMORY |
| 029A 7D | 1468 MOV A,L ;TEST LSB OF ADDRESS |
| 029B EE FF | 1470 XRI OFFH ;AGAINST MAX. ADDRESS |
| 029D CA A4 02 | 1472 JZ LMTST ;IF MAX.,TEST MSB |
| 02A0 23 | 1474 INX H ;IF NOT,GO TO NEXT ADDRESS |

02A1 C3 98 02
02A4 7C
02A5 EE FF
02A7 CA AE 02
02AA 23
02AB C3 98 02
02AE 21 FF 1F
02B1 CD 70 02
02B4 3E 00
02B6 32 05 10
02B9 C9
02BA
0300 CD 60 02
0303 3A 02 10
0306 EE 60
0308 CA 1B 03
030B 3A 02 10
030E EE 42
0310 C2 E0 03
0313 3E 44
0315 32 02 10
0318 C3 1D 03
031B 3E 44
031D D3 06
031F CD 40 02
0322 7C
0323 EE 20
0325 C2 31 03
0328 7D
0329 EE 00
032B C2 31 03
032E C3 42 03
0331 3A 05 10
0334 EE 00
0336 CA 3C 03
0339 C3 3F 03
033C 21 00 20
033F C3 42 03
0342 CD 00 0E
0345 3E 60
0347 32 02 10
034A F6 02
034C D3 06
034E C9
034F
0380 CD 60 02
0383 3A 02 10
0386 EE 01
0388 C2 E0 03
038B CD 40 02
038E 3A 00 10
0391 77
0392 CD 40 02
0395 3A 01 10
0398 77
0399 11 11 10
039C 0E 06
039E CD 40 02
03A1 1A
03A2 77
03A3 13
03A4 13
03A5 0D
03A6 C2 9E 03
03A9 3E 42
03AB 32 02 10

1476 JMP BCCL2 ;AND CONTINUE TO CLEAR MEMORY
1478 LMTST MOV A,H ;TEST MSB OF ADDRESS
1479 XRI OFFH ;AGAINST MAX.ADDRESS
1480 JZ STUP2 ;IF MAX.,STOP CLEARING
1482 INX H ;IF NOT,GO TO NEXT ADDRESS
1484 JMP BCCL2 ;AND CONTINUE TO CLEAR MEMORY
1486 STUP2 LXI H,1FFFH ;REINITIALIZE MEM. PNTR. FOR NEW INPUT
1488 CALL STWD1 ;AND STORE AWAY
1490 MVI A,00H ;INITIALIZE OVERFLOW INDICATOR
1492 STA 1005H ;AND STORE AWAY
1494 EXIT3 RET ;GO BACK TO IDLE
1500 DS START+300H-\$
1510 DUMP CALL LDWD1
1520 LDA 1002H ;LOAD FLAGS
1530 XRI 60H ;TEST REENTRY
1540 JZ DBIT ;IF SO,SET "DUMPING" FLAG BIT(WITH DISABLE)
1550 ENTRI LDA 1002H ;IF NOT,LOAD FLAGS AGAIN
1560 XRI 42H ;AND CHECK "READY TO DUMP" FLAG
1570 JNZ ERRIN ;IF NOT SET,INDICATE ERROR
1580 MVI A,44H ;IF SO,SET "DUMPING"FLAG
1590 STA 1002H ;AND STORE AWAY
1600 JMP DLED ;PROCEED TO TURNING ON INDICATOR
1610 DBIT MVI A,44H ;IF SO,SET "DUMPING" FLAG
1620 DLED OUT 06H ;ILLUMINATE LED
1630 TEST CALL LIMIT ;TEST FOR OVERFLOW
1640 MOV A,H ;CHECK FOR REINITIALIZATION
1650 XRI 20H
1655 JNZ OVFLW
1660 MOV A,L
1665 XRI 00H
1670 JNZ OVFLW
1675 JMP DSKO ;IF SO,GO AND OUTPUT TO DISK
1680 OVFLW LDA 1005H ;IF NOT,TEST OVERFLOW INDICATOR
1685 XRI 00H ;SET?
1690 JZ RESET ;IF NOT,REINITIALIZE FIRST
1695 JMP WEXIT ;IF SO,GO DIRECTLY TO DISK OUT
1700 RESET LXI H,2000H
1705 WEXIT JMP DSKO
1710 DSKO CALL WRITE
1780 QTCLR MVI A,60H ;SET "DUMP COMPLETE"FLAG(WITH DISABLE SET)
1785 STA 1002H ;AND STORE AWAY
1790 ORI 02H ;SET "RDY TO DUMP"BIT TO ALLOW REENTRY
1795 OUT 06H ;TURN ON "RDY TO DUMP" & "DUMP COMPLETE" LEDS
1798 EXIT4 RET ;AND GO BACK TO IDLE
1800 DS START+380H-\$
1810 DSABL CALL LDWD1 ;LOAD FINAL MEMORY POINTER
1820 LDA 1002H ;CHECK MONITORING FLAG
1830 XRI 01H ;SET?
1840 JNZ ERRIN ;IF NOT,GIVE ERROR INDICATION
1850 TIMM2 CALL LIMIT ;TEST FOR MEMORY OVERFLOW
1860 LDA 1000H ;LOAD MSB OF TIME
1870 MOV M,A ;AND PUT INTO STORAGE
1880 CALL LIMIT ;TEST AGAIN
1890 LDA 1001H ;LOAD LSB OF TIME
1900 MOV M,A ;AND PUT INTO STORAGE
1910 LXI D,1011H ;GO TO NEW DATA
1920 MVI C,06H ;SET WORD SIZE COUNTER
1930 DATN2 CALL LIMIT ;TEST
1940 LDAX D ;BRING NEW DATA IN
1950 MOV M,A ;AND STORE AWAY IN FINAL STORAGE
1990 NEWRD INX D ;MOVE TO NEXT NEW WORD
2000 INX D
2010 DCR C ;DECREMENT WORD SIZE COUNTER
2020 JNZ DATN2 ;IF NOT DONE,GET MORE DATA
2030 FLAG2 MVI A,42H ;SET"RDY TO DUMP" AND DISABL CLK" FLGS
2040 STA 1002H ;STORE AWAY

| | | |
|---------------|------|----------------------------------------------------|
| 03AE D3 06 | 2060 | OUT 06H ;TURN ON "RDY TO DUMP" INDICATOR |
| 03B0 CD 70 02 | 2070 | RSTR2 CALL STWD1 ;STORE FINAL MEMORY POINTER |
| 03B3 C9 | 2080 | RET ;GO BACK TO IDLE |
| 03B4 | 2081 | DS START+3E0H-\$ |
| 03E0 3A 02 10 | 2082 | ERRIN LDA 1002H ;LOAD FLAG WORD |
| 03E3 F6 10 | 2084 | ORI 10H ;COMBINE WITH "ERROR" BIT |
| 03E5 D3 06 | 2086 | OUT 06H ;TURN ON ERROR INDICATOR |
| 03E7 C9 | 2088 | RET ;AND GO BACK TO IDLE |
| 03E8 | 2105 | DS START+0E00H-\$ |
| 0E00 | 2110 | BASE EQU 1800H |
| 0E00 | 2115 | *****THE FOLLOWING ROUTINE PLACES 56K OF TEST DATA |
| 0E00 | 2116 | *****ON DISK FOR LATER ANALYSIS***** |
| 0E00 3A 90 1B | 2120 | WRITE LDA BASE+390H ;START DRIVE MOTOR |
| 0E03 16 32 | 2130 | MVI D,50 ;WAIT 50 SECTOR TIMES |
| 0E05 CD D0 19 | 2140 | CALL BASE+1D0H |
| 0E08 3A 01 1B | 2150 | LDA BASE+301H ;LOAD HEAD |
| 0E0B 16 0D | 2160 | MVI D,13 ;WAIT 13 SECTOR TIMES |
| 0E0D CD D0 19 | 2170 | CALL BASE+1D0H |
| 0E10 3A 1C 1B | 2180 | LDA BASE+31CH ;SET UP HEAD TO MOVE OUT |
| 0E13 3A 10 1B | 2190 | TRACK0 LDA BASE+310H ;GET STATUS |
| 0E16 E6 01 | 2200 | ANI 1 ;MASK FOR TRACK ZERO FLAG |
| 0E18 C2 2B 0E | 2210 | JNZ FIRST ;EXIT IF TRACK ZERO FOUND |
| 0E1B 3A 09 1B | 2220 | LDA BASE+309H ;SET STEP FLIP FLOP |
| 0E1E E3 | 2230 | XTHL ;PAUSE |
| 0E1F E3 | 2240 | XTHL |
| 0E20 3A 08 1B | 2250 | LDA BASE+308H ;RESET STEP FLIP FLOP |
| 0E23 16 02 | 2260 | MVI D,2 ;WAIT 2 SECTOR TIMES |
| 0E25 CD D0 19 | 2270 | CALL BASE+1D0H |
| 0E28 C3 13 0E | 2280 | JMP TRACK0 ;LOOP UNTIL TRACK ZERO FOUND |
| 0E2B 3A 1D 1B | 2290 | FIRST LDA BASE+31DH ;SET UP HEAD TO MOVE IN |
| 0E2E 01 17 04 | 2300 | LXI B,400H+23 ;B=4-SECTORS,C=23-TRACKS |
| 0E31 CD CE 19 | 2310 | FIND CALL BASE+1CEH ;WAIT FOR NEXT SECTOR |
| 0E34 3A 30 1B | 2320 | LDA BASE+330H ;GET "B" STATUS |
| 0E37 E6 0F | 2330 | ANI 0FH ;MASK FOR SECTOR COUNT |
| 0E39 FE 06 | 2340 | CPI 6 ;LOOK FOR SECTOR 6 |
| 0E3B C2 31 0E | 2350 | JNZ FIND |
| 0E3E 3A 04 1B | 2360 | WRIT LDA BASE+304H ;WRITE COMMAND |
| 0E41 3A 10 1B | 2370 | WRSTAT LDA BASE+310H ;GET STATUS |
| 0E44 E6 08 | 2380 | ANI 8 ;MASK FOR "WRITE RDY" FLAG |
| 0E46 CA 41 0E | 2390 | JZ WRSTAT ;WAIT FOR WRITE READY |
| 0E49 C5 | 2400 | PUSH B ;SAVE COUNTERS |
| 0E4A 11 00 1A | 2410 | LXI D,BASE+200H ;SET UP TO WRITE ZEROES |
| 0E4D 01 0F 00 | 2420 | LXI B,15 ;ZEROES=15 |
| 0E50 1A | 2430 | ZERLP LDAX D ;WRITE A ZERO |
| 0E51 0D | 2440 | DCR C ;COUNT |
| 0E52 C2 50 0E | 2450 | JNZ ZERLP ;IF NOT DONE,WRITE MORE ZEROES |
| 0E55 1E FB | 2460 | MVI E,0FBH ;IF DONE,SET UP "SYNC" |
| 0E57 1A | 2470 | LDAX D ;WRITE IT |
| 0E58 7E | 2480 | WRLP MOV A,M ;GET DATA FROM VDAS MEMORY |
| 0E59 5F | 2490 | MOV E,A ;SET UP DATA FOR WRITING |
| 0E5A A8 | 2500 | XRA B ;COMPUTE CRC |
| 0E5B 07 | 2510 | RLC |
| 0E5C 47 | 2520 | MOV B,A |
| 0E5D 1A | 2530 | LDAX D ;WRITE DATA |
| 0E5E 23 | 2540 | INX H ;BUMP MEMORY POINTER |
| 0E5F 7C | 2550 | MOV A,H ;CHECK FOR MEMORY OVERFLOW |
| 0E60 B5 | 2560 | ORA L |
| 0E61 C2 66 0E | 2570 | JNZ CONT ;IF NOT REACHED,DON'T WRAPAROUND |
| 0E64 26 20 | 2580 | MVI H,20H ;IF SO,REINITIALIZE TO 2000H |
| 0E66 0D | 2590 | CONT DCR C ;COUNT BYTES |
| 0E67 C2 58 0E | 2600 | JNZ WRLP ;WRITE 256 TIMES |
| 0E6A 58 | 2610 | MOV E,B ;WRITE CRC |
| 0E6B 1A | 2620 | LDAX D |
| 0E6C C1 | 2630 | POP B ;GET TRACK & SECTOR COUNTERS |
| 0E6D CD CE 19 | 2640 | CALL BASE+1CEH ;WAIT FOR NEXT SECTOR |
| 0E70 05 | 2650 | DCR B ;COUNT SECTORS |

| | | |
|---------------|------|-------------------------------------|
| OE71 C2 3E UE | 2660 | JNZ WRIT ;LOOP 10 SECTORS PER TRACK |
| OE74 3A 09 1B | 2670 | LDA BASE+309H ;SET HEAD FLIP FLOP |
| OE77 E3 | 2680 | XTHL ;PAUSE |
| OE78 E3 | 2690 | XTHL |
| OE79 3A 08 1B | 2700 | LDA BASE+308H ;RESET HEAD FLIP FLOP |
| OE7C 16 0A | 2710 | MVI D,10 ;WAIT 10 SECTORS |
| OE7E CD D0 19 | 2720 | CALL BASE+1D0H |
| OE81 06 0A | 2730 | MVI B,10 ;RESET SECTOR COUNT TO 10 |
| OE83 0D | 2740 | DCR C ;COUNT TRACK |
| OE84 C2 3E OE | 2750 | JNZ WRIT ;LOOP 23 TRACKS |
| OE87 C9 | 2760 | RET ;GO BACK TO "DUMP"ROUTINE |

| | | | | | | | | | | | | |
|--------|------|------|------|------|------|------|------|------|------|------|------|------|
| BASE | 1800 | 2120 | 2140 | 2150 | 2170 | 2180 | 2190 | 2220 | 2250 | 2270 | 2290 | 2310 |
| | | 2320 | 2360 | 2370 | 2410 | 2640 | 2670 | 2700 | 2720 | | | |
| BGCL2 | 0298 | 1476 | 1484 | | | | | | | | | |
| BSLIN | 012D | | | | | | | | | | | |
| BUMP | 0246 | 1324 | | | | | | | | | | |
| CLMM3 | 0299 | | | | | | | | | | | |
| CONT | 0E66 | 2570 | | | | | | | | | | |
| DATN1 | 01A6 | 0780 | | | | | | | | | | |
| DATN2 | 039E | 2020 | | | | | | | | | | |
| DBIT | 031B | 1540 | | | | | | | | | | |
| DLED | 031D | 1600 | | | | | | | | | | |
| DSABL | 0380 | 0110 | | | | | | | | | | |
| DSKO | 0342 | 1675 | 1705 | | | | | | | | | |
| DUMP | 0300 | 0090 | | | | | | | | | | |
| ENR1 | 030B | | | | | | | | | | | |
| ERRIN | 03E0 | 0690 | 1430 | 1570 | 1840 | | | | | | | |
| EXIT1 | 0259 | | | | | | | | | | | |
| EXIT2 | 01F5 | 0920 | | | | | | | | | | |
| EXIT3 | 02B9 | | | | | | | | | | | |
| EXIT4 | 034E | | | | | | | | | | | |
| FIND | 0E31 | 2350 | | | | | | | | | | |
| FIRST | 0E2B | 2210 | | | | | | | | | | |
| FLAG2 | 03A9 | | | | | | | | | | | |
| FLG1 | 0128 | | | | | | | | | | | |
| FLG2 | 0190 | 0670 | | | | | | | | | | |
| FLGWD | 0125 | 0320 | | | | | | | | | | |
| IDLE | 0046 | 0180 | 0396 | | | | | | | | | |
| INCOMP | 01AC | | | | | | | | | | | |
| INCTM | 0197 | 0674 | | | | | | | | | | |
| INT0 | 0043 | | | | | | | | | | | |
| INT1 | 0030 | | | | | | | | | | | |
| INT2 | 0028 | | | | | | | | | | | |
| INT3 | 0020 | | | | | | | | | | | |
| INT4 | 0018 | | | | | | | | | | | |
| LDWD1 | 0260 | 0950 | 1510 | 1810 | | | | | | | | |
| LIM3 | 01D7 | 1100 | | | | | | | | | | |
| LIMIT | 0240 | 0960 | 0990 | 1040 | 1630 | 1850 | 1880 | 1930 | | | | |
| LMTST | 02A4 | 1472 | | | | | | | | | | |
| MMPNT | 010B | | | | | | | | | | | |
| NEWRD | 03A3 | | | | | | | | | | | |
| ODTNW | 01E2 | | | | | | | | | | | |
| OVPLW | 0331 | 1655 | 1670 | | | | | | | | | |
| PINIT | 0040 | 0030 | | | | | | | | | | |
| PORT | 1080 | 1283 | | | | | | | | | | |
| PWRON | 0100 | 0150 | | | | | | | | | | |
| QTCLR | 0345 | | | | | | | | | | | |
| REINT | 0251 | 1321 | | | | | | | | | | |
| RESET | 033C | 1690 | | | | | | | | | | |
| RSTR1 | 01F2 | 1230 | | | | | | | | | | |
| RSTR2 | 03B0 | | | | | | | | | | | |
| SETOV | 0254 | | | | | | | | | | | |
| SETUP | 0295 | | | | | | | | | | | |
| START | 0000 | 0040 | 0060 | 0080 | 0100 | 0120 | 0190 | 0398 | 0630 | 1299 | 1339 | 1357 |
| | | 1400 | 1500 | 1800 | 2081 | 2105 | | | | | | |

| | | | |
|-------|------|------|-----------|
| STRTO | 0280 | 0070 | |
| STRWD | 01C1 | 0900 | |
| STUP2 | 02AE | 1480 | |
| STWD1 | 0270 | 1245 | 1488 2070 |
| TEST | 031F | | |
| TIME | 020E | 1271 | |
| TIMN2 | 038B | | |
| TRACK | 0E13 | 2280 | |
| TRNIN | 0150 | 0395 | 0840 |
| TSMSB | 0248 | 1306 | |
| VDASI | 0180 | 0050 | |
| WDCMP | 01B1 | 0940 | |
| WEXIT | 033F | 1695 | |
| WRIT | 0E3E | 2660 | 2750 |
| WRITE | 0E00 | 1710 | |
| WRLP | 0E58 | 2600 | |
| WRSTA | 0E41 | 2390 | |
| XFER | 01E7 | 1240 | |
| ZERLP | 0E50 | 2450 | |
| ZMEM | 0118 | 0340 | |

FILE /PCOMP/

PCOMP 9000 92C6


LIST


0010 * THIS PROGRAM IS USED FOR REPROGRAMMING
0020 * 1K PROMS AFTER REASSEMBLY
0030 * ALL UNCHANGED LOCATIONS ARE SET TO DDH
0040 * ALL CHANGED LOCATIONS ARE SET TO NEW VALUE
0050 * LOAD OLD OBJECT CODE AT 8000H
0060 * LOAD NEW OBJECT CODE AT A000H
0070 * EDITED CODE IS LOADED AT B000H
0100 LXI H,8000H
0105 LXI D,0A000H
0110 CHECK MOV A,M
0114 DW OFF31H
0117 DB 55H
0130 XCHG
0133 SHLD 5500H
0140 MOV B,M
0150 XRA B
0160 JZ CLEAR
0162 DELTA PUSH D
0165 LXI D,1000H
0170 DAD D
0180 MOV M,B
0190 LHLD 5500H
0195 POP D
0200 XCHG
0210 INX D
0220 INX H
0222 MOV A,H
0225 XRI 90H
0228 JZ QUIT
0230 JMP CHECK
0240 CLEAR MVI B,ODDH
0250 JMP DELTA
0260 QUIT HLT

EXEC 2028

APPENDIX D

Data Analysis

 


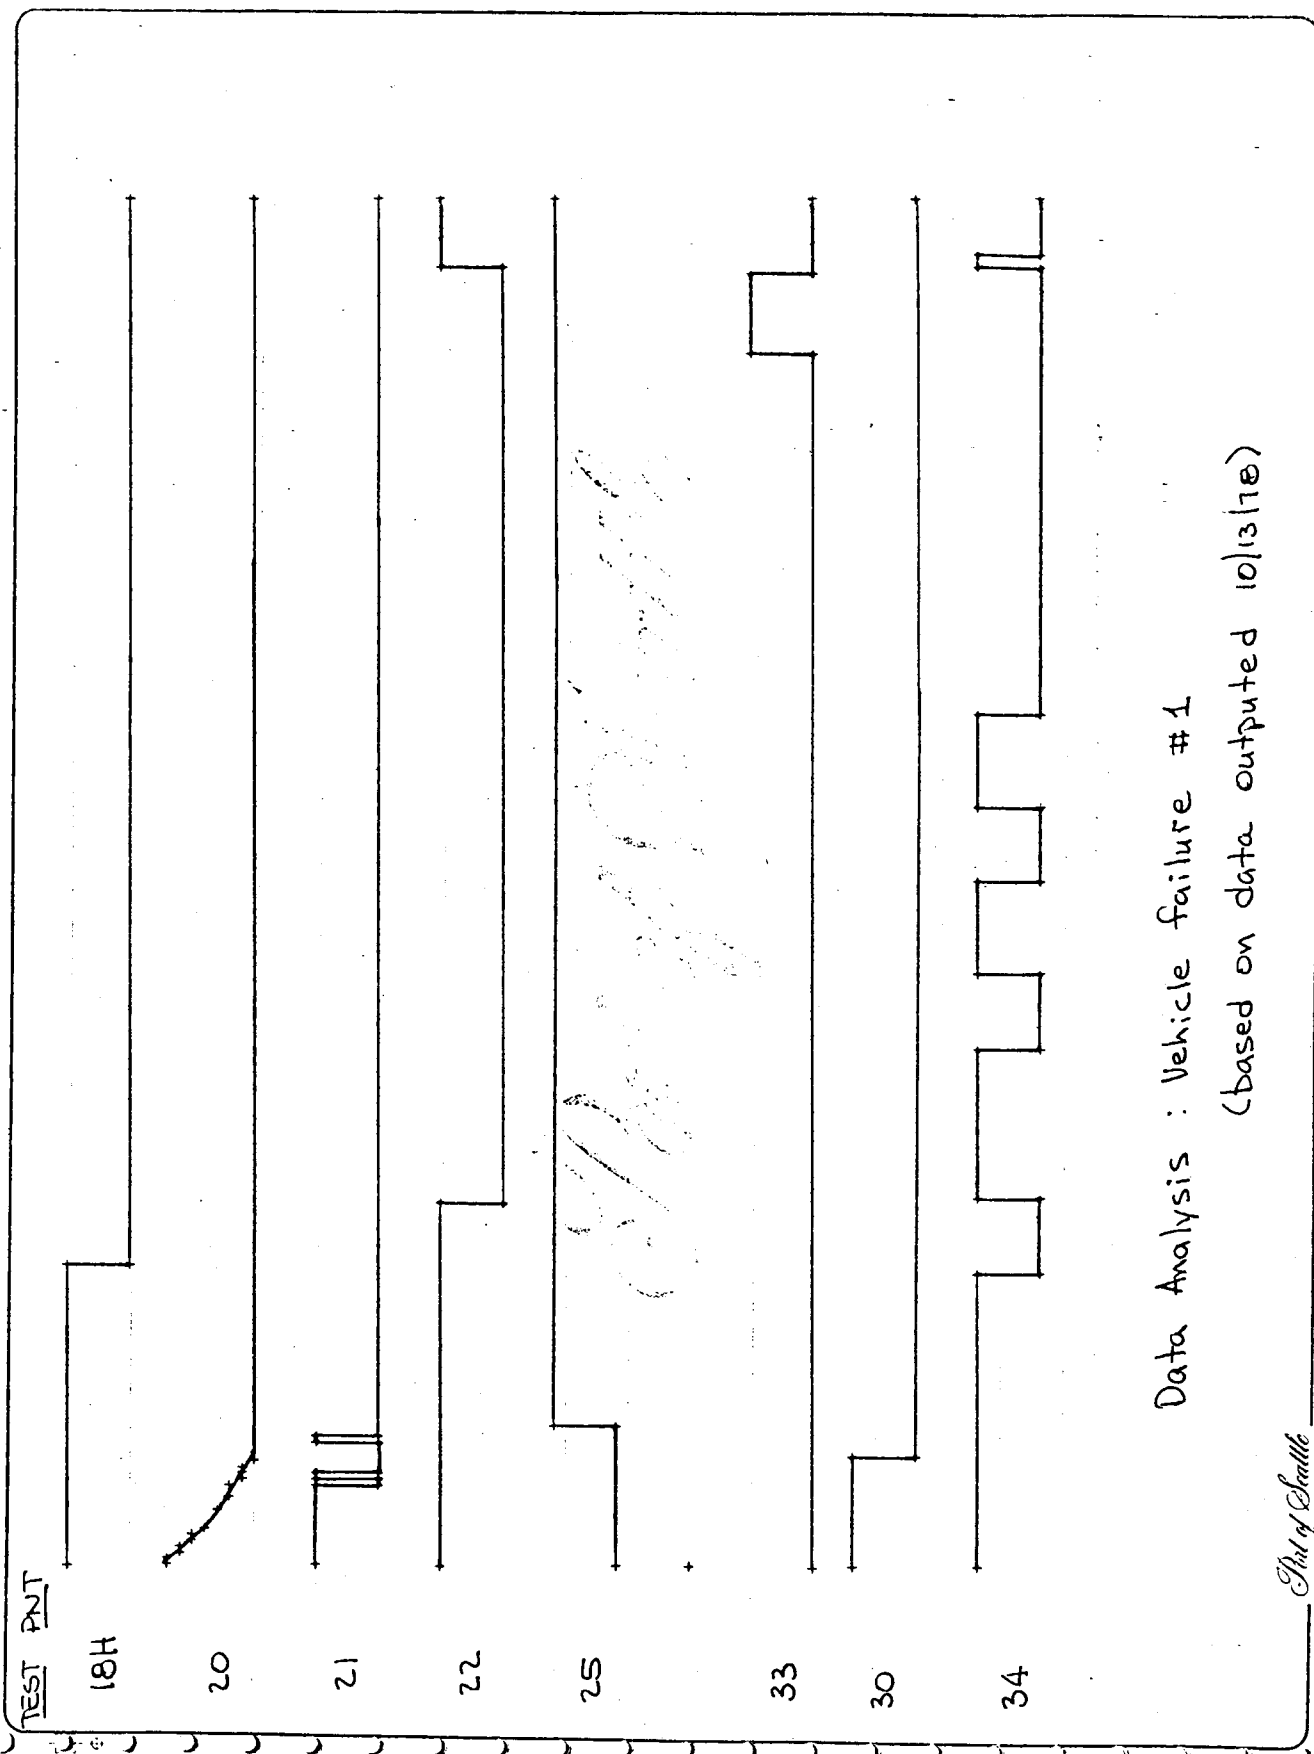

Data Analysis : Vehicle failure #1

Pat of Shuttle

TEST PNT

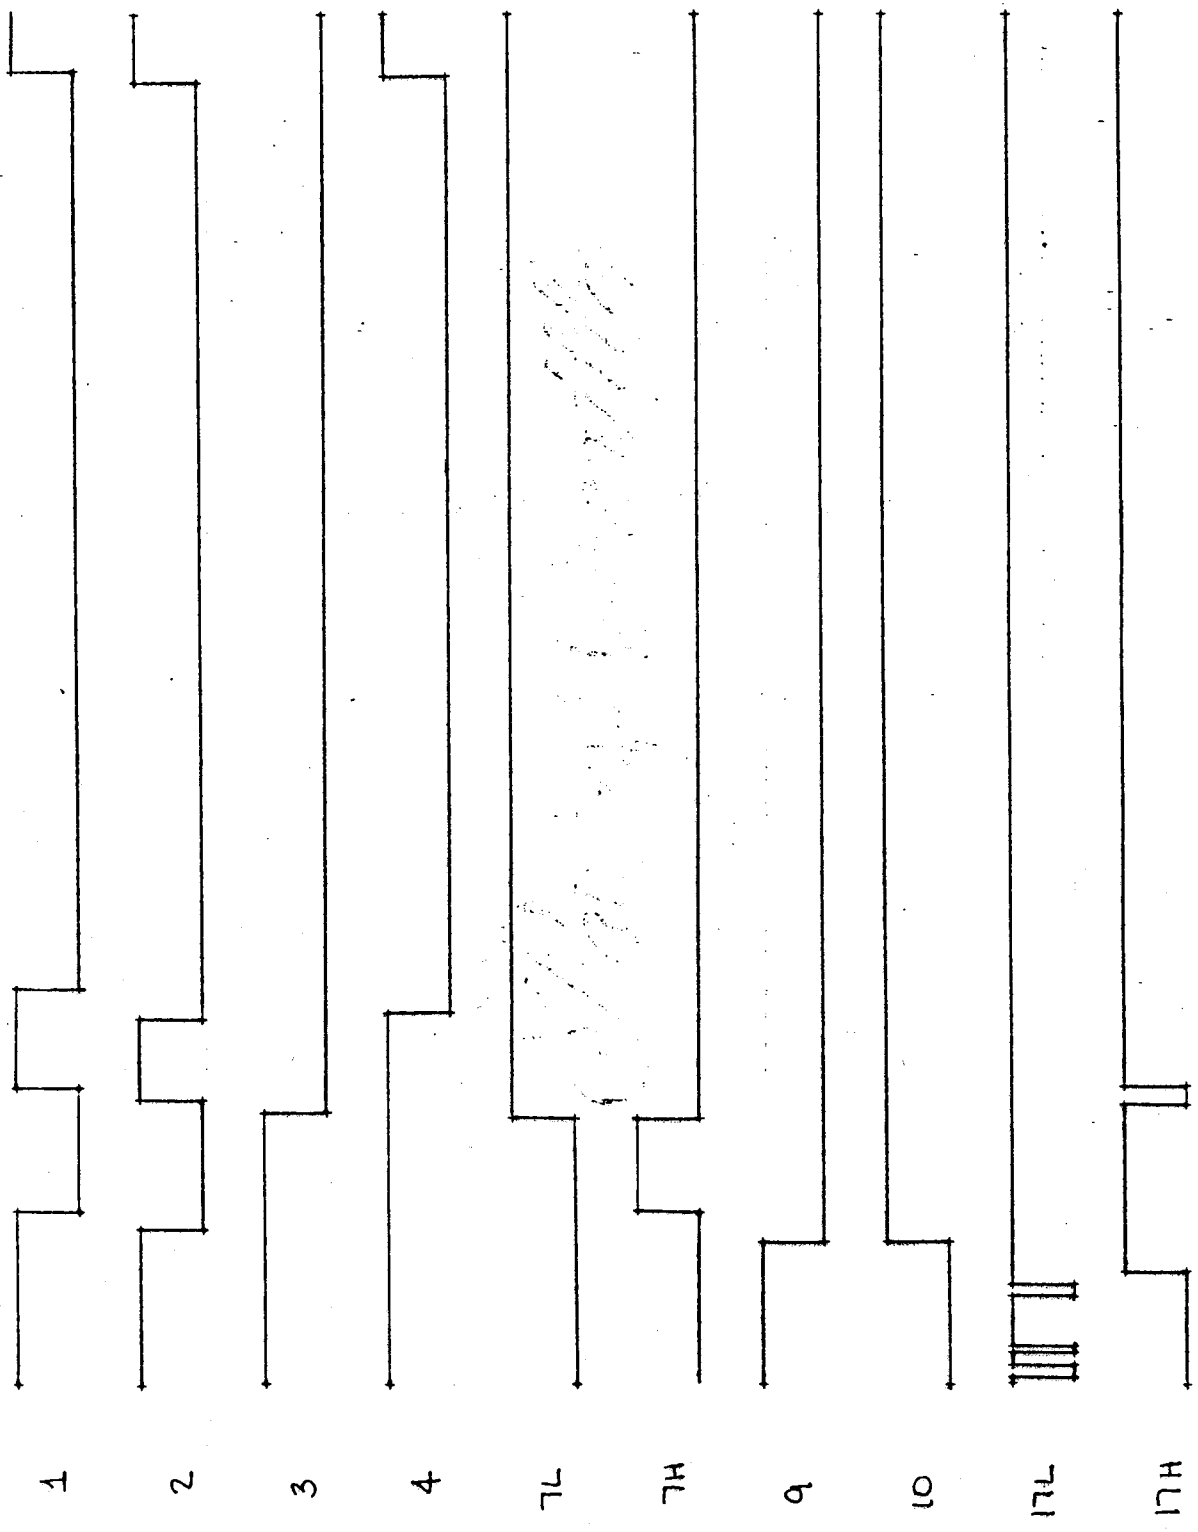

Print of Oscilloscope

10/13/78

STOP IN LINE 31000


(TP 1 THRU 34)

TEST DATA

| DATA PNT | TIME (SEC) | (TP 1 THRU 34) | | | | | | | | | | | | | | TEST DATA | | | | | | | | | | | | | | | |
|----------|------------|----------------|---|---|---|---|---|----|---|---|---|---|----|----|----|-----------|-----|---|---|---|---|---|---|---|---|---|---|---|---|---|---|
| | | 1 | 2 | 3 | 4 | 5 | 6 | 7 | 8 | 9 | 0 | 1 | 1 | 1 | 1 | 1 | 2 | 2 | 2 | 2 | 2 | 2 | 2 | 2 | 2 | 2 | 3 | 3 | 3 | 3 | 3 |
| 940 | 1554.9 | 1 | 1 | 1 | 1 | 0 | 0 | 00 | 1 | 1 | 0 | 0 | 00 | 10 | 01 | 00 | 1.4 | 1 | 1 | 0 | 0 | 0 | 0 | 0 | 0 | 0 | 1 | 0 | 0 | 0 | 1 |
| 941 | 1555 | 1 | 1 | 1 | 1 | 0 | 0 | 00 | 1 | 1 | 0 | 0 | 00 | 00 | 01 | 00 | 1.4 | 1 | 1 | 0 | 0 | 0 | 0 | 0 | 0 | 0 | 1 | 0 | 0 | 0 | 1 |
| 942 | 1555.1 | 1 | 1 | 1 | 1 | 0 | 0 | 00 | 1 | 1 | 0 | 0 | 00 | 00 | 01 | 00 | 1.2 | 1 | 1 | 0 | 0 | 0 | 0 | 0 | 0 | 0 | 1 | 0 | 0 | 0 | 1 |
| 943 | 1555.2 | 1 | 1 | 1 | 1 | 0 | 0 | 00 | 1 | 1 | 0 | 0 | 00 | 10 | 01 | 00 | 1.2 | 1 | 1 | 0 | 0 | 0 | 0 | 0 | 0 | 0 | 1 | 0 | 0 | 0 | 1 |
| 944 | 1555.3 | 1 | 1 | 1 | 1 | 0 | 0 | 00 | 1 | 1 | 0 | 0 | 00 | 10 | 01 | 00 | 1 | 1 | 1 | 0 | 0 | 0 | 0 | 0 | 0 | 0 | 1 | 0 | 0 | 0 | 1 |
| 945 | 1555.4 | 1 | 1 | 1 | 1 | 0 | 0 | 00 | 1 | 1 | 0 | 0 | 00 | 00 | 01 | 00 | 1 | 1 | 1 | 0 | 0 | 0 | 0 | 0 | 0 | 0 | 1 | 0 | 0 | 0 | 1 |
| 946 | 1555.5 | 1 | 1 | 1 | 1 | 0 | 0 | 00 | 1 | 1 | 0 | 0 | 00 | 10 | 01 | 00 | .8 | 1 | 1 | 0 | 0 | 0 | 0 | 0 | 0 | 0 | 1 | 0 | 0 | 0 | 1 |
| 947 | 1555.8 | 1 | 1 | 1 | 1 | 0 | 0 | 00 | 1 | 1 | 0 | 0 | 00 | 10 | 01 | 00 | .6 | 1 | 1 | 0 | 0 | 0 | 0 | 0 | 0 | 0 | 1 | 0 | 0 | 0 | 1 |
| 948 | 1556 | 1 | 1 | 1 | 1 | 0 | 0 | 00 | 1 | 1 | 0 | 0 | 00 | 10 | 01 | 00 | .4 | 1 | 1 | 0 | 0 | 0 | 0 | 0 | 0 | 0 | 1 | 0 | 0 | 0 | 1 |
| 949 | 1556.2 | 1 | 1 | 1 | 1 | 0 | 0 | 00 | 1 | 1 | 0 | 0 | 00 | 10 | 01 | 00 | .4 | 0 | 1 | 0 | 0 | 0 | 0 | 0 | 0 | 0 | 1 | 0 | 0 | 0 | 1 |
| 950 | 1556.3 | 1 | 1 | 1 | 1 | 0 | 0 | 00 | 1 | 1 | 0 | 0 | 00 | 00 | 01 | 00 | .2 | 1 | 1 | 0 | 0 | 0 | 0 | 0 | 0 | 0 | 1 | 0 | 0 | 0 | 1 |
| 951 | 1556.4 | 1 | 1 | 1 | 1 | 0 | 0 | 00 | 1 | 1 | 0 | 0 | 00 | 00 | 01 | 00 | .2 | 0 | 1 | 0 | 0 | 0 | 0 | 0 | 0 | 0 | 1 | 0 | 0 | 0 | 1 |
| 952 | 1556.5 | 1 | 1 | 1 | 1 | 0 | 0 | 00 | 1 | 1 | 0 | 0 | 00 | 10 | 01 | 00 | .2 | 0 | 1 | 0 | 0 | 0 | 0 | 0 | 0 | 0 | 1 | 0 | 0 | 0 | 1 |
| 953 | 1556.6 | 1 | 1 | 1 | 1 | 0 | 0 | 00 | 1 | 1 | 0 | 0 | 00 | 10 | 01 | 00 | 0 | 0 | 1 | 0 | 0 | 0 | 0 | 0 | 0 | 0 | 1 | 0 | 0 | 0 | 1 |
| 954 | 1556.7 | 1 | 1 | 1 | 1 | 0 | 0 | 00 | 1 | 1 | 0 | 0 | 00 | 11 | 01 | 00 | 0 | 0 | 1 | 0 | 0 | 0 | 0 | 0 | 0 | 0 | 1 | 0 | 0 | 0 | 1 |
| 955 | 1556.9 | 1 | 1 | 1 | 1 | 0 | 0 | 00 | 1 | 1 | 0 | 0 | 00 | 11 | 01 | 00 | 0 | 1 | 1 | 0 | 0 | 0 | 0 | 0 | 0 | 0 | 0 | 0 | 0 | 0 | 1 |
| 956 | 1557 | 1 | 1 | 1 | 1 | 0 | 0 | 00 | 1 | 1 | 0 | 0 | 00 | 11 | 01 | 00 | 0 | 0 | 1 | 0 | 0 | 0 | 0 | 0 | 0 | 0 | 0 | 0 | 0 | 0 | 1 |
| 957 | 1557.2 | 1 | 1 | 1 | 1 | 0 | 0 | 00 | 1 | 1 | 0 | 0 | 00 | 11 | 01 | 00 | 0 | 0 | 1 | 0 | 0 | 1 | 0 | 0 | 0 | 0 | 0 | 0 | 0 | 0 | 1 |
| 958 | 1557.4 | 1 | 0 | 1 | 1 | 0 | 0 | 00 | 1 | 0 | 1 | 0 | 00 | 11 | 01 | 00 | 0 | 0 | 1 | 0 | 0 | 1 | 0 | 0 | 0 | 0 | 0 | 0 | 0 | 0 | 1 |
| 959 | 1557.7 | 1 | 0 | 1 | 1 | 0 | 0 | 01 | 1 | 0 | 1 | 0 | 00 | 11 | 01 | 00 | 0 | 0 | 1 | 0 | 0 | 1 | 0 | 0 | 0 | 0 | 0 | 0 | 0 | 0 | 1 |
| 960 | 1557.8 | 0 | 0 | 1 | 1 | 0 | 0 | 01 | 1 | 0 | 1 | 0 | 00 | 11 | 01 | 00 | 0 | 0 | 1 | 0 | 0 | 1 | 0 | 0 | 0 | 0 | 0 | 0 | 0 | 0 | 1 |
| 961 | 1559.2 | 0 | 0 | 1 | 1 | 0 | 0 | 10 | 1 | 0 | 1 | 0 | 00 | 11 | 01 | 00 | 0 | 0 | 1 | 0 | 0 | 1 | 0 | 0 | 0 | 0 | 0 | 0 | 0 | 0 | 1 |
| 962 | 1559.3 | 0 | 0 | 0 | 1 | 0 | 0 | 10 | 1 | 0 | 1 | 0 | 00 | 11 | 01 | 00 | 0 | 0 | 1 | 0 | 0 | 1 | 0 | 0 | 0 | 0 | 0 | 0 | 0 | 0 | 1 |
| 963 | 1559.4 | 0 | 0 | 0 | 1 | 0 | 0 | 10 | 1 | 0 | 1 | 0 | 00 | 10 | 01 | 00 | 0 | 0 | 1 | 0 | 0 | 1 | 0 | 0 | 0 | 0 | 0 | 0 | 0 | 0 | 1 |
| 964 | 1559.5 | 0 | 1 | 0 | 1 | 0 | 0 | 10 | 1 | 0 | 1 | 0 | 00 | 10 | 01 | 00 | 0 | 0 | 1 | 0 | 0 | 1 | 0 | 0 | 0 | 0 | 0 | 0 | 0 | 0 | 1 |
| 965 | 1559.7 | 1 | 1 | 0 | 1 | 0 | 0 | 10 | 1 | 0 | 1 | 0 | 00 | 11 | 01 | 00 | 0 | 0 | 1 | 0 | 0 | 1 | 0 | 0 | 0 | 0 | 0 | 0 | 0 | 0 | 0 |
| 966 | 1559.8 | 1 | 1 | 0 | 1 | 0 | 0 | 10 | 1 | 0 | 1 | 0 | 00 | 11 | 00 | 00 | 0 | 0 | 1 | 0 | 0 | 1 | 0 | 0 | 0 | 0 | 0 | 0 | 0 | 0 | 0 |
| 967 | 1560.8 | 1 | 0 | 0 | 1 | 0 | 0 | 10 | 1 | 0 | 1 | 0 | 00 | 11 | 00 | 00 | 0 | 0 | 0 | 0 | 1 | 0 | 0 | 0 | 0 | 0 | 0 | 0 | 0 | 0 | 0 |
| 968 | 1560.9 | 1 | 0 | 0 | 0 | 0 | 0 | 10 | 1 | 0 | 1 | 0 | 00 | 11 | 00 | 00 | 0 | 0 | 0 | 0 | 1 | 0 | 0 | 0 | 0 | 0 | 0 | 0 | 0 | 0 | 1 |
| 969 | 1561.3 | 0 | 0 | 0 | 0 | 0 | 0 | 10 | 1 | 0 | 1 | 0 | 00 | 11 | 00 | 00 | 0 | 0 | 0 | 0 | 1 | 0 | 0 | 0 | 0 | 0 | 0 | 0 | 0 | 0 | 1 |
| 970 | 1563.3 | 0 | 0 | 0 | 0 | 0 | 0 | 10 | 1 | 0 | 1 | 0 | 00 | 11 | 00 | 00 | 0 | 0 | 0 | 0 | 1 | 0 | 0 | 0 | 0 | 0 | 0 | 0 | 0 | 0 | 0 |
| 971 | 1564.5 | 0 | 0 | 0 | 0 | 0 | 0 | 10 | 1 | 0 | 1 | 0 | 00 | 11 | 00 | 00 | 0 | 0 | 0 | 0 | 1 | 0 | 0 | 0 | 0 | 0 | 0 | 0 | 0 | 0 | 0 |
| 972 | 1566 | 0 | 0 | 0 | 0 | 0 | 0 | 10 | 1 | 0 | 1 | 0 | 00 | 11 | 00 | 00 | 0 | 0 | 0 | 0 | 1 | 0 | 0 | 0 | 0 | 0 | 0 | 0 | 0 | 0 | 0 |
| 973 | 1567.2 | 0 | 0 | 0 | 0 | 0 | 0 | 10 | 1 | 0 | 1 | 0 | 00 | 11 | 00 | 00 | 0 | 0 | 0 | 0 | 1 | 0 | 0 | 0 | 0 | 0 | 0 | 0 | 0 | 0 | 1 |
| 974 | 1568.7 | 0 | 0 | 0 | 0 | 0 | 0 | 10 | 1 | 0 | 1 | 0 | 00 | 11 | 00 | 00 | 0 | 0 | 0 | 0 | 1 | 0 | 0 | 0 | 0 | 0 | 0 | 0 | 0 | 0 | 0 |
| 975 | 1574.5 | 0 | 0 | 0 | 0 | 0 | 0 | 10 | 1 | 0 | 1 | 0 | 00 | 11 | 00 | 00 | 0 | 0 | 0 | 0 | 1 | 0 | 0 | 0 | 0 | 0 | 0 | 0 | 0 | 0 | 1 |
| 976 | 1575.8 | 0 | 0 | 0 | 0 | 0 | 0 | 10 | 1 | 0 | 1 | 0 | 00 | 11 | 00 | 00 | 0 | 0 | 0 | 0 | 1 | 0 | 0 | 0 | 0 | 0 | 0 | 0 | 0 | 0 | 1 |
| 977 | 1575.9 | 0 | 1 | 0 | 0 | 0 | 0 | 10 | 1 | 0 | 1 | 0 | 00 | 11 | 00 | 00 | 0 | 0 | 1 | 0 | 0 | 1 | 0 | 0 | 0 | 0 | 0 | 0 | 0 | 0 | 1 |
| 978 | 1576 | 0 | 1 | 0 | 1 | 0 | 0 | 10 | 1 | 0 | 1 | 0 | 00 | 11 | 00 | 00 | 0 | 0 | 1 | 0 | 0 | 1 | 0 | 0 | 0 | 0 | 0 | 0 | 0 | 0 | 1 |
| 979 | 1576.1 | 1 | 1 | 0 | 1 | 0 | 0 | 10 | 1 | 0 | 1 | 0 | 00 | 11 | 00 | 00 | 0 | 0 | 1 | 0 | 0 | 1 | 0 | 0 | 0 | 0 | 0 | 0 | 0 | 0 | 1 |
| 980 | 1577 | 1 | 1 | 0 | 1 | 0 | 0 | 10 | 1 | 0 | 1 | 0 | 00 | 11 | 00 | 00 | 0 | 0 | 1 | 0 | 0 | 1 | 0 | 0 | 0 | 0 | 0 | 0 | 0 | 0 | 1 |

LEAD

TEST POINT

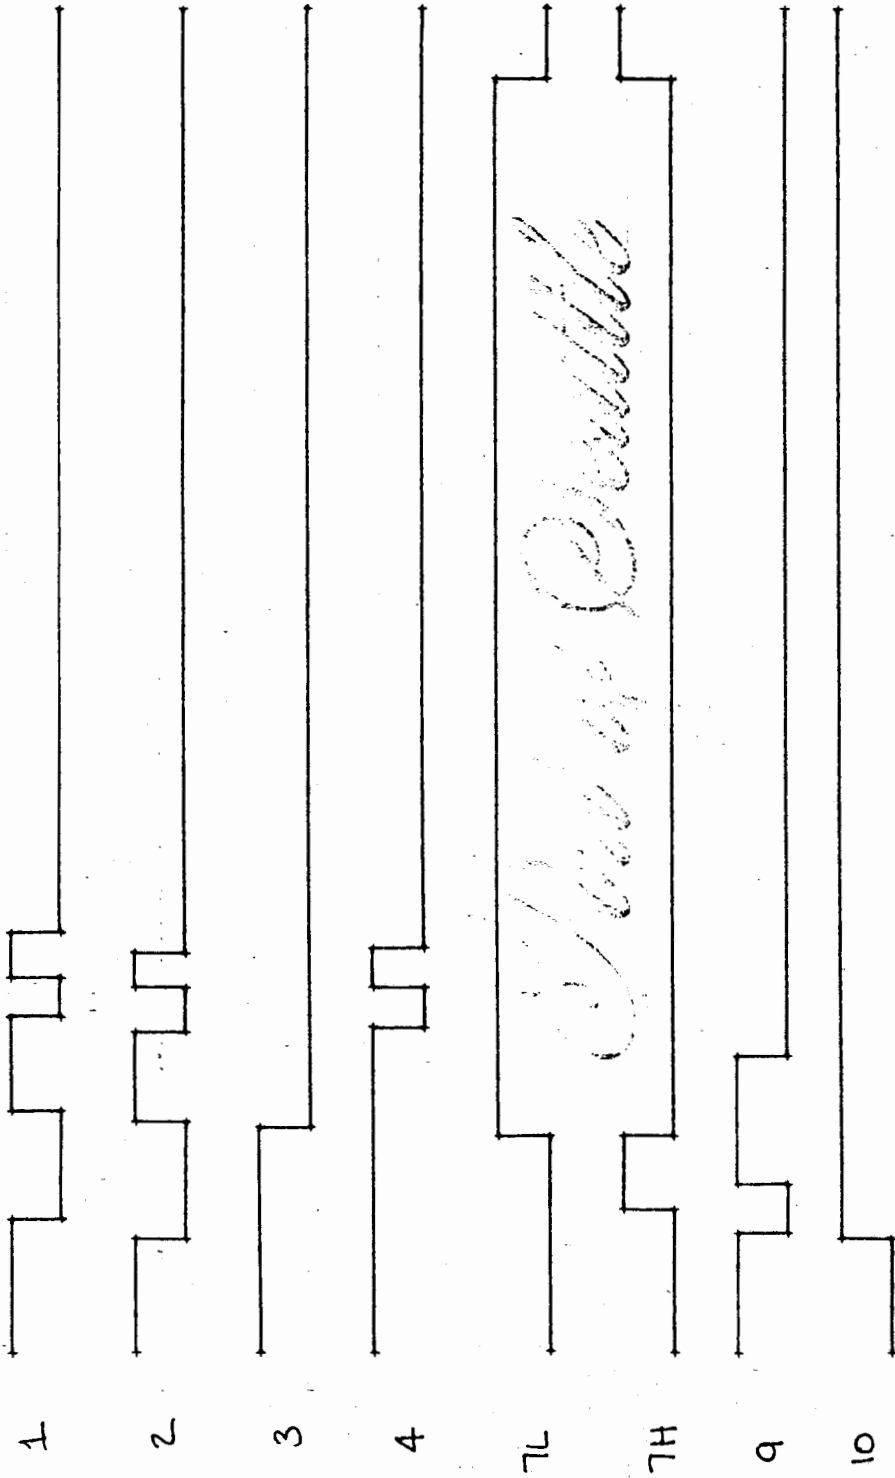



Data Analysis: Vehicle failure #2
(based on data outputted 10/18/18)


TEST PNT

101910

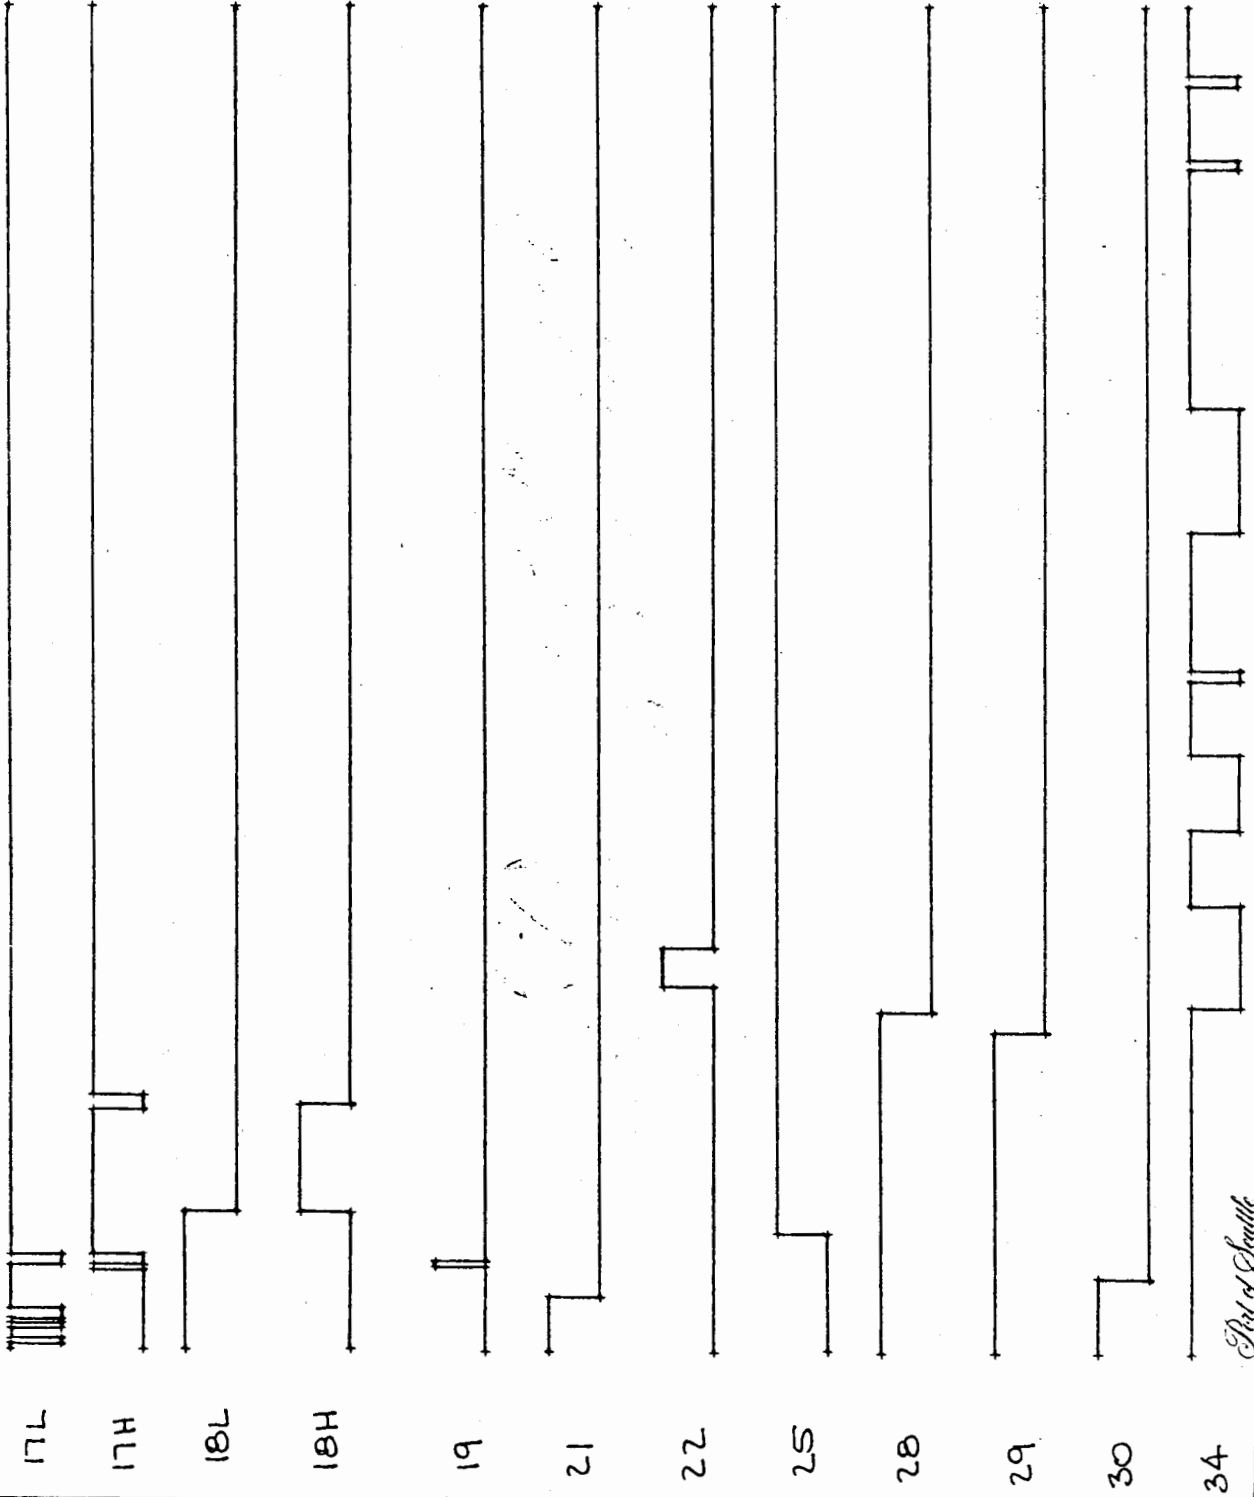


Dist of Seattle

Data Analysis : Vehicle failure # 3
(based on data outputed 10/30/18)


TEST PNT

1

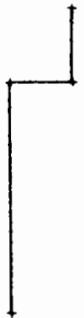

2



3



4



9



16L




16H




17L



17H

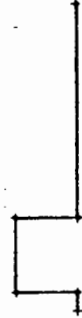

18L

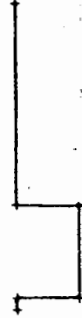

Print of Seattle

TEST PNT

18 H




10/30/18

19 LPH



22

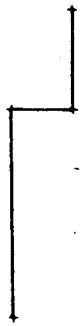

24



30



33



Part of Shuttle

